

Addressing Request
No:2841519

Cancelling Lot 9001 on SP307780.

PRELIMINARY

Original information compiled from
SP307780 in the Department of Natural
Resources, Mines & Energy.


12/06/2019

See Sheet 10 for Reference Marks, Permanent
Marks, MGA Coordinates and Meridian tables.

Property Address Lot 9001.
Lot 9001 Everleigh Drive,
GREENBANK 4124.

Area of New Road
1.59 ha

SEE SHEETS 3-7 FOR MORE ALLOCATED
PROPERTY/STREET NUMBERING.

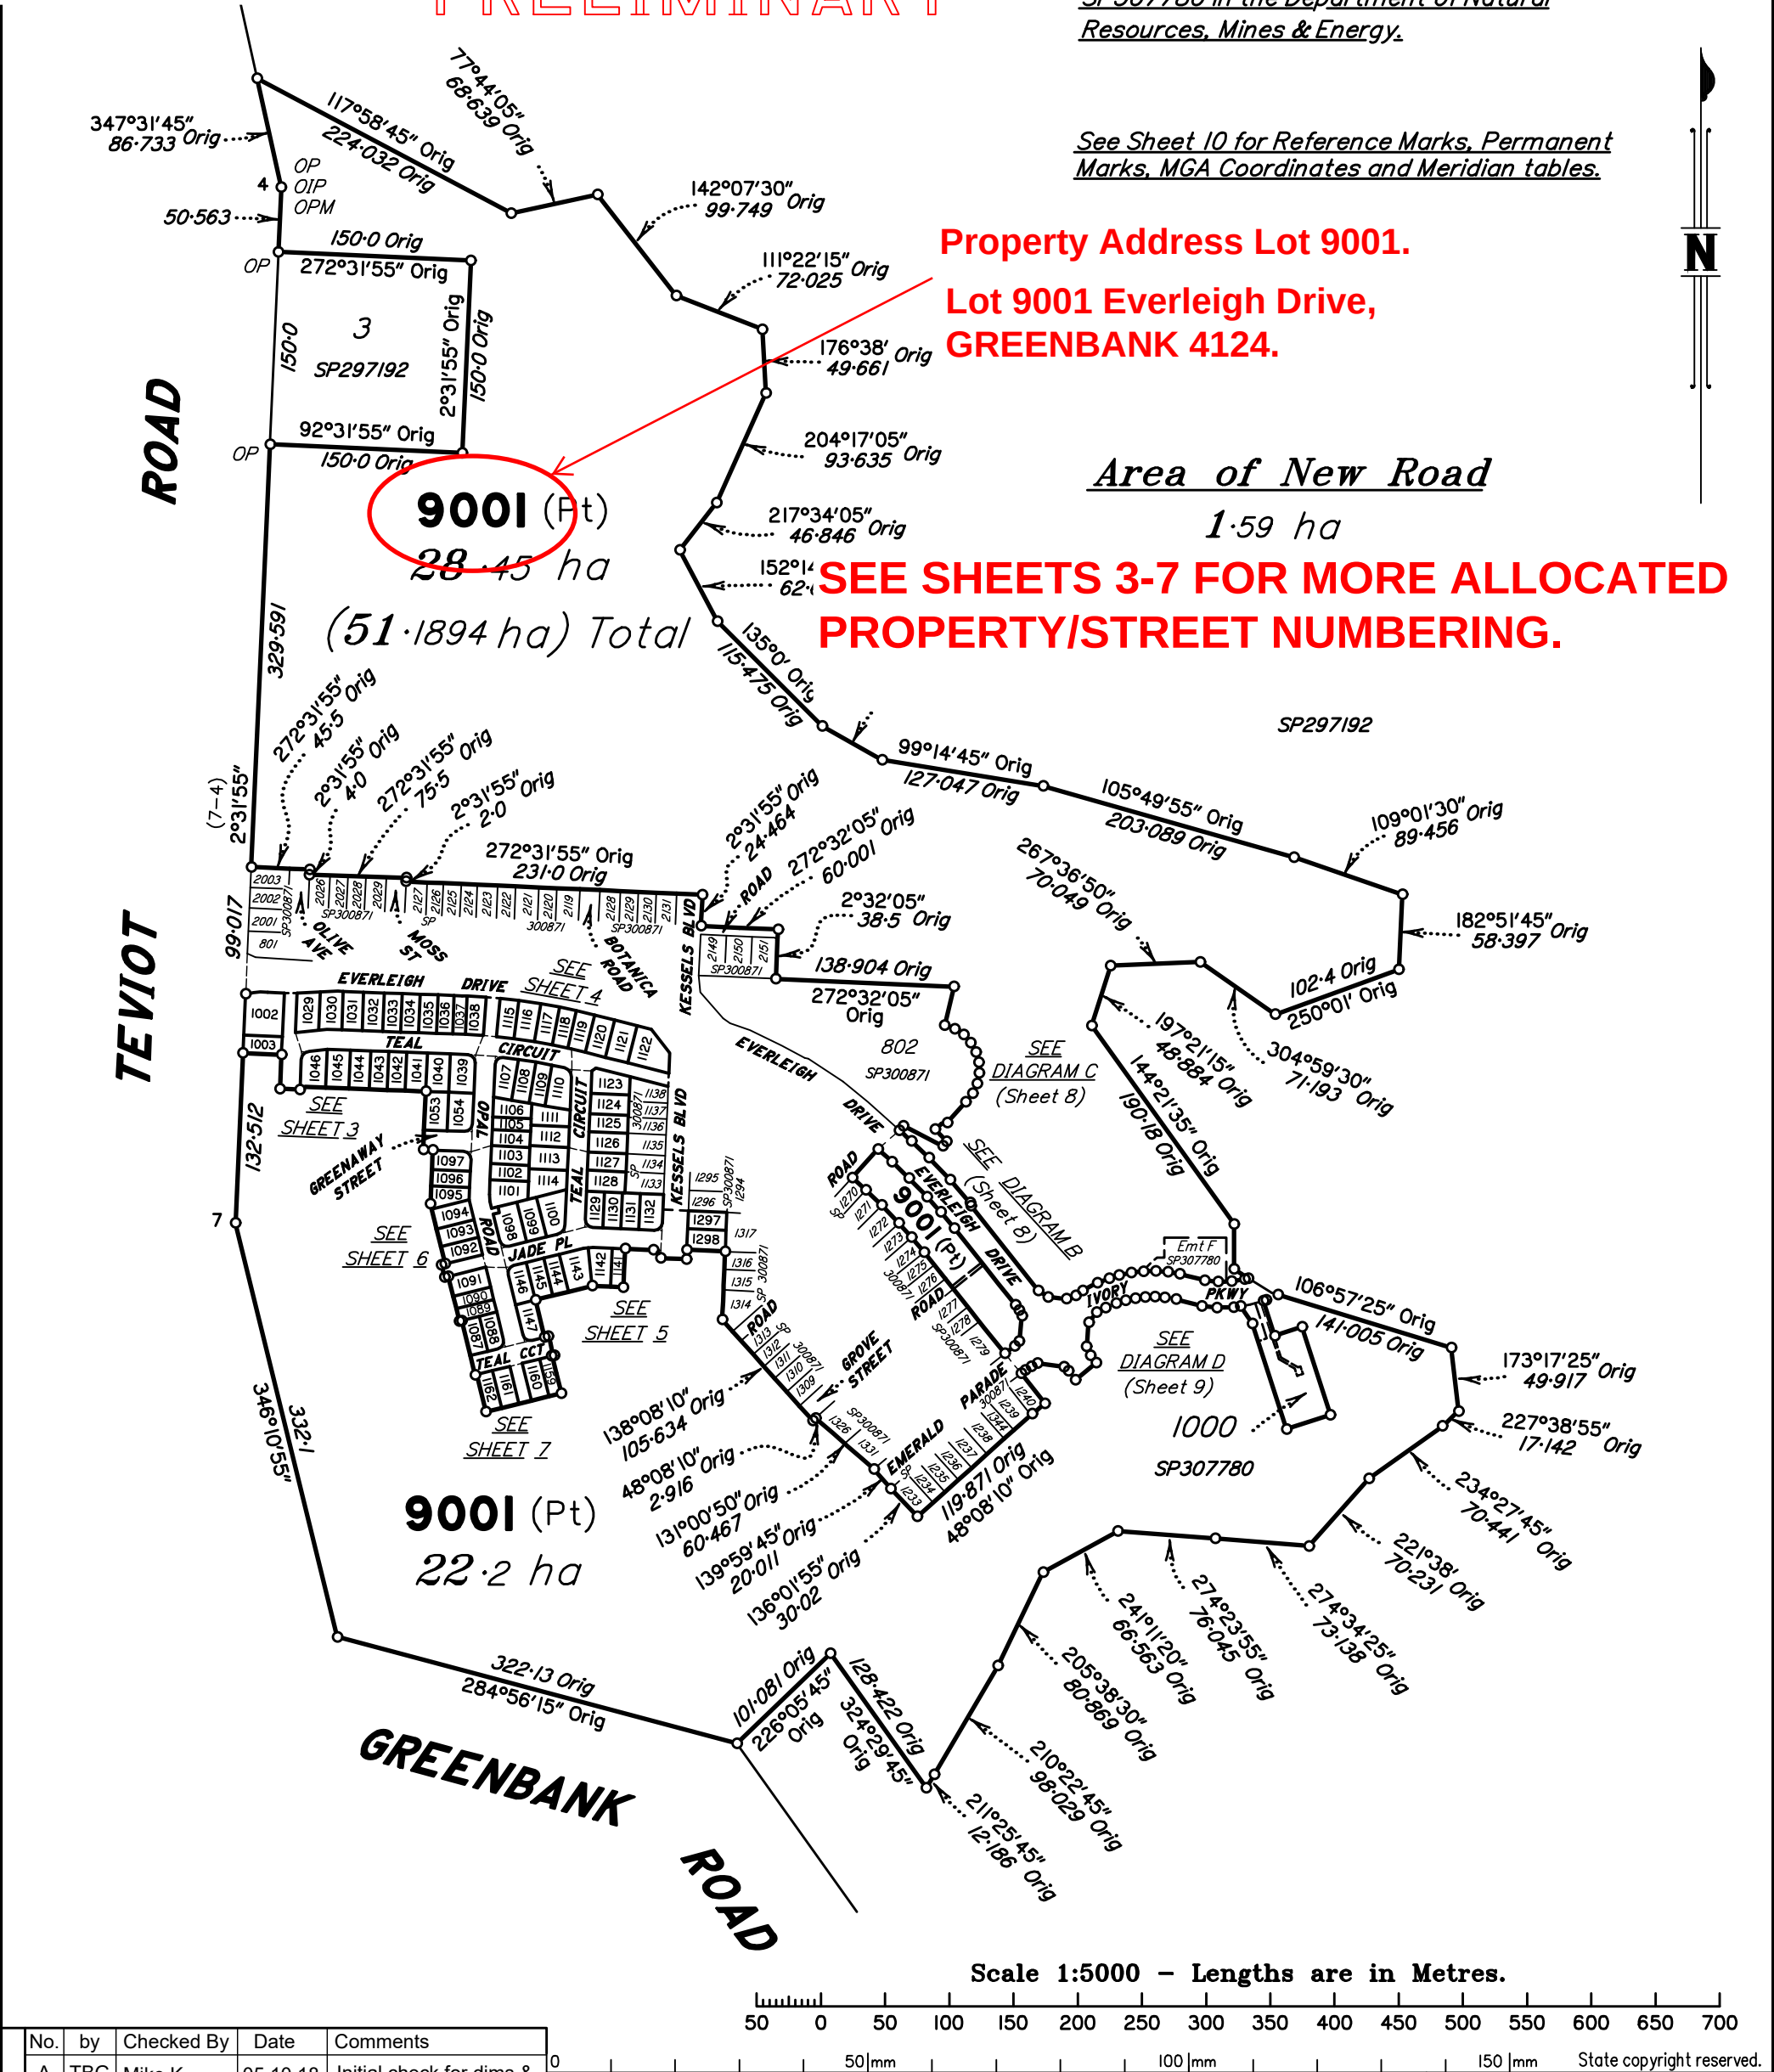

No.	by	Checked By	Date	Comments
A	TBG	Mike K	05.10.18	Initial check for dims & DP suitability.
B	TBG	Mike K	24.05.19	Amended as per SP307780
C	TBG	Mike K	10.06.19	Corner info added. Stage bdys minor amendment.

Plan of Lots 1002, 1003, 1029-1046,
1053, 1054, 1087-1132, 1141-1147,
1159-1162, 1297, 1298 & 9001
Cancelling Lot 9001 on SP307780

LOCAL
GOVERNMENT: LOGAN CITY

LOCALITY: GREENBANK

Meridian: MGA (Zone 56) vide Meridian Table

Survey
Records: No

Scale: 1:5000
Format: STANDARD

SP300873

SAUNDERS HAVILL GROUP
Preliminary Issues

7598 SP300873.DWG TBG

Land Title Act 1994 ; Land Act 1994
Form 2IB Version I

WARNING : Folded or Mutilated Plans will not be accepted.
Plans may be rolled.
Information may not be placed in the outer margins.

Sheet
2of
10

5. Lodged by

(Include address, phone number, reference, and Lodger Code)

1. Certificate of Registered Owners or Lessees.

I/We MIRVAC QUEENSLAND PTY LIMITED
A.C.N. 060 411 207

(Names in full)

* as Registered Owners of this land agree to this plan and dedicate the Public Use Land as shown hereon in accordance with Section 50 of the Land Title Act 1994.

~~* as Lessees of this land agree to this plan.~~

Signature of *Registered Owners ~~*Lessees~~
MIRVAC QUEENSLAND PTY LIMITED A.C.N. 060 411 207
BY ITS DULY AUTHORISED ATTORNEYS

EMPLOYEES OF MIRVAC GROUP OF COMPANIES UNDER
POWER OF ATTORNEY NO.
AND WHO HAS RECEIVED NO NOTICE OF REVOCATION
OF THAT ATTORNEY AND WHO WARRANTS THAT THEY
HAVE THE REQUISITE POWER UNDER THAT ATTORNEY.

* Rule out whichever is inapplicable

6. ExistingCreated

Title Reference	Description	New Lots	Road	Secondary Interests
51184608	Lot 9001 on SP307780	1002, 1003, 1029–1046, 1053, 1054, 1087–1132, 1141–1147, 1159–1162, 1297, 1298 & 9001	New Rd	

ENCUMBRANCE EASEMENT ALLOCATIONS

Easement	Lots to be Encumbered
..... (Emt C on SP307780)	9001
..... (Emt F on SP307780)	9001

Easement A on SP307760 is fully absorbed by new road.

PRELIMINARY

2. Planning Body Approval.

*
hereby approves this plan in accordance with the :
%

Dated this day of
..... #
..... #


* Insert the name of the Planning Body.
Insert designation of signatory or delegation

3.Plans with Community Management Statement :4. References :
CMS Number :
Name :
Dept File :
Local Govt :
Surveyor : 7598

7. Orig Grant Allocation :
8. Passed & Endorsed :
By: SAUNDERS HAVILL GROUP PTY LTD
Date :
Signed :
Designation : Liaison Officer


9. Building Format Plans only.
I certify that :
* As far as it is practical to determine, no part of the building shown on this plan encroaches onto adjoining lots or road;
* Part of the building shown on this plan encroaches onto adjoining* lots and road
Cadastral Surveyor/Director* Date
*delete words not required

10. Lodgement Fees :
Survey Deposit \$
Lodgement \$
.....New Titles \$
Photocopy \$
Postage \$
TOTAL \$
II. Insert Plan Number
SP300873

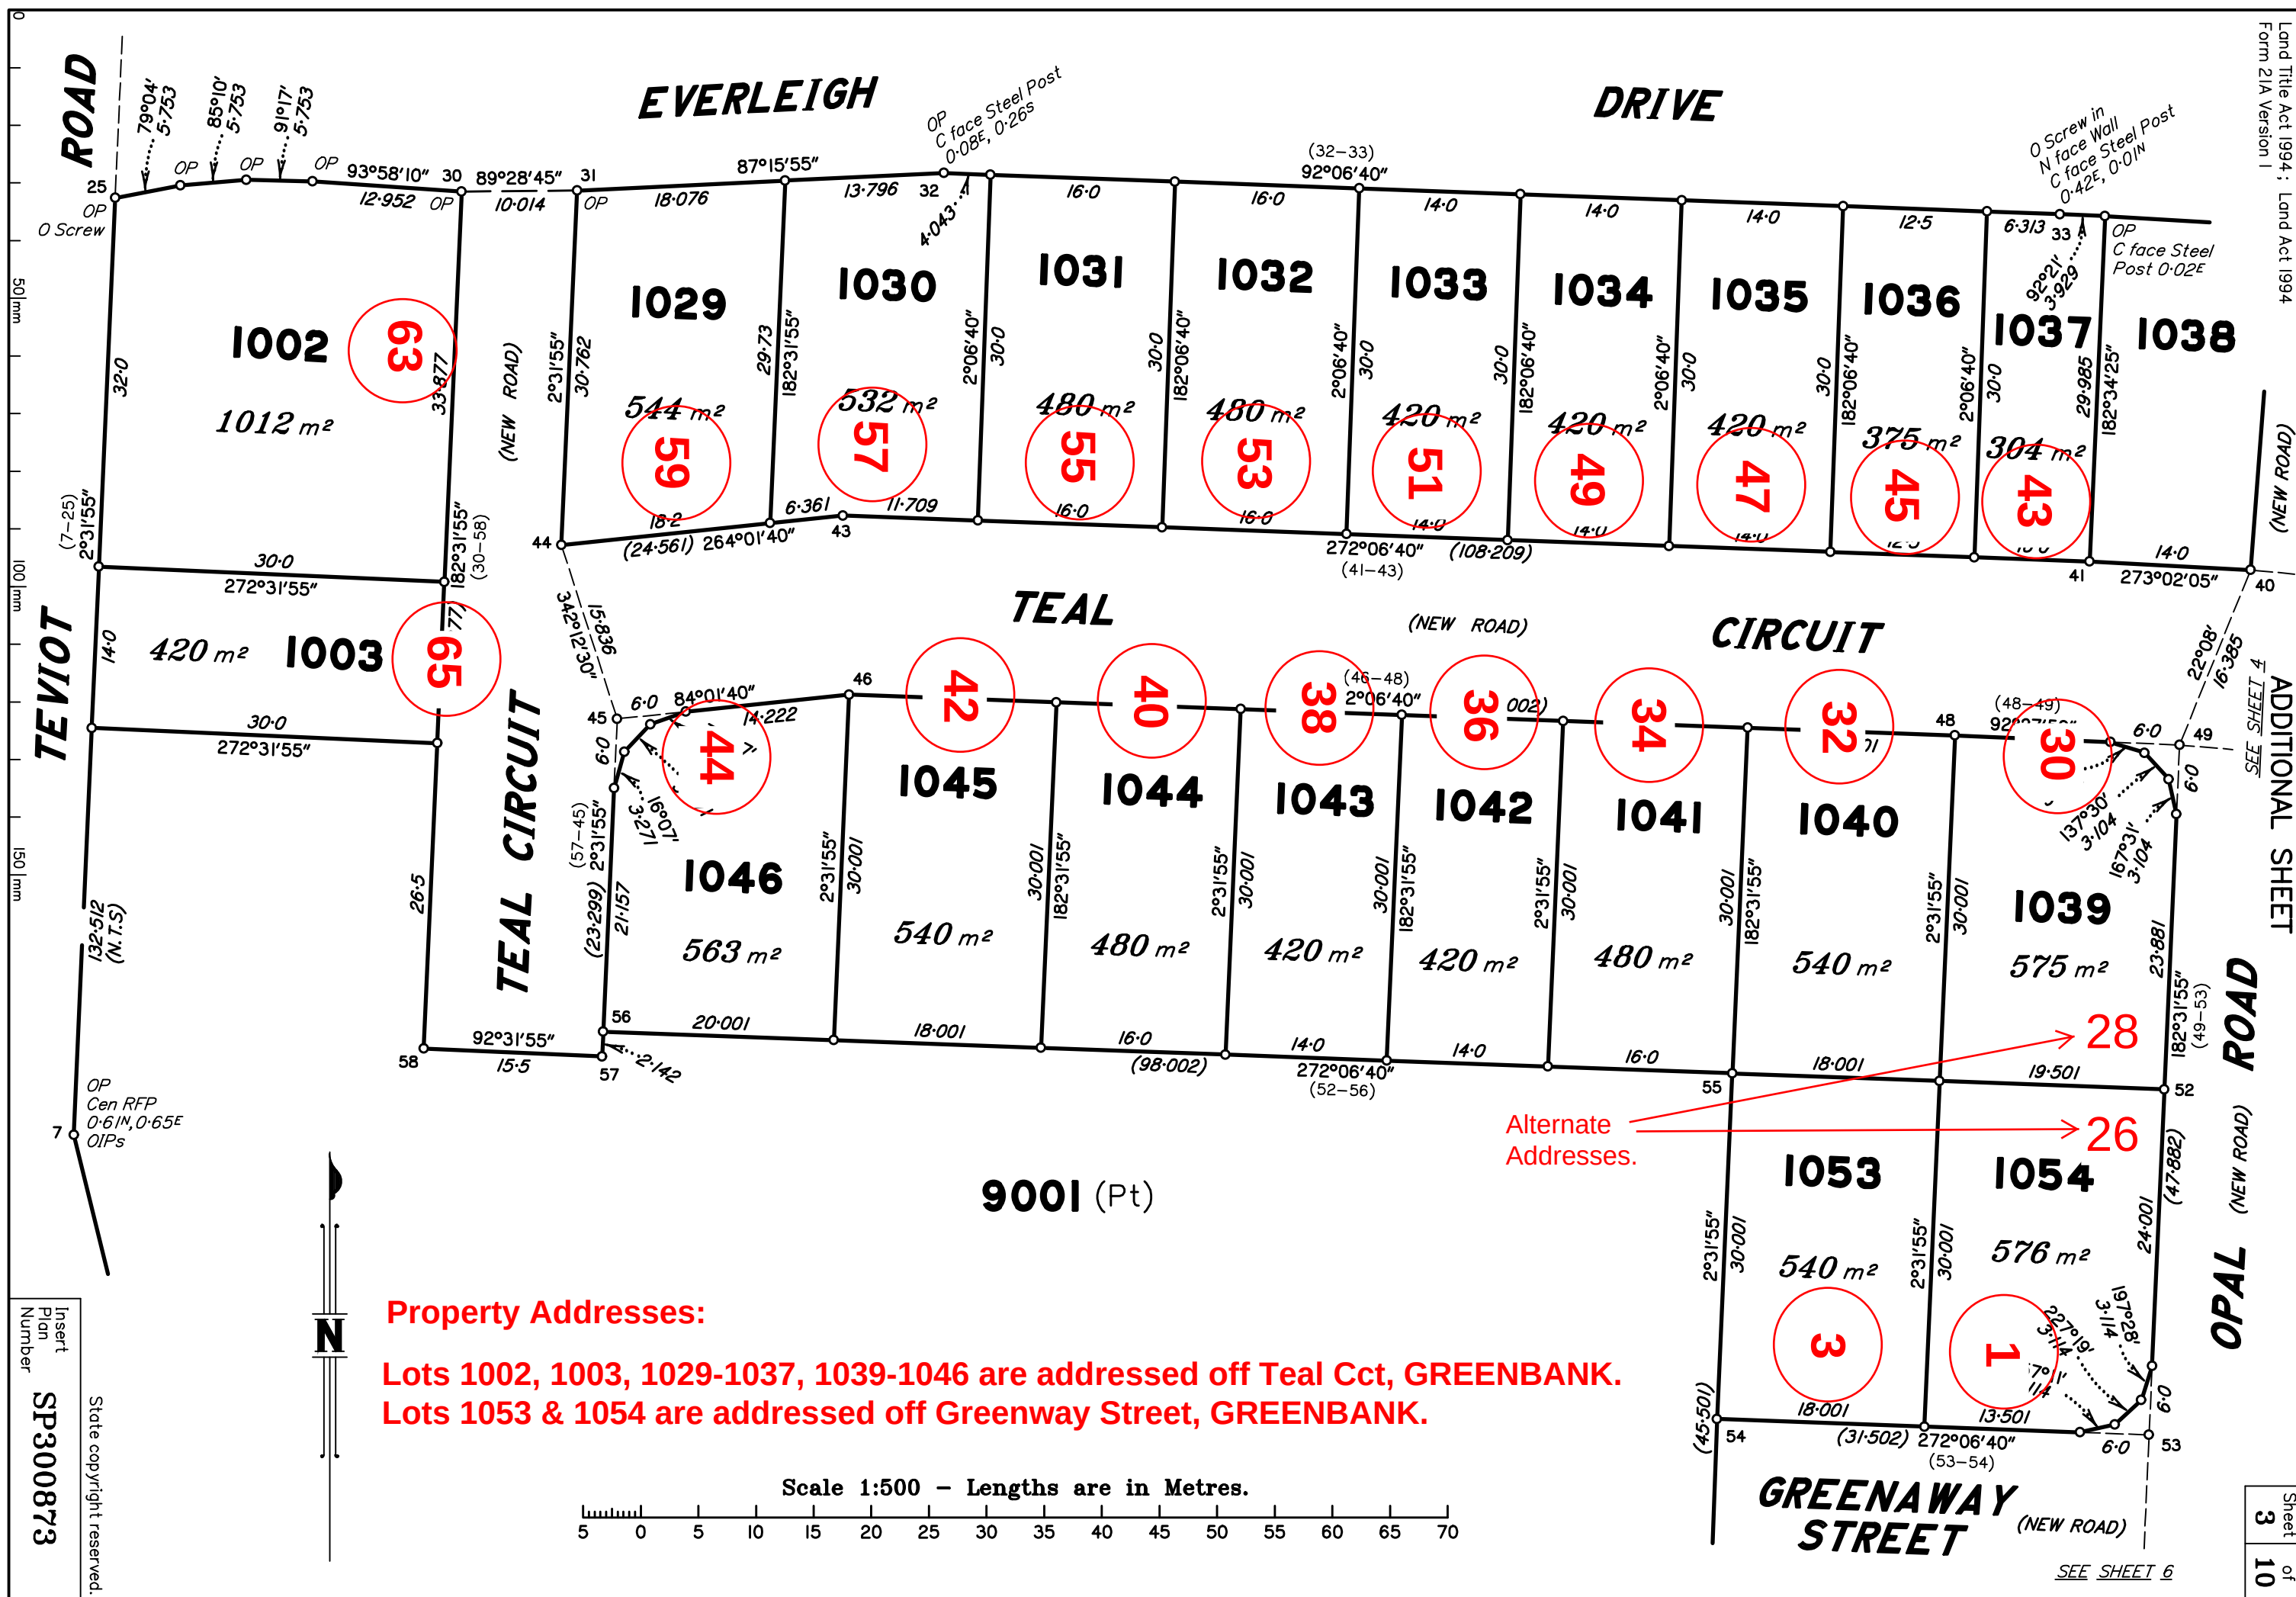


Lots 1104-1106 are addressed off Opal Road, GREENBANK.
Lots 1038, 1107-1112, 1115-1126 are addressed off Teal Drive, GREENBANK.



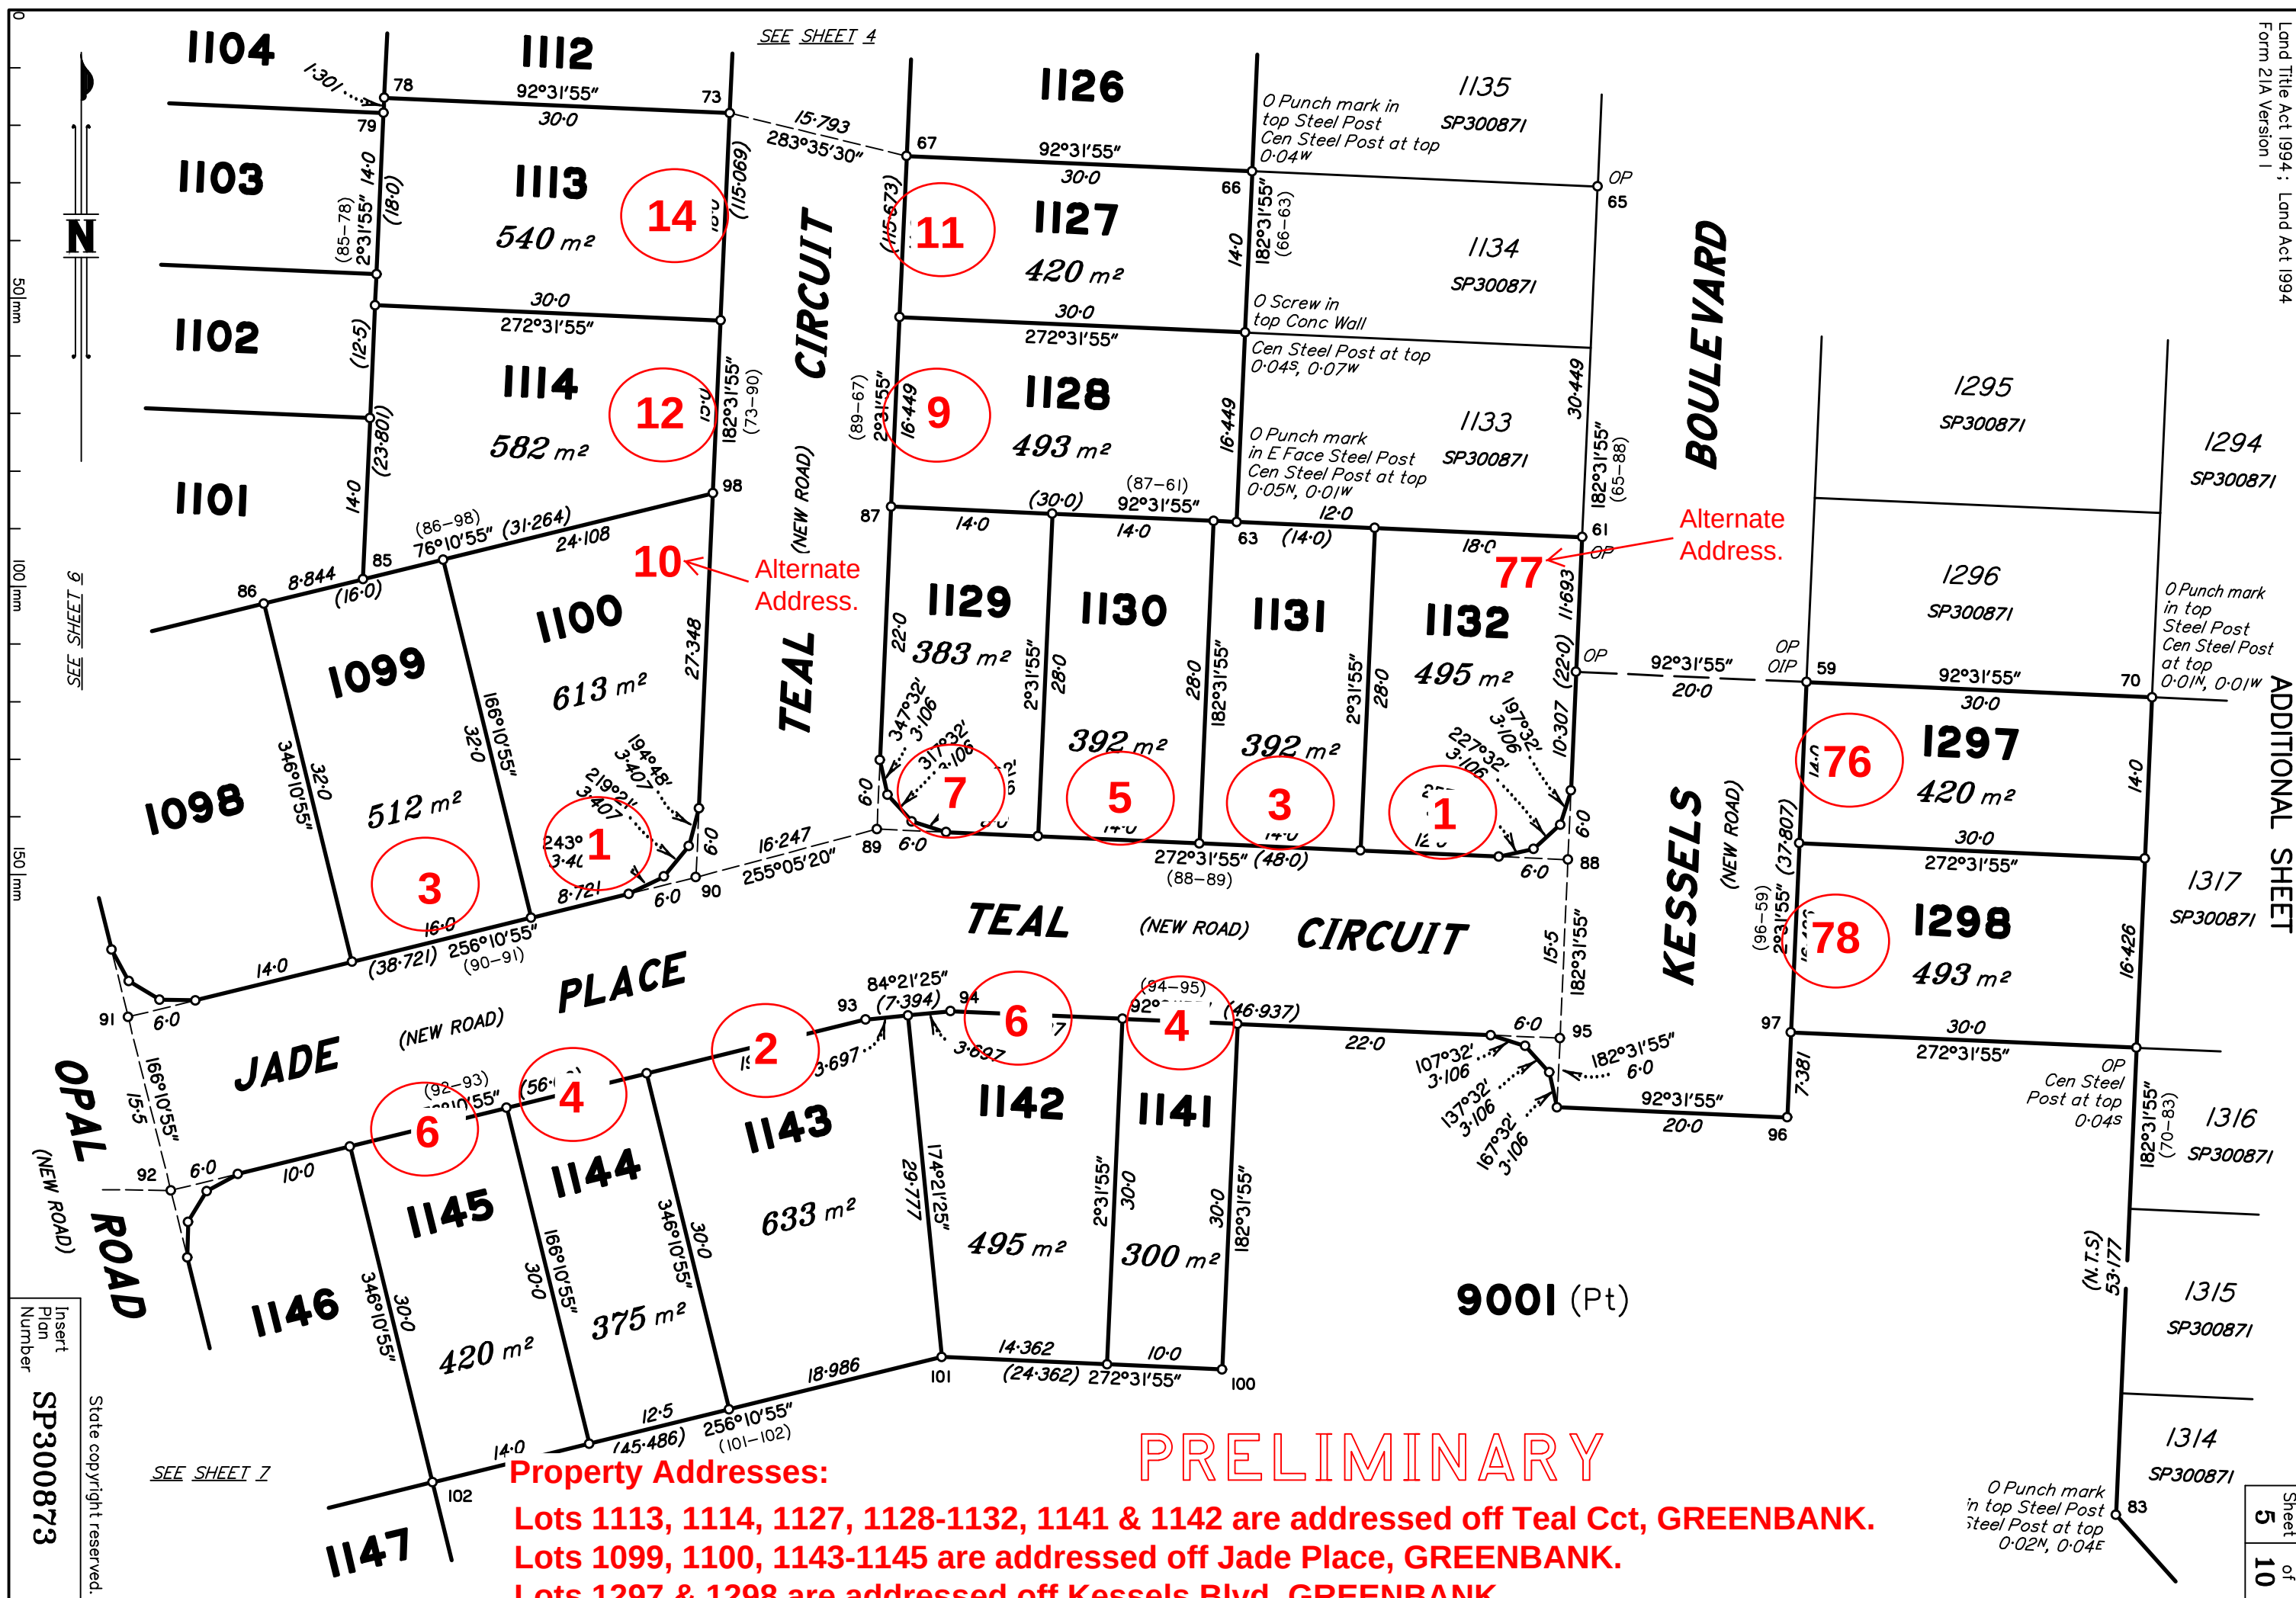

PRELIMINARY

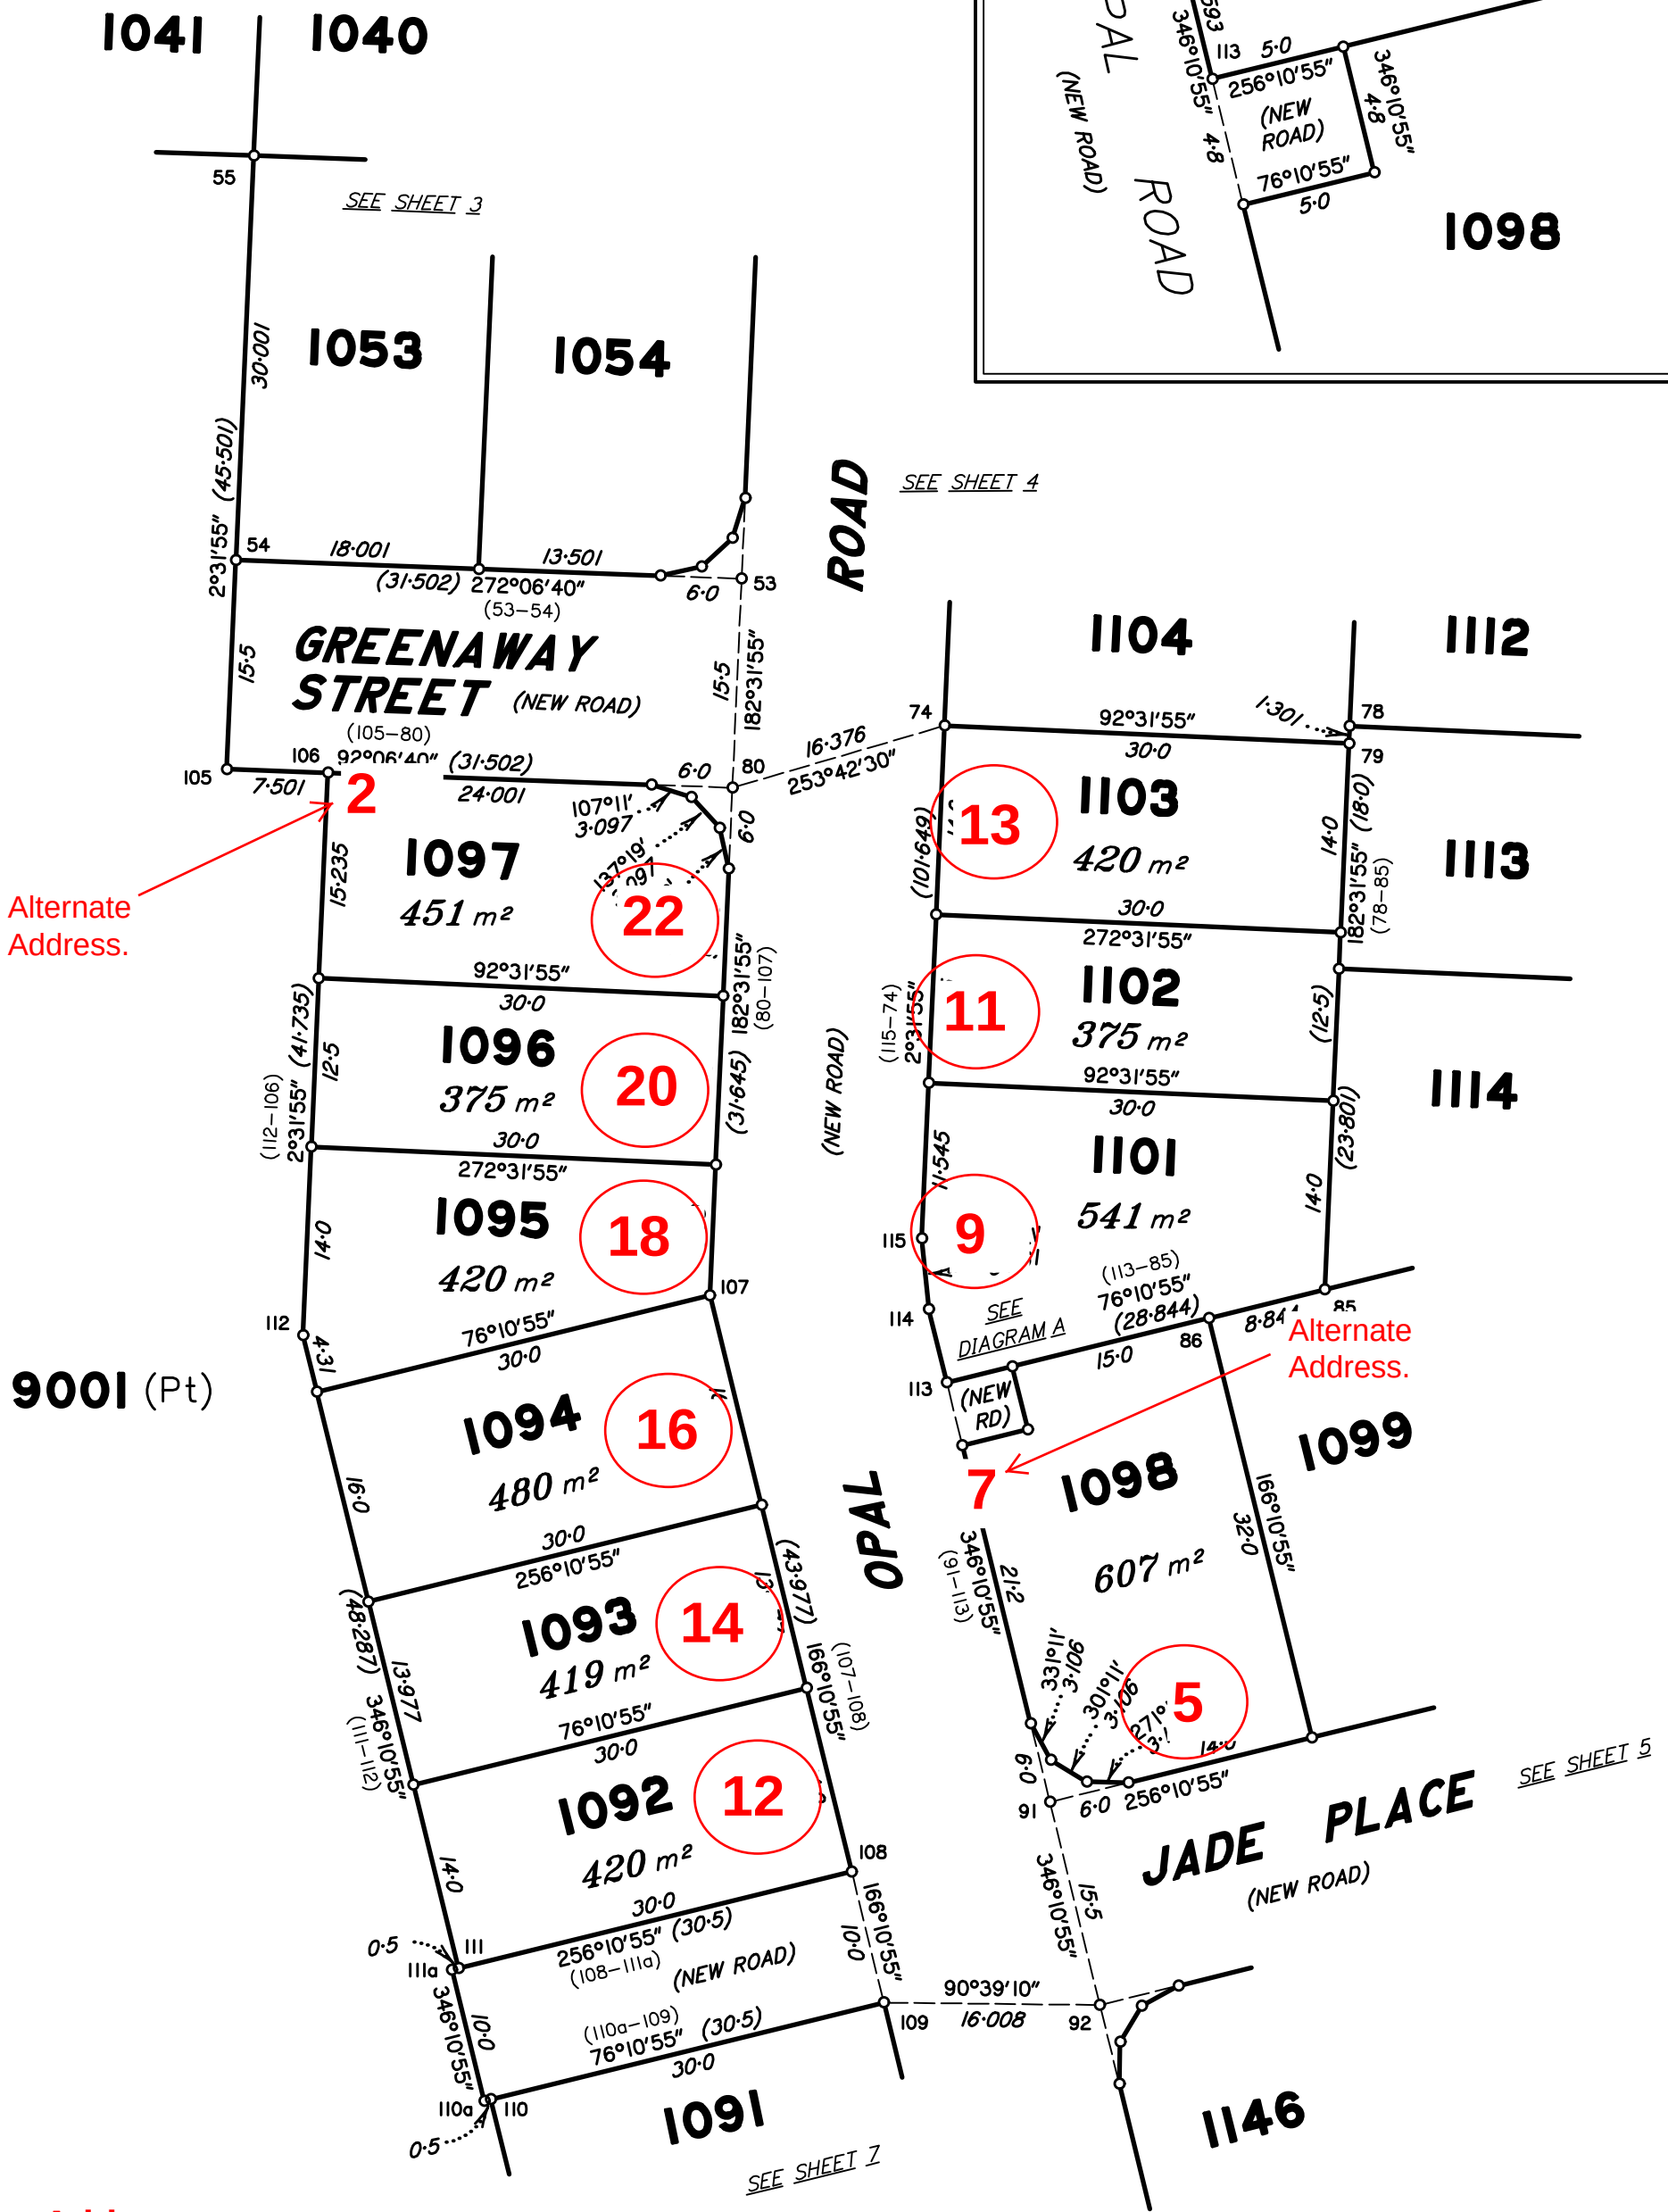


Property Addresses:

Lots 1092-1097, 1101-1103 are addressed off Opal Road, GREENBANK.
Lot 1098 is addressed off Jade Place, GREENBANK.

State copyright reserved.


Insert
Plan
Number
SP300873

PRELIMINARY

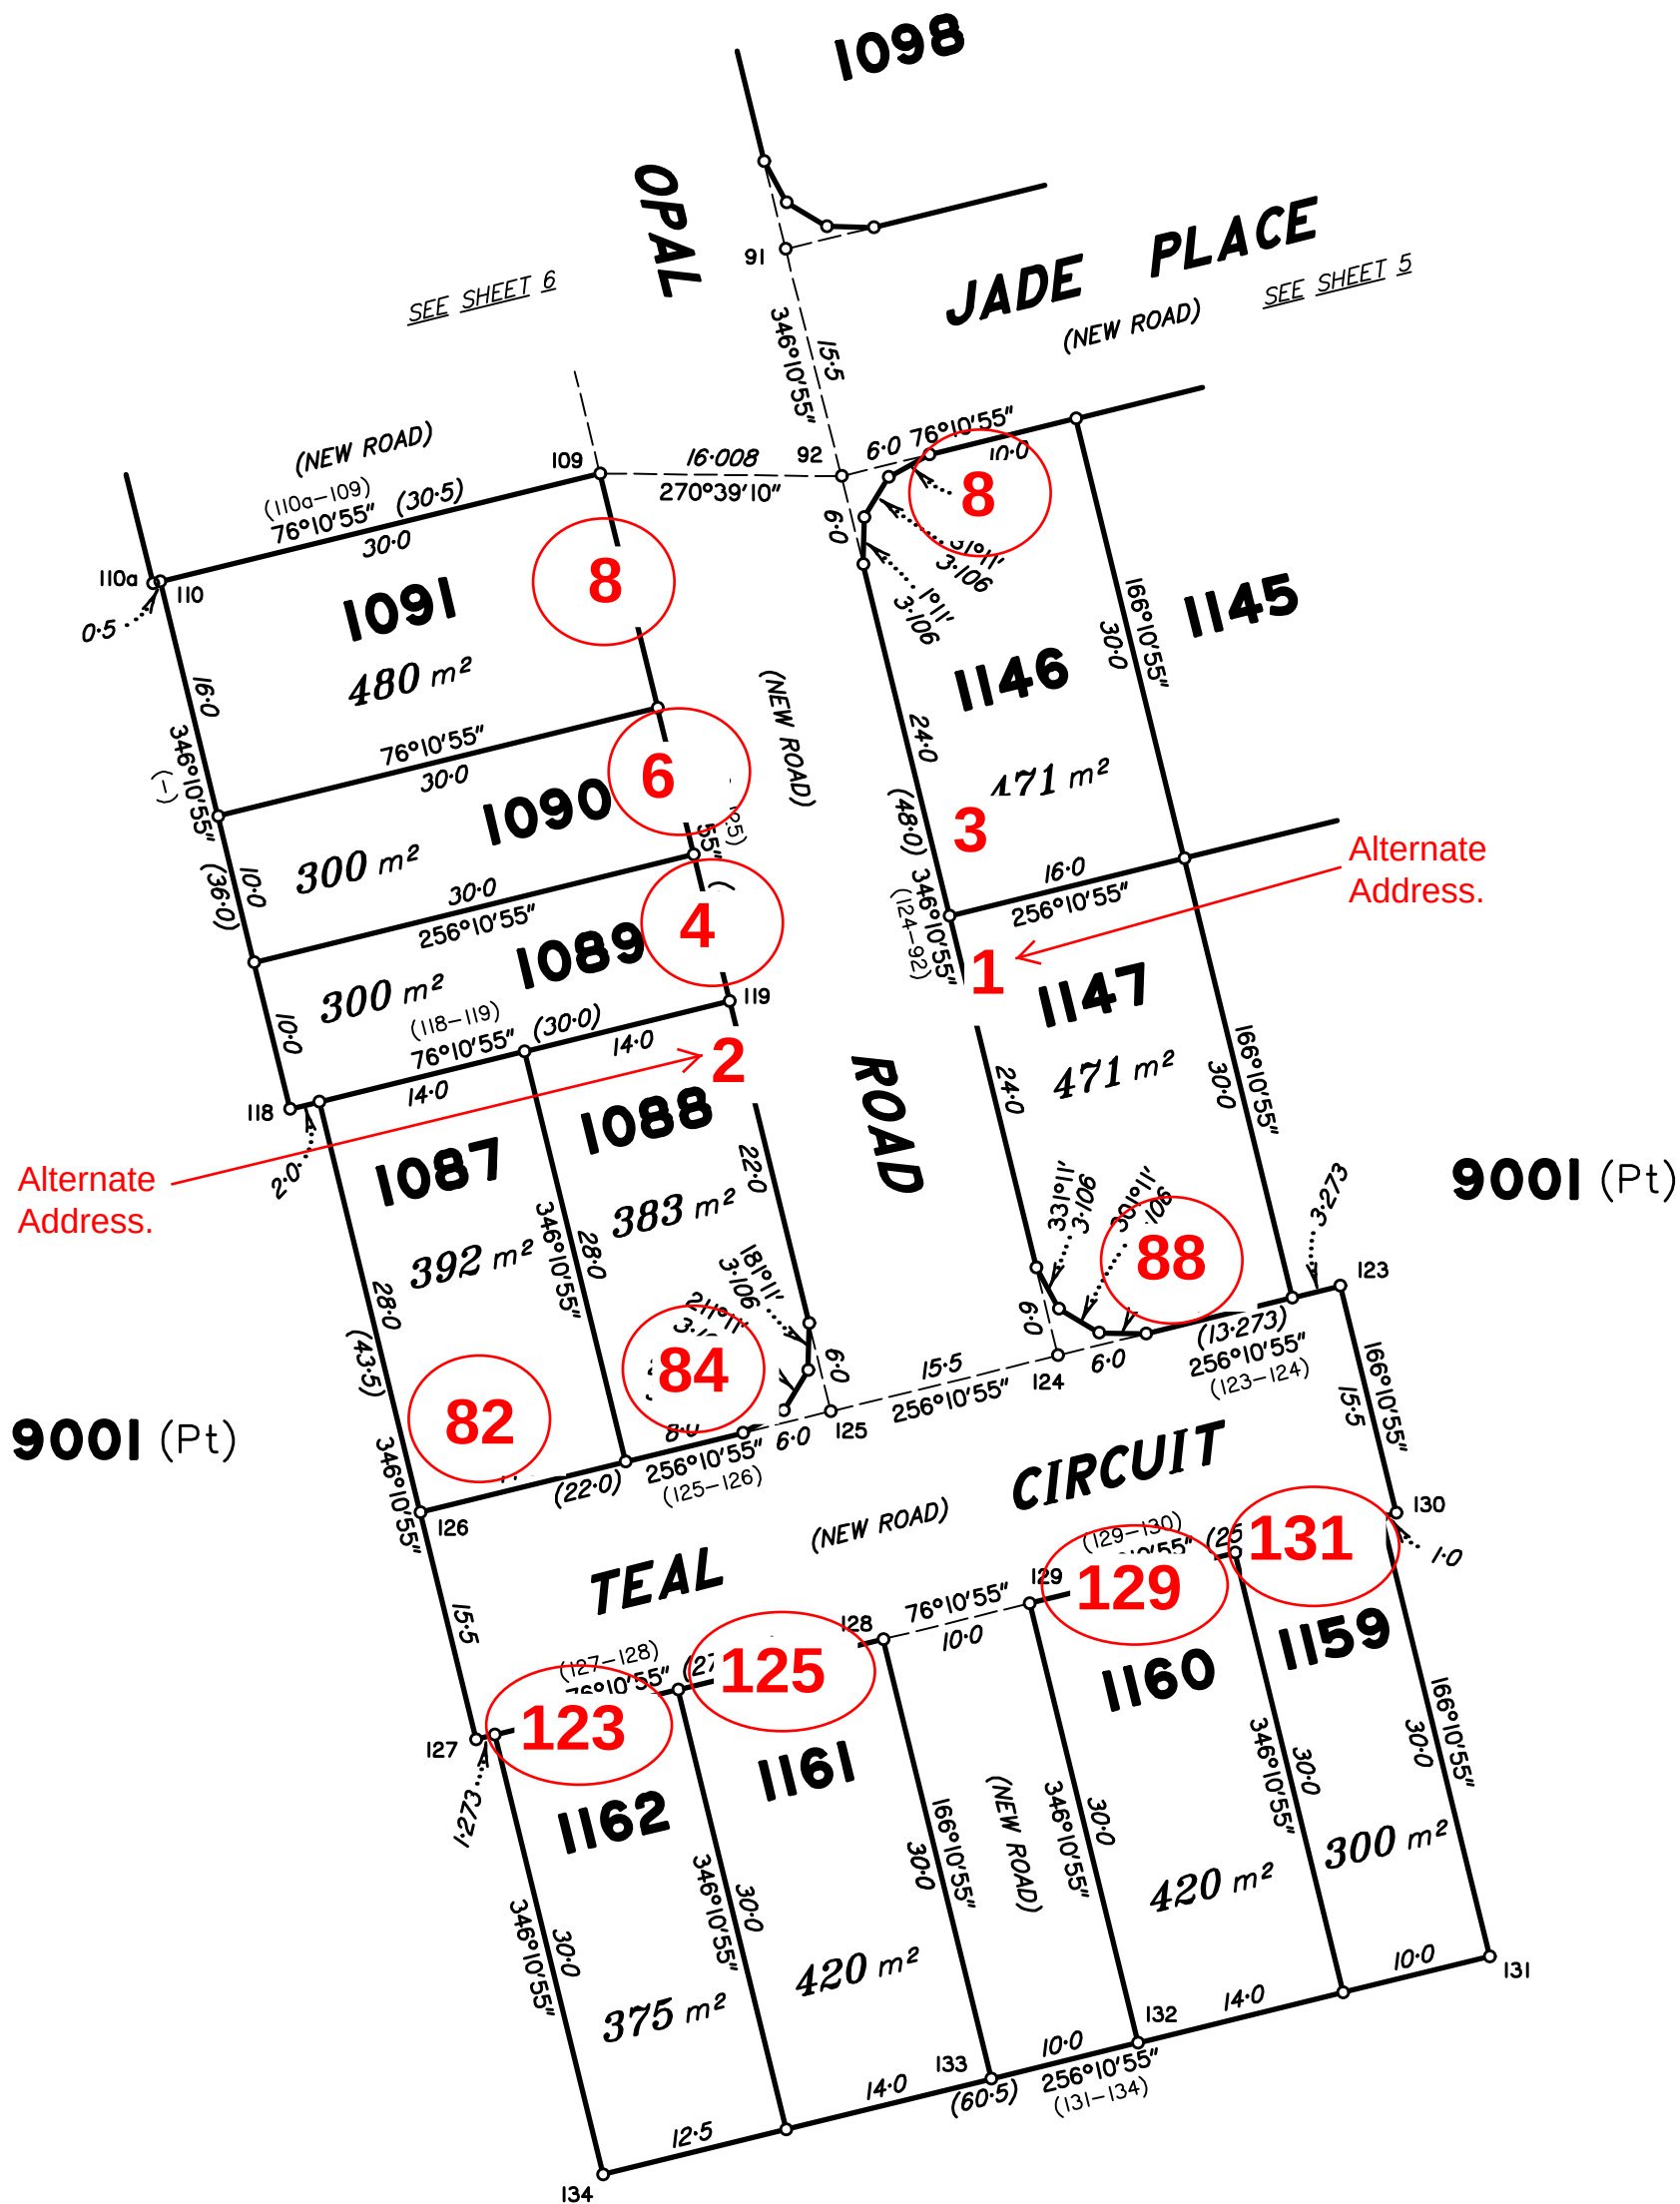


Property Addresses:

Lots 1087, 1088, 1147, 1159-1162 are addressed off Teal Circuit, GREENBANK.
Lot 1146 is addressed off Jade Place, GREENBANK.
Lots 1089-1091 are addressed off Opal Road, GREENBANK.

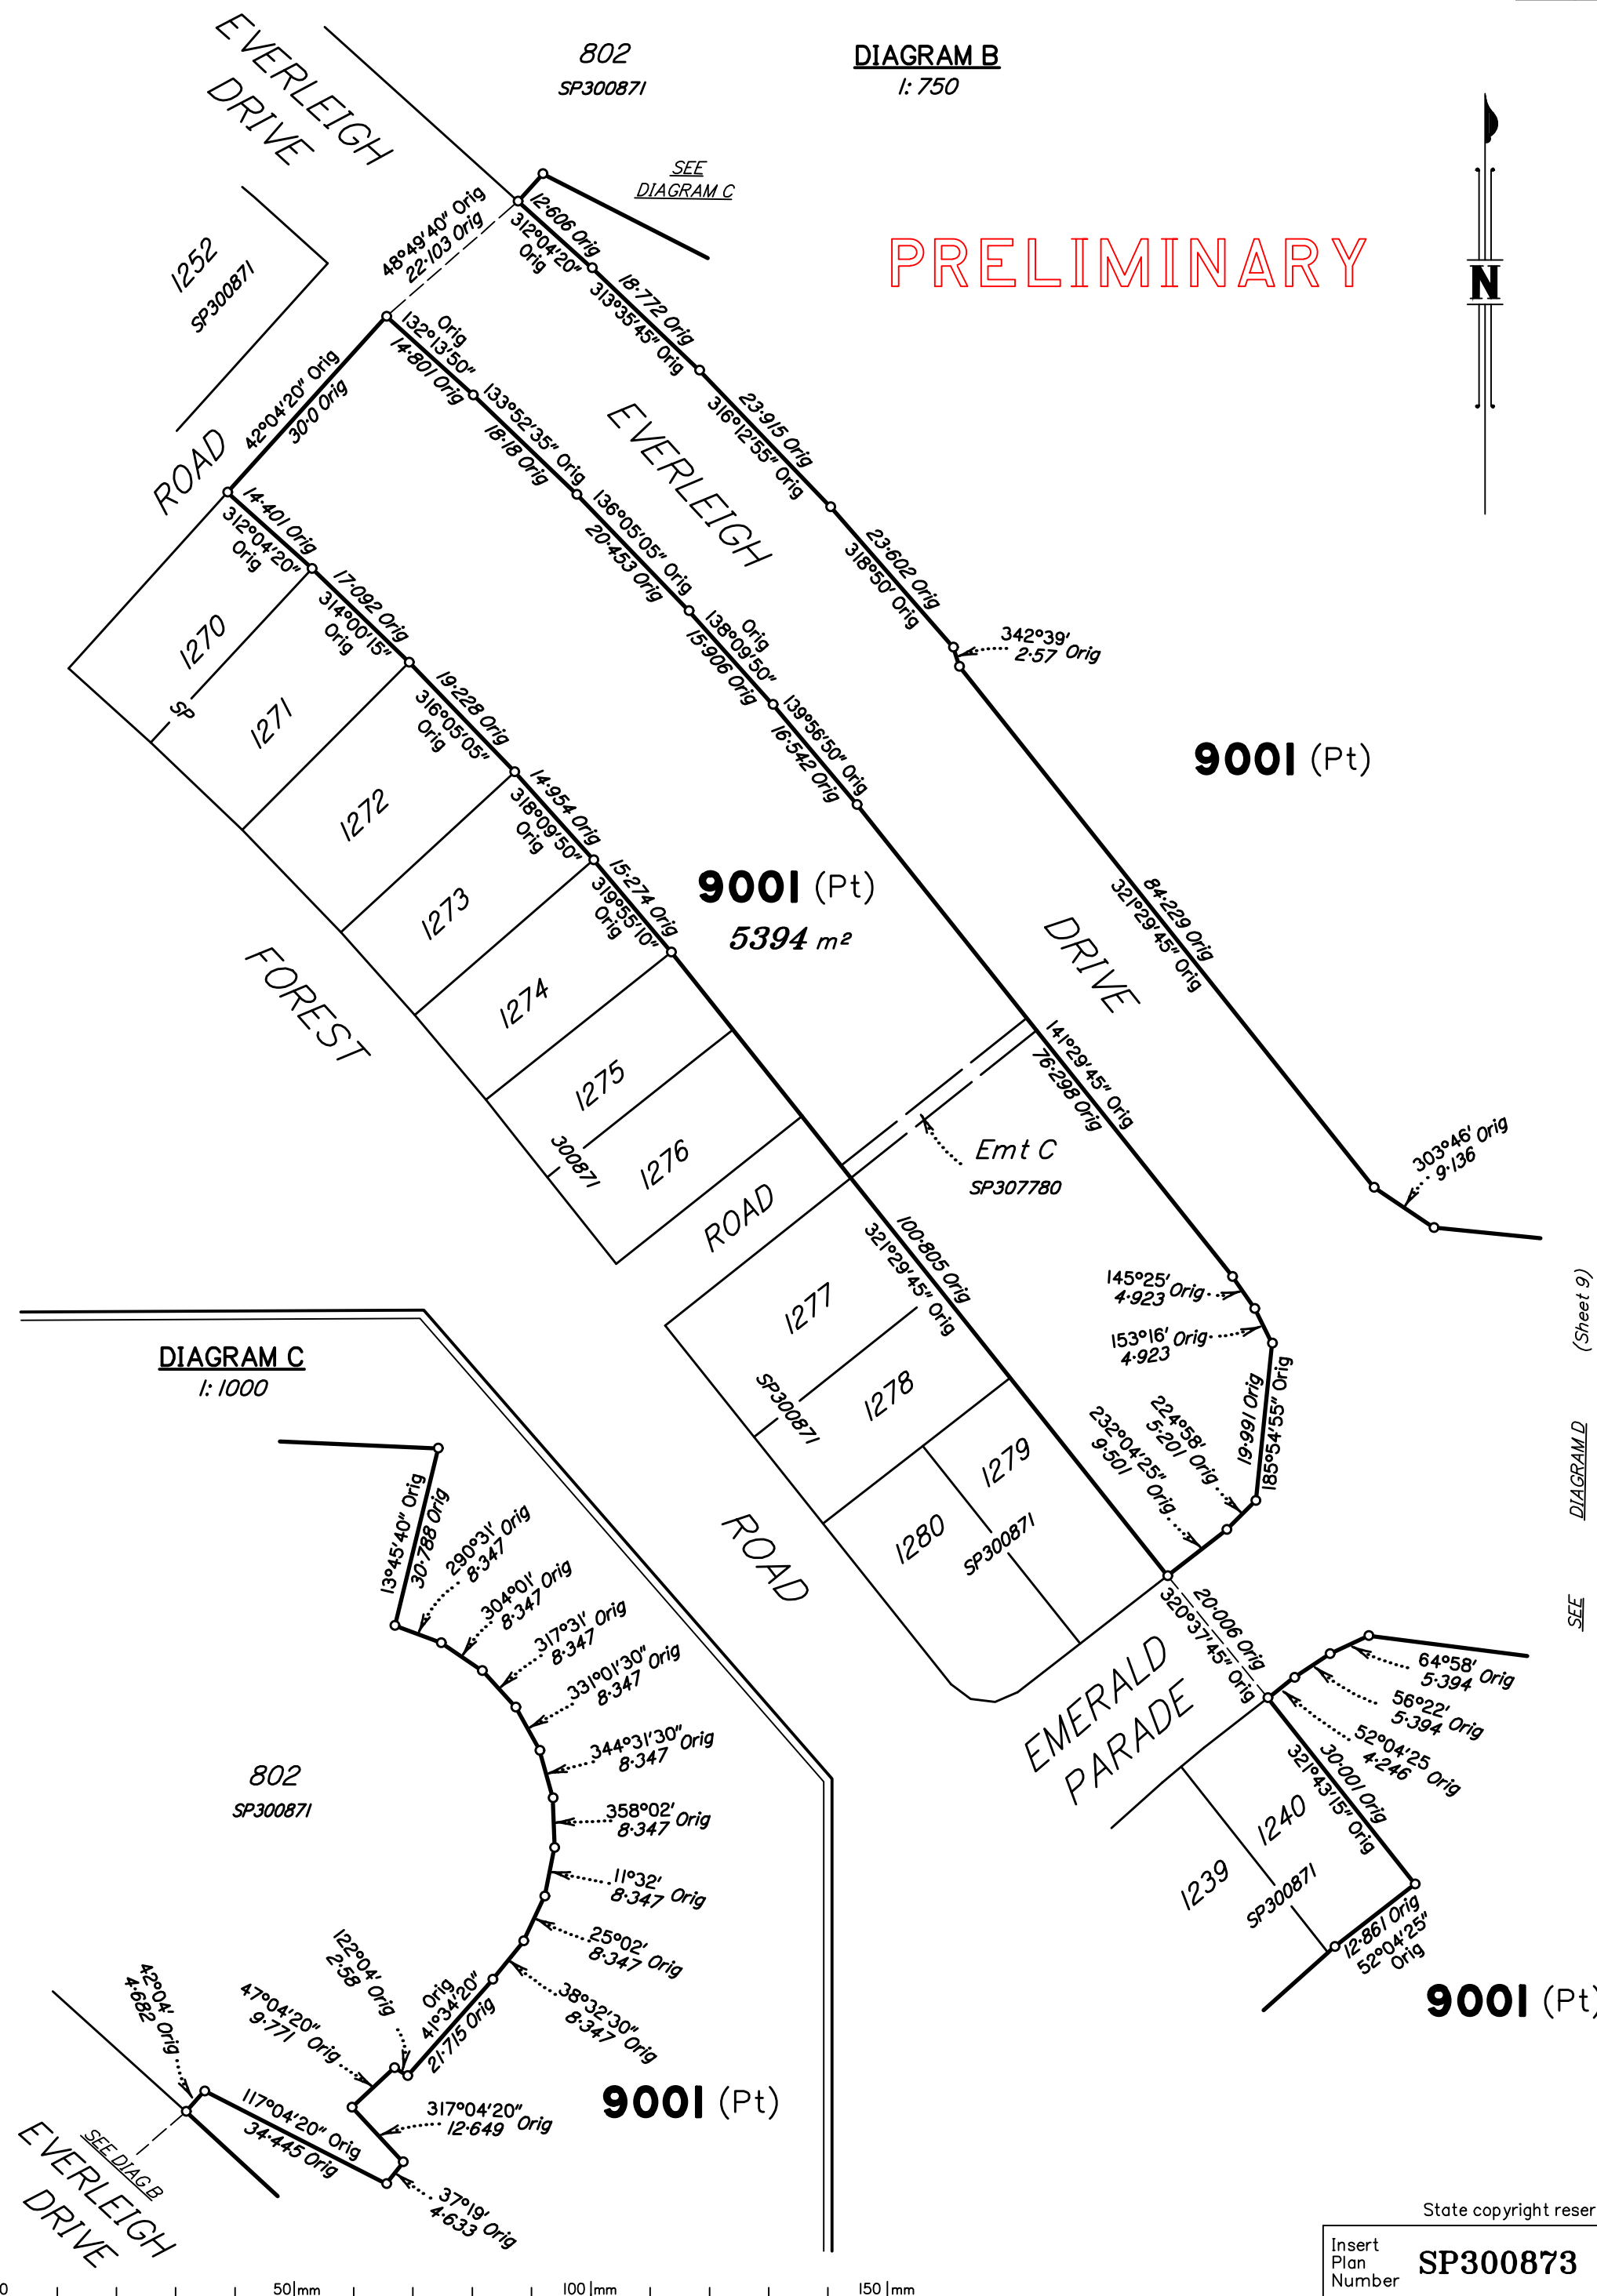



Scale 1:750 – Lengths are in Metres.

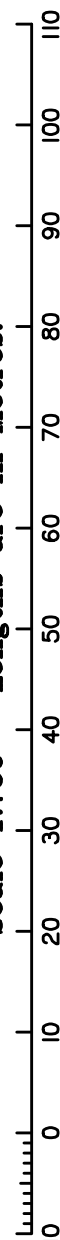

State copyright reserved.

Insert
Plan
Number

SP300873

DIAGRAM D

1:750

9001 (Pt)

PARKWAY

IVORY

9001 (Pt)

775

DIAGRAM B

(Sheet 8)

PRELIMINARY

STATION	EASTING	NORTHING	ZONE	P.U.	LINEAGE	METHOD	REMARKS
PM203517 PM203673							

LINE	PLAN BEARING	MGA ZONE 56 BEARING
PM203517-PM203673		

<i>PM</i>	<i>ORIGIN</i>	<i>BEARING</i>	<i>DIST</i>	<i>NO</i>	<i>TYPE</i>

<i>STN</i>	<i>TO</i>	<i>ORIGIN</i>	<i>BEARING</i>	<i>DIST</i>