

**CIVIL TREATMENT OF LOTS IN CUT**

This warranty applies to residential allotments prepared by Shadforth Civil Contractors ("Shadforth") and included on Plan Number 121 within Mirvac's Everleigh master planned community at Greenbank Queensland.

Shadforth, at the direction of Mirvac, has carried out works to mitigate residential dwelling construction excavation risk in response to the potential presence of rock within Everleigh.

Shadforth warrant that material to a depth of 500mm below the as-constructed finished surface level has been managed to provide for future excavation with machinery typical of residential detached dwelling construction.

**LEGEND**

**REMOVE & REPLACE ORANGE**  
**STAGE BOUNDARY RED**

ISSUE DATE	AUTHOR	COMMENTS	DRAWING TITLE	ASSOCIATE CONSULTANT	DATUM	N/A
			<b>LOT TREATMENT FOR LOTS IN CUT</b>	-	LEVEL ORIGIN	N/A
			CLIENT	LOCAL GOVERNMENT	CONTOUR INTERVAL	N/A
			PROJECT	MIRVAC	DRAWN	MW
				EVERLEIGH PRECINCT 1.3	CHECKED	21/08/19
					SHEET N°	1
					PLAN NUMBER	<b>121</b>
					REVISION	-




99 Sandalwood Lane, Forest Glen QLD 4556  
P: 07 5438 3300 ▶ F: 07 5438 3388 ▶ E: admin@shadcivil.com.au

**CIVIL TREATMENT OF LOTS IN CUT**

This warranty applies to residential allotments prepared by Shadforth Civil Contractors ("Shadforth") and included on Plan Number 120 within Mirvac's Everleigh master planned community at Greenbank Queensland.

Shadforth, at the direction of Mirvac, has carried out works to mitigate residential dwelling construction excavation risk in response to the potential presence of rock within Everleigh.

Shadforth warrant that material to a depth of 500mm below the as-constructed finished surface level has been managed to provide for future excavation with machinery typical of residential detached dwelling construction.

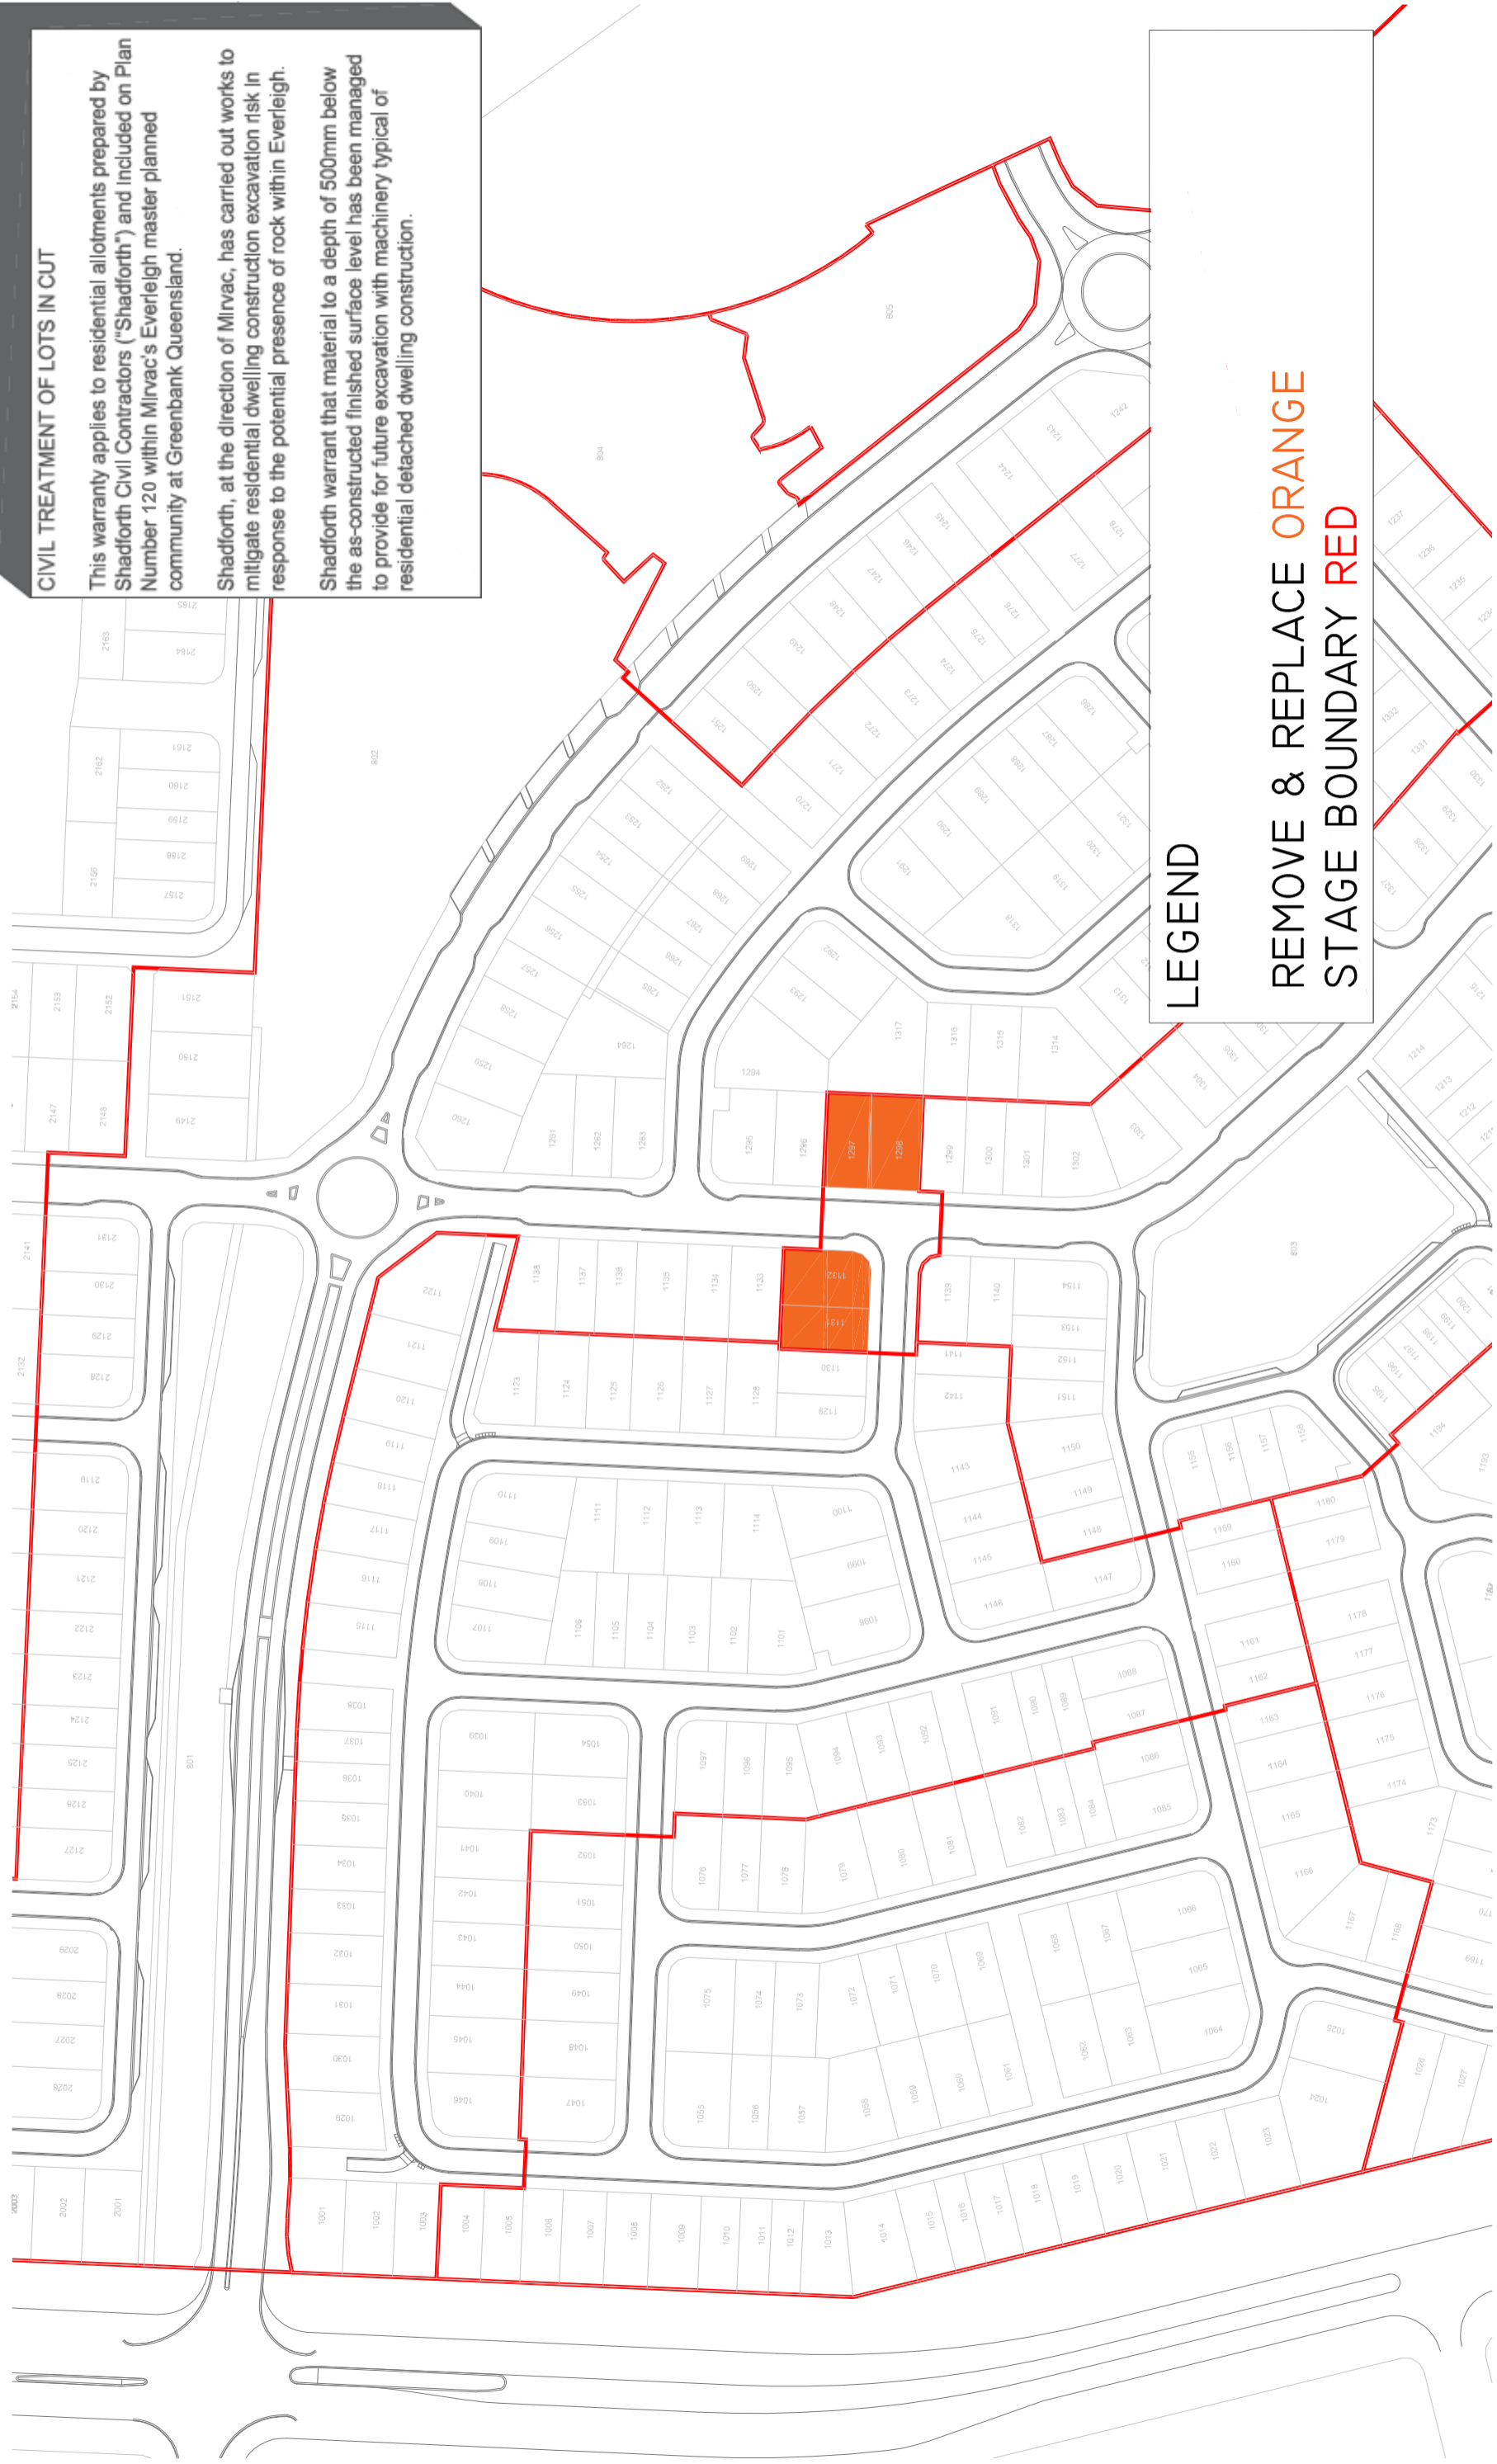

**LEGEND**

REMOVE & REPLACE ORANGE  
STAGE BOUNDARY RED

ISSUE DATE	AUTHOR	COMMENTS	DRAWING TITLE	ASSOCIATE CONSULTANT	DATUM	N/A
			LOT TREATMENT FOR LOTS IN CUT	-	LEVEL ORIGIN	N/A
			CLIENT	LOCAL GOVERNMENT	CONTOUR INTERVAL	N/A
			MIRVAC	-	DRAWN	MW DATE
			PROJECT	EVERLEIGH PRECINCT 1.2a	CHECKED	21/08/19 DATE
					SHEET N°	1
					PLAN NUMBER	120
					REVISION	



99 Sandalwood Lane, Forest Glen QLD 4556  
P: 07 5438 3300 ▶ F: 07 5438 3388 ▶ E: admin@shadcivil.com.au