

| PAVEMENT DESIGN        |                        |                        |                        |
|------------------------|------------------------|------------------------|------------------------|
| <b>TEAL CIRCUIT</b>    | <b>GREENWAY STREET</b> | <b>VERIDIAN ROAD</b>   | <b>EDGE LANE</b>       |
| A(1mm) - 35            | A(1mm) - 35            | A(1mm) - 35            | A(1mm) - 35            |
| BASE(2.1)(mm) - 150    | BASE(2.1)(mm) - 150    | BASE(2.1)(mm) - 150    | BASE(2.1)(mm) - 150    |
| SUBBASE(2.3)(mm) - 150 | SUBBASE(2.3)(mm) - 150 | SUBBASE(2.3)(mm) - 150 | SUBBASE(2.3)(mm) - 150 |

**COORDINATE DATUM NOTE:**  
 HORIZONTAL COORDINATES(E,N) SUPPLIED ARE MAPPING GRID OF AUSTRALIA(MGA), ZONE 56 BASED ON THE UNIVERSAL TRANSVERSE MERCATOR PROJECTION AND THE GEOCENTRIC DATUM OF AUSTRALIA 1994. HORIZONTAL DATUM DERIVED FROM PSM 61308 E 4.98528.114 N 6931171.033. LEVELS SUPPLIED ARE ON THE AUSTRALIAN HEIGHT DATUM(AHD) LEVEL DATUM DERIVED FROM PSM 61308 RL54.660 (AHD)

**ENGINEER'S CERTIFICATION**  
 I, \_\_\_\_\_ hereby certify that:  
 1. The information contained in this drawing / document is in compliance with approved drawings and design.  
 2. This represents an accurate record of as-constructed works  
 3. I accept responsibility for the information contained in this drawing / document.  
 RPEQ (signature) RPEQ No. \_\_\_\_\_ Date: \_\_\_\_\_

**REGISTERED SURVEYOR'S CERTIFICATION**  
 I, Gordon Nicholson, hereby certify that the vertical and horizontal locations and dimensions shown on this plan are a true and correct record and were located by survey.  
 Registered Surveyor (sig.) Reg. Surveyor No. SA 3405 Date: 24/06/2020

A1

| INDEX | DATE       | REVISIONS      |
|-------|------------|----------------|
| A     | 24/06/2020 | AS CONSTRUCTED |

| DRAWN | CHECKED | PASSED | INITIALS | DATE       |
|-------|---------|--------|----------|------------|
| DAM   | -       | LS     |          | 24/06/2020 |
| DAM   | -       | LS     |          | 24/06/2020 |



**LOGAN CITY COUNCIL**  
 MIRVAC MIR001-04  
 AS CONSTRUCTED SURVEY - ROADS AND EARTHWORKS  
 EVERLEIGH PRECINCT 14  
 GREENBANK QLD

| SHEET 1 OF 4 SHEETS              | SCALE 1:500 A1 |
|----------------------------------|----------------|
| REVISION DATE 24/06/2020         | REVISION A     |
| DISCIPLINE CODE -                |                |
| DRAWING NO. ASC-RDS AND EW-01-14 |                |




**COORDINATE DATUM NOTE:**  
 HORIZONTAL COORDINATES(E,N) SUPPLIED ARE MAPPING GRID OF AUSTRALIA(MGA), ZONE 56 BASED ON THE UNIVERSAL TRANSVERSE MERCATOR PROJECTION AND THE GEOCENTRIC DATUM OF AUSTRALIA 1994.  
 HORIZONTAL DATUM DERIVED FROM PSM 61308 E 498528.114 N 6931171.033.  
 LEVELS SUPPLIED ARE ON THE AUSTRALIAN HEIGHT DATUM(AHD)  
 LEVEL DATUM DERIVED FROM PSM 61308 RL54.660 (AHD)

| PAVEMENT DESIGN        |                        |                        |
|------------------------|------------------------|------------------------|
| <b>VERIDIAN ROAD</b>   | <b>EDGE LANE</b>       | <b>RETAINING WALLS</b> |
| AC(mm)- 35             | AC(mm)- 35             | ---                    |
| BASE(2.1)(mm) - 150    | BASE(2.1)(mm) - 150    | ---                    |
| SUBBASE(2.3)(mm) - 150 | SUBBASE(2.3)(mm) - 150 | ---                    |
| <b>TEAL CIRCUIT</b>    | <b>GREENWAY STREET</b> |                        |
| AC(mm)- 35             | AC(mm)- 35             |                        |
| BASE(2.1)(mm) - 150    | BASE(2.1)(mm) - 150    |                        |
| SUBBASE(2.3)(mm) - 150 | SUBBASE(2.3)(mm) - 150 |                        |

**REGISTERED SURVEYOR'S CERTIFICATION**  
 I, Gordon Nicholson, hereby certify that the vertical and horizontal locations and dimensions shown on this plan are a true and correct record and were located by survey.  
 Registered Surveyor (Sig.) Reg. Surveyor No. SA 3405 Date: 24/06/2020

**ENGINEER'S CERTIFICATION**  
 I, \_\_\_\_\_, hereby certify that:  
 1. The information contained in this drawing / document is in compliance with approved drawings and design.  
 2. This represents an accurate record of as-constructed works  
 3. I accept responsibility for the information contained in this drawing / document.  
 RPEQ (signature) RPEQ No. \_\_\_\_\_ Date: \_\_\_\_\_

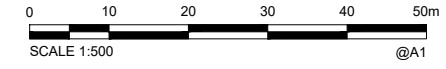

**AS CONSTRUCTED**

|           |       |            |                |       |         |        |
|-----------|-------|------------|----------------|-------|---------|--------|
| <b>A1</b> | INDEX | DATE       | REVISIONS      | DRAWN | CHECKED | PASSED |
|           | A     | 24/06/2020 | AS CONSTRUCTED | DAM   | -       | LS     |



|          |     |            |
|----------|-----|------------|
| DRAWN    | DAM | 24/06/2020 |
| CHECKED  | -   | 24/06/2020 |
| PASSED   | LS  | 24/06/2020 |
| INITIALS |     | DATE       |



**LOGAN CITY COUNCIL**  
 MIRVAC MIR001-04  
 AS CONSTRUCTED SURVEY - STORMWATER  
 EVERLEIGH PRECINCT 14  
 GREENBANK QLD

|                             |                |
|-----------------------------|----------------|
| SHEET 3 OF 4 SHEETS         | SCALE 1:250 A1 |
| REVISION DATE 24/06/2020    | REVISION A     |
| DISCIPLINE CODE -           |                |
| DRAWING NO.                 |                |
| <b>ASC-RDS AND EW-03-14</b> |                |



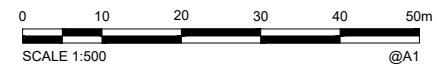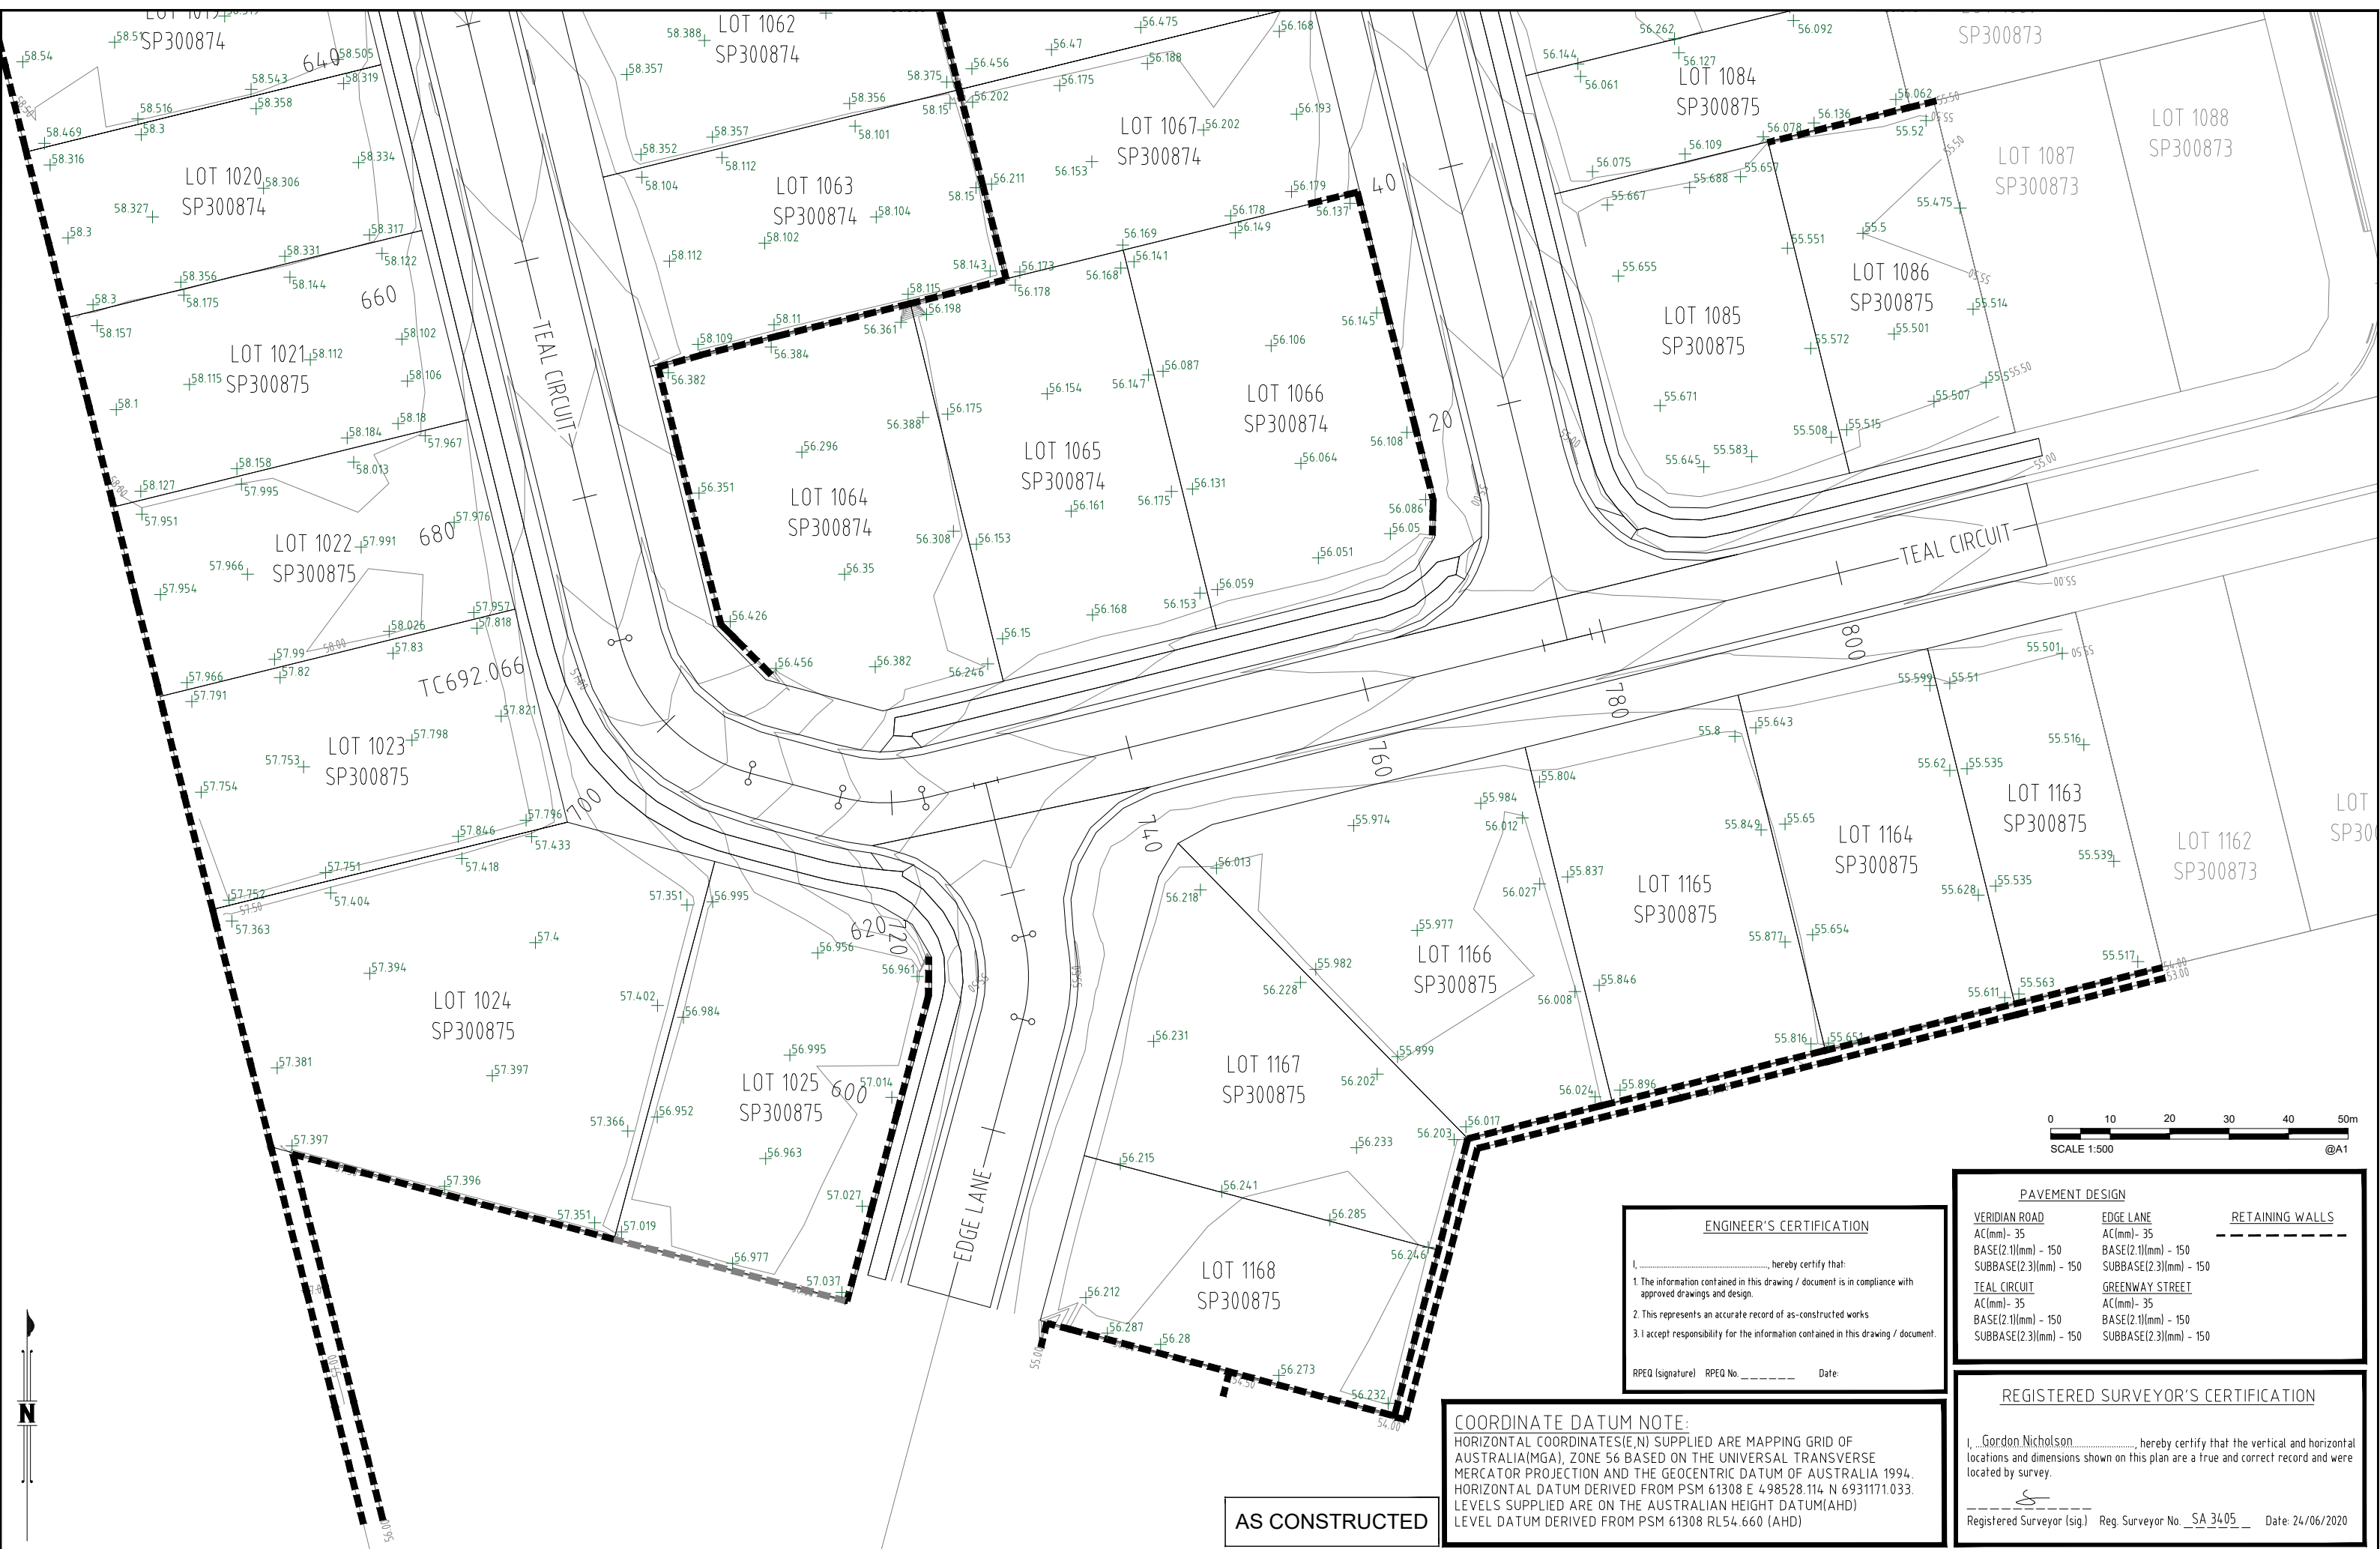

**ENGINEER'S CERTIFICATION**

I, \_\_\_\_\_, hereby certify that:

- The information contained in this drawing / document is in compliance with approved drawings and design.
- This represents an accurate record of as-constructed works
- I accept responsibility for the information contained in this drawing / document.

RPEQ (Signature) RPEQ No. \_\_\_\_\_ Date: \_\_\_\_\_

| PAVEMENT DESIGN        |                        |                        |
|------------------------|------------------------|------------------------|
| <b>VERIDIAN ROAD</b>   | <b>EDGE LANE</b>       | <b>RETAINING WALLS</b> |
| AC(mm)- 35             | AC(mm)- 35             | -----                  |
| BASE(2.1)(mm) - 150    | BASE(2.1)(mm) - 150    |                        |
| SUBBASE(2.3)(mm) - 150 | SUBBASE(2.3)(mm) - 150 |                        |
| <b>TEAL CIRCUIT</b>    | <b>GREENWAY STREET</b> |                        |
| AC(mm)- 35             | AC(mm)- 35             |                        |
| BASE(2.1)(mm) - 150    | BASE(2.1)(mm) - 150    |                        |
| SUBBASE(2.3)(mm) - 150 | SUBBASE(2.3)(mm) - 150 |                        |

**COORDINATE DATUM NOTE:**  
 HORIZONTAL COORDINATES(E,N) SUPPLIED ARE MAPPING GRID OF AUSTRALIA(MGA), ZONE 56 BASED ON THE UNIVERSAL TRANSVERSE MERCATOR PROJECTION AND THE GEOCENTRIC DATUM OF AUSTRALIA 1994. HORIZONTAL DATUM DERIVED FROM PSM 61308 E 4 98528.114 N 6931171.033. LEVELS SUPPLIED ARE ON THE AUSTRALIAN HEIGHT DATUM(AHD) LEVEL DATUM DERIVED FROM PSM 61308 RL54.660 (AHD)

**REGISTERED SURVEYOR'S CERTIFICATION**

I, Gordon Nicholson, hereby certify that the vertical and horizontal locations and dimensions shown on this plan are a true and correct record and were located by survey.

Registered Surveyor (sig.) Reg. Surveyor No. SA 3405 Date: 24/06/2020

**AS CONSTRUCTED**

|           |       |            |                |       |         |        |
|-----------|-------|------------|----------------|-------|---------|--------|
| <b>A1</b> | INDEX | DATE       | REVISIONS      | DRAWN | CHECKED | PASSED |
|           | A     | 24/06/2020 | AS CONSTRUCTED | LB    | DAM     | DB     |

|          |     |            |
|----------|-----|------------|
| DRAWN    | LB  | 24/06/2020 |
| CHECKED  | DAM | 24/06/2020 |
| PASSED   | DB  | 24/06/2020 |
| INITIALS |     | DATE       |



**LOGAN CITY COUNCIL**

MIRVAC MIR001-04  
 AS CONSTRUCTED SURVEY - STORMWATER  
 EVERLEIGH PRECINCT 14  
 GREENBANK QLD

|                              |                |
|------------------------------|----------------|
| SHEET 4 OF 4 SHEETS          | SCALE 1:250 A1 |
| REVISION DATE 24/06/2020     | REVISION A     |
| DISCIPLINE CODE -            |                |
| DRAWING NO.                  |                |
| <b>ASC-RDS AND EW-04-1.4</b> |                |

**COORDINATE DATUM NOTE:**  
 HORIZONTAL COORDINATES(E,N) SUPPLIED ARE MAPPING GRID OF AUSTRALIA(MGA), ZONE 56 BASED ON THE UNIVERSAL TRANSVERSE MERCATOR PROJECTION AND THE GEOCENTRIC DATUM OF AUSTRALIA 1994. HORIZONTAL DATUM DERIVED FROM PSM 61308 E 4 98528.114 N 6931171.033. LEVELS SUPPLIED ARE ON THE AUSTRALIAN HEIGHT DATUM(AHD) LEVEL DATUM DERIVED FROM PSM 61308 RL54.660 (AHD)

| PAVEMENT DESIGN       |                       |                 |
|-----------------------|-----------------------|-----------------|
| VERIDIAN ROAD         | EDGE LANE             | RETAINING WALLS |
| AC(mm)- 35            | AC(mm)- 35            | ---             |
| BASE(2.1lmm) - 150    | BASE(2.1lmm) - 150    |                 |
| SUBBASE(2.3lmm) - 150 | SUBBASE(2.3lmm) - 150 |                 |
| TEAL CIRCUIT          | GREENWAY STREET       |                 |
| AC(mm)- 35            | AC(mm)- 35            |                 |
| BASE(2.1lmm) - 150    | BASE(2.1lmm) - 150    |                 |
| SUBBASE(2.3lmm) - 150 | SUBBASE(2.3lmm) - 150 |                 |

**REGISTERED SURVEYOR'S CERTIFICATION**

I, Gordon Nicholson, hereby certify that the vertical and horizontal locations and dimensions shown on this plan are a true and correct record and were located by survey.



Registered Surveyor (Sig.) SA 3405 Reg. Surveyor No. SA 3405 Date: 24/06/2020

**ENGINEER'S CERTIFICATION**

I, \_\_\_\_\_, hereby certify that:

- The information contained in this drawing / document is in compliance with approved drawings and design.
- This represents an accurate record of as-constructed works
- I accept responsibility for the information contained in this drawing / document.

RPEQ (Signature) \_\_\_\_\_ RPEQ No. \_\_\_\_\_ Date: \_\_\_\_\_

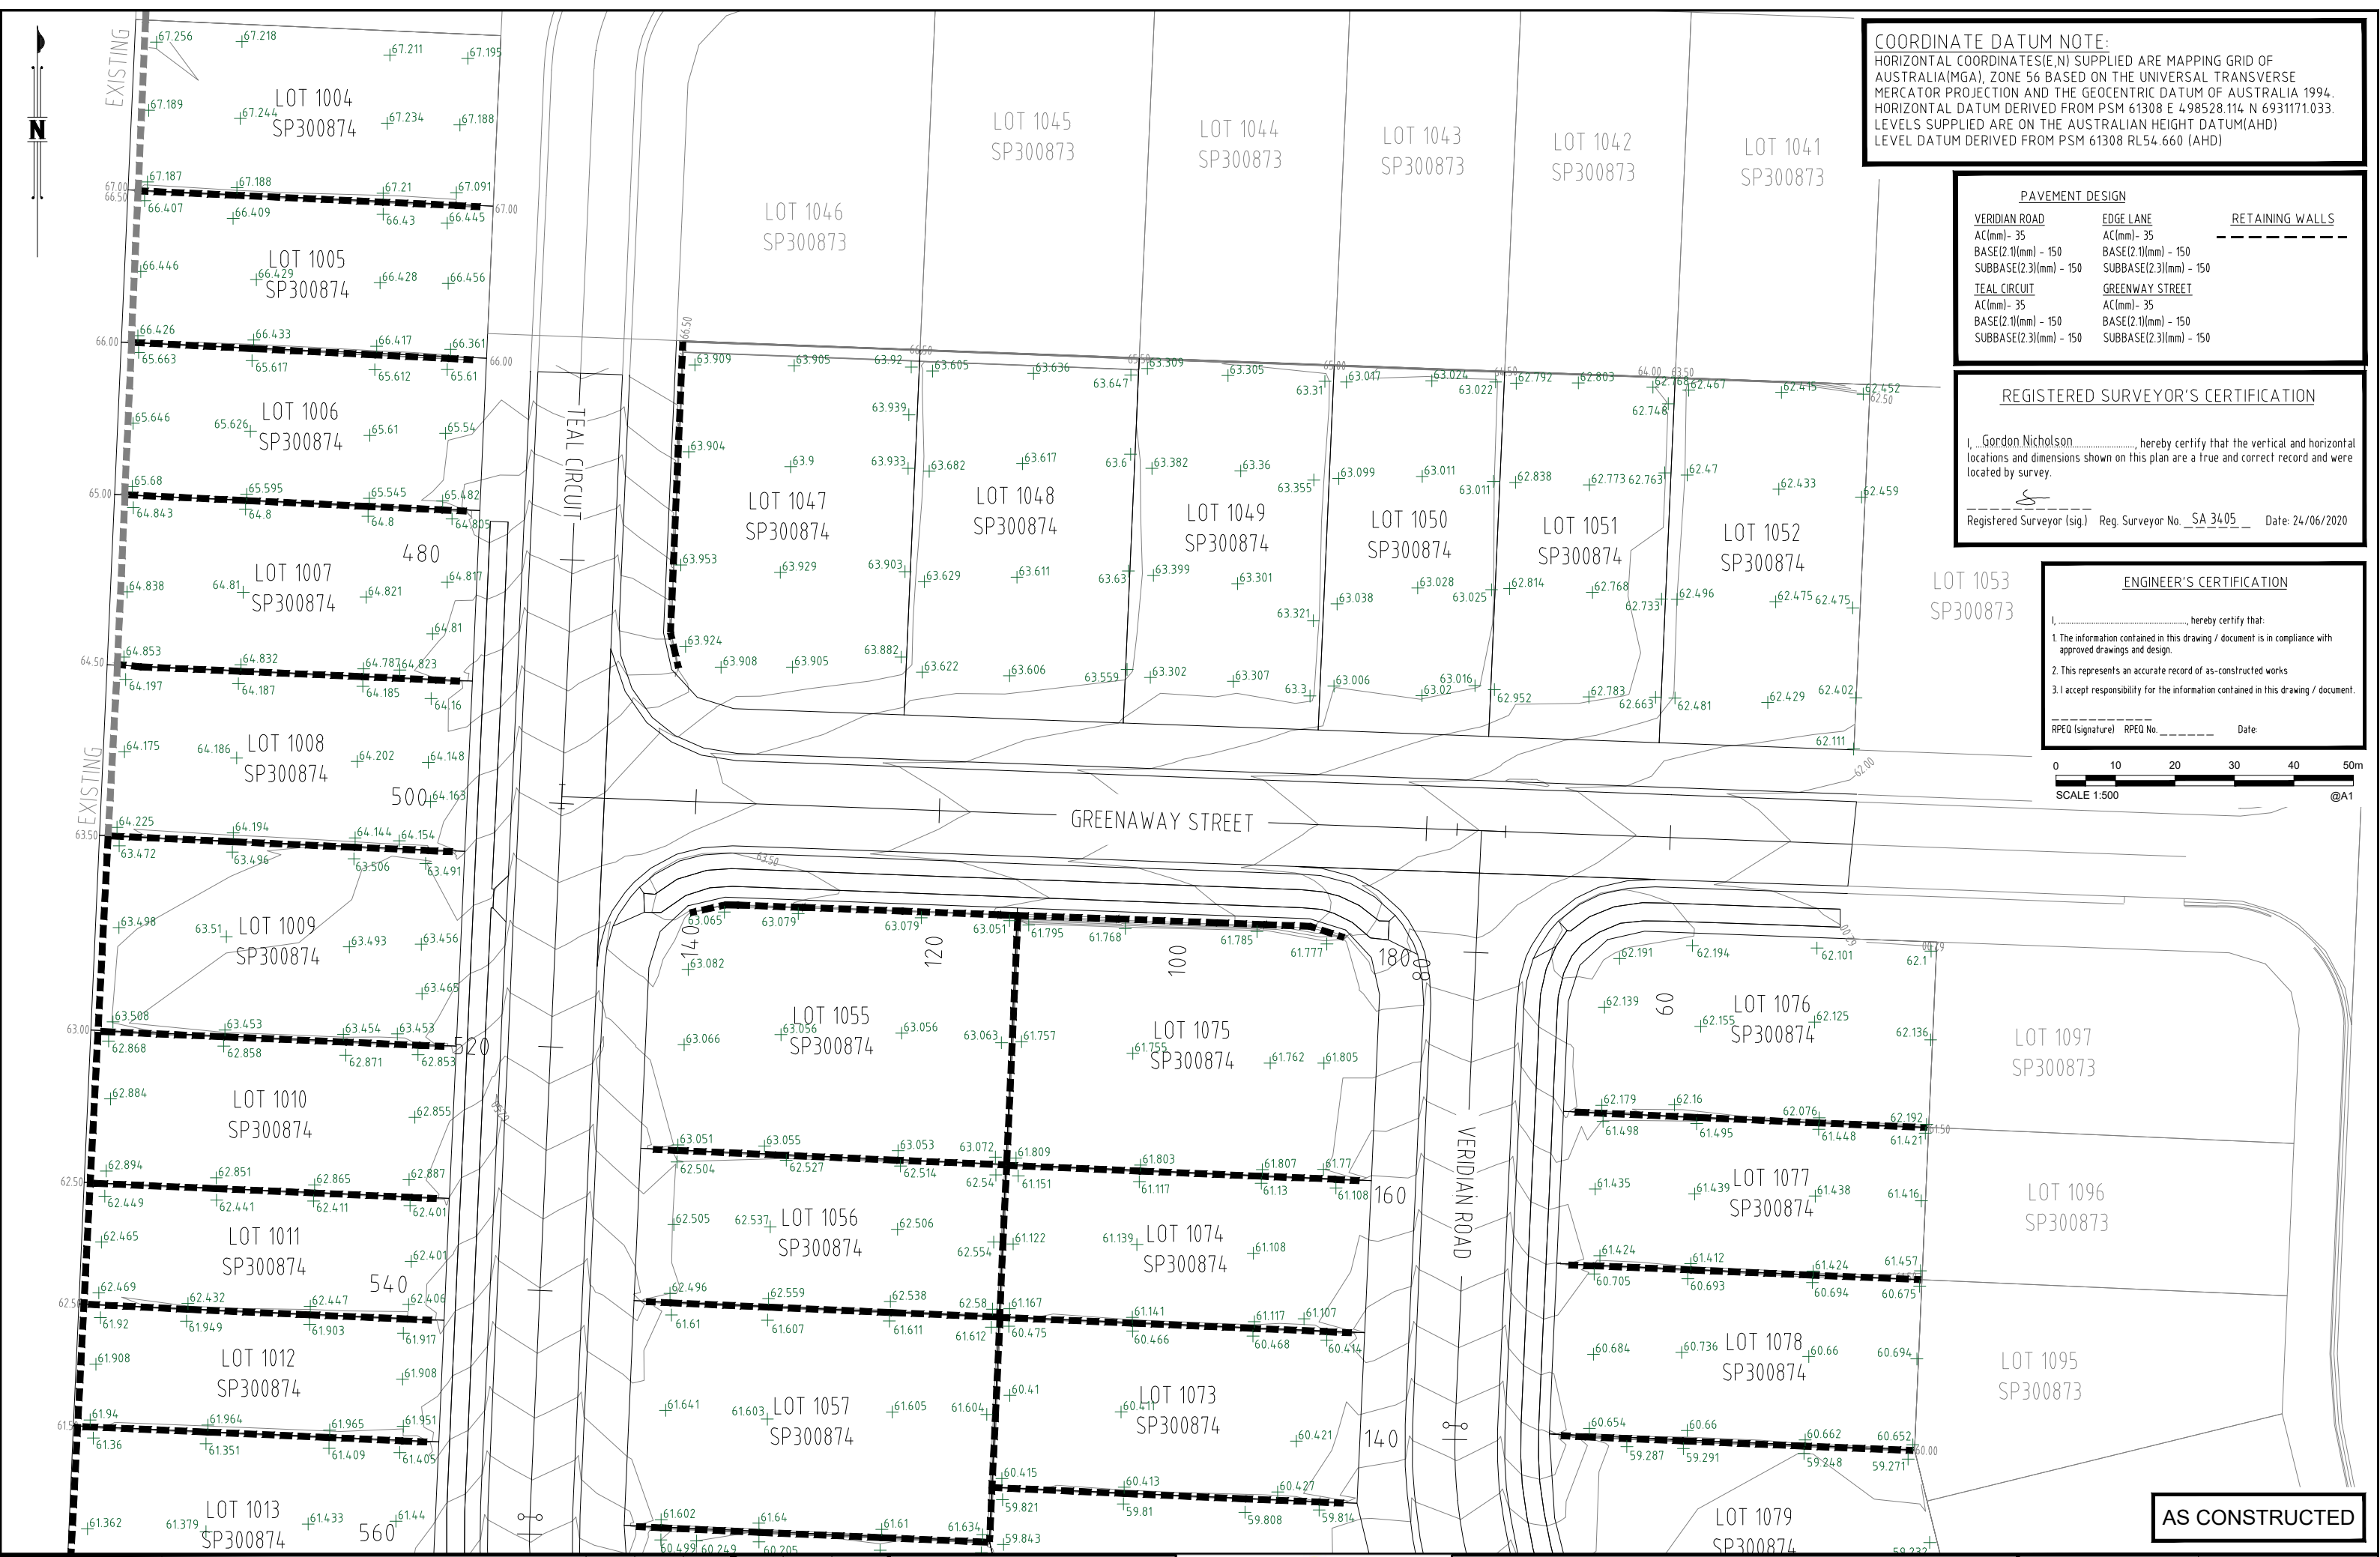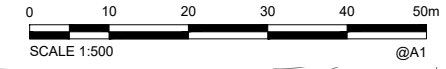

**AS CONSTRUCTED**

|    |       |            |                |       |         |        |
|----|-------|------------|----------------|-------|---------|--------|
| A1 | INDEX | DATE       | REVISIONS      | DRAWN | CHECKED | PASSED |
|    | A     | 24/06/2020 | AS CONSTRUCTED | DAM   | -       | LS     |

|          |     |            |
|----------|-----|------------|
| DRAWN    | DAM | 24/06/2020 |
| CHECKED  | -   | 24/06/2020 |
| PASSED   | LS  | 24/06/2020 |
| INITIALS |     | DATE       |



**LOGAN CITY COUNCIL**

MIRVAC MIR001-04  
 AS CONSTRUCTED SURVEY - STORMWATER  
 EVERLEIGH PRECINCT 14  
 GREENBANK QLD

|                             |                |
|-----------------------------|----------------|
| SHEET 2 OF 4 SHEETS         | SCALE 1:250 A1 |
| REVISION DATE 24/06/2020    | REVISION A     |
| DISCIPLINE CODE -           |                |
| DRAWING NO.                 |                |
| <b>ASC-RDS AND EW-02-14</b> |                |