


**COORDINATE DATUM NOTE:**  
 HORIZONTAL COORDINATES(E,N) SUPPLIED ARE MAPPING GRID OF AUSTRALIA(MGA), ZONE 56 BASED ON THE UNIVERSAL TRANSVERSE MERCATOR PROJECTION AND THE GEOCENTRIC DATUM OF AUSTRALIA 1994.  
 HORIZONTAL DATUM DERIVED FROM PSM 61308 E 4.98528.114 N 6931171.033.  
 LEVELS SUPPLIED ARE ON THE AUSTRALIAN HEIGHT DATUM(AHD)  
 LEVEL DATUM DERIVED FROM PSM 61308 RL54.660 (AHD)

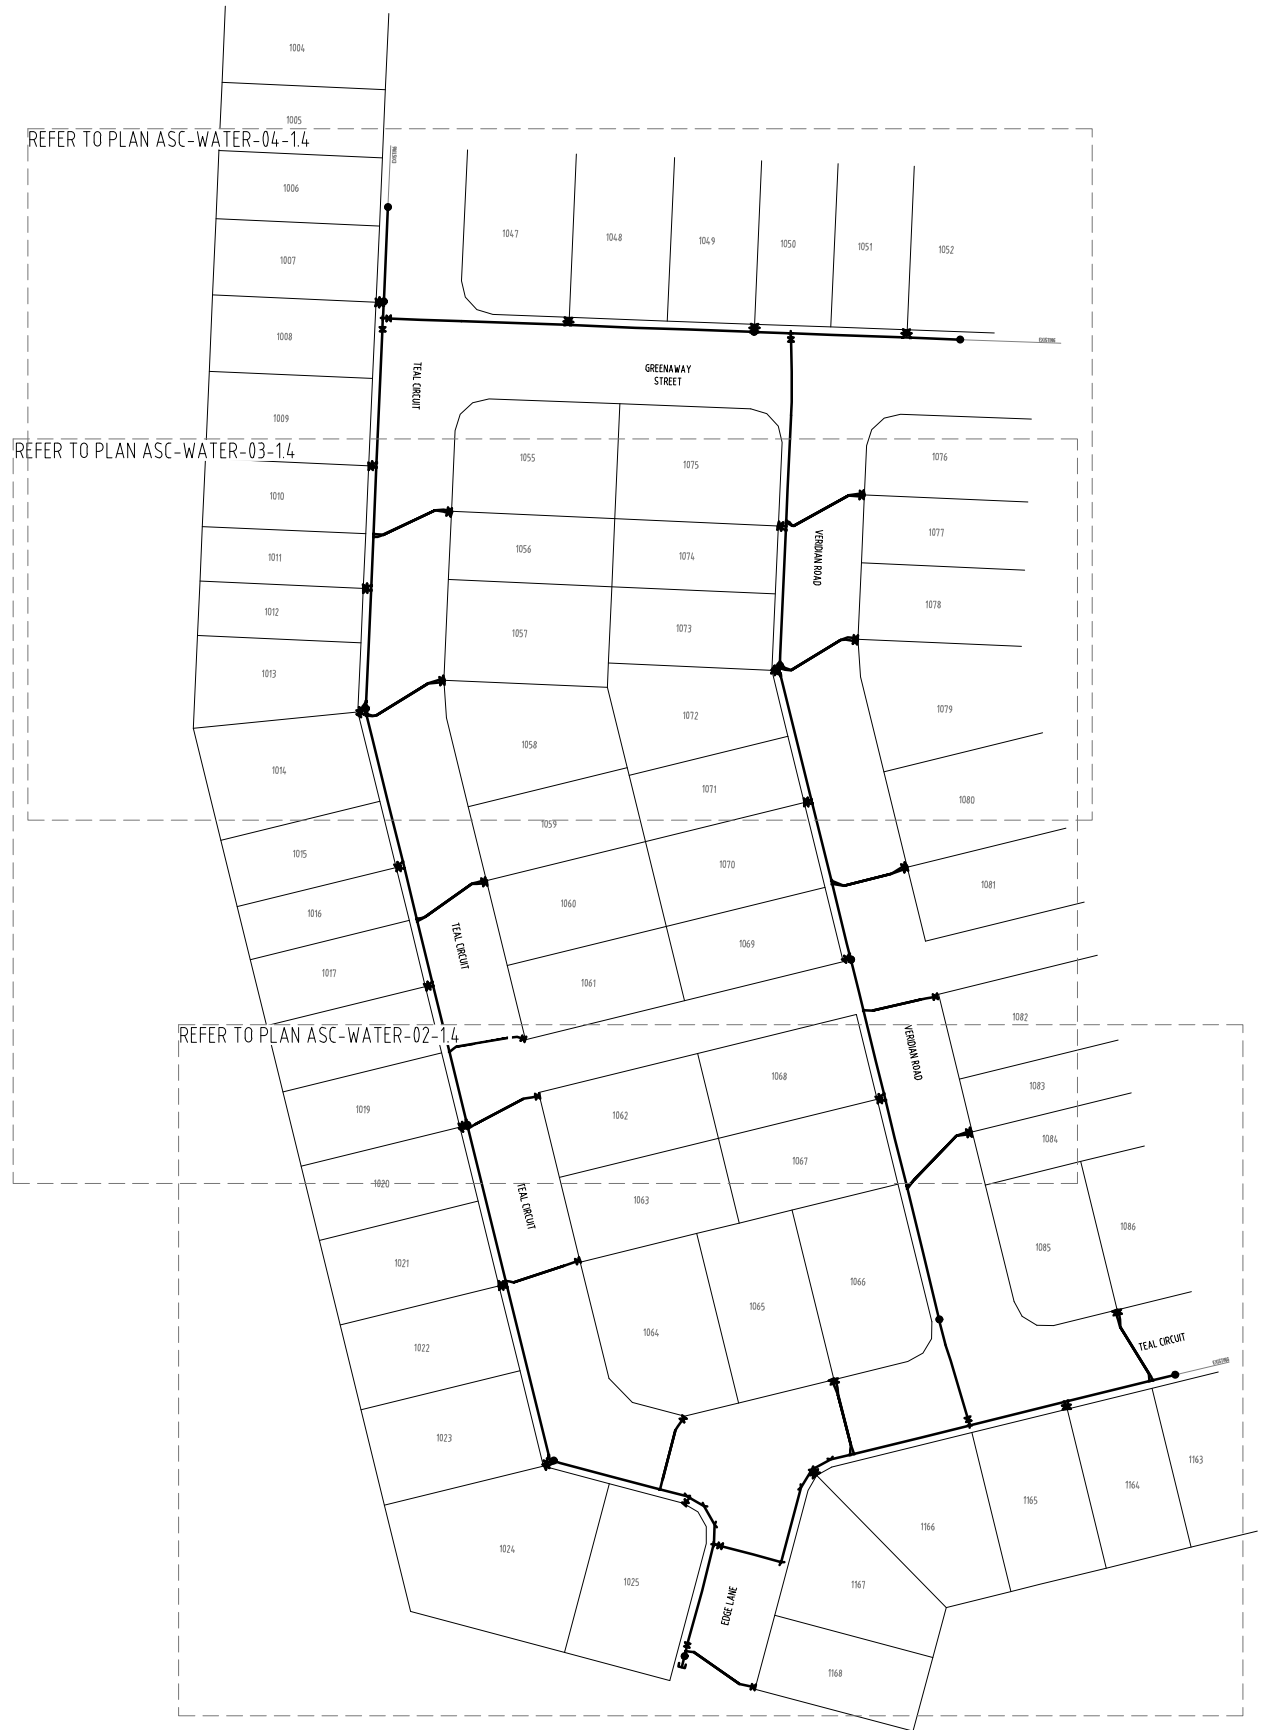

**ENGINEER'S CERTIFICATION**

I, \_\_\_\_\_, hereby certify that:



- The information contained in this drawing / document is in compliance with approved drawings and design.
- The new water and sewerage works defined by this drawing have been designed and constructed in accordance with the SEQ Code.
- This represents an accurate record of as-constructed works.
- I accept responsibility for the information contained in this drawing / document.

\_\_\_\_\_  
 RPEQ (signature) RPEQ No. \_\_\_\_\_ Date: \_\_\_\_\_

**REGISTERED SURVEYOR'S CERTIFICATION**

I, Gordon Nicholson, hereby certify that the vertical and horizontal locations and dimensions shown on this plan are a true and correct record and were located by survey.

Gordon Nicholson  
 Registered Surveyor (sig.) Reg. Surveyor No. SA 3405 Date: 24/06/2020

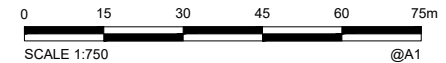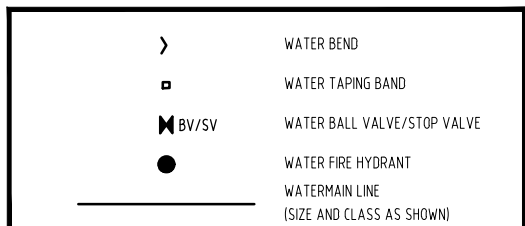

**AS CONSTRUCTED**


A1	INDEX	DATE	REVISIONS	DRAWN	CHECKED	PASSED	INITIALS	DATE
	A	24/06/2020	AS CONSTRUCTED	DAM	-	LS		24/06/2020



**LOGAN CITY COUNCIL**

MIRVAC MIR001-04  
 AS CONSTRUCTED SURVEY - WATER  
 EVERLEIGH PRECINCT 1.4  
 GREENBANK QLD

SHEET 1 OF 4 SHEETS	SCALE 1:750 A1
REVISION DATE 24/06/2020	REVISION A
DISCIPLINE CODE -	
DRAWING NO. ASC-WATER-01-1.4	

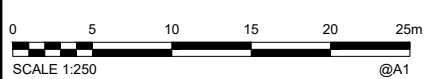

**AS CONSTRUCTED**

- > WATER BEND
- WATER TAPING BAND
- ⊕ BV/SV WATER BALL VALVE/STOP VALVE
- WATER FIRE HYDRANT
- WATERMAIN LINE (SIZE AND CLASS AS SHOWN)

**ENGINEER'S CERTIFICATION**

I, \_\_\_\_\_, hereby certify that:

- The information contained in this drawing / document is in compliance with approved drawings and design.
- The new water and sewerage works defined by this drawing have been designed and constructed in accordance with the SEQ Code.
- This represents an accurate record of as-constructed works.
- I accept responsibility for the information contained in this drawing / document.


\_\_\_\_\_  
RPEQ (signature) RPEQ No. \_\_\_\_\_ Date: \_\_\_\_\_

**REGISTERED SURVEYOR'S CERTIFICATION**

I, Gordon Nicholson, hereby certify that the vertical and horizontal locations and dimensions shown on this plan are a true and correct record and were located by survey.

\_\_\_\_\_  
Registered Surveyor (sig.) Reg. Surveyor No. SA 3405 Date: 24/06/2020

**COORDINATE DATUM NOTE:**  
 HORIZONTAL COORDINATES (E, N) SUPPLIED ARE MAPPING GRID OF AUSTRALIA (MGA), ZONE 56 BASED ON THE UNIVERSAL TRANSVERSE MERCATOR PROJECTION AND THE GEOCENTRIC DATUM OF AUSTRALIA 1994.  
 HORIZONTAL DATUM DERIVED FROM PSM 61308 E 4.98528.114 N 6931171.033.  
 LEVELS SUPPLIED ARE ON THE AUSTRALIAN HEIGHT DATUM (AHD)  
 LEVEL DATUM DERIVED FROM PSM 61308 RL54.660 (AHD)

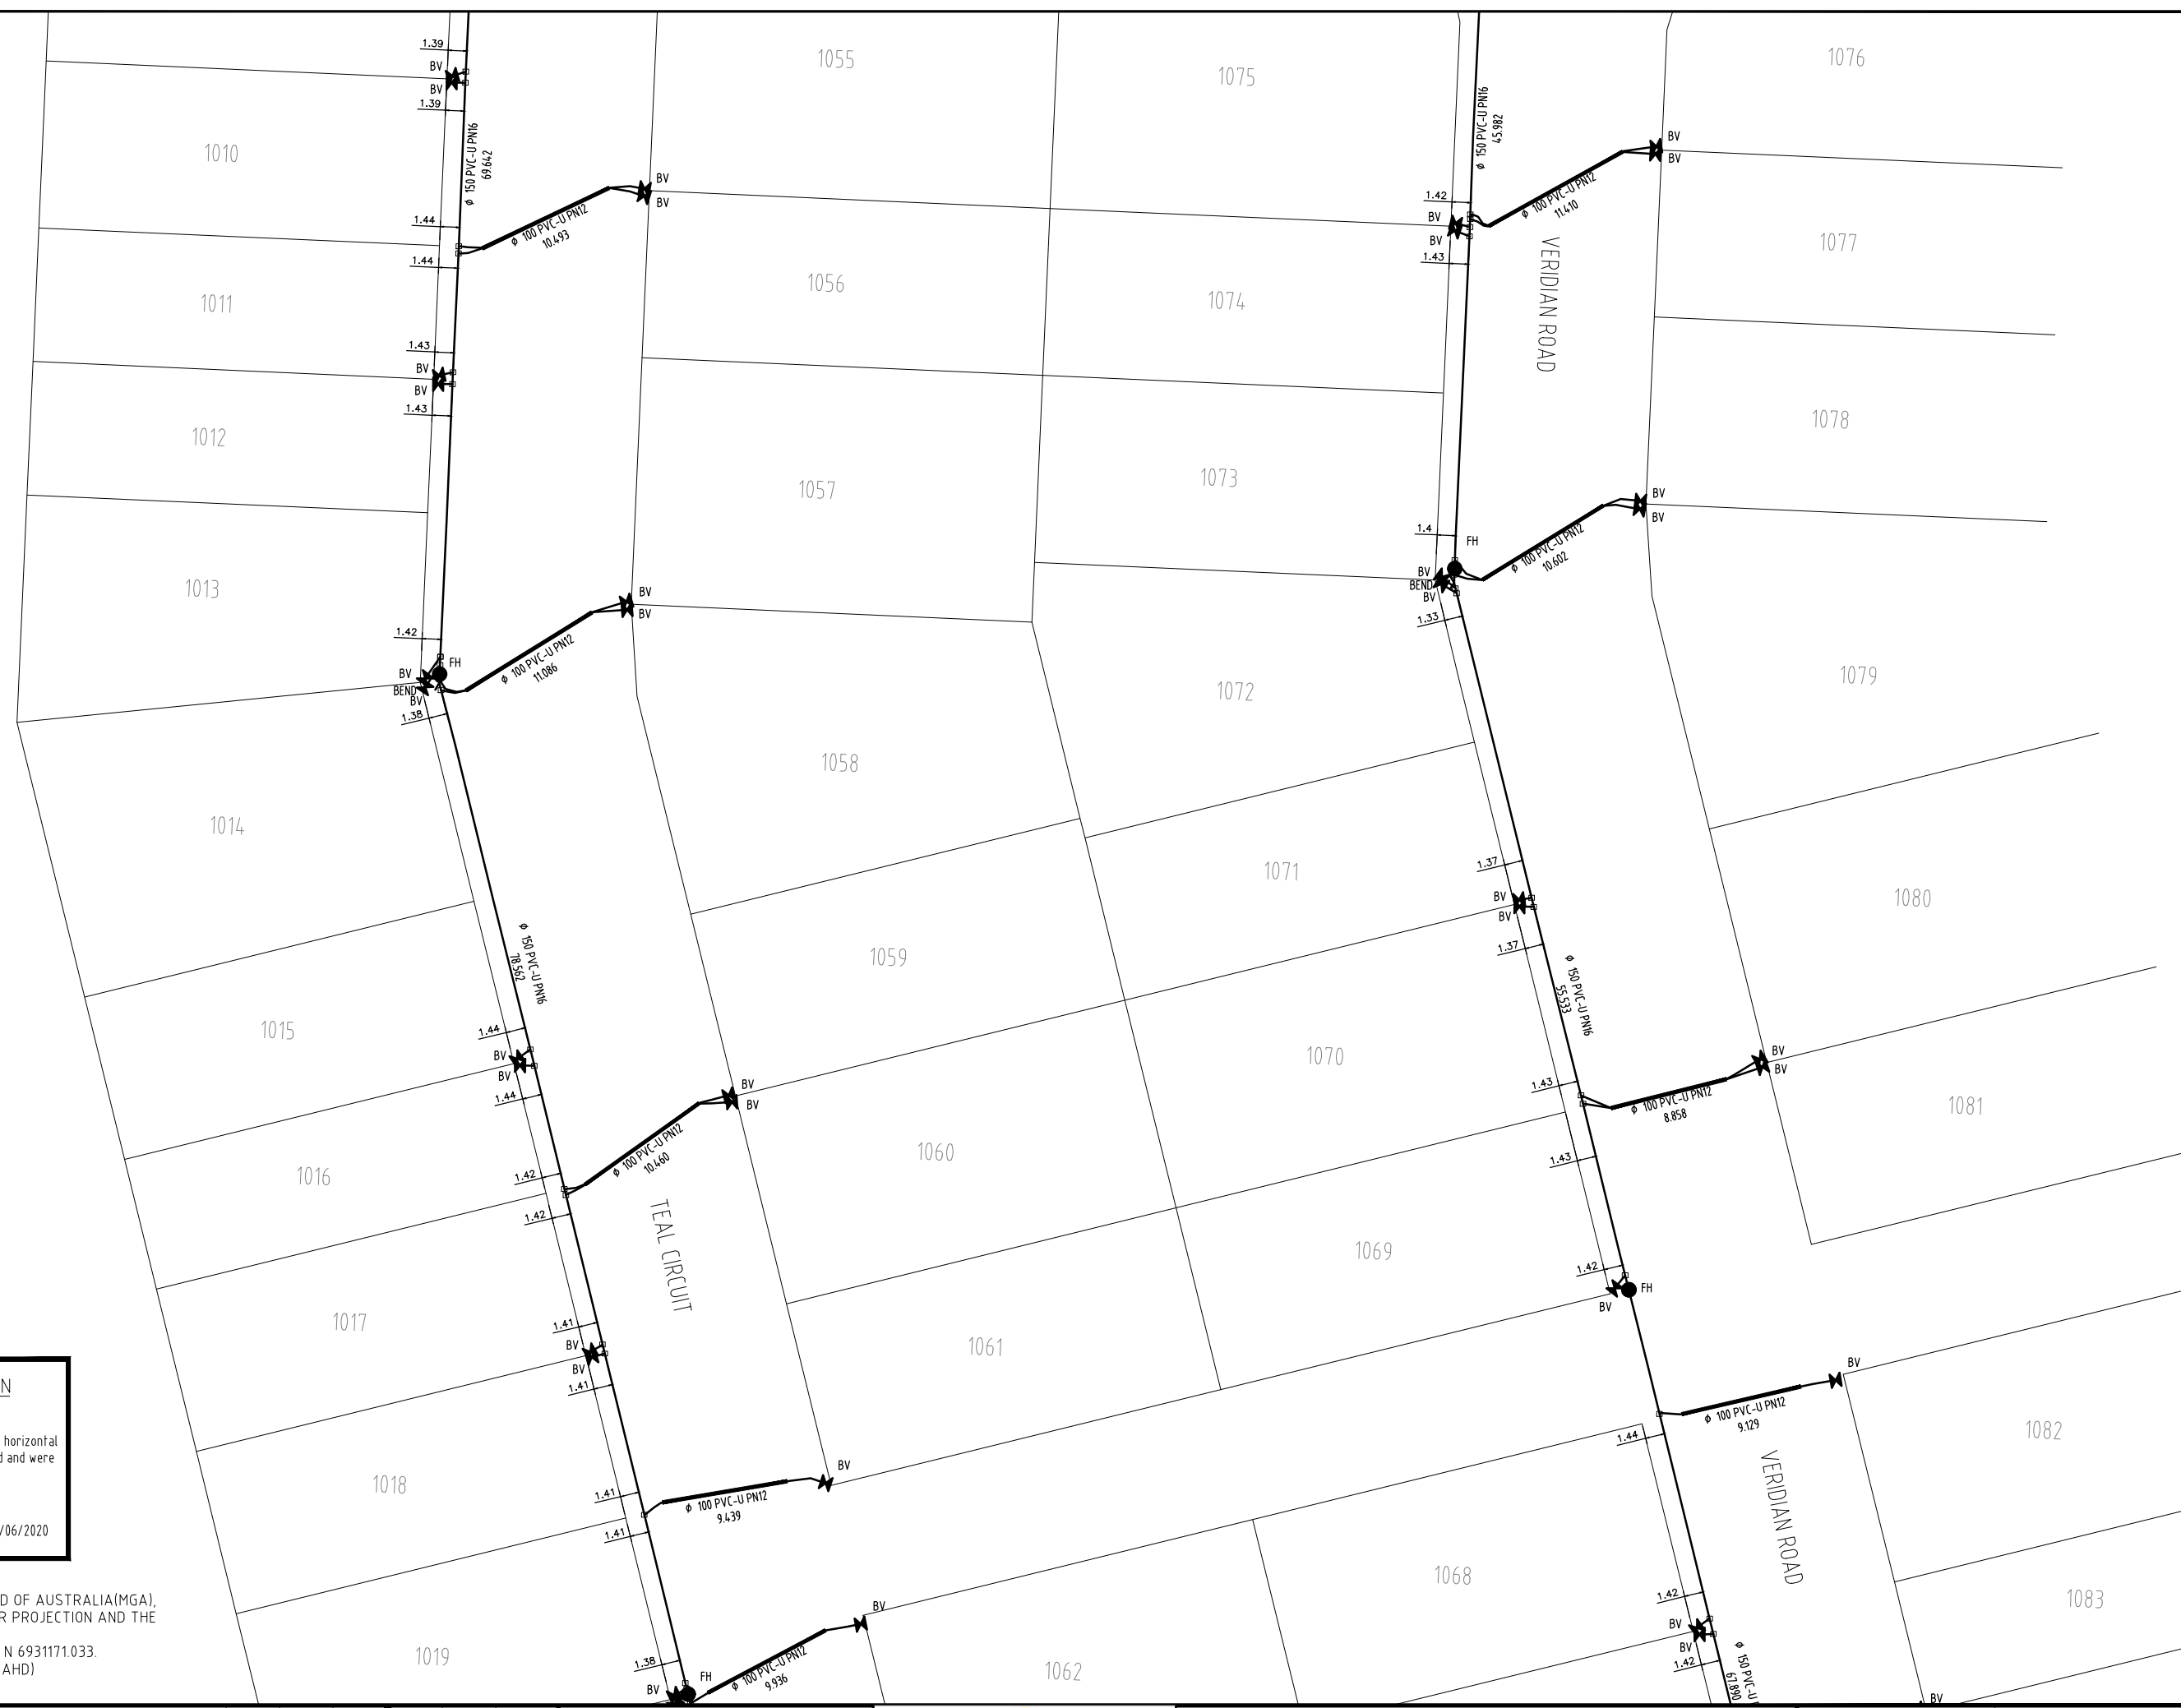

A1	INDEX	DATE	REVISIONS	DRAWN	CHECKED	PASSED	INITIALS	DATE
	A	24/06/2020	AS CONSTRUCTED	DAM	-	LS		24/06/2020

**shadforth**

58 Southshore Lane, Forest Glen QLD 4006  
 07 5438 2000 • 07 5438 2008 • shadforth@shadforth.com.au

**LOGAN CITY COUNCIL**






**LOGAN CITY COUNCIL**

MIRVAC MIR001-04  
 B  
 EVERLEIGH PRECINCT 14  
 GREENBANK QLD

SHEET 3 OF 4 SHEETS	SCALE 1:250 A1
REVISION DATE 24/06/2020	REVISION A
DISCIPLINE CODE -	
DRAWING NO. ASC-WATER-03-14	



**AS CONSTRUCTED**

-  WATER BEND
-  WATER TAPPING BAND
-  WATER BALL VALVE/STOP VALVE
-  WATER FIRE HYDRANT
-  WATERMAIN LINE  
(SIZE AND CLASS AS SHOWN)

**ENGINEER'S CERTIFICATION**


I, \_\_\_\_\_, hereby certify that:

1. The information contained in this drawing / document is in compliance with approved drawings and design.
2. The new water and sewerage works defined by this drawing have been designed and constructed in accordance with the SEQ Code.
3. This represents an accurate record of as-constructed works.
4. I accept responsibility for the information contained in this drawing / document.

RPEQ (signature) RPEQ No. \_\_\_\_\_ Date: \_\_\_\_\_

**REGISTERED SURVEYOR'S CERTIFICATION**

I, Gordon Nicholson, hereby certify that the vertical and horizontal locations and dimensions shown on this plan are a true and correct record and were located by survey.

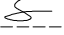  
Registered Surveyor (sig.) Reg. Surveyor No. SA 3405 Date: 24/06/2020

**COORDINATE DATUM NOTE:**  
 HORIZONTAL COORDINATES(E,N) SUPPLIED ARE MAPPING GRID OF AUSTRALIA(MGA), ZONE 56 BASED ON THE UNIVERSAL TRANSVERSE MERCATOR PROJECTION AND THE GEOCENTRIC DATUM OF AUSTRALIA 1994.  
 HORIZONTAL DATUM DERIVED FROM PSM 61308 E 4 98528.114 N 6931171.033.  
 LEVELS SUPPLIED ARE ON THE AUSTRALIAN HEIGHT DATUM(AHD)  
 LEVEL DATUM DERIVED FROM PSM 61308 RL54.660 (AHD)

A1	INDEX	DATE	REVISIONS	DRAWN	CHECKED	PASSED	INITIALS	DATE
	A	24/06/2020	AS CONSTRUCTED	DAM	-	LS		24/06/2020


DRAWN	DAM	24/06/2020
CHECKED	-	24/06/2020
PASSED	LS	24/06/2020




**LOGAN CITY COUNCIL**

MIRVAC MIR001-04  
B  
EVERLEIGH PRECINCT 14  
GREENBANK QLD

SHEET 4 OF 4 SHEETS	SCALE 1:250 A1
REVISION DATE 24/06/2020	REVISION A
DISCIPLINE CODE -	
DRAWING NO.	
ASC-WATER-04-14	

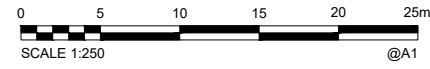

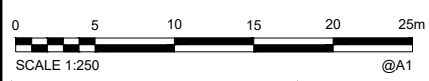

**AS CONSTRUCTED**

- WATER BEND
- WATER TAPING BAND
- WATER BALL VALVE/STOP VALVE
- WATER FIRE HYDRANT
- WATERMAIN LINE  
(SIZE AND CLASS AS SHOWN)

**ENGINEER'S CERTIFICATION**

I, \_\_\_\_\_, hereby certify that:

1. The information contained in this drawing / document is in compliance with approved drawings and design.
2. The new water and sewerage works defined by this drawing have been designed and constructed in accordance with the SEO Code.
3. This represents an accurate record of as-constructed works.
4. I accept responsibility for the information contained in this drawing / document.

\_\_\_\_\_  
RPEQ (signature) RPEQ No. \_\_\_\_\_ Date: \_\_\_\_\_

**REGISTERED SURVEYOR'S CERTIFICATION**

I, Gordon Nicholson, hereby certify that the vertical and horizontal locations and dimensions shown on this plan are a true and correct record and were located by survey.

\_\_\_\_\_  
Registered Surveyor (sig.) Reg. Surveyor No. SA 3405 Date: 24/06/2020

**COORDINATE DATUM NOTE:**  
 HORIZONTAL COORDINATES (E, N) SUPPLIED ARE MAPPING GRID OF AUSTRALIA (MGA), ZONE 56 BASED ON THE UNIVERSAL TRANSVERSE MERCATOR PROJECTION AND THE GEOCENTRIC DATUM OF AUSTRALIA 1994.  
 HORIZONTAL DATUM DERIVED FROM PSM 61308 E 4.98528.114 N 6931171.033.  
 LEVELS SUPPLIED ARE ON THE AUSTRALIAN HEIGHT DATUM (AHD)  
 LEVEL DATUM DERIVED FROM PSM 61308 RL54.660 (AHD)

<b>A1</b>	INDEX	DATE	REVISIONS	DRAWN	CHECKED	PASSED	INITIALS	DATE
	A	24/06/2020	AS CONSTRUCTED	DAM	-	LS		24/06/2020

38 Southwood Lane, Forest Glen QLD 4036  
08 52 64 28 2000 • 08 52 64 28 2000 • shadforth@shadforth.com.au

**LOGAN CITY COUNCIL**

MIRVAC MIR001-04  
AS CONSTRUCTED SURVEY - WATER  
EVERLEIGH PRECINCT 14  
GREENBANK QLD

SHEET 2 OF 4 SHEETS	SCALE 1:250 A1
REVISION DATE 24/06/2020	REVISION <b>A</b>
DISCIPLINE CODE -	
DRAWING NO. <b>ASC-WATER-02-1.4</b>	