

ENGINEER'S CERTIFICATION

Joshua Stone hereby certify that:
 1. The information contained in this drawing / document is in compliance with approved drawings and design.
 2. The new water and sewerage works defined by this drawing have been designed and constructed in accordance with the SEQ Code.
 3. This represents an accurate record of as-constructed works.
 4. I accept responsibility for the information contained in this drawing / document.

RPEQ (signature) RPEQ No. 15187 Date: 10.12.2018

NOTES:

1. COORDINATE DATUM:
 SURVEYOR: SHADFORTH
 HORIZONTAL COORDINATE(S) SUPPLIED ARE MAPPING GRID OF AUSTRALIA(MGA), ZONE 56 BASED ON THE UNIVERSAL TRANSVERSE MERCATOR PROJECTION AND THE GEOCENTRIC DATUM OF AUSTRALIA 1994.
 HORIZONTAL DATUM DERIVED FROM PM 61308
 LEVELS SUPPLIED ARE ON THE AUSTRALIAN HEIGHT DATUM(AHD).
 LEVEL DATUM DERIVED FROM PM 61308 RL54.660 (AHD)

ALL AS CONSTRUCTED LINEMARKING IS SHOWN WITH DASHED LINE

REGISTERED SURVEYOR'S CERTIFICATION

LEE SCORRAR hereby certify that the vertical and horizontal locations and dimensions shown on this plan are a true and correct record and were located by survey.

Registered Surveyor (sig) Reg. Surveyor No. SA 6609 Date: 14/12/2018

PAVEMENT DESIGNS

BOTANICA ROAD / MOSS STREET / VINE WAY / FOREST ROAD / GROVE STREET / OLIVE AVENUE	KESSELS BOULEVARD(NORTH AND SOUTH) / EMERALD PARADE / EVERLEIGH DRIVE
AC(mm) - 50	AC(mm) - 50
PRIMER SEAL(mm)	PRIMER SEAL(mm)
BASE(mm) - 150	BASE(mm) - 300
SUBBASE(mm) - 150	SUBBASE(mm) - 100
TOTAL (mm) - 335	TOTAL (mm) - 450

LEGEND

CONCRETE RETAINING WALL

ACOUSTIC FENCING

RETAINING WALL HEIGHTS

SPOT LEVELS

AS CONSTRUCTED

ISSUE	DATE	AUTHOR	COMMENTS

99 Sandalwood Lane, Forest Glen QLD 4556
 P: 07 5438 3300 > F: 07 5438 3388 > E: admin@shadcivil.com.au

DRAWING TITLE
 AS CONSTRUCTED ROADS & EWKS

CLIENT
 MIRVAC

PROJECT
 EVERLEIGH PRECINCT 1.1
 SUBDIVISION INFRASTRUCTURE WORKS

ASSOCIATE CONSULTANT
 PREMISE

LOCAL GOVERNMENT
 LCC

SCALE
 0 7.5 15 22.5 30 37.5m
 SCALE 1:750 A3


DATUM MGA94 Zone 56
LEVEL ORIGIN PM61308 RL 54.660
CONTOUR INTERVAL MAJ 0.500 MIN 0.250

DRAWN DAM **DATE** 14/12/2018
CHECKED LS **DATE** 14/12/2018

SHEET N° 1 OF 6
PLAN NUMBER ASC-RDS & EWKS-01-1183
REVISION -

JOINS DRAWING ASC-RDS & EWKS-02-1183

JOINS DRAWING ASC-RDS & EWKS-01-1183

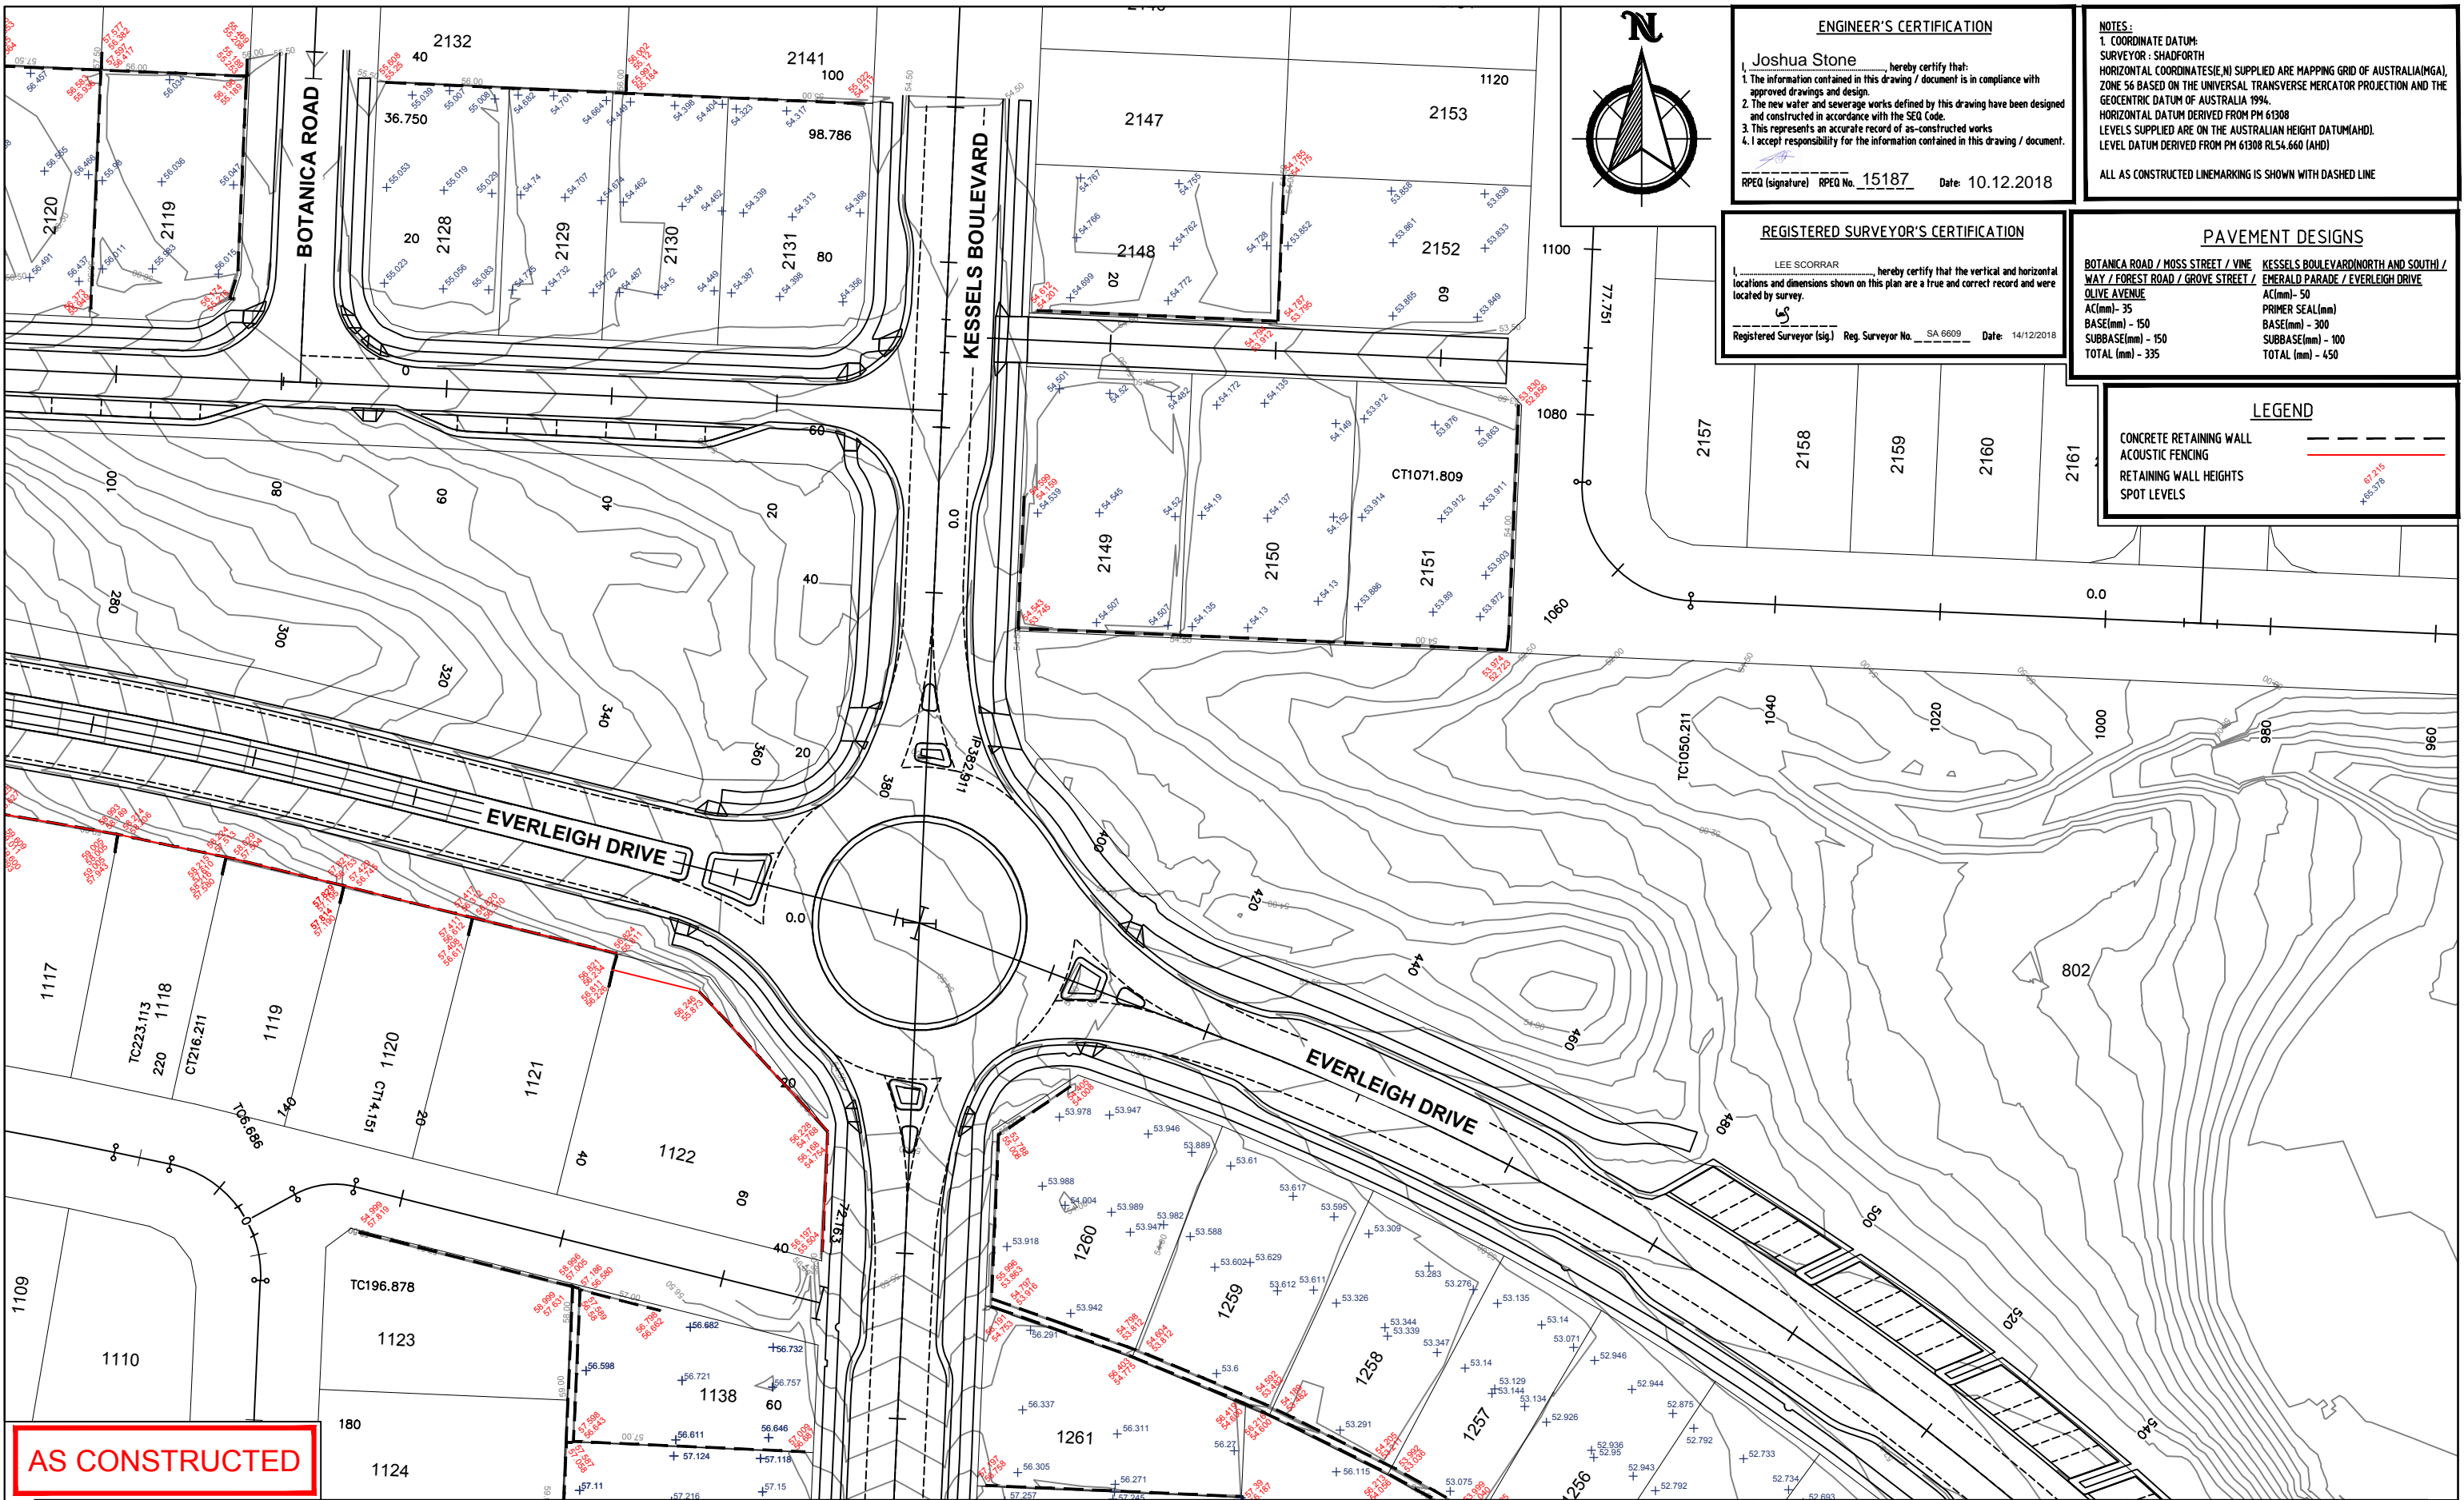

ENGINEER'S CERTIFICATION
 Joshua Stone hereby certify that:
 1. The information contained in this drawing / document is in compliance with approved drawings and design.
 2. The new water and sewerage works defined by this drawing have been designed and constructed in accordance with the SEQ Code.
 3. This represents an accurate record of as-constructed works.
 4. I accept responsibility for the information contained in this drawing / document.
 RPEQ (signature) RPEQ No. 15187 Date: 10.12.2018

NOTES:
 1. COORDINATE DATUM: SURVEYOR: SHADFORTH
 HORIZONTAL COORDINATE(S,N) SUPPLIED ARE MAPPING GRID OF AUSTRALIA(MGA), ZONE 56 BASED ON THE UNIVERSAL TRANSVERSE MERCATOR PROJECTION AND THE GEOCENTRIC DATUM OF AUSTRALIA 1994.
 HORIZONTAL DATUM DERIVED FROM PM 61308
 LEVELS SUPPLIED ARE ON THE AUSTRALIAN HEIGHT DATUM(AHD).
 LEVEL DATUM DERIVED FROM PM 61308 RL54.660 (AHD)
 ALL AS CONSTRUCTED LINEMARKING IS SHOWN WITH DASHED LINE

REGISTERED SURVEYOR'S CERTIFICATION
 LEE SCORRAR hereby certify that the vertical and horizontal locations and dimensions shown on this plan are a true and correct record and were located by survey.
 Registered Surveyor (sig) Reg. Surveyor No. SA 6609 Date: 14/12/2018

PAVEMENT DESIGNS
 BOTANICA ROAD / MOSS STREET / VINE WAY / FOREST ROAD / GROVE STREET / OLIVE AVENUE
 AC(mm) - 50
 PRIMER SEAL(mm)
 BASE(mm) - 150
 SUBBASE(mm) - 150
 TOTAL (mm) - 335
 KESSELS BOULEVARD(NORTH AND SOUTH) / EMERALD PARADE / EVERLEIGH DRIVE
 AC(mm) - 50
 PRIMER SEAL(mm)
 BASE(mm) - 300
 SUBBASE(mm) - 100
 TOTAL (mm) - 450

LEGEND
 CONCRETE RETAINING WALL
 ACOUSTIC FENCING
 RETAINING WALL HEIGHTS
 SPOT LEVELS

AS CONSTRUCTED

ISSUE	DATE	AUTHOR	COMMENTS

99 Sandalwood Lane, Forest Glen QLD 4556
 P: 07 5438 3300 ▶ F: 07 5438 3388 ▶ E: admin@shadcivil.com.au

DRAWING TITLE
 AS CONSTRUCTED ROADS & EWKS
CLIENT
 MIRVAC
PROJECT
 EVERLEIGH PRECINCT 1.1
 SUBDIVISION INFRASTRUCTURE WORKS

ASSOCIATE CONSULTANT
 PREMISE
 LOCAL GOVERNMENT
 LCC
SCALE
 0 7.5 15 22.5 30 37.5m
 SCALE 1:750 A3

DATUM	MGA94 Zone 56
LEVEL ORIGIN	PM61308 RL 54.660
CONTOUR INTERVAL	MAJ 0.500 MIN 0.250
DRAWN	DAM DATE 14/12/2018
CHECKED	LS DATE 14/12/2018
SHEET N°	2 OF 6
PLAN NUMBER	ASC-RDS & EWKS-02-1183
REVISION	-



ENGINEER'S CERTIFICATION
 Joshua Stone, hereby certify that:
 1. The information contained in this drawing / document is in compliance with approved drawings and design.
 2. The new water and sewerage works defined by this drawing have been designed and constructed in accordance with the SEQ Code.
 3. This represents an accurate record of as-constructed works.
 4. I accept responsibility for the information contained in this drawing / document.
 RPEQ (signature) RPEQ No. 15187 Date: 10.12.2018

NOTES:
 1. COORDINATE DATUM: SURVEYOR: SHADFORTH
 HORIZONTAL COORDINATE(S) SUPPLIED ARE MAPPING GRID OF AUSTRALIA(MGA), ZONE 56 BASED ON THE UNIVERSAL TRANSVERSE MERCATOR PROJECTION AND THE GEOCENTRIC DATUM OF AUSTRALIA 1994.
 HORIZONTAL DATUM DERIVED FROM PM 61308
 LEVELS SUPPLIED ARE ON THE AUSTRALIAN HEIGHT DATUM(AHD).
 LEVEL DATUM DERIVED FROM PM 61308 RL54.660 (AHD)
 ALL AS CONSTRUCTED LINEMARKING IS SHOWN WITH DASHED LINE

REGISTERED SURVEYOR'S CERTIFICATION
 LEE SCORRAR, hereby certify that the vertical and horizontal locations and dimensions shown on this plan are a true and correct record and were located by survey.
 Registered Surveyor (sig.) Reg. Surveyor No. SA 6609 Date: 14/12/2018

PAVEMENT DESIGNS
 BOTANICA ROAD / MOSS STREET / VINE WAY / FOREST ROAD / GROVE STREET / OLIVE AVENUE
 AC(mm) - 50
 PRIMER SEAL(mm)
 BASE(mm) - 150
 SUBBASE(mm) - 150
 TOTAL (mm) - 335
 KESSELS BOULEVARD(NORTH AND SOUTH) / EMERALD PARADE / EVERLEIGH DRIVE
 AC(mm) - 50
 PRIMER SEAL(mm)
 BASE(mm) - 300
 SUBBASE(mm) - 100
 TOTAL (mm) - 450

LEGEND
 CONCRETE RETAINING WALL
 ACOUSTIC FENCING
 RETAINING WALL HEIGHTS
 SPOT LEVELS

AS CONSTRUCTED

ISSUE	DATE	AUTHOR	COMMENTS



99 Sandalwood Lane, Forest Glen QLD 4556
 P: 07 5438 3300 > F: 07 5438 3388 > E: admin@shadforth.com.au

DRAWING TITLE
AS CONSTRUCTED ROADS & EWKS
 CLIENT
MIRVAC
 PROJECT
**EVERLEIGH PRECINCT 1.1
 SUBDIVISION INFRASTRUCTURE WORKS**

ASSOCIATE CONSULTANT
PREMISE
 LOCAL GOVERNMENT
LCC
 SCALE
 0 7.5 15 22.5 30 37.5m
 SCALE 1:750 A3

DATUM
MGA94 Zone 56
 LEVEL ORIGIN
PM61308 RL 54.660
 CONTOUR INTERVAL
MAJ 0.500 MIN 0.250
 DRAWN
DAM DATE
14/12/2018
 CHECKED
LS DATE
14/12/2018
 SHEET N°
3 OF 6
 PLAN NUMBER
ASC-RDS & EWKS-03-1183
 REVISION
-

JOINS DRAWING ASC-RDS & EWKS-04-1183




ENGINEER'S CERTIFICATION
 Joshua Stone hereby certify that:
 1. The information contained in this drawing / document is in compliance with approved drawings and design.
 2. The new water and sewerage works defined by this drawing have been designed and constructed in accordance with the SEQ Code.
 3. This represents an accurate record of as-constructed works.
 4. I accept responsibility for the information contained in this drawing / document.
 RPEQ (signature) RPEQ No. 15187 Date: 10.12.2018

NOTES:
 1. COORDINATE DATUM: SURVEYOR: SHADFORTH
 HORIZONTAL COORDINATE(S) SUPPLIED ARE MAPPING GRID OF AUSTRALIA(MGA), ZONE 56 BASED ON THE UNIVERSAL TRANSVERSE MERCATOR PROJECTION AND THE GEOMETRIC DATUM OF AUSTRALIA 1994.
 HORIZONTAL DATUM DERIVED FROM PM 61308
 LEVELS SUPPLIED ARE ON THE AUSTRALIAN HEIGHT DATUM(AHD).
 LEVEL DATUM DERIVED FROM PM 61308 RL54.660 (AHD)
 ALL AS CONSTRUCTED LINEMARKING IS SHOWN WITH DASHED LINE

REGISTERED SURVEYOR'S CERTIFICATION
 LEE SCORRAR hereby certify that the vertical and horizontal locations and dimensions shown on this plan are a true and correct record and were located by survey.
 Registered Surveyor (sig) Reg. Surveyor No. SA 6009 Date: 14/12/2018

PAVEMENT DESIGNS
 BOTANICA ROAD / MOSS STREET / VINE WAY / FOREST ROAD / GROVE STREET / OLIVE AVENUE
 AC(mm) - 50
 PRIMER SEAL(mm)
 BASE(mm) - 150
 SUBBASE(mm) - 150
 TOTAL (mm) - 335
 KESSELS BOULEVARD(NORTH AND SOUTH) / EMERALD PARADE / EVERLEIGH DRIVE
 AC(mm) - 50
 PRIMER SEAL(mm)
 BASE(mm) - 300
 SUBBASE(mm) - 100
 TOTAL (mm) - 450

LEGEND
 CONCRETE RETAINING WALL
 ACOUSTIC FENCING
 RETAINING WALL HEIGHTS
 SPOT LEVELS

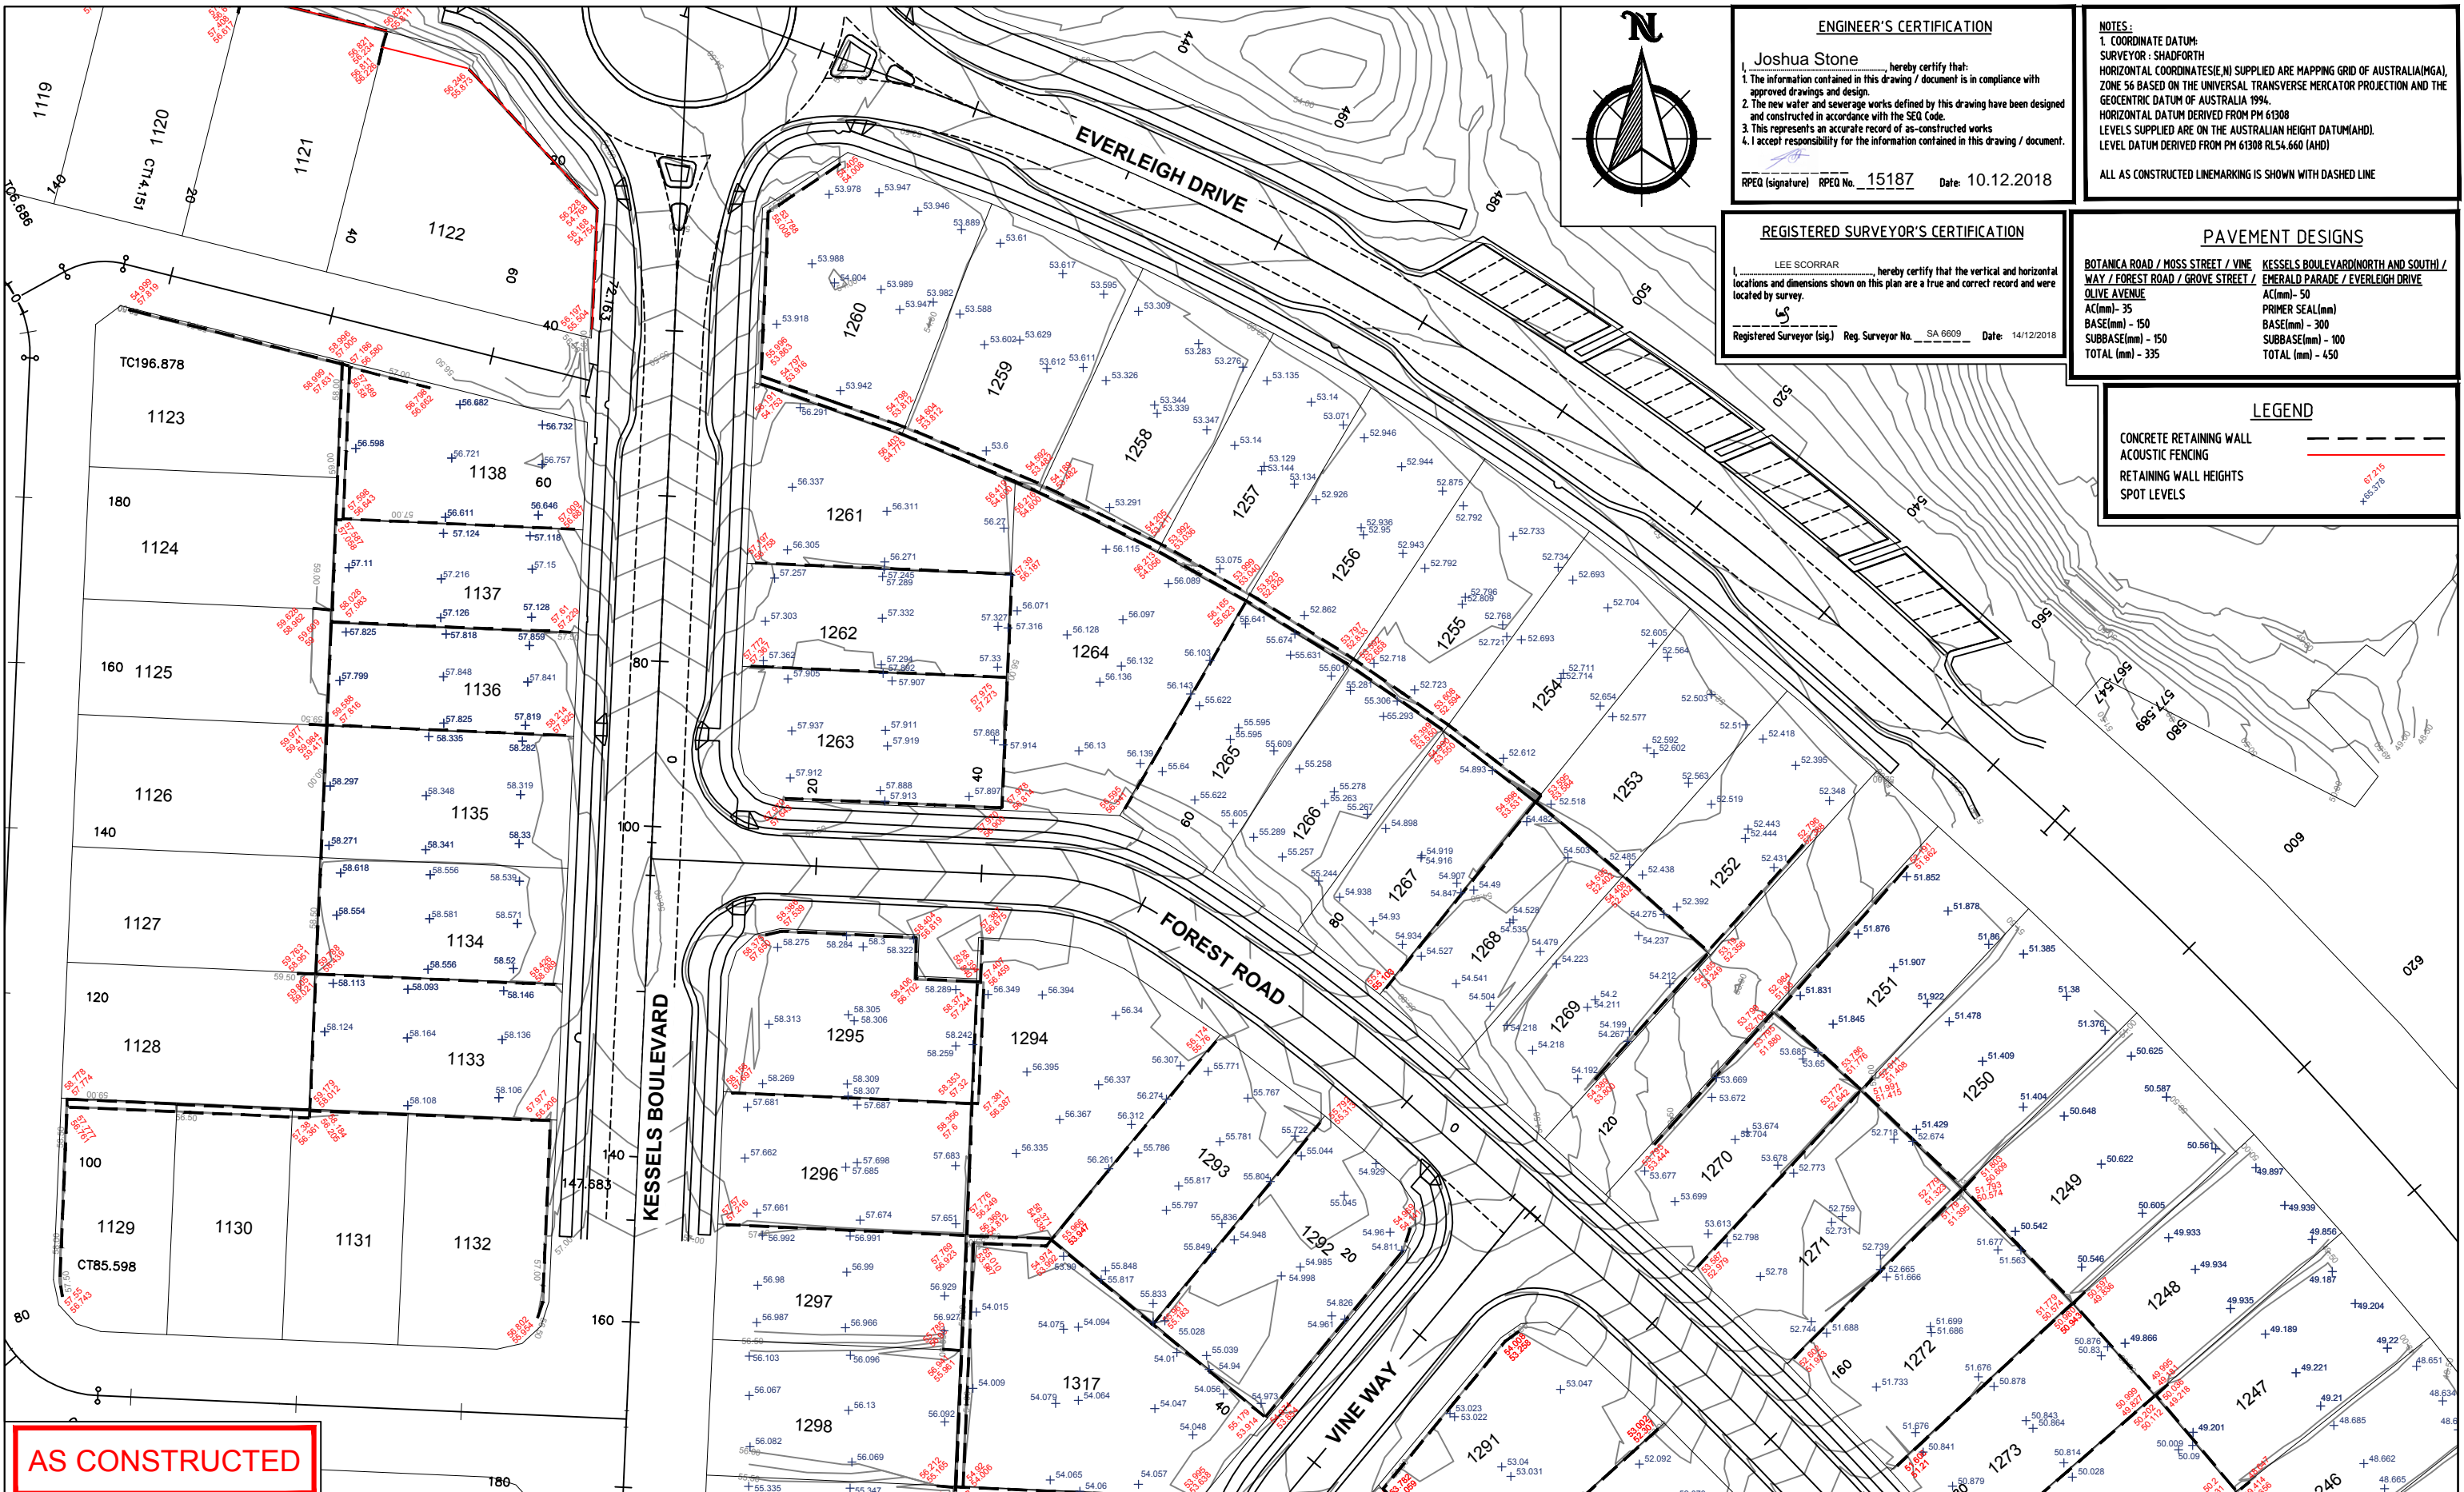

AS CONSTRUCTED

ISSUE	DATE	AUTHOR	COMMENTS





99 Sandalwood Lane, Forest Glen QLD 4556
 P: 07 5438 3300 ▶ F: 07 5438 3388 ▶ E: admin@shadcivil.com.au

DRAWING TITLE
 AS CONSTRUCTED ROADS & EWKS
CLIENT
 MIRVAC
PROJECT
 EVERLEIGH PRECINCT 1.1
 SUBDIVISION INFRASTRUCTURE WORKS

ASSOCIATE CONSULTANT
 PREMISE
LOCAL GOVERNMENT
 LCC
SCALE
 0 7.5 15 22.5 30 37.5m
 SCALE 1:750 A3

DATUM MGA94 Zone 56
LEVEL ORIGIN PM61308 RL 54.660
CONTOUR INTERVAL MAJ 0.500 MIN 0.250
DRAWN DAM DATE 14/12/2018
CHECKED LS DATE 14/12/2018
SHEET N° 4 OF 6
PLAN NUMBER ASC-RDS & EWKS-04-1183
REVISION -

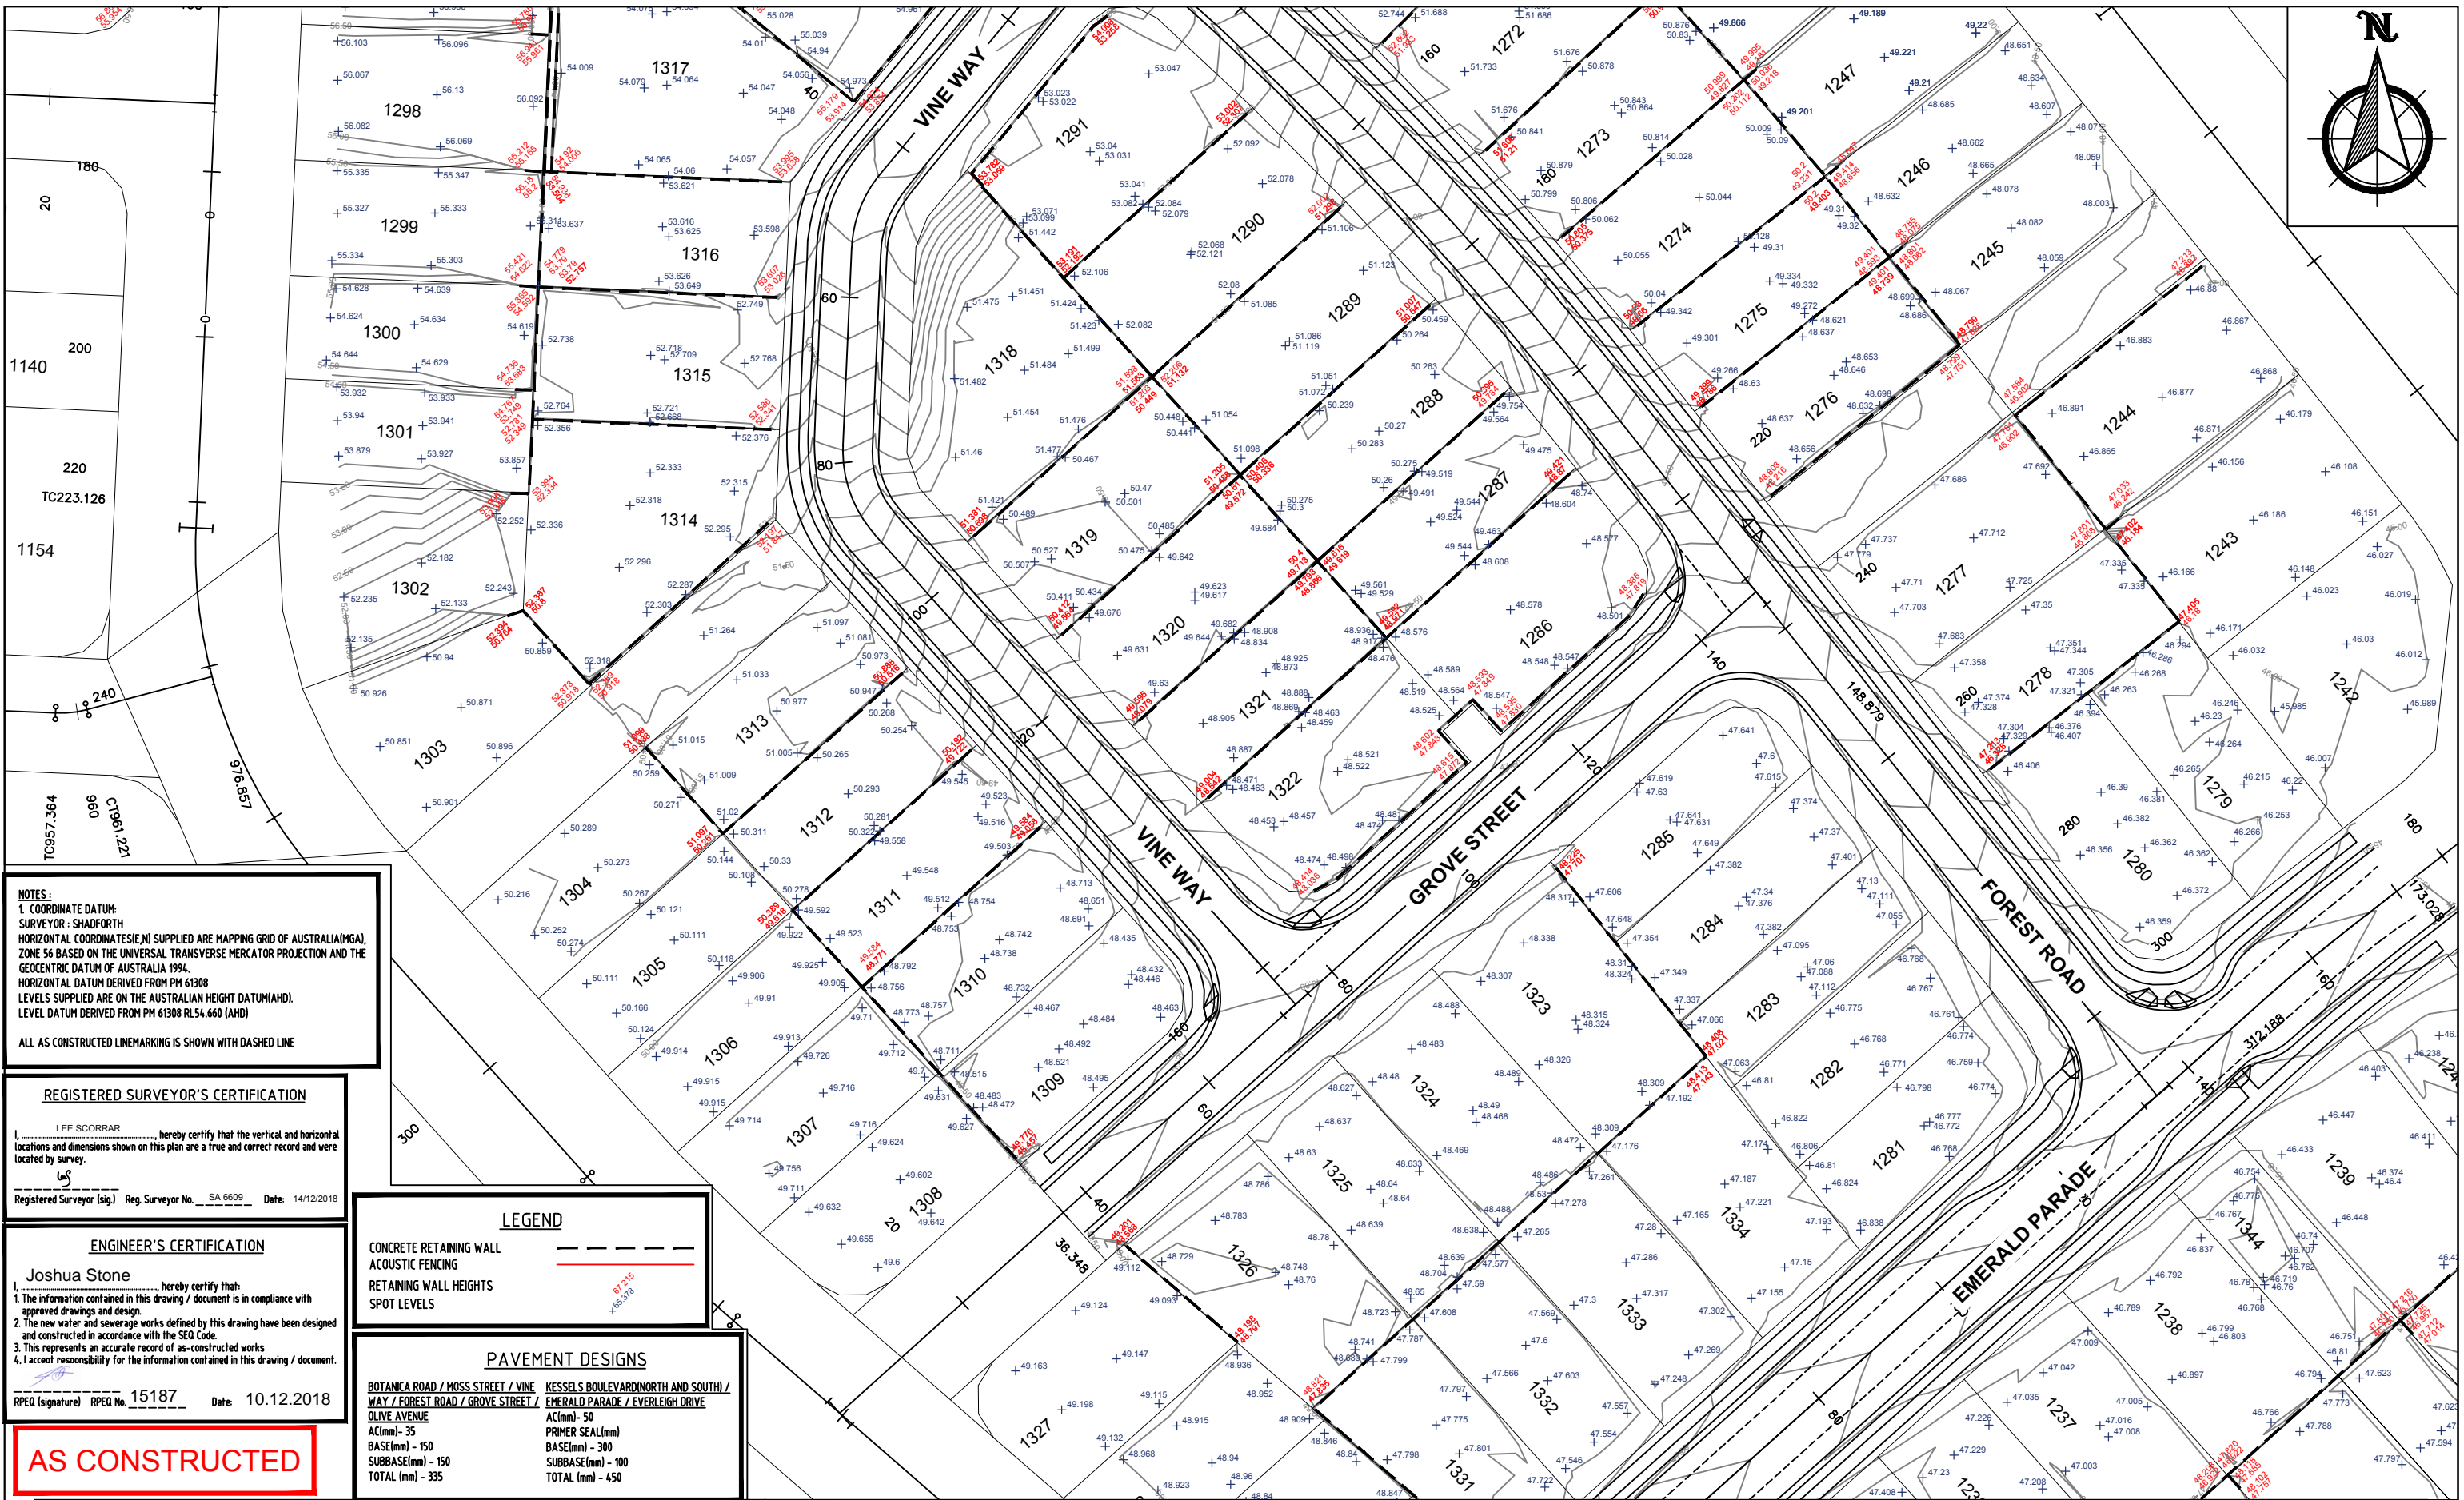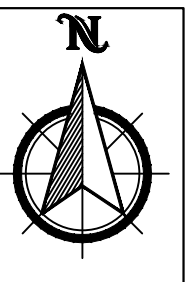

NOTES:
 1. COORDINATE DATUM:
 SURVEYOR: SHADFORTH
 HORIZONTAL COORDINATES (E,N) SUPPLIED ARE MAPPING GRID OF AUSTRALIA (MGA), ZONE 56 BASED ON THE UNIVERSAL TRANSVERSE MERCATOR PROJECTION AND THE GEOCENTRIC DATUM OF AUSTRALIA 1994.
 HORIZONTAL DATUM DERIVED FROM PM 61308
 LEVELS SUPPLIED ARE ON THE AUSTRALIAN HEIGHT DATUM (AHD).
 LEVEL DATUM DERIVED FROM PM 61308 RL 54.660 (AHD)
 ALL AS CONSTRUCTED LINEMARKING IS SHOWN WITH DASHED LINE

REGISTERED SURVEYOR'S CERTIFICATION
 I, LEE SCORRAR, hereby certify that the vertical and horizontal locations and dimensions shown on this plan are a true and correct record and were located by survey.
 Registered Surveyor (sig.) Reg. Surveyor No. SA 6609 Date: 14/12/2018

ENGINEER'S CERTIFICATION
 Joshua Stone, hereby certify that:
 1. The information contained in this drawing / document is in compliance with approved drawings and design.
 2. The new water and sewerage works defined by this drawing have been designed and constructed in accordance with the SEQ Code.
 3. This represents an accurate record of as-constructed works
 4. I accept responsibility for the information contained in this drawing / document.
 RPEQ (signature) RPEQ No. 15187 Date: 10.12.2018

AS CONSTRUCTED

LEGEND
 CONCRETE RETAINING WALL
 ACOUSTIC FENCING
 RETAINING WALL HEIGHTS
 SPOT LEVELS

PAVEMENT DESIGNS
 BOTANICA ROAD / MOSS STREET / VINE WAY / FOREST ROAD / GROVE STREET / OLIVE AVENUE
 AC(mm) - 35
 BASE(mm) - 150
 SUBBASE(mm) - 150
 TOTAL (mm) - 335
 KESSELS BOULEVARD/NORTH AND SOUTH / EMERALD PARADE / EVERLEIGH DRIVE
 AC(mm) - 50
 PRIMER SEAL(mm)
 BASE(mm) - 300
 SUBBASE(mm) - 100
 TOTAL (mm) - 450


ISSUE	DATE	AUTHOR	COMMENTS

shadforth
 99 Sandalwood Lane, Forest Glen QLD 4556
 P: 07 5438 3300 F: 07 5438 3388 E: admin@shadforth.com.au

DRAWING TITLE
 AS CONSTRUCTED ROADS & EWKS
CLIENT
 MIRVAC
PROJECT
 EVERLEIGH PRECINCT 1.1
 SUBDIVISION INFRASTRUCTURE WORKS

ASSOCIATE CONSULTANT
 PREMISE
 LOCAL GOVERNMENT
 LCC
SCALE
 0 7.5 15 22.5 30 37.5m
 SCALE 1:750 A3

DATUM MGA94 Zone 56
LEVEL ORIGIN PM61308 RL 54.660
CONTOUR INTERVAL MAJ 0.500 MIN 0.250
DRAWN DAM DATE 14/12/2018
CHECKED LS DATE 14/12/2018
SHEET N° 5 OF 6
PLAN NUMBER ASC-RDS & EWKS-05-1183
REVISION -

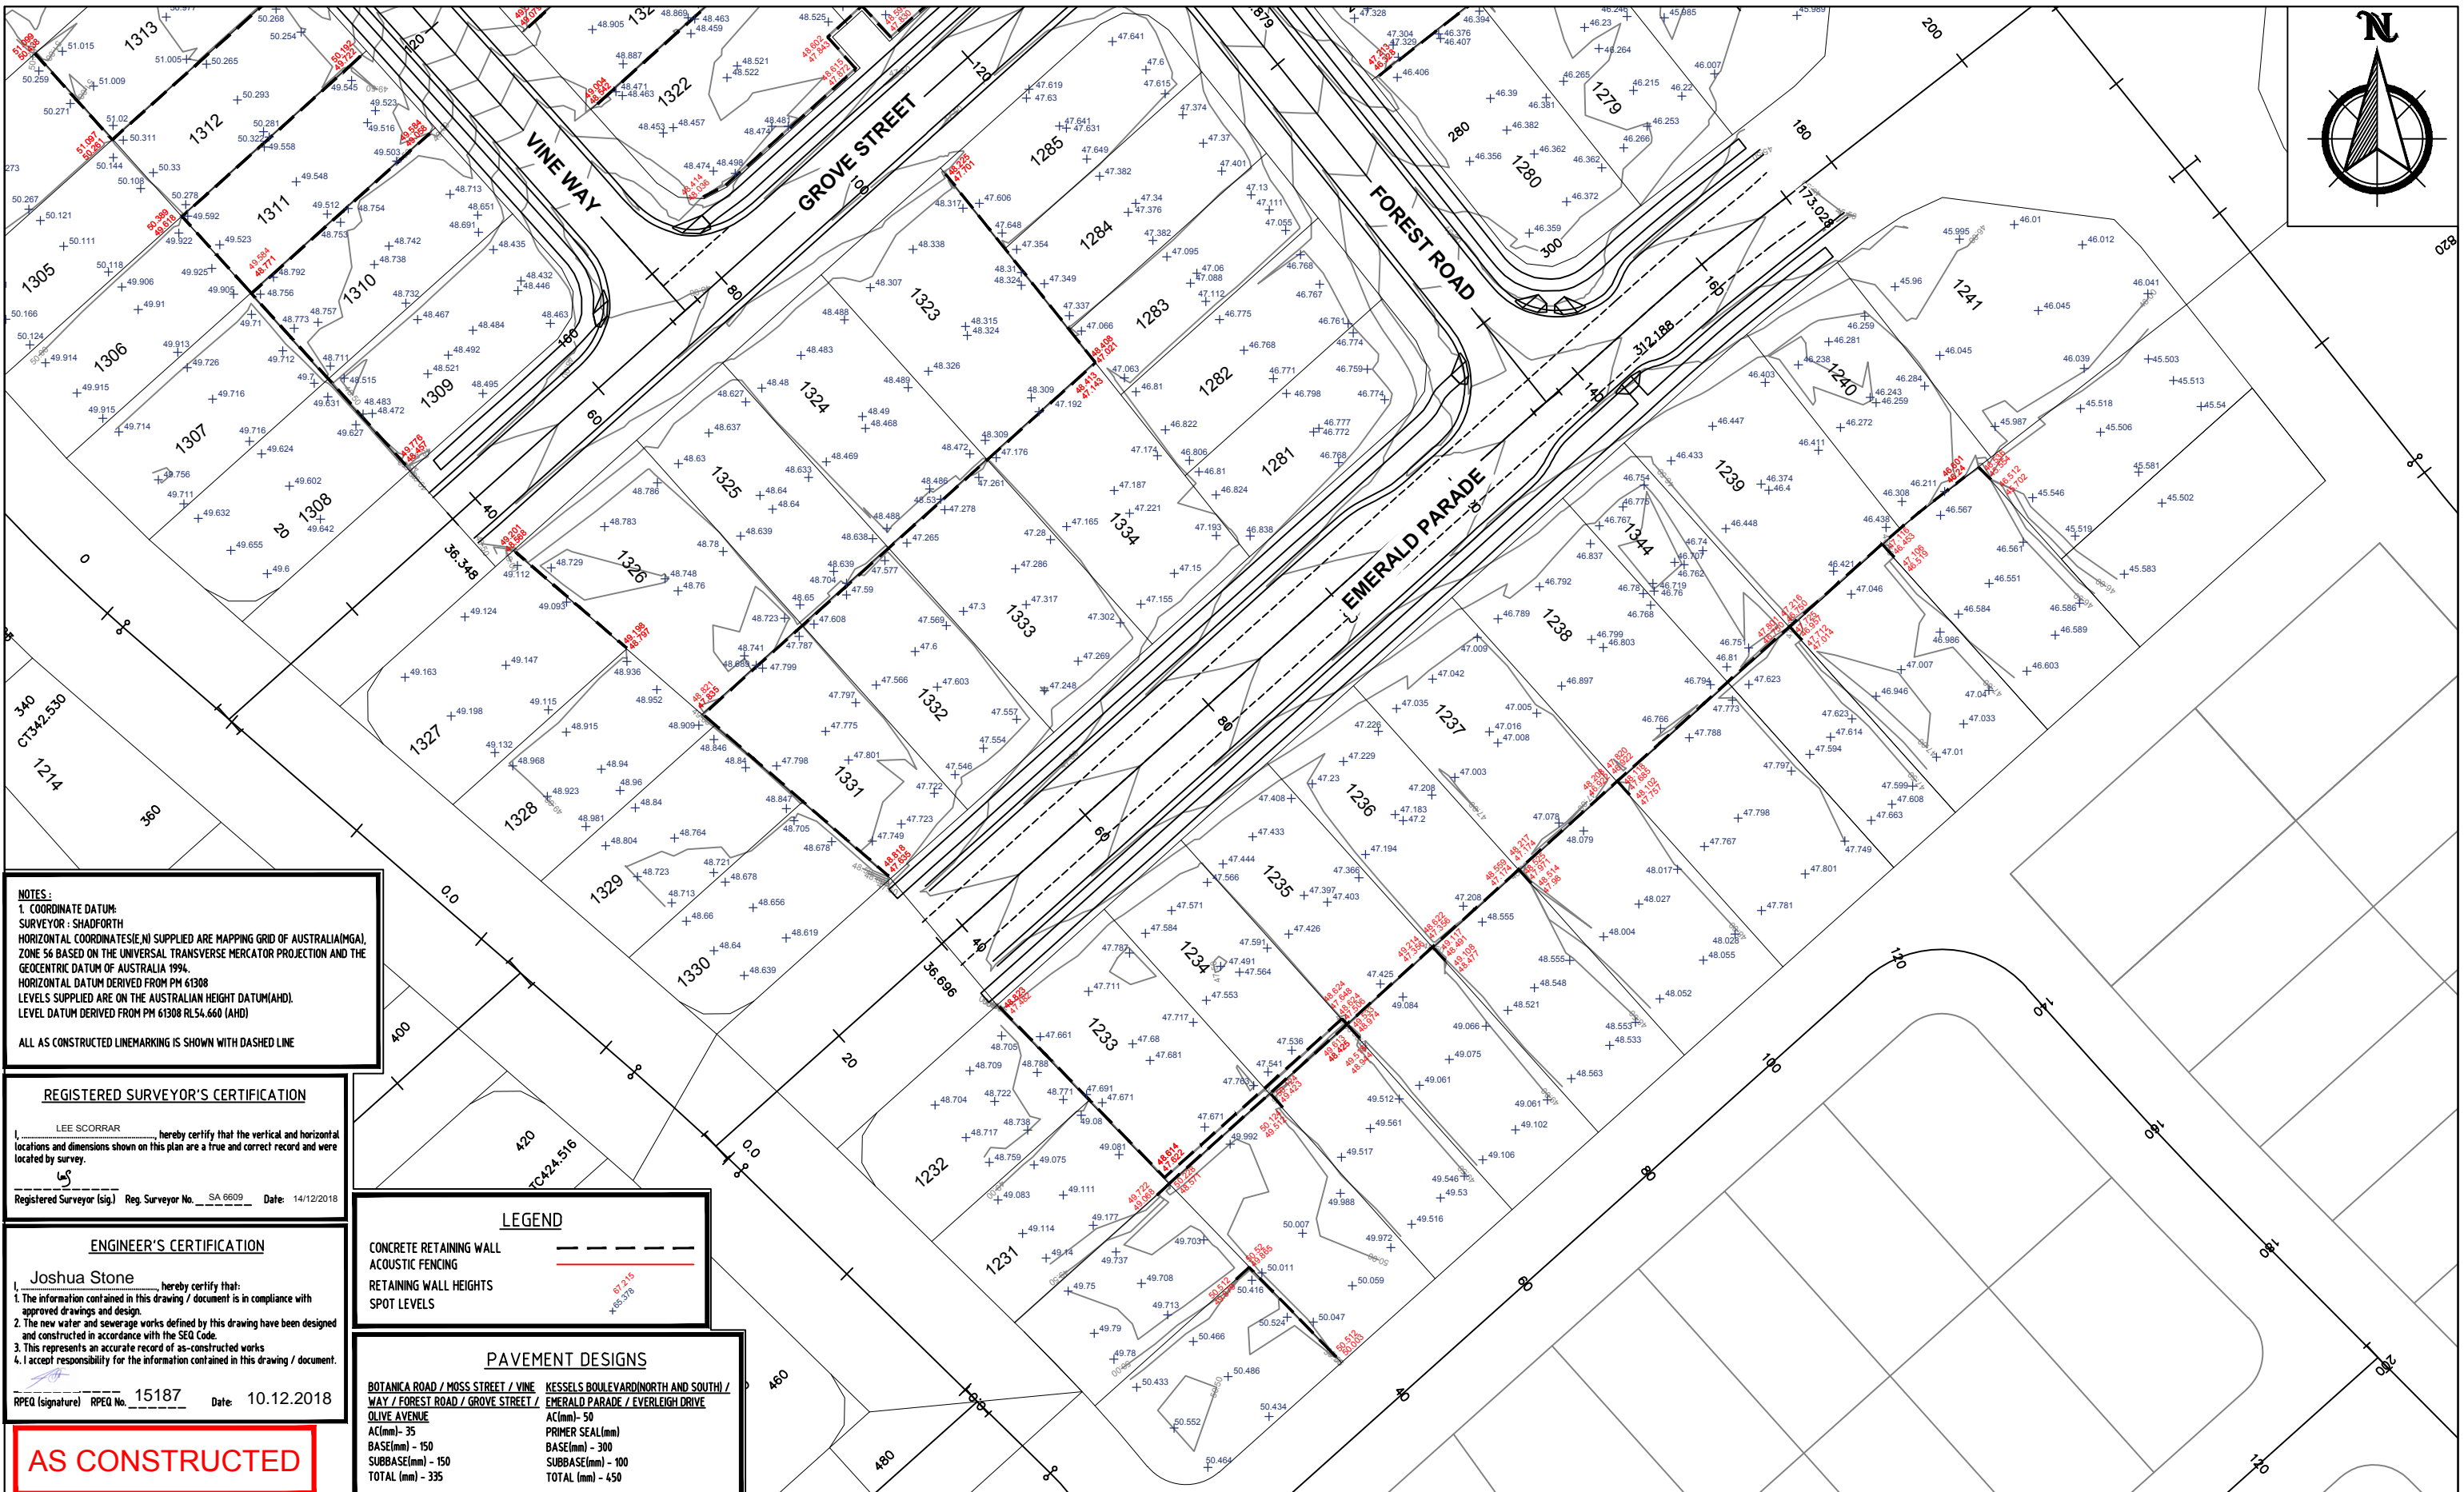

NOTES:
 1. COORDINATE DATUM:
 SURVEYOR: SHADFORTH
 HORIZONTAL COORDINATES(E,N) SUPPLIED ARE MAPPING GRID OF AUSTRALIA(MGA), ZONE 56 BASED ON THE UNIVERSAL TRANSVERSE MERCATOR PROJECTION AND THE GEOCENTRIC DATUM OF AUSTRALIA 1994.
 HORIZONTAL DATUM DERIVED FROM PM 61308
 LEVELS SUPPLIED ARE ON THE AUSTRALIAN HEIGHT DATUM(AHD).
 LEVEL DATUM DERIVED FROM PM 61308 RL54.660 (AHD)
 ALL AS CONSTRUCTED LINEMARKING IS SHOWN WITH DASHED LINE

REGISTERED SURVEYOR'S CERTIFICATION
 I, LEE SCORRAR, hereby certify that the vertical and horizontal locations and dimensions shown on this plan are a true and correct record and were located by survey.
 Registered Surveyor (sig.) Reg. Surveyor No. SA 6609 Date: 14/12/2018

ENGINEER'S CERTIFICATION
 Joshua Stone, hereby certify that:
 1. The information contained in this drawing / document is in compliance with approved drawings and design.
 2. The new water and sewerage works defined by this drawing have been designed and constructed in accordance with the SEQ Code.
 3. This represents an accurate record of as-constructed works
 4. I accept responsibility for the information contained in this drawing / document.
 RPEQ (signature) RPEQ No. 15187 Date: 10.12.2018

AS CONSTRUCTED

LEGEND
 CONCRETE RETAINING WALL
 ACOUSTIC FENCING
 RETAINING WALL HEIGHTS
 SPOT LEVELS

PAVEMENT DESIGNS
 BOTANICA ROAD / MOSS STREET / VINE WAY / FOREST ROAD / GROVE STREET / OLIVE AVENUE
 AC(mm)- 50
 PRIMER SEAL(mm)
 BASE(mm) - 150
 SUBBASE(mm) - 100
 TOTAL (mm) - 335
 KESSELS BOULEVARD(NORTH AND SOUTH) / EMERALD PARADE / EVERLEIGH DRIVE
 AC(mm)- 50
 PRIMER SEAL(mm)
 BASE(mm) - 300
 SUBBASE(mm) - 100
 TOTAL (mm) - 450

ISSUE	DATE	AUTHOR	COMMENTS



99 Sandalwood Lane, Forest Glen QLD 4556
 P: 07 5438 3300 F: 07 5438 3388 E: admin@shadforth.com.au

DRAWING TITLE
AS CONSTRUCTED ROADS & EWKS
 CLIENT
 MIRVAC
 PROJECT
 EVERLEIGH PRECINCT 1.1
 SUBDIVISION INFRASTRUCTURE WORKS

ASSOCIATE CONSULTANT
 PREMISE
 LOCAL GOVERNMENT
 LCC
 SCALE
 0 7.5 15 22.5 30 37.5m
 SCALE 1:750 A3

DATUM
 MGA94 Zone 56
 LEVEL ORIGIN
 PM61308 RL 54.660
 CONTOUR INTERVAL
 MAJ 0.500 MIN 0.250
 DRAWN
 DAM DATE 14/12/2018
 CHECKED
 LS DATE 14/12/2018
 SHEET N°
 6 OF 6
 PLAN NUMBER
ASC-RDS & EWKS-06-1183
 REVISION
 -