



NOTES:
 1. COORDINATE DATUM:
 SURVEYOR : SHADFORTH
 HORIZONTAL COORDINATES(E,N) SUPPLIED ARE MAPPING GRID OF AUSTRALIA(MGA), ZONE 56 BASED ON THE UNIVERSAL TRANSVERSE MERCATOR PROJECTION AND THE GEOCENTRIC DATUM OF AUSTRALIA 1994.
 HORIZONTAL DATUM DERIVED FROM PM 61308
 LEVELS SUPPLIED ARE ON THE AUSTRALIAN HEIGHT DATUM(AHD).
 LEVEL DATUM DERIVED FROM PM 61308 RL54.660 (AHD)
 ALL WATER SERVICE PIPES ARE Ø25 PE100 CLASS PN16 UNLESS OTHERWISE NOTED

REGISTERED SURVEYOR'S CERTIFICATION
 I, LEE SCORRAR, hereby certify that the vertical and horizontal locations and dimensions shown on this plan are a true and correct record and were located by survey.
 Registered Surveyor (sig.) Reg. Surveyor No. SA 6609 Date: 16/11/2018

ENGINEER'S CERTIFICATION
 I, Keith Howells, hereby certify that:
 1. The information contained in this drawing / document is in compliance with approved drawings and design.
 2. The new water and sewerage works defined by this drawing have been designed and constructed in accordance with the SEQ Code.
 3. This represents an accurate record of as-constructed works
 4. I accept responsibility for the information contained in this drawing / document.
 RPEQ (signature) RPEQ No. 7295 Date: 22/11/2018

AS CONSTRUCTED

ISSUE	DATE	AUTHOR	COMMENTS



DRAWING TITLE: **AS CONSTRUCTED WATER**
 CLIENT: **MIRVAC**
 PROJECT: **EVERLEIGH PRECINCT 1.1 SUBDIVISION INFRASTRUCTURE WORKS**

ASSOCIATE CONSULTANT: **PREMISE**
 LOCAL GOVERNMENT: **LCC**
 SCALE: 0 10 20 30 40 50m
 SCALE 1:1000 A3

DATUM: **MGA94 Zone 56**
 LEVEL ORIGIN: **PM61308 RL 54.660**
 CONTOUR INTERVAL: **N/A**
 DRAWN: **DAM** DATE: **16/11/2018**
 CHECKED: **LS** DATE: **16/11/2018**
 SHEET N°: **1 OF 3**
 PLAN NUMBER: **ASC-WATER-01-1183**



NOTES:
 1. COORDINATE DATUM:
 SURVEYOR : SHADFORTH
 HORIZONTAL COORDINATES(E,N) SUPPLIED ARE MAPPING GRID OF AUSTRALIA(MGA),
 ZONE 56 BASED ON THE UNIVERSAL TRANSVERSE MERCATOR PROJECTION AND THE
 GEOCENTRIC DATUM OF AUSTRALIA 1994.
 HORIZONTAL DATUM DERIVED FROM PM 61308
 LEVELS SUPPLIED ARE ON THE AUSTRALIAN HEIGHT DATUM(AHD).
 LEVEL DATUM DERIVED FROM PM 61308 RL54.660 (AHD)
 ALL WATER SERVICE PIPES ARE Ø25 PE100 CLASS PN16 UNLESS OTHERWISE NOTED

REGISTERED SURVEYOR'S CERTIFICATION

I, LEE SCORRAR, hereby certify that the vertical and horizontal locations and dimensions shown on this plan are a true and correct record and were located by survey.
 Registered Surveyor (sig.) Lee Scorrar Reg. Surveyor No. SA 6609 Date: 16/11/2018

ENGINEER'S CERTIFICATION

I, Keith Howells, hereby certify that:
 1. The information contained in this drawing / document is in compliance with approved drawings and design.
 2. The new water and sewerage works defined by this drawing have been designed and constructed in accordance with the SEQ Code.
 3. This represents an accurate record of as-constructed works
 4. I accept responsibility for the information contained in this drawing / document.
 RPEQ (signature) Keith Howells RPEQ No. 7295 Date: 22/11/2018

JOINS DRAWING ASC-WATER-01-1183



AS CONSTRUCTED

ISSUE	DATE	AUTHOR	COMMENTS



shadforth
 99 Sandalwood Lane, Forest Glen QLD 4556
 P: 07 5438 3300 > F: 07 5438 3388 > E: admin@shadforth.com.au

DRAWING TITLE
AS CONSTRUCTED WATER

CLIENT
MIRVAC

PROJECT
**EVERLEIGH PRECINCT 1.1
 SUBDIVISION INFRASTRUCTURE WORKS**

ASSOCIATE CONSULTANT
PREMISE

LOCAL GOVERNMENT
LCC

SCALE

 SCALE 1:1000 A3

DATUM	MGA94 Zone 56
LEVEL ORIGIN	PM61308 RL 54.660
CONTOUR INTERVAL	N/A
DRAWN	DAM DATE 16/11/2018
CHECKED	LS DATE 16/11/2018
SHEET N°	2 OF 3
PLAN NUMBER	ASC-WATER-02-1183
REVISION	-



NOTES:
 1. COORDINATE DATUM:
 SURVEYOR : SHADFORTH
 HORIZONTAL COORDINATES(E,N) SUPPLIED ARE MAPPING GRID OF AUSTRALIA(MGA),
 ZONE 56 BASED ON THE UNIVERSAL TRANSVERSE MERCATOR PROJECTION AND THE
 GEOCENTRIC DATUM OF AUSTRALIA 1994.
 HORIZONTAL DATUM DERIVED FROM PM 61308
 LEVELS SUPPLIED ARE ON THE AUSTRALIAN HEIGHT DATUM(AHD).
 LEVEL DATUM DERIVED FROM PM 61308 RL54.660 (AHD)


ALL WATER SERVICE PIPES ARE Ø25 PE100 CLASS PN16 UNLESS OTHERWISE NOTED

REGISTERED SURVEYOR'S CERTIFICATION

I, LEE SCORRAR, hereby certify that the vertical and horizontal locations and dimensions shown on this plan are a true and correct record and were located by survey.
 Registered Surveyor (sig.) Reg. Surveyor No. SA 6609 Date: 16/11/2018

ENGINEER'S CERTIFICATION

I, Keith Howells, hereby certify that:
 1. The information contained in this drawing / document is in compliance with approved drawings and design.
 2. The new water and sewerage works defined by this drawing have been designed and constructed in accordance with the SEQ Code.
 3. This represents an accurate record of as-constructed works
 4. I accept responsibility for the information contained in this drawing / document.
 RPEQ (signature) RPEQ No. 7295 Date: 22/11/2018

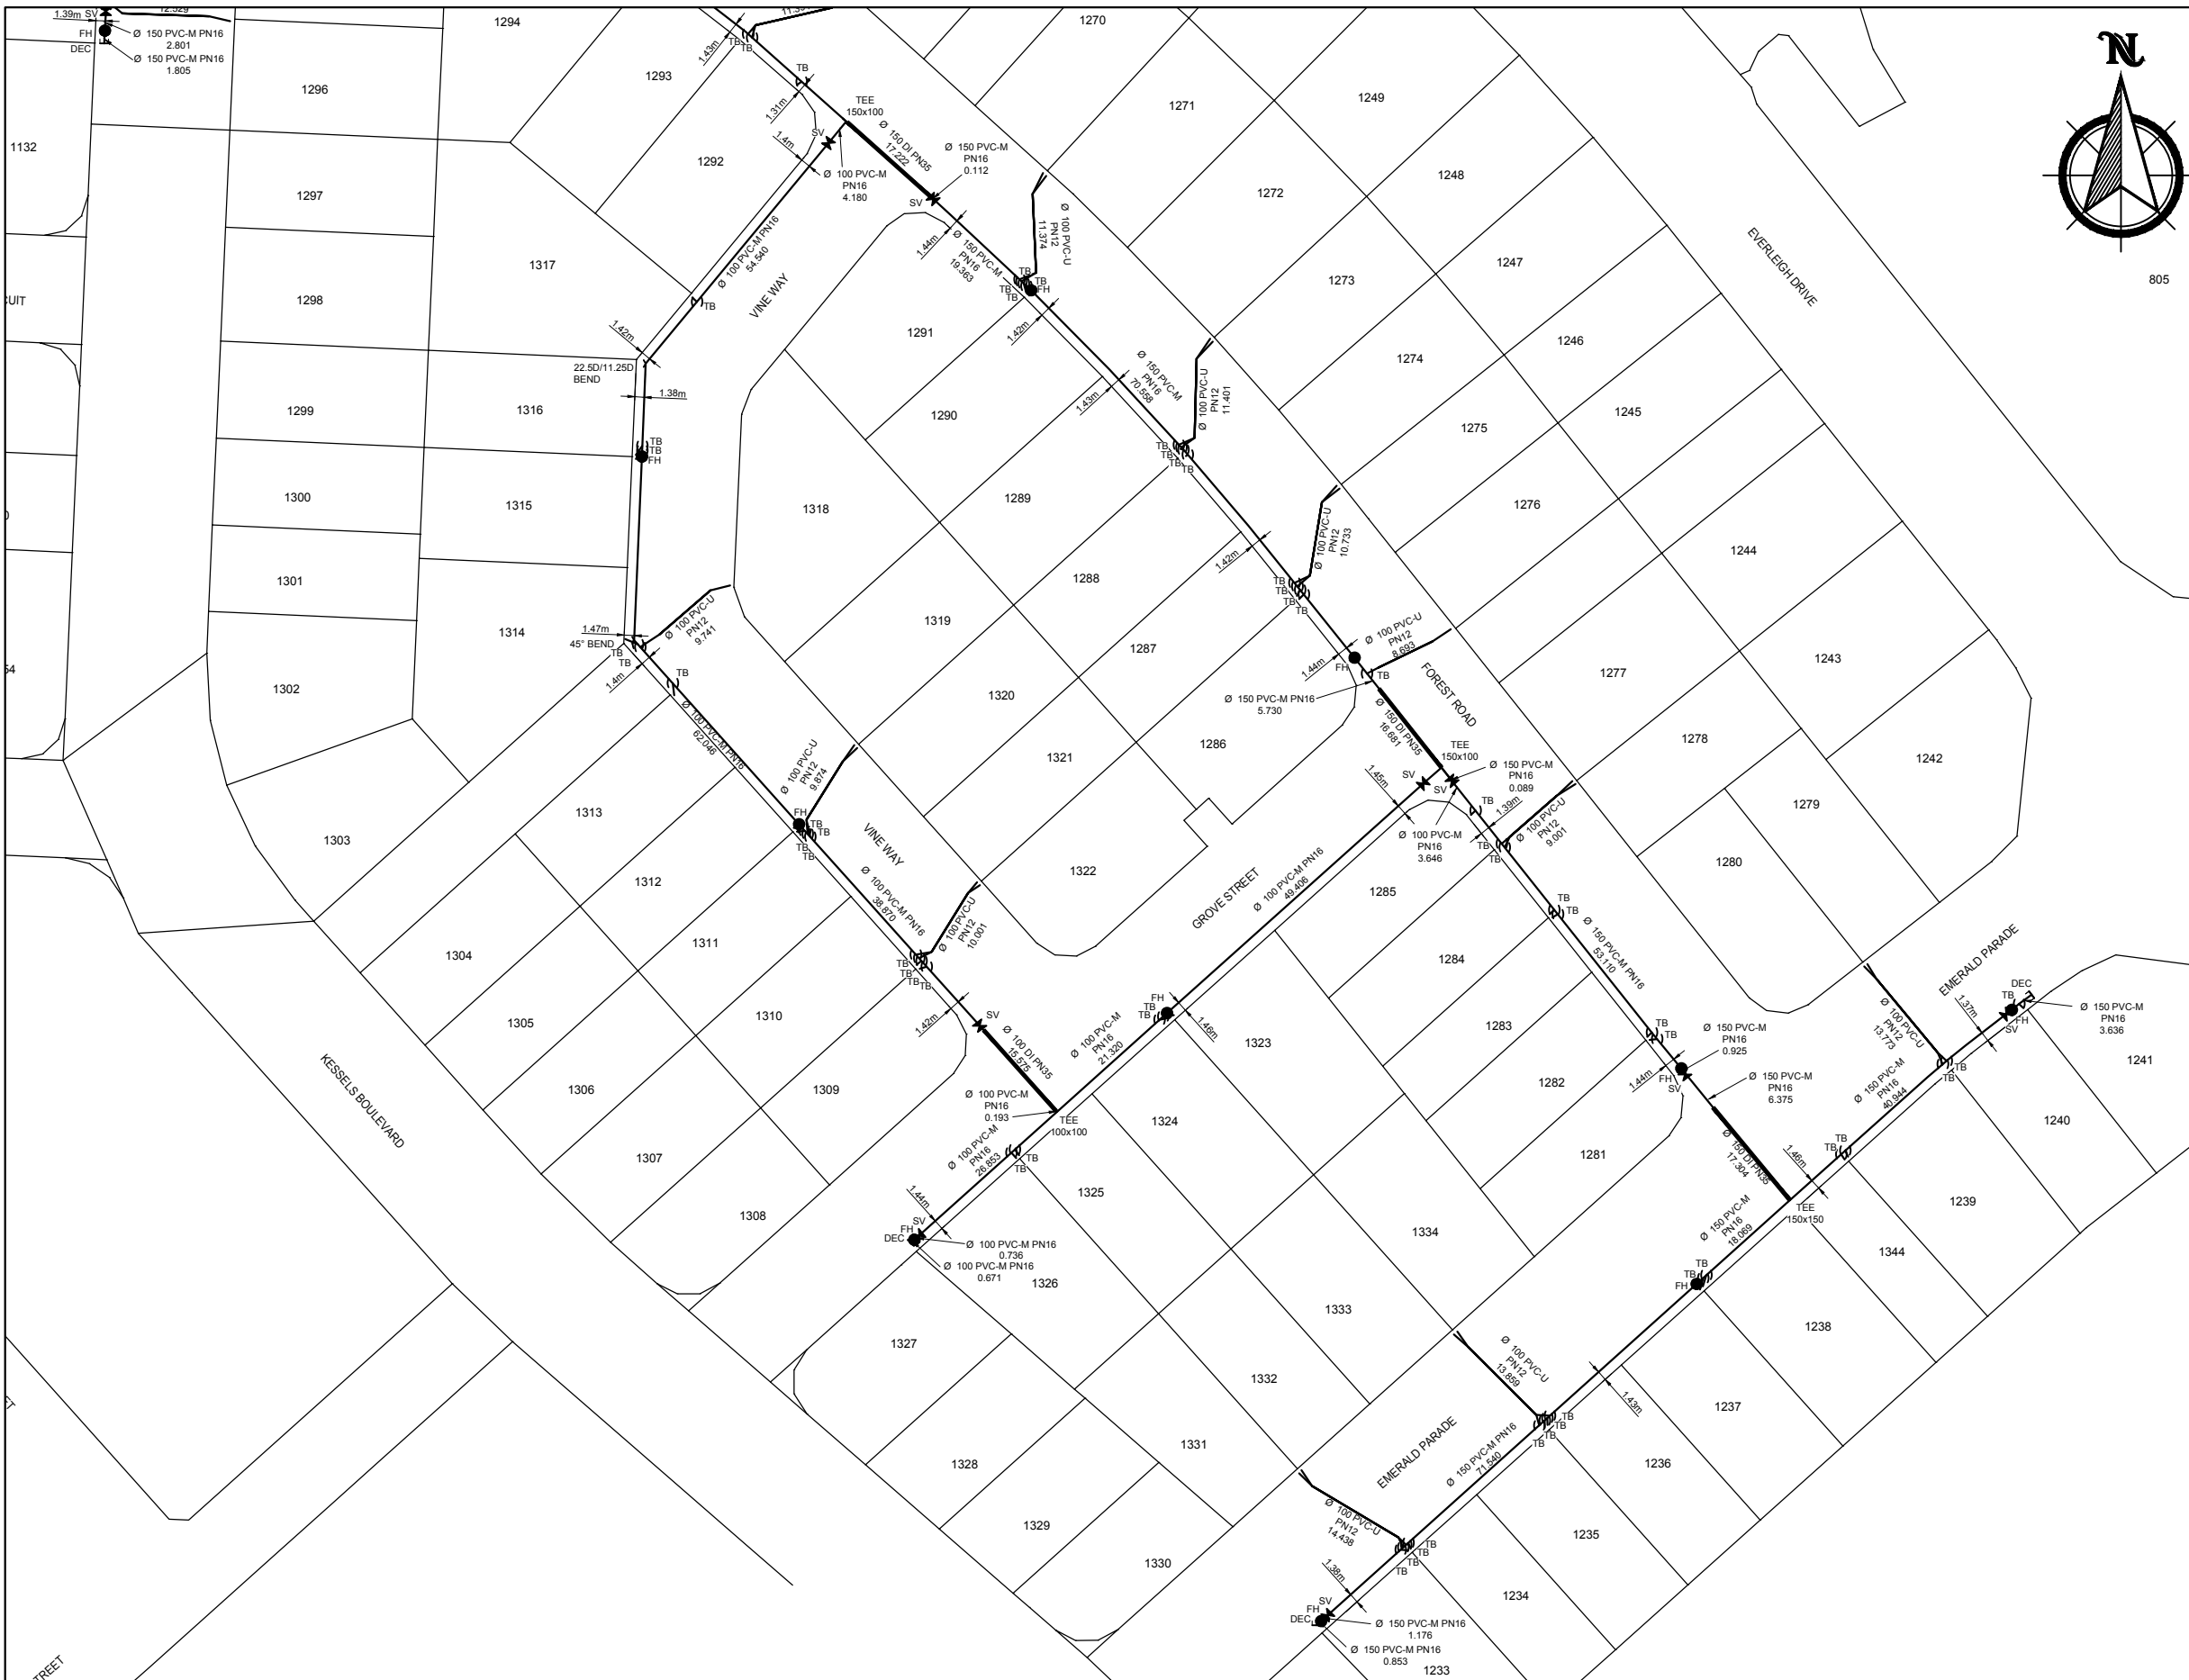

AS CONSTRUCTED

ISSUE	DATE	AUTHOR	COMMENTS

99 Sandalwood Lane, Forest Glen QLD 4556
 P: 07 5438 3300 > F: 07 5438 3388 > E: admin@shadcivil.com.au

DRAWING TITLE
AS CONSTRUCTED WATER

CLIENT
MIRVAC

PROJECT
**EVERLEIGH PRECINCT 1.1
 SUBDIVISION INFRASTRUCTURE WORKS**

ASSOCIATE CONSULTANT
PREMISE

LOCAL GOVERNMENT
LCC

SCALE

 SCALE 1:1000 A3

DATUM	MGA94 Zone 56
LEVEL ORIGIN	PM61308 RL 54.660
CONTOUR INTERVAL	N/A
DRAWN	DAM DATE 16/11/2018
CHECKED	LS DATE 16/11/2018
SHEET N°	3 OF 3
PLAN NUMBER	ASC-WATER-03-1183
REVISION	-