

PAVEMENT DESIGN				
<b>KESSELS BLVD</b>	<b>AMAZON WAY</b>	<b>EMERALD PARADE</b>	<b>HEDGE LANE</b>	<b>RETAINING WALLS</b>
AC(mm) - 50	AC(mm) - 35	AC(mm) - 50	AC(mm) - 35	-----
BASE(2.1)(mm) - 300	BASE(2.1)(mm) - 150	BASE(2.1)(mm) - 300	BASE(2.1)(mm) - 150	
SUBBASE(2.3)(mm) - 100	SUBBASE(2.3)(mm) - 150	SUBBASE(2.3)(mm) - 100	SUBBASE(2.3)(mm) - 150	
<b>GROVE STREET</b>	<b>LEAF STREET</b>	<b>GRASS LANE</b>	<b>TEAL CIRCUIT</b>	<b>DRIVEWAY 3</b>
AC(mm) - 35	AC(mm) - 35	AC(mm) - 35	AC(mm) - 35	AC(mm) - 35
BASE(2.1)(mm) - 150	BASE(2.1)(mm) - 150	BASE(2.1)(mm) - 150	BASE(2.1)(mm) - 150	BASE(2.1)(mm) - 150
SUBBASE(2.3)(mm) - 150	SUBBASE(2.3)(mm) - 150	SUBBASE(2.3)(mm) - 150	SUBBASE(2.3)(mm) - 150	SUBBASE(2.3)(mm) - 150

**REGISTERED SURVEYOR'S CERTIFICATION**

I, Gordon Nicholson, hereby certify that the vertical and horizontal locations and dimensions shown on this plan are a true and correct record and were located by survey.

Registered Surveyor (sig.) Reg. Surveyor No. SA 3405 Date: 11/12/2020

**COORDINATE DATUM NOTE:**



HORIZONTAL COORDINATES (N) SUPPLIED ARE MAPPING GRID OF AUSTRALIA (MGA), ZONE 56 BASED ON THE UNIVERSAL TRANSVERSE MERCATOR PROJECTION AND THE GEOCENTRIC DATUM OF AUSTRALIA 1994.  
 HORIZONTAL DATUM DERIVED FROM PSM 61308 E 498528.114 N 6931171.033.  
 LEVELS SUPPLIED ARE ON THE AUSTRALIAN HEIGHT DATUM (AHD) LEVEL DATUM DERIVED FROM PSM 61308 RL54.660 (AHD)

**AS CONSTRUCTED CERTIFICATION**

I, Patrick Brady, hereby certify that:

- The information contained in this drawing/document is generally in compliance with approved drawings and design.
- To the best of my knowledge, this represents an accurate record of as constructed works and I accept the responsibility for the information contained in this drawing/document. Excluding Survey Error.

7112 11/01/2021  
 RPEQ No. .... Date.....  
 RPEQ (Signature)

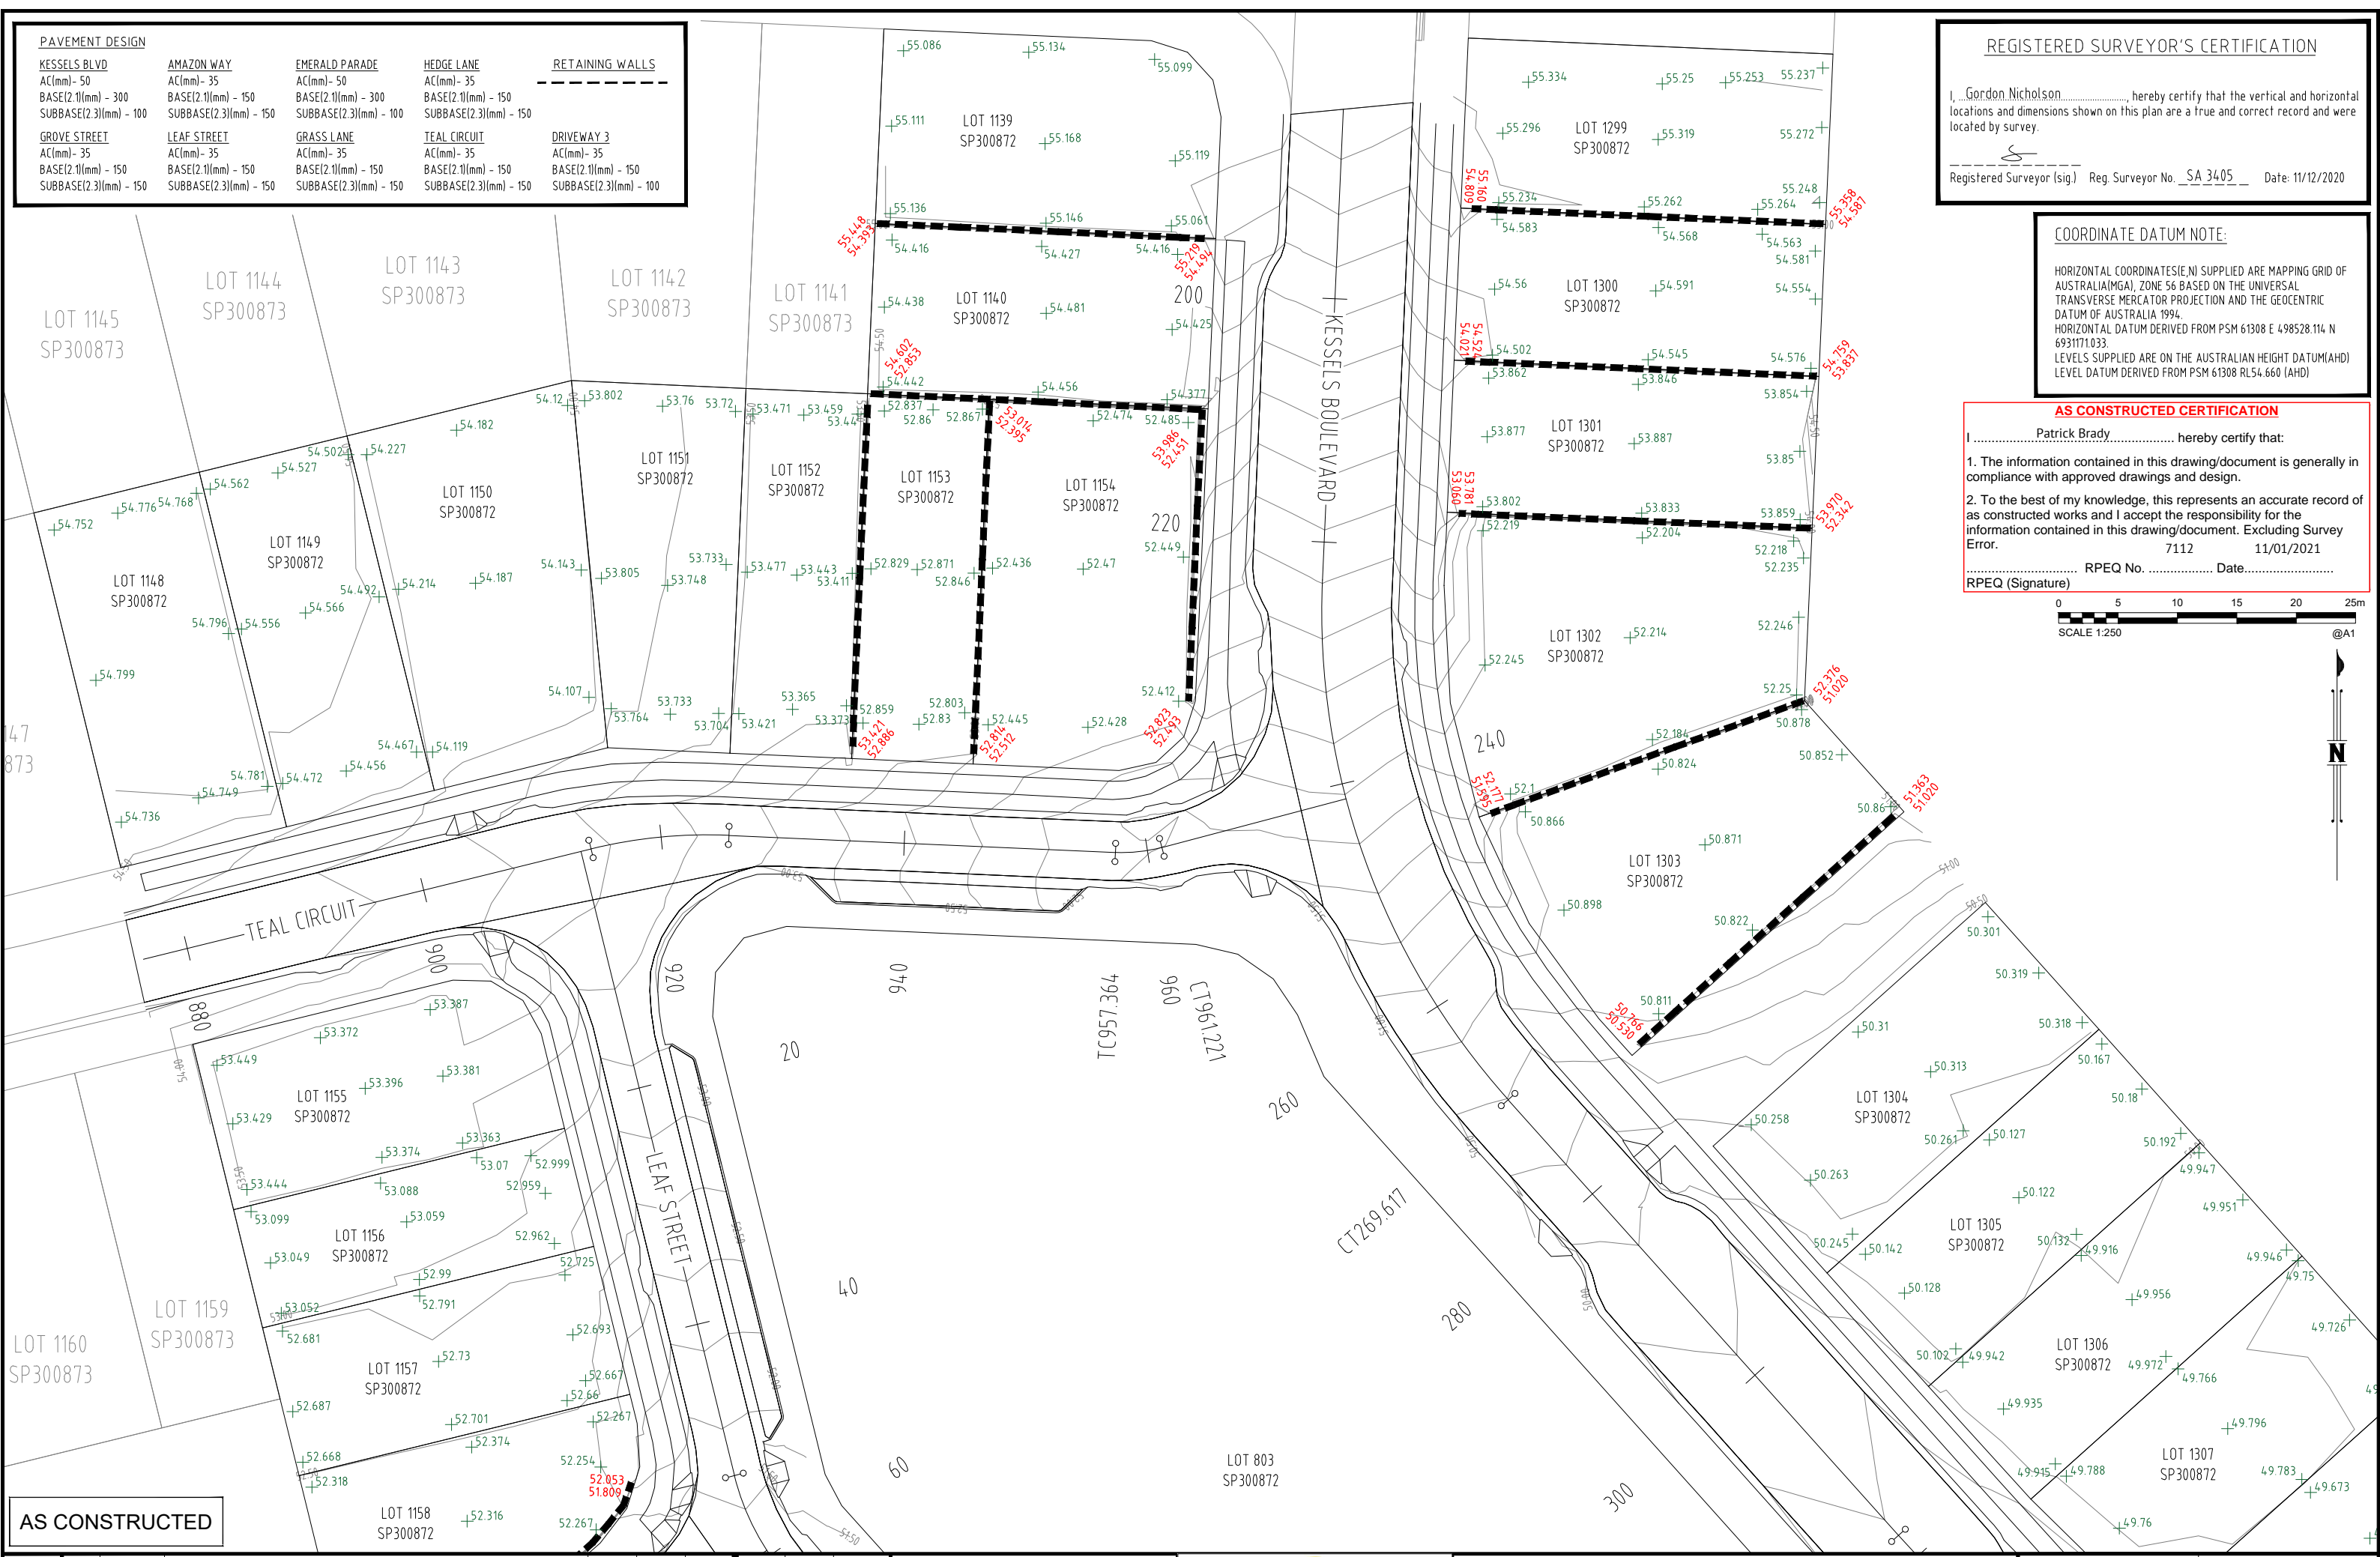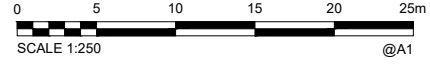

**AS CONSTRUCTED**

<b>A1</b>	INDEX	DATE	REVISIONS	DRAWN	CHECKED	PASSED	INITIALS	DATE
	A	11/12/2020	AS CONSTRUCTED	DAM	-	CW		

**shadforth**


39 Shadforth Lane, Forest Glen QLD 4055  
 07 5488 3300 • 07 5488 3388 • shadforth@shadforth.com.au

**LOGAN CITY COUNCIL**

**LOGAN CITY COUNCIL**

MIRVAC MIR001-02B  
 AS CONSTRUCTED SURVEY - ROADS AND EARTHWORKS  
 EVERLEIGH PRECINCT 1.2B  
 GREENBANK QLD

SHEET 2 OF 4 SHEETS	SCALE 1:250 A1
REVISION DATE 11/12/2020	REVISION A
DISCIPLINE CODE -	
DRAWING NO.	
<b>ASC-RDS AND EW-02-1.2B</b>	

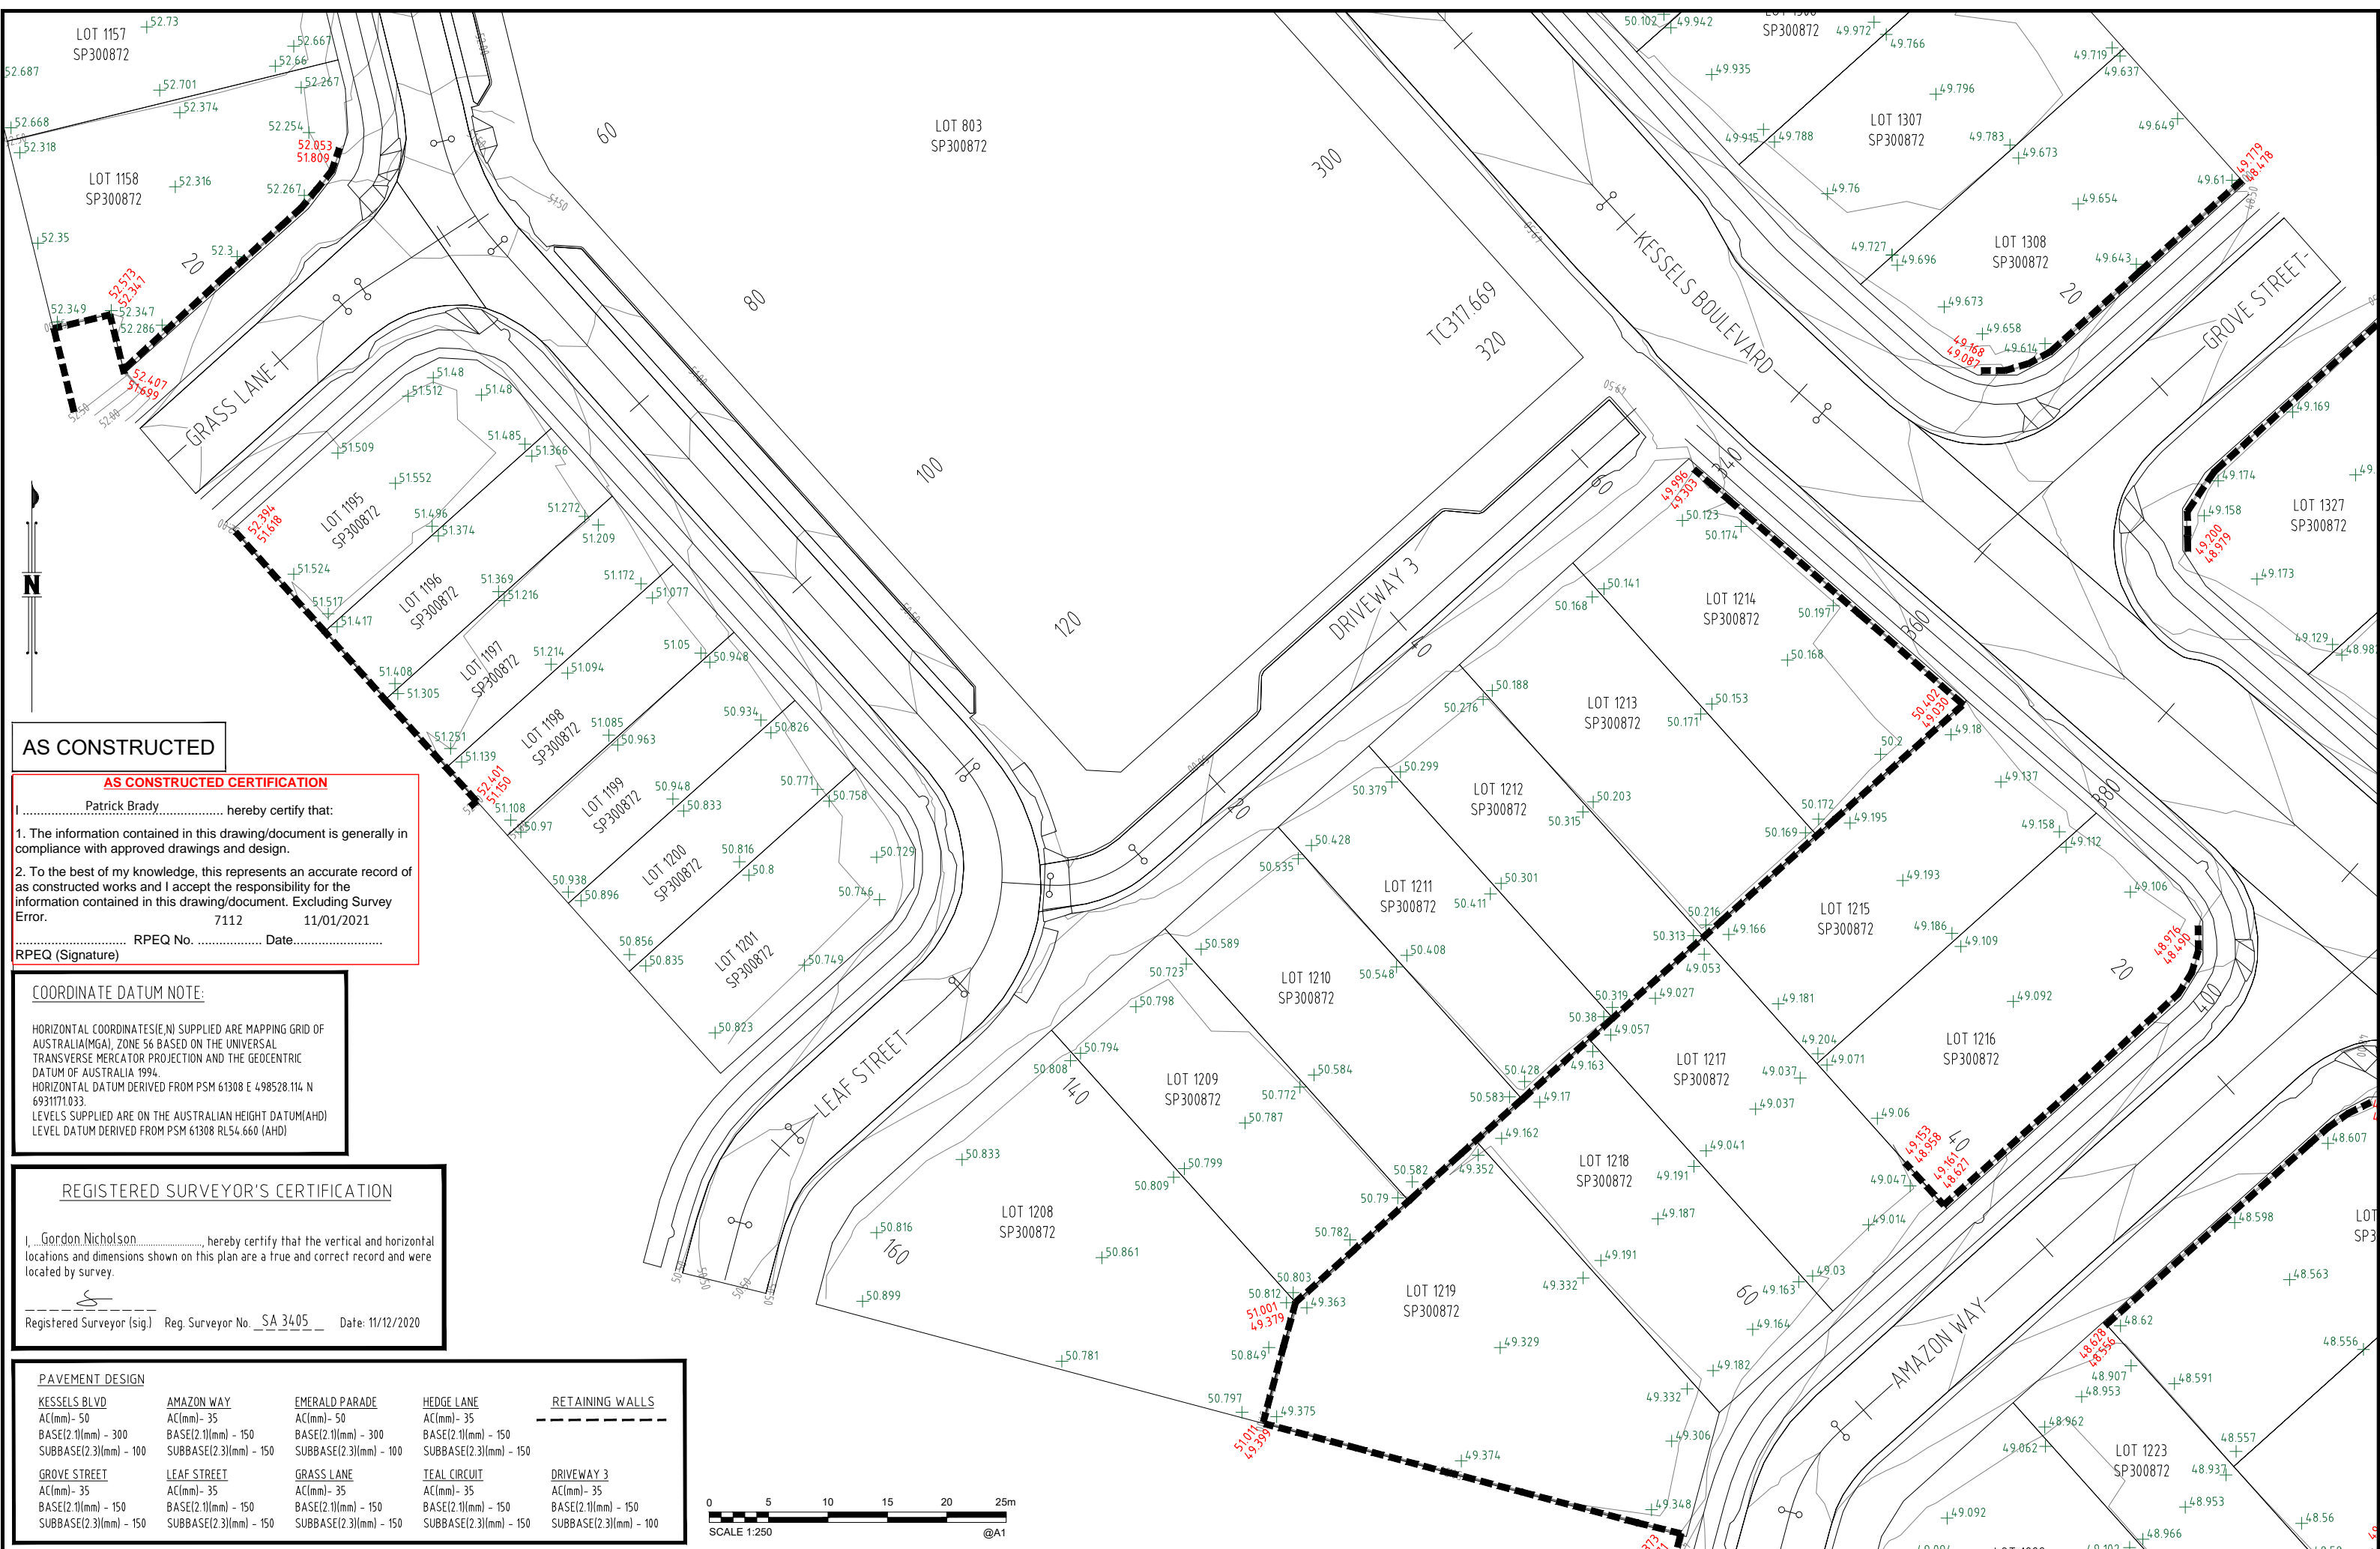

**AS CONSTRUCTED**

**AS CONSTRUCTED CERTIFICATION**

I, Patrick Brady, hereby certify that:

- The information contained in this drawing/document is generally in compliance with approved drawings and design.
- To the best of my knowledge, this represents an accurate record of as constructed works and I accept the responsibility for the information contained in this drawing/document. Excluding Survey Error.

7112      11/01/2021

RPEQ No. \_\_\_\_\_ Date: \_\_\_\_\_

RPEQ (Signature) \_\_\_\_\_

**COORDINATE DATUM NOTE:**

HORIZONTAL COORDINATES (E/N) SUPPLIED ARE MAPPING GRID OF AUSTRALIA (MGA), ZONE 56 BASED ON THE UNIVERSAL TRANSVERSE MERCATOR PROJECTION AND THE GEOCENTRIC DATUM OF AUSTRALIA 1994.

HORIZONTAL DATUM DERIVED FROM PSM 61308 E 498528.114 N 6931171.033.


LEVELS SUPPLIED ARE ON THE AUSTRALIAN HEIGHT DATUM (AHD) LEVEL DATUM DERIVED FROM PSM 61308 RL54.660 (AHD)

**REGISTERED SURVEYOR'S CERTIFICATION**

I, Gordon Nicholson, hereby certify that the vertical and horizontal locations and dimensions shown on this plan are a true and correct record and were located by survey.

Registered Surveyor (Sig) \_\_\_\_\_ Reg. Surveyor No. SA 3405      Date: 11/12/2020

PAVEMENT DESIGN		RETAINING WALLS	
<b>KESSELS BLVD</b> AC(mm) - 50 BASE(2.1l(mm) - 300 SUBBASE(2.3l(mm) - 100	<b>AMAZON WAY</b> AC(mm) - 35 BASE(2.1l(mm) - 150 SUBBASE(2.3l(mm) - 150	<b>EMERALD PARADE</b> AC(mm) - 50 BASE(2.1l(mm) - 300 SUBBASE(2.3l(mm) - 100	<b>HEDGE LANE</b> AC(mm) - 35 BASE(2.1l(mm) - 150 SUBBASE(2.3l(mm) - 150
<b>GROVE STREET</b> AC(mm) - 35 BASE(2.1l(mm) - 150 SUBBASE(2.3l(mm) - 150	<b>LEAF STREET</b> AC(mm) - 35 BASE(2.1l(mm) - 150 SUBBASE(2.3l(mm) - 150	<b>GRASS LANE</b> AC(mm) - 35 BASE(2.1l(mm) - 150 SUBBASE(2.3l(mm) - 150	<b>TEAL CIRCUIT</b> AC(mm) - 35 BASE(2.1l(mm) - 150 SUBBASE(2.3l(mm) - 150
			<b>DRIVEWAY 3</b> AC(mm) - 35 BASE(2.1l(mm) - 150 SUBBASE(2.3l(mm) - 100

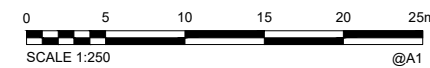


<b>A1</b>											
	-	-	-	-	-	-	-	-	-	-	-
	A	11/12/2020	AS CONSTRUCTED		DAM	-	CW		DRAWN	CHECKED	PASSED
INDEX	DATE	REVISIONS		DRAWN	CHECKED	PASSED		INITIALS	DATE		

59 Southwood Lane, Forest Glen QLD 4056  
07 4383 2300 • 07 4383 2388 • info@shadforth.com.au

**LOGAN CITY COUNCIL**

MIRVAC MIR001-02B  
AS CONSTRUCTED SURVEY - ROADS AND EARTHWORKS  
EVERLEIGH PRECINCT 1.2B  
GREENBANK QLD

SHEET 3 OF 4 SHEETS	SCALE 1:250 A1
REVISION DATE 11/12/2020	REVISION A
DISCIPLINE CODE -	
DRAWING NO.	
<b>ASC-RDS AND EW-03-1.2B</b>	

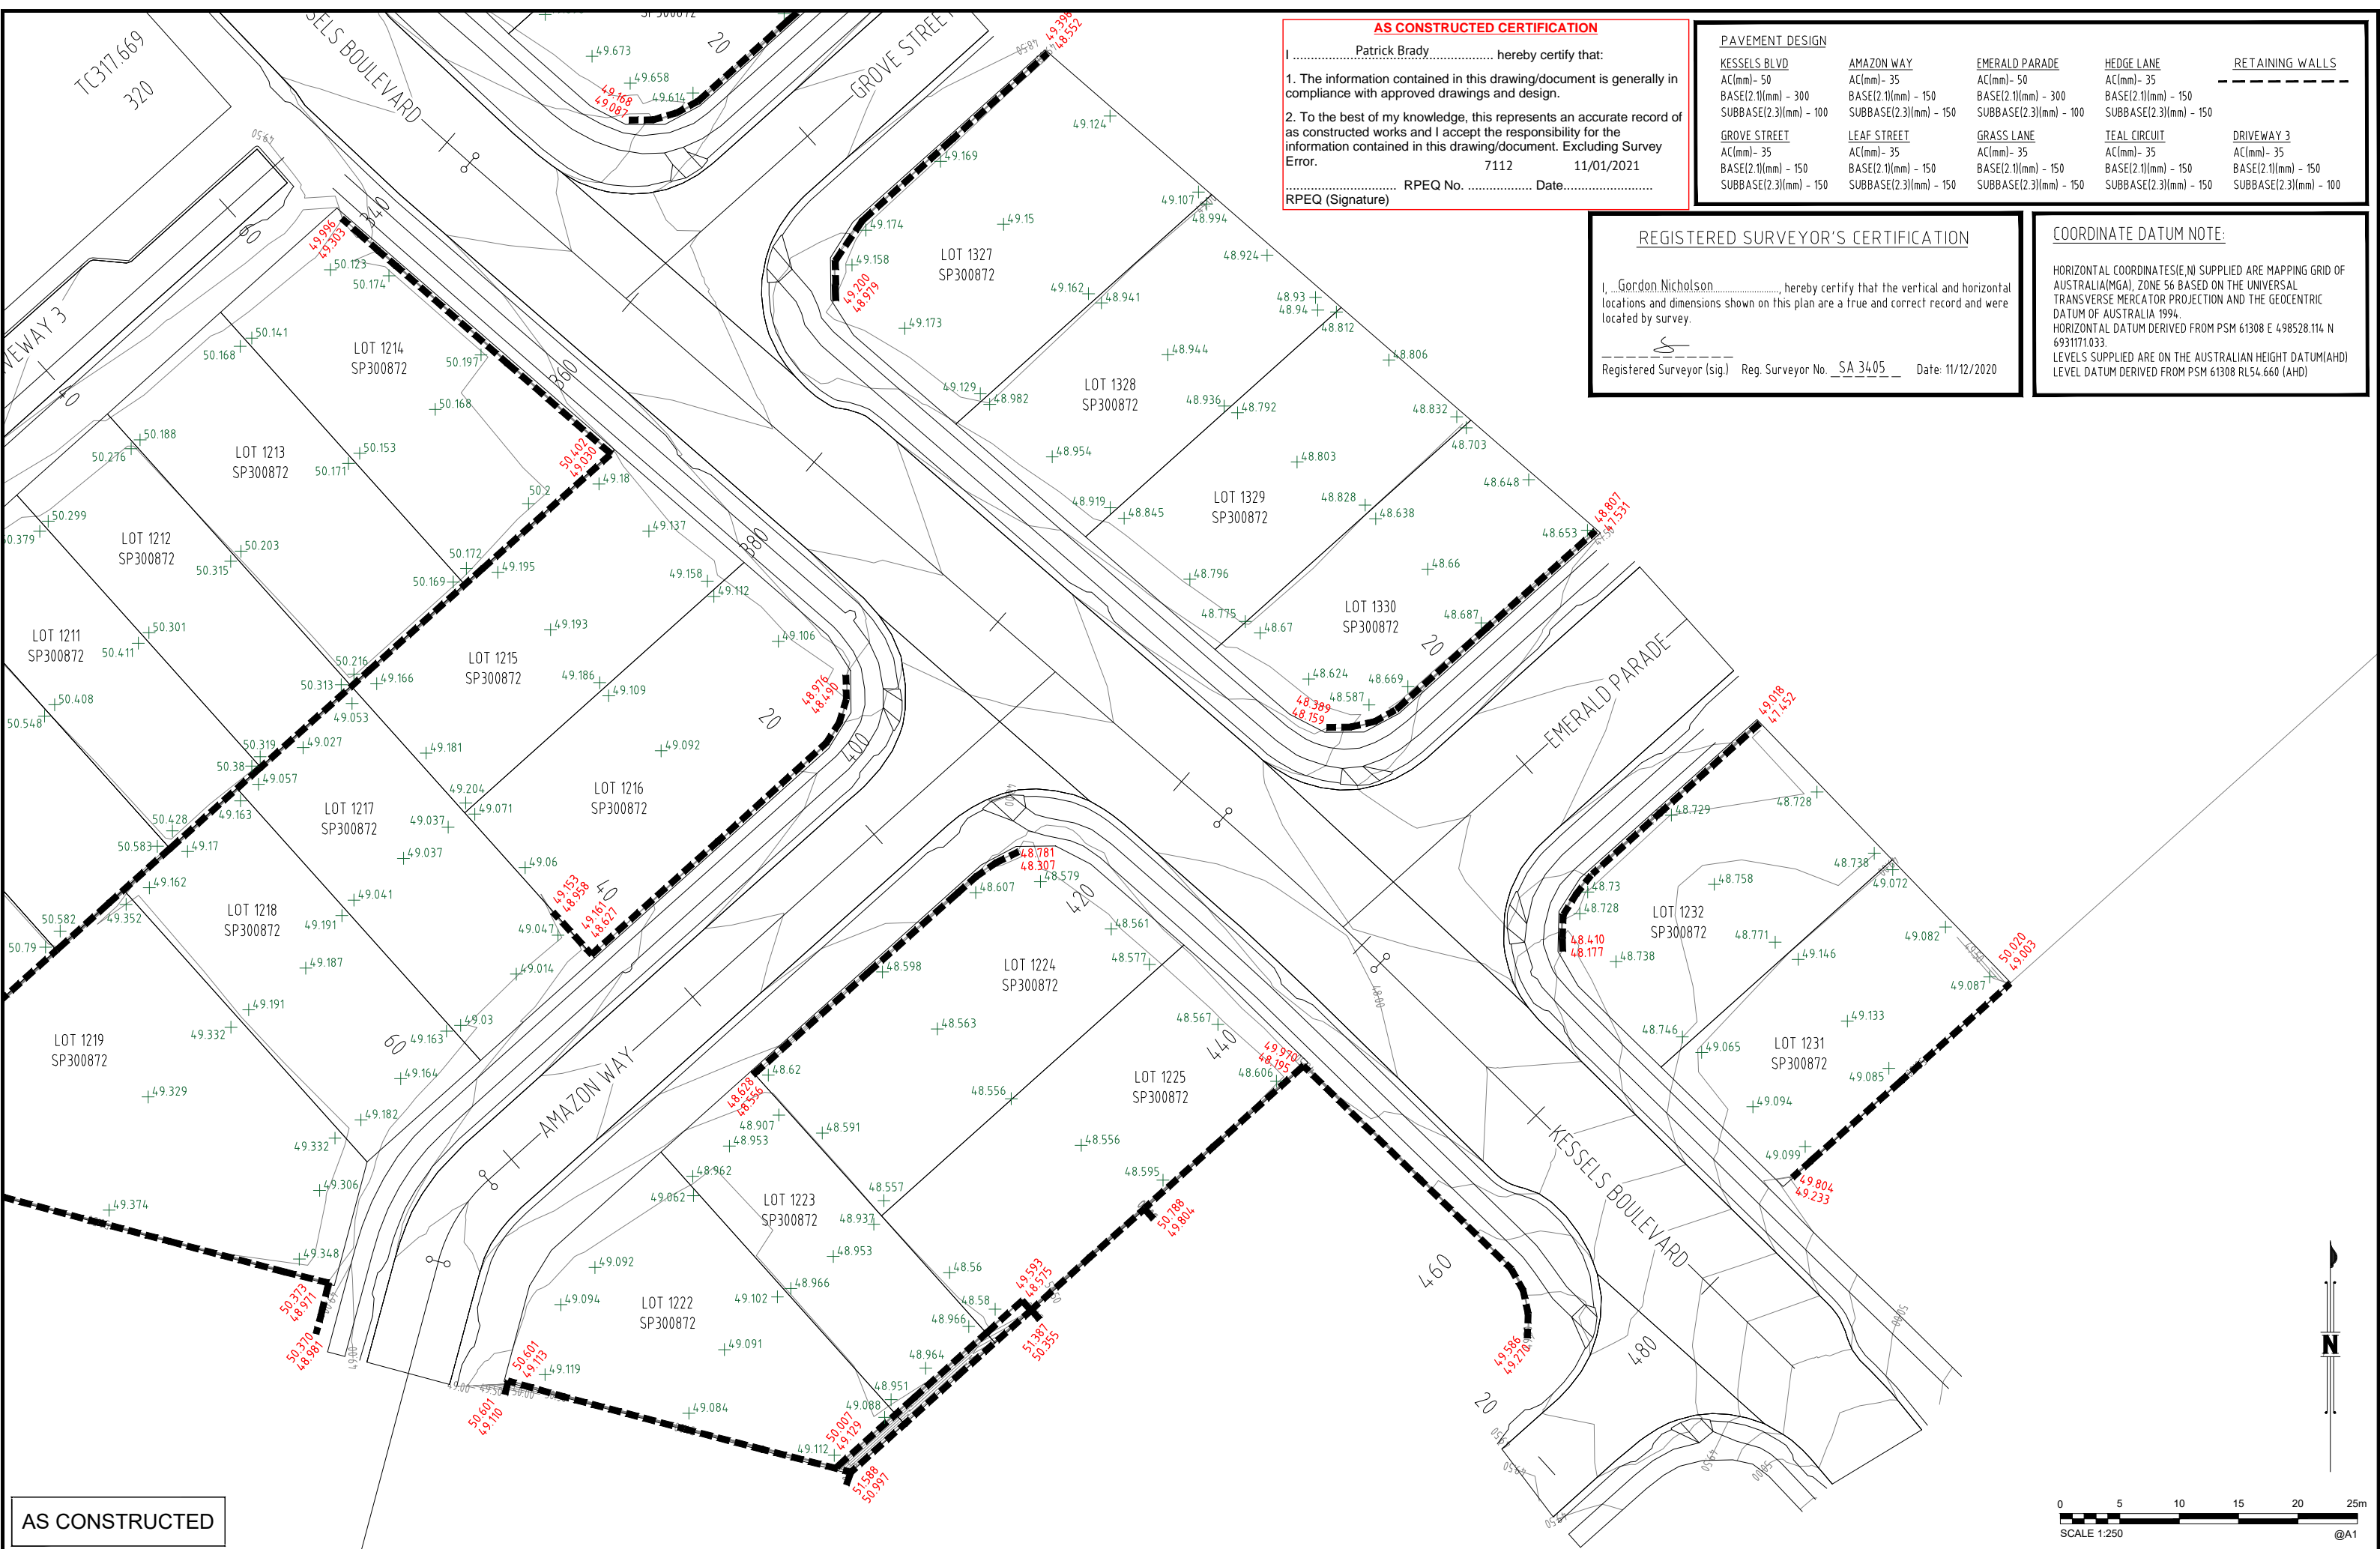

**AS CONSTRUCTED CERTIFICATION**

I, Patrick Brady, hereby certify that:

- The information contained in this drawing/document is generally in compliance with approved drawings and design.
- To the best of my knowledge, this represents an accurate record of as constructed works and I accept the responsibility for the information contained in this drawing/document. Excluding Survey Error.

7112 11/01/2021

RPEQ No. Date

RPEQ (Signature)

PAVEMENT DESIGN				
<b>KESSELS BLVD</b>	<b>AMAZON WAY</b>	<b>EMERALD PARADE</b>	<b>HEDGE LANE</b>	<b>RETAINING WALLS</b>
AC(mm)- 50	AC(mm)- 35	AC(mm)- 50	AC(mm)- 35	---
BASE(2.1l(mm) - 300	BASE(2.1l(mm) - 150	BASE(2.1l(mm) - 300	BASE(2.1l(mm) - 150	---
SUBBASE(2.3l(mm) - 100	SUBBASE(2.3l(mm) - 150	SUBBASE(2.3l(mm) - 100	SUBBASE(2.3l(mm) - 150	---
<b>GROVE STREET</b>	<b>LEAF STREET</b>	<b>GRASS LANE</b>	<b>TEAL CIRCUIT</b>	<b>DRIVEWAY 3</b>
AC(mm)- 35	AC(mm)- 35	AC(mm)- 35	AC(mm)- 35	AC(mm)- 35
BASE(2.1l(mm) - 150	BASE(2.1l(mm) - 150	BASE(2.1l(mm) - 150	BASE(2.1l(mm) - 150	BASE(2.1l(mm) - 150
SUBBASE(2.3l(mm) - 150	SUBBASE(2.3l(mm) - 150	SUBBASE(2.3l(mm) - 150	SUBBASE(2.3l(mm) - 150	SUBBASE(2.3l(mm) - 100

**REGISTERED SURVEYOR'S CERTIFICATION**

I, Gordon Nicholson, hereby certify that the vertical and horizontal locations and dimensions shown on this plan are a true and correct record and were located by survey.

Registered Surveyor (sig.) Reg. Surveyor No. SA 3405 Date: 11/12/2020


**COORDINATE DATUM NOTE:**

HORIZONTAL COORDINATES (E, N) SUPPLIED ARE MAPPING GRID OF AUSTRALIA (MGA), ZONE 56 BASED ON THE UNIVERSAL TRANSVERSE MERCATOR PROJECTION AND THE GEOCENTRIC DATUM OF AUSTRALIA 1994.

HORIZONTAL DATUM DERIVED FROM PSM 61308 E 4 98528 114 N 6931171 033.

LEVELS SUPPLIED ARE ON THE AUSTRALIAN HEIGHT DATUM (AHD) LEVEL DATUM DERIVED FROM PSM 61308 RL 54.660 (AHD)

AS CONSTRUCTED

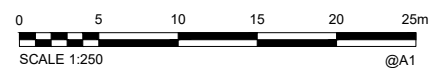

A1	INDEX	DATE	REVISIONS	DRAWN	CHECKED	PASSED	INITIALS	DATE
	-	-	-	-	-	-	-	-
	A	11/12/2020	AS CONSTRUCTED	DAM	-	CW	-	11/12/2020



**LOGAN CITY COUNCIL**

MIRVAC MIR001-02B  
AS CONSTRUCTED SURVEY - ROADS AND EARTHWORKS  
EVERLEIGH PRECINCT 1.2B  
GREENBANK QLD

SHEET 4 OF 4 SHEETS	SCALE 1:250 A1
REVISION DATE 11/12/2020	REVISION A
DISCIPLINE CODE -	
DRAWING NO. ASC-RDS AND EW-04-1.2B	



**AS CONSTRUCTED CERTIFICATION**

I, Patrick Brady, hereby certify that:

- The information contained in this drawing/document is generally in compliance with approved drawings and design.
- To the best of my knowledge, this represents an accurate record of as constructed works and I accept the responsibility for the information contained in this drawing/document. Excluding Survey Error. 7112 11/01/2021

..... RPEQ No. .... Date.....  
 RPEQ (Signature)

**REGISTERED SURVEYOR'S CERTIFICATION**


I, Gordon Nicholson, hereby certify that the vertical and horizontal locations and dimensions shown on this plan are a true and correct record and were located by survey.

.....  
 Registered Surveyor (sig.) Reg. Surveyor No. SA 3405 Date: 11/12/2020

**COORDINATE DATUM NOTE:**

HORIZONTAL COORDINATES (E,N) SUPPLIED ARE MAPPING GRID OF AUSTRALIA (MGA), ZONE 56 BASED ON THE UNIVERSAL TRANSVERSE MERCATOR PROJECTION AND THE GEOCENTRIC DATUM OF AUSTRALIA 1994.  
 HORIZONTAL DATUM DERIVED FROM PSM 61308 E 498528.114 N 6931171.033.  
 LEVELS SUPPLIED ARE ON THE AUSTRALIAN HEIGHT DATUM (AHD) LEVEL DATUM DERIVED FROM PSM 61308 RL54.660 (AHD)

PAVEMENT DESIGN		RETAINING WALLS	
<b>KESSELS BLVD</b> AC(mm) - 50 BASE(2.1)(mm) - 300 SUBBASE(2.3)(mm) - 100	<b>AMAZON WAY</b> AC(mm) - 35 BASE(2.1)(mm) - 150 SUBBASE(2.3)(mm) - 150	<b>EMERALD PARADE</b> AC(mm) - 50 BASE(2.1)(mm) - 300 SUBBASE(2.3)(mm) - 100	<b>HEDGE LANE</b> AC(mm) - 35 BASE(2.1)(mm) - 150 SUBBASE(2.3)(mm) - 150
<b>GROVE STREET</b> AC(mm) - 35 BASE(2.1)(mm) - 150 SUBBASE(2.3)(mm) - 150	<b>LEAF STREET</b> AC(mm) - 35 BASE(2.1)(mm) - 150 SUBBASE(2.3)(mm) - 150	<b>GRASS LANE</b> AC(mm) - 35 BASE(2.1)(mm) - 150 SUBBASE(2.3)(mm) - 150	<b>TEAL CIRCUIT</b> AC(mm) - 35 BASE(2.1)(mm) - 150 SUBBASE(2.3)(mm) - 150
			<b>DRIVEWAY 3</b> AC(mm) - 35 BASE(2.1)(mm) - 150 SUBBASE(2.3)(mm) - 100

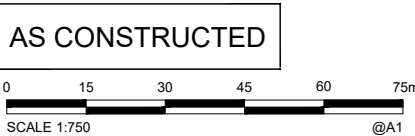

<b>A1</b>	INDEX	DATE	REVISIONS	DRAWN	CHECKED	PASSED	INITIALS	DATE
	A	11/12/2020	AS CONSTRUCTED	DAM	-	CW		11/12/2020



**LOGAN CITY COUNCIL**

MIRVAC MIR001-02B  
 AS CONSTRUCTED SURVEY - ROADS AND EARTHWORKS  
 EVERLEIGH PRECINCT 1.2B  
 GREENBANK QLD

SHEET 1 OF 4 SHEETS	SCALE 1:750 A1
REVISION DATE 11/12/2020	REVISION A
DISCIPLINE CODE -	
DRAWING NO. ASC-RDS AND EW-01-12B	