


PM61308 RL
 E: 498528.114
 N: 6931171.033
 RL: 54.660m




COORDINATE DATUM NOTE:
 HORIZONTAL COORDINATES(E,N) SUPPLIED ARE MAPPING GRID OF AUSTRALIA(MGA), ZONE 56 BASED ON THE UNIVERSAL TRANSVERSE MERCATOR PROJECTION AND THE GEOCENTRIC DATUM OF AUSTRALIA 1994.
 HORIZONTAL DATUM DERIVED FROM PSM 61308 E 498528.114 N 6931171.033
 LEVELS SUPPLIED ARE ON THE AUSTRALIAN HEIGHT DATUM(AHD)
 LEVEL DATUM DERIVED FROM PSM 61308 RL54.660 (AHD)

REGISTERED SURVEYOR'S CERTIFICATION
 I, Gordon Nicholson, hereby certify that the vertical and horizontal locations and dimensions shown on this plan are a true and correct record and were located by survey.
 Registered Surveyor (sig.) Reg. Surveyor No. SA 3405 Date: 10/12/2020

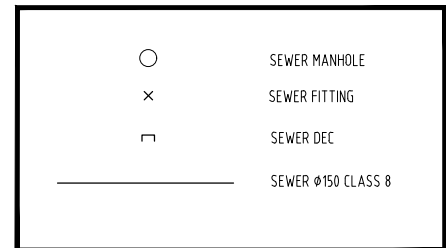

AS CONSTRUCTED CERTIFICATION
 I, Patrick Brady, hereby certify that:
 1. The information contained in this drawing/document is generally in compliance with approved drawings and design.
 2. To the best of my knowledge, this represents an accurate record of as constructed works and I accept the responsibility for the information contained in this drawing/document. Excluding Survey Error.
 7112 11/01/2021
 RPEQ No. _____ Date: _____
 RPEQ (Signature) _____

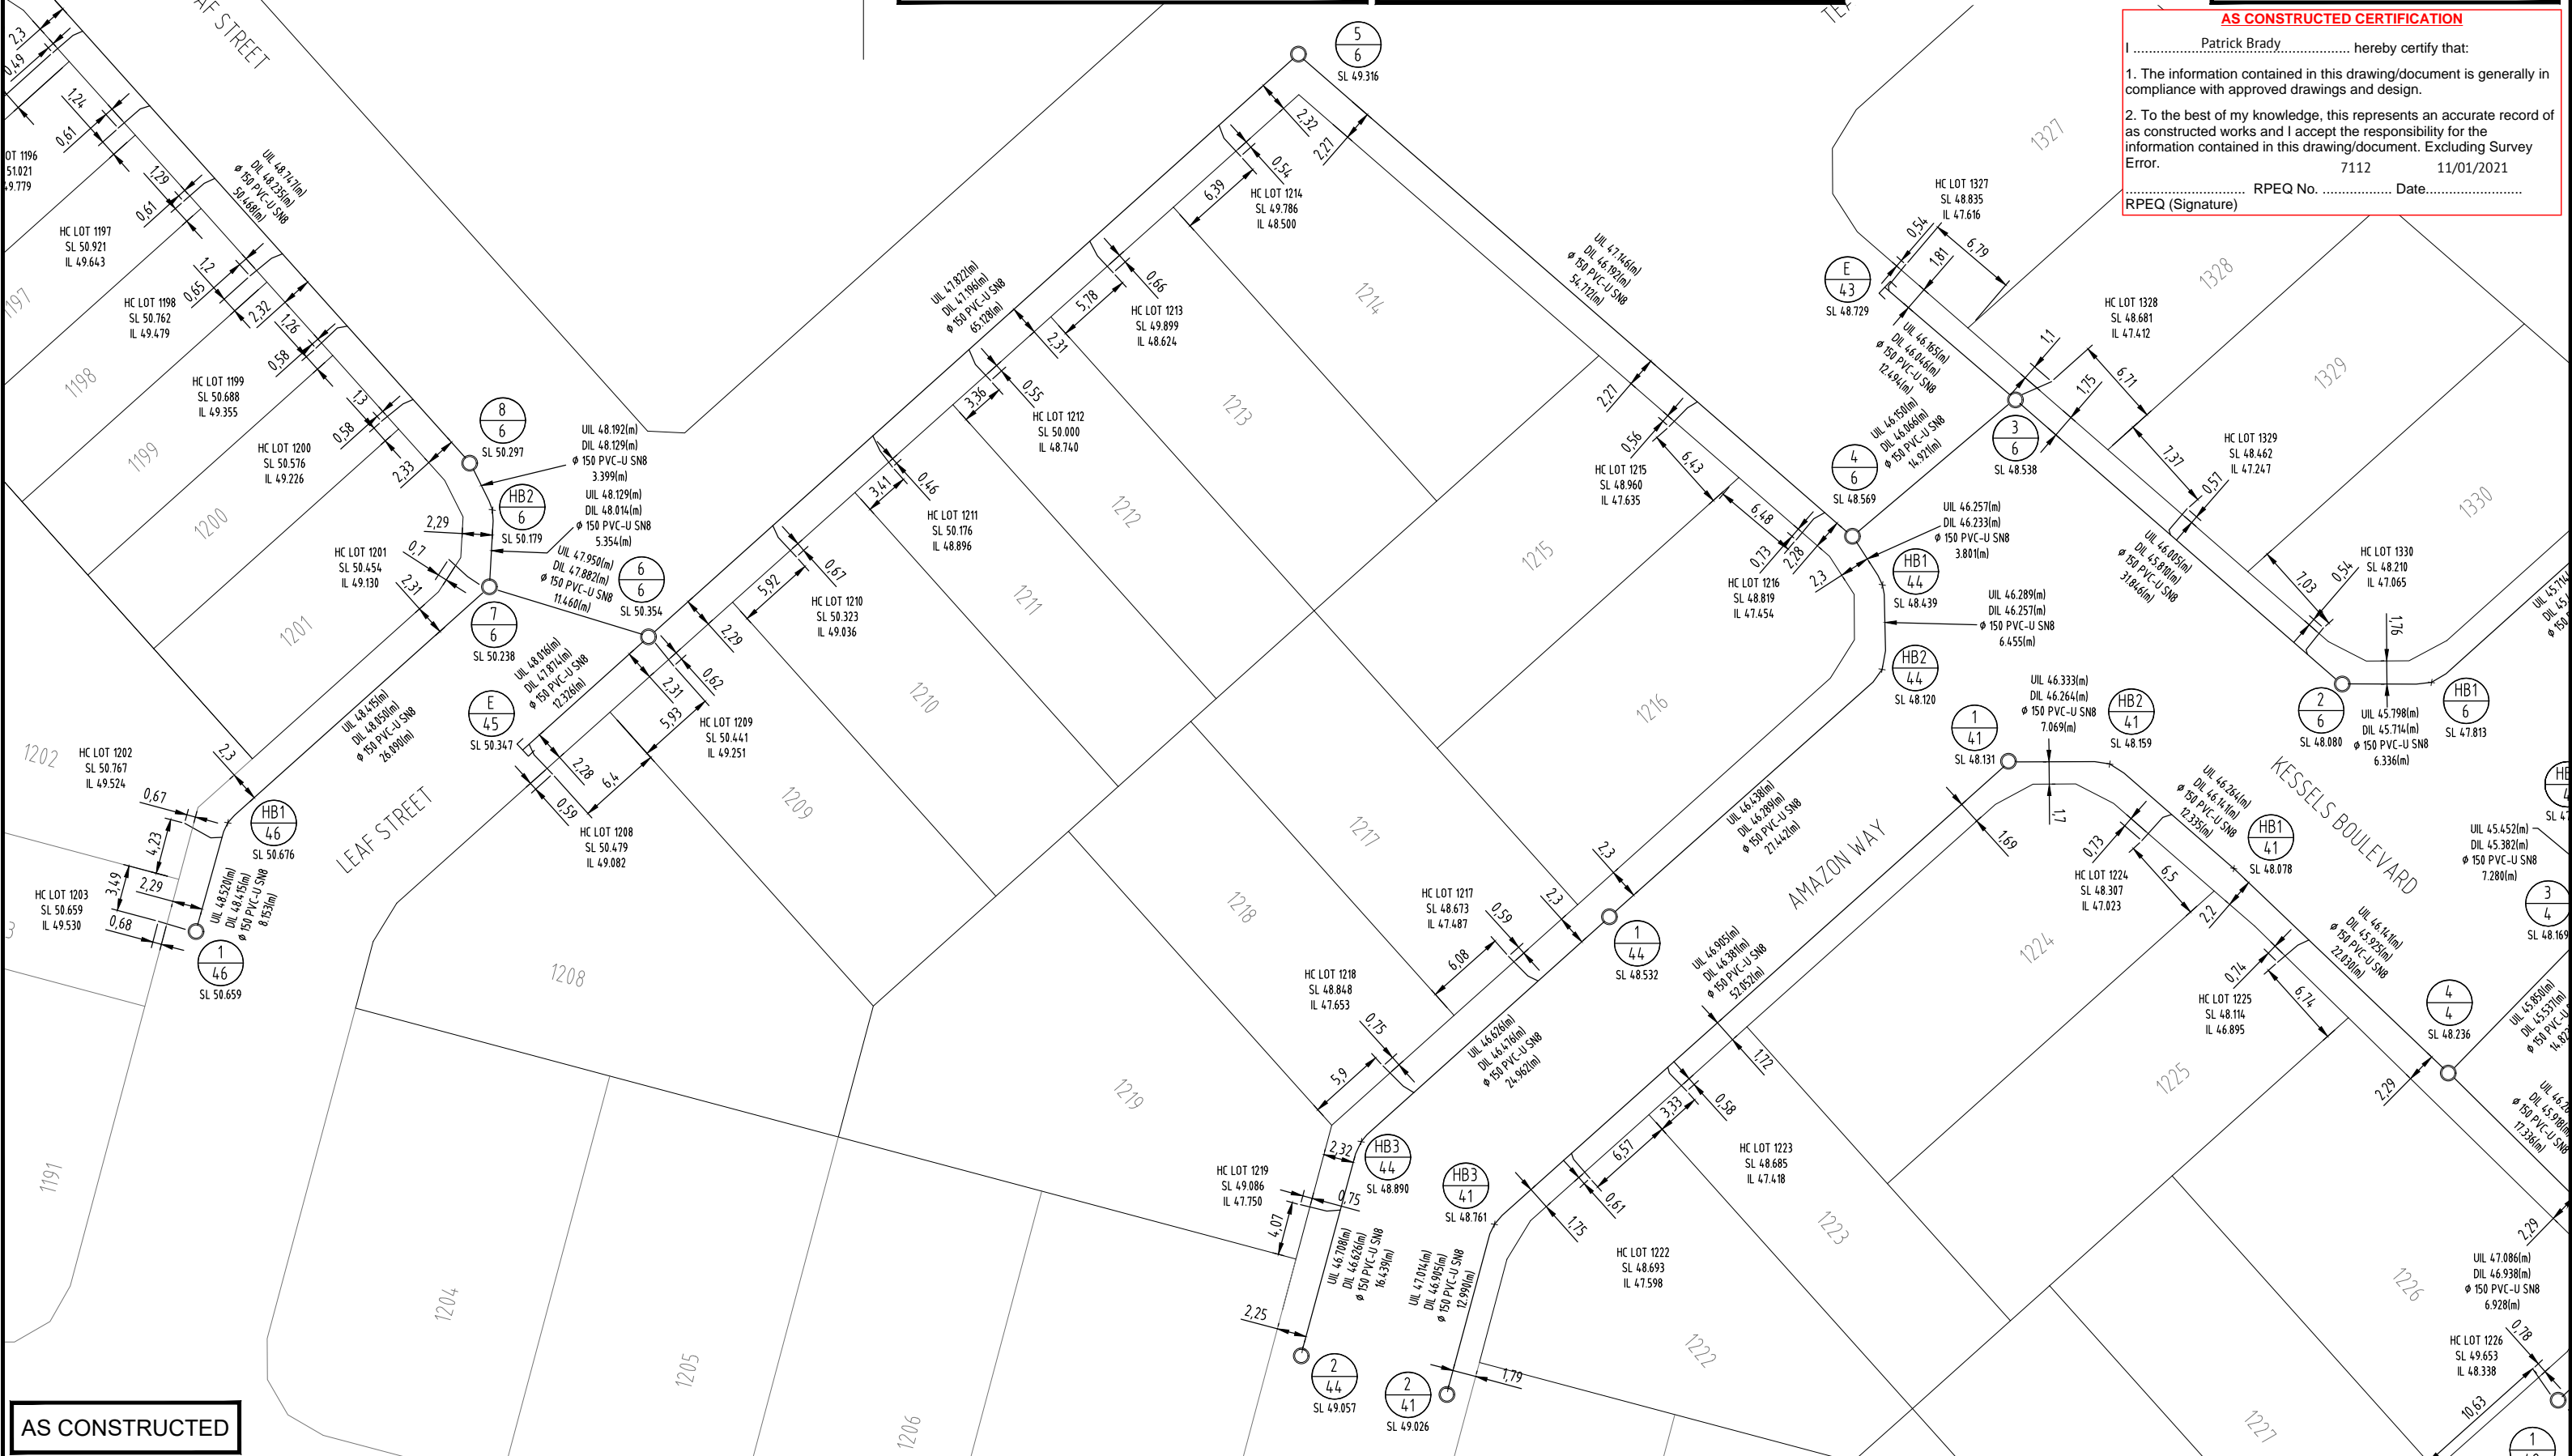


AS CONSTRUCTED

A1	INDEX	DATE	REVISIONS	DRAWN	CHECKED	PASSED	INITIALS	DATE
	A	10/12/2020	AS CONSTRUCTED	DAM	-	CW		
				DAM	-	CW		
				DAM	-	CW		



LOGAN CITY COUNCIL
 MIRVAC MIR001-02B
 AS CONSTRUCTED SURVEY - SEWER
 EVERLEIGH PRECINCT 1.2B
 GREENBANK QLD

SHEET 3 OF 4 SHEETS	SCALE 1:250 A1
REVISION DATE 10/12/2020	REVISION A
DISCIPLINE CODE -	
DRAWING NO. ASC-SEWER-03-1.2B	

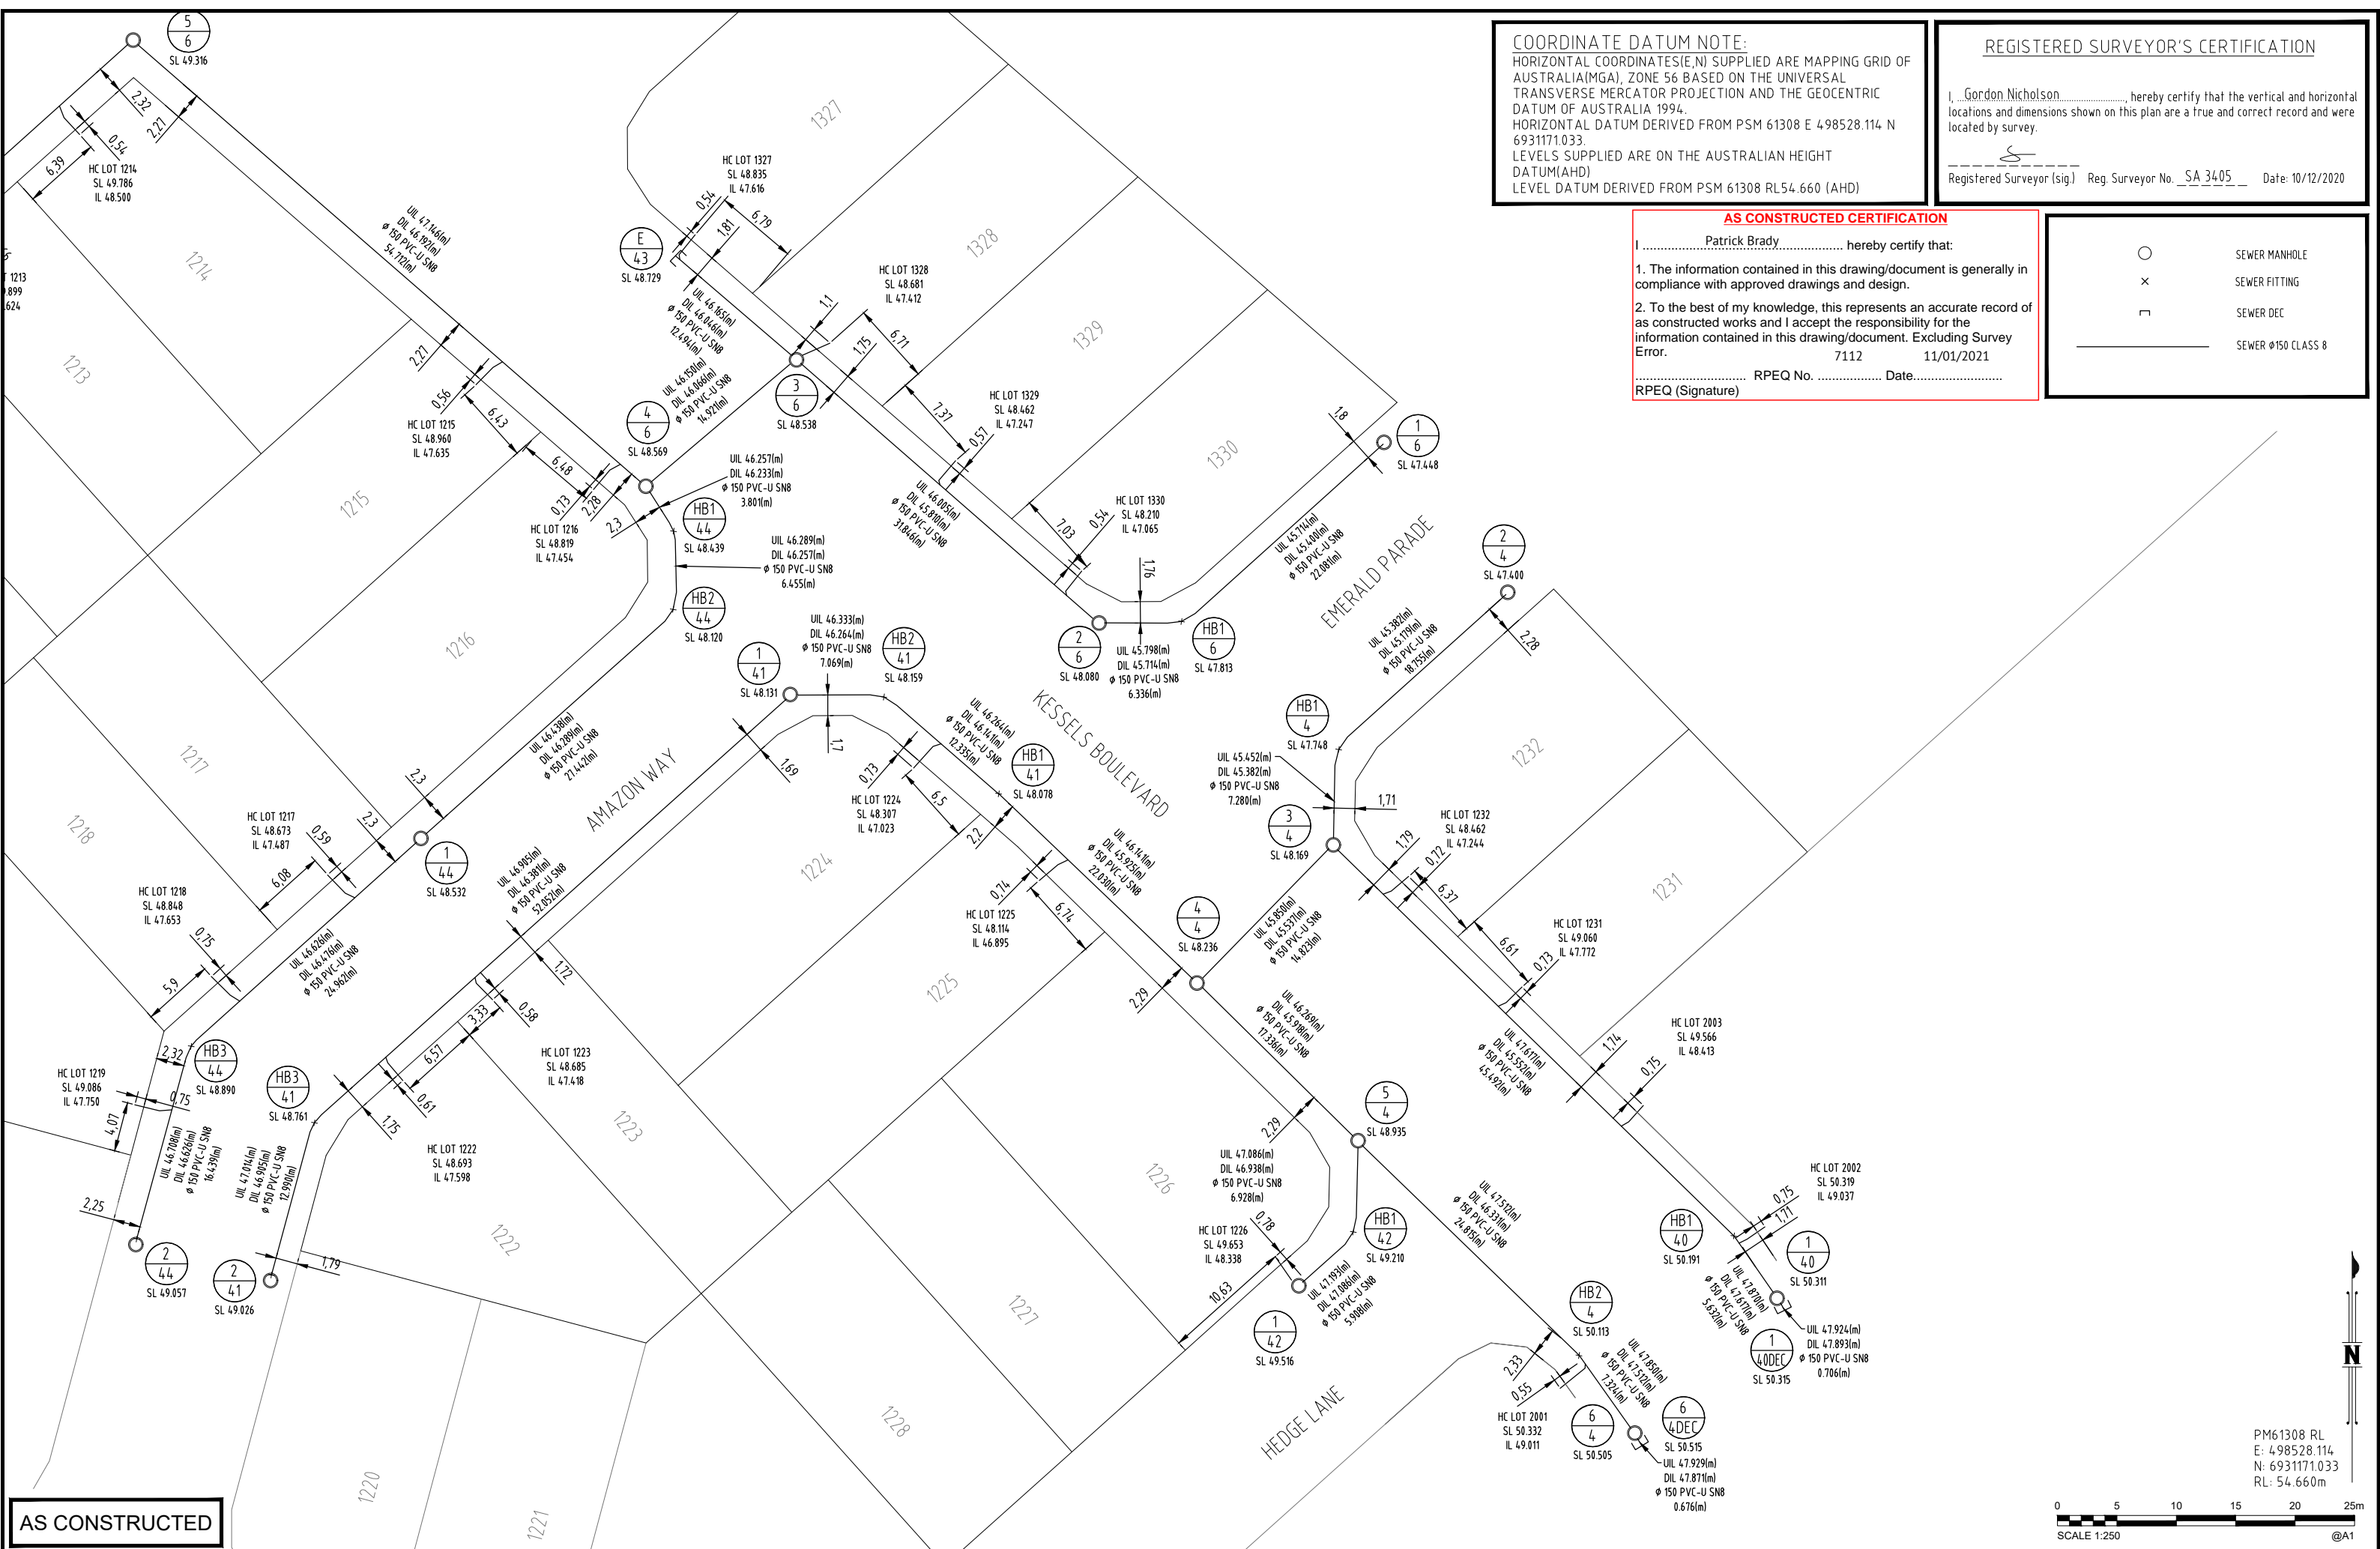


COORDINATE DATUM NOTE:
 HORIZONTAL COORDINATES(E,N) SUPPLIED ARE MAPPING GRID OF AUSTRALIA(MGA), ZONE 56 BASED ON THE UNIVERSAL TRANSVERSE MERCATOR PROJECTION AND THE GEOCENTRIC DATUM OF AUSTRALIA 1994.
 HORIZONTAL DATUM DERIVED FROM PSM 61308 E 4 98528.114 N 6931171.033.
 LEVELS SUPPLIED ARE ON THE AUSTRALIAN HEIGHT DATUM(AHD)
 LEVEL DATUM DERIVED FROM PSM 61308 RL54.660 (AHD)

REGISTERED SURVEYOR'S CERTIFICATION
 I, Gordon Nicholson, hereby certify that the vertical and horizontal locations and dimensions shown on this plan are a true and correct record and were located by survey.
 Registered Surveyor (sig.) Gordon Nicholson Reg. Surveyor No. SA 3405 Date: 10/12/2020

AS CONSTRUCTED CERTIFICATION
 I, Patrick Brady, hereby certify that:
 1. The information contained in this drawing/document is generally in compliance with approved drawings and design.
 2. To the best of my knowledge, this represents an accurate record of as constructed works and I accept the responsibility for the information contained in this drawing/document. Excluding Survey Error.
 7112 11/01/2021
 RPEQ No. _____ Date: _____
 RPEQ (Signature) _____

○	SEWER MANHOLE
×	SEWER FITTING
□	SEWER DEC
—	SEWER Ø150 CLASS 8

AS CONSTRUCTED

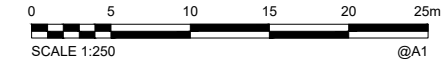

PM61308 RL
 E: 498528.114
 N: 6931171.033
 RL: 54.660m

A1	INDEX	DATE	REVISIONS	DRAWN	CHECKED	PASSED	INITIALS	DATE
	A	10/12/2020	AS CONSTRUCTED	DAM	-	CW		
				DAM	-	CW		
				DAM	-	CW		



LOGAN CITY COUNCIL
 MIRVAC MIR001-02B
 AS CONSTRUCTED SURVEY - SEWER
 EVERLEIGH PRECINCT 1.2B
 GREENBANK QLD

SHEET 4 OF 4 SHEETS	SCALE 1:250 A1
REVISION DATE 10/12/2020	REVISION A
DISCIPLINE CODE -	
DRAWING NO. ASC-SEWER-04-1.2B	




PM61308 RL
 E: 4.98528.114
 N: 6931171.033
 RL: 54.660m



COORDINATE DATUM NOTE:
 HORIZONTAL COORDINATES(E,N) SUPPLIED ARE MAPPING GRID OF AUSTRALIA(MGA), ZONE 56 BASED ON THE UNIVERSAL TRANSVERSE MERCATOR PROJECTION AND THE GEOCENTRIC DATUM OF AUSTRALIA 1994.
 HORIZONTAL DATUM DERIVED FROM PSM 61308 E 4.98528.114 N 6931171.033.
 LEVELS SUPPLIED ARE ON THE AUSTRALIAN HEIGHT DATUM(AHD)
 LEVEL DATUM DERIVED FROM PSM 61308 RL54.660 (AHD)

REGISTERED SURVEYOR'S CERTIFICATION
 I, Gordon Nicholson, hereby certify that the vertical and horizontal locations and dimensions shown on this plan are a true and correct record and were located by survey.
 Registered Surveyor (sig) [Signature] Reg. Surveyor No. SA 3405 Date: 10/12/2020

AS CONSTRUCTED CERTIFICATION
 I, Patrick Brady, hereby certify that:
 1. The information contained in this drawing/document is generally in compliance with approved drawings and design.
 2. To the best of my knowledge, this represents an accurate record of as constructed works and I accept the responsibility for the information contained in this drawing/document. Excluding Survey Error.
 7112 11/01/2021
 RPEQ No. Date.....
 RPEQ (Signature)

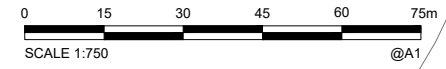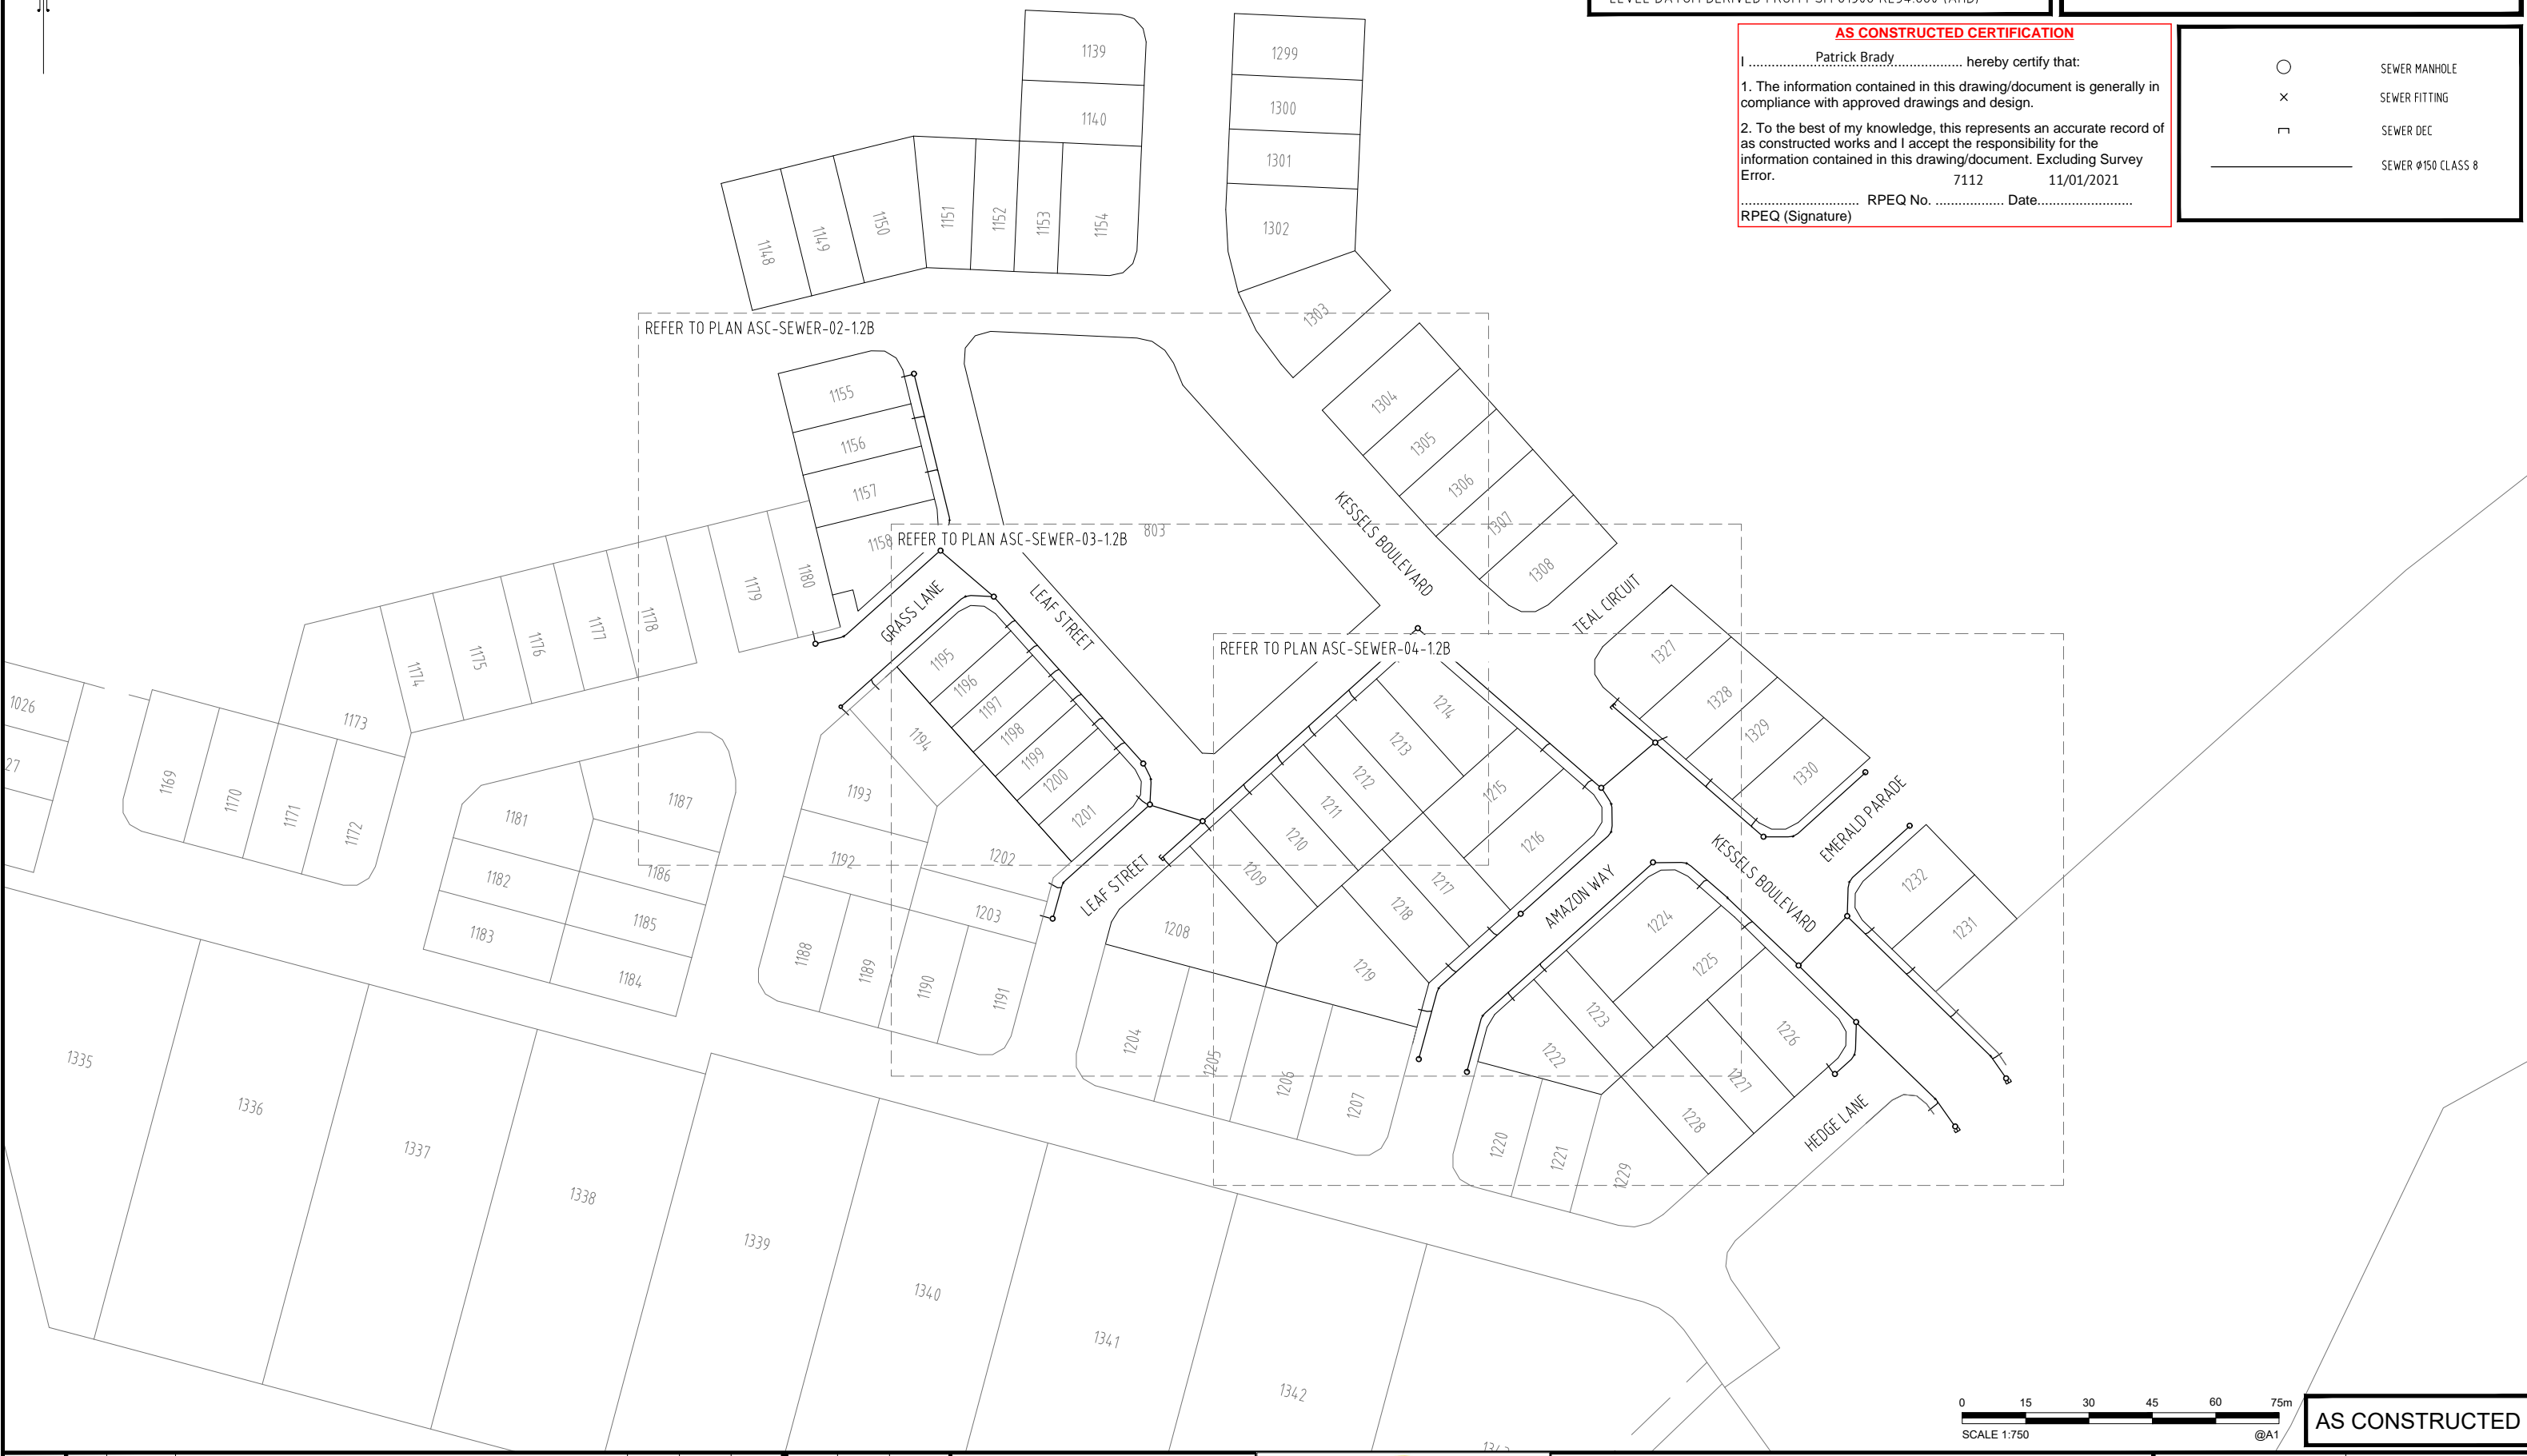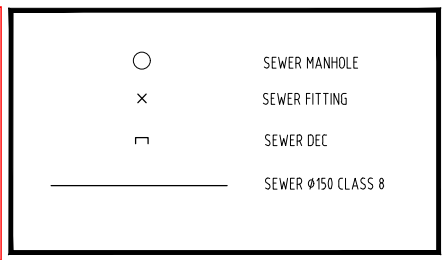

AS CONSTRUCTED

A1

INDEX	DATE	REVISIONS	DRAWN	CHECKED	PASSED	INITIALS	DATE
A	10/12/2020	AS CONSTRUCTED	DAM	-	CW		10/12/2020




LOGAN CITY COUNCIL
 MIRVAC MIR001-02B
 AS CONSTRUCTED SURVEY - SEWER
 EVERLEIGH PRECINCT 1.2B
 GREENBANK QLD

SHEET 1 OF 4 SHEETS	SCALE 1:750 A1
REVISION DATE 10/12/2020	REVISION A
DISCIPLINE CODE -	
DRAWING NO. ASC-SEWER-01-1.2B	


PM61308 RL
 E: 498528.114
 N: 6931171.033
 RL: 54.660m

COORDINATE DATUM NOTE:
 HORIZONTAL COORDINATES(E,N) SUPPLIED ARE MAPPING GRID OF AUSTRALIA(MGA), ZONE 56 BASED ON THE UNIVERSAL TRANSVERSE MERCATOR PROJECTION AND THE GEOCENTRIC DATUM OF AUSTRALIA 1994.
 HORIZONTAL DATUM DERIVED FROM PSM 61308 E 498528.114 N 6931171.033
 LEVELS SUPPLIED ARE ON THE AUSTRALIAN HEIGHT DATUM(AHD)
 LEVEL DATUM DERIVED FROM PSM 61308 RL54.660 (AHD)

REGISTERED SURVEYOR'S CERTIFICATION
 I, Gordon Nicholson, hereby certify that the vertical and horizontal locations and dimensions shown on this plan are a true and correct record and were located by survey.
 Registered Surveyor (sig.) Gordon Nicholson Reg. Surveyor No. SA 3405 Date: 10/12/2020

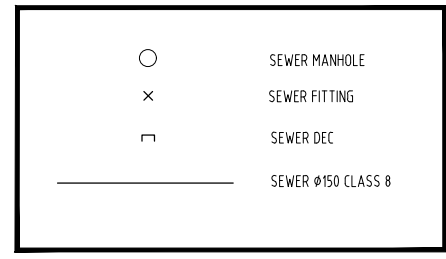

AS CONSTRUCTED CERTIFICATION
 I, Patrick Brady, hereby certify that:
 1. The information contained in this drawing/document is generally in compliance with approved drawings and design.
 2. To the best of my knowledge, this represents an accurate record of as constructed works and I accept the responsibility for the information contained in this drawing/document. Excluding Survey Error.
 RPEQ No. 7112 Date: 11/01/2021
 RPEQ (Signature) Patrick Brady

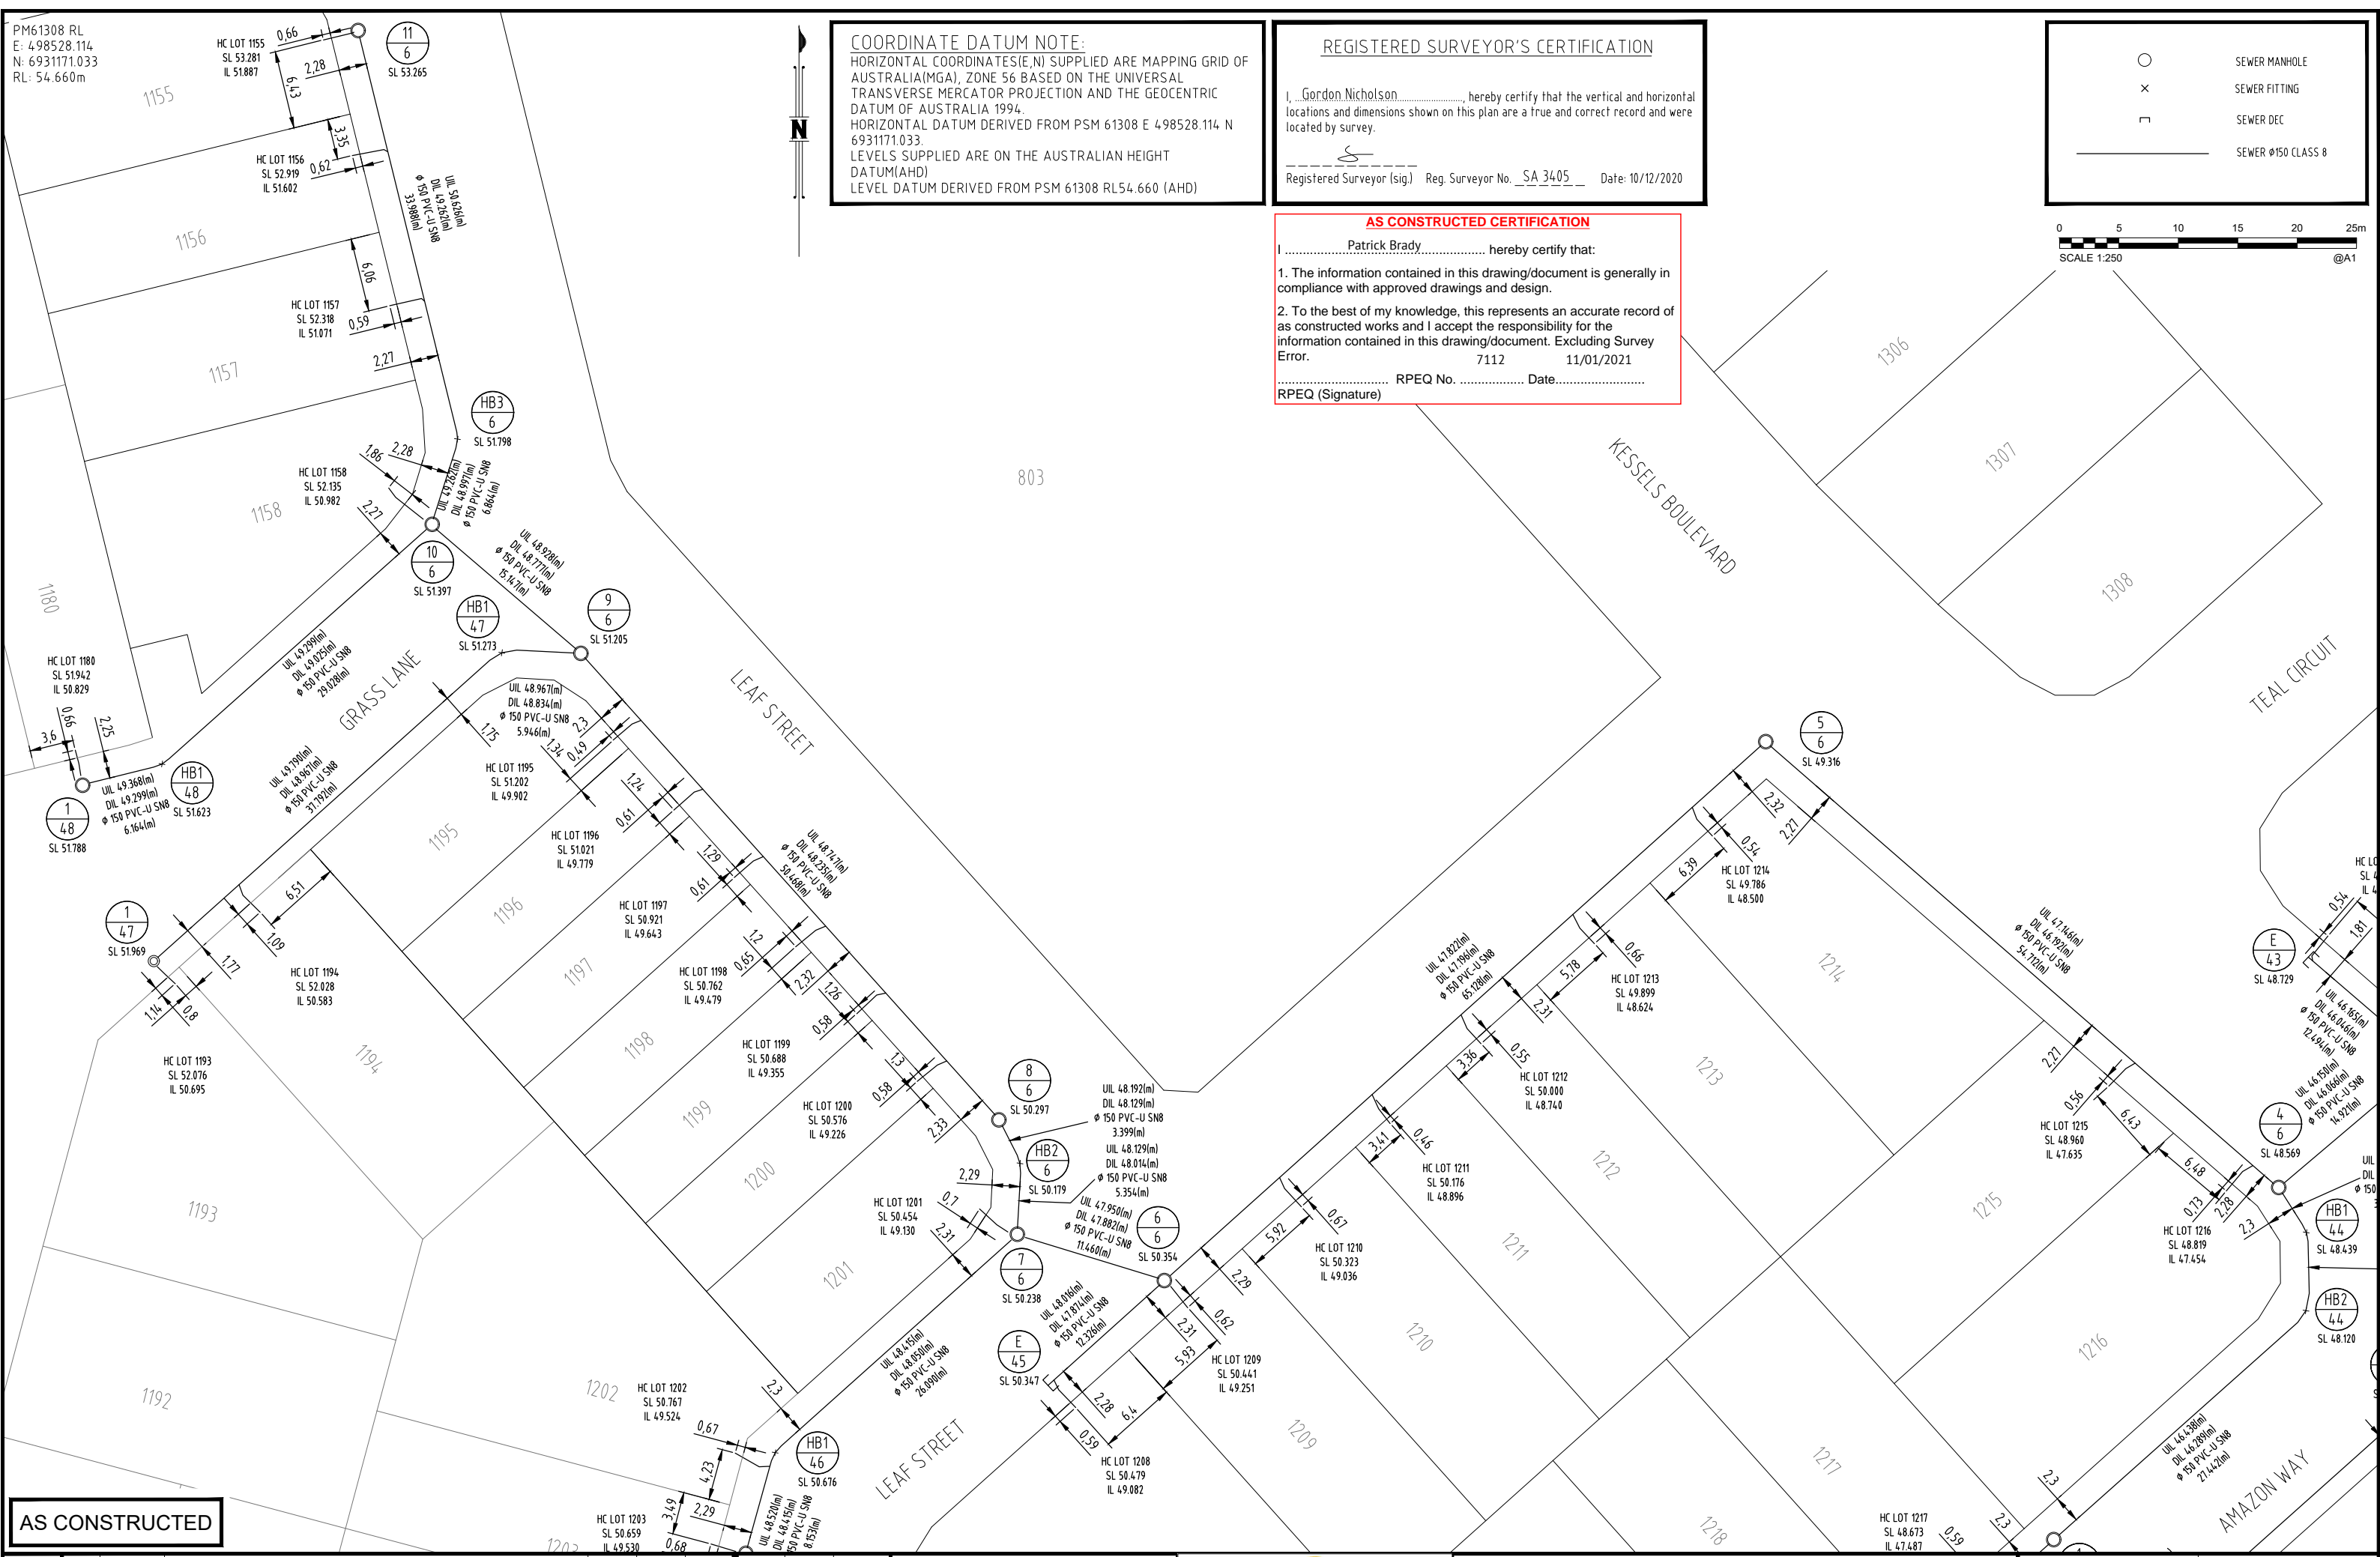

AS CONSTRUCTED

A1

INDEX	DATE	REVISIONS	DRAWN	CHECKED	PASSED	INITIALS	DATE
A	10/12/2020	AS CONSTRUCTED	DAM	-	CW		10/12/2020

shadforth
 40 Sandstone Lane, Forest Glen QLD 4085
 07 5488 3300 • 07 5488 3388 • shadforth@shadforth.com.au

LOGAN CITY COUNCIL

LOGAN CITY COUNCIL
 MIRVAC M1001-02B
 AS CONSTRUCTED SURVEY - SEWER
 EVERLEIGH PRECINCT 1.2B
 GREENBANK QLD

SHEET 2 OF 4 SHEETS	SCALE 1:250 A1
REVISION DATE 10/12/2020	REVISION A
DISCIPLINE CODE -	
DRAWING NO. ASC-SEWER-02-1.2B	