




AS CONSTRUCTED

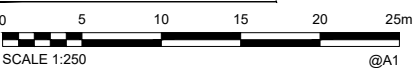

COORDINATE DATUM NOTE:
 HORIZONTAL COORDINATES (E, N) SUPPLIED ARE MAPPING GRID OF AUSTRALIA (MGA), ZONE 56 BASED ON THE UNIVERSAL TRANSVERSE MERCATOR PROJECTION AND THE GEOCENTRIC DATUM OF AUSTRALIA 1994.
 HORIZONTAL DATUM DERIVED FROM PSM 61308 E 4 98528.114 N 6931171.033.
 LEVELS SUPPLIED ARE ON THE AUSTRALIAN HEIGHT DATUM (AHD) LEVEL DATUM DERIVED FROM PSM 61308 RL54.660 (AHD)

PAVEMENT DESIGN			
HEDGE LANE	LEAF STREET	IVY LANE	DRIVEWAYS
AC(mm) - 35	AC(mm) - 35	AC(mm) - 35	AC(mm) - 35
BASE(2.1)(mm) - 150	BASE(2.1)(mm) - 150	BASE(2.1)(mm) - 150	BASE(2.1)(mm) - 150
SUBBASE(2.3)(mm) - 150	SUBBASE(2.3)(mm) - 150	SUBBASE(2.3)(mm) - 150	SUBBASE(2.3)(mm) - 100
GRASS LANE	AMAZON WAY	RETAINING WALLS	
AC(mm) - 35	AC(mm) - 35	-	
BASE(2.1)(mm) - 150	BASE(2.1)(mm) - 150	ACCOUSTIC WALLS	
SUBBASE(2.3)(mm) - 150	SUBBASE(2.3)(mm) - 150	-	

ENGINEER'S CERTIFICATION
 I, _____, hereby certify that:
 1. The information contained in this drawing / document is in compliance with approved drawings and design.
 2. This represents an accurate record of as-constructed works
 3. I accept responsibility for the information contained in this drawing / document.
 RPEQ (signature) RPEQ No. _____ Date: _____

REGISTERED SURVEYOR'S CERTIFICATION
 I, Gordon Nicholson, hereby certify that the vertical and horizontal locations and dimensions shown on this plan are a true and correct record and were located by survey.

 Registered Surveyor (sig.) Reg. Surveyor No. SA 3405 Date: 14/01/2021



A1	INDEX	DATE	REVISIONS	DRAWN	CHECKED	PASSED
	-	14/01/2021	AS CONSTRUCTED	NJA	DAM	CW

DRAWN	NJA	14/01/2021
CHECKED	DAM	14/01/2021
PASSED	CW	14/01/2021
INITIALS		DATE



LOGAN CITY COUNCIL
 MIRVAC MIR001-05
 AS CONSTRUCTED SURVEY - ROADS AND EARTHWORKS
 EVERLEIGH PRECINCT 15A
 GREENBANK QLD

SHEET 2 OF 5 SHEETS	SCALE 1:250 A1
REVISION DATE 14/01/2021	REVISION A
DISCIPLINE CODE -	
DRAWING NO. ASC-RDS AND EW-02-15A	

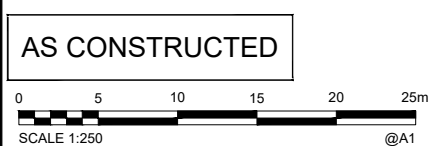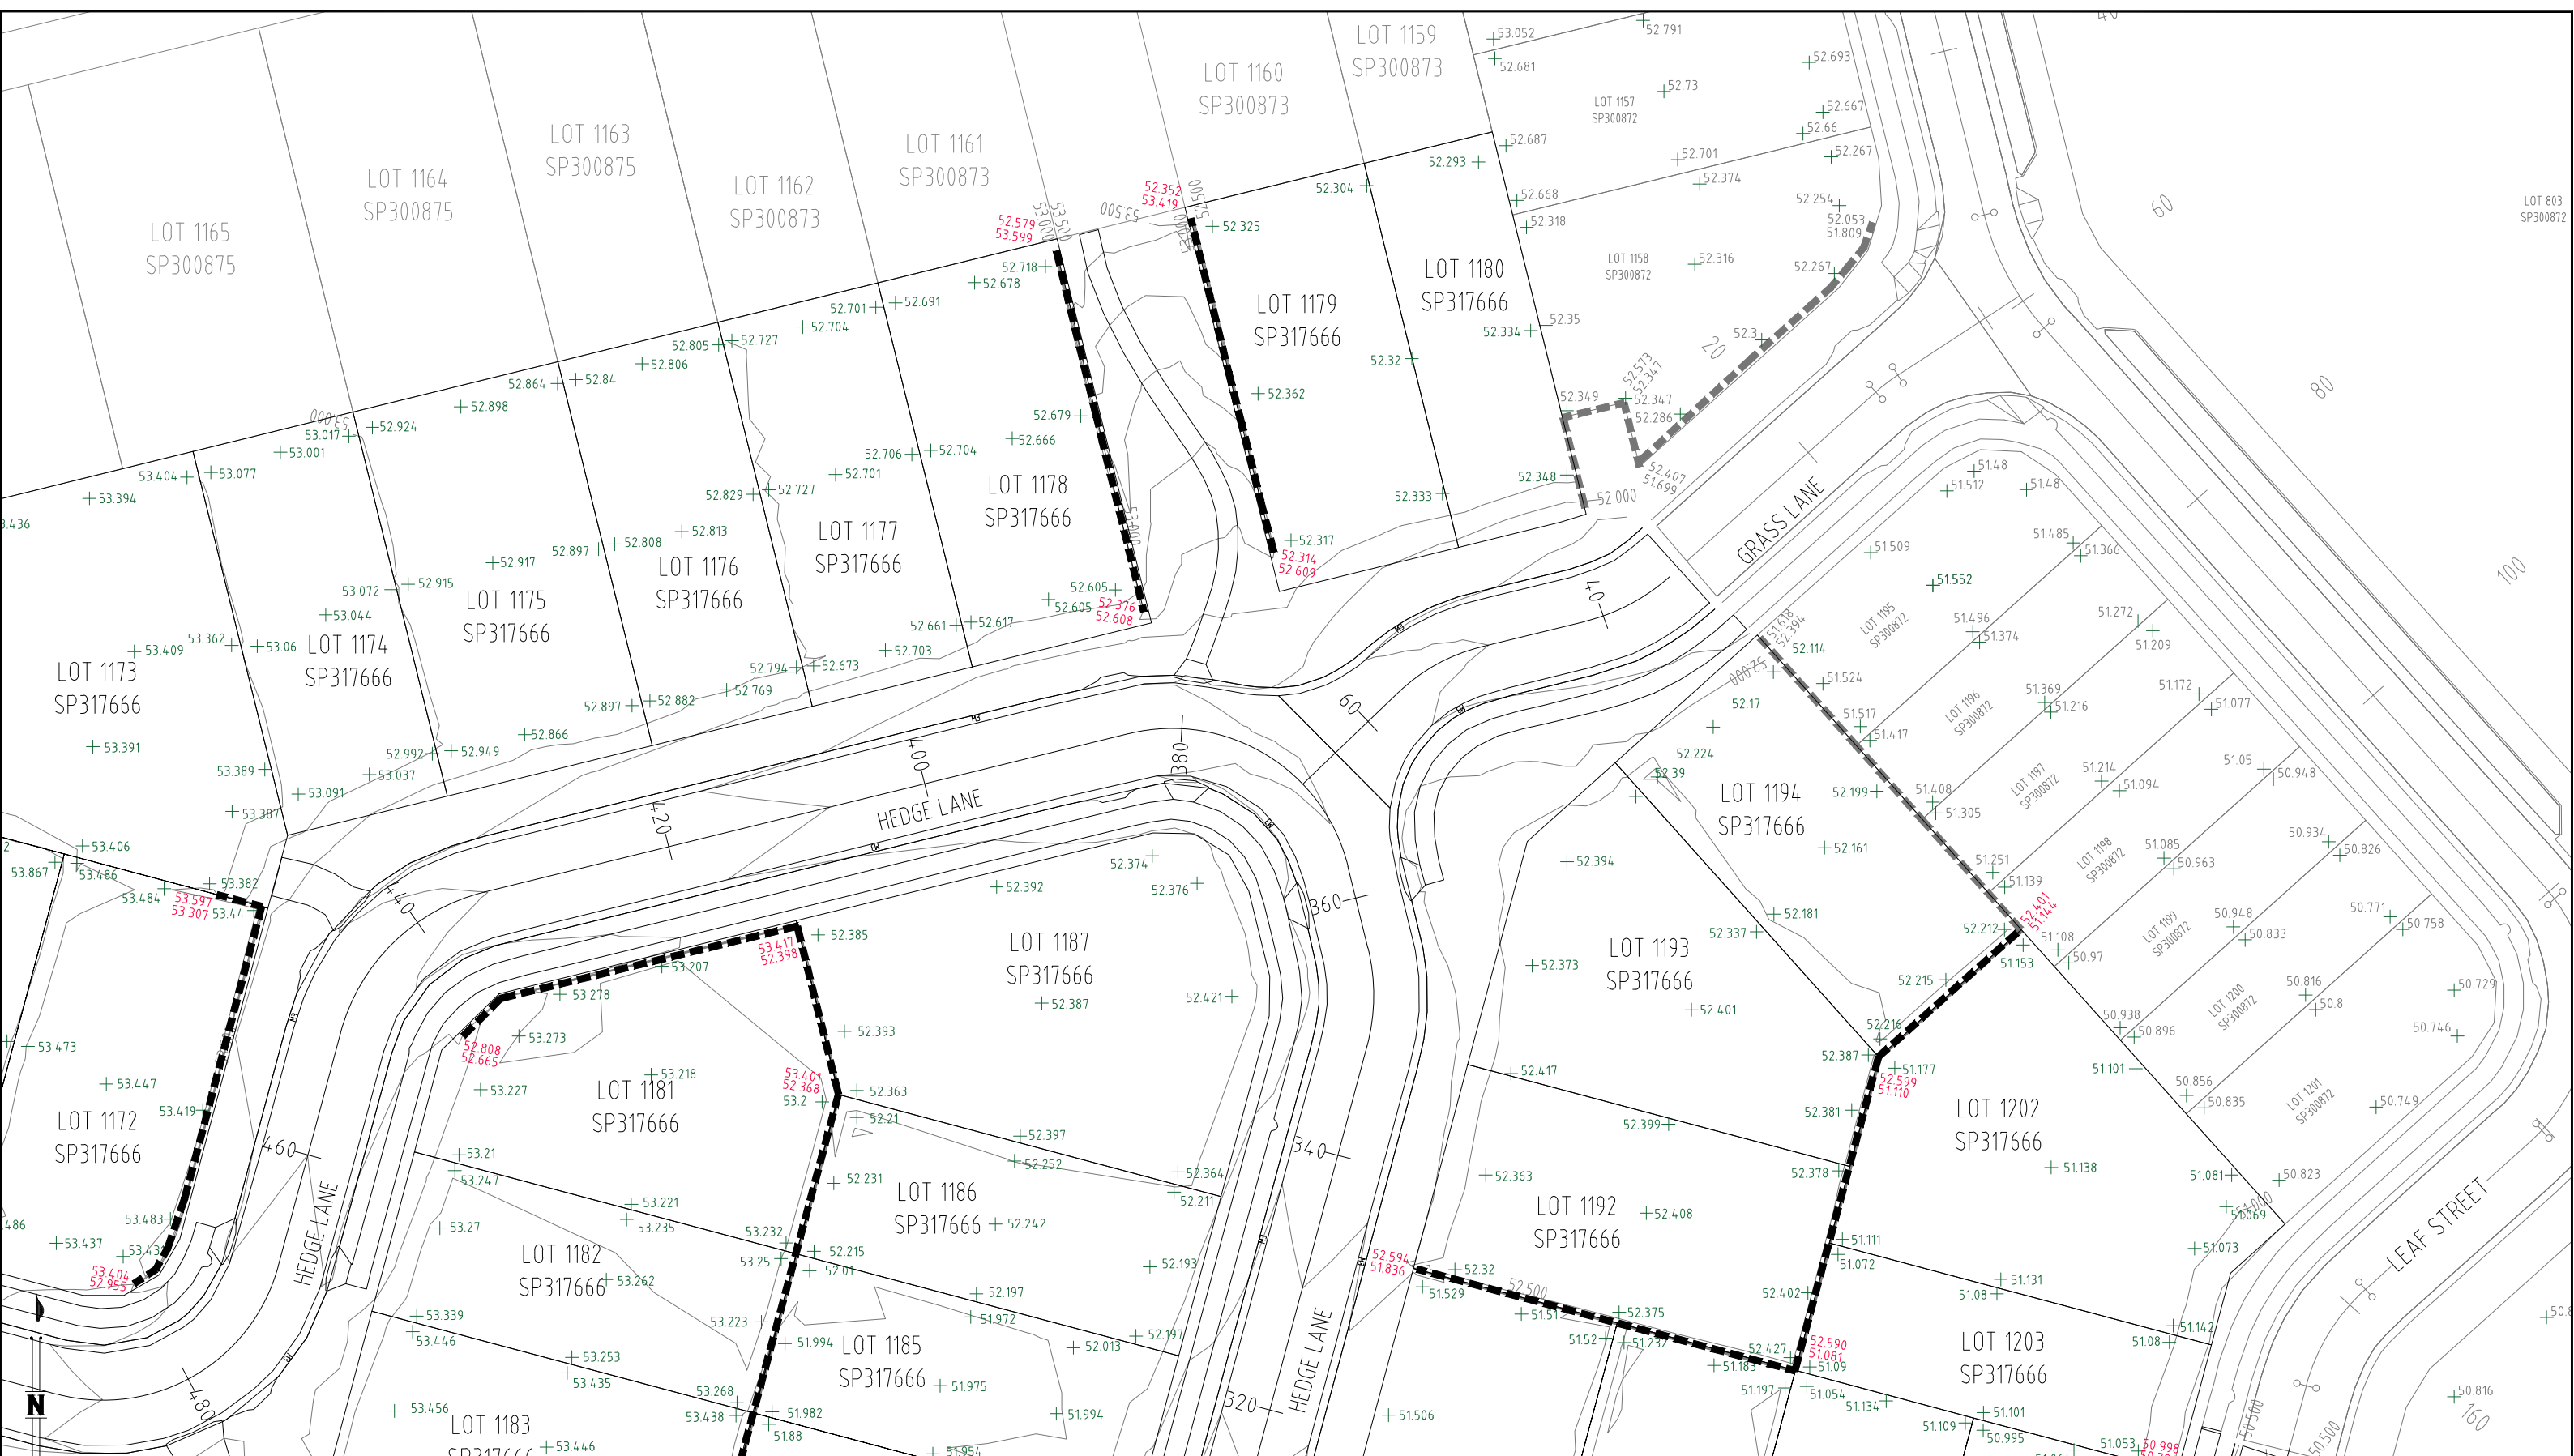

COORDINATE DATUM NOTE:
 HORIZONTAL COORDINATES(E,N) SUPPLIED ARE MAPPING GRID OF AUSTRALIA(MGA), ZONE 56 BASED ON THE UNIVERSAL TRANSVERSE MERCATOR PROJECTION AND THE GEOCENTRIC DATUM OF AUSTRALIA 1994.
 HORIZONTAL DATUM DERIVED FROM PSM 61308 E 498528.114 N 693171.033.
 LEVELS SUPPLIED ARE ON THE AUSTRALIAN HEIGHT DATUM(AHD) LEVEL DATUM DERIVED FROM PSM 61308 RLS4.660 (AHD)

PAVEMENT DESIGN			
HEDGE LANE	LEAF STREET	IVY LANE	DRIVEWAYS
AC(mm)- 35	AC(mm)- 35	AC(mm)- 35	AC(mm)- 35
BASE(2.1l)(mm) - 150	BASE(2.1l)(mm) - 150	BASE(2.1l)(mm) - 150	BASE(2.1l)(mm) - 150
SUBBASE(2.3l)(mm) - 150	SUBBASE(2.3l)(mm) - 150	SUBBASE(2.3l)(mm) - 150	SUBBASE(2.3l)(mm) - 100
GRASS LANE	AMAZON WAY	RETAINING WALLS	
AC(mm)- 35	AC(mm)- 35	ACOUSTIC WALLS	
BASE(2.1l)(mm) - 150	BASE(2.1l)(mm) - 150		
SUBBASE(2.3l)(mm) - 150	SUBBASE(2.3l)(mm) - 150		

ENGINEER'S CERTIFICATION
 I, _____, hereby certify that:
 1. The information contained in this drawing / document is in compliance with approved drawings and design.
 2. This represents an accurate record of as-constructed works
 3. I accept responsibility for the information contained in this drawing / document.
 RPEQ (signature) RPEQ No. _____ Date: _____

REGISTERED SURVEYOR'S CERTIFICATION
 I, Gordon Nicholson, hereby certify that the vertical and horizontal locations and dimensions shown on this plan are a true and correct record and were located by survey.
 Registered Surveyor (Sig.) SA 3405 Date: 14/01/2021


INDEX	DATE	REVISIONS	DRAWN	CHECKED	PASSED
A1	14/01/2021	AS CONSTRUCTED	NJA	DAM	CW

DRAWN	CHECKED	PASSED	INITIALS	DATE
NJA	DAM	CW		14/01/2021




LOGAN CITY COUNCIL
 MIRVAC MIR001-05
 AS CONSTRUCTED SURVEY - ROADS AND EARTHWORKS
 EVERLEIGH PRECINCT 15A
 GREENBANK QLD

SHEET	REVISION	DISCIPLINE CODE	DRAWING NO.
3 OF 5	14/01/2021	-	ASC-RDS AND EW-03-15A

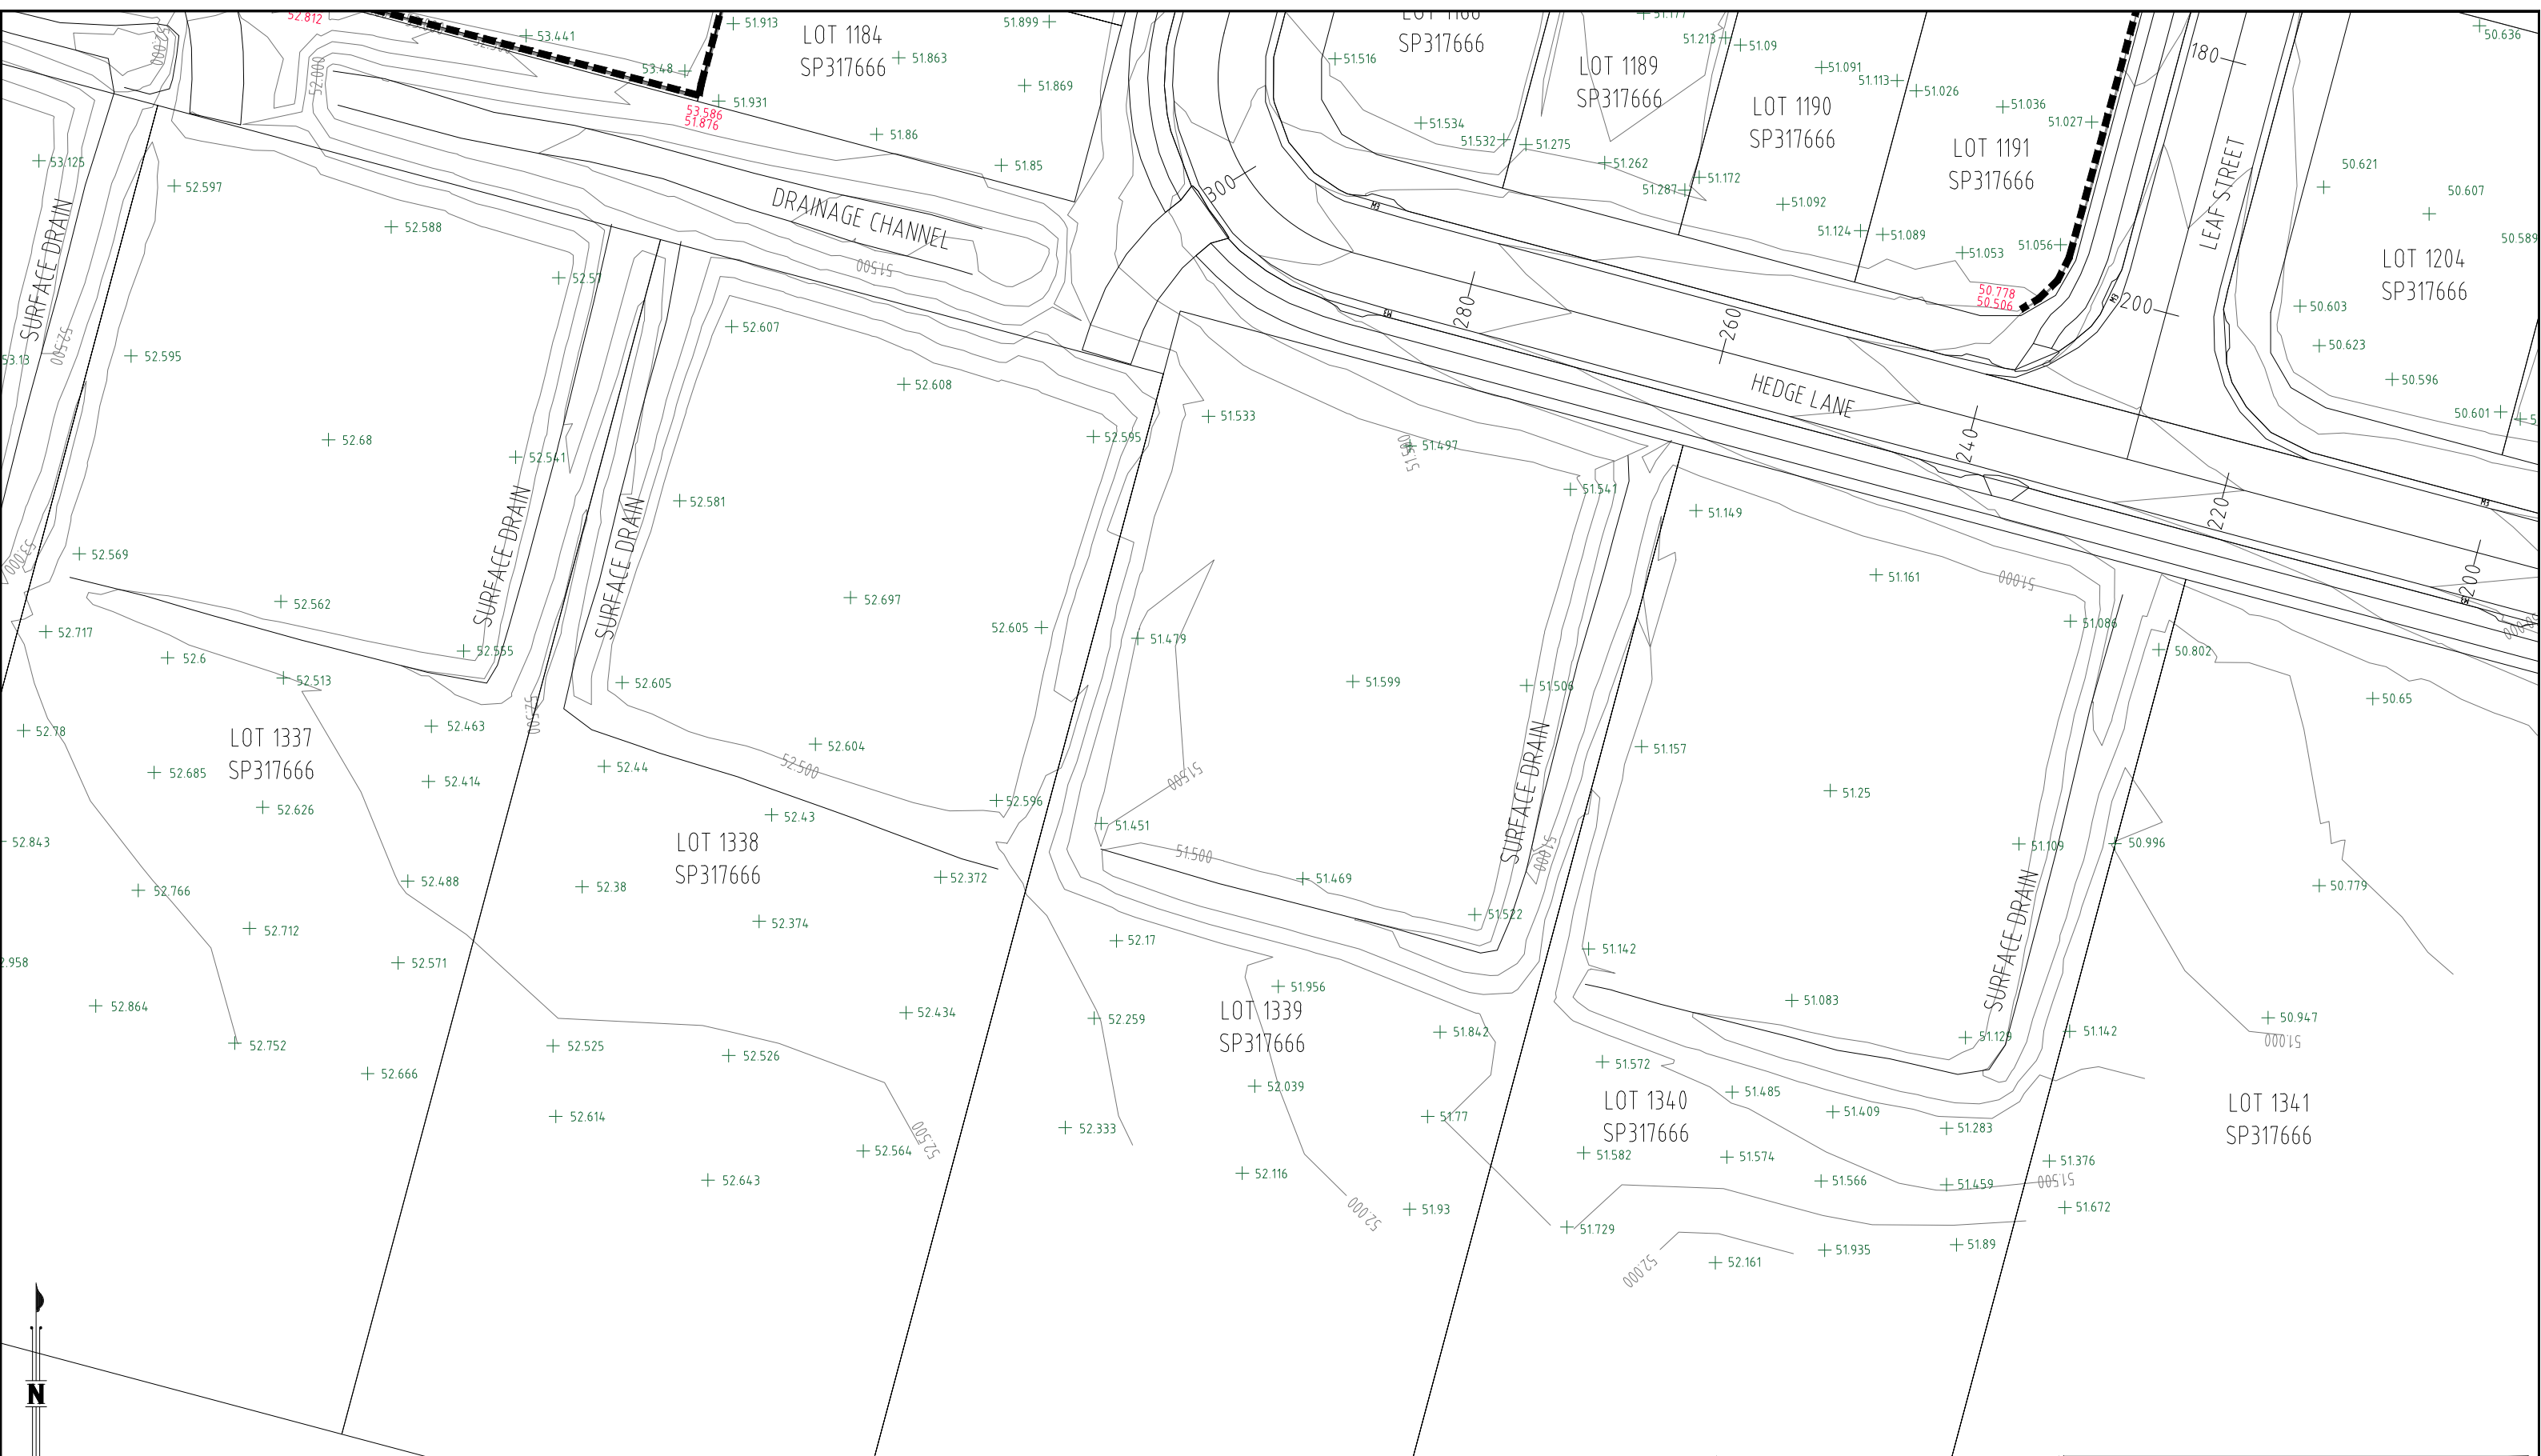

<p>AS CONSTRUCTED</p> <p>SCALE 1:250 @A1</p>	<p>COORDINATE DATUM NOTE:</p> <p>HORIZONTAL COORDINATES (E, N) SUPPLIED ARE MAPPING GRID OF AUSTRALIA (MGA), ZONE 56 BASED ON THE UNIVERSAL TRANSVERSE MERCATOR PROJECTION AND THE GEOCENTRIC DATUM OF AUSTRALIA 1994.</p> <p>HORIZONTAL DATUM DERIVED FROM PSM 61308 E 4 98528.114 N 6931171.033.</p> <p>LEVELS SUPPLIED ARE ON THE AUSTRALIAN HEIGHT DATUM (AHD) LEVEL DATUM DERIVED FROM PSM 61308 RL54.660 (AHD)</p>			<p>PAVEMENT DESIGN</p> <table border="1"> <tr> <td>HEDGE LANE</td> <td>LEAF STREET</td> <td>IVY LANE</td> <td>DRIVEWAYS</td> </tr> <tr> <td>AC(mm)- 35</td> <td>AC(mm)- 35</td> <td>AC(mm)- 35</td> <td>AC(mm)- 35</td> </tr> <tr> <td>BASE(2.1)(mm) - 150</td> <td>BASE(2.1)(mm) - 150</td> <td>BASE(2.1)(mm) - 150</td> <td>BASE(2.1)(mm) - 150</td> </tr> <tr> <td>SUBBASE(2.3)(mm) - 150</td> <td>SUBBASE(2.3)(mm) - 150</td> <td>SUBBASE(2.3)(mm) - 150</td> <td>SUBBASE(2.3)(mm) - 150</td> </tr> </table>				HEDGE LANE	LEAF STREET	IVY LANE	DRIVEWAYS	AC(mm)- 35	AC(mm)- 35	AC(mm)- 35	AC(mm)- 35	BASE(2.1)(mm) - 150	BASE(2.1)(mm) - 150	BASE(2.1)(mm) - 150	BASE(2.1)(mm) - 150	SUBBASE(2.3)(mm) - 150	SUBBASE(2.3)(mm) - 150	SUBBASE(2.3)(mm) - 150	SUBBASE(2.3)(mm) - 150	<p>ENGINEER'S CERTIFICATION</p> <p>I, _____, hereby certify that:</p> <ol style="list-style-type: none"> The information contained in this drawing / document is in compliance with approved drawings and design. This represents an accurate record of as-constructed works I accept responsibility for the information contained in this drawing / document. <p>RPEQ (signature) RPEQ No. _____ Date: _____</p>		<p>REGISTERED SURVEYOR'S CERTIFICATION</p> <p>I, <u>Gordon Nicholson</u>, hereby certify that the vertical and horizontal locations and dimensions shown on this plan are a true and correct record and were located by survey.</p> <p></p> <p>Registered Surveyor (sig.) Reg. Surveyor No. <u>SA 3405</u> Date: <u>14/01/2021</u></p>	
	HEDGE LANE	LEAF STREET	IVY LANE	DRIVEWAYS																							
AC(mm)- 35	AC(mm)- 35	AC(mm)- 35	AC(mm)- 35																								
BASE(2.1)(mm) - 150	BASE(2.1)(mm) - 150	BASE(2.1)(mm) - 150	BASE(2.1)(mm) - 150																								
SUBBASE(2.3)(mm) - 150	SUBBASE(2.3)(mm) - 150	SUBBASE(2.3)(mm) - 150	SUBBASE(2.3)(mm) - 150																								
<p>GRASS LANE</p> <p>AC(mm)- 35</p> <p>BASE(2.1)(mm) - 150</p> <p>SUBBASE(2.3)(mm) - 150</p>			<p>AMAZON WAY</p> <p>AC(mm)- 35</p> <p>BASE(2.1)(mm) - 150</p> <p>SUBBASE(2.3)(mm) - 150</p>		<p>RETAINING WALLS</p> <p>-----</p> <p>ACOUSTIC WALLS</p> <p>-----</p>																						

<p>A1</p>	INDEX	DATE	REVISIONS	DRAWN	CHECKED	PASSED	DRAWN	CHECKED	PASSED			<p>LOGAN CITY COUNCIL</p> <p>MIRVAC MIR001-05</p> <p>AS CONSTRUCTED SURVEY - ROADS AND EARTHWORKS</p> <p>EVERLEIGH PRECINCT 15A</p> <p>GREENBANK QLD</p>		<p>SHEET 4 OF 5 SHEETS</p> <p>REVISION DATE 14/01/2021</p> <p>DISCIPLINE CODE -</p> <p>DRAWING NO.</p> <p>ASC-RDS AND EW-04-15A</p>		<p>SCALE 1:250 A1</p> <p>REVISION A</p>	
	-	-	-	NJA	DAM	CW	NJA	DAM	CW			<p>DRAWN NJA 14/01/2021</p> <p>CHECKED DAM 14/01/2021</p> <p>PASSED CW 14/01/2021</p>		<p>REVISION A</p>			
	A	14/01/2021	AS CONSTRUCTED	NJA	DAM	CW	NJA	DAM	CW			<p>INITIALS DATE</p>		<p>REVISION A</p>			
													<p>LOGAN CITY COUNCIL</p>		<p>REVISION A</p>		

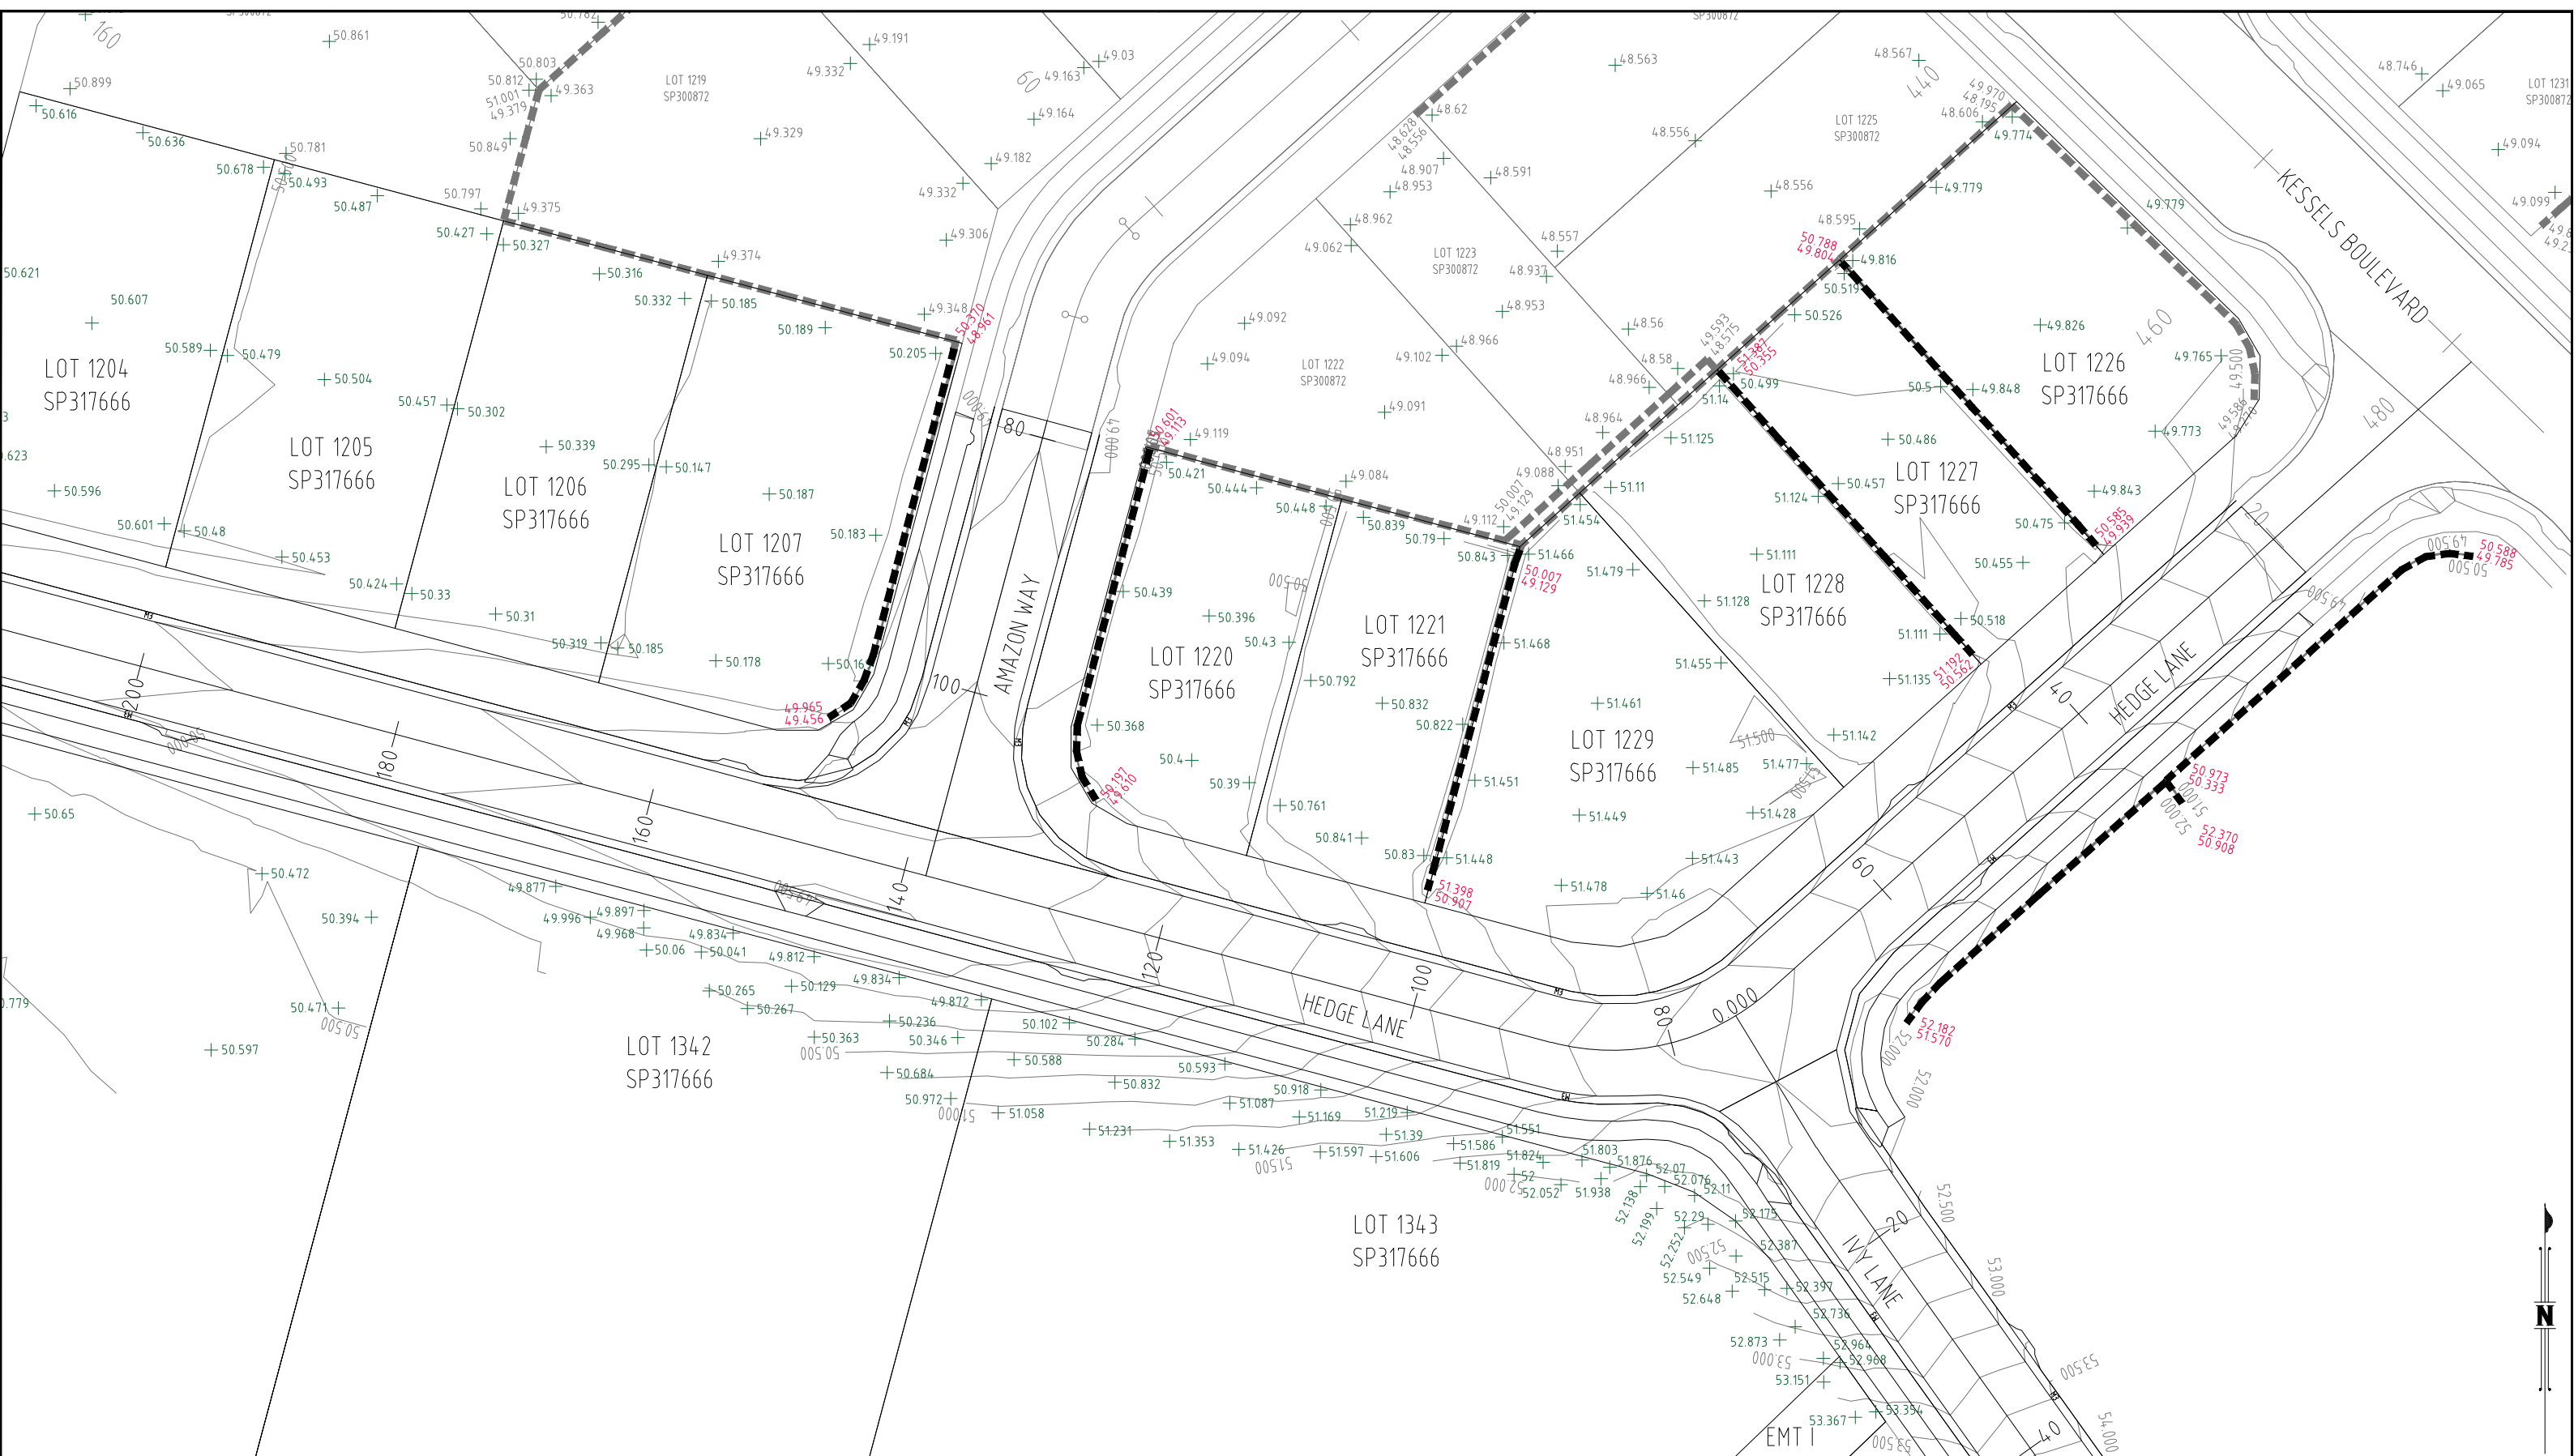


COORDINATE DATUM NOTE:
 HORIZONTAL COORDINATES(E,N) SUPPLIED ARE MAPPING GRID OF AUSTRALIA(MGA), ZONE 56 BASED ON THE UNIVERSAL TRANSVERSE MERCATOR PROJECTION AND THE GEOCENTRIC DATUM OF AUSTRALIA 1994.
 HORIZONTAL DATUM DERIVED FROM PSM 61308 E 4.98528.114 N 6931171.033.
 LEVELS SUPPLIED ARE ON THE AUSTRALIAN HEIGHT DATUM(AHD) LEVEL DATUM DERIVED FROM PSM 61308 RL54.660 (AHD)

PAVEMENT DESIGN			
HEDGE LANE	LEAF STREET	IVY LANE	DRIVEWAYS
AC(mm)- 35	AC(mm)- 35	AC(mm)- 35	AC(mm)- 35
BASE(2.1)(mm) - 150	BASE(2.1)(mm) - 150	BASE(2.1)(mm) - 150	BASE(2.1)(mm) - 150
SUBBASE(2.3)(mm) - 150	SUBBASE(2.3)(mm) - 150	SUBBASE(2.3)(mm) - 150	SUBBASE(2.3)(mm) - 100
GRASS LANE	AMAZON WAY	RETAINING WALLS	
AC(mm)- 35	AC(mm)- 35	---	
BASE(2.1)(mm) - 150	BASE(2.1)(mm) - 150	ACOUSTIC WALLS	
SUBBASE(2.3)(mm) - 150	SUBBASE(2.3)(mm) - 150	---	

ENGINEER'S CERTIFICATION
 I, _____, hereby certify that:
 1. The information contained in this drawing / document is in compliance with approved drawings and design.
 2. This represents an accurate record of as-constructed works
 3. I accept responsibility for the information contained in this drawing / document.
 RPEQ (signature) RPEQ No. _____ Date: _____

REGISTERED SURVEYOR'S CERTIFICATION
 I, Gordon Nicholson, hereby certify that the vertical and horizontal locations and dimensions shown on this plan are a true and correct record and were located by survey.

 Registered Surveyor (sig.) Reg. Surveyor No. SA 3405 Date: 14/01/2021

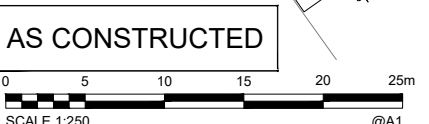

A1



INDEX	DATE	REVISIONS	DRAWN	CHECKED	PASSED	INITIALS	DATE
-	-	-	-	-	-	-	-
A	14/01/2021	AS CONSTRUCTED	NJA	DAM	CW		14/01/2021

DRAWN	NJA	14/01/2021
CHECKED	DAM	14/01/2021
PASSED	CW	14/01/2021



LOGAN CITY COUNCIL
 MIRVAC MIR001-05
 AS CONSTRUCTED SURVEY - ROADS AND EARTHWORKS
 EVERLEIGH PRECINCT 15A
 GREENBANK QLD

SHEET 5 OF 5 SHEETS	SCALE 1:250 A1
REVISION DATE 14/01/2021	REVISION A
DISCIPLINE CODE -	
DRAWING NO. ASC-RDS AND EW-05-15A	

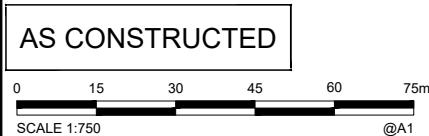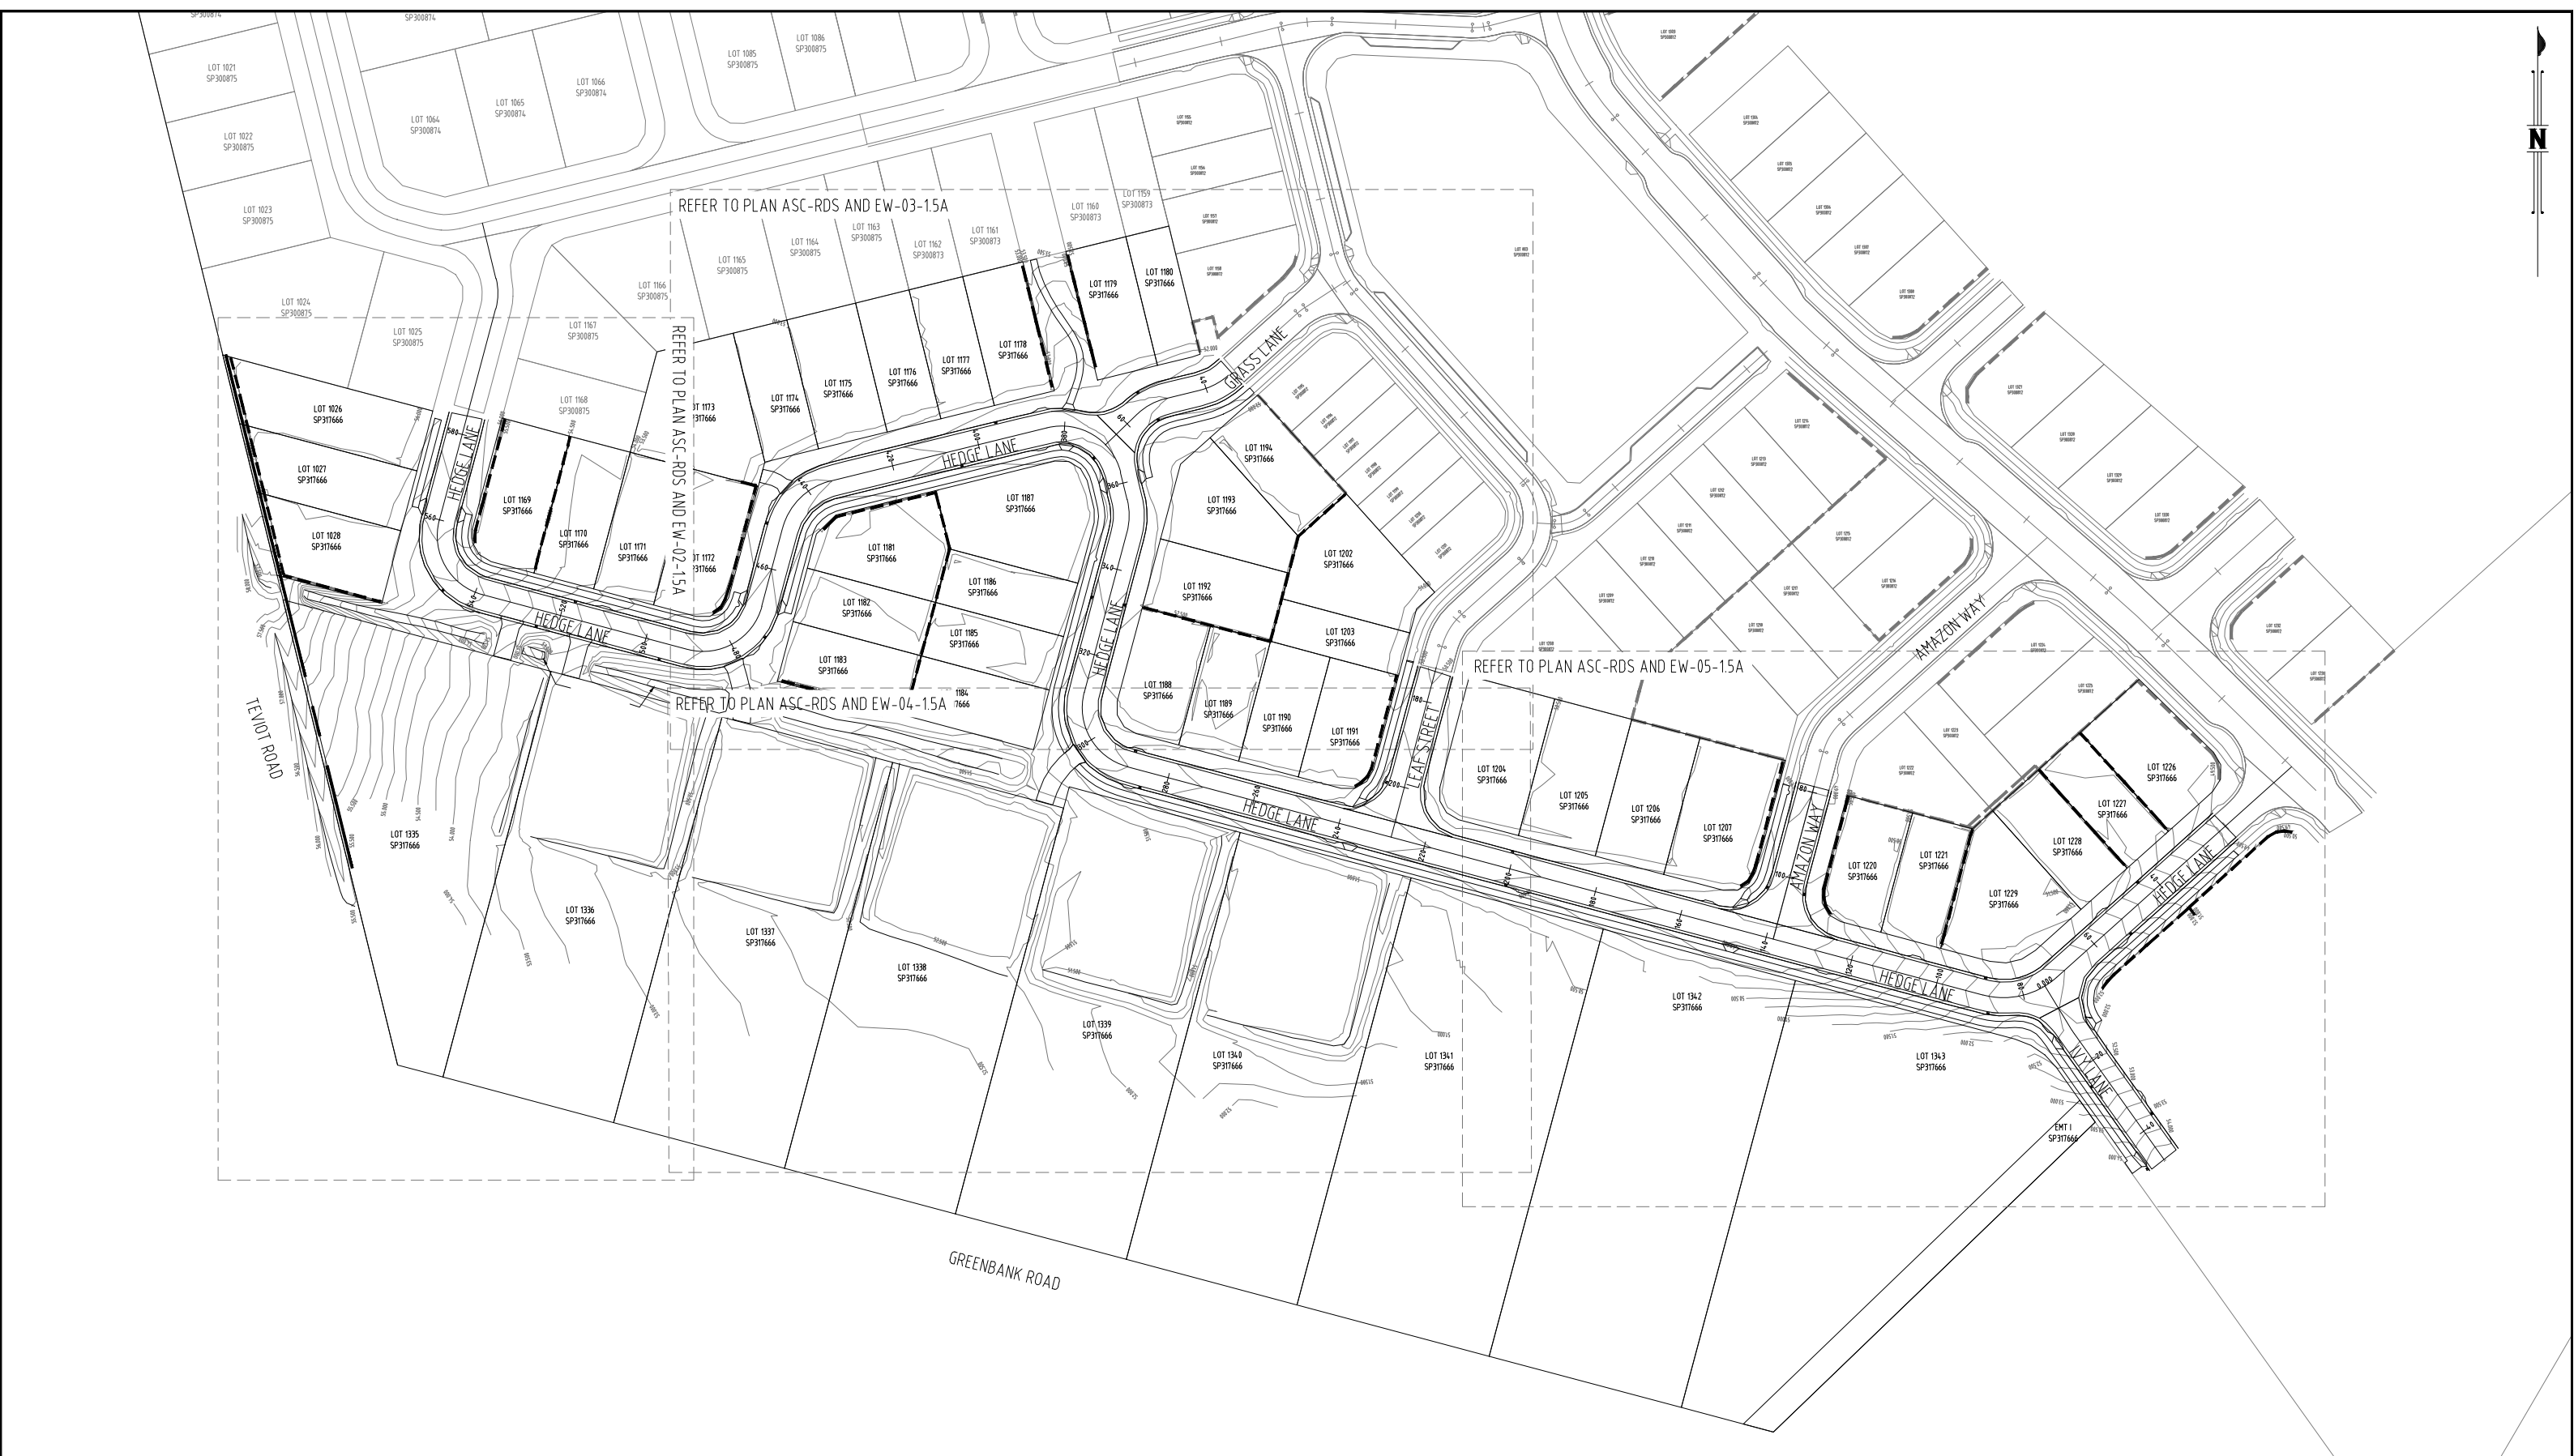

COORDINATE DATUM NOTE:

HORIZONTAL COORDINATES (E,N) SUPPLIED ARE MAPPING GRID OF AUSTRALIA (MGA), ZONE 56 BASED ON THE UNIVERSAL TRANSVERSE MERCATOR PROJECTION AND THE GEOCENTRIC DATUM OF AUSTRALIA 1994.
 HORIZONTAL DATUM DERIVED FROM PSM 61308 E 4.98528.114 N 6931171.033.
 LEVELS SUPPLIED ARE ON THE AUSTRALIAN HEIGHT DATUM (AHD) LEVEL DATUM DERIVED FROM PSM 61308 RL54.660 (AHD)

PAVEMENT DESIGN			
HEDGE LANE	LEAF STREET	IVY LANE	DRIVEWAYS
AC(mm)- 35	AC(mm)- 35	AC(mm)- 35	AC(mm)- 35
BASE(2.1)(mm) - 150	BASE(2.1)(mm) - 150	BASE(2.1)(mm) - 150	BASE(2.1)(mm) - 150
SUBBASE(2.3)(mm) - 150	SUBBASE(2.3)(mm) - 150	SUBBASE(2.3)(mm) - 150	SUBBASE(2.3)(mm) - 100
GRASS LANE	AMAZON WAY	RETAINING WALLS	
AC(mm)- 35	AC(mm)- 35	ACOUSTIC WALLS	
BASE(2.1)(mm) - 150	BASE(2.1)(mm) - 150		
SUBBASE(2.3)(mm) - 150	SUBBASE(2.3)(mm) - 150		

ENGINEER'S CERTIFICATION

I, _____, hereby certify that:

- The information contained in this drawing / document is in compliance with approved drawings and design.
- This represents an accurate record of as-constructed works
- I accept responsibility for the information contained in this drawing / document.

RPEQ (signature) RPEQ No. _____ Date: _____

REGISTERED SURVEYOR'S CERTIFICATION

I, Gordon Nicholson, hereby certify that the vertical and horizontal locations and dimensions shown on this plan are a true and correct record and were located by survey.

Registered Surveyor (sig.) Reg. Surveyor No. SA 3405 Date: 14/01/2021

A1	INDEX	DATE	AS CONSTRUCTED	REVISIONS	DRAWN	CHECKED	PASSED
	A	14/01/2021	AS CONSTRUCTED		NJA	DAM	CW

DRAWN	NJA	14/01/2021
CHECKED	DAM	14/01/2021
PASSED	CW	14/01/2021
INITIALS		DATE



LOGAN CITY COUNCIL

MIRVAC MIR001-05
 AS CONSTRUCTED SURVEY - ROADS AND EARTHWORKS
 EVERLEIGH PRECINCT 15A
 GREENBANK QLD

SHEET 1 OF 5 SHEETS	SCALE 1:750 A1
REVISION DATE 14/01/2021	REVISION A
DISCIPLINE CODE -	
DRAWING NO. ASC-RDS AND EW-01-1.5A	