

PM61308 RL
 E: 498528.114
 N: 6931171.033
 RL: 54.660m

REGISTERED SURVEYOR'S CERTIFICATION

I, Gordon Nicholson, hereby certify that the vertical and horizontal locations and dimensions shown on this plan are a true and correct record and were located by survey.

Registered Surveyor (sig) SA 3405 Date: 06/01/2021


COORDINATE DATUM NOTE:
 HORIZONTAL COORDINATES(E,N) SUPPLIED ARE MAPPING GRID OF AUSTRALIA(MGA), ZONE 56 BASED ON THE UNIVERSAL TRANSVERSE MERCATOR PROJECTION AND THE GEOCENTRIC DATUM OF AUSTRALIA 1994.
 HORIZONTAL DATUM DERIVED FROM PSM 61308 E 498528.114 N 6931171.033.
 LEVELS SUPPLIED ARE ON THE AUSTRALIAN HEIGHT DATUM(AHD)
 LEVEL DATUM DERIVED FROM PSM 61308 RL54.660 (AHD)

ENGINEER'S CERTIFICATION


I, _____, hereby certify that:

- The information contained in this drawing / document is in compliance with approved drawings and design.
- This represents an accurate record of as-constructed works.
- I accept responsibility for the information contained in this drawing / document.

RPEQ (signature) RPEQ No. _____ Date: _____

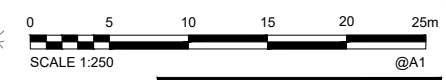


AS CONSTRUCTED

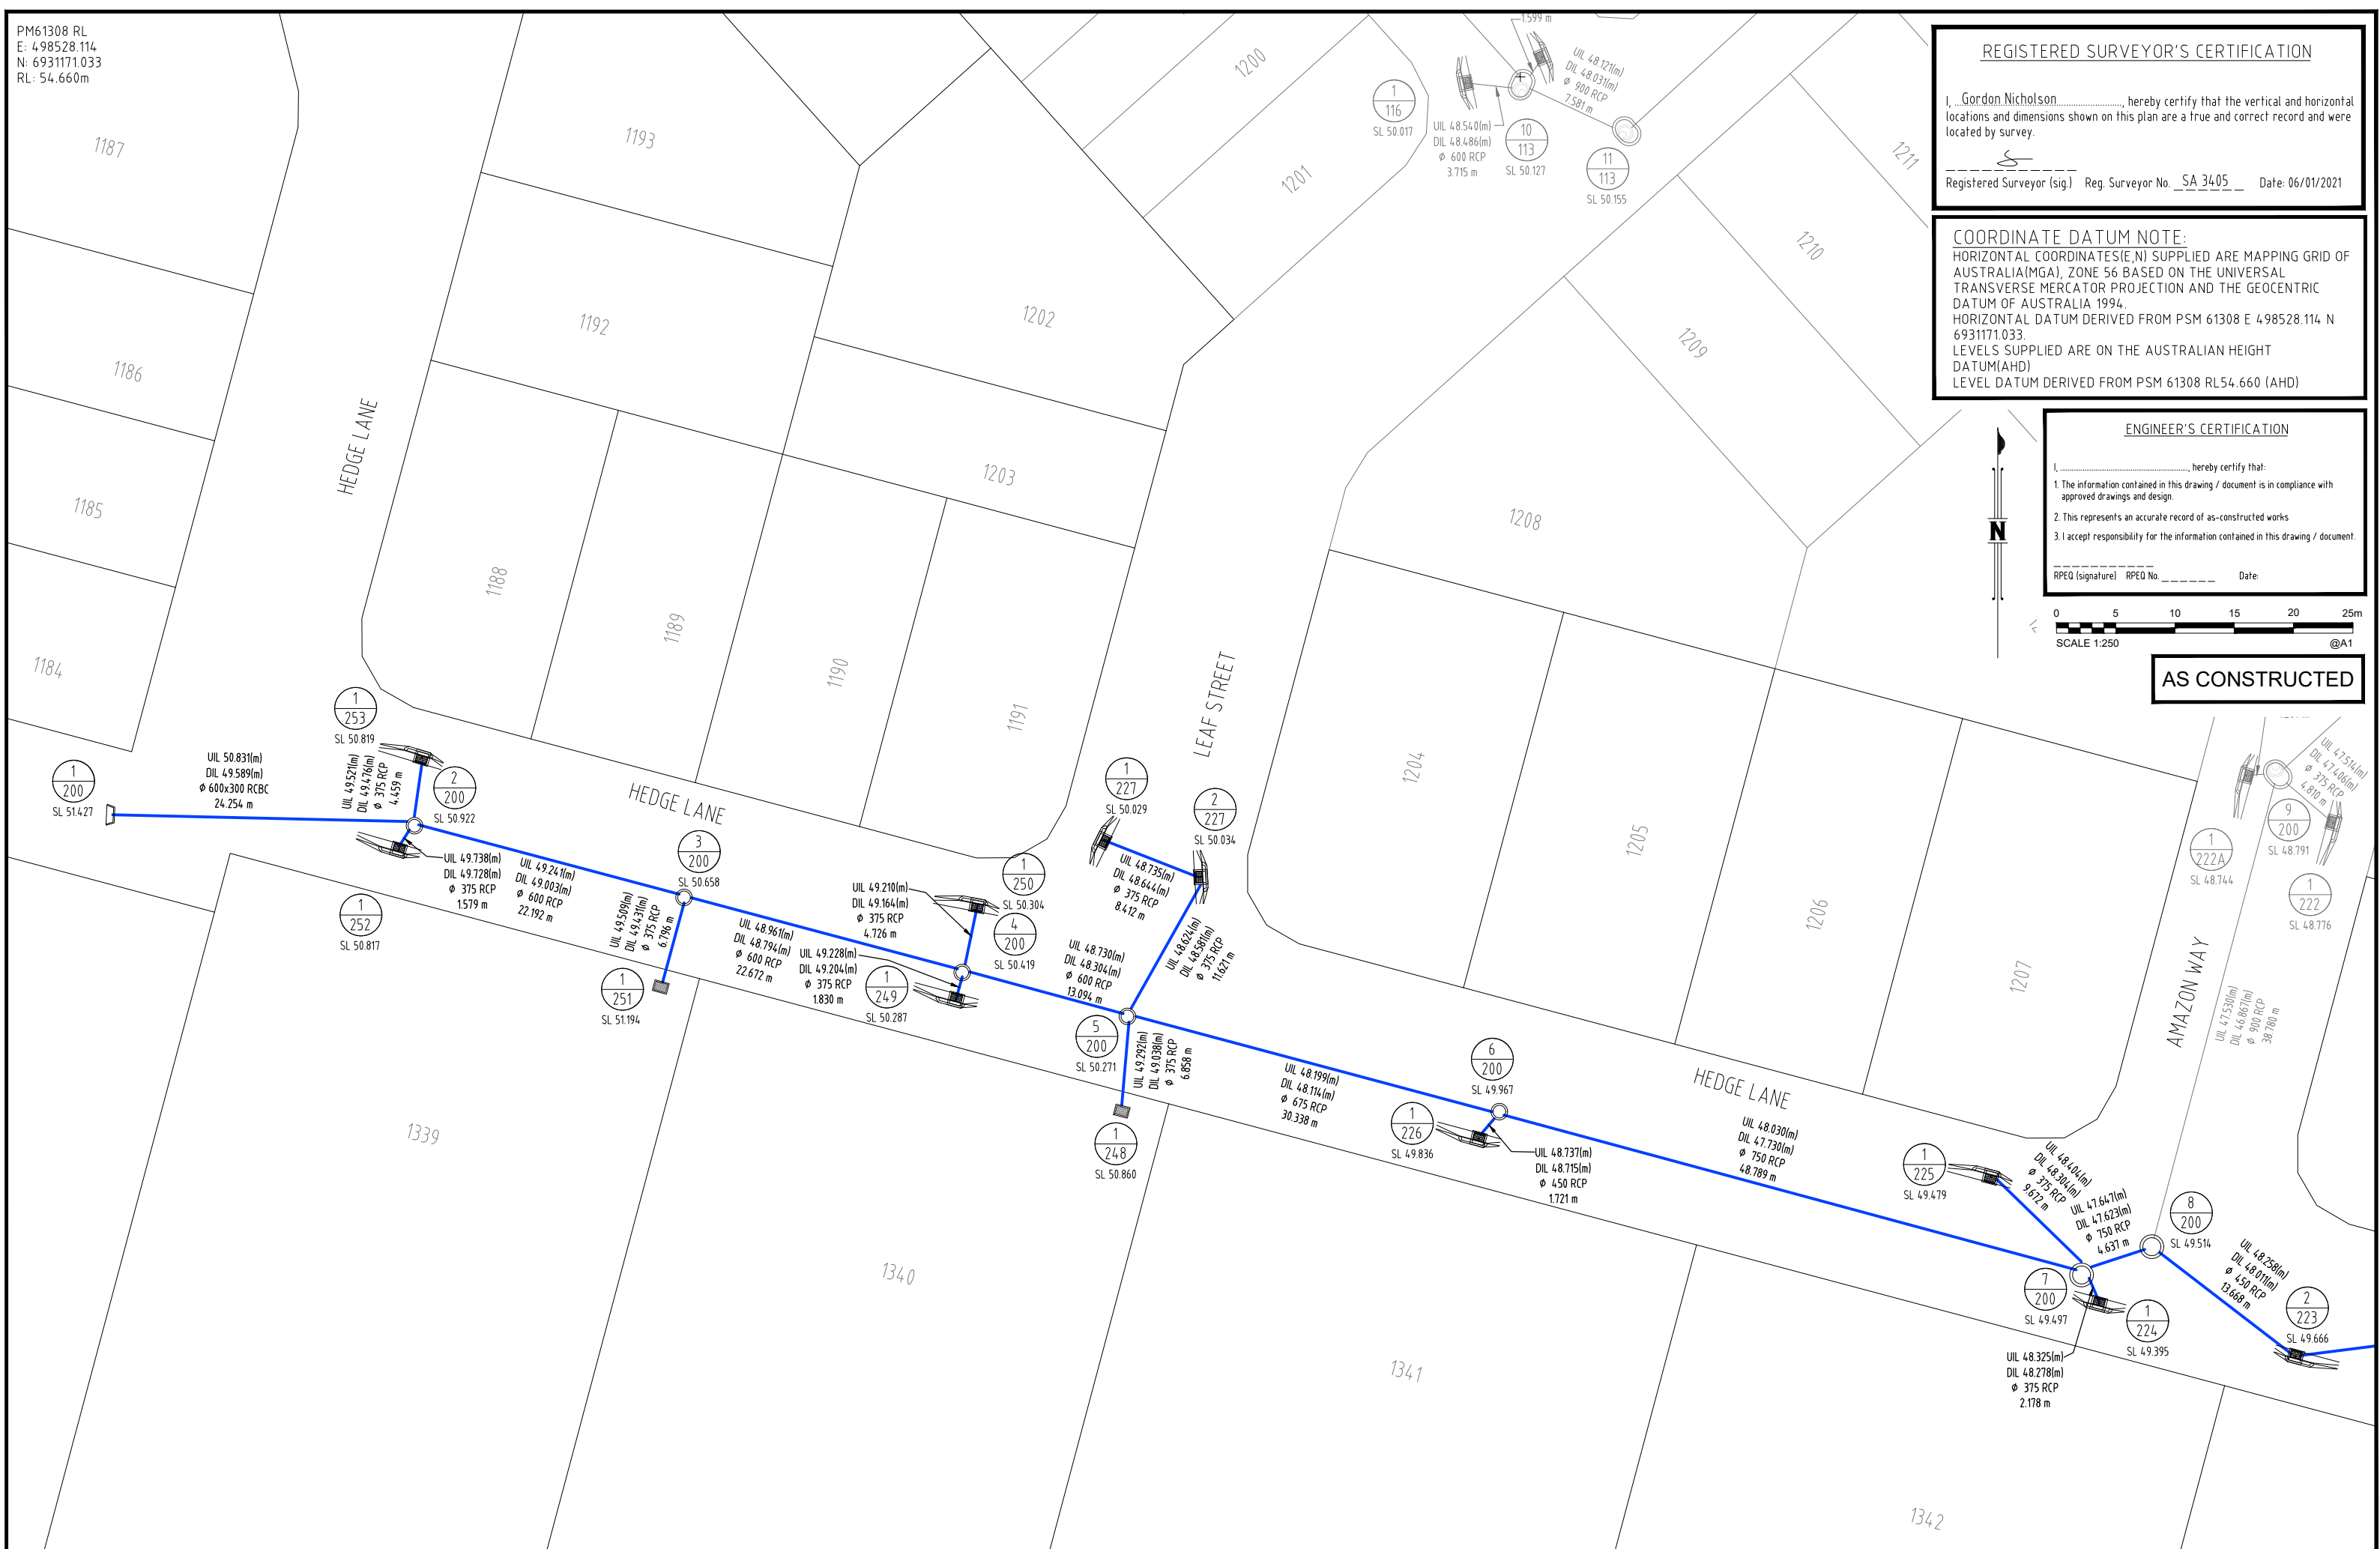


A1	INDEX	DATE	REVISIONS	DRAWN	CHECKED	PASSED	INITIALS	DATE	 <small>50 Sandstone Lane, Forest Glen QLD 4055 Ph: 07 5488 2000 Fax: 07 5488 2000 Email: info@shadforth.com.au</small>	 LOGAN CITY COUNCIL	LOGAN CITY COUNCIL MIRVAC MIR001-05 AS CONSTRUCTED SURVEY - STORMWATER EVERLEIGH PRECINCT 15B GREENBANK QLD	SHEET 3 OF 4 SHEETS	SCALE 1:250 A1
	A	06/01/2021	AS CONSTRUCTED	NJA	DAM	CW						REVISION DATE 06/01/2021	REVISION A

PM61308 RL
 E: 498528.114
 N: 6931171.033
 RL: 54.660m

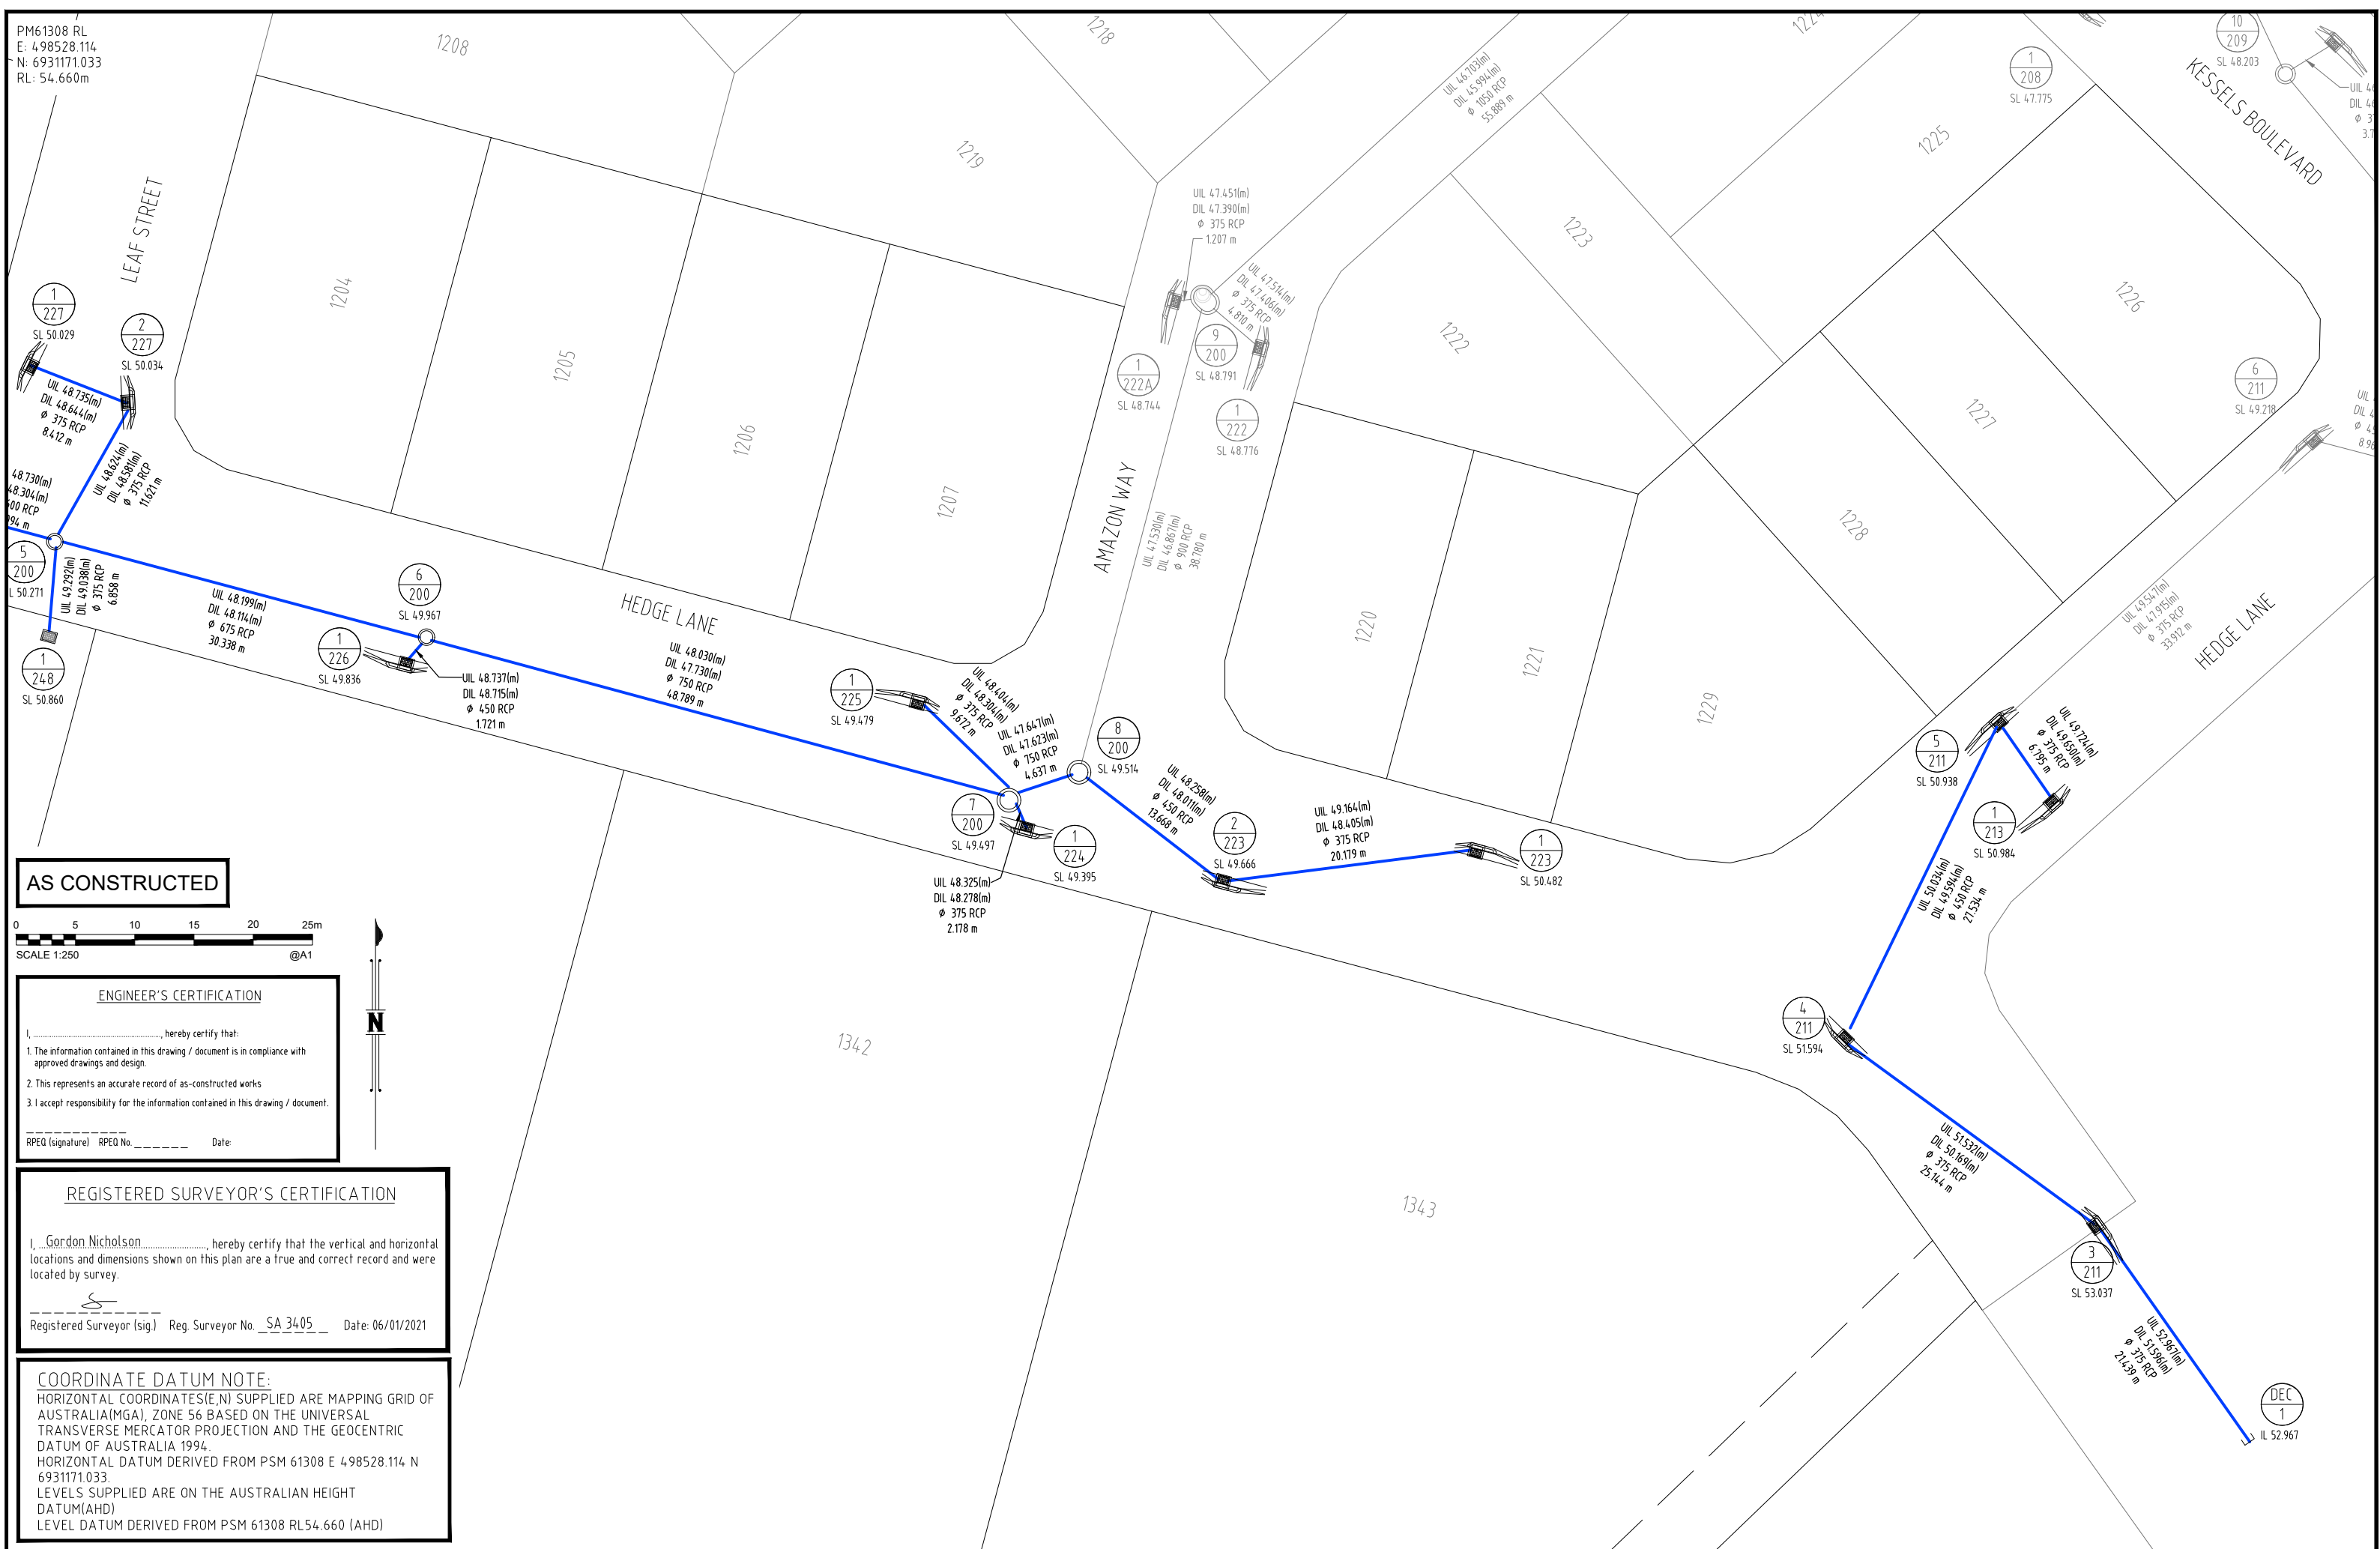

AS CONSTRUCTED

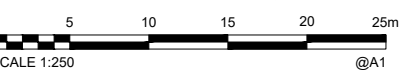

ENGINEER'S CERTIFICATION

I, _____, hereby certify that:

- The information contained in this drawing / document is in compliance with approved drawings and design.
- This represents an accurate record of as-constructed works
- I accept responsibility for the information contained in this drawing / document.

RPEQ (signature) RPEQ No. _____ Date: _____

REGISTERED SURVEYOR'S CERTIFICATION

I, Gordon Nicholson, hereby certify that the vertical and horizontal locations and dimensions shown on this plan are a true and correct record and were located by survey.

Registered Surveyor (sig.) Reg. Surveyor No. SA 3405 Date: 06/01/2021

COORDINATE DATUM NOTE:
 HORIZONTAL COORDINATES (E,N) SUPPLIED ARE MAPPING GRID OF AUSTRALIA (MGA), ZONE 56 BASED ON THE UNIVERSAL TRANSVERSE MERCATOR PROJECTION AND THE GEOCENTRIC DATUM OF AUSTRALIA 1994.
 HORIZONTAL DATUM DERIVED FROM PSM 61308 E 498528.114 N 6931171.033
 LEVELS SUPPLIED ARE ON THE AUSTRALIAN HEIGHT DATUM (AHD)
 LEVEL DATUM DERIVED FROM PSM 61308 RL54.660 (AHD)

A1	INDEX	DATE	REVISIONS	DRAWN	CHECKED	PASSED
	A	06/01/2021	AS CONSTRUCTED	NJA	DAM	CW

shadforth


30 Sandwood Lane, Forest Glen QLD 4205
 Ph: 07 5488 2828 Fax: 07 5488 2888 Email: info@shadforth.com.au

LOGAN CITY COUNCIL

LOGAN CITY COUNCIL

MIRVAC MIR001-05
 AS CONSTRUCTED SURVEY - STORMWATER
 EVERLEIGH PRECINCT 15A
 GREENBANK QLD

SHEET 4 OF 4 SHEETS	SCALE 1:250 A1
REVISION DATE 06/01/2021	REVISION A
DISCIPLINE CODE -	
DRAWING NO. ASC-STORM-04-15A	

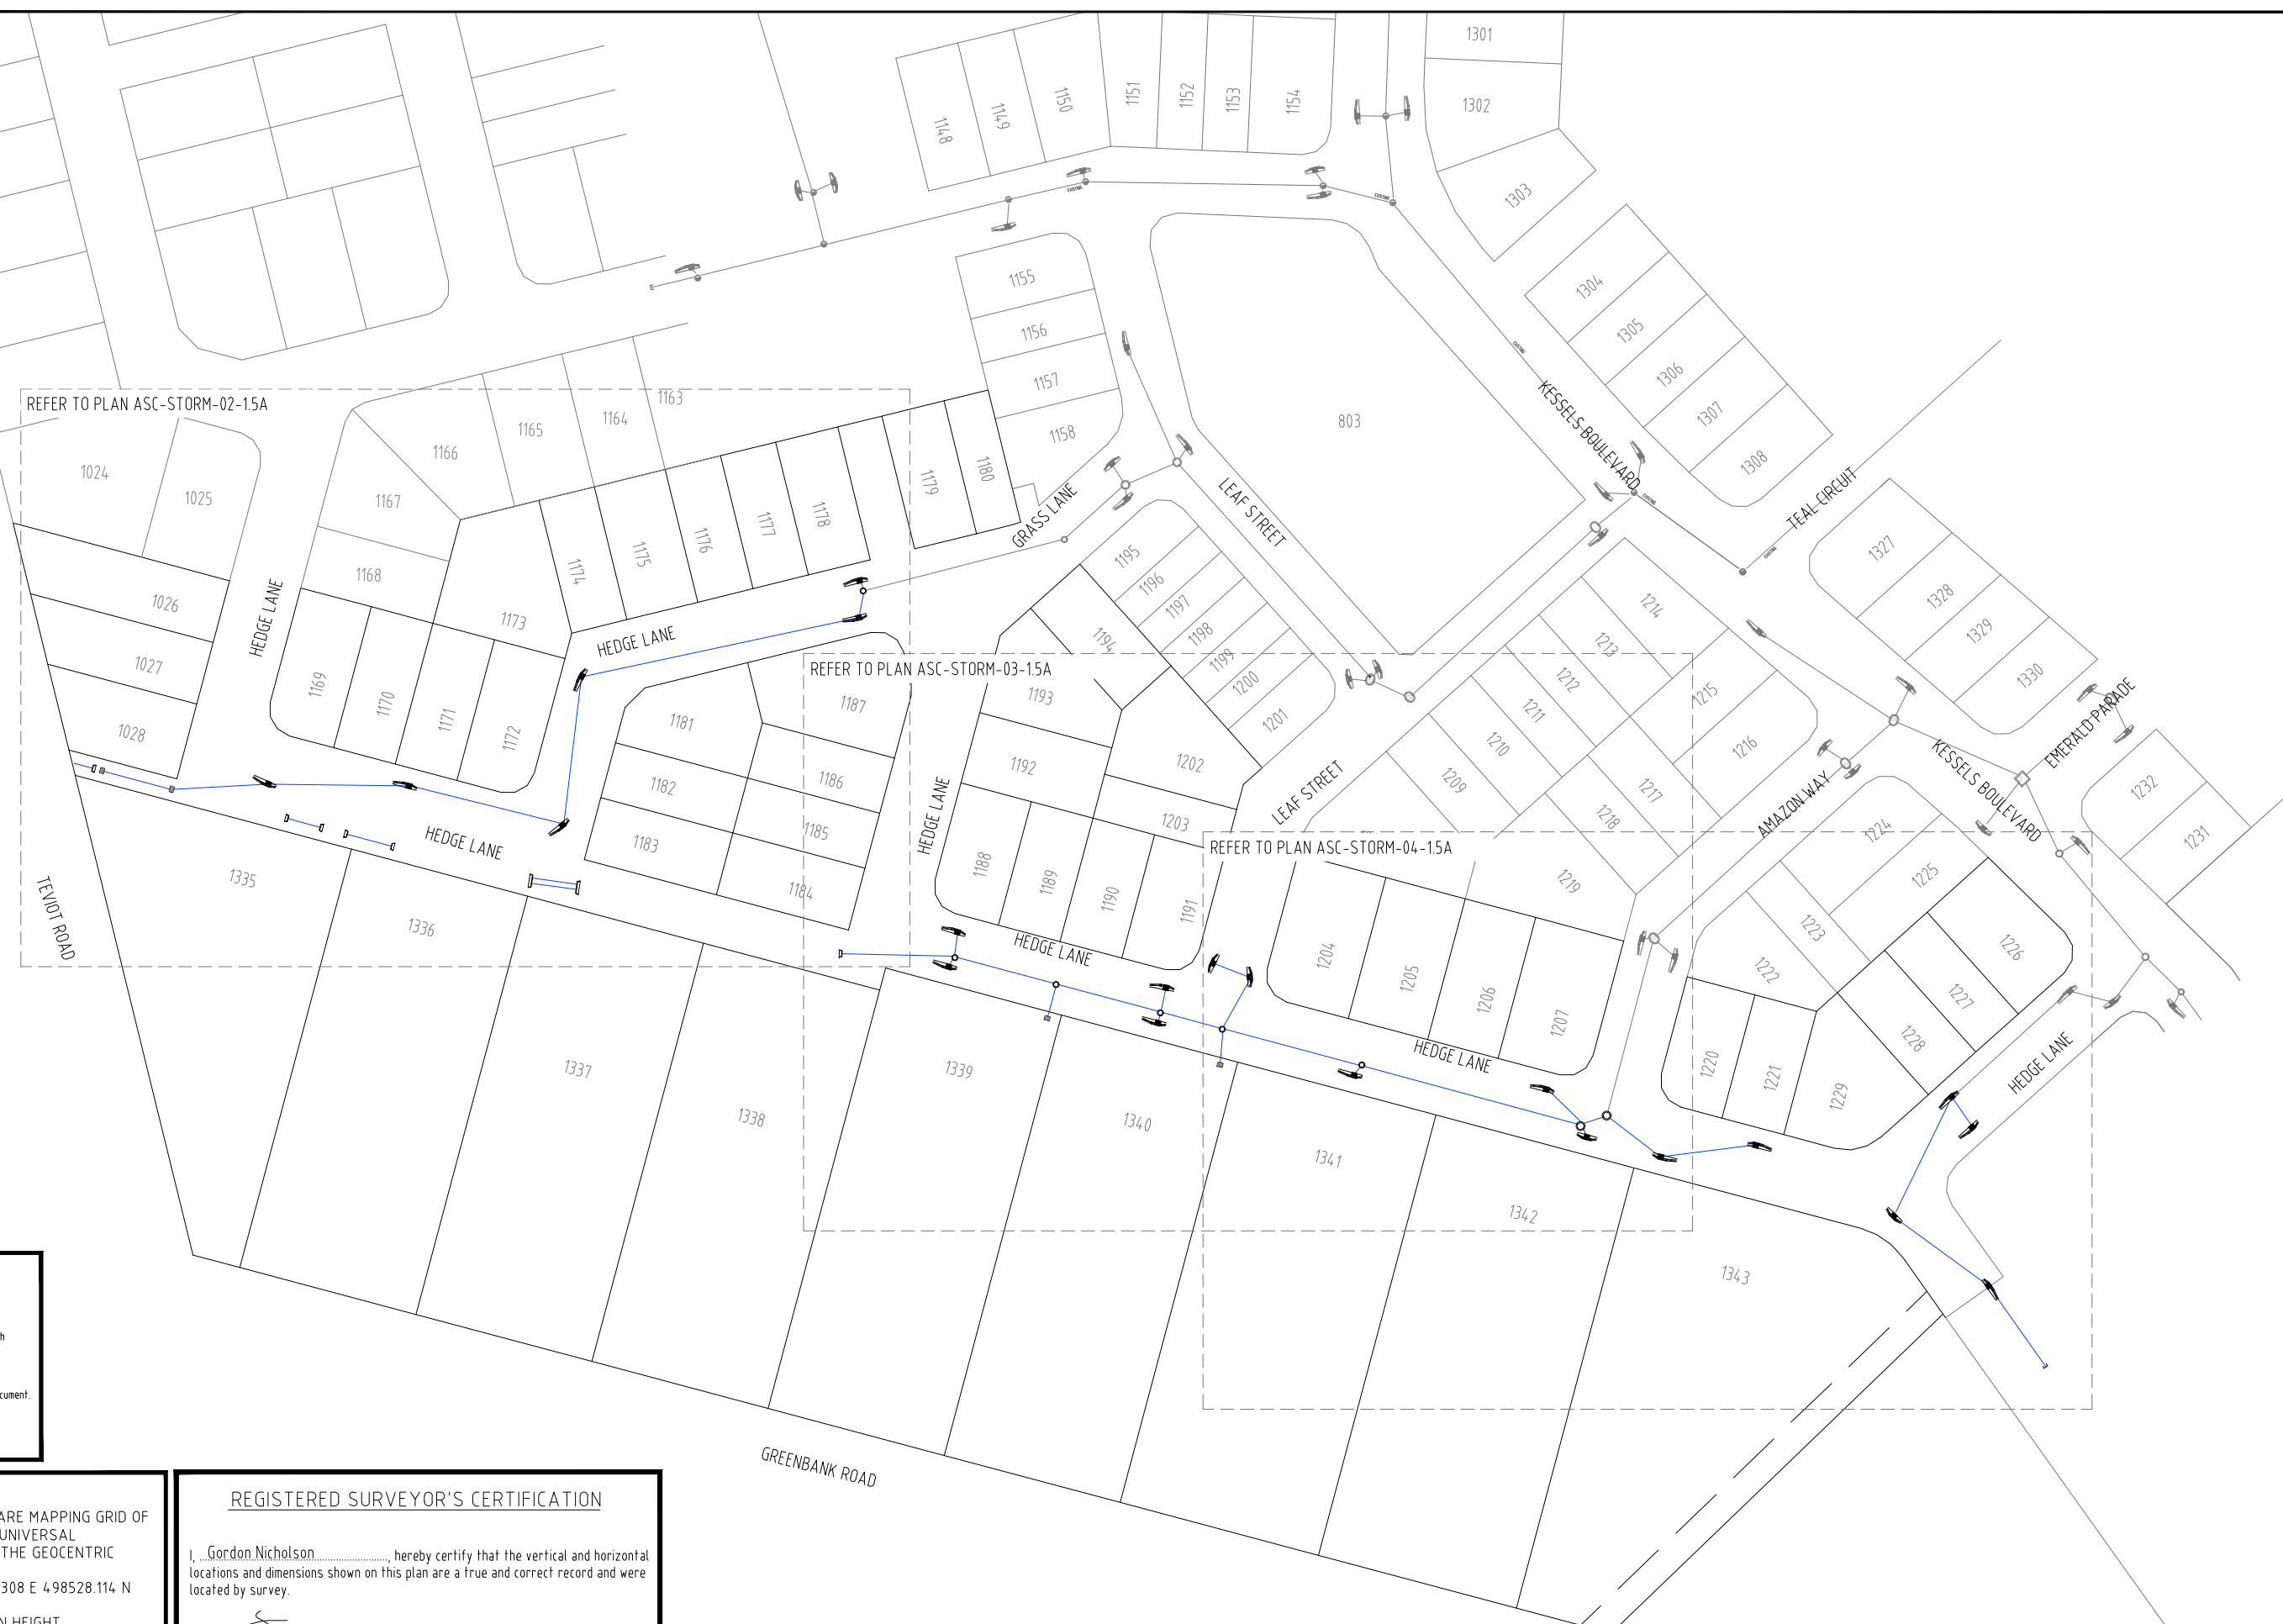

ENGINEER'S CERTIFICATION

I, _____, hereby certify that:

- The information contained in this drawing / document is in compliance with approved drawings and design.
- This represents an accurate record of as-constructed works
- I accept responsibility for the information contained in this drawing / document.


 RPEQ (signature) RPEQ No. _____ Date: _____

COORDINATE DATUM NOTE:
 HORIZONTAL COORDINATES(E,N) SUPPLIED ARE MAPPING GRID OF AUSTRALIA(MGA), ZONE 56 BASED ON THE UNIVERSAL TRANSVERSE MERCATOR PROJECTION AND THE GEOCENTRIC DATUM OF AUSTRALIA 1994.
 HORIZONTAL DATUM DERIVED FROM PSM 61308 E 498528.114 N 6931171.033.
 LEVELS SUPPLIED ARE ON THE AUSTRALIAN HEIGHT DATUM(AHD)
 LEVEL DATUM DERIVED FROM PSM 61308 RL54.660 (AHD)

REGISTERED SURVEYOR'S CERTIFICATION

I, Gordon Nicholson, hereby certify that the vertical and horizontal locations and dimensions shown on this plan are a true and correct record and were located by survey.

 Registered Surveyor (sig.) Reg. Surveyor No. SA 3405 Date: 06/01/2021

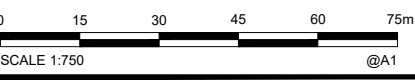

AS CONSTRUCTED

A1	INDEX	DATE	REVISIONS	DRAWN	CHECKED	PASSED	INITIALS	DATE
	A	06/01/2021	AS CONSTRUCTED	NJA	DAM	CW		06/01/2021



LOGAN CITY COUNCIL

MIRVAC MIR001-05
 AS CONSTRUCTED SURVEY - STORMWATER
 EVERLEIGH PRECINCT 15A
 GREENBANK QLD

SHEET 1 OF 4 SHEETS	SCALE 1:750 A1
REVISION DATE 06/01/2021	REVISION A
DISCIPLINE CODE -	
DRAWING NO. ASC-STORM-01-15A	

REGISTERED SURVEYOR'S CERTIFICATION

PM61308 RL
E: 498528.114
N: 6931171.033
RL: 54.660m

I, Gordon Nicholson, hereby certify that the vertical and horizontal locations and dimensions shown on this plan are a true and correct record and were located by survey.

Registered Surveyor (sig) Reg. Surveyor No. SA 3405 Date: 06/01/2021

COORDINATE DATUM NOTE:

HORIZONTAL COORDINATES(E,N) SUPPLIED ARE MAPPING GRID OF AUSTRALIA(MGA), ZONE 56 BASED ON THE UNIVERSAL TRANSVERSE MERCATOR PROJECTION AND THE GEOCENTRIC DATUM OF AUSTRALIA 1994.
HORIZONTAL DATUM DERIVED FROM PSM 61308 E 498528.114 N 6931171.033.
LEVELS SUPPLIED ARE ON THE AUSTRALIAN HEIGHT DATUM(AHD)
LEVEL DATUM DERIVED FROM PSM 61308 RL54.660 (AHD)


ENGINEER'S CERTIFICATION

I, _____, hereby certify that:
1. The information contained in this drawing / document is in compliance with approved drawings and design.
2. This represents an accurate record of as-constructed works.
3. I accept responsibility for the information contained in this drawing / document.

RPEQ (signature) RPEQ No. _____ Date: _____

0 5 10 15 20 25m
SCALE 1:250 @A1

AS CONSTRUCTED

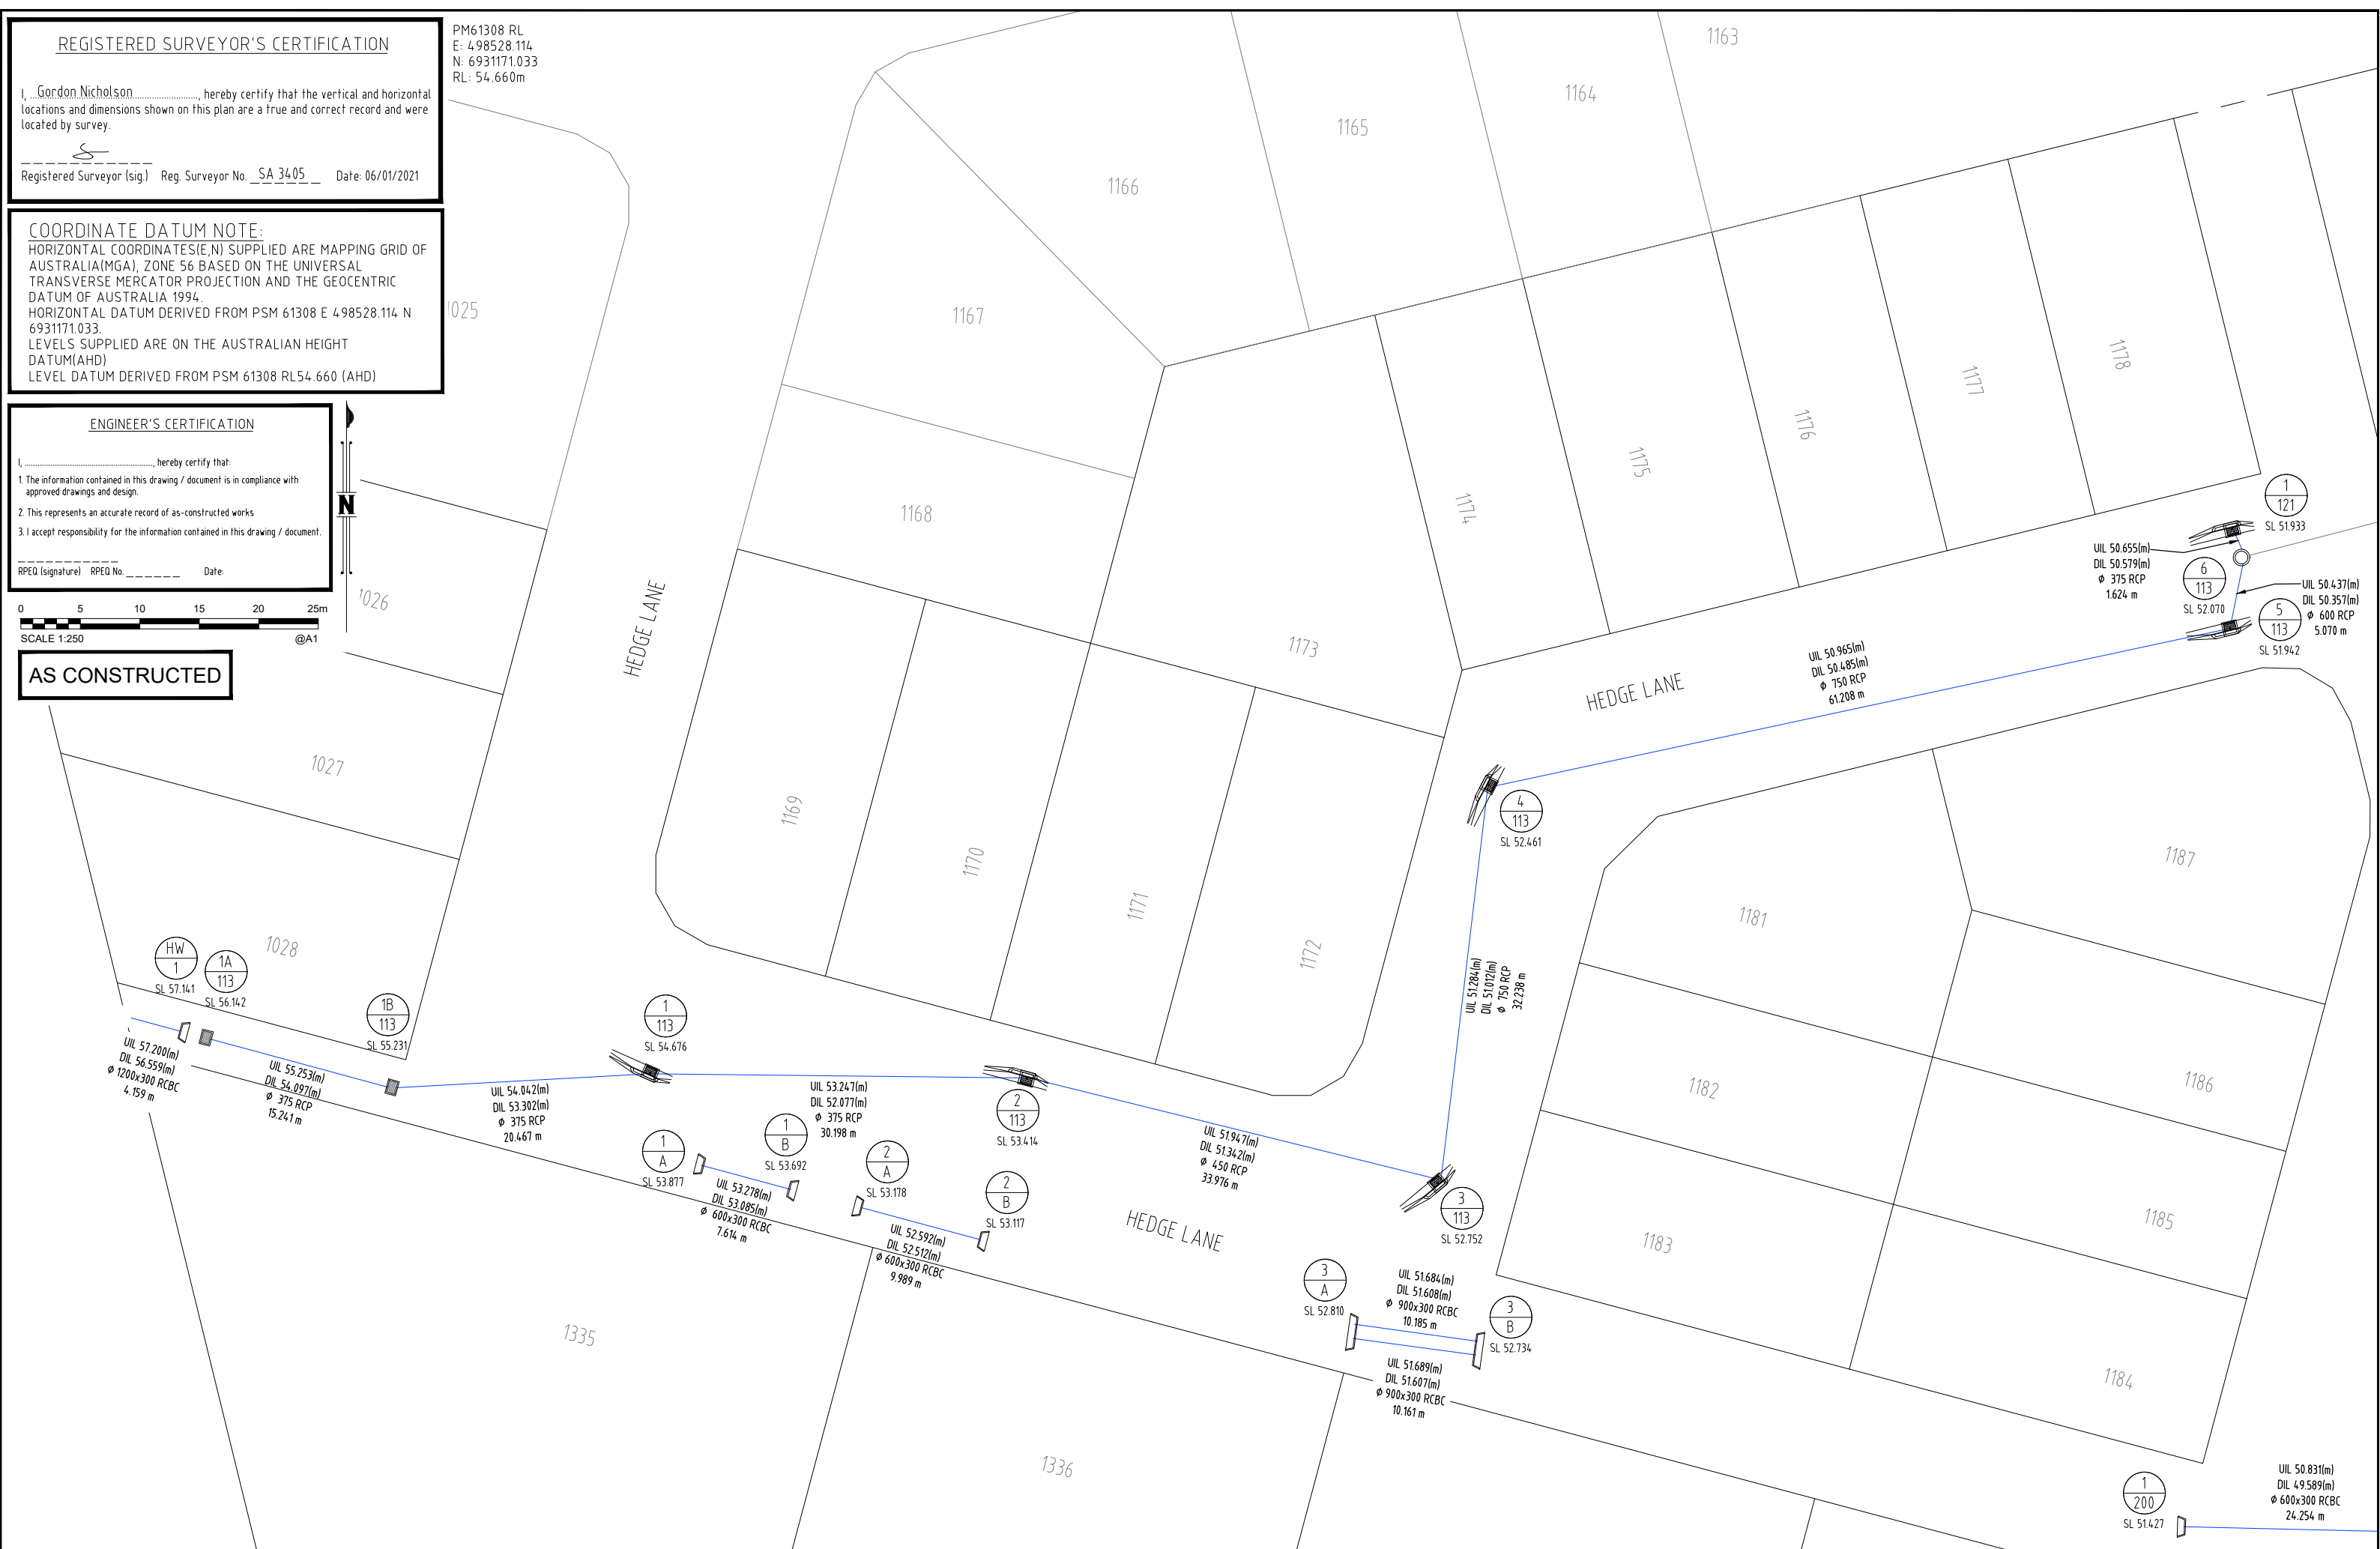

A1

INDEX	DATE	REVISIONS	DRAWN	CHECKED	PASSED	INITIALS	DATE
A	06/01/2021	AS CONSTRUCTED	NJA	DAM	CW		06/01/2021



LOGAN CITY COUNCIL
MIRVAC MIR001-05
AS CONSTRUCTED SURVEY - STORMWATER
EVERLEIGH PRECINCT 1.5
GREENBANK QLD

SHEET 2 OF 4 SHEETS	SCALE 1:250 A1
REVISION DATE 06/01/2021	REVISION A
DISCIPLINE CODE -	
DRAWING NO. ASC-STORM-02-1.5A	