


PM61308 RL
 E: 4.98528.114
 N: 6.931171.033
 RL: 54.660m

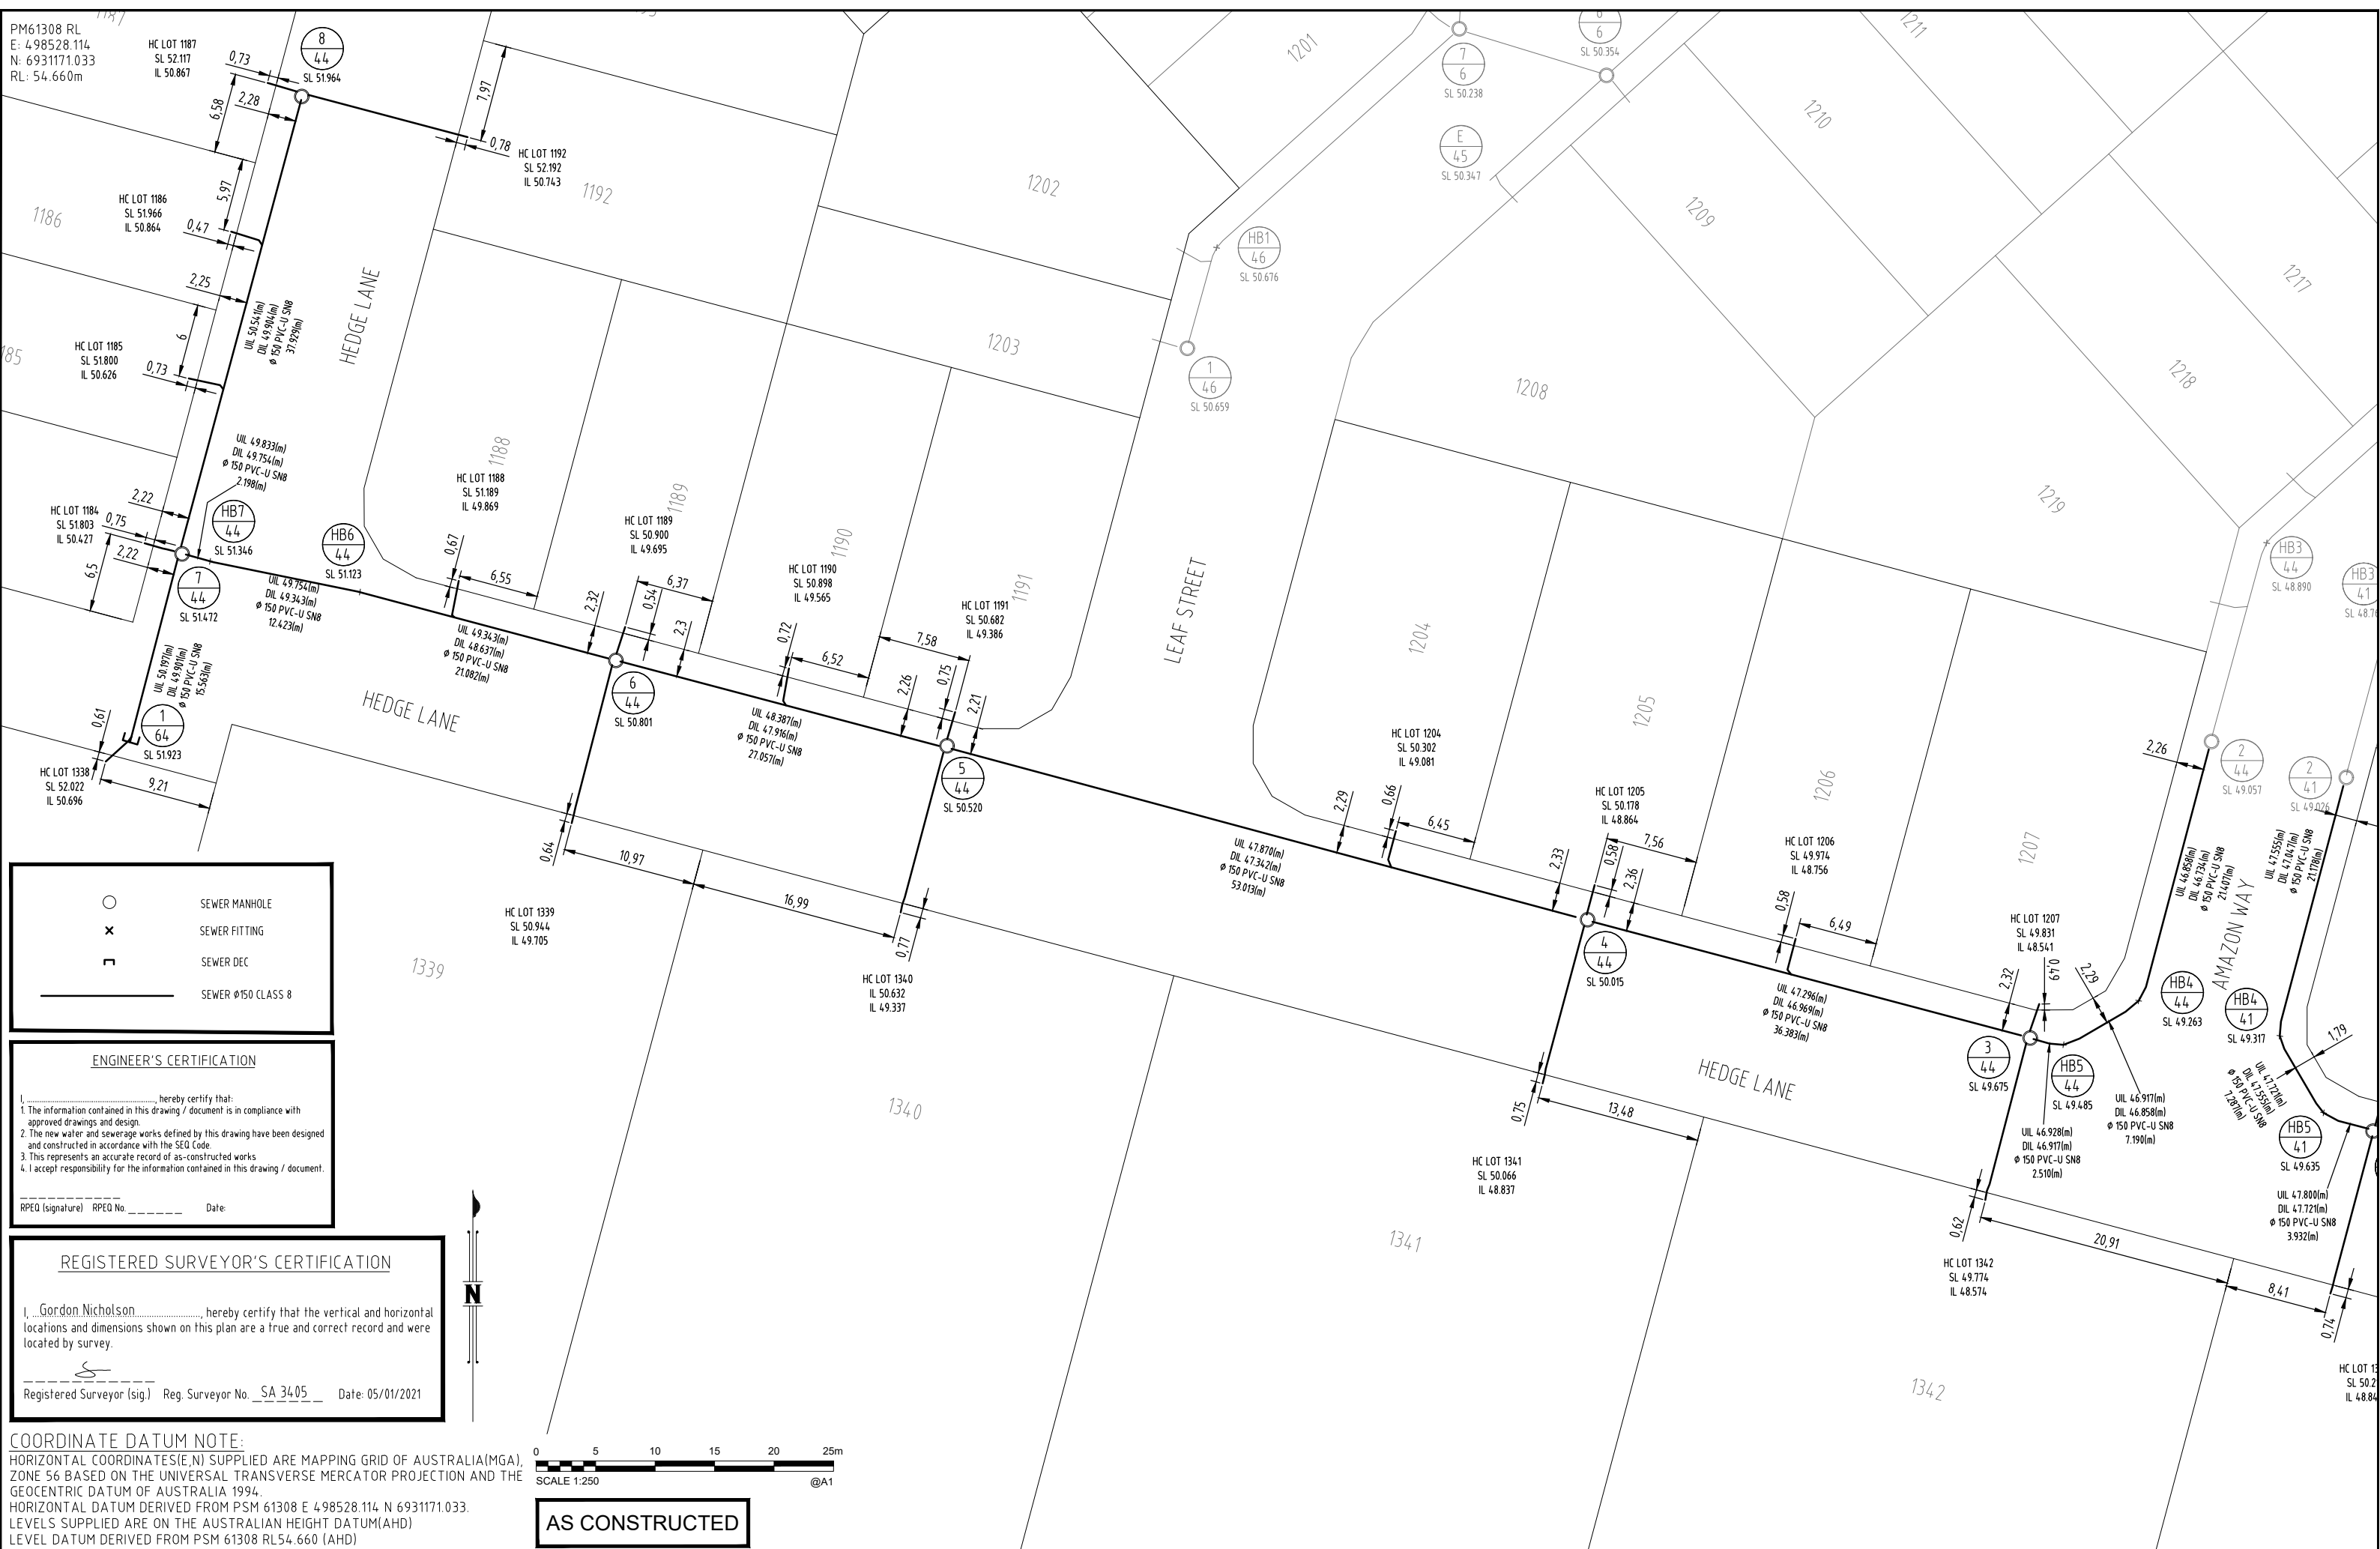

○	SEWER MANHOLE
×	SEWER FITTING
□	SEWER DEC
—	SEWER Ø150 CLASS 8

ENGINEER'S CERTIFICATION

I, _____, hereby certify that:

- The information contained in this drawing / document is in compliance with approved drawings and design.
- The new water and sewerage works defined by this drawing have been designed and constructed in accordance with the SEQ Code.
- This represents an accurate record of as-constructed works.
- I accept responsibility for the information contained in this drawing / document.

RPEQ (signature) RPEQ No. _____ Date: _____

REGISTERED SURVEYOR'S CERTIFICATION

I, Gordon Nicholson, hereby certify that the vertical and horizontal locations and dimensions shown on this plan are a true and correct record and were located by survey.

Gordon Nicholson
 Registered Surveyor (sig.) Reg. Surveyor No. SA 34.05 Date: 05/01/2021

COORDINATE DATUM NOTE:
 HORIZONTAL COORDINATES(E,N) SUPPLIED ARE MAPPING GRID OF AUSTRALIA(MGA), ZONE 56 BASED ON THE UNIVERSAL TRANSVERSE MERCATOR PROJECTION AND THE GEOCENTRIC DATUM OF AUSTRALIA 1994.
 HORIZONTAL DATUM DERIVED FROM PSM 61308 E 4.98528.114 N 6.931171.033.
 LEVELS SUPPLIED ARE ON THE AUSTRALIAN HEIGHT DATUM(AHD)
 LEVEL DATUM DERIVED FROM PSM 61308 RL54.660 (AHD)



AS CONSTRUCTED

A1	A	05/01/2021	AS CONSTRUCTED	NJA	DAM	LS	DRAWN	CHECKED	PASSED	INITIALS	DATE
	INDEX	DATE	REVISIONS	DRAWN	CHECKED	PASSED					





LOGAN CITY COUNCIL

MIRVAC MIR001-05
 AS CONSTRUCTED SURVEY - SEWER
 EVERLEIGH PRECINCT 15A
 GREENBANK QLD

SHEET 3 OF 4 SHEETS	SCALE 1:250 A1
REVISION DATE 05/01/2021	REVISION A
DISCIPLINE CODE -	
DRAWING NO. ASC-SEWER-03-15A	

PM61308 RL
 E: 498528.114
 N: 6931171.033
 RL: 54.660m

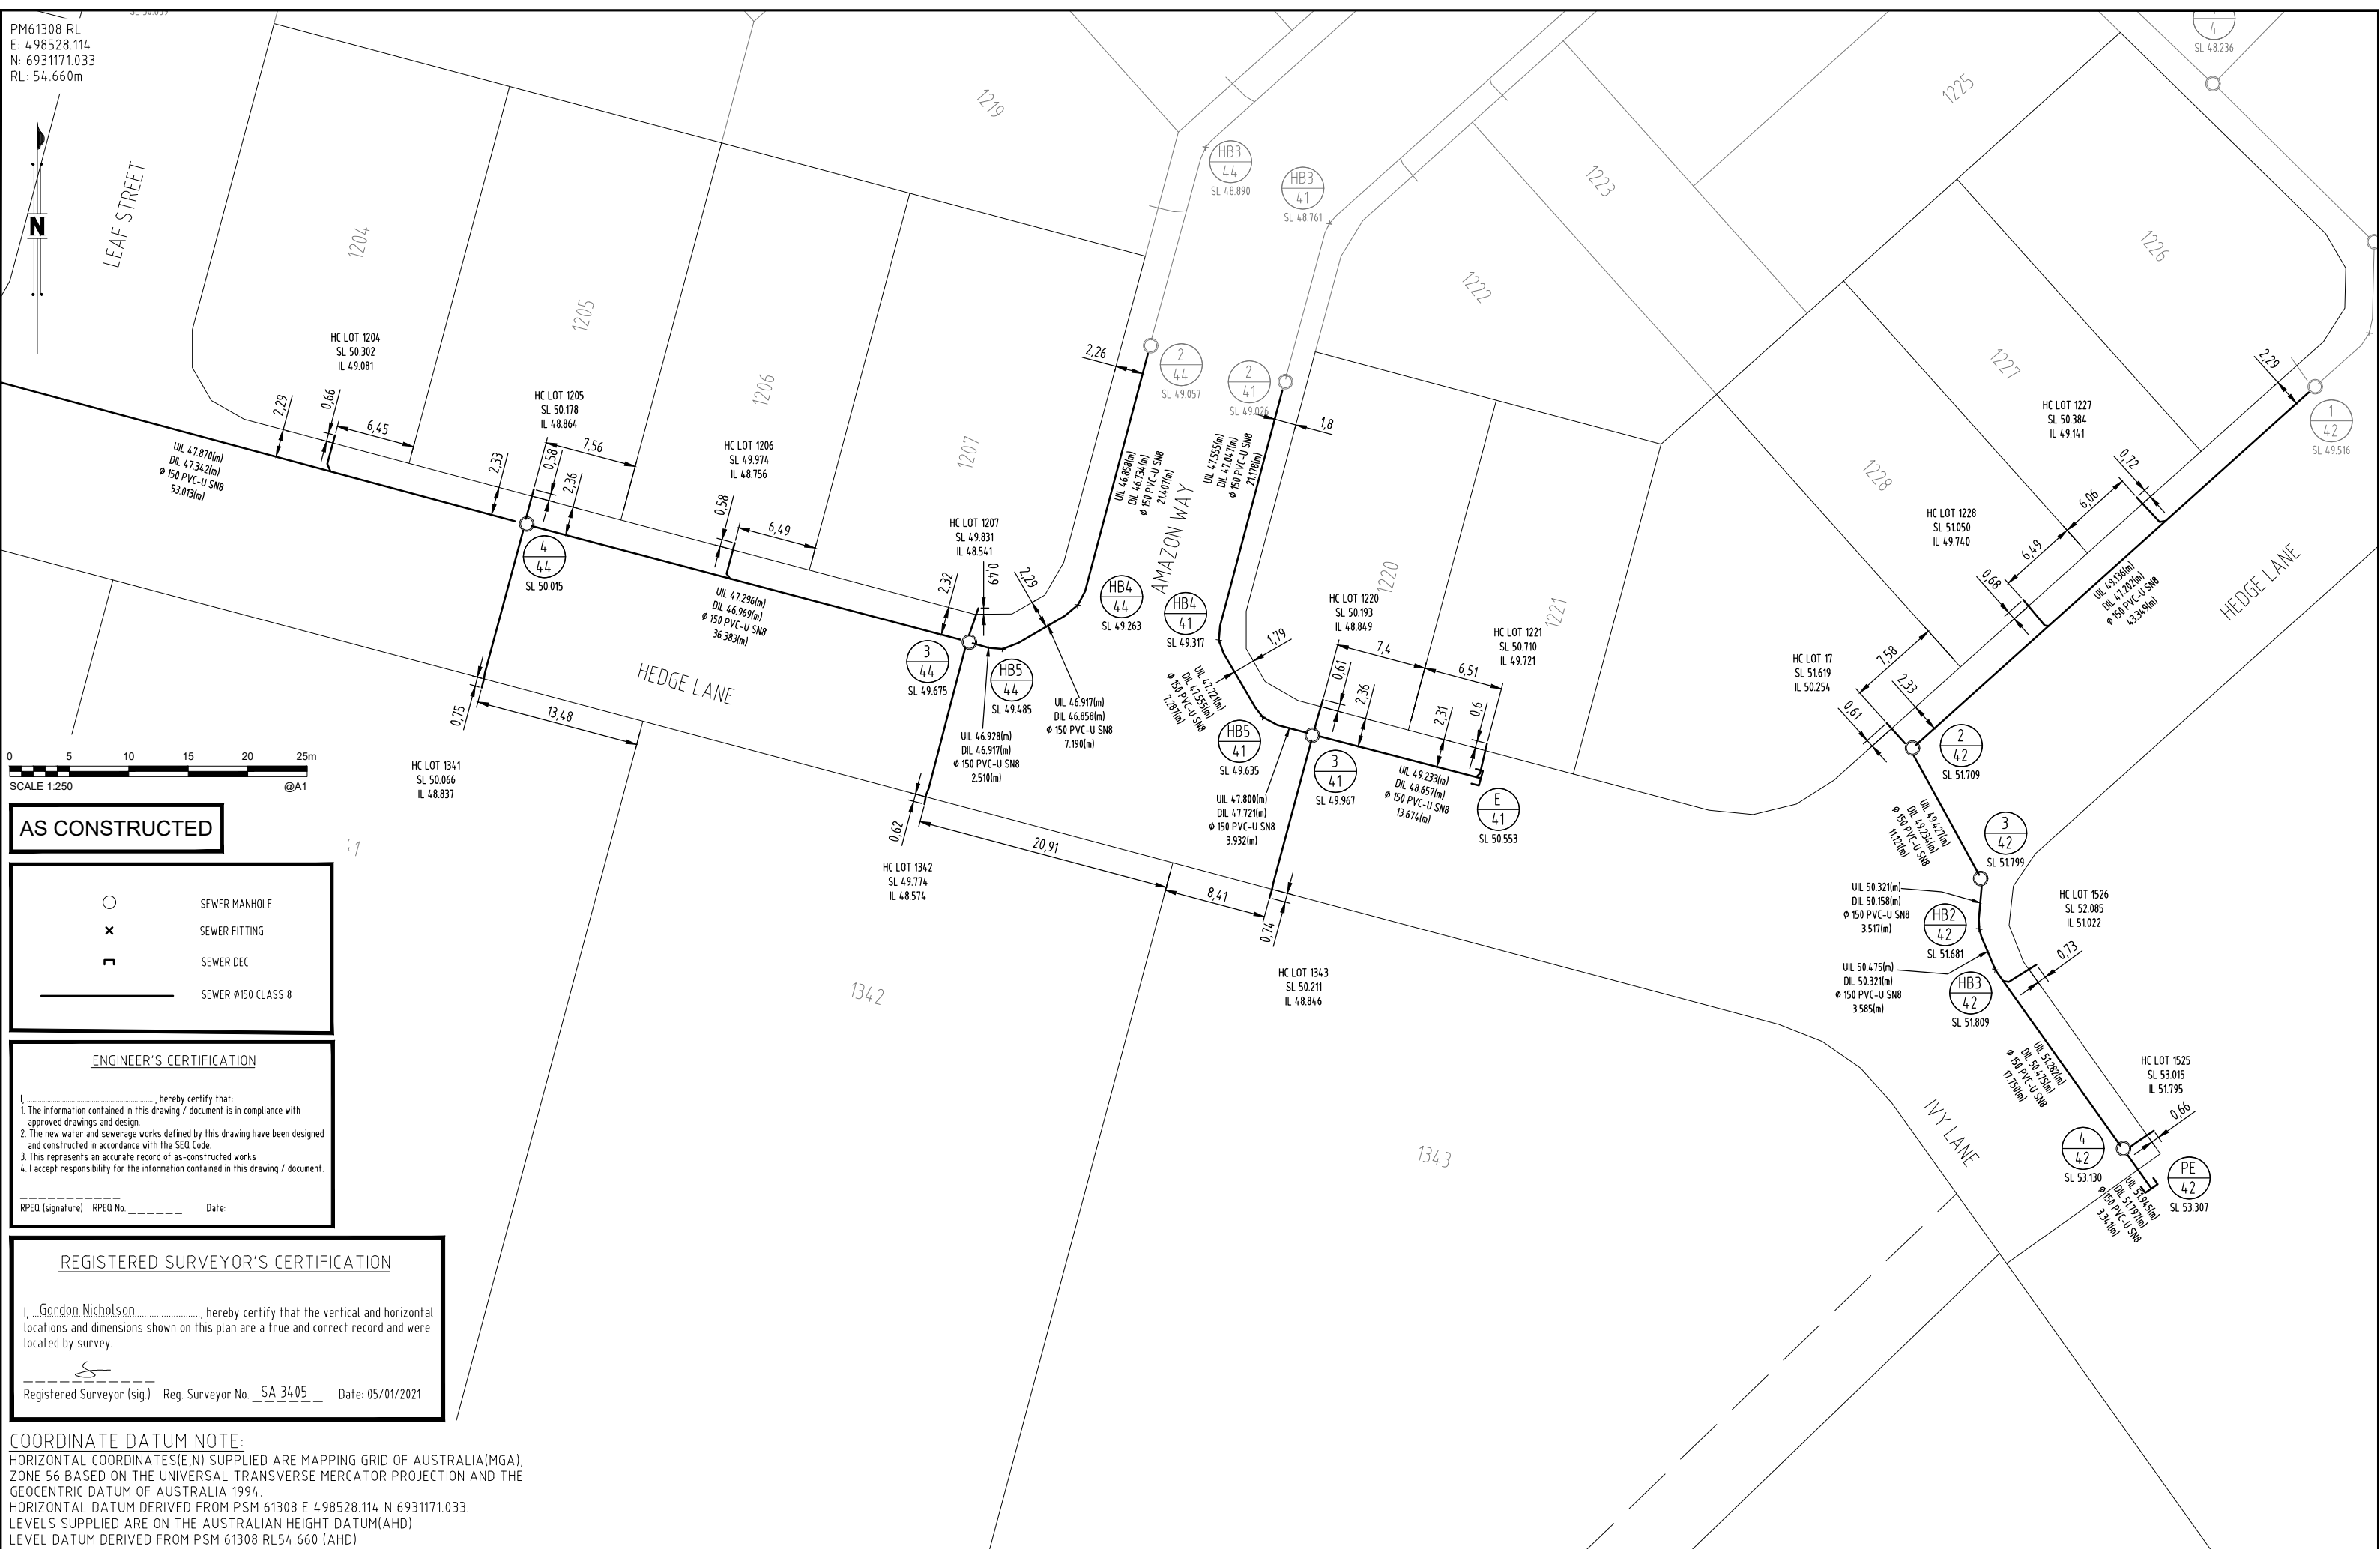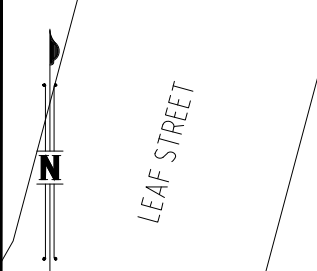

AS CONSTRUCTED

- SEWER MANHOLE
- × SEWER FITTING
- SEWER DEC
- SEWER Ø150 CLASS 8

ENGINEER'S CERTIFICATION

I, _____, hereby certify that:

- The information contained in this drawing / document is in compliance with approved drawings and design.
- The new water and sewerage works defined by this drawing have been designed and constructed in accordance with the SEQ Code.
- This represents an accurate record of as-constructed works.
- I accept responsibility for the information contained in this drawing / document.

RPEQ (signature) RPEQ No. _____ Date: _____

REGISTERED SURVEYOR'S CERTIFICATION

I, Gordon Nicholson, hereby certify that the vertical and horizontal locations and dimensions shown on this plan are a true and correct record and were located by survey.

Gordon Nicholson
 Registered Surveyor (sig.) Reg. Surveyor No. SA 3405 Date: 05/01/2021

COORDINATE DATUM NOTE:
 HORIZONTAL COORDINATES (E, N) SUPPLIED ARE MAPPING GRID OF AUSTRALIA (MGA), ZONE 56 BASED ON THE UNIVERSAL TRANSVERSE MERCATOR PROJECTION AND THE GEOCENTRIC DATUM OF AUSTRALIA 1994.
 HORIZONTAL DATUM DERIVED FROM PSM 61308 E 498528.114 N 6931171.033.
 LEVELS SUPPLIED ARE ON THE AUSTRALIAN HEIGHT DATUM (AHD).
 LEVEL DATUM DERIVED FROM PSM 61308 RL54.660 (AHD).

A1	INDEX	DATE	REVISIONS	DRAWN	CHECKED	PASSED	INITIALS	DATE
	A	05/01/2021	AS CONSTRUCTED	NJA	DAM	LS		

SHADFORTH
 58 Shadforth Lane, Forest Glen QLD 4086
 07 5438 2000 • 07 5438 2008 • shadforth@shadforth.com.au

LOGAN
 CITY COUNCIL

LOGAN CITY COUNCIL

MIRVAC MIR001-05
 AS CONSTRUCTED SURVEY - SEWER
 EVERLEIGH PRECINCT 15B
 GREENBANK QLD

SHEET 4 OF 4 SHEETS	SCALE 1:250 A1
REVISION DATE 05/01/2021	REVISION A
DISCIPLINE CODE -	
DRAWING NO. ASC-SEWER-04-1.5A	

COORDINATE DATUM NOTE:
 HORIZONTAL COORDINATES(E,N) SUPPLIED ARE MAPPING GRID OF AUSTRALIA(IMGA),
 ZONE 56 BASED ON THE UNIVERSAL TRANSVERSE MERCATOR PROJECTION AND THE
 GEOCENTRIC DATUM OF AUSTRALIA 1994.
 HORIZONTAL DATUM DERIVED FROM PSM 61308 E 4.98528.114 N 6931171.033.
 LEVELS SUPPLIED ARE ON THE AUSTRALIAN HEIGHT DATUM(AHD)
 LEVEL DATUM DERIVED FROM PSM 61308 RL54.660 (AHD)



ENGINEER'S CERTIFICATION

I, _____, hereby certify that:



- The information contained in this drawing / document is in compliance with approved drawings and design.
- The new water and sewerage works defined by this drawing have been designed and constructed in accordance with the SEQ Code.
- This represents an accurate record of as-constructed works.
- I accept responsibility for the information contained in this drawing / document.

 RPEQ (signature) RPEQ No. _____ Date: _____

REGISTERED SURVEYOR'S CERTIFICATION

I, Gordon Nicholson, hereby certify that the vertical and horizontal locations and dimensions shown on this plan are a true and correct record and were located by survey.

Gordon Nicholson
 Registered Surveyor (Sig.) Reg. Surveyor No. SA 3405 Date: 05/01/2021

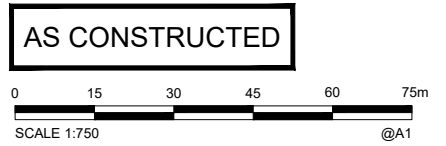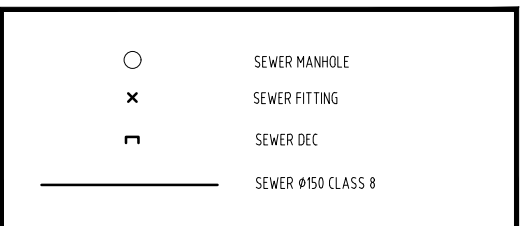

AS CONSTRUCTED

A1	INDEX	DATE	REVISIONS	DRAWN	CHECKED	PASSED
	A	14/01/2021	AS CONSTRUCTED	NJA	DAM	LS

DRAWN	NJA	14/01/2021
CHECKED	DAM	14/01/2021
PASSED	LS	14/01/2021
INITIALS		DATE





LOGAN CITY COUNCIL

MIRVAC MIR001-05
 AS CONSTRUCTED SURVEY - SEWER
 EVERLEIGH PRECINCT 15A
 GREENBANK QLD

SHEET 1 OF 4 SHEETS	SCALE 1:750 A1
REVISION DATE 14/01/2021	REVISION A
DISCIPLINE CODE -	
DRAWING NO. ASC-SEWER-01-1.5A	

PM61308 RL
 E: 4.98528.114
 N: 6.931171.033
 RL: 54.660m

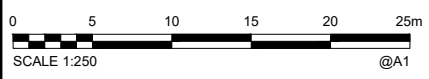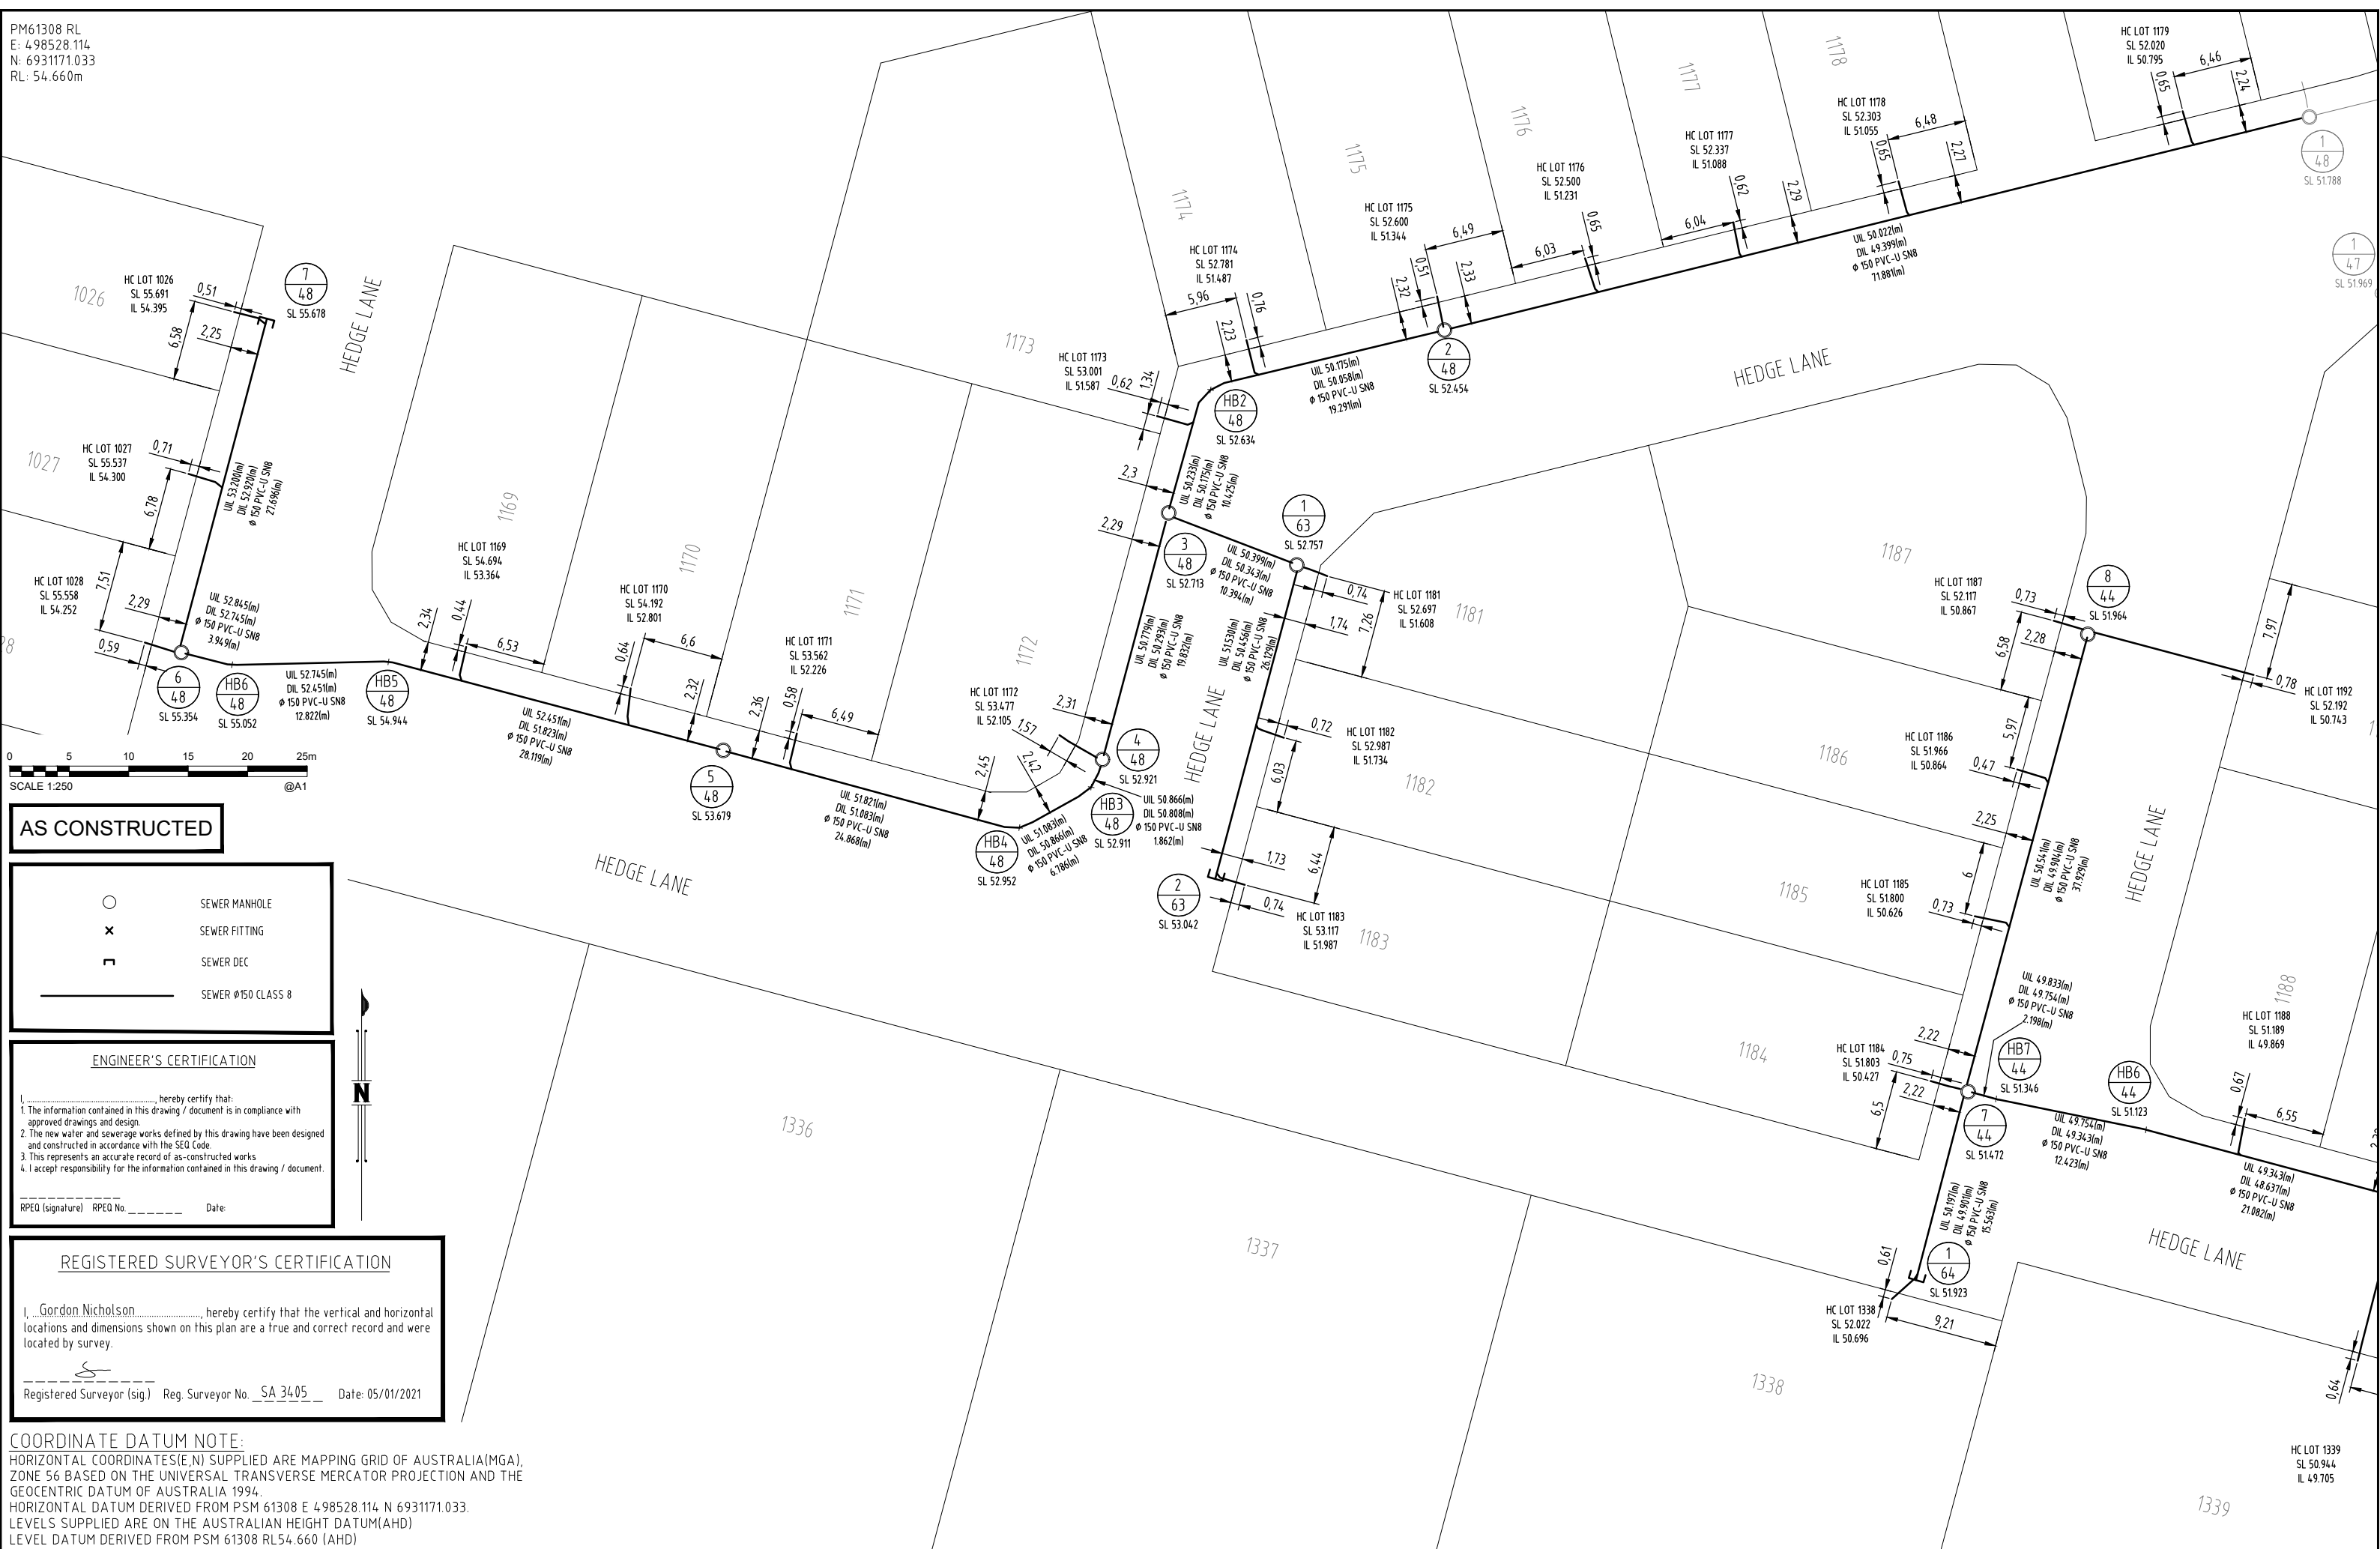

AS CONSTRUCTED

- SEWER MANHOLE
- × SEWER FITTING
- SEWER DEC
- SEWER Ø150 CLASS 8

ENGINEER'S CERTIFICATION

I, _____, hereby certify that:
 1. The information contained in this drawing / document is in compliance with approved drawings and design.
 2. The new water and sewerage works defined by this drawing have been designed and constructed in accordance with the SEQ Code.
 3. This represents an accurate record of as-constructed works.
 4. I accept responsibility for the information contained in this drawing / document.

RPEQ (signature) RPEQ No. _____ Date: _____

REGISTERED SURVEYOR'S CERTIFICATION

I, Gordon Nicholson, hereby certify that the vertical and horizontal locations and dimensions shown on this plan are a true and correct record and were located by survey.

Registered Surveyor (sig.) Reg. Surveyor No. SA 3405 Date: 05/01/2021

COORDINATE DATUM NOTE:
 HORIZONTAL COORDINATES(E,N) SUPPLIED ARE MAPPING GRID OF AUSTRALIA(MGA), ZONE 56 BASED ON THE UNIVERSAL TRANSVERSE MERCATOR PROJECTION AND THE GEOCENTRIC DATUM OF AUSTRALIA 1994.
 HORIZONTAL DATUM DERIVED FROM PSM 61308 E 4.98528.114 N 6.931171.033.
 LEVELS SUPPLIED ARE ON THE AUSTRALIAN HEIGHT DATUM(AHD)
 LEVEL DATUM DERIVED FROM PSM 61308 RL54.660 (AHD)

A1	A	05/01/2021	AS CONSTRUCTED	NJA	DAM	LS	PASSED	LS	05/01/2021
	INDEX	DATE	REVISIONS	DRAWN	CHECKED	PASSED	INITIALS	DATE	



LOGAN CITY COUNCIL
 MIRVAC M1R001-05
 AS CONSTRUCTED SURVEY - SEWER
 EVERLEIGH PRECINCT 15A
 GREENBANK QLD

SHEET 2 OF 4 SHEETS	SCALE 1:250 A1
REVISION DATE 05/01/2021	REVISION A
DISCIPLINE CODE -	
DRAWING NO. ASC-SEWER-02-15A	