

PM61308 RL
 E: 498528.114
 N: 6931171.033
 RL: 54.660m



REGISTERED SURVEYOR'S CERTIFICATION

I, Gordon Nicholson, hereby certify that the vertical and horizontal locations and dimensions shown on this plan are a true and correct record and were located by survey.

Registered Surveyor (sig.) Gordon Nicholson Reg. Surveyor No. SA 3405 Date: 10/12/2020

COORDINATE DATUM NOTE:


HORIZONTAL COORDINATES (E, N) SUPPLIED ARE MAPPING GRID OF AUSTRALIA (MGA), ZONE 56 BASED ON THE UNIVERSAL TRANSVERSE MERCATOR PROJECTION AND THE GEOCENTRIC DATUM OF AUSTRALIA 1994.
 HORIZONTAL DATUM DERIVED FROM PSM 61308 E 498528.114 N 6931171.033.
 LEVELS SUPPLIED ARE ON THE AUSTRALIAN HEIGHT DATUM (AHD).
 LEVEL DATUM DERIVED FROM PSM 61308 RL54.660 (AHD)

AS CONSTRUCTED CERTIFICATION


I, Patrick Brady, hereby certify that:

- The information contained in this drawing/document is generally in compliance with approved drawings and design.
- To the best of my knowledge, this represents an accurate record of as constructed works and I accept the responsibility for the information contained in this drawing/document. Excluding Survey Error. 7112 11/01/2021

RPEQ No. _____ Date: _____
 RPEQ (Signature) _____

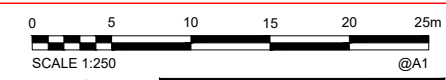

AS CONSTRUCTED

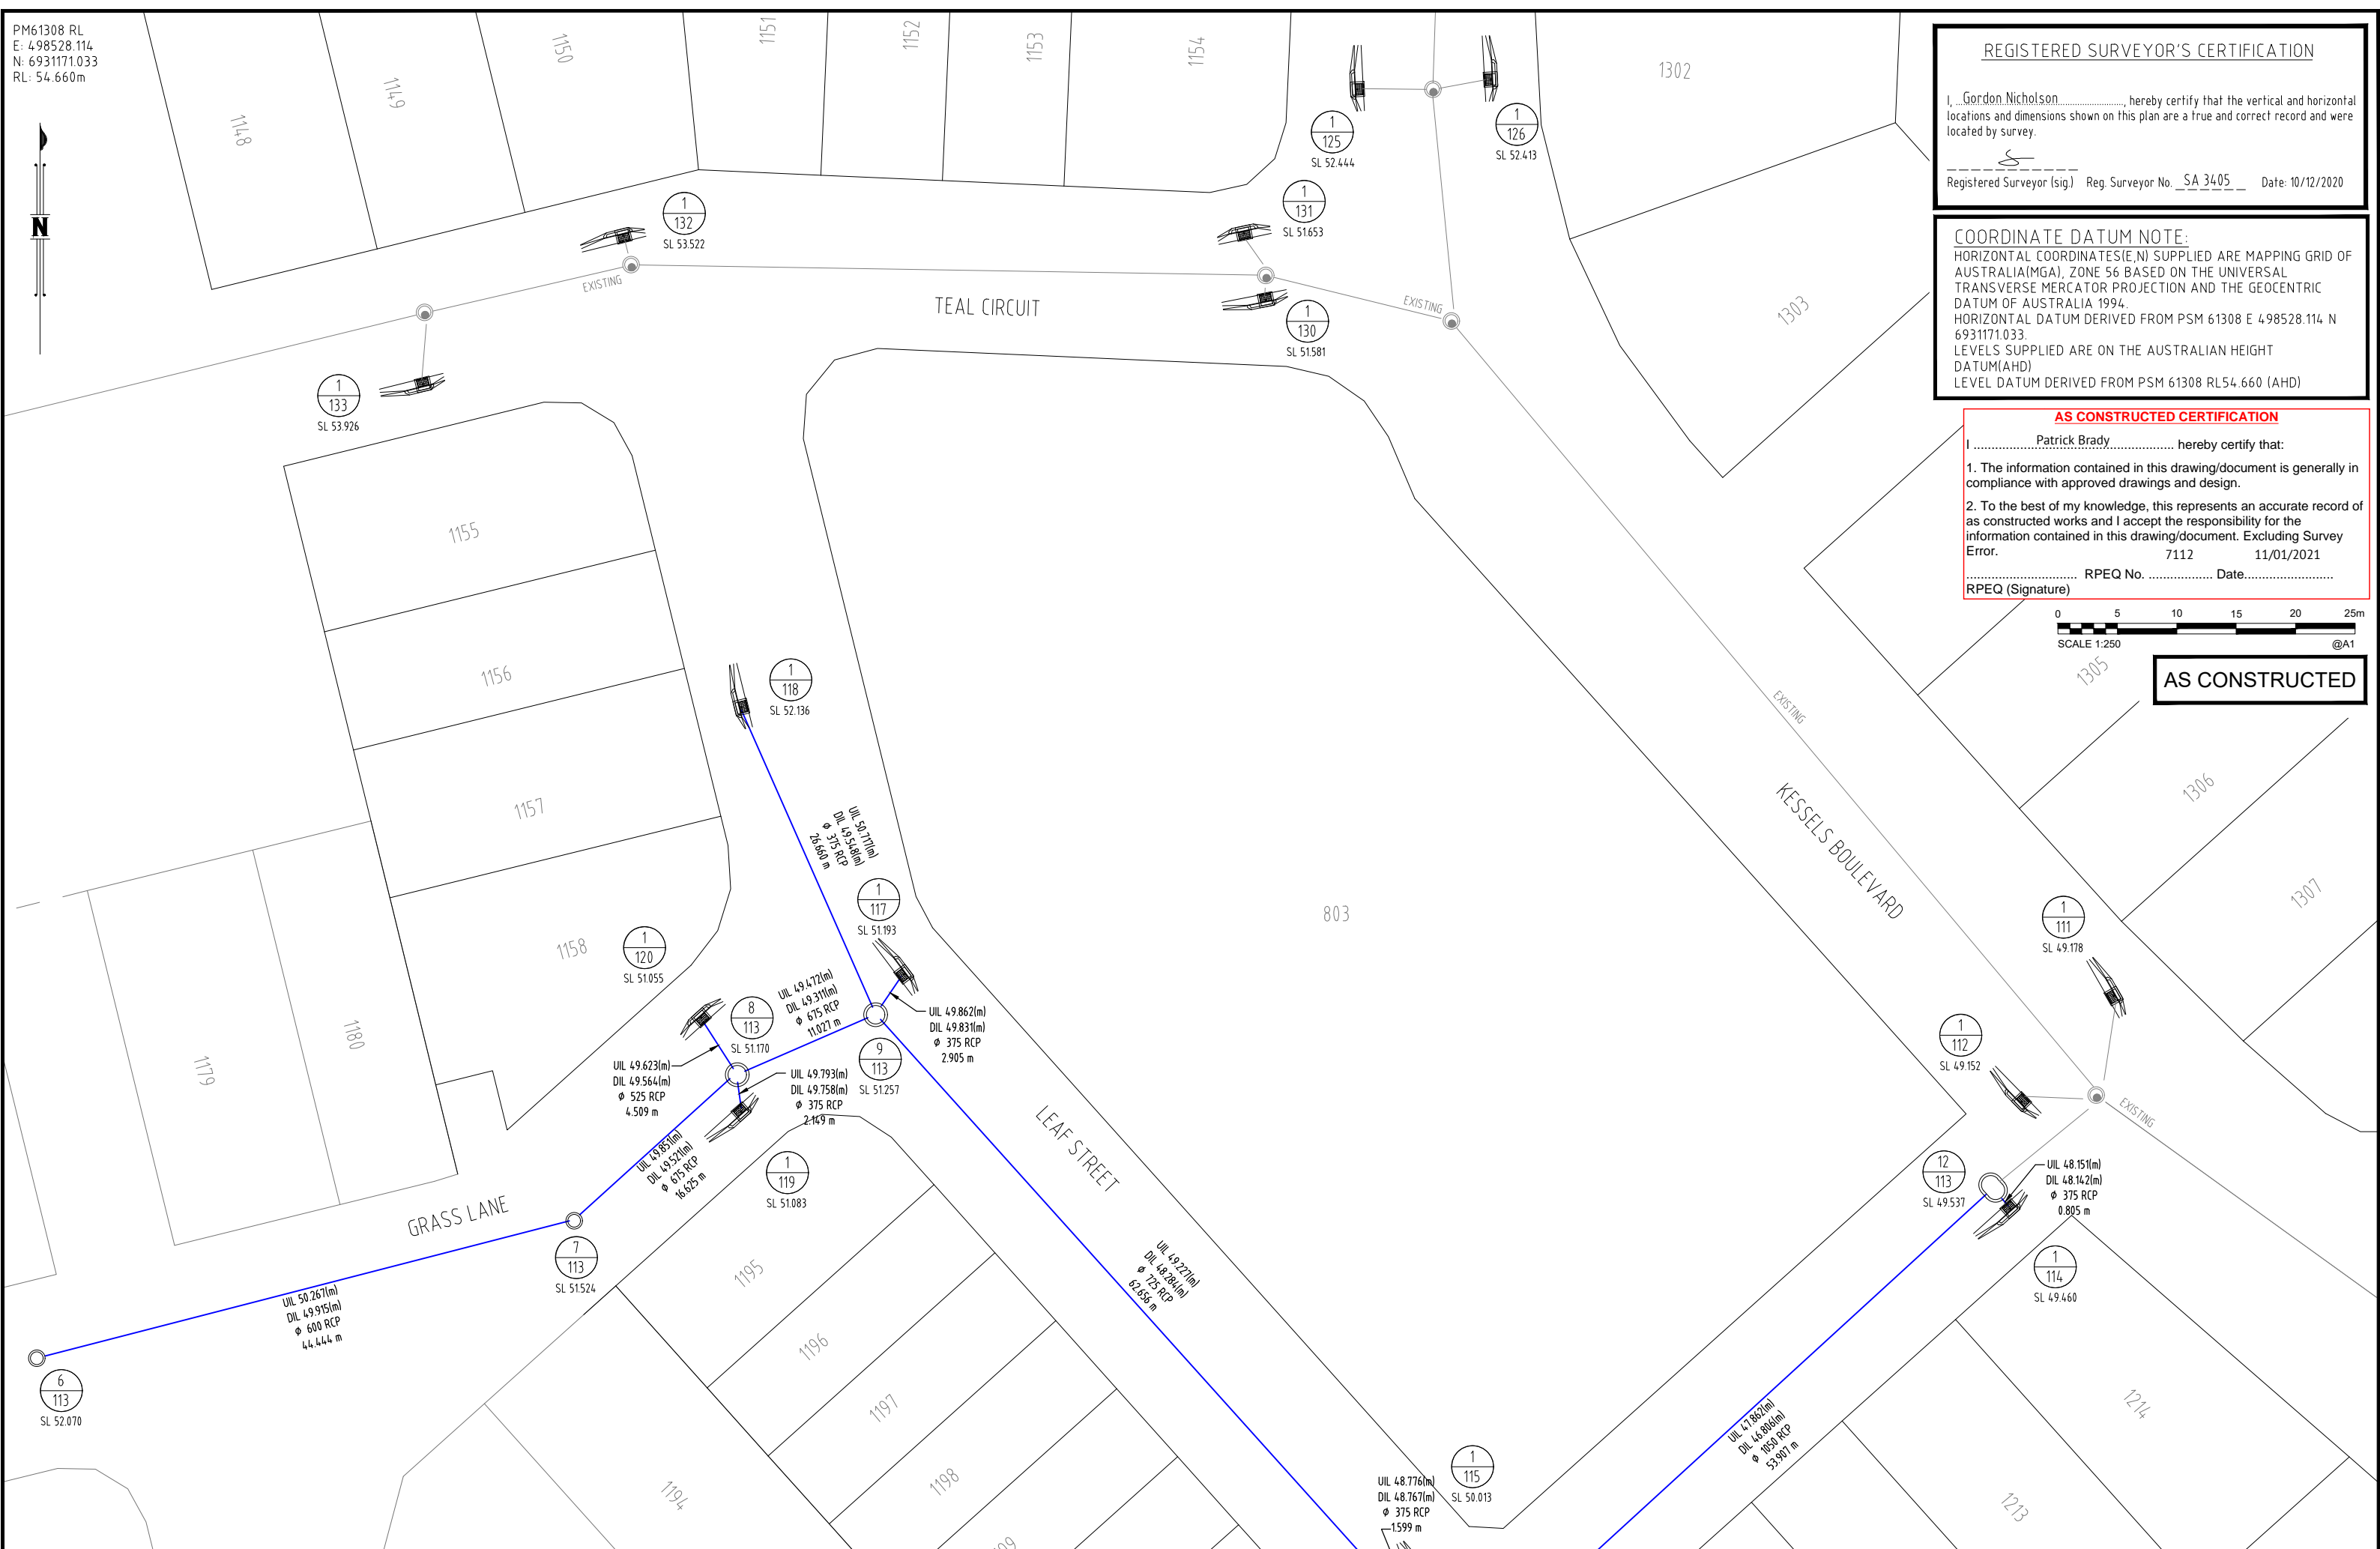

A1	INDEX	DATE	REVISIONS	DRAWN	CHECKED	PASSED	INITIALS	DATE
	A	10/12/2020	AS CONSTRUCTED	DAM	-	CW		

DRAWN	DAM	10/12/2020
CHECKED	-	10/12/2020
PASSED	CW	10/12/2020



LOGAN CITY COUNCIL

MIRVAC MIR001-04
 AS CONSTRUCTED SURVEY - STORMWATER
 EVERLEIGH PRECINCT 14
 GREENBANK QLD

SHEET 2 OF 4 SHEETS	SCALE 1:250 A1
REVISION DATE 10/12/2020	REVISION A
DISCIPLINE CODE -	
DRAWING NO. ASC-STORM-02-1.2B	

PM61308 RL
 E: 498528.114
 N: 6931171.033
 RL: 54.660m



REGISTERED SURVEYOR'S CERTIFICATION

I, Gordon Nicholson, hereby certify that the vertical and horizontal locations and dimensions shown on this plan are a true and correct record and were located by survey.

Registered Surveyor (sig) Gordon Nicholson Reg. Surveyor No. SA 3405 Date: 10/12/2020

COORDINATE DATUM NOTE:
 HORIZONTAL COORDINATES (E,N) SUPPLIED ARE MAPPING GRID OF AUSTRALIA (MGA), ZONE 56 BASED ON THE UNIVERSAL TRANSVERSE MERCATOR PROJECTION AND THE GEOCENTRIC DATUM OF AUSTRALIA 1994.
 HORIZONTAL DATUM DERIVED FROM PSM 61308 E 498528.114 N 6931171.033.
 LEVELS SUPPLIED ARE ON THE AUSTRALIAN HEIGHT DATUM (AHD).
 LEVEL DATUM DERIVED FROM PSM 61308 RL54.660 (AHD)


AS CONSTRUCTED CERTIFICATION

I, Patrick Brady, hereby certify that:


- The information contained in this drawing/document is generally in compliance with approved drawings and design.
- To the best of my knowledge, this represents an accurate record of as constructed works and I accept the responsibility for the information contained in this drawing/document. Excluding Survey Error.

RPEQ No. 7112 Date: 11/01/2021

RPEQ (Signature) _____

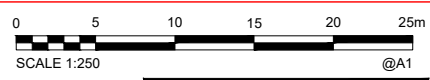

AS CONSTRUCTED

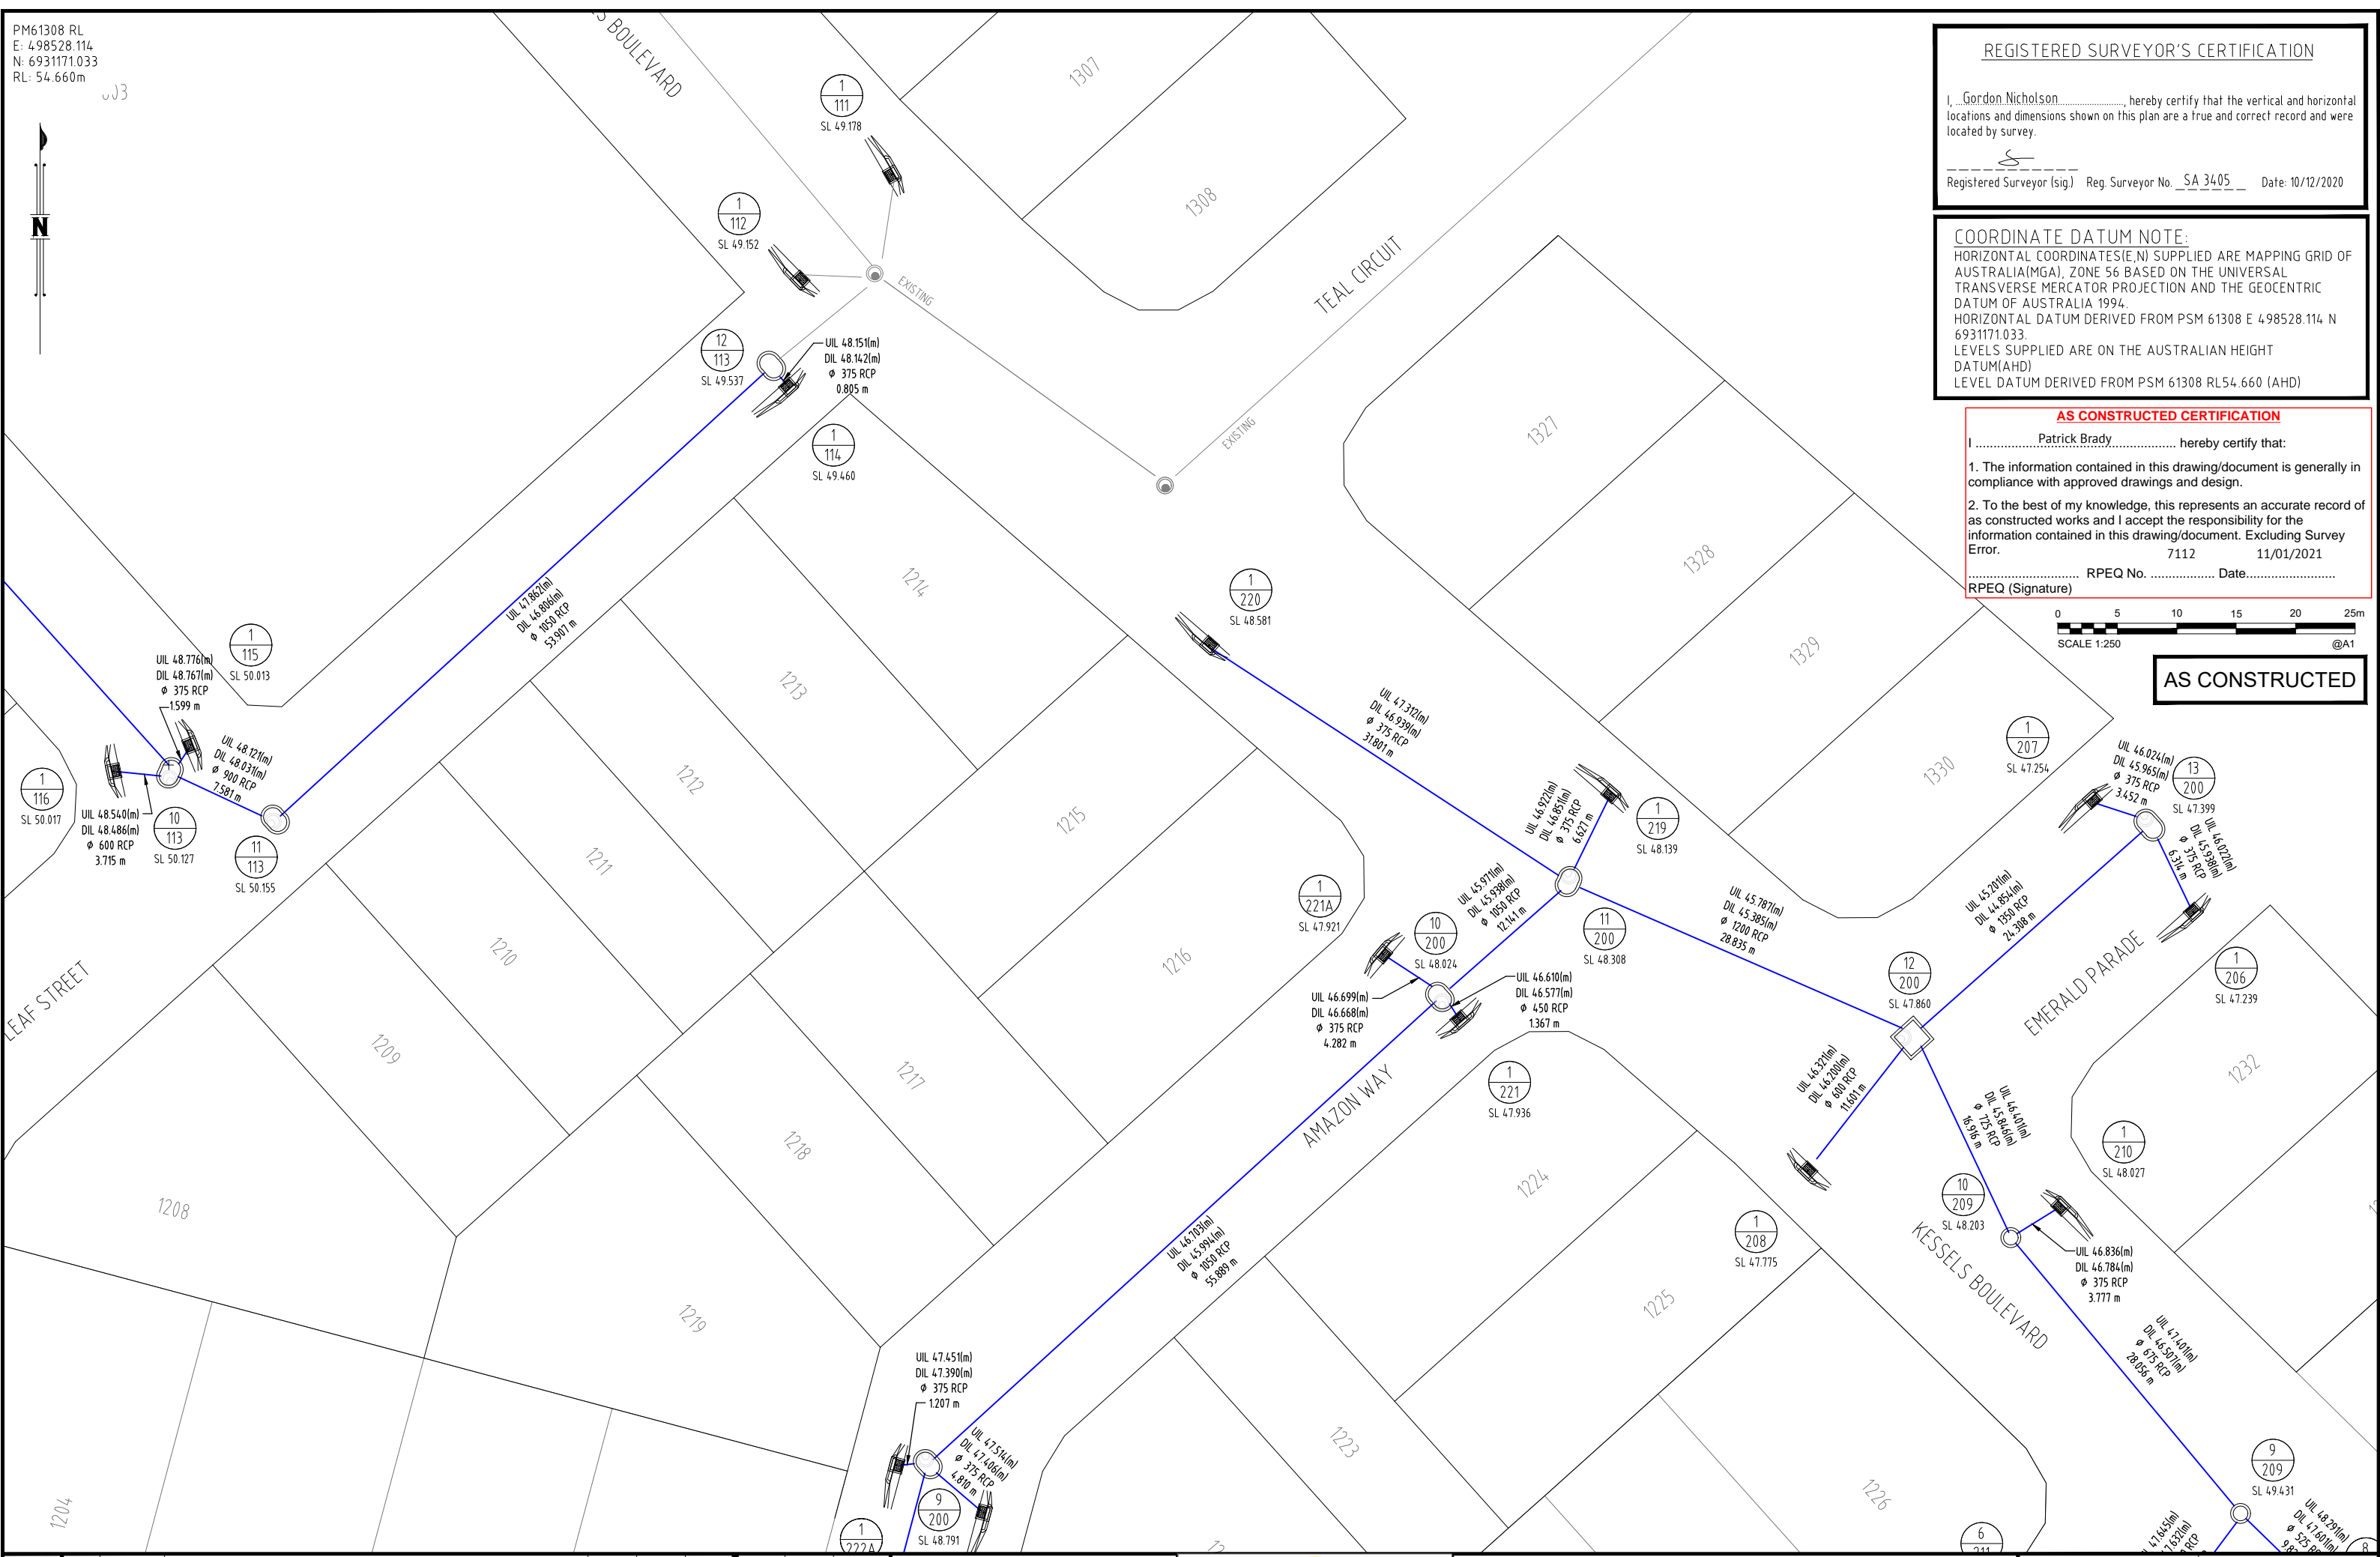

A1	INDEX	DATE	REVISIONS	DRAWN	CHECKED	PASSED	INITIALS	DATE
	A	10/12/2020	AS CONSTRUCTED	DAM	-	CW		




LOGAN CITY COUNCIL


MIRVAC MIR001-04
 AS CONSTRUCTED SURVEY - STORMWATER
 EVERLEIGH PRECINCT 14
 GREENBANK QLD

SHEET 3 OF 4 SHEETS	SCALE 1:250 A1
REVISION DATE 10/12/2020	REVISION A
DISCIPLINE CODE -	
DRAWING NO. ASC-STORM-03-1.2B	

PM61308 RL
 E: 498528.114
 N: 6931171.033
 RL: 54.660m

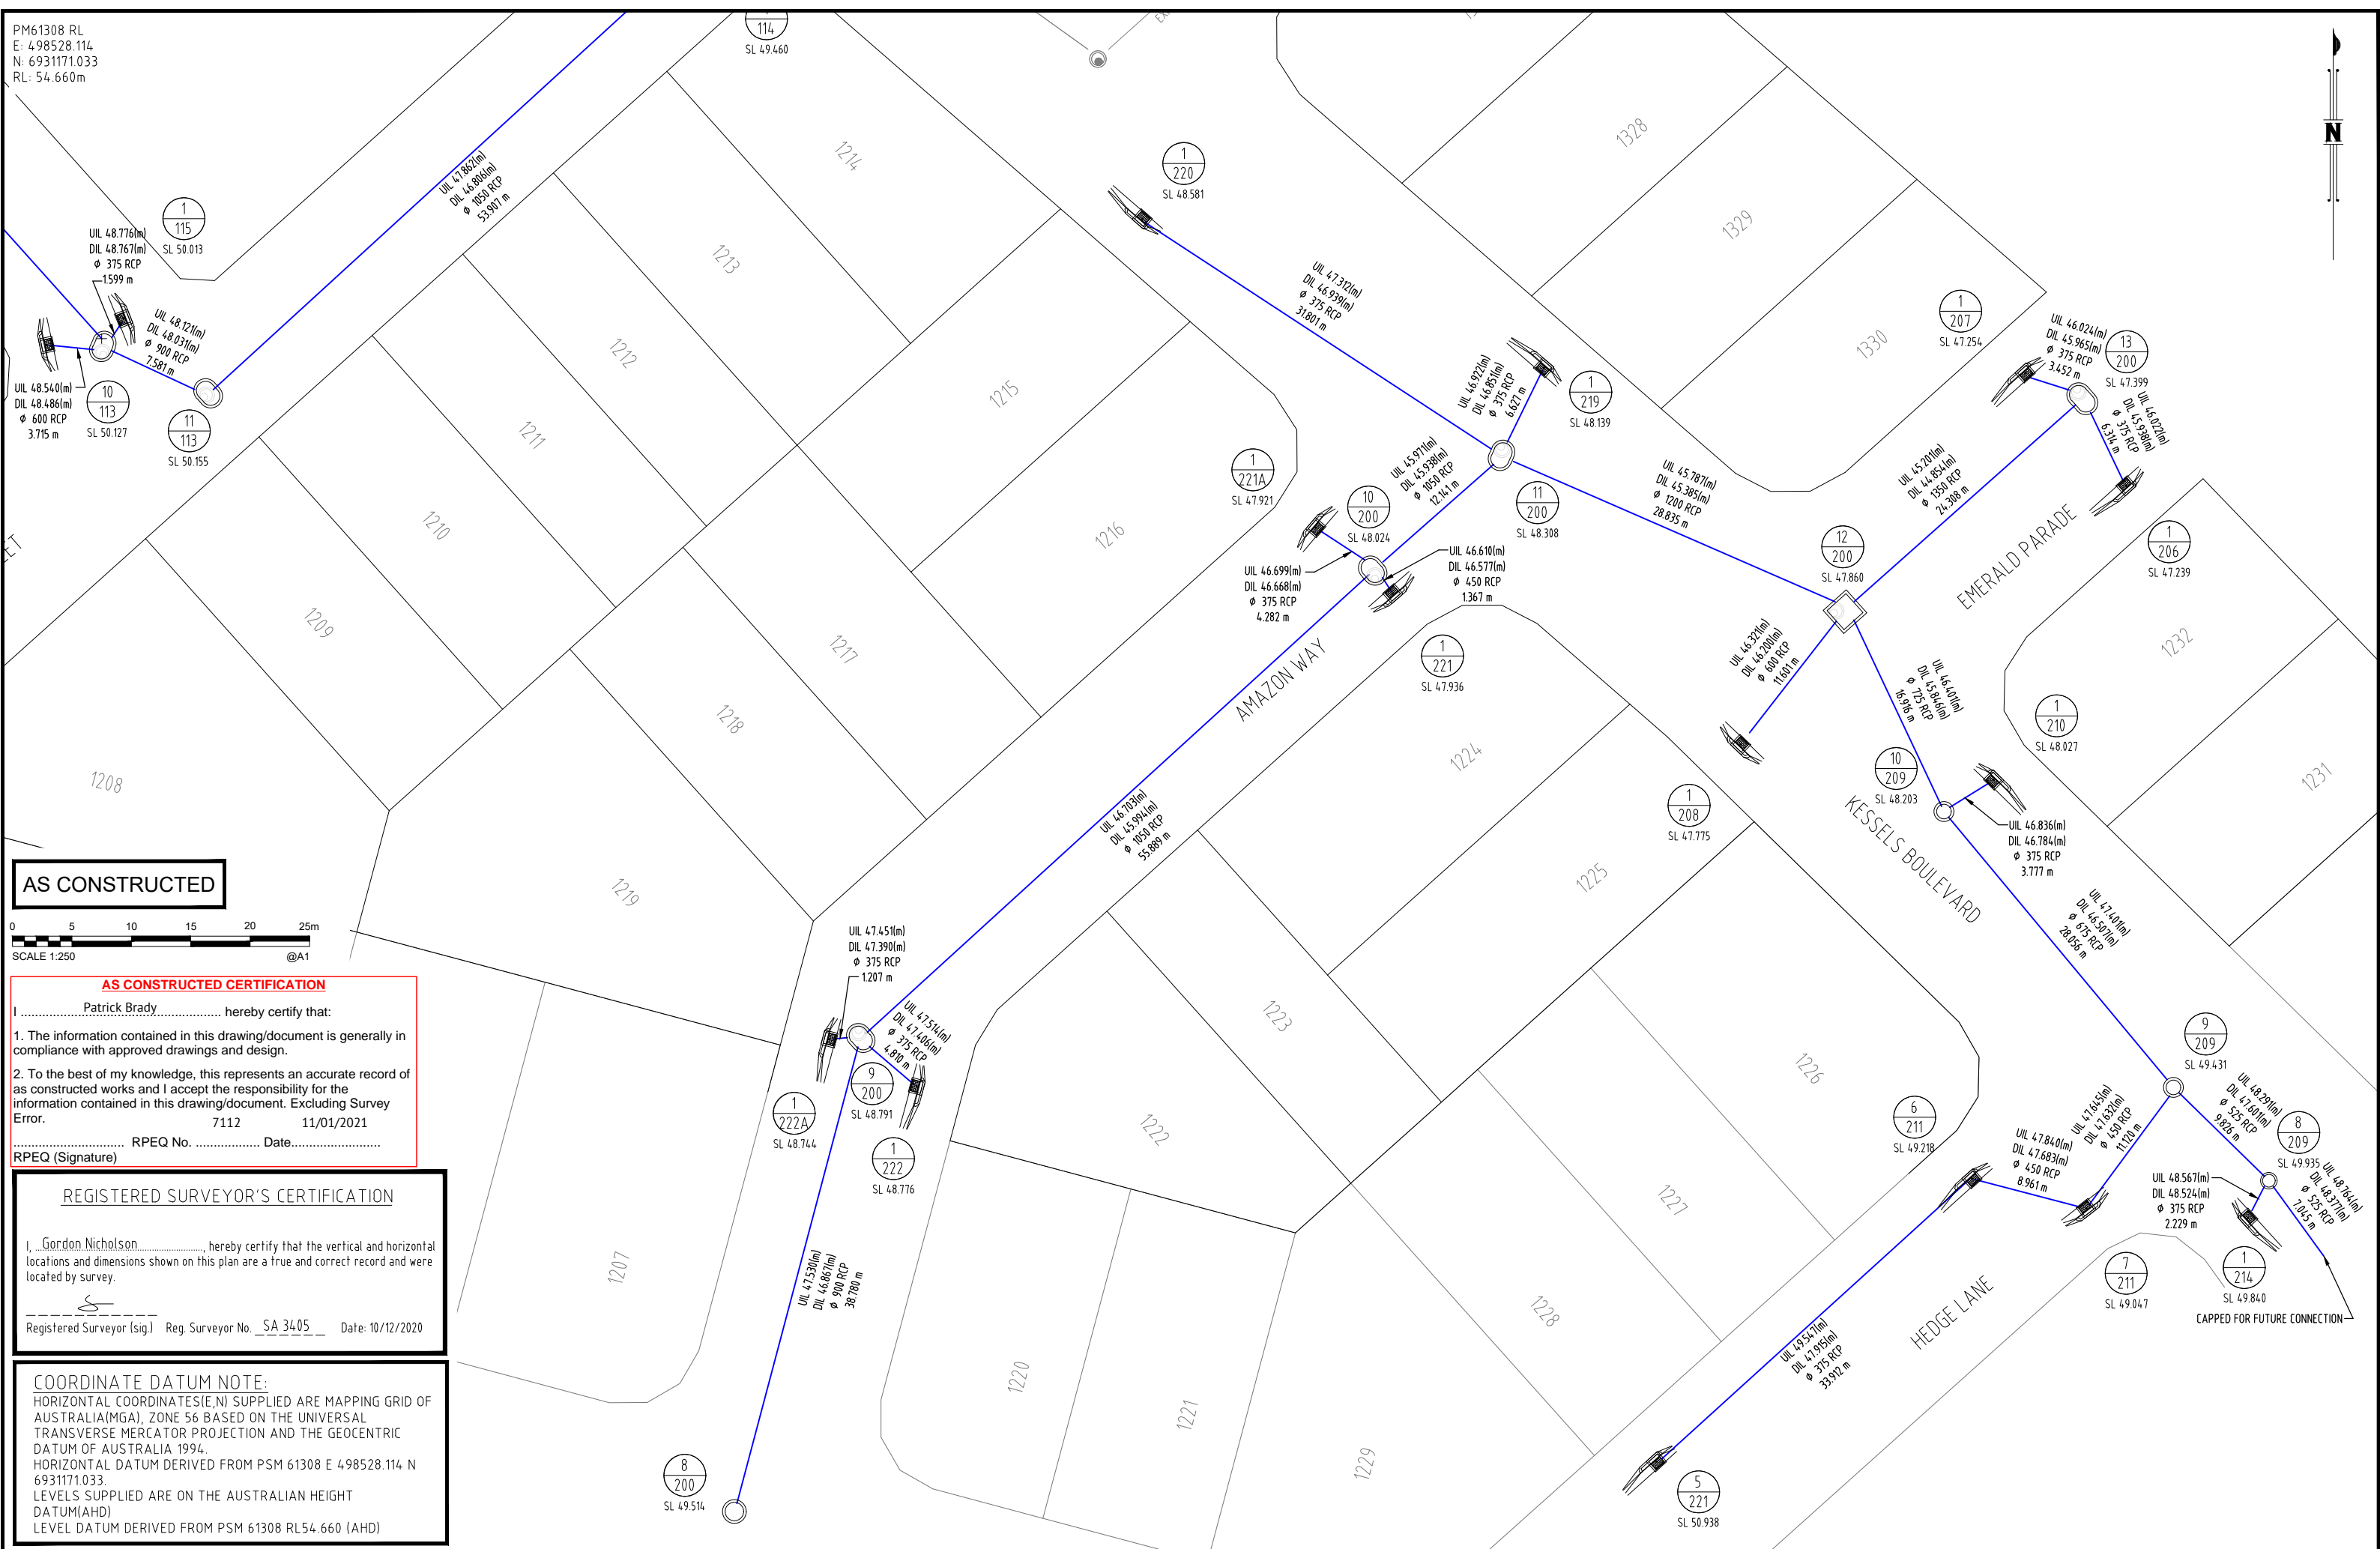

AS CONSTRUCTED

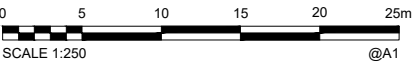

AS CONSTRUCTED CERTIFICATION
 I, Patrick Brady, hereby certify that:
 1. The information contained in this drawing/document is generally in compliance with approved drawings and design.
 2. To the best of my knowledge, this represents an accurate record of as constructed works and I accept the responsibility for the information contained in this drawing/document. Excluding Survey Error.
 7112 11/01/2021
 RPEQ No. _____ Date: _____
 RPEQ (Signature) _____

REGISTERED SURVEYOR'S CERTIFICATION
 I, Gordon Nicholson, hereby certify that the vertical and horizontal locations and dimensions shown on this plan are a true and correct record and were located by survey.

 Registered Surveyor (sig.) Reg. Surveyor No. SA 3405 Date: 10/12/2020

COORDINATE DATUM NOTE:
 HORIZONTAL COORDINATES(E,N) SUPPLIED ARE MAPPING GRID OF AUSTRALIA(MGA), ZONE 56 BASED ON THE UNIVERSAL TRANSVERSE MERCATOR PROJECTION AND THE GEOCENTRIC DATUM OF AUSTRALIA 1994.
 HORIZONTAL DATUM DERIVED FROM PSM 61308 E 498528.114 N 6931171.033.
 LEVELS SUPPLIED ARE ON THE AUSTRALIAN HEIGHT DATUM(AHD)
 LEVEL DATUM DERIVED FROM PSM 61308 RL54.660 (AHD)

A1

INDEX	DATE	REVISIONS	DRAWN	CHECKED	PASSED	INITIALS	DATE
A	10/12/2020	AS CONSTRUCTED	DAM	-	CW		
			DRAWN	CHECKED	PASSED		



LOGAN CITY COUNCIL
 MIRVAC MIR001-04
 AS CONSTRUCTED SURVEY - STORMWATER
 EVERLEIGH PRECINCT 14
 GREENBANK QLD


SHEET 4 OF 4 SHEETS	SCALE 1:250 A1
REVISION DATE 10/12/2020	REVISION A
DISCIPLINE CODE -	
DRAWING NO.	
ASC-STORM-04-1.2B	

PM61308 RL
 E: 498528.114
 N: 6931171.033
 RL: 54.660m


COORDINATE DATUM NOTE:
 HORIZONTAL COORDINATES(E,N) SUPPLIED ARE MAPPING GRID OF AUSTRALIA(MGA), ZONE 56 BASED ON THE UNIVERSAL TRANSVERSE MERCATOR PROJECTION AND THE GEOCENTRIC DATUM OF AUSTRALIA 1994.
 HORIZONTAL DATUM DERIVED FROM PSM 61308 E 498528.114 N 6931171.033.
 LEVELS SUPPLIED ARE ON THE AUSTRALIAN HEIGHT DATUM(AHD)
 LEVEL DATUM DERIVED FROM PSM 61308 RL54.660 (AHD)

REGISTERED SURVEYOR'S CERTIFICATION
 I, Gordon Nicholson, hereby certify that the vertical and horizontal locations and dimensions shown on this plan are a true and correct record and were located by survey.
 Registered Surveyor (sig) [Signature] Reg. Surveyor No. SA 3405 Date: 10/12/2020

AS CONSTRUCTED CERTIFICATION
 I, Patrick Brady, hereby certify that:
 1. The information contained in this drawing/document is generally in compliance with approved drawings and design.
 2. To the best of my knowledge, this represents an accurate record of as constructed works and I accept the responsibility for the information contained in this drawing/document. Excluding Survey Error. 7112 11/01/2021
 RPEQ No. _____ Date: _____
 RPEQ (Signature) _____

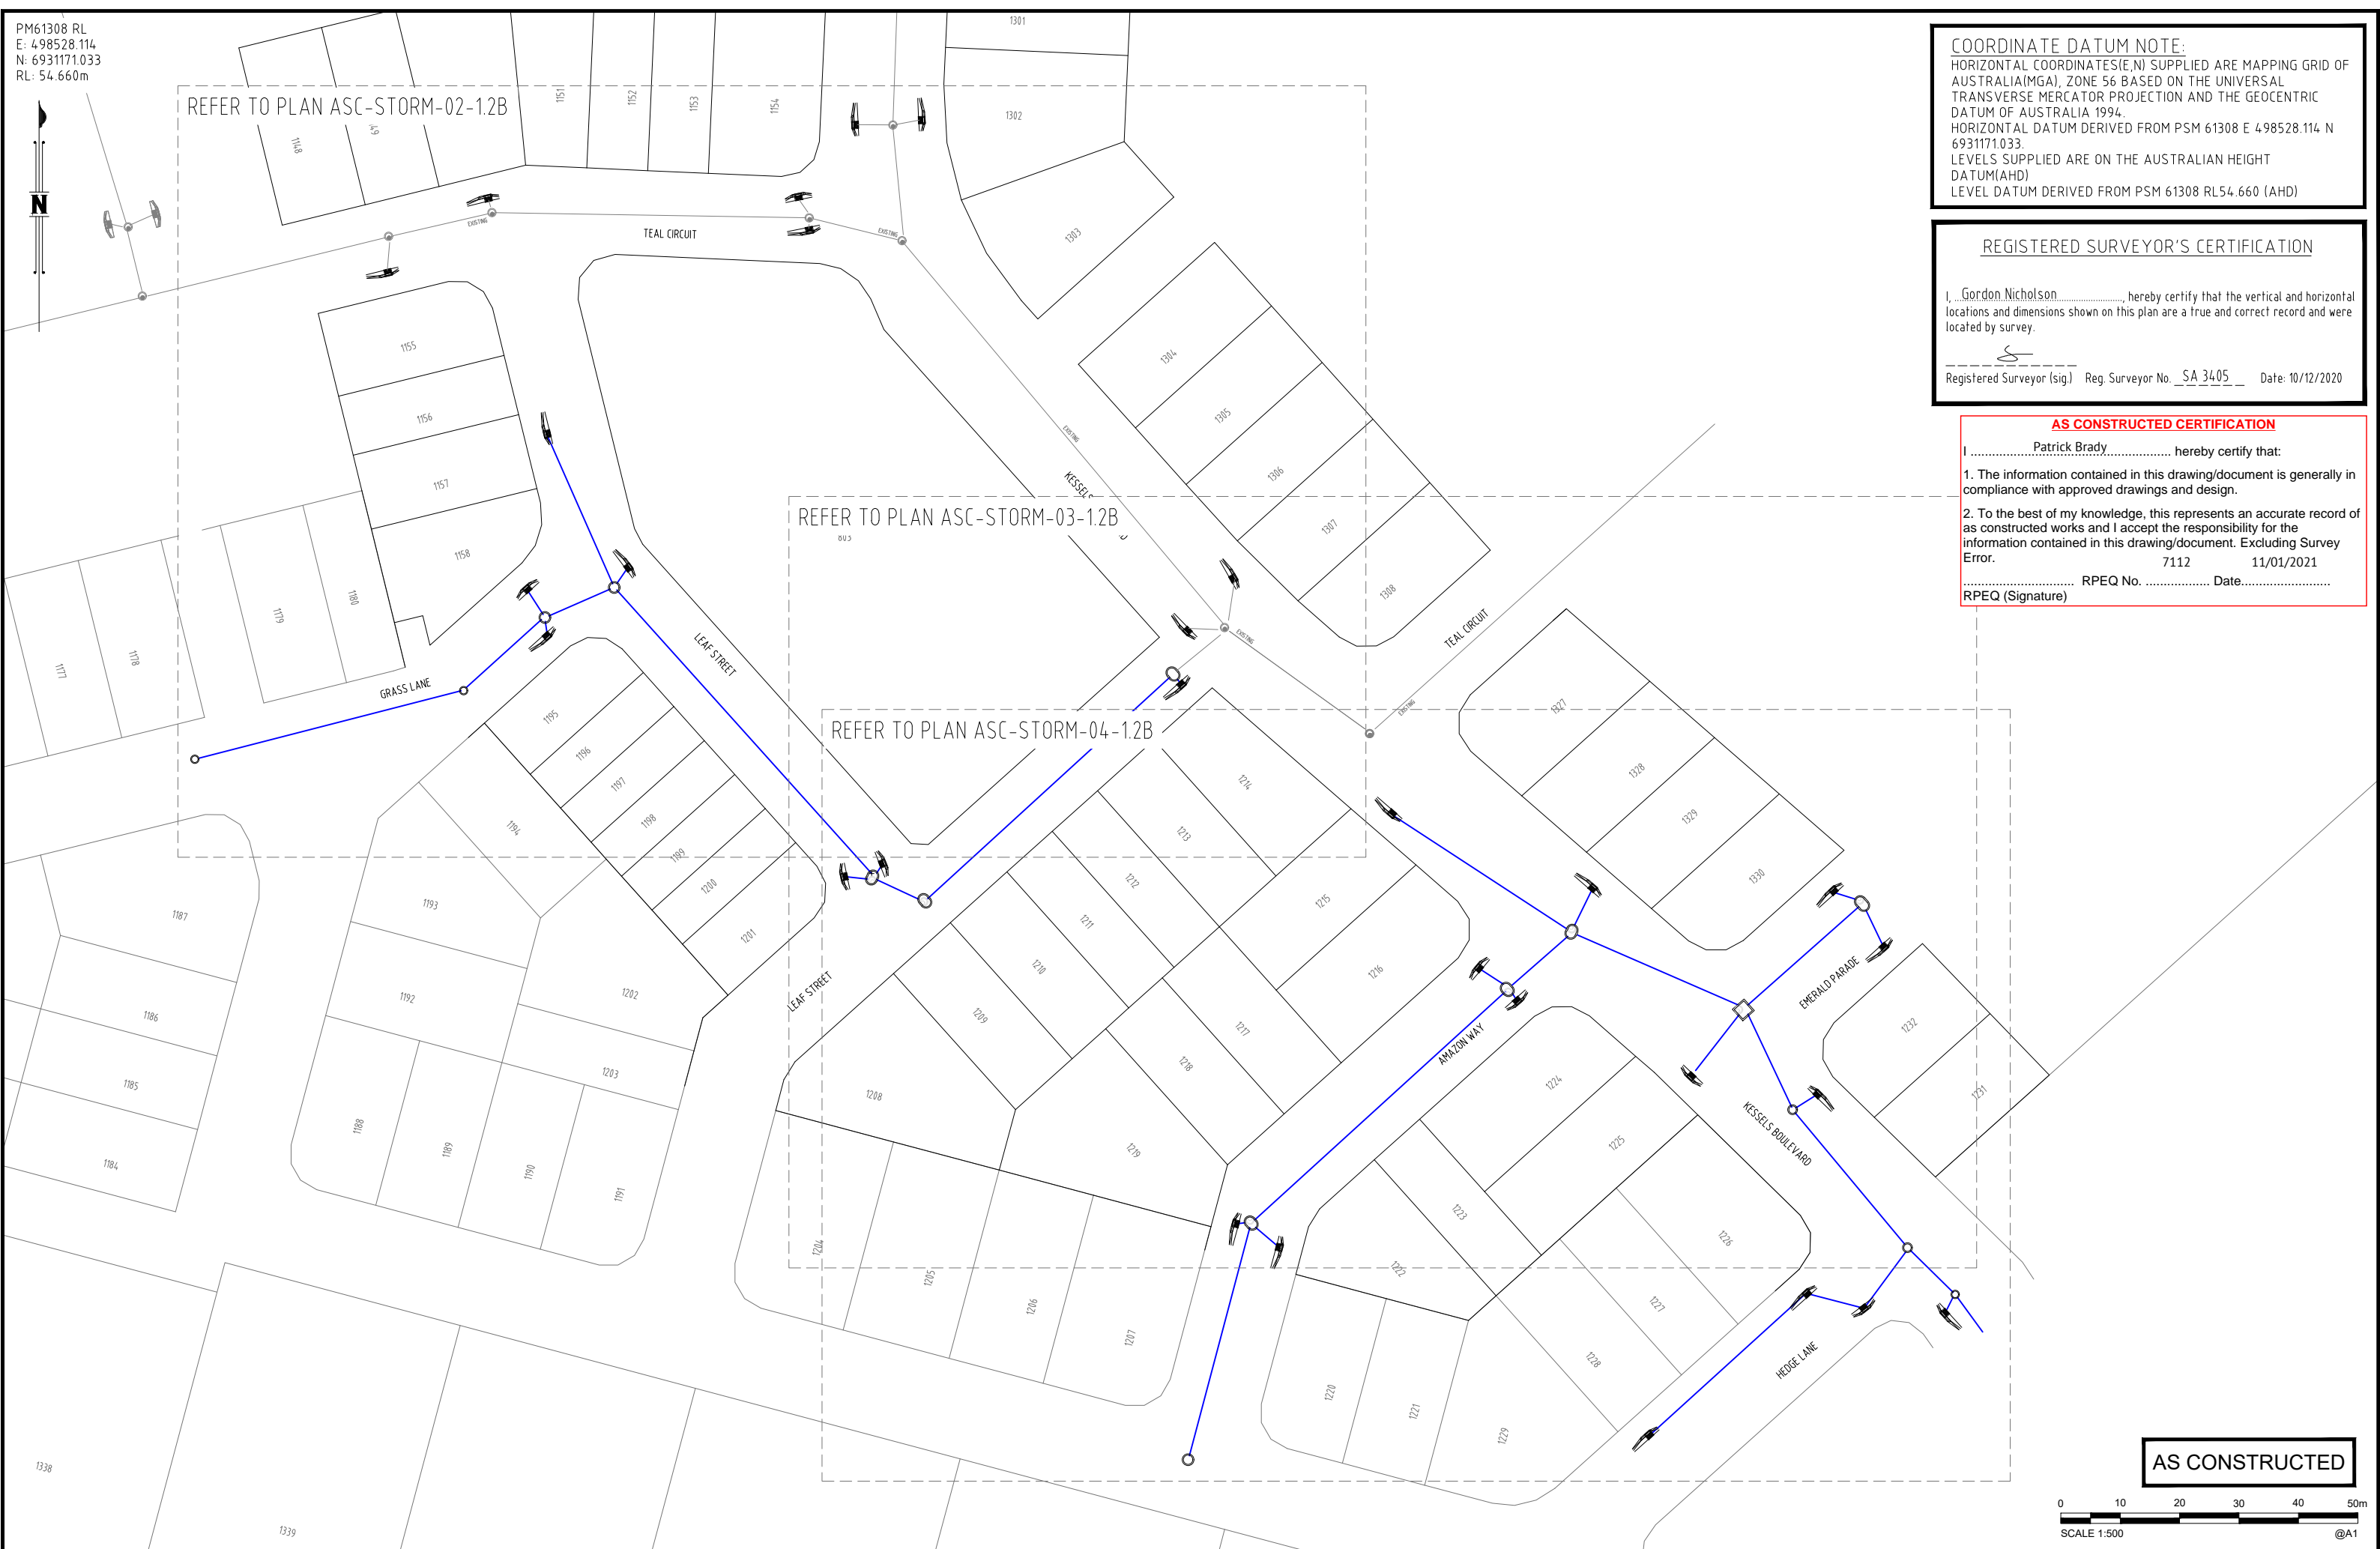

AS CONSTRUCTED

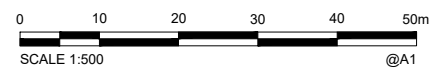

A1	INDEX	DATE	REVISIONS	DRAWN	CHECKED	PASSED	INITIALS	DATE
	A	10/12/2020	AS CONSTRUCTED	DAM	-	CW		

DRAWN	DAM	10/12/2020
CHECKED	-	10/12/2020
PASSED	CW	10/12/2020



LOGAN CITY COUNCIL
 MIRVAC MIR001-04
 AS CONSTRUCTED SURVEY - STORMWATER
 EVERLEIGH PRECINCT 1.4
 GREENBANK QLD

SHEET 1 OF 4 SHEETS	SCALE 1:500 A1
REVISION DATE 10/12/2020	REVISION A
DISCIPLINE CODE -	
DRAWING NO.	
ASC-STORM-01-1.2B	