



**ENGINEER'S CERTIFICATION**

- I, \_\_\_\_\_, hereby certify that:
1. The information contained in this drawing / document is in compliance with approved drawings and design.
  2. The new water and sewerage works defined by this drawing have been designed and constructed in accordance with the SEQ Code.
  3. This represents an accurate record of as-constructed works.
  4. I accept responsibility for the information contained in this drawing / document.


\_\_\_\_\_  
RPEQ (signature) RPEQ No. \_\_\_\_\_ Date: \_\_\_\_\_

**AS CONSTRUCTED**

**REGISTERED SURVEYOR'S CERTIFICATION**

I, Gordon Nicholson, hereby certify that the vertical and horizontal locations and dimensions shown on this plan are a true and correct record and were located by survey.

\_\_\_\_\_  
Registered Surveyor (Sig.) Reg. Surveyor No. SA 3405 Date: 28/07/2021

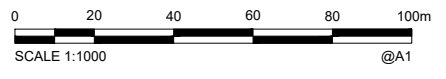

**COORDINATE DATUM NOTE:**  
 HORIZONTAL COORDINATES(E,N) SUPPLIED ARE MAPPING GRID OF AUSTRALIA(MGA), ZONE 56 BASED ON THE UNIVERSAL TRANSVERSE MERCATOR PROJECTION AND THE GEOCENTRIC DATUM OF AUSTRALIA 1994.  
 HORIZONTAL DATUM DERIVED FROM PSM 61308 E 4 98528.114 N 6931171.033.  
 LEVELS SUPPLIED ARE ON THE AUSTRALIAN HEIGHT DATUM(AHD)  
 LEVEL DATUM DERIVED FROM PSM 61308 RL54.660 (AHD)

**A1**


INDEX	DATE	REVISIONS	DRAWN	CHECKED	PASSED	INITIALS	DATE
A	28/07/2021	AS CONSTRUCTED	NJA	DAM	LS		28/07/2021



**LOGAN CITY COUNCIL**  
 MIRVAC MIR001-04  
 AS CONSTRUCTED SURVEY - STORMWATER  
 EVERLEIGH PRECINCT 12.1  
 GREENBANK QLD

SHEET 1 OF 6 SHEETS	SCALE 1:1000 A1
REVISION DATE 28/07/2021	REVISION <b>A</b>
DISCIPLINE CODE -	
DRAWING NO. <b>ASC-STORM-01-12.1</b>	

PM61308 RL  
 E: 4.98528.114  
 N: 6931171.033  
 RL: 54.660m

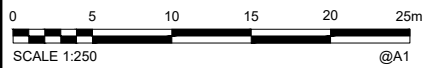

**AS CONSTRUCTED**

**ENGINEER'S CERTIFICATION**

I, \_\_\_\_\_, hereby certify that:

- The information contained in this drawing / document is in compliance with approved drawings and design.
- The new water and sewerage works defined by this drawing have been designed and constructed in accordance with the SEQ Code.
- This represents an accurate record of as-constructed works.
- I accept responsibility for the information contained in this drawing / document.

RPEQ (signature) RPEQ No. \_\_\_\_\_ Date: \_\_\_\_\_

**REGISTERED SURVEYOR'S CERTIFICATION**

I, Gordon Nicholson, hereby certify that the vertical and horizontal locations and dimensions shown on this plan are a true and correct record and were located by survey.

Gordon Nicholson  
 Registered Surveyor (sig.) Reg. Surveyor No. SA 34.05 Date: 28/07/2021

**COORDINATE DATUM NOTE:**  
 HORIZONTAL COORDINATES(E,N) SUPPLIED ARE MAPPING GRID OF AUSTRALIA(MGA), ZONE 56 BASED ON THE UNIVERSAL TRANSVERSE MERCATOR PROJECTION AND THE GEOCENTRIC DATUM OF AUSTRALIA 1994.  
 HORIZONTAL DATUM DERIVED FROM PSM 61308 E 4.98528.114 N 6931171.033.  
 LEVELS SUPPLIED ARE ON THE AUSTRALIAN HEIGHT DATUM(AHD)  
 LEVEL DATUM DERIVED FROM PSM 61308 RL54.660 (AHD)

A1	INDEX	DATE	REVISIONS	DRAWN	CHECKED	PASSED	INITIALS	DATE
	A	28/07/2021	AS CONSTRUCTED	NJA	DAM	LS		28/07/2021




**LOGAN CITY COUNCIL**

MIRVAC MIR001-04  
 AS CONSTRUCTED SURVEY - STORMWATER  
 EVERLEIGH PRECINCT 12.1  
 GREENBANK QLD

SHEET 2 OF 6 SHEETS	SCALE 1:250 A1
REVISION DATE 28/07/2021	REVISION <b>A</b>
DISCIPLINE CODE -	
DRAWING NO. <b>ASC-STORM-02-12.1</b>	

PM61308 RL  
 E: 498528.114  
 N: 6931171.033  
 RL: 54.660m

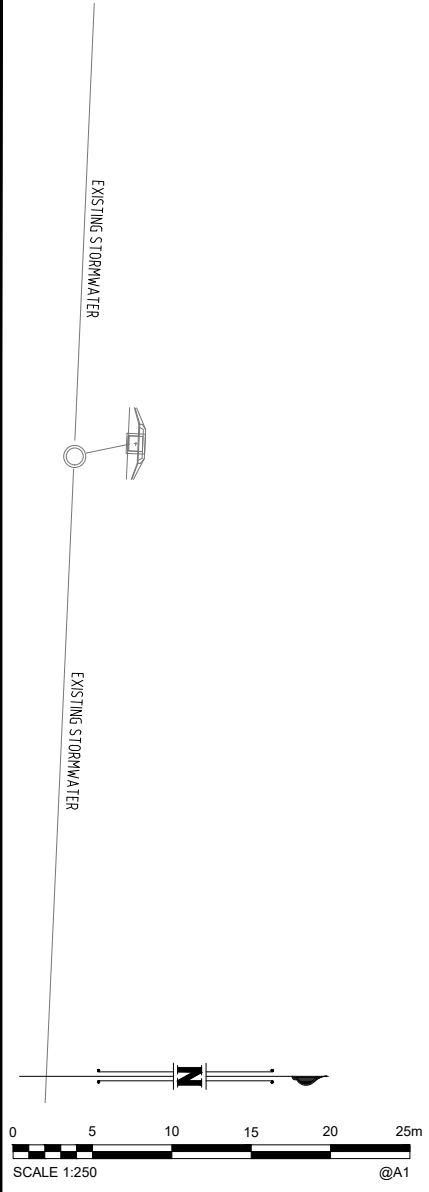

**AS CONSTRUCTED**

**ENGINEER'S CERTIFICATION**


I, \_\_\_\_\_, hereby certify that:

- The information contained in this drawing / document is in compliance with approved drawings and design.
- The new water and sewerage works defined by this drawing have been designed and constructed in accordance with the SEQ Code.
- This represents an accurate record of as-constructed works.
- I accept responsibility for the information contained in this drawing / document.

RPEQ (signature) RPEQ No. \_\_\_\_\_ Date: \_\_\_\_\_

**REGISTERED SURVEYOR'S CERTIFICATION**

I, Gordon Nicholson, hereby certify that the vertical and horizontal locations and dimensions shown on this plan are a true and correct record and were located by survey.

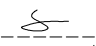 Registered Surveyor (sig.) Reg. Surveyor No. SA 3405 Date: 28/07/2021

**COORDINATE DATUM NOTE:**  
 HORIZONTAL COORDINATES(E,N) SUPPLIED ARE MAPPING GRID OF AUSTRALIA(MGA), ZONE 56 BASED ON THE UNIVERSAL TRANSVERSE MERCATOR PROJECTION AND THE GEOCENTRIC DATUM OF AUSTRALIA 1994.  
 HORIZONTAL DATUM DERIVED FROM PSM 61308 E 498528.114 N 6931171.033.  
 LEVELS SUPPLIED ARE ON THE AUSTRALIAN HEIGHT DATUM(AHD)  
 LEVEL DATUM DERIVED FROM PSM 61308 RL54.660 (AHD)

A1	INDEX	DATE	REVISIONS	DRAWN	CHECKED	PASSED	INITIALS	DATE
	A	28/07/2021	AS CONSTRUCTED	NJA	DAM	LS		28/07/2021



58 Southwood Lane, Forest Glen QLD 4006  
 07 5438 2000 • 07 5438 2008 • shadforth@shadforth.com.au




**LOGAN CITY COUNCIL**

MIRVAC MIR001-04  
 AS CONSTRUCTED SURVEY - STORMWATER  
 EVERLEIGH PRECINCT 12.1  
 GREENBANK QLD

SHEET 3 OF 6 SHEETS	SCALE 1:250 A1
REVISION DATE 28/07/2021	REVISION <b>A</b>
DISCIPLINE CODE -	
DRAWING NO. <b>ASC-STORMWATER-03-12.1</b>	

PM61308 RL  
 E: 498528.114  
 N: 6931171.033  
 RL: 54.660m

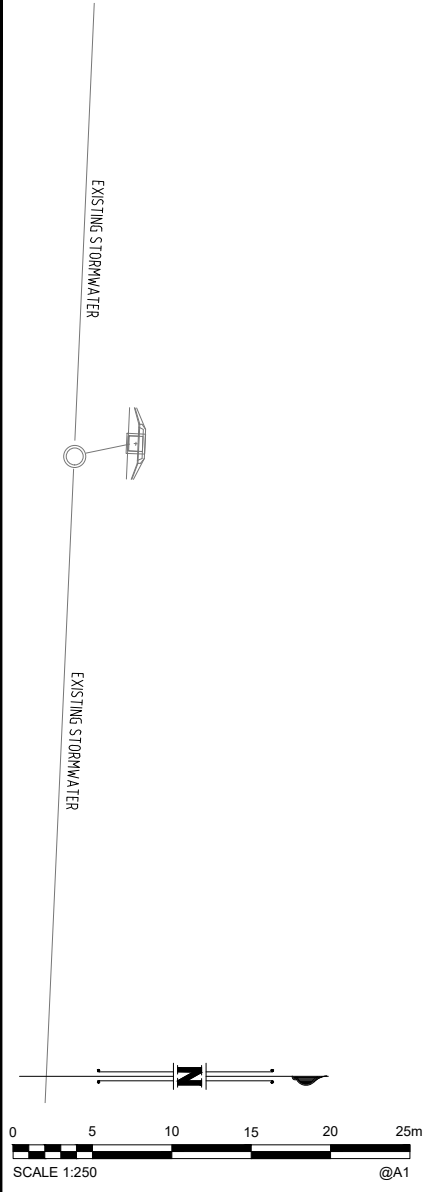

EXISTING STORMWATER  
 EXISTING STORMWATER

SCALE 1:250 @A1

**AS CONSTRUCTED**

**ENGINEER'S CERTIFICATION**


I, \_\_\_\_\_, hereby certify that:

- The information contained in this drawing / document is in compliance with approved drawings and design.
- The new water and sewerage works defined by this drawing have been designed and constructed in accordance with the SEQ Code.
- This represents an accurate record of as-constructed works.
- I accept responsibility for the information contained in this drawing / document.

RPEQ (signature) RPEQ No. \_\_\_\_\_ Date: \_\_\_\_\_

**REGISTERED SURVEYOR'S CERTIFICATION**

I, Gordon Nicholson, hereby certify that the vertical and horizontal locations and dimensions shown on this plan are a true and correct record and were located by survey.

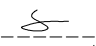  
 Registered Surveyor (sig.) Reg. Surveyor No. SA 3405 Date: 28/07/2021

**COORDINATE DATUM NOTE:**  
 HORIZONTAL COORDINATES(E,N) SUPPLIED ARE MAPPING GRID OF AUSTRALIA(MGA), ZONE 56 BASED ON THE UNIVERSAL TRANSVERSE MERCATOR PROJECTION AND THE GEOCENTRIC DATUM OF AUSTRALIA 1994.  
 HORIZONTAL DATUM DERIVED FROM PSM 61308 E 498528.114 N 6931171.033.  
 LEVELS SUPPLIED ARE ON THE AUSTRALIAN HEIGHT DATUM(AHD)  
 LEVEL DATUM DERIVED FROM PSM 61308 RL54.660 (AHD)

A1	INDEX	DATE	REVISIONS	DRAWN	CHECKED	PASSED	INITIALS	DATE
	A	28/07/2021	AS CONSTRUCTED	NJA	DAM	LS		28/07/2021



58 Southwood Lane, Forest Glen QLD 4006  
 07 5438 2000 • 07 5438 2008 • shadforth@shadforth.com.au



**LOGAN CITY COUNCIL**

MIRVAC MIR001-04  
 AS CONSTRUCTED SURVEY - STORMWATER  
 EVERLEIGH PRECINCT 12.1  
 GREENBANK QLD

SHEET 3 OF 6 SHEETS	SCALE 1:250 A1
REVISION DATE 28/07/2021	REVISION <b>A</b>
DISCIPLINE CODE -	
DRAWING NO. <b>ASC-STORMWATER-03-12.1</b>	

