



REFER TO PLAN ASC-RDS & EWKS-02-12.1

REFER TO PLAN ASC-RDS & EWKS-03-12.1




**COORDINATE DATUM NOTE:**  
 HORIZONTAL COORDINATES (E, N) SUPPLIED ARE MAPPING GRID OF AUSTRALIA (MGA), ZONE 56 BASED ON THE UNIVERSAL TRANSVERSE MERCATOR PROJECTION AND THE GEOCENTRIC DATUM OF AUSTRALIA 1994.  
 HORIZONTAL DATUM DERIVED FROM PSM 61308 E 4.98528.114 N 6931171.033.  
 LEVELS SUPPLIED ARE ON THE AUSTRALIAN HEIGHT DATUM (AHD) LEVEL DATUM DERIVED FROM PSM 61308 RL54.660 (AHD)

PAVEMENT DESIGN		SPOT HEIGHTS	
TUSCAN CIRCUIT	AC(mm)- 35	+	56.36
	BASE(2.1)(mm) - 150	WALL HEIGHTS	
	SUBBASE(2.3)(mm) - 150	56.600	
		55.524	
SPRING STREET		RETAINING WALLS	
	AC(mm)- 35		
	BASE(2.1)(mm) - 150	ACCOUSTIC WALLS	
	SUBBASE(2.3)(mm) - 150		

**ENGINEER'S CERTIFICATION**  
 I, \_\_\_\_\_, hereby certify that:  
 1. The information contained in this drawing / document is in compliance with approved drawings and design.  
 2. This represents an accurate record of as-constructed works  
 3. I accept responsibility for the information contained in this drawing / document.  
 RPEQ (signature) RPEQ No. \_\_\_\_\_ Date: \_\_\_\_\_

**REGISTERED SURVEYOR'S CERTIFICATION**  
 I, Gordon Nicholson, hereby certify that the vertical and horizontal locations and dimensions shown on this plan are a true and correct record and were located by survey.  
 Registered Surveyor (sig) \_\_\_\_\_ Reg. Surveyor No. SA 3405 Date: 10/09/2021

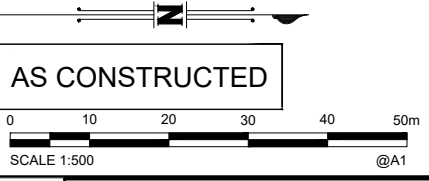

<b>A1</b>	A	10/09/2021	AS CONSTRUCTED	NJA	DAM	CW
	INDEX	DATE	REVISIONS	DRAWN	CHECKED	PASSED

DRAWN	NJA	10/09/2021
CHECKED	DAM	10/09/2021
PASSED	CW	10/09/2021
INITIALS	DATE	



**LOGAN CITY COUNCIL**  
 MIRVAC MIR012-03  
 AS CONSTRUCTED SURVEY - ROADS AND EARTHWORKS  
 EVERLEIGH PRECINCT 12.3  
 GREENBANK QLD

SHEET 1 OF 3 SHEETS	SCALE 1:750 A1
REVISION DATE 10/09/2021	REVISION A
DISCIPLINE CODE -	
DRAWING NO. ASC-RDS AND EWKS-01-12.3	



**COORDINATE DATUM NOTE:**  
 HORIZONTAL COORDINATES(E,N) SUPPLIED ARE MAPPING GRID OF AUSTRALIA(MGA), ZONE 56 BASED ON THE UNIVERSAL TRANSVERSE MERCATOR PROJECTION AND THE GEOCENTRIC DATUM OF AUSTRALIA 1994.  
 HORIZONTAL DATUM DERIVED FROM PSM 61308 E 4.98528,114 N 6931171.033.  
 LEVELS SUPPLIED ARE ON THE AUSTRALIAN HEIGHT DATUM(AHD) LEVEL DATUM DERIVED FROM PSM 61308 RL54.660 (AHD)

**PAVEMENT DESIGN**  
 TUSCAN CIRCUIT  
 AC(mm)- 35  
 BASE(2.1)(mm) - 150  
 SUBBASE(2.3)(mm) - 150  
 SPRING STREET  
 AC(mm)- 35  
 BASE(2.1)(mm) - 150  
 SUBBASE(2.3)(mm) - 150


**SPOT HEIGHTS**  
 +56.36

**WALL HEIGHTS**  
 56.600  
 55.524

**RETAINING WALLS**

**ENGINEER'S CERTIFICATION**  
 I, \_\_\_\_\_, hereby certify that:  
 1. The information contained in this drawing / document is in compliance with approved drawings and design.  
 2. This represents an accurate record of as-constructed works  
 3. I accept responsibility for the information contained in this drawing / document.  
 RPEQ (signature) RPEQ No. \_\_\_\_\_ Date: \_\_\_\_\_

**REGISTERED SURVEYOR'S CERTIFICATION**  
 I, Gordon Nicholson, hereby certify that the vertical and horizontal locations and dimensions shown on this plan are a true and correct record and were located by survey.  
 Registered Surveyor (sig.) Reg. Surveyor No. SA 34.05 Date: 10/09/2021

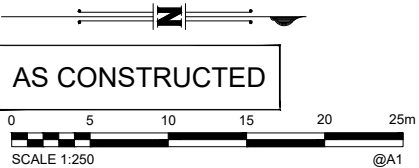


<b>A1</b>	INDEX	DATE	REVISIONS	DRAWN	CHECKED	PASSED	INITIALS	DATE
	A	10/09/2021	AS CONSTRUCTED	NJA	DAM	CW		10/09/2021



**LOGAN CITY COUNCIL**  
 MIRVAC MIR012-03  
 AS CONSTRUCTED SURVEY - ROADS AND EARTHWORKS  
 EVERLEIGH PRECINCT 12.3  
 GREENBANK QLD

SHEET 2 OF 3 SHEETS	SCALE 1:250 A1
REVISION DATE 10/09/2021	REVISION A
DISCIPLINE CODE -	
DRAWING NO. ASC-RDS AND EWKS-02-12.3	

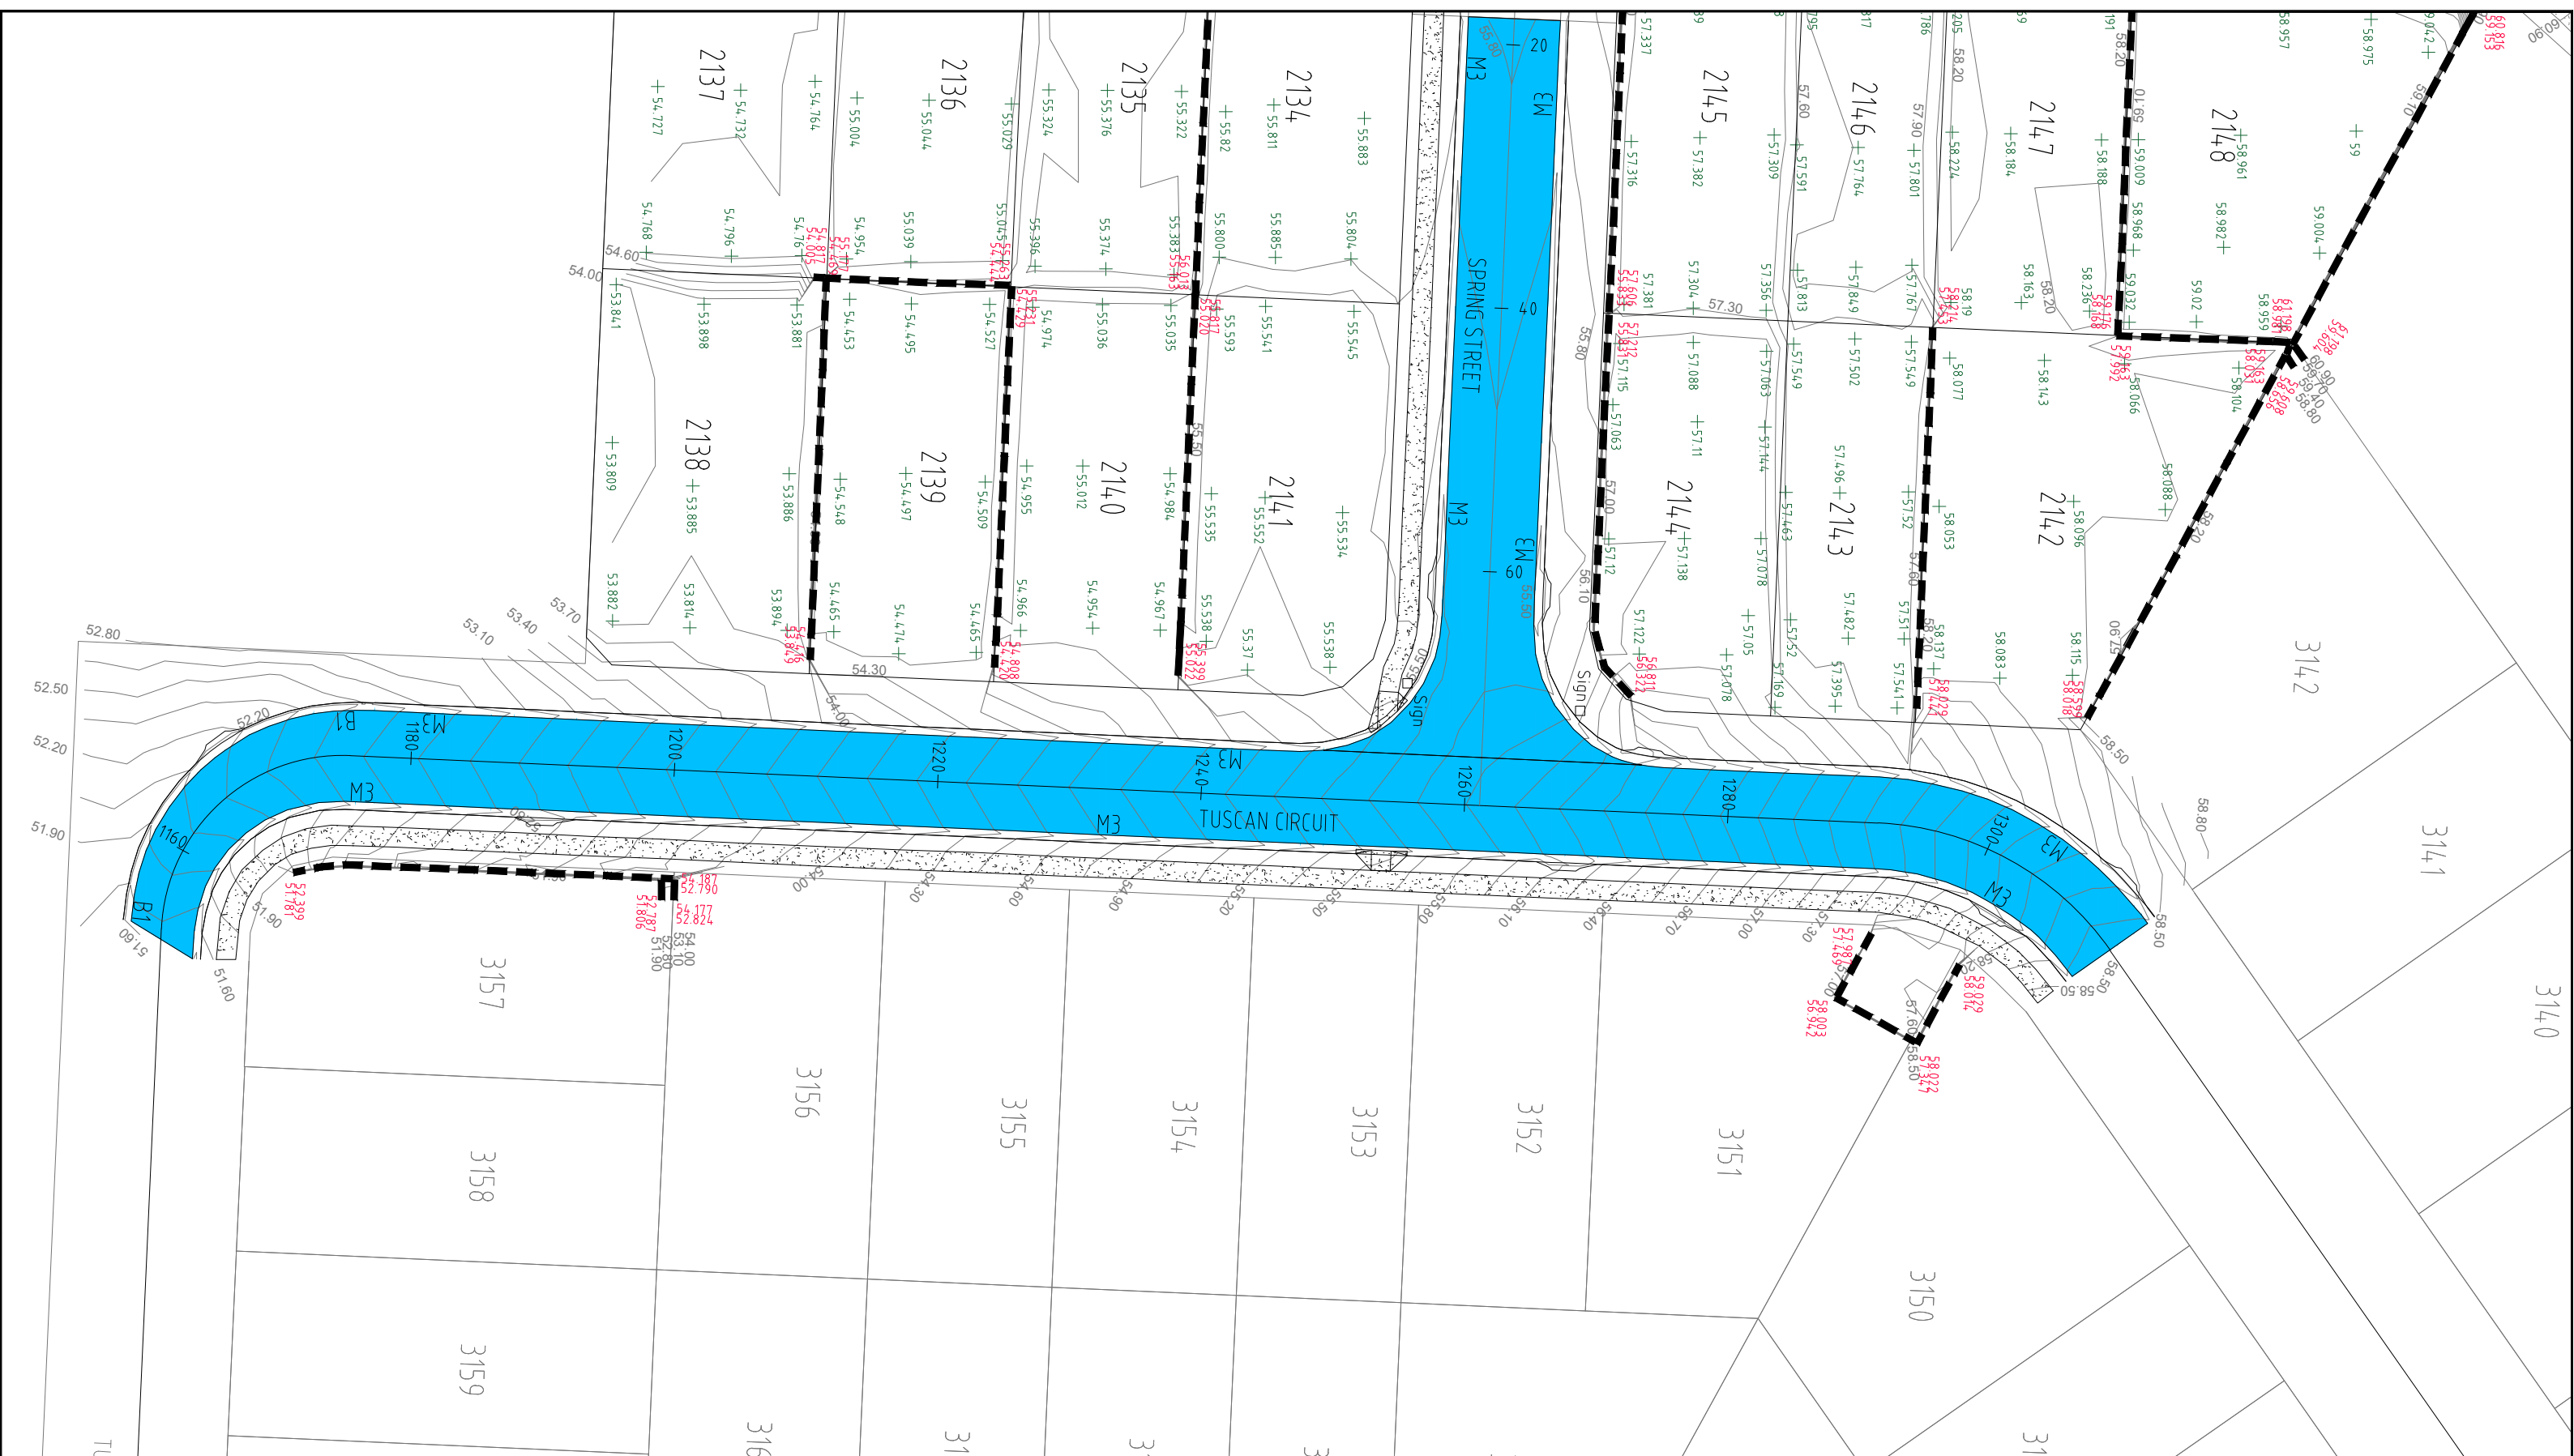


**COORDINATE DATUM NOTE:**  
 HORIZONTAL COORDINATES(E,N) SUPPLIED ARE MAPPING GRID OF AUSTRALIA(MGA), ZONE 56 BASED ON THE UNIVERSAL TRANSVERSE MERCATOR PROJECTION AND THE GEOCENTRIC DATUM OF AUSTRALIA 1994.  
 HORIZONTAL DATUM DERIVED FROM PSM 61308 E 4.98528.114 N 6931171.033.  
 LEVELS SUPPLIED ARE ON THE AUSTRALIAN HEIGHT DATUM(AHD) LEVEL DATUM DERIVED FROM PSM 61308 RL54.660 (AHD)

PAVEMENT DESIGN	
<b>TUSCAN CIRCUIT</b>	<b>SPOT HEIGHTS</b>
AC(mm)- 35	+56.36
BASE(2.1)(mm) - 150	<b>WALL HEIGHTS</b>
SUBBASE(2.3)(mm) - 150	56.600
	55.524
<b>SPRING STREET</b>	<b>RETAINING WALLS</b>
AC(mm)- 35	---
BASE(2.1)(mm) - 150	<b>ACOUSTIC WALLS</b>
SUBBASE(2.3)(mm) - 150	---

**ENGINEER'S CERTIFICATION**  
 I, \_\_\_\_\_, hereby certify that:  
 1. The information contained in this drawing / document is in compliance with approved drawings and design.  
 2. This represents an accurate record of as-constructed works  
 3. I accept responsibility for the information contained in this drawing / document.  
 RPEQ (signature) RPEQ No. \_\_\_\_\_ Date: \_\_\_\_\_

**REGISTERED SURVEYOR'S CERTIFICATION**  
 I, Gordon Nicholson, hereby certify that the vertical and horizontal locations and dimensions shown on this plan are a true and correct record and were located by survey.  
 Registered Surveyor (sig.) \_\_\_\_\_ Reg. Surveyor No. SA 3405 Date: 10/09/2021

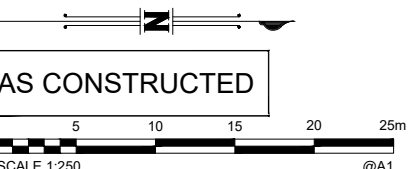

<b>A1</b>			
	INDEX	DATE	REVISIONS
	A	10/09/2021	AS CONSTRUCTED

DRAWN	NJA	10/09/2021
CHECKED	DAM	10/09/2021
PASSED	CW	10/09/2021
INITIALS		DATE



**LOGAN CITY COUNCIL**  
 MIRVAC MIR012-03  
 AS CONSTRUCTED SURVEY - ROADS AND EARTHWORKS  
 EVERLEIGH PRECINCT 12.3  
 GREENBANK QLD

SHEET 3 OF 3 SHEETS	SCALE 1:250 A1
REVISION DATE 10/09/2021	REVISION <b>A</b>
DISCIPLINE CODE	
DRAWING NO.	
<b>ASC-RDS AND EWKS-03-12.3</b>	