



**ENGINEER'S CERTIFICATION**

- I, \_\_\_\_\_ hereby certify that:
- 1. The information contained in this drawing / document is in compliance with approved drawings and design.
- 2. The new water and sewerage works defined by this drawing have been designed and constructed in accordance with the SEQ Code.
- 3. This represents an accurate record of as-constructed works.
- 4. I accept responsibility for the information contained in this drawing / document.



\_\_\_\_\_  
RPEQ (signature) RPEQ No. \_\_\_\_\_ Date: \_\_\_\_\_

**AS CONSTRUCTED**

**REGISTERED SURVEYOR'S CERTIFICATION**

I, Gordon Nicholson, hereby certify that the vertical and horizontal locations and dimensions shown on this plan are a true and correct record and were located by survey.

Gordon Nicholson  
Registered Surveyor (Sig.) Reg. Surveyor No. SA 3405 Date: 16/11/2021

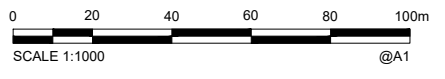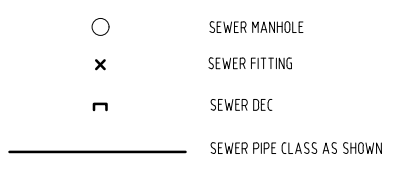

**COORDINATE DATUM NOTE:**  
 HORIZONTAL COORDINATES(E,N) SUPPLIED ARE MAPPING GRID OF AUSTRALIA(MGA), ZONE 56 BASED ON THE UNIVERSAL TRANSVERSE MERCATOR PROJECTION AND THE GEOCENTRIC DATUM OF AUSTRALIA 1994.  
 HORIZONTAL DATUM DERIVED FROM PSM 61308 E 4.98528.114 N 6931171.033.  
 LEVELS SUPPLIED ARE ON THE AUSTRALIAN HEIGHT DATUM(AHD)  
 LEVEL DATUM DERIVED FROM PSM 61308 RL54.660 (AHD)

**A1**

INDEX	DATE	REVISIONS	DRAWN	CHECKED	PASSED
A	16/11/2021	AS CONSTRUCTED	NJA	DAM	CW


DRAWN	INITIALS	DATE
NJA	NJA	16/11/2021
DAM	DAM	16/11/2021
CW	CW	16/11/2021



**LOGAN CITY COUNCIL**  
 MIRVAC MIR012-02  
 AS CONSTRUCTED SURVEY - SEWER  
 EVERLEIGH PRECINCT 12.2  
 GREENBANK QLD

SHEET 1 OF 5 SHEETS	SCALE 1:1000 A1
REVISION DATE 16/11/2021	REVISION <b>A</b>
DISCIPLINE CODE	
DRAWING NO.	
<b>ASC-SEWER-01-12.2</b>	

PM61308 RL  
 E: 498528.114  
 N: 6931171.033  
 RL: 54.660m

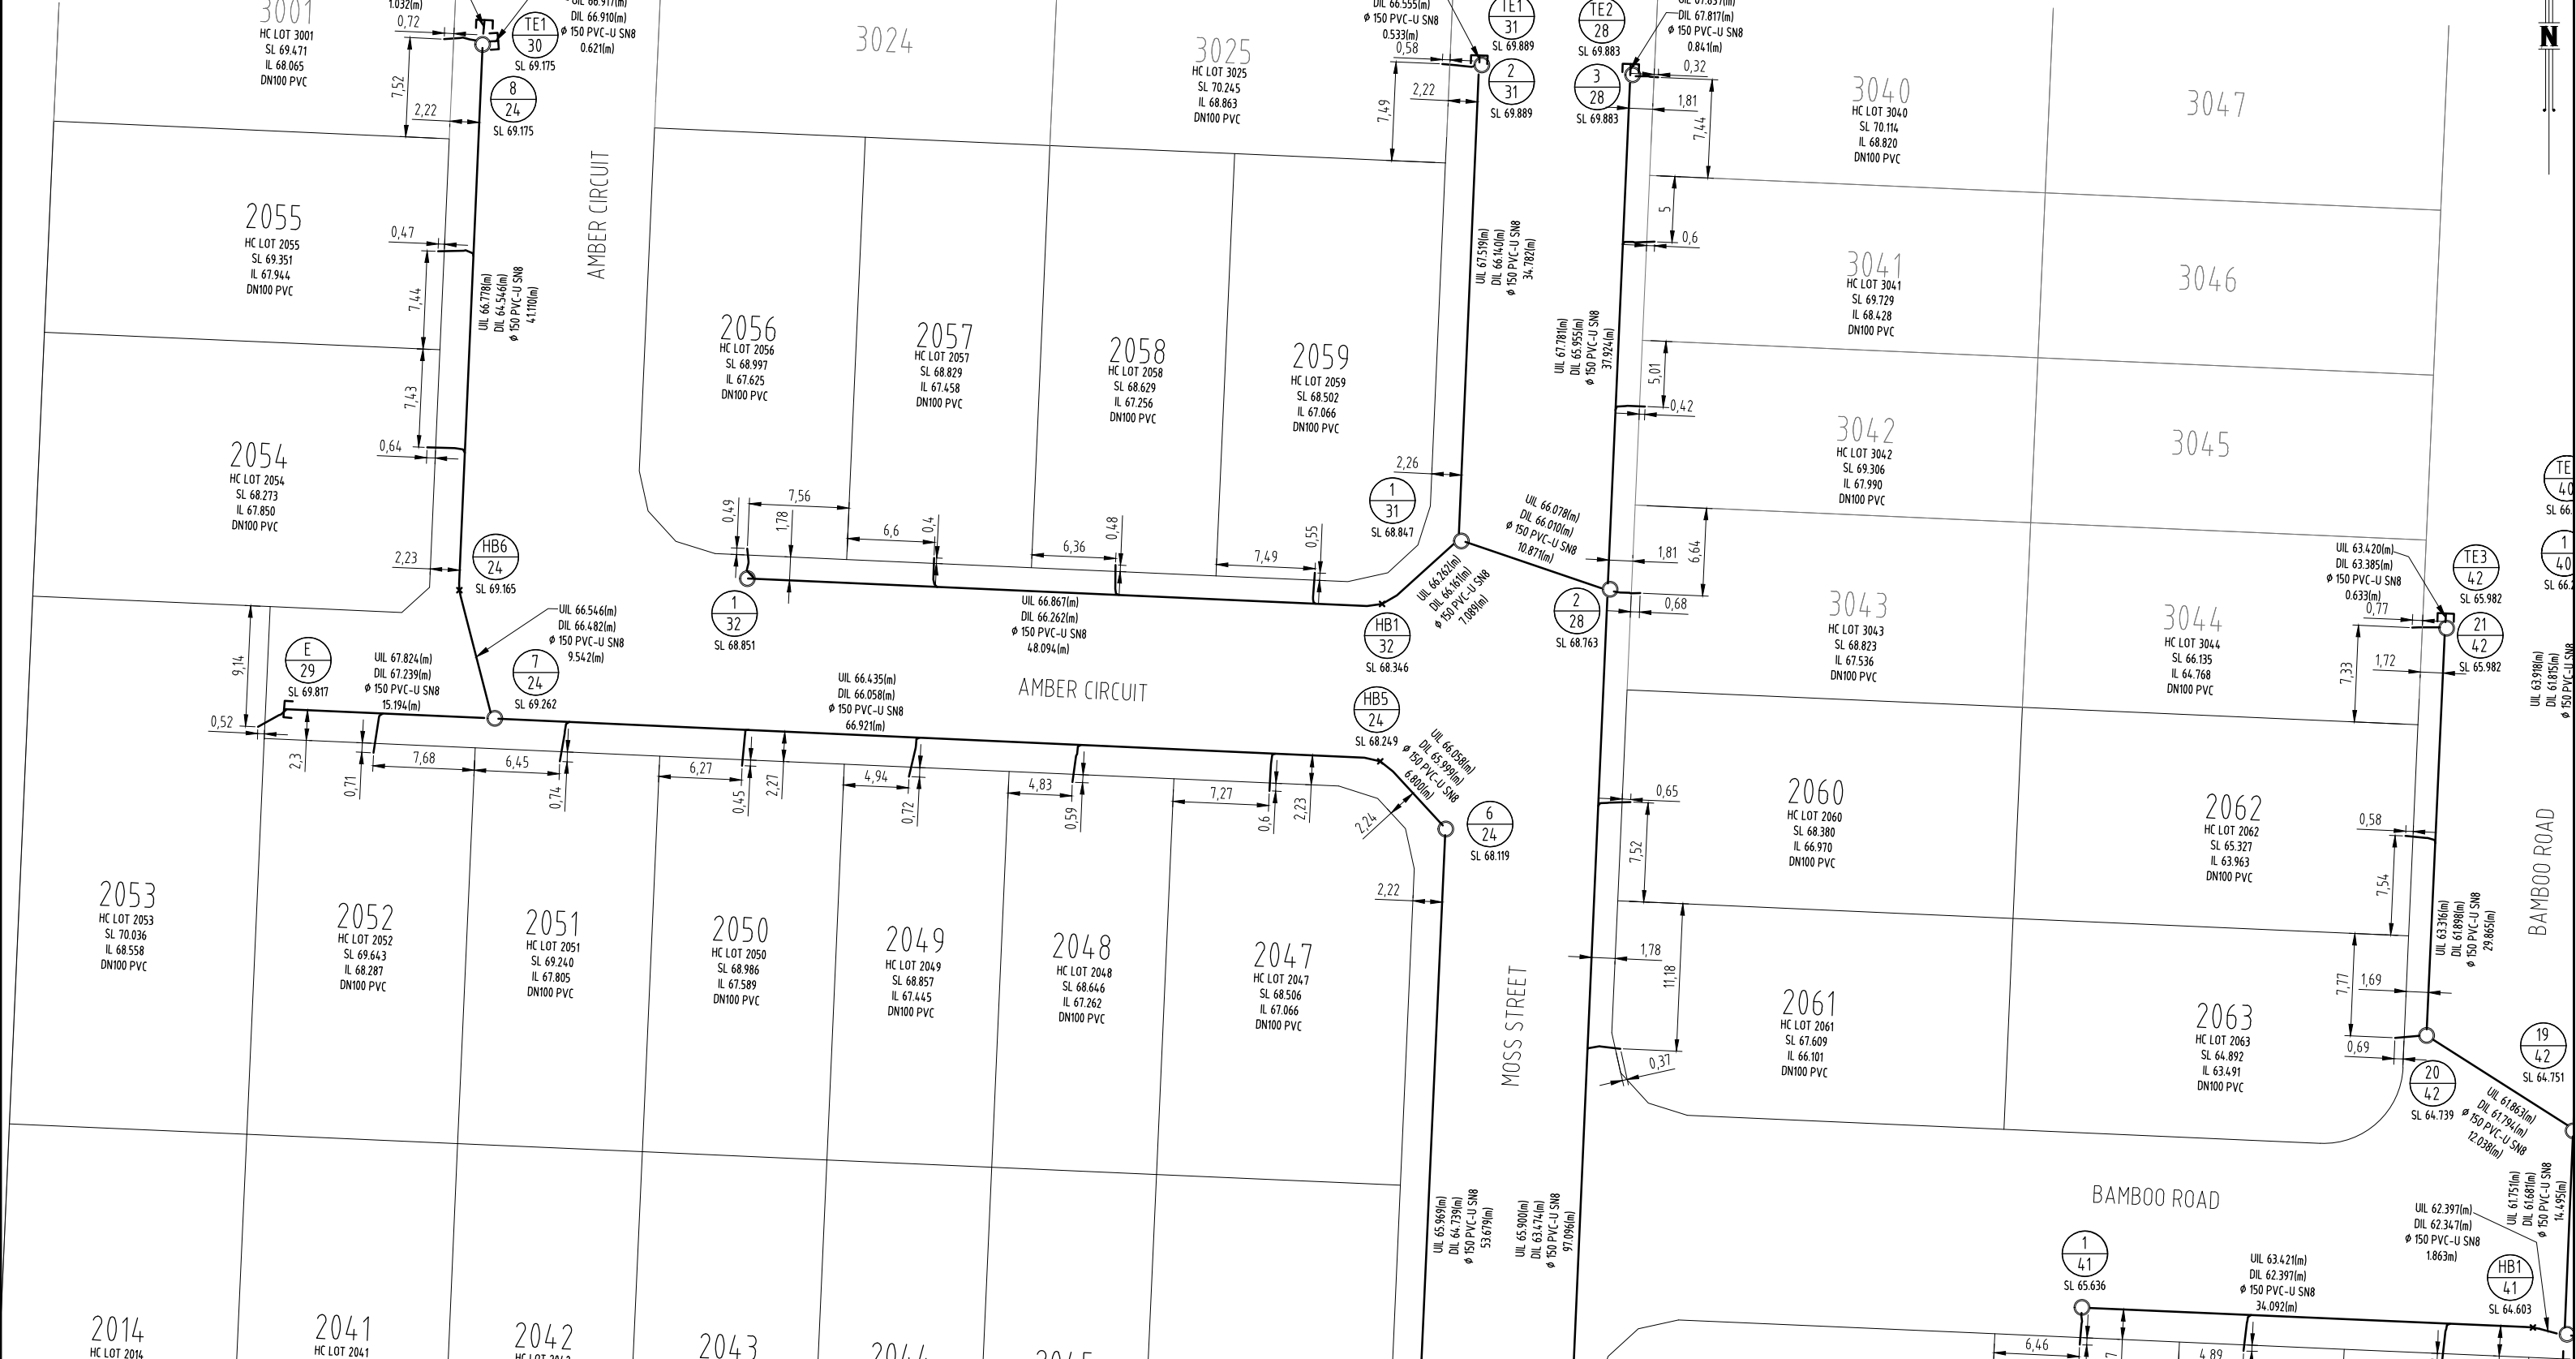


**COORDINATE DATUM NOTE:**  
 HORIZONTAL COORDINATES (E, N) SUPPLIED ARE MAPPING GRID OF AUSTRALIA (MGA), ZONE 56 BASED ON THE UNIVERSAL TRANSVERSE MERCATOR PROJECTION AND THE GEOCENTRIC DATUM OF AUSTRALIA 1994.  
 HORIZONTAL DATUM DERIVED FROM PSM 61308 E 498528.114 N 6931171.033.  
 LEVELS SUPPLIED ARE ON THE AUSTRALIAN HEIGHT DATUM (AHD)  
 LEVEL DATUM DERIVED FROM PSM 61308 RL54.660 (AHD)

**REGISTERED SURVEYOR'S CERTIFICATION**  
 I, Gordon Nicholson, hereby certify that the vertical and horizontal locations and dimensions shown on this plan are a true and correct record and were located by survey.  
 Registered Surveyor (sig.) Reg. Surveyor No. SA 3405 Date: 16/11/2021

**ENGINEER'S CERTIFICATION**  
 I, \_\_\_\_\_, hereby certify that:  
 1. The information contained in this drawing / document is in compliance with approved drawings and design.  
 2. The new water and sewerage works defined by this drawing have been designed and constructed in accordance with the SEQ Code.  
 3. This represents an accurate record of as-constructed works.  
 4. I accept responsibility for the information contained in this drawing / document.  
 RPEQ (signature) RPEQ No. \_\_\_\_\_ Date: \_\_\_\_\_

○ SEWER MANHOLE  
 x SEWER FITTING  
 □ SEWER DEC  
 \_\_\_\_\_ SEWER PIPE CLASS AS SHOWN

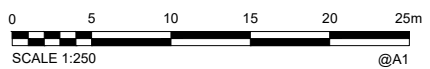

**AS CONSTRUCTED**

A1	A	16/11/2021	AS CONSTRUCTED	NJA	DAM	CW	PASSED	CW	16/11/2021
	INDEX	DATE	REVISIONS	DRAWN	CHECKED	PASSED	INITIALS	DATE	


**shadforth**  
 58 Shadforth Lane, Forest Glen QLD 4086  
 07 5438 2000 • 07 5438 2008 • shadforth@shadforth.com.au



**LOGAN CITY COUNCIL**  
 MIRVAC MIR012-02  
 AS CONSTRUCTED SURVEY - SEWER  
 EVERLEIGH PRECINCT 12.2  
 GREENBANK QLD

SHEET 2 OF 5 SHEETS	SCALE 1:250 A1
REVISION DATE 16/11/2021	REVISION A
DISCIPLINE CODE -	
DRAWING NO. ASC-SEWER-02-12.2	



PM61308 RL  
E: 498528.114  
N: 6931171.033  
RL: 54.660m

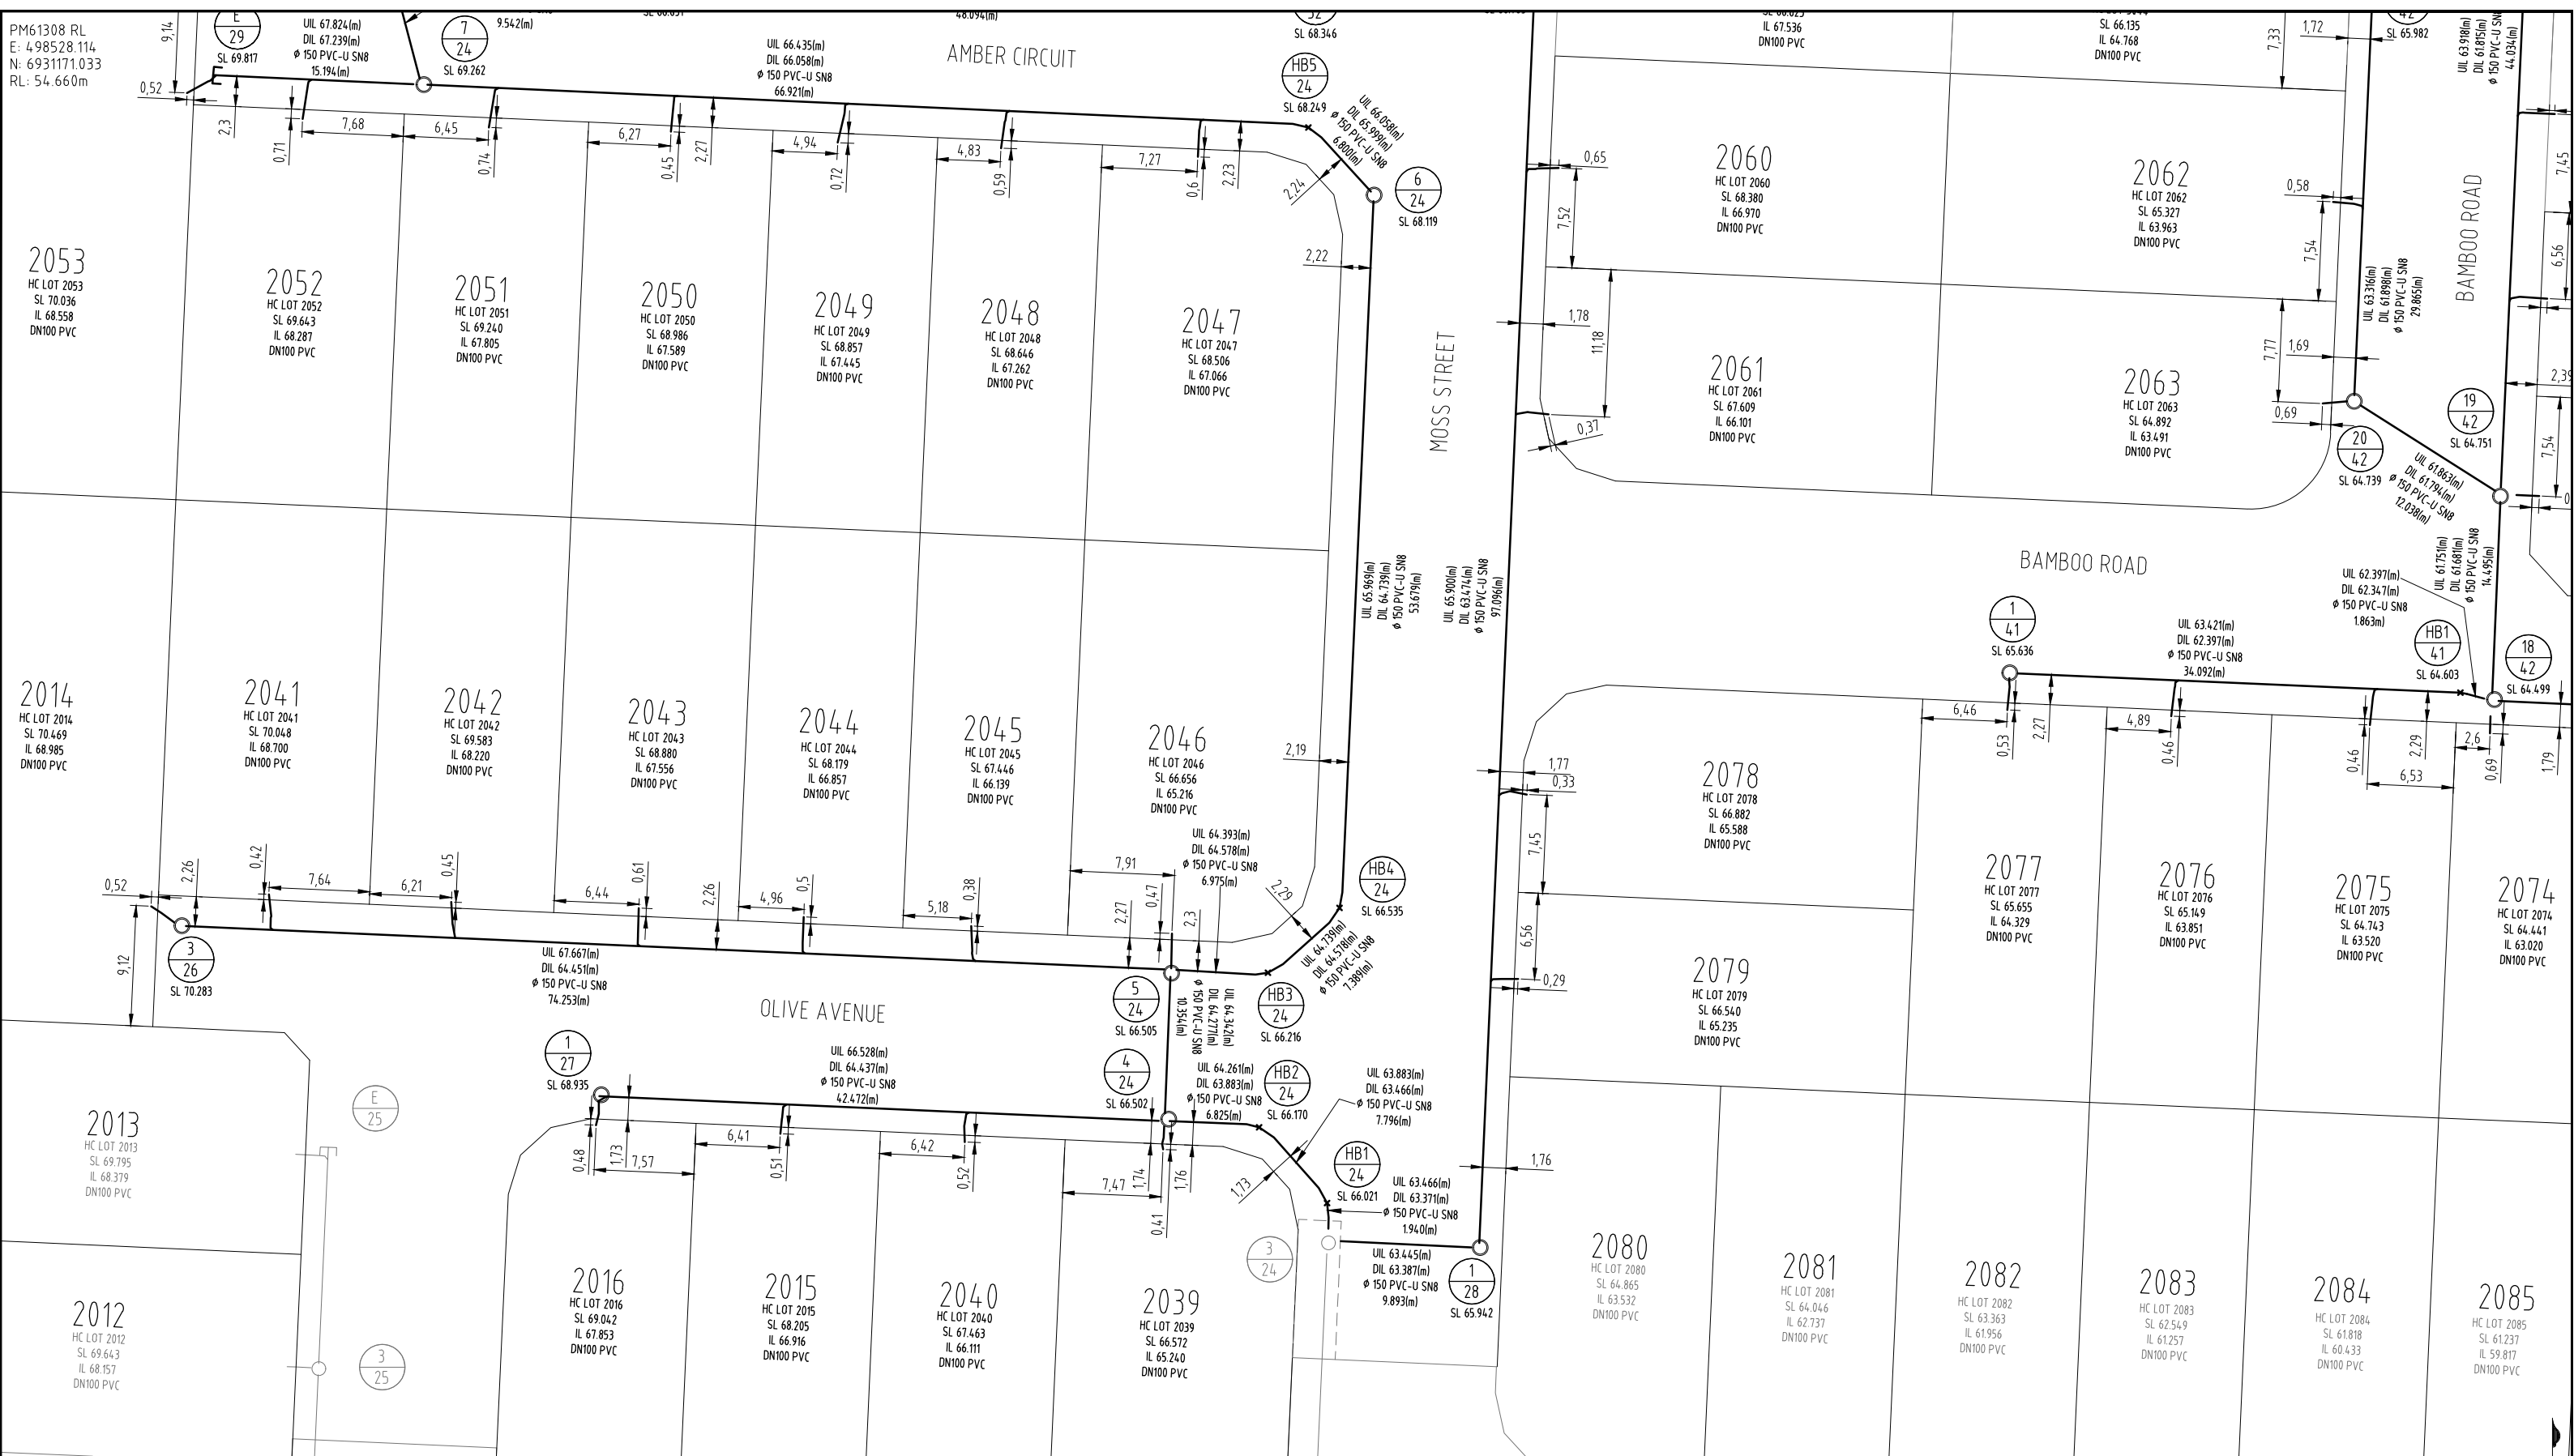

**COORDINATE DATUM NOTE:**  
HORIZONTAL COORDINATES (E, N) SUPPLIED ARE MAPPING GRID OF AUSTRALIA (MGA), ZONE 56 BASED ON THE UNIVERSAL TRANSVERSE MERCATOR PROJECTION AND THE GEOCENTRIC DATUM OF AUSTRALIA 1994.  
HORIZONTAL DATUM DERIVED FROM PSM 61308 E 498528.114 N 6931171.033.  
LEVELS SUPPLIED ARE ON THE AUSTRALIAN HEIGHT DATUM (AHD)  
LEVEL DATUM DERIVED FROM PSM 61308 RL54.660 (AHD)

**REGISTERED SURVEYOR'S CERTIFICATION**  
I, Gordon Nicholson, hereby certify that the vertical and horizontal locations and dimensions shown on this plan are a true and correct record and were located by survey.  
Registered Surveyor (Sig.) [Signature] Reg. Surveyor No. SA 3405 Date: 16/11/2021

**ENGINEER'S CERTIFICATION**  
I, \_\_\_\_\_, hereby certify that:  
1. The information contained in this drawing / document is in compliance with approved drawings and design.  
2. The new water and sewerage works defined by this drawing have been designed and constructed in accordance with the SED Code.  
3. This represents an accurate record of as-constructed works.  
4. I accept responsibility for the information contained in this drawing / document.  
RPEQ (signature) \_\_\_\_\_ RPEQ No. \_\_\_\_\_ Date: \_\_\_\_\_

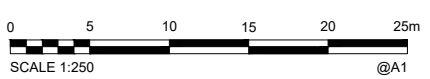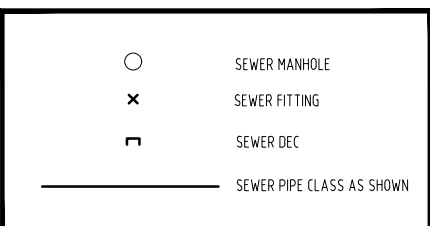

**AS CONSTRUCTED**

A1	A	16/11/2021	AS CONSTRUCTED	NJA	DAM	CW	DRAWN	NJA	16/11/2021
	INDEX	DATE	REVISIONS	DRAWN	CHECKED	PASSED	INITIALS	DATE	



**LOGAN CITY COUNCIL**  
MIRVAC MIR012-02  
AS CONSTRUCTED SURVEY - SEWER  
EVERLEIGH PRECINCT 12.2  
GREENBANK QLD

SHEET 3 OF 5 SHEETS	SCALE 1:250 A1
REVISION DATE 16/11/2021	REVISION A
DISCIPLINE CODE	
DRAWING NO.	
<b>ASC-SEWER-03-12.2</b>	




**COORDINATE DATUM NOTE:**  
 HORIZONTAL COORDINATES (E, N) SUPPLIED ARE MAPPING GRID OF AUSTRALIA (MGA), ZONE 56 BASED ON THE UNIVERSAL TRANSVERSE MERCATOR PROJECTION AND THE GEOCENTRIC DATUM OF AUSTRALIA 1994.  
 HORIZONTAL DATUM DERIVED FROM PSM 61308 E 4.98528.114 N 6931171.033.  
 LEVELS SUPPLIED ARE ON THE AUSTRALIAN HEIGHT DATUM (AHD)  
 LEVEL DATUM DERIVED FROM PSM 61308 RL54.660 (AHD)

**REGISTERED SURVEYOR'S CERTIFICATION**  
 I, Gordon Nicholson, hereby certify that the vertical and horizontal locations and dimensions shown on this plan are a true and correct record and were located by survey.  
 Registered Surveyor (sig.) [Signature] Reg. Surveyor No. SA 3405 Date: 16/11/2021

**ENGINEER'S CERTIFICATION**  
 I, \_\_\_\_\_, hereby certify that:  
 1. The information contained in this drawing / document is in compliance with approved drawings and design.  
 2. The new water and sewerage works defined by this drawing have been designed and constructed in accordance with the SEQ Code.  
 3. This represents an accurate record of as-constructed works.  
 4. I accept responsibility for the information contained in this drawing / document.  
 RPEQ (signature) \_\_\_\_\_ RPEQ No. \_\_\_\_\_ Date: \_\_\_\_\_

Legend:  
 ○ SEWER MANHOLE  
 × SEWER FITTING  
 □ SEWER DEC  
 \_\_\_\_\_ SEWER PIPE CLASS AS SHOWN

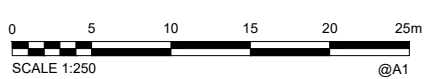


**AS CONSTRUCTED**

A1	A	16/11/2021	AS CONSTRUCTED	NJA	DAM	CW	PASSED		
	INDEX	DATE	REVISIONS	DRAWN	CHECKED	PASSED	INITIALS	DATE	



**LOGAN CITY COUNCIL**  
 MIRVAC MIR012-02  
 AS CONSTRUCTED SURVEY - SEWER  
 EVERLEIGH PRECINCT 12.2  
 GREENBANK QLD

SHEET 4 OF 5 SHEETS	SCALE 1:250 A1
REVISION DATE 16/11/2021	REVISION A
DISCIPLINE CODE -	
DRAWING NO. ASC-SEWER-04-12.2	

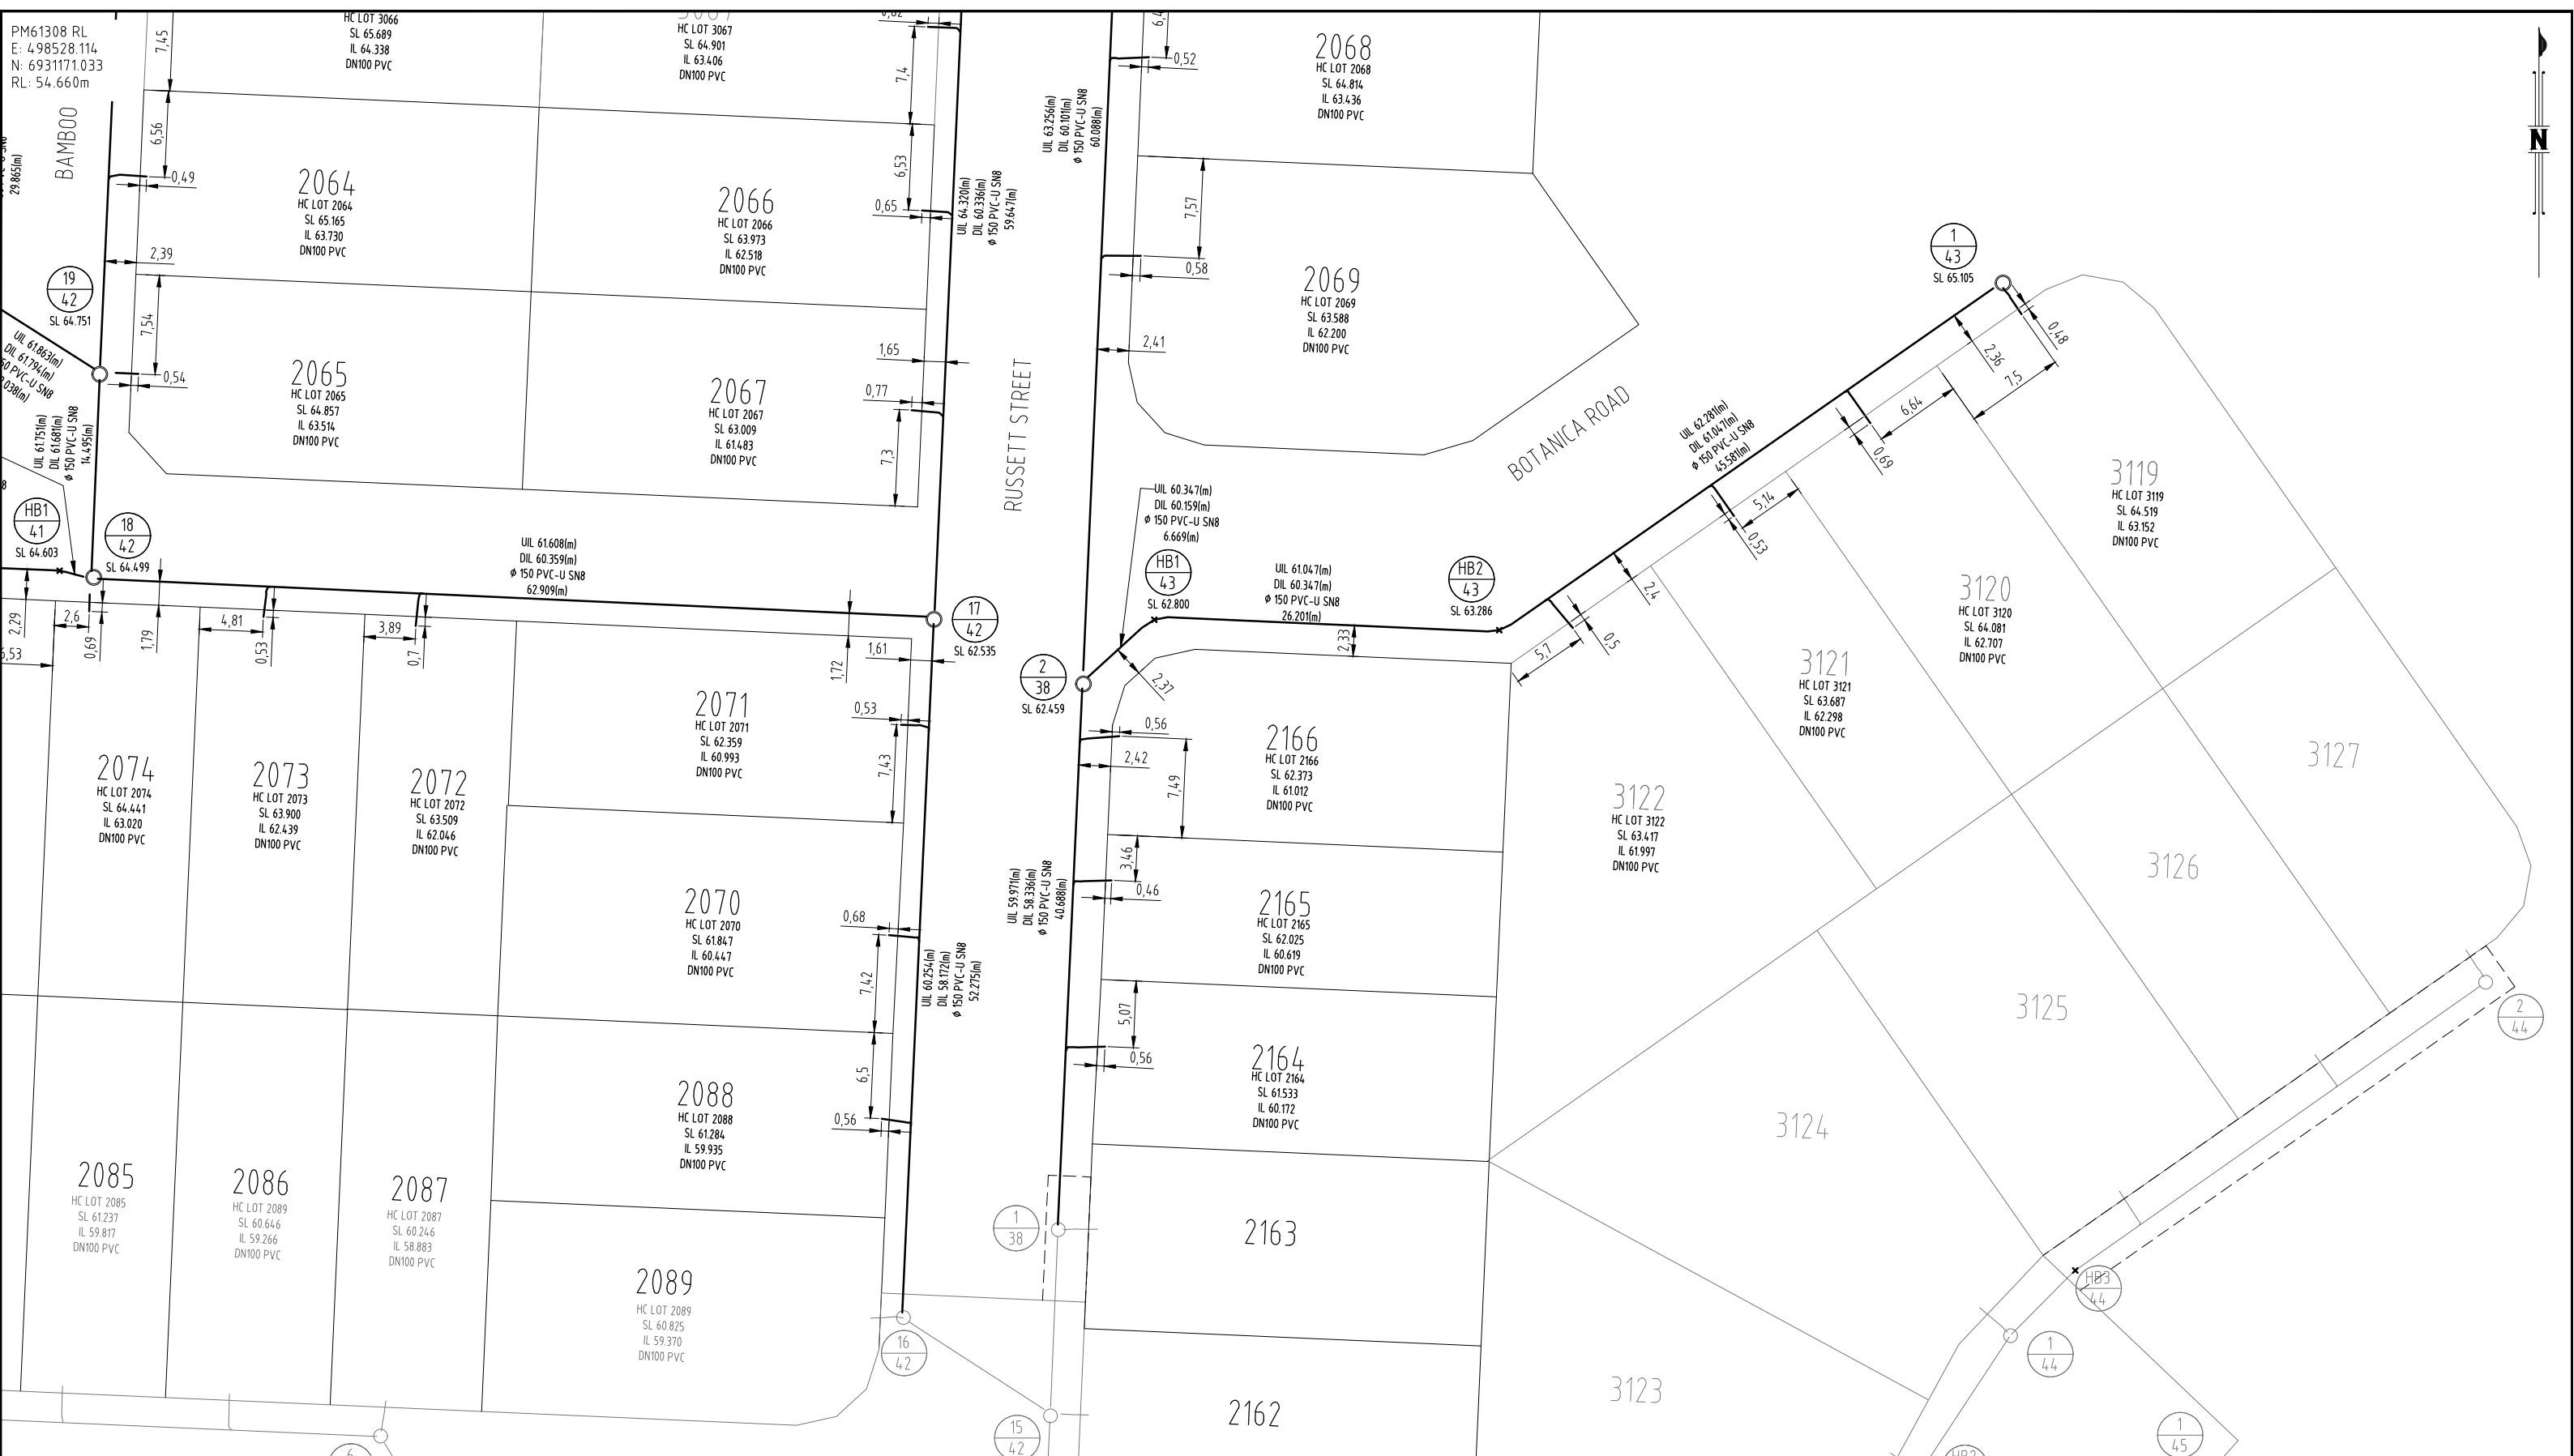


**COORDINATE DATUM NOTE:**  
 HORIZONTAL COORDINATES(E,N) SUPPLIED ARE MAPPING GRID OF AUSTRALIA(MGA), ZONE 56 BASED ON THE UNIVERSAL TRANSVERSE MERCATOR PROJECTION AND THE GEOCENTRIC DATUM OF AUSTRALIA 1994.  
 HORIZONTAL DATUM DERIVED FROM PSM 61308 E 4.98528.114 N 6931171.033.  
 LEVELS SUPPLIED ARE ON THE AUSTRALIAN HEIGHT DATUM(AHD)  
 LEVEL DATUM DERIVED FROM PSM 61308 RL54.660 (AHD)

**REGISTERED SURVEYOR'S CERTIFICATION**  
 I, Gordon Nicholson, hereby certify that the vertical and horizontal locations and dimensions shown on this plan are a true and correct record and were located by survey.  
 Registered Surveyor (sig.) [Signature] Reg. Surveyor No. SA 3405 Date: 16/11/2021

**ENGINEER'S CERTIFICATION**  
 I, \_\_\_\_\_, hereby certify that:  
 1. The information contained in this drawing / document is in compliance with approved drawings and design.  
 2. The new water and sewerage works defined by this drawing have been designed and constructed in accordance with the SEQ Code.  
 3. This represents an accurate record of as-constructed works  
 4. I accept responsibility for the information contained in this drawing / document.  
 RPEQ (signature) \_\_\_\_\_ RPEQ No. \_\_\_\_\_ Date: \_\_\_\_\_

○ SEWER MANHOLE  
 x SEWER FITTING  
 □ SEWER DEC  
 \_\_\_\_\_ SEWER PIPE CLASS AS SHOWN

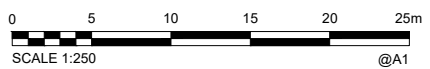

**AS CONSTRUCTED**

A1	A	16/11/2021	AS CONSTRUCTED	NJA	DAM	CW
	INDEX	DATE	REVISIONS	DRAWN	CHECKED	PASSED

DRAWN	NJA	16/11/2021
CHECKED	DAM	16/11/2021
PASSED	CW	16/11/2021
INITIALS		DATE



**LOGAN CITY COUNCIL**  
 MIRVAC MIR012-02  
 AS CONSTRUCTED SURVEY - SEWER  
 EVERLEIGH PRECINCT 12.2  
 GREENBANK QLD

SHEET 5 OF 5 SHEETS	SCALE 1:250 A1
REVISION DATE 16/11/2021	REVISION A
DISCIPLINE CODE -	
DRAWING NO. ASC-SEWER-05-12.2	