

**ENGINEER'S CERTIFICATION**

I, \_\_\_\_\_, hereby certify that:

- The information contained in this drawing / document is in compliance with approved drawings and design.
- The new water and sewerage works defined by this drawing have been designed and constructed in accordance with the SEQ Code.
- This represents an accurate record of as-constructed works.
- I accept responsibility for the information contained in this drawing / document.

\_\_\_\_\_  
RPEQ (signature) RPEQ No. \_\_\_\_\_ Date: \_\_\_\_\_

**AS CONSTRUCTED**

**REGISTERED SURVEYOR'S CERTIFICATION**

I, Gordon Nicholson, hereby certify that the vertical and horizontal locations and dimensions shown on this plan are a true and correct record and were located by survey.

\_\_\_\_\_  
Registered Surveyor (Sig.) Reg. Surveyor No. SA 3405 Date: 26/11/2021

**COORDINATE DATUM NOTE:**  
 HORIZONTAL COORDINATES(E,N) SUPPLIED ARE MAPPING GRID OF AUSTRALIA(MGA), ZONE 56 BASED ON THE UNIVERSAL TRANSVERSE MERCATOR PROJECTION AND THE GEOCENTRIC DATUM OF AUSTRALIA 1994.  
 HORIZONTAL DATUM DERIVED FROM PSM 61308 E 4 98528.114 N 6931171.033.  
 LEVELS SUPPLIED ARE ON THE AUSTRALIAN HEIGHT DATUM(AHD)  
 LEVEL DATUM DERIVED FROM PSM 61308 RL54.660 (AHD)

A1	INDEX	DATE	REVISIONS	DRAWN	CHECKED	PASSED	INITIALS	DATE
	A	26/11/2021	AS CONSTRUCTED	NJA	DAM	CW		26/11/2021




**LOGAN CITY COUNCIL**

MIRVAC MIR012-02  
 AS CONSTRUCTED SURVEY - STORMWATER  
 EVERLEIGH PRECINCT 12.2  
 GREENBANK QLD

SHEET 1 OF 4 SHEETS	SCALE 1:1000 A1
REVISION DATE 26/11/2021	REVISION A
DISCIPLINE CODE -	
DRAWING NO. ASC-STORM-01-12.2	

PM61308 RL  
 E: 4.98528.114  
 N: 6931171.033  
 RL: 54.660m

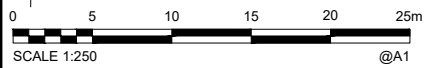

**AS CONSTRUCTED**

**ENGINEER'S CERTIFICATION**

I, \_\_\_\_\_, hereby certify that:

- The information contained in this drawing / document is in compliance with approved drawings and design.
- The new water and sewerage works defined by this drawing have been designed and constructed in accordance with the SEQ Code.
- This represents an accurate record of as-constructed works.
- I accept responsibility for the information contained in this drawing / document.

RPQ (signature) RPQ No. \_\_\_\_\_ Date: \_\_\_\_\_

**REGISTERED SURVEYOR'S CERTIFICATION**

I, Gordon Nicholson, hereby certify that the vertical and horizontal locations and dimensions shown on this plan are a true and correct record and were located by survey.

Gordon Nicholson  
 Registered Surveyor (sig.) Reg. Surveyor No. SA 3405 Date: 26/11/2021

**COORDINATE DATUM NOTE:**  
 HORIZONTAL COORDINATES(E,N) SUPPLIED ARE MAPPING GRID OF AUSTRALIA(MGA), ZONE 56 BASED ON THE UNIVERSAL TRANSVERSE MERCATOR PROJECTION AND THE GEOCENTRIC DATUM OF AUSTRALIA 1994.  
 HORIZONTAL DATUM DERIVED FROM PSM 61308 E 4.98528.114 N 6931171.033.  
 LEVELS SUPPLIED ARE ON THE AUSTRALIAN HEIGHT DATUM(AHD)  
 LEVEL DATUM DERIVED FROM PSM 61308 RL54.660 (AHD)

A1	INDEX	DATE	REVISIONS	DRAWN	CHECKED	PASSED	INITIALS	DATE
	A	26/11/2021	AS CONSTRUCTED	NJA	DAM	CW		26/11/2021

**shadforth**

380 Sandhurst Lane, Forest Glen QLD 4006  
 07 5438 2000 • 07 5438 2008 • shadforth@shadforth.com.au


**LOGAN CITY COUNCIL**

**LOGAN CITY COUNCIL**

MIRVAC MIR012-02  
 AS CONSTRUCTED SURVEY - STORMWATER  
 EVERLEIGH PRECINCT 12.2  
 GREENBANK QLD

SHEET 2 OF 4 SHEETS	SCALE 1:250 A1
REVISION DATE 26/11/2021	REVISION A
DISCIPLINE CODE -	
DRAWING NO. ASC-STORM-02-12.2	

PM61308 RL  
 E: 4.98528.114  
 N: 6931171.033  
 RL: 54.660m

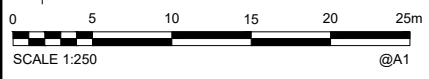

**AS CONSTRUCTED**

**ENGINEER'S CERTIFICATION**  
 I, \_\_\_\_\_, hereby certify that:  
 1. The information contained in this drawing / document is in compliance with approved drawings and design.  
 2. The new water and sewerage works defined by this drawing have been designed and constructed in accordance with the SEQ Code.  
 3. This represents an accurate record of as-constructed works.  
 4. I accept responsibility for the information contained in this drawing / document.  
 RPEQ (signature) RPEQ No. \_\_\_\_\_ Date: \_\_\_\_\_

**REGISTERED SURVEYOR'S CERTIFICATION**  
 I, Gordon Nicholson, hereby certify that the vertical and horizontal locations and dimensions shown on this plan are a true and correct record and were located by survey.  
 \_\_\_\_\_  
 Registered Surveyor (sig.) Reg. Surveyor No. SA 3405 Date: 26/11/2021

**COORDINATE DATUM NOTE:**  
 HORIZONTAL COORDINATES(E,N) SUPPLIED ARE MAPPING GRID OF AUSTRALIA(MGA), ZONE 56 BASED ON THE UNIVERSAL TRANSVERSE MERCATOR PROJECTION AND THE GEOCENTRIC DATUM OF AUSTRALIA 1994.  
 HORIZONTAL DATUM DERIVED FROM PSM 61308 E 4.98528.114 N 6931171.033.  
 LEVELS SUPPLIED ARE ON THE AUSTRALIAN HEIGHT DATUM(AHD)  
 LEVEL DATUM DERIVED FROM PSM 61308 RL54.660 (AHD)



<b>A1</b>	INDEX	DATE	REVISIONS	DRAWN	CHECKED	PASSED	INITIALS	DATE
	A	26/11/2021	AS CONSTRUCTED	NJA	DAM	CW		26/11/2021



**LOGAN CITY COUNCIL**  
 MIRVAC MIR012-02  
 AS CONSTRUCTED SURVEY - STORMWATER  
 EVERLEIGH PRECINCT 12.2  
 GREENBANK QLD

SHEET 3 OF 4 SHEETS	SCALE 1:250 A1
REVISION DATE 26/11/2021	REVISION A
DISCIPLINE CODE -	
DRAWING NO. ASC-STORMWATER-03-12.2	

PM61308 RL  
 E: 498528.114  
 N: 6931171.033  
 RL: 54.660m

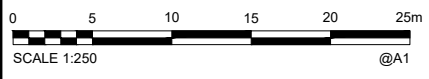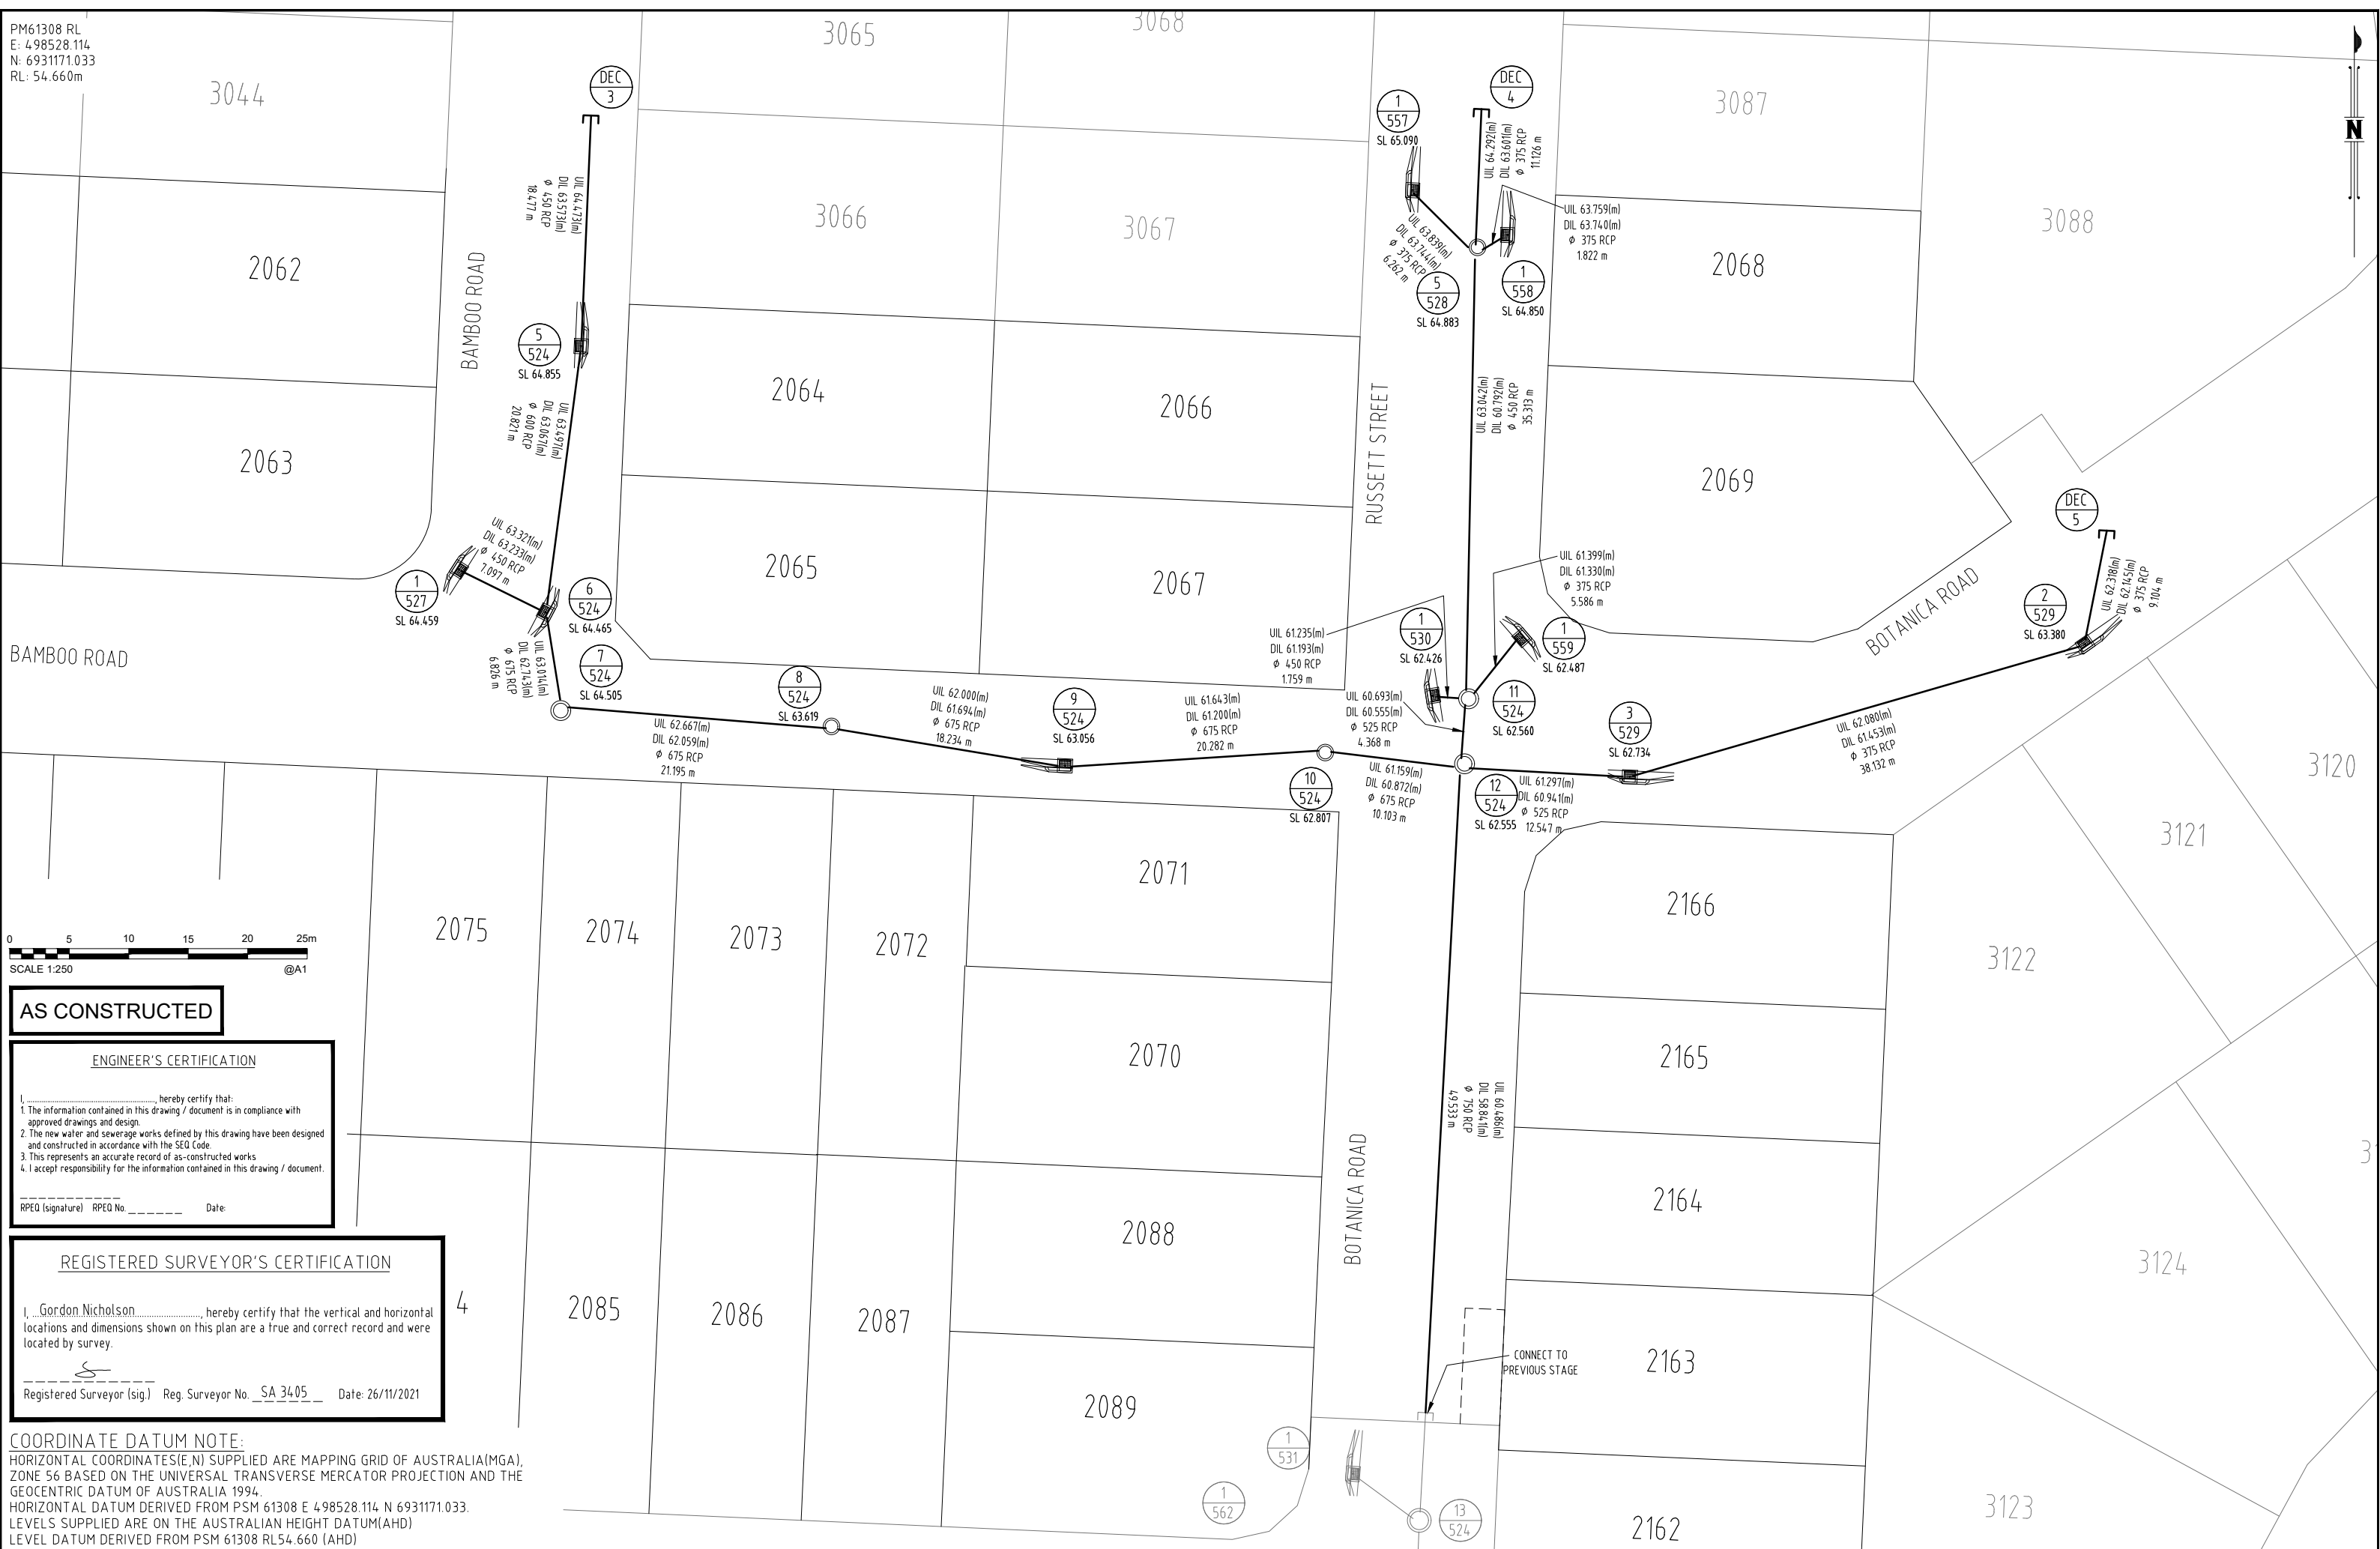

**AS CONSTRUCTED**

**ENGINEER'S CERTIFICATION**

I, \_\_\_\_\_, hereby certify that:

- The information contained in this drawing / document is in compliance with approved drawings and design.
- The new water and sewerage works defined by this drawing have been designed and constructed in accordance with the SEQ Code.
- This represents an accurate record of as-constructed works.
- I accept responsibility for the information contained in this drawing / document.

\_\_\_\_\_  
 RPEQ (signature) RPEQ No. \_\_\_\_\_ Date: \_\_\_\_\_

**REGISTERED SURVEYOR'S CERTIFICATION**

I, Gordon Nicholson, hereby certify that the vertical and horizontal locations and dimensions shown on this plan are a true and correct record and were located by survey.

S  
 Registered Surveyor (sig.) Reg. Surveyor No. SA 3405 Date: 26/11/2021

**COORDINATE DATUM NOTE:**  
 HORIZONTAL COORDINATES (E, N) SUPPLIED ARE MAPPING GRID OF AUSTRALIA (MGA), ZONE 56 BASED ON THE UNIVERSAL TRANSVERSE MERCATOR PROJECTION AND THE GEOCENTRIC DATUM OF AUSTRALIA 1994.  
 HORIZONTAL DATUM DERIVED FROM PSM 61308 E 498528.114 N 6931171.033.  
 LEVELS SUPPLIED ARE ON THE AUSTRALIAN HEIGHT DATUM (AHD)  
 LEVEL DATUM DERIVED FROM PSM 61308 RL54.660 (AHD)

A1	INDEX	DATE	REVISIONS	DRAWN	CHECKED	PASSED	INITIALS	DATE
	A	26/11/2021	AS CONSTRUCTED	NJA	DAM	CW		26/11/2021



**LOGAN CITY COUNCIL**


MIRVAC MIR012-02  
 AS CONSTRUCTED SURVEY - STORMWATER  
 EVERLEIGH PRECINCT 12.2  
 GREENBANK QLD

SHEET 4 OF 4 SHEETS	SCALE 1:250 A1
REVISION DATE 26/11/2021	REVISION A
DISCIPLINE CODE -	
DRAWING NO. ASC-STORM-04-12.2	

STRUCTURE NAME	5/502	6/502	7/502	8/502
STRUCTURE DESCRIPTION	IPWEA MANHOLE 1050mm DIA	IPWEA MANHOLE 1200mm DIA	IPWEA MANHOLE 1200mm DIA	IPWEA MANHOLE 1050mm DIA


**REGISTERED SURVEYOR'S CERTIFICATION**  
 I, Gordon Nicholson, hereby certify that the vertical and horizontal locations and dimensions shown on this plan are a true and correct record and were located by survey.  
 Registered Surveyor (sig.) Reg. Surveyor No. SA 3405 Date 26/11/2021

**AS CONSTRUCTED**

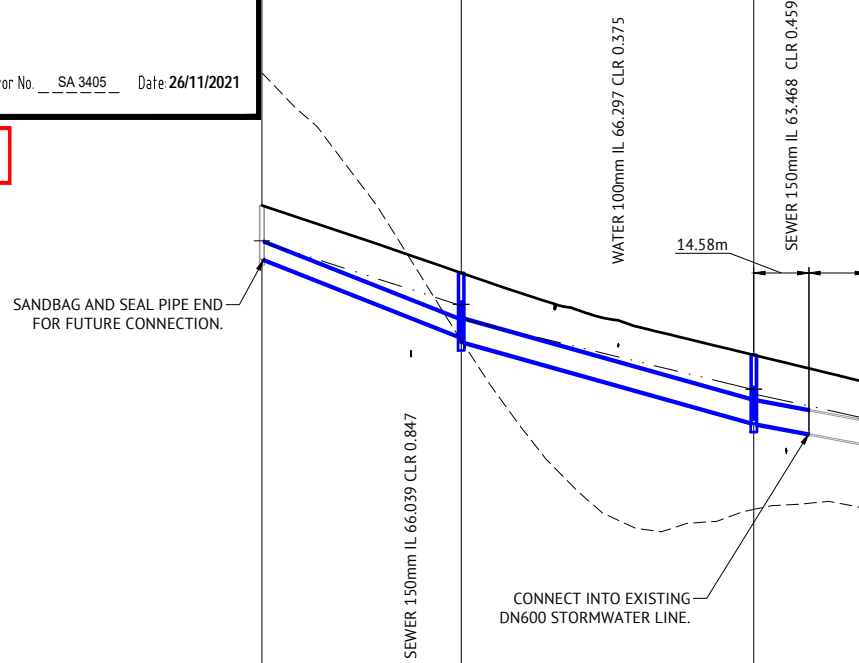


PIPE SIZE (mm)	450	600	600
PIPE CLASS	2	2	2
PIPE GRADE (%)	3.87%	2.72%	1.87%
PIPE SLOPE (1 in X)	25.9	26.2	53.4
FULL PIPE VELOCITY (m/s)	1.42	2.58	3.16
PART FULL VELOCITY (m/s)	3.33	3.92	3.16
PIPE FLOW (cumecs)	0.226	0.731	0.895
PIPE CAPACITY AT GRADE (cumecs)	0.560	1.020	0.824
DATUM RL	51.0		
WSE IN STRUCTURE	69.102	67.421	65.178
HGL IN PIPE	69.061	67.407	65.178
DEPTH OF INVERT BELOW FSL	1.427	1.678	1.792
INVERT LEVEL	66.641	66.583	64.251
FINISHED (& EXISTING) SURFACE LEVEL	70.038	68.263	66.082
CHAINAGE	0.000	52.728	130.140

5/506	6/506	7/506	8/506	6/502
IPWEA MANHOLE 1200mm DIA	IPWEA MANHOLE 1500mm DIA	IPWEA MANHOLE 1050mm DIA	IPWEA MANHOLE 1350mm DIA	IPWEA MANHOLE 1200mm DIA

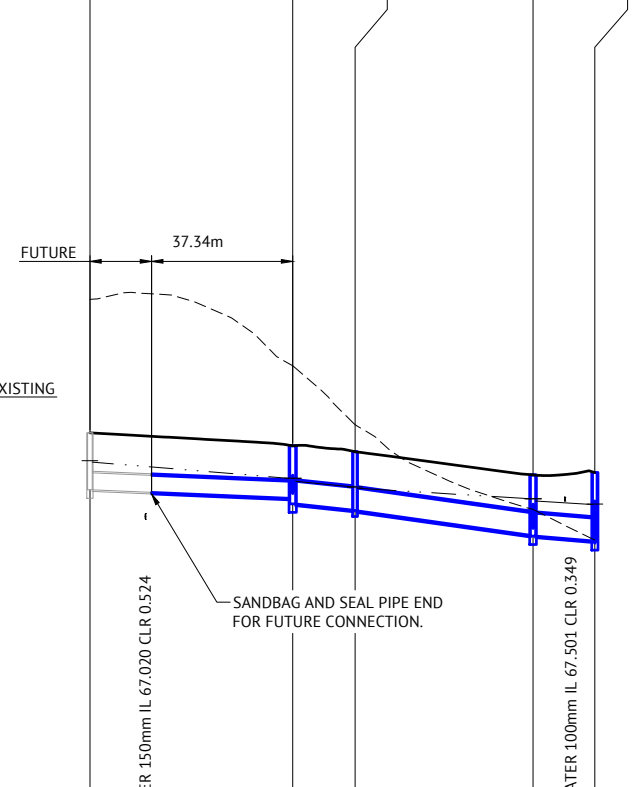


PIPE SIZE (mm)	450	600	600	600
PIPE CLASS	2	2	2	2
PIPE GRADE (%)	0.43%	1.00%	1.39%	0.88%
PIPE SLOPE (1 in X)	240.0	101.8	72.7	128.7
FULL PIPE VELOCITY (m/s)	1.60	1.16	1.16	1.66
PART FULL VELOCITY (m/s)	1.60	2.19	2.49	2.15
PIPE FLOW (cumecs)	0.254	0.329	0.327	0.469
PIPE CAPACITY AT GRADE (cumecs)	0.184	0.609	0.720	0.541
DATUM RL	53.0			
WSE IN STRUCTURE	68.558	68.100	67.874	67.558
HGL IN PIPE	68.523	68.098	67.874	67.558
DEPTH OF INVERT BELOW FSL	1.507	1.389	1.543	1.599
INVERT LEVEL	67.796	67.421	67.241	66.599
FINISHED (& EXISTING) SURFACE LEVEL	72.835	68.924	68.177	68.189
CHAINAGE	53.652	53.652	16.491	117.246

1/507	6/502
IPWEA KERB INLET L.L.I.; 2.4m Lintel	IPWEA MANHOLE 1200mm DIA

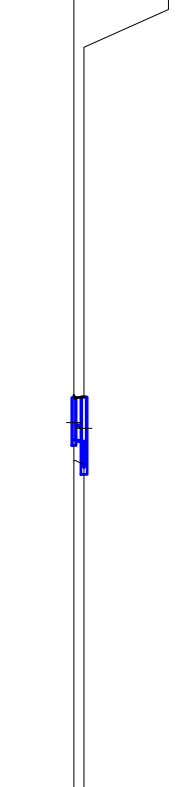


PIPE SIZE (mm)	375
PIPE CLASS	2
PIPE GRADE (%)	1.14%
PIPE SLOPE (1 in X)	100.1
FULL PIPE VELOCITY (m/s)	0.40
PART FULL VELOCITY (m/s)	1.32
PIPE FLOW (cumecs)	0.044
PIPE CAPACITY AT GRADE (cumecs)	0.175
DATUM RL	51.0
WSE IN STRUCTURE	67.574
HGL IN PIPE	67.495
DEPTH OF INVERT BELOW FSL	1.115
INVERT LEVEL	67.110
FINISHED (& EXISTING) SURFACE LEVEL	68.263
CHAINAGE	2.657

1/508	2/508	7/502
IPWEA KERB INLET (SAG) L.L.I.; 2.4m Lintel	IPWEA KERB INLET L.L.I.; 2.4m Lintel	IPWEA MANHOLE 1200mm DIA

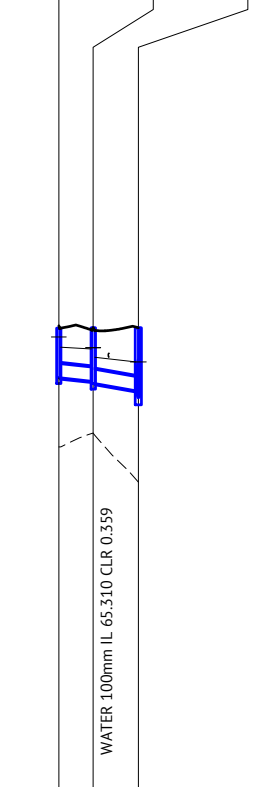


PIPE SIZE (mm)	375	375
PIPE CLASS	2	2
PIPE GRADE (%)	1.07%	1.82%
PIPE SLOPE (1 in X)	180.0	158.0
FULL PIPE VELOCITY (m/s)	1.14	1.61
PART FULL VELOCITY (m/s)	1.73	2.29
PIPE FLOW (cumecs)	0.126	0.177
PIPE CAPACITY AT GRADE (cumecs)	0.175	0.229
DATUM RL	47.0	
WSE IN STRUCTURE	65.841	65.178
HGL IN PIPE	65.570	65.178
DEPTH OF INVERT BELOW FSL	1.315	1.812
INVERT LEVEL	64.752	64.235
FINISHED (& EXISTING) SURFACE LEVEL	66.011	66.082
CHAINAGE	9.095	21.039

1/509	7/502
IPWEA KERB INLET L.L.I.; 2.4m Lintel	IPWEA MANHOLE 1200mm DIA

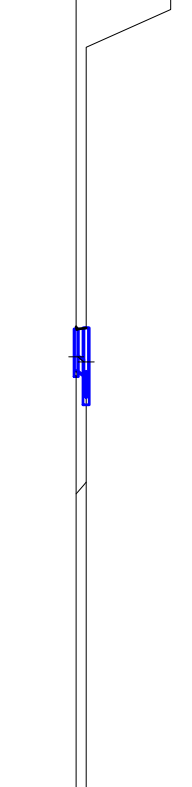


PIPE SIZE (mm)	375
PIPE CLASS	2
PIPE GRADE (%)	1.82%
PIPE SLOPE (1 in X)	25.0
FULL PIPE VELOCITY (m/s)	0.07
PART FULL VELOCITY (m/s)	1.28
PIPE FLOW (cumecs)	0.007
PIPE CAPACITY AT GRADE (cumecs)	0.351
DATUM RL	47.0
WSE IN STRUCTURE	65.315
HGL IN PIPE	65.313
DEPTH OF INVERT BELOW FSL	1.115
INVERT LEVEL	64.899
FINISHED (& EXISTING) SURFACE LEVEL	66.082
CHAINAGE	2.649

1/516	6/506
IPWEA KERB INLET L.L.I.; 2.4m Lintel	IPWEA MANHOLE 1500mm DIA

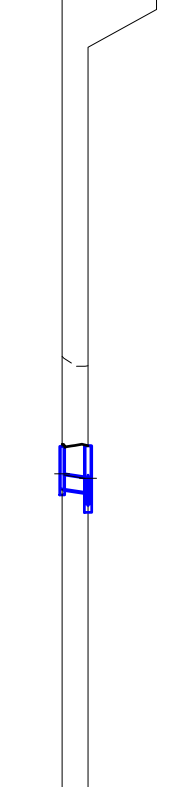

PIPE SIZE (mm)	375
PIPE CLASS	2
PIPE GRADE (%)	1.16%
PIPE SLOPE (1 in X)	63.3
FULL PIPE VELOCITY (m/s)	0.25
PART FULL VELOCITY (m/s)	1.24
PIPE FLOW (cumecs)	0.028
PIPE CAPACITY AT GRADE (cumecs)	0.192
DATUM RL	53.0
WSE IN STRUCTURE	68.220
HGL IN PIPE	68.188
DEPTH OF INVERT BELOW FSL	1.133
INVERT LEVEL	67.796
FINISHED (& EXISTING) SURFACE LEVEL	68.924
CHAINAGE	6.870

1/517	6/506
IPWEA KERB INLET L.L.I.; 2.4m Lintel	IPWEA MANHOLE 1500mm DIA

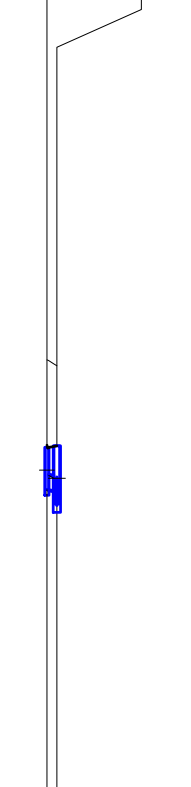

PIPE SIZE (mm)	375
PIPE CLASS	2
PIPE GRADE (%)	1.47%
PIPE SLOPE (1 in X)	100.0
FULL PIPE VELOCITY (m/s)	0.53
PART FULL VELOCITY (m/s)	1.43
PIPE FLOW (cumecs)	0.059
PIPE CAPACITY AT GRADE (cumecs)	0.175
DATUM RL	53.0
WSE IN STRUCTURE	68.318
HGL IN PIPE	68.177
DEPTH OF INVERT BELOW FSL	1.116
INVERT LEVEL	67.804
FINISHED (& EXISTING) SURFACE LEVEL	68.924
CHAINAGE	2.623

**AS CONSTRUCTED**

26/11/2021	B	AS CONSTRUCTED
20/08/2020	A	APPROVAL ISSUE
DD/MM/YYYY	1	PRELIMINARY - NOT FOR CONSTRUCTION
DATE	REV	DESCRIPTION

**Premise**  
 BRISBANE OFFICE  
 LEVEL 1, 100 BRUNSWICK STREET  
 PO BOX 361  
 FORTITUDE VALLEY, QLD 4006  
 PH: (07) 3253 2222  
 WEB: www.premise.com.au

DESIGNED  
B ADAMS  
 CHECKED  
M MAJZNER  
 PROJECT MANAGER  
R LLEWELYN  
 PROJECT DIRECTOR  
PAT BRADY RPEQ 7112

SCALE  
 HORIZONTAL 1:1000 (A1)  
 VERTICAL 1:100 (A1)  
 ORIGINAL SHEET SIZE A1

CLIENT  
**MIRVAC GROUP**  
 PROJECT  
**EVERLEIGH PRECINCT 12.2 SUBDIVISION DEVELOPMENT**  
 LOCATION  
**TEVIOT ROAD, GREENBANK**  
 SHEET TITLE  
**STORMWATER DRAINAGE LONG SECTIONS - SHEET 1**

JOB CODE  
**MIR012-02**  
 SHEET NUMBER  
**C410**  
 REV  
**AC**



STRUCTURE NAME	1/518
STRUCTURE DESCRIPTION	IPWEA KERB INLET (SAG) L.L.I.; 2.4m Lintel
	8/506
	IPWEA MANHOLE 1350mm DIA

1/519	IPWEA KERB INLET L.L.I.; 2.4m Lintel
8/506	IPWEA MANHOLE 1350mm DIA

4/524	IPWEA KERB INLET L.L.I.; 2.4m Lintel
5/524	IPWEA KERB INLET L.L.I.; 2.4m Lintel
6/524	IPWEA KERB INLET (SAG) L.L.I.; 2.4m Lintel ON 1050mm DIA MANHOLE
7/524	IPWEA MANHOLE 1200mm DIA
8/524	IPWEA MANHOLE 1050mm DIA
9/524	IPWEA KERB INLET L.L.I.; 2.4m Lintel ON 1050mm DIA MANHOLE
10/524	IPWEA MANHOLE 1050mm DIA
12/524	IPWEA MANHOLE 1500mm DIA
13/524	IPWEA MANHOLE 1500mm DIA

1/527	IPWEA KERB INLET (SAG) L.L.I.; 2.4m Lintel
6/524	IPWEA KERB INLET L.L.I.; 2.4m Lintel ON 1050mm DIA MANHOLE

4/528	IPWEA MANHOLE 1050mm DIA
5/528	IPWEA MANHOLE 1050mm DIA
11/524	IPWEA MANHOLE 1200mm DIA
12/524	IPWEA MANHOLE 1500mm DIA

1/529	IPWEA KERB INLET L.L.I.; 2.4m Lintel
2/529	IPWEA KERB INLET L.L.I.; 2.4m Lintel
3/529	IPWEA KERB INLET L.L.I.; 2.4m Lintel
12/524	IPWEA MANHOLE 1500mm DIA

**REGISTERED SURVEYOR'S CERTIFICATION**

I, Gordon Nicholson, hereby certify that the vertical and horizontal locations and dimensions shown on this plan are a true and correct record and were located by survey.

Registered Surveyor (sig.) Reg. Surveyor No. SA 3405 Date 26/11/2021

**AS CONSTRUCTED**



PIPE SIZE (mm)	525
PIPE CLASS	2
PIPE GRADE (%)	1.22%
PIPE SLOPE (1 in X)	100.0
FULL PIPE VELOCITY (m/s)	0.35
PART FULL VELOCITY (m/s)	1.50
PIPE FLOW (cumecs)	0.076
PIPE CAPACITY AT GRADE (cumecs)	0.430
DATUM RL	51.0

PIPE SIZE (mm)	525
PIPE CLASS	2
PIPE GRADE (%)	1.75%
PIPE SLOPE (1 in X)	100.0
FULL PIPE VELOCITY (m/s)	0.38
PART FULL VELOCITY (m/s)	1.53
PIPE FLOW (cumecs)	0.082
PIPE CAPACITY AT GRADE (cumecs)	0.430
DATUM RL	51.0

450	600	675	675	675	675	675	750
2	2	2	2	2	2	2	2
1.88%	1.75%	2.06%	3.97%	2.86%	1.67%	2.18%	3.32%
20.1	56.8	56.1	27.7	34.5	58.0	45.5	29.9
1.42	0.94	1.10	1.10	1.10	1.29	1.29	1.96
3.64	2.69	3.91	3.41	3.41	3.23	3.61	4.42
0.227	0.265	0.394	0.394	0.392	0.463	0.461	0.856
0.630	0.868	1.728	1.432	1.104	1.247	1.457	2.056
46.0							
66.151							
67.620	64.095	63.752	63.710	63.467	62.708	62.428	58.982
67.651	64.095	63.752	63.710	63.467	62.708	62.428	61.517
67.558	64.095	63.752	63.710	63.467	62.708	62.428	61.517
67.502	64.095	63.752	63.710	63.467	62.708	62.428	61.517
1.274	1.358	1.421	1.475	1.811	1.565	1.695	1.800
66.880	63.573	63.497	63.014	62.743	62.000	61.694	58.470
66.862	63.558	63.482	63.000	62.728	62.000	61.680	58.470
66.808	63.495	63.419	62.936	62.714	62.000	61.666	58.470
66.819	63.480	63.404	62.921	62.700	62.000	61.652	58.470
66.819	63.465	63.389	62.906	62.685	62.000	61.637	58.470
66.819	63.450	63.374	62.891	62.670	62.000	61.622	58.470
66.819	63.435	63.359	62.876	62.655	62.000	61.607	58.470
66.819	63.420	63.344	62.861	62.640	62.000	61.592	58.470
66.819	63.405	63.329	62.846	62.625	62.000	61.577	58.470
66.819	63.390	63.314	62.831	62.610	62.000	61.562	58.470
66.819	63.375	63.299	62.816	62.595	62.000	61.547	58.470
66.819	63.360	63.284	62.801	62.580	62.000	61.532	58.470
66.819	63.345	63.269	62.786	62.565	62.000	61.517	58.470
66.819	63.330	63.254	62.771	62.550	62.000	61.502	58.470
66.819	63.315	63.239	62.756	62.535	62.000	61.487	58.470
66.819	63.300	63.224	62.741	62.520	62.000	61.472	58.470
66.819	63.285	63.209	62.726	62.505	62.000	61.457	58.470
66.819	63.270	63.194	62.711	62.490	62.000	61.442	58.470
66.819	63.255	63.179	62.696	62.475	62.000	61.427	58.470
66.819	63.240	63.164	62.681	62.460	62.000	61.412	58.470
66.819	63.225	63.149	62.666	62.445	62.000	61.397	58.470
66.819	63.210	63.134	62.651	62.430	62.000	61.382	58.470
66.819	63.195	63.119	62.636	62.415	62.000	61.367	58.470
66.819	63.180	63.104	62.621	62.400	62.000	61.352	58.470
66.819	63.165	63.089	62.606	62.385	62.000	61.337	58.470
66.819	63.150	63.074	62.591	62.370	62.000	61.322	58.470
66.819	63.135	63.059	62.576	62.355	62.000	61.307	58.470
66.819	63.120	63.044	62.561	62.340	62.000	61.292	58.470
66.819	63.105	63.029	62.546	62.325	62.000	61.277	58.470
66.819	63.090	63.014	62.531	62.310	62.000	61.262	58.470
66.819	63.075	63.000	62.516	62.295	62.000	61.247	58.470
66.819	63.060	62.985	62.501	62.280	62.000	61.232	58.470
66.819	63.045	62.970	62.486	62.265	62.000	61.217	58.470
66.819	62.250	62.175	61.691	61.470	62.000	60.422	58.470
66.819	62.235	62.160	61.676	61.455			

STRUCTURE NAME	1/530	11/524
STRUCTURE DESCRIPTION	IPWEA KERB INLET L.L.I.; 2.4m Limetel	IPWEA MANHOLE 1200mm DIA

1/557	5/528
IPWEA KERB INLET L.L.I.; 2.4m Limetel	IPWEA MANHOLE 1050mm DIA

1/558	5/528
IPWEA KERB INLET L.L.I.; 2.4m Limetel	IPWEA MANHOLE 1050mm DIA

1/559	11/524
IPWEA KERB INLET (SAG) L.L.I.; 2.4m Limetel	IPWEA MANHOLE 1200mm DIA

**REGISTERED SURVEYOR'S CERTIFICATION**

I, Gordon Nicholson, hereby certify that the vertical and horizontal locations and dimensions shown on this plan are a true and correct record and were located by survey.

Registered Surveyor (sig.) Reg. Surveyor No. SA 3405 Date: 26/11/2021

**AS CONSTRUCTED**

PIPE SIZE (mm)	450	375	375	375
PIPE CLASS	2	2	2	2
PIPE GRADE (%)	2.38% <del>3.00%</del>	1.51% <del>1.09%</del>	1.04% <del>1.01%</del>	1.23% <del>1.01%</del>
PIPE SLOPE (1 in X)	77.7 <del>41.8</del>	65.9 <del>41.8</del>	99.2 <del>41.8</del>	99.4 <del>41.8</del>
FULL PIPE VELOCITY (m/s)	0.28	0.41	0.40	0.41
PART FULL VELOCITY (m/s)	1.92	1.46	1.32	1.33
PIPE FLOW (cumecs)	0.044	0.045	0.044	0.045
PIPE CAPACITY AT GRADE (cumecs)	0.494	0.199	0.175	0.175
DATUM RL	46.0	50.0	49.0	46.0
WSE IN STRUCTURE	61.756	64.318	64.220	61.846
HGL IN PIPE	61.718	64.236	64.141	61.763
DEPTH OF INVERT BELOW FSL	1.197	1.316	1.150	1.113
INVERT LEVEL	<del>64.366</del> 61.235	<del>63.864</del> 63.839	<del>63.766</del> 63.759	<del>64.360</del> 61.399
FINISHED (& EXISTING) SURFACE LEVEL	64.426 <del>64.466</del> (64.141)	65.090 <del>64.977</del> (69.527)	64.850 <del>64.946</del> (69.138)	62.487 <del>64.735</del> (64.735)
CHAINAGE	0.000 2.868 2.868	0.000 7.481 7.481	0.000 2.976 2.976	0.000 6.688 6.688
LINE	530	557	558	559

**AS CONSTRUCTED**

26/11/2021	B	AS CONSTRUCTED		
20/08/2020	A	APPROVAL ISSUE	MM	PB
DD/MM/YYYY	1	PRELIMINARY - NOT FOR CONSTRUCTION	REC	APP
DATE	REV	DESCRIPTION	REC	APP

**Premise**

BRISBANE OFFICE  
LEVEL 1, 100 BRUNSWICK STREET  
PO BOX 361  
FORTITUDE VALLEY, QLD 4006  
PH: (07) 3253 2222  
WEB: www.premise.com.au

DESIGNED  
B ADAMS

CHECKED  
M MAJZNER

PROJECT MANAGER  
R LLEWELYN

PROJECT DIRECTOR  
PAT BRADY RPEQ 7112

SCALE

HORIZONTAL 1:1000 (A1)

VERTICAL 1:100 (A1)

ORIGINAL SHEET SIZE A1

CLIENT  
**MIRVAC GROUP**

PROJECT  
**EVERLEIGH PRECINCT 12.2 SUBDIVISION DEVELOPMENT**

LOCATION  
**TEVIOT ROAD, GREENBANK**

SHEET TITLE  
**STORMWATER DRAINAGE LONG SECTIONS - SHEET 3**

JOB CODE  
**MIR012-02**

SHEET NUMBER  
**C412**

REV  
**AC**