




COORDINATE DATUM NOTE:
 HORIZONTAL COORDINATES(E,N) SUPPLIED ARE MAPPING GRID OF AUSTRALIA(MGA), ZONE 56 BASED ON THE UNIVERSAL TRANSVERSE MERCATOR PROJECTION AND THE GEOCENTRIC DATUM OF AUSTRALIA 1994.
 HORIZONTAL DATUM DERIVED FROM PSM 61308 E 4.98528.114 N 6931171.033.
 LEVELS SUPPLIED ARE ON THE AUSTRALIAN HEIGHT DATUM(AHD)
 LEVEL DATUM DERIVED FROM PSM 61308 RL54.660 (AHD)

REGISTERED SURVEYOR'S CERTIFICATION
 I, Gordon Nicholson, hereby certify that the vertical and horizontal locations and dimensions shown on this plan are a true and correct record and were located by survey.
 Registered Surveyor (sig.) [Signature] Reg. Surveyor No. SA 3405 Date: 05/11/2021

ENGINEER'S CERTIFICATION
 I, _____, hereby certify that:
 1. The information contained in this drawing / document is in compliance with approved drawings and design.
 2. The new water and sewerage works defined by this drawing have been designed and constructed in accordance with the SEQ Code.
 3. This represents an accurate record of as-constructed works
 4. I accept responsibility for the information contained in this drawing / document.
 RPEQ (signature) _____ RPEQ No. _____ Date: _____

- WATER REDUCER
- WATER METER BOX
- WATER BEND
- WATER TAPING BAND
- WATER BALL VALVE/STOP VALVE
- WATER FIRE HYDRANT
- WATERMAIN LINE (SIZE AND CLASS AS SHOWN)
- WATERMAIN CONDUIT

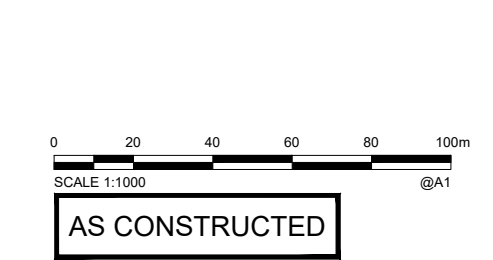


A1	INDEX	DATE	REVISIONS	DRAWN	CHECKED	PASSED
	A	05/11/2021	AS CONSTRUCTED	NJA	DAM	CW

DRAWN	NJA	05/11/2021
CHECKED	DAM	05/11/2021
PASSED	CW	05/11/2021
INITIALS		DATE



LOGAN CITY COUNCIL
 MIRVAC MIR012-02
 AS CONSTRUCTED SURVEY - WATERMAIN
 EVERLEIGH PRECINCT 12.2
 GREENBANK QLD

SHEET 1 OF 5 SHEETS	SCALE 1:250 A1
REVISION DATE 05/11/2021	REVISION A
DISCIPLINE CODE -	
DRAWING NO. ASC-WATER-01-12.2	

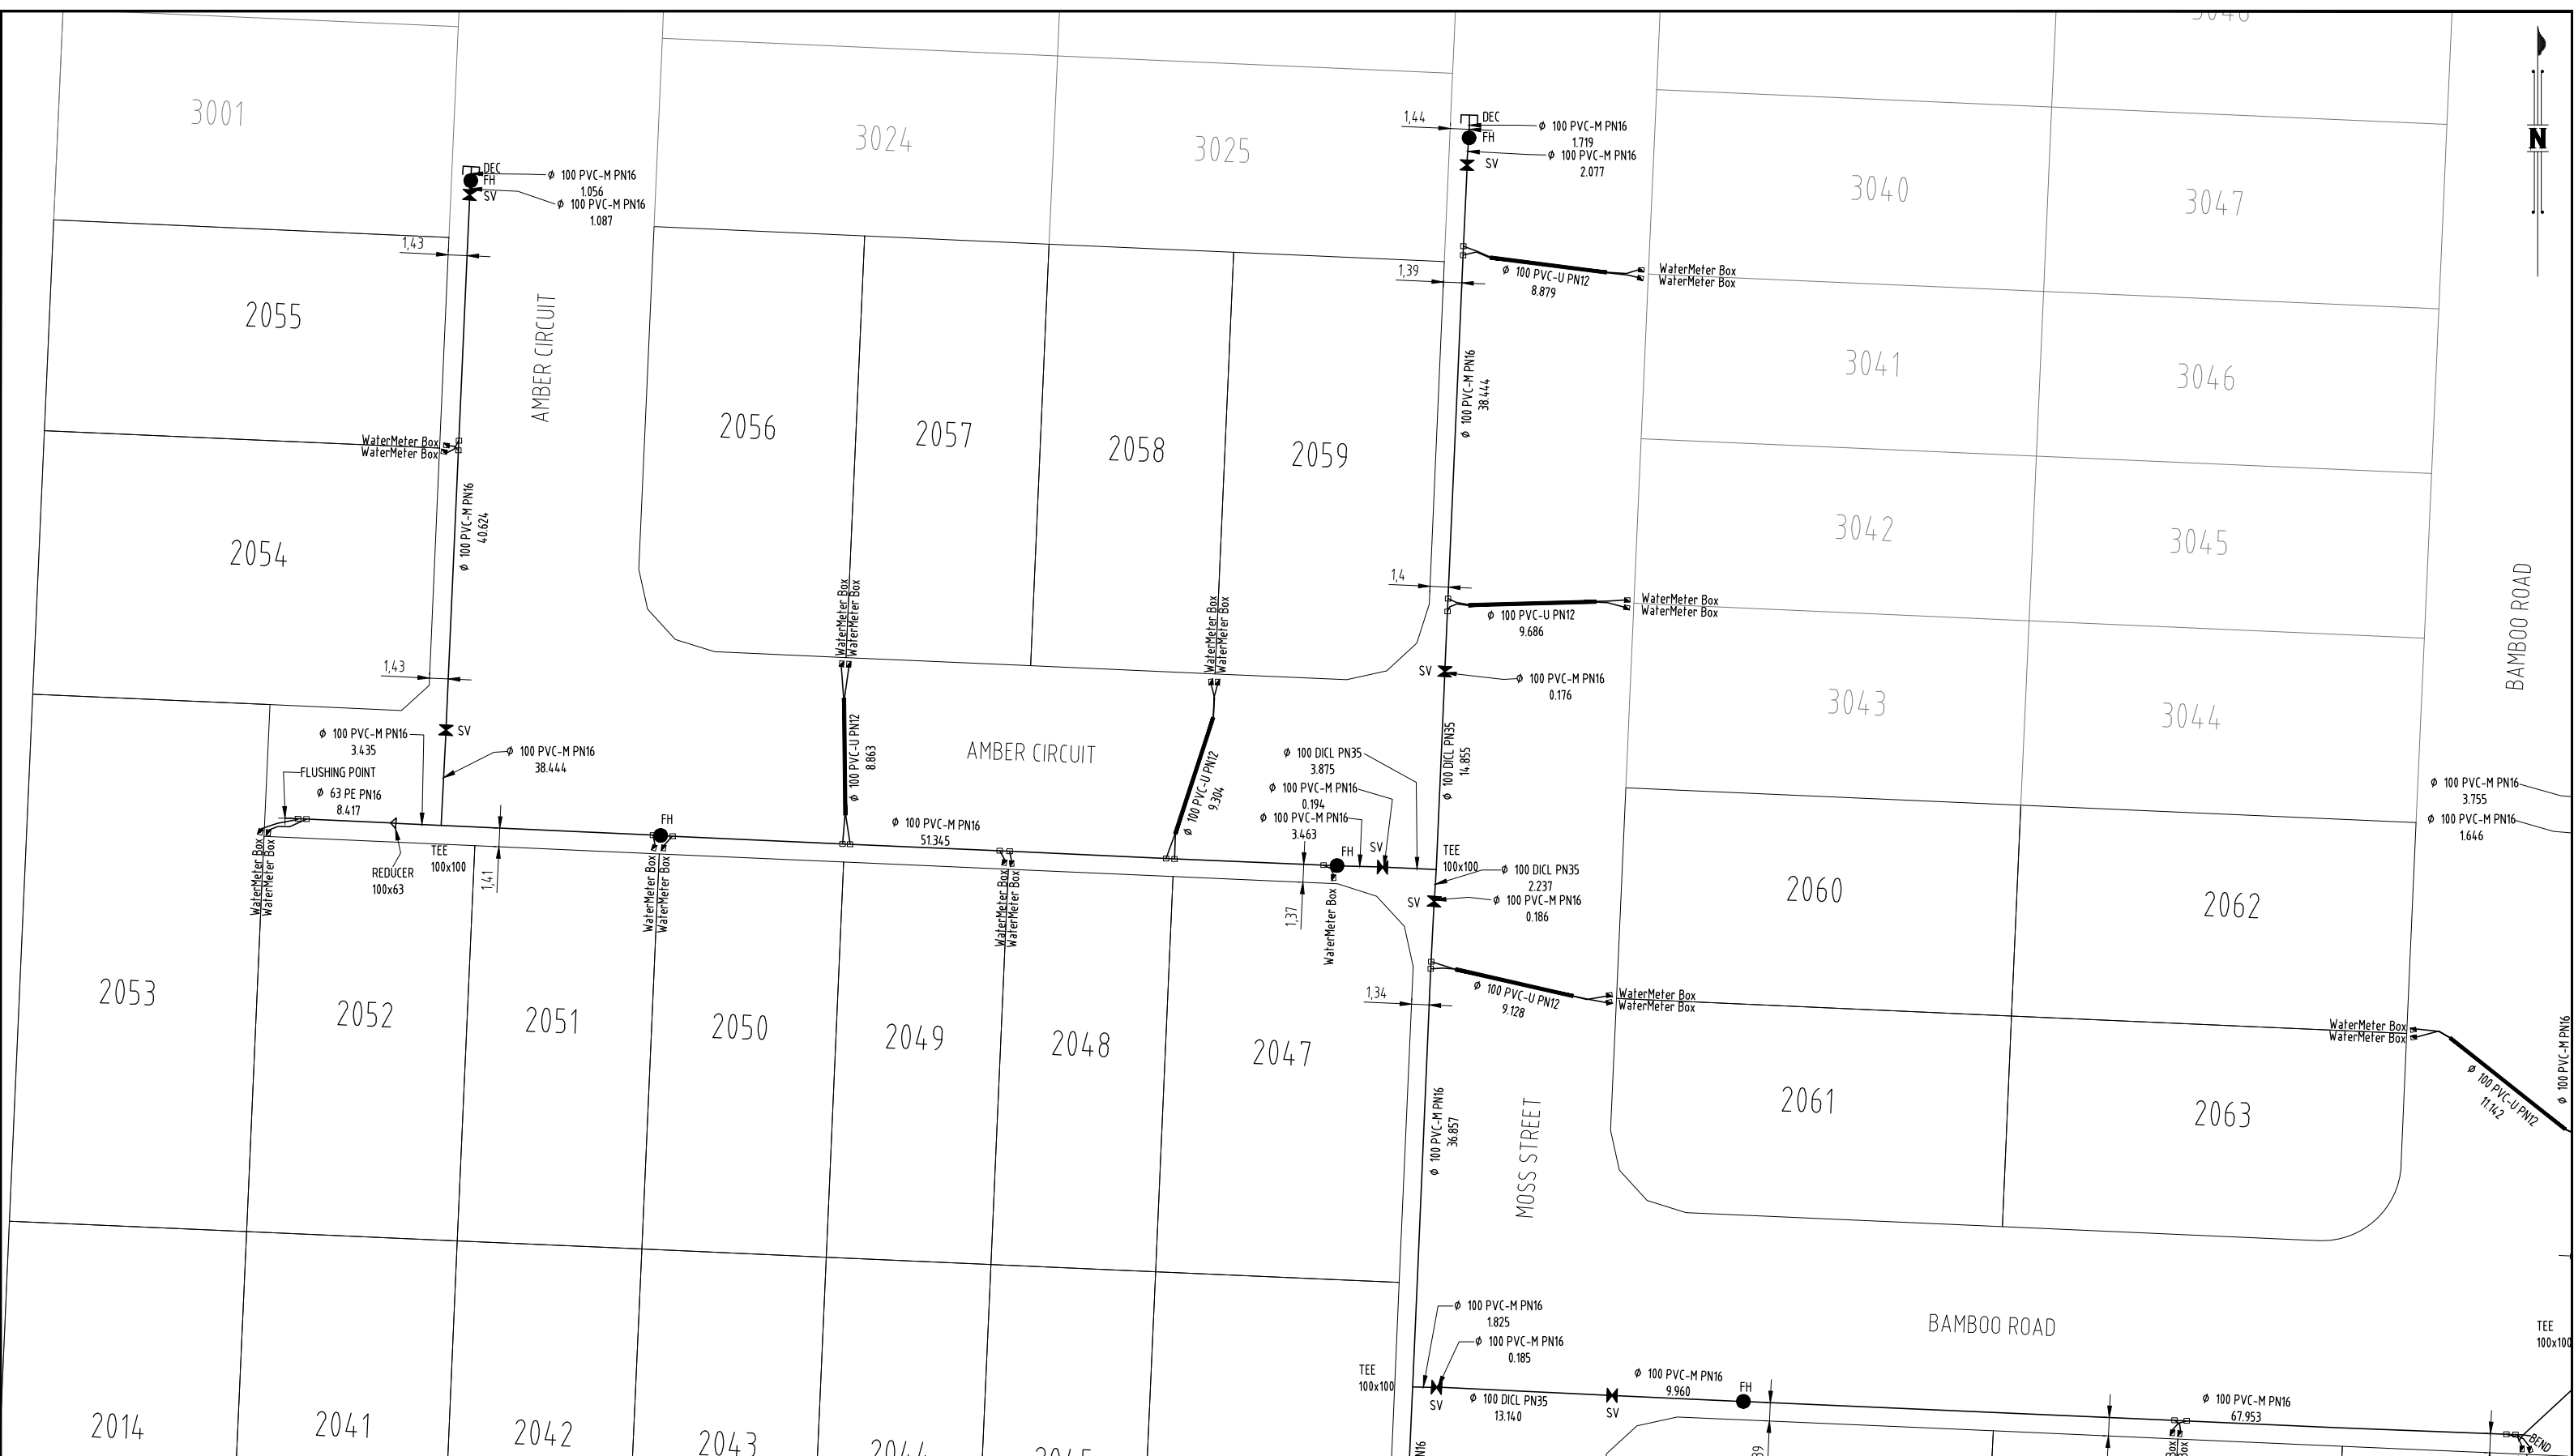


PM61308 RL
 E: 4.98528.114
 N: 6931171.033
 RL: 54.660m

COORDINATE DATUM NOTE:
 HORIZONTAL COORDINATES(E,N) SUPPLIED ARE MAPPING GRID OF AUSTRALIA(MGA), ZONE 56 BASED ON THE UNIVERSAL TRANSVERSE MERCATOR PROJECTION AND THE GEOCENTRIC DATUM OF AUSTRALIA 1994.
 HORIZONTAL DATUM DERIVED FROM PSM 61308 E 4.98528.114 N 6931171.033.
 LEVELS SUPPLIED ARE ON THE AUSTRALIAN HEIGHT DATUM(AHD)
 LEVEL DATUM DERIVED FROM PSM 61308 RL54.660 (AHD)

REGISTERED SURVEYOR'S CERTIFICATION
 I, Gordon Nicholson, hereby certify that the vertical and horizontal locations and dimensions shown on this plan are a true and correct record and were located by survey.
 Registered Surveyor (sig.) [Signature] Reg. Surveyor No. SA 3405 Date: 05/11/2021

ENGINEER'S CERTIFICATION
 I, _____, hereby certify that:
 1. The information contained in this drawing / document is in compliance with approved drawings and design.
 2. The new water and sewerage works defined by this drawing have been designed and constructed in accordance with the SEQ Code.
 3. This represents an accurate record of as-constructed works.
 4. I accept responsibility for the information contained in this drawing / document.
 RPEQ (signature) _____ RPEQ No. _____ Date: _____

- ▾ WATER REDUCER
- ▣ WATER METER BOX
- > WATER BEND
- WATER TAPING BAND
- ⊗ BV/SV WATER BALL VALVE/STOP VALVE
- WATER FIRE HYDRANT
- WATERMAIN LINE (SIZE AND CLASS AS SHOWN)
- WATERMAIN CONDUIT

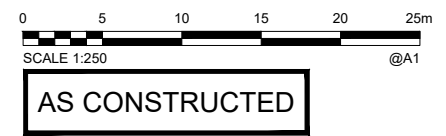


A1	INDEX	DATE	REVISIONS	DRAWN	CHECKED	PASSED	INITIALS	DATE
	A	05/11/2021	AS CONSTRUCTED	NJA	DAM	CW		



LOGAN CITY COUNCIL
 MIRVAC MIR012-02
 AS CONSTRUCTED SURVEY - WATERMAIN
 EVERLEIGH PRECINCT 12.2
 GREENBANK QLD

SHEET 2 OF 5 SHEETS	SCALE 1:250 A1
REVISION DATE 05/11/2021	REVISION A
DISCIPLINE CODE -	
DRAWING NO. ASC-WATER-02-12.2	

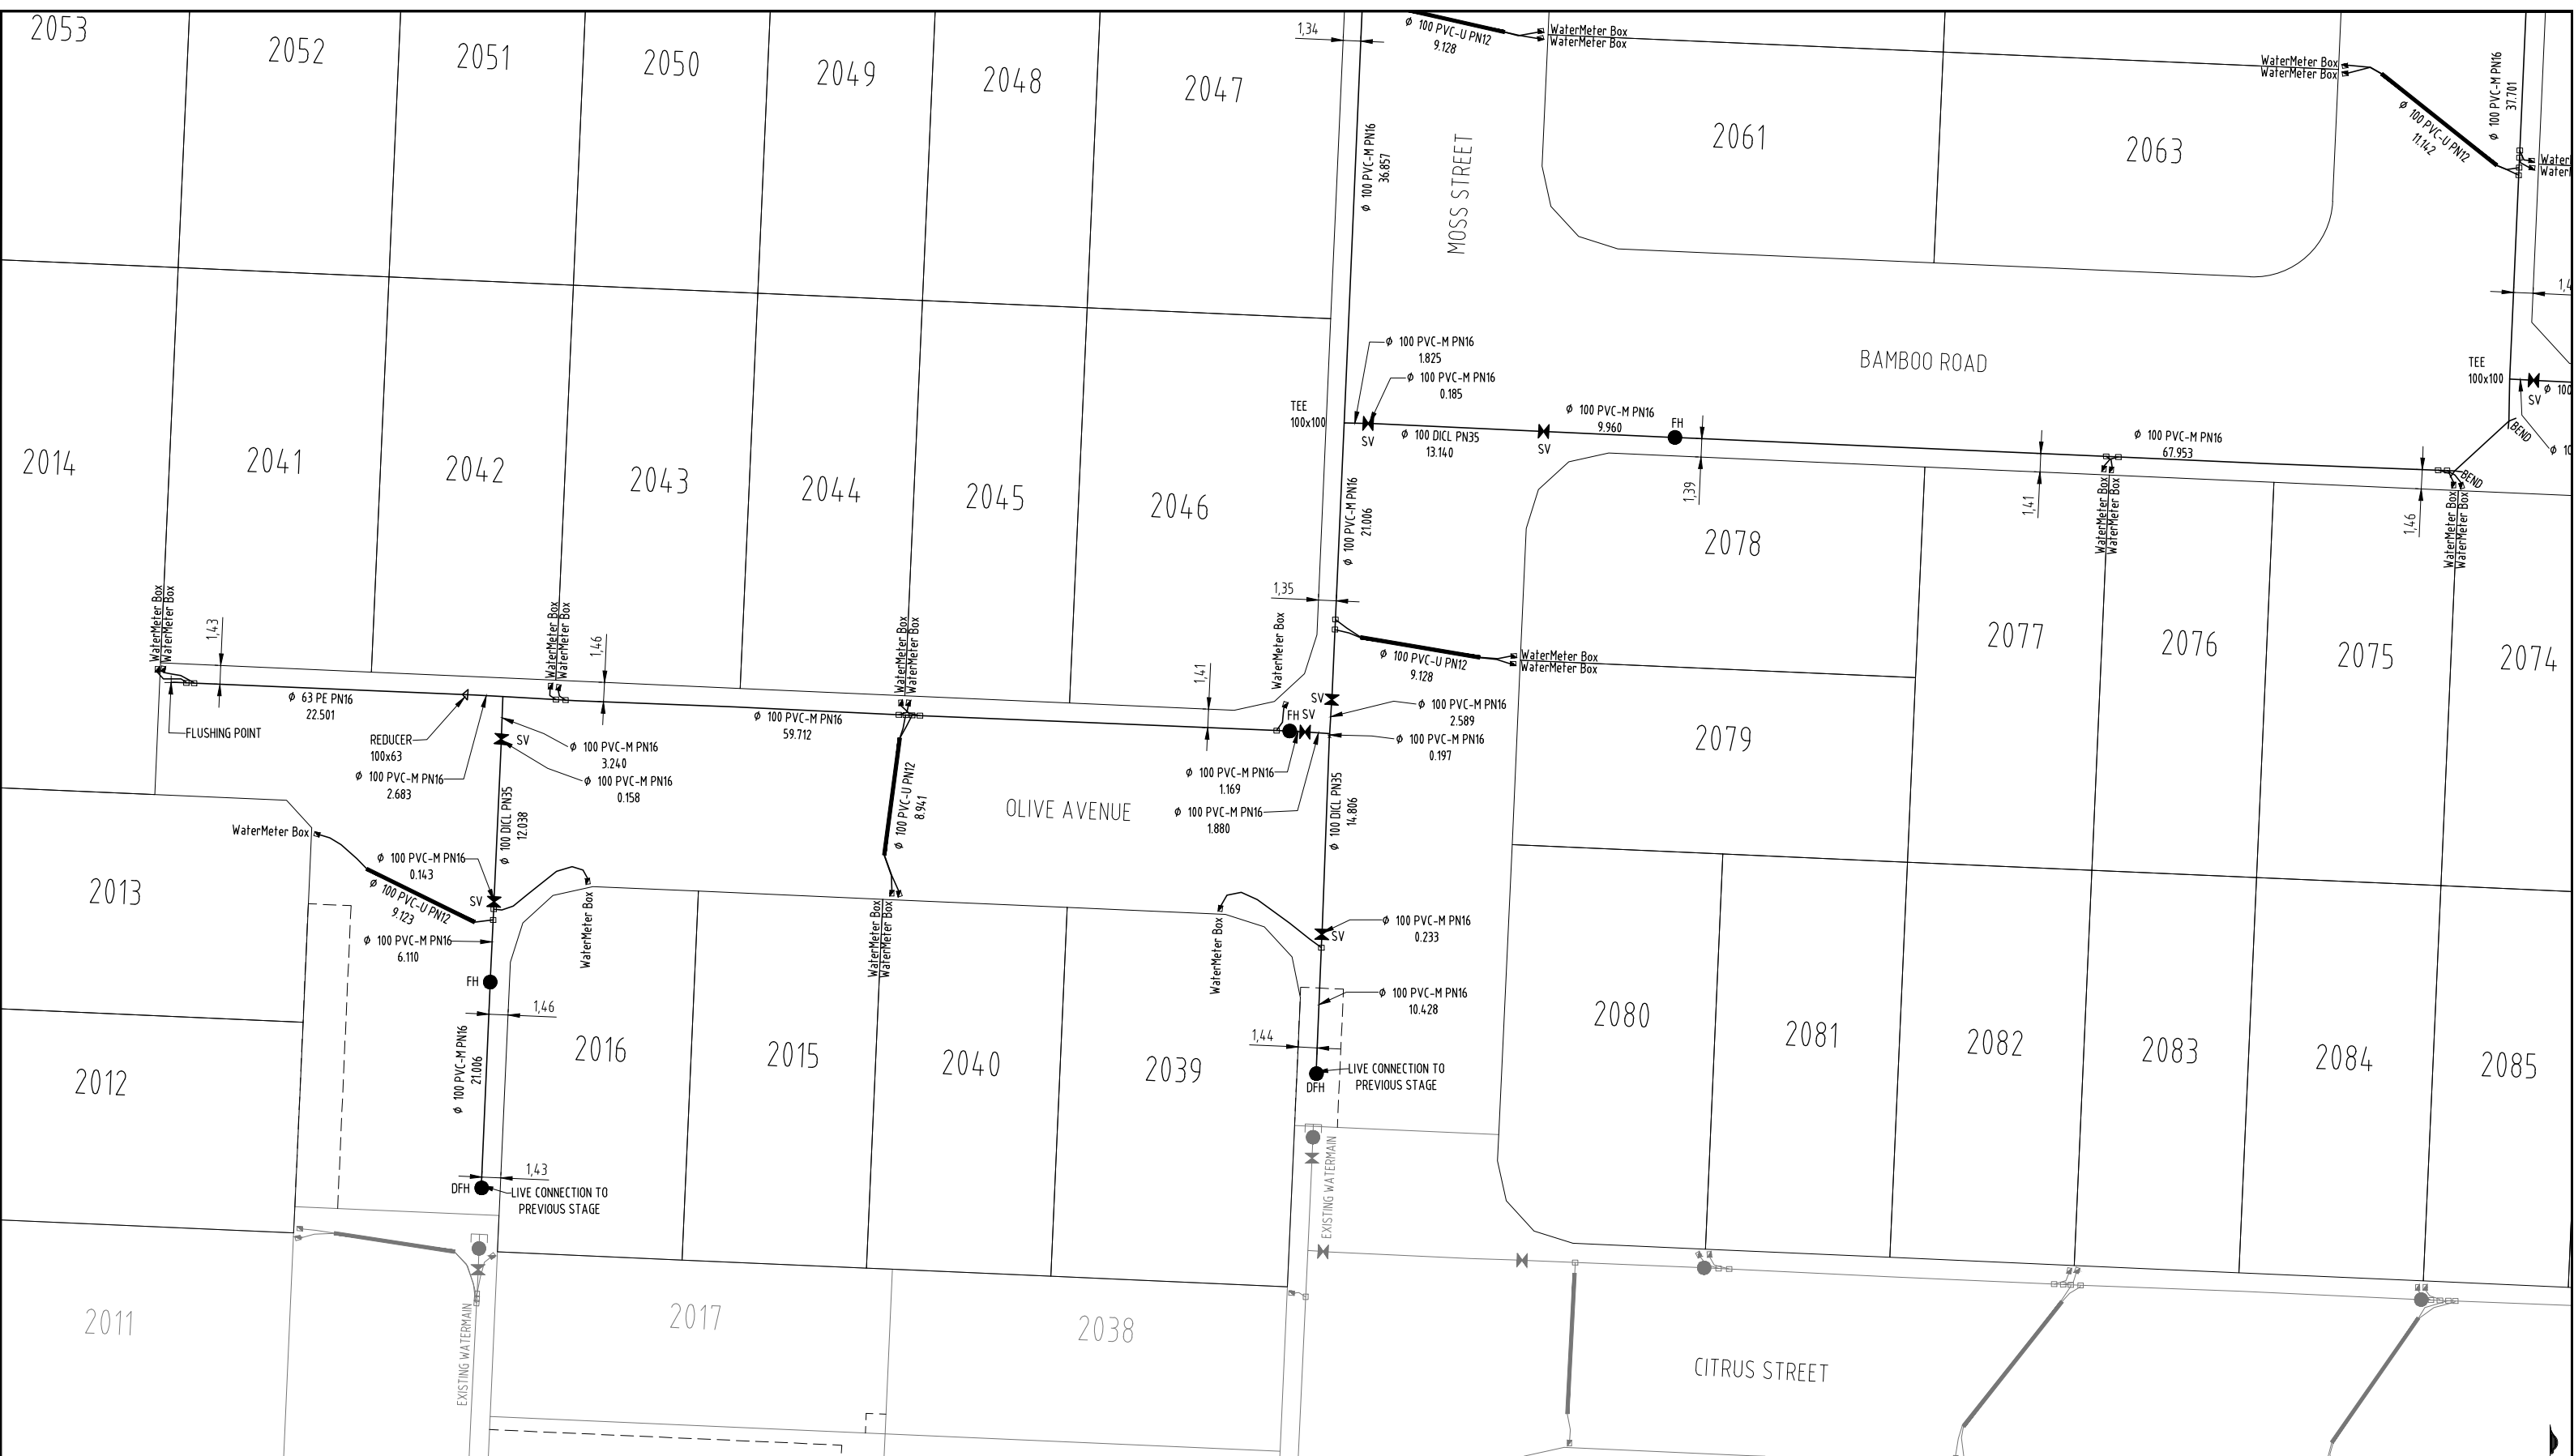

PM61308 RL
 E: 4.98528.114
 N: 6931171.033
 RL: 54.660m

COORDINATE DATUM NOTE:
 HORIZONTAL COORDINATES(E,N) SUPPLIED ARE MAPPING GRID OF AUSTRALIA(MGA), ZONE 56 BASED ON THE UNIVERSAL TRANSVERSE MERCATOR PROJECTION AND THE GEOCENTRIC DATUM OF AUSTRALIA 1994.
 HORIZONTAL DATUM DERIVED FROM PSM 61308 E 4.98528.114 N 6931171.033.
 LEVELS SUPPLIED ARE ON THE AUSTRALIAN HEIGHT DATUM(AHD)
 LEVEL DATUM DERIVED FROM PSM 61308 RL54.660 (AHD)

REGISTERED SURVEYOR'S CERTIFICATION
 I, Gordon Nicholson, hereby certify that the vertical and horizontal locations and dimensions shown on this plan are a true and correct record and were located by survey.
 Registered Surveyor (sig.) [Signature] Reg. Surveyor No. SA 3405 Date: 05/11/2021

ENGINEER'S CERTIFICATION
 I, _____, hereby certify that:
 1. The information contained in this drawing / document is in compliance with approved drawings and design.
 2. The new water and sewerage works defined by this drawing have been designed and constructed in accordance with the SEQ Code.
 3. This represents an accurate record of as-constructed works.
 4. I accept responsibility for the information contained in this drawing / document.
 RPEQ (signature) _____ RPEQ No. _____ Date: _____

- ▷ WATER REDUCER
- ◻ WATER METER BOX
- > WATER BEND
- ◻ WATER TAPING BAND
- ◻ BV/SV WATER BALL VALVE/STOP VALVE
- WATER FIRE HYDRANT
- WATERMAIN LINE (SIZE AND CLASS AS SHOWN)
- WATERMAIN CONDUIT



AS CONSTRUCTED

A1	INDEX	DATE	REVISIONS	DRAWN	CHECKED	PASSED
	A	05/11/2021	AS CONSTRUCTED	NJA	DAM	CW

shadforth
 50 Shadforth Lane, Forest Glen QLD 4086
 07 5438 2000 • 07 5438 2008 • shadforth@shadforth.com.au

LOGAN CITY COUNCIL

LOGAN CITY COUNCIL
 MIRVAC MIR012-02
 AS CONSTRUCTED SURVEY - WATERMAIN
 EVERLEIGH PRECINCT 12.2
 GREENBANK QLD

SHEET 3 OF 5 SHEETS	SCALE 1:250 A1
REVISION DATE 05/11/2021	REVISION A
DISCIPLINE CODE -	
DRAWING NO. ASC-WATER-03-12.2	




PM61308 RL
E: 4.98528.114
N: 6931171.033
RL: 54.660m

COORDINATE DATUM NOTE:
HORIZONTAL COORDINATES(E,N) SUPPLIED ARE MAPPING GRID OF AUSTRALIA(MGA), ZONE 56 BASED ON THE UNIVERSAL TRANSVERSE MERCATOR PROJECTION AND THE GEOCENTRIC DATUM OF AUSTRALIA 1994.
HORIZONTAL DATUM DERIVED FROM PSM 61308 E 4.98528.114 N 6931171.033.
LEVELS SUPPLIED ARE ON THE AUSTRALIAN HEIGHT DATUM(AHD)
LEVEL DATUM DERIVED FROM PSM 61308 RL54.660 (AHD)

REGISTERED SURVEYOR'S CERTIFICATION
I, Gordon Nicholson, hereby certify that the vertical and horizontal locations and dimensions shown on this plan are a true and correct record and were located by survey.
Registered Surveyor (sig.) [Signature] Reg. Surveyor No. SA 3405 Date: 05/11/2021

ENGINEER'S CERTIFICATION
I, _____, hereby certify that:
1. The information contained in this drawing / document is in compliance with approved drawings and design.
2. The new water and sewerage works defined by this drawing have been designed and constructed in accordance with the SEQ Code.
3. This represents an accurate record of as-constructed works.
4. I accept responsibility for the information contained in this drawing / document.
RPEQ (signature) _____ RPEQ No. _____ Date: _____

- ▶ WATER REDUCER
- WATER METER BOX
- > WATER BEND
- WATER TAPING BAND
- BV/SV WATER BALL VALVE/STOP VALVE
- WATER FIRE HYDRANT
- WATERMAIN LINE (SIZE AND CLASS AS SHOWN)
- WATERMAIN CONDUIT

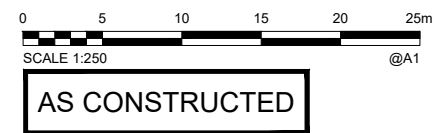

A1

INDEX	DATE	REVISIONS	DRAWN	CHECKED	PASSED	INITIALS	DATE
A	05/11/2021	AS CONSTRUCTED	NJA	DAM	CW		05/11/2021



LOGAN CITY COUNCIL
MIRVAC MIR012-02
AS CONSTRUCTED SURVEY - WATERMAIN
EVERLEIGH PRECINCT 12.2
GREENBANK QLD

SHEET 4 OF 5 SHEETS	SCALE 1:250 A1
REVISION DATE 05/11/2021	REVISION A
DISCIPLINE CODE -	
DRAWING NO. ASC-WATER-04-12.2	




PM61308 RL
 E: 4.98528.114
 N: 6931171.033
 RL: 54.660m

COORDINATE DATUM NOTE:
 HORIZONTAL COORDINATES(E,N) SUPPLIED ARE MAPPING GRID OF AUSTRALIA(MGA), ZONE 56 BASED ON THE UNIVERSAL TRANSVERSE MERCATOR PROJECTION AND THE GEOCENTRIC DATUM OF AUSTRALIA 1994.
 HORIZONTAL DATUM DERIVED FROM PSM 61308 E 4.98528.114 N 6931171.033.
 LEVELS SUPPLIED ARE ON THE AUSTRALIAN HEIGHT DATUM(AHD)
 LEVEL DATUM DERIVED FROM PSM 61308 RL54.660 (AHD)

REGISTERED SURVEYOR'S CERTIFICATION
 I, Gordon Nicholson, hereby certify that the vertical and horizontal locations and dimensions shown on this plan are a true and correct record and were located by survey.
 Registered Surveyor (sig.) [Signature] Reg. Surveyor No. SA 3405 Date: 05/11/2021

ENGINEER'S CERTIFICATION
 I, _____, hereby certify that:
 1. The information contained in this drawing / document is in compliance with approved drawings and design.
 2. The new water and sewerage works defined by this drawing have been designed and constructed in accordance with the SEQ Code.
 3. This represents an accurate record of as-constructed works.
 4. I accept responsibility for the information contained in this drawing / document.
 RPEQ (signature) _____ RPEQ No. _____ Date: _____

- ▷ WATER REDUCER
- ◻ WATER METER BOX
- ◊ WATER BEND
- ◊ WATER TAPING BAND
- ◻ BV/SV WATER BALL VALVE/STOP VALVE
- WATER FIRE HYDRANT
- WATERMAIN LINE (SIZE AND CLASS AS SHOWN)
- WATERMAIN CONDUIT

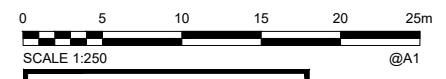

AS CONSTRUCTED

A1	INDEX	DATE	AS CONSTRUCTED	REVISIONS	DRAWN	CHECKED	PASSED	INITIALS	DATE
	A	05/11/2021	AS CONSTRUCTED		NJA	DAM	CW		
					DRAWN	CHECKED	PASSED		
					NJA	DAM	CW		



LOGAN CITY COUNCIL
 MIRVAC MIR012-02
 AS CONSTRUCTED SURVEY - WATERMAIN
 EVERLEIGH PRECINCT 12.2
 GREENBANK QLD

SHEET 5 OF 5 SHEETS	SCALE 1:250 A1
REVISION DATE 05/11/2021	REVISION A
DISCIPLINE CODE -	
DRAWING NO. ASC-WATER-05-12.2	