




PM61308 RL  
 E: 498528.114  
 N: 6931171.033  
 RL: 54.660m



**COORDINATE DATUM NOTE:**  
 HORIZONTAL COORDINATES(E,N) SUPPLIED ARE MAPPING GRID OF AUSTRALIA(MGA), ZONE 56 BASED ON THE UNIVERSAL TRANSVERSE MERCATOR PROJECTION AND THE GEOCENTRIC DATUM OF AUSTRALIA 1994.  
 HORIZONTAL DATUM DERIVED FROM PSM 61308 E 498528.114 N 6931171.033.  
 LEVELS SUPPLIED ARE ON THE AUSTRALIAN HEIGHT DATUM(AHD)  
 LEVEL DATUM DERIVED FROM PSM 61308 RL54.660 (AHD)

**REGISTERED SURVEYOR'S CERTIFICATION**  
 I, Gordon Nicholson, hereby certify that the vertical and horizontal locations and dimensions shown on this plan are a true and correct record and were located by survey.  
 Registered Surveyor (sig.) [Signature] Reg. Surveyor No. SA 3405 Date: 13/05/2022

**ENGINEER'S CERTIFICATION**  
 I, \_\_\_\_\_, hereby certify that:  
 1. The information contained in this drawing / document is in compliance with approved drawings and design.  
 2. The new water and sewerage works defined by this drawing have been designed and constructed in accordance with the SEQ Code.  
 3. This represents an accurate record of as-constructed works  
 4. I accept responsibility for the information contained in this drawing / document.  
 RPEQ (signature) \_\_\_\_\_ RPEQ No. \_\_\_\_\_ Date: \_\_\_\_\_

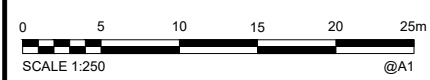

**AS CONSTRUCTED**

**A1**

INDEX	DATE	REVISIONS	DRAWN	CHECKED	PASSED	INITIALS	DATE
B	13/05/2022	AS CONSTRUCTED	MW	DAM	CW	CHECKED	DAM 13/05/2022
B	25/01/2022	AS CONSTRUCTED	DC	DAM	CW	PASSED	CW 13/05/2022



**LOGAN CITY COUNCIL**  
 MIRVAC MIR009-01  
 AS CONSTRUCTED SURVEY - SEWER  
 EVERLEIGH PRECINCT 9.1  
 GREENBANK QLD

SHEET 2 OF 5 SHEETS	SCALE 1:250 A1
REVISION DATE 13/05/2022	REVISION B
DISCIPLINE CODE -	
DRAWING NO. ASC-SEWER-02-9.1	

PM61308 RL  
 E: 498528.114  
 N: 6931171.033  
 RL: 54.660m



**REGISTERED SURVEYOR'S CERTIFICATION**


I, Gordon Nicholson, hereby certify that the vertical and horizontal locations and dimensions shown on this plan are a true and correct record and were located by survey.

Registered Surveyor (sig.) Reg. Surveyor No. SA 3405 Date: 13/05/2022

**ENGINEER'S CERTIFICATION**

I, \_\_\_\_\_, hereby certify that:  
 1. The information contained in this drawing / document is in compliance with approved drawings and design.  
 2. The new water and sewerage works defined by this drawing have been designed and constructed in accordance with the SEQ Code.  
 3. This represents an accurate record of as-constructed works  
 4. I accept responsibility for the information contained in this drawing / document.

RPEQ (signature) RPEQ No. \_\_\_\_\_ Date: \_\_\_\_\_

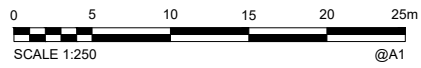

**AS CONSTRUCTED**

**COORDINATE DATUM NOTE:**  
 HORIZONTAL COORDINATES(E,N) SUPPLIED ARE MAPPING GRID OF AUSTRALIA(MGA), ZONE 56 BASED ON THE UNIVERSAL TRANSVERSE MERCATOR PROJECTION AND THE GEOCENTRIC DATUM OF AUSTRALIA 1994.  
 HORIZONTAL DATUM DERIVED FROM PSM 61308 E 498528.114 N 6931171.033.  
 LEVELS SUPPLIED ARE ON THE AUSTRALIAN HEIGHT DATUM(AHD)  
 LEVEL DATUM DERIVED FROM PSM 61308 RL54.660 (AHD)

<b>A1</b>	INDEX	DATE	REVISIONS	DRAWN	CHECKED	PASSED	INITIALS	DATE
	A	13/05/2022	AS CONSTRUCTED	MW	DAM	CW		13/05/2022

**shadforth**

LOGAN CITY COUNCIL


**LOGAN CITY COUNCIL**

**LOGAN CITY COUNCIL**

MIRVAC MIR009-01  
 AS CONSTRUCTED SURVEY - SEWER  
 EVERLEIGH PRECINCT 9.1  
 GREENBANK QLD

SHEET 3 OF 5 SHEETS	SCALE 1:250 A1
REVISION DATE 13/05/2022	REVISION A
DISCIPLINE CODE -	
DRAWING NO. ASC-SEWER-03-9.1	


PM61308 RL  
 E: 498528.114  
 N: 6931171.033  
 RL: 54.660m

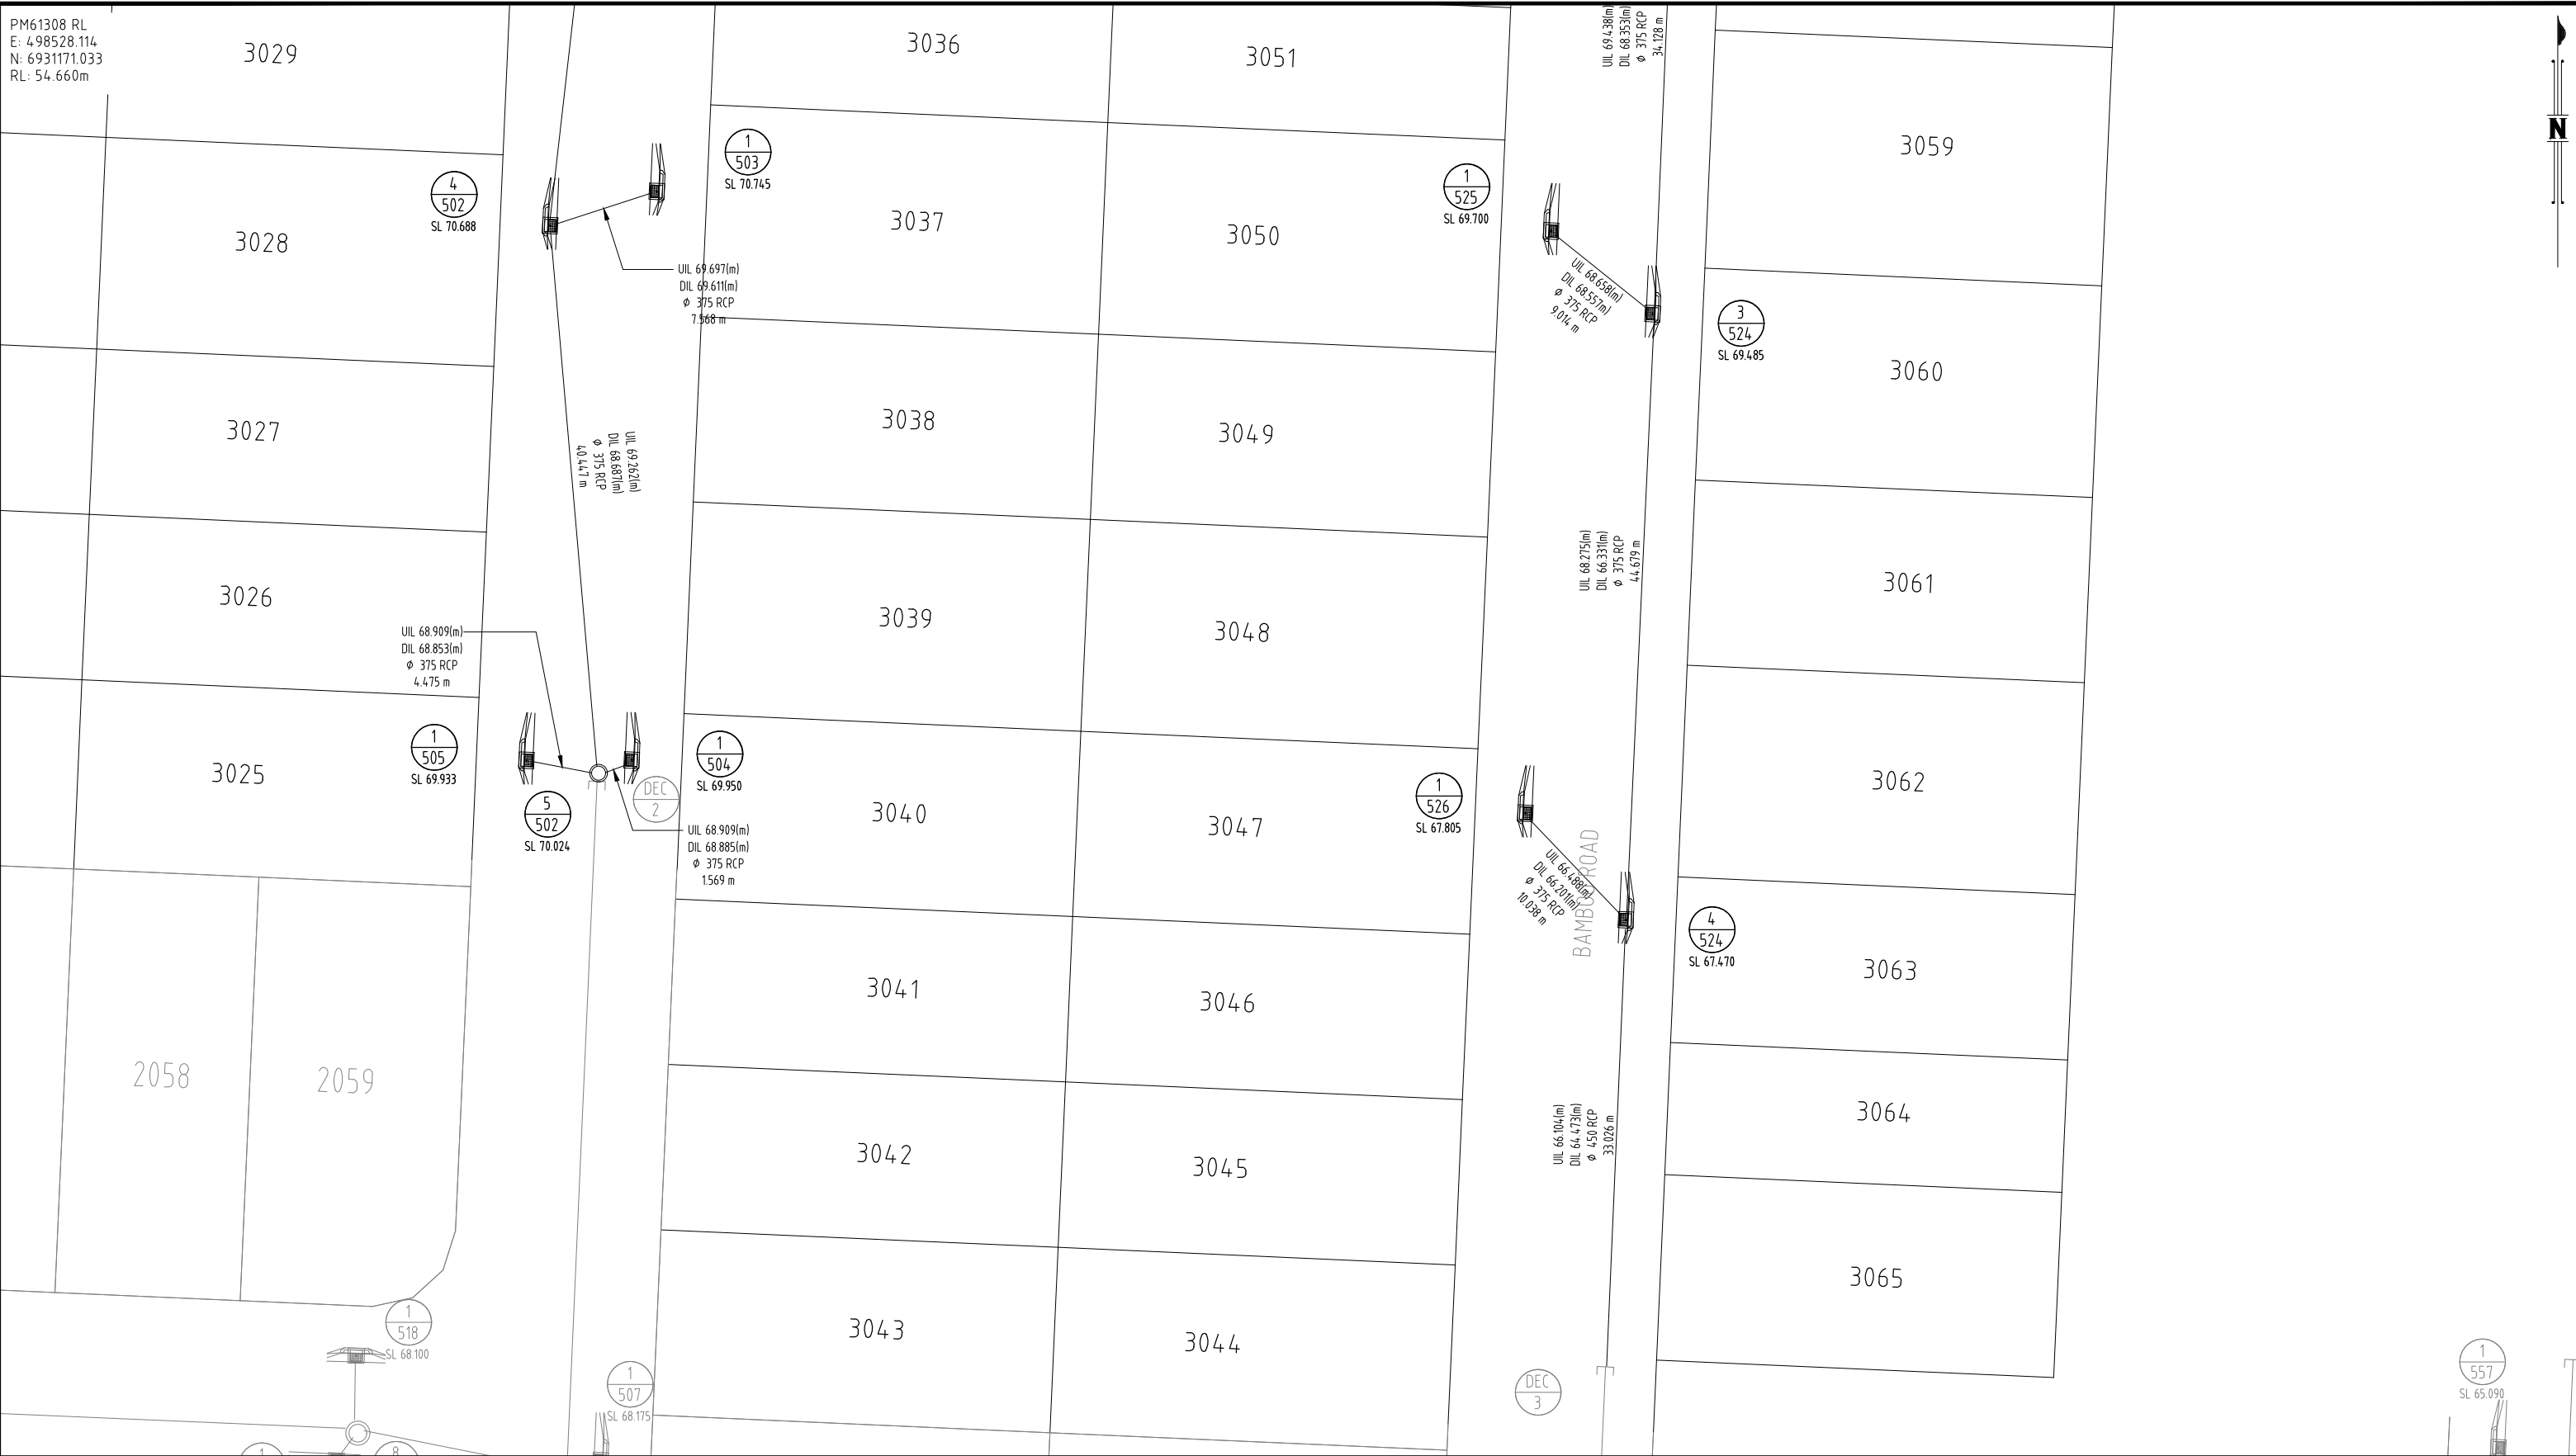

**COORDINATE DATUM NOTE:**  
 HORIZONTAL COORDINATES(E,N) SUPPLIED ARE MAPPING GRID OF AUSTRALIA(MGA), ZONE 56 BASED ON THE UNIVERSAL TRANSVERSE MERCATOR PROJECTION AND THE GEOCENTRIC DATUM OF AUSTRALIA 1994.  
 HORIZONTAL DATUM DERIVED FROM PSM 61308 E 498528.114 N 6931171.033.  
 LEVELS SUPPLIED ARE ON THE AUSTRALIAN HEIGHT DATUM(AHD)  
 LEVEL DATUM DERIVED FROM PSM 61308 RL54.660 (AHD)

**REGISTERED SURVEYOR'S CERTIFICATION**  
 I, Gordon Nicholson, hereby certify that the vertical and horizontal locations and dimensions shown on this plan are a true and correct record and were located by survey.  
 Registered Surveyor (sig.) Reg. Surveyor No. SA 3405 Date: 13/05/2022

**ENGINEER'S CERTIFICATION**  
 I, \_\_\_\_\_, hereby certify that:  
 1. The information contained in this drawing / document is in compliance with approved drawings and design.  
 2. The new water and sewerage works defined by this drawing have been designed and constructed in accordance with the SEQ Code.  
 3. This represents an accurate record of as-constructed works  
 4. I accept responsibility for the information contained in this drawing / document.  
 RPEQ (signature) RPEQ No. \_\_\_\_\_ Date: \_\_\_\_\_

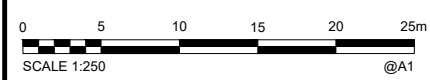

**AS CONSTRUCTED**

<b>A1</b>	INDEX	DATE	REVISIONS	DRAWN	CHECKED	PASSED	INITIALS	DATE
	A	13/05/2022	AS CONSTRUCTED	MW	DAM	CW		13/05/2022


**shadforth**  
 20 South Street, Forest Hill QLD 4055  
 075520 3300 > 075520 3300 > 075520 3300

**LOGAN CITY COUNCIL**

**LOGAN CITY COUNCIL**  
 MIRVAC MIR009-01  
 AS CONSTRUCTED SURVEY - SEWER  
 EVERLEIGH PRECINCT 9.1  
 GREENBANK QLD


SHEET 4 OF 5 SHEETS	SCALE 1:250 A1
REVISION DATE 13/05/2022	REVISION A
DISCIPLINE CODE -	
DRAWING NO. ASC-SEWER-04-9.1	

PM61308 RL  
 E: 498528.114  
 N: 6931171.033  
 RL: 54.660m

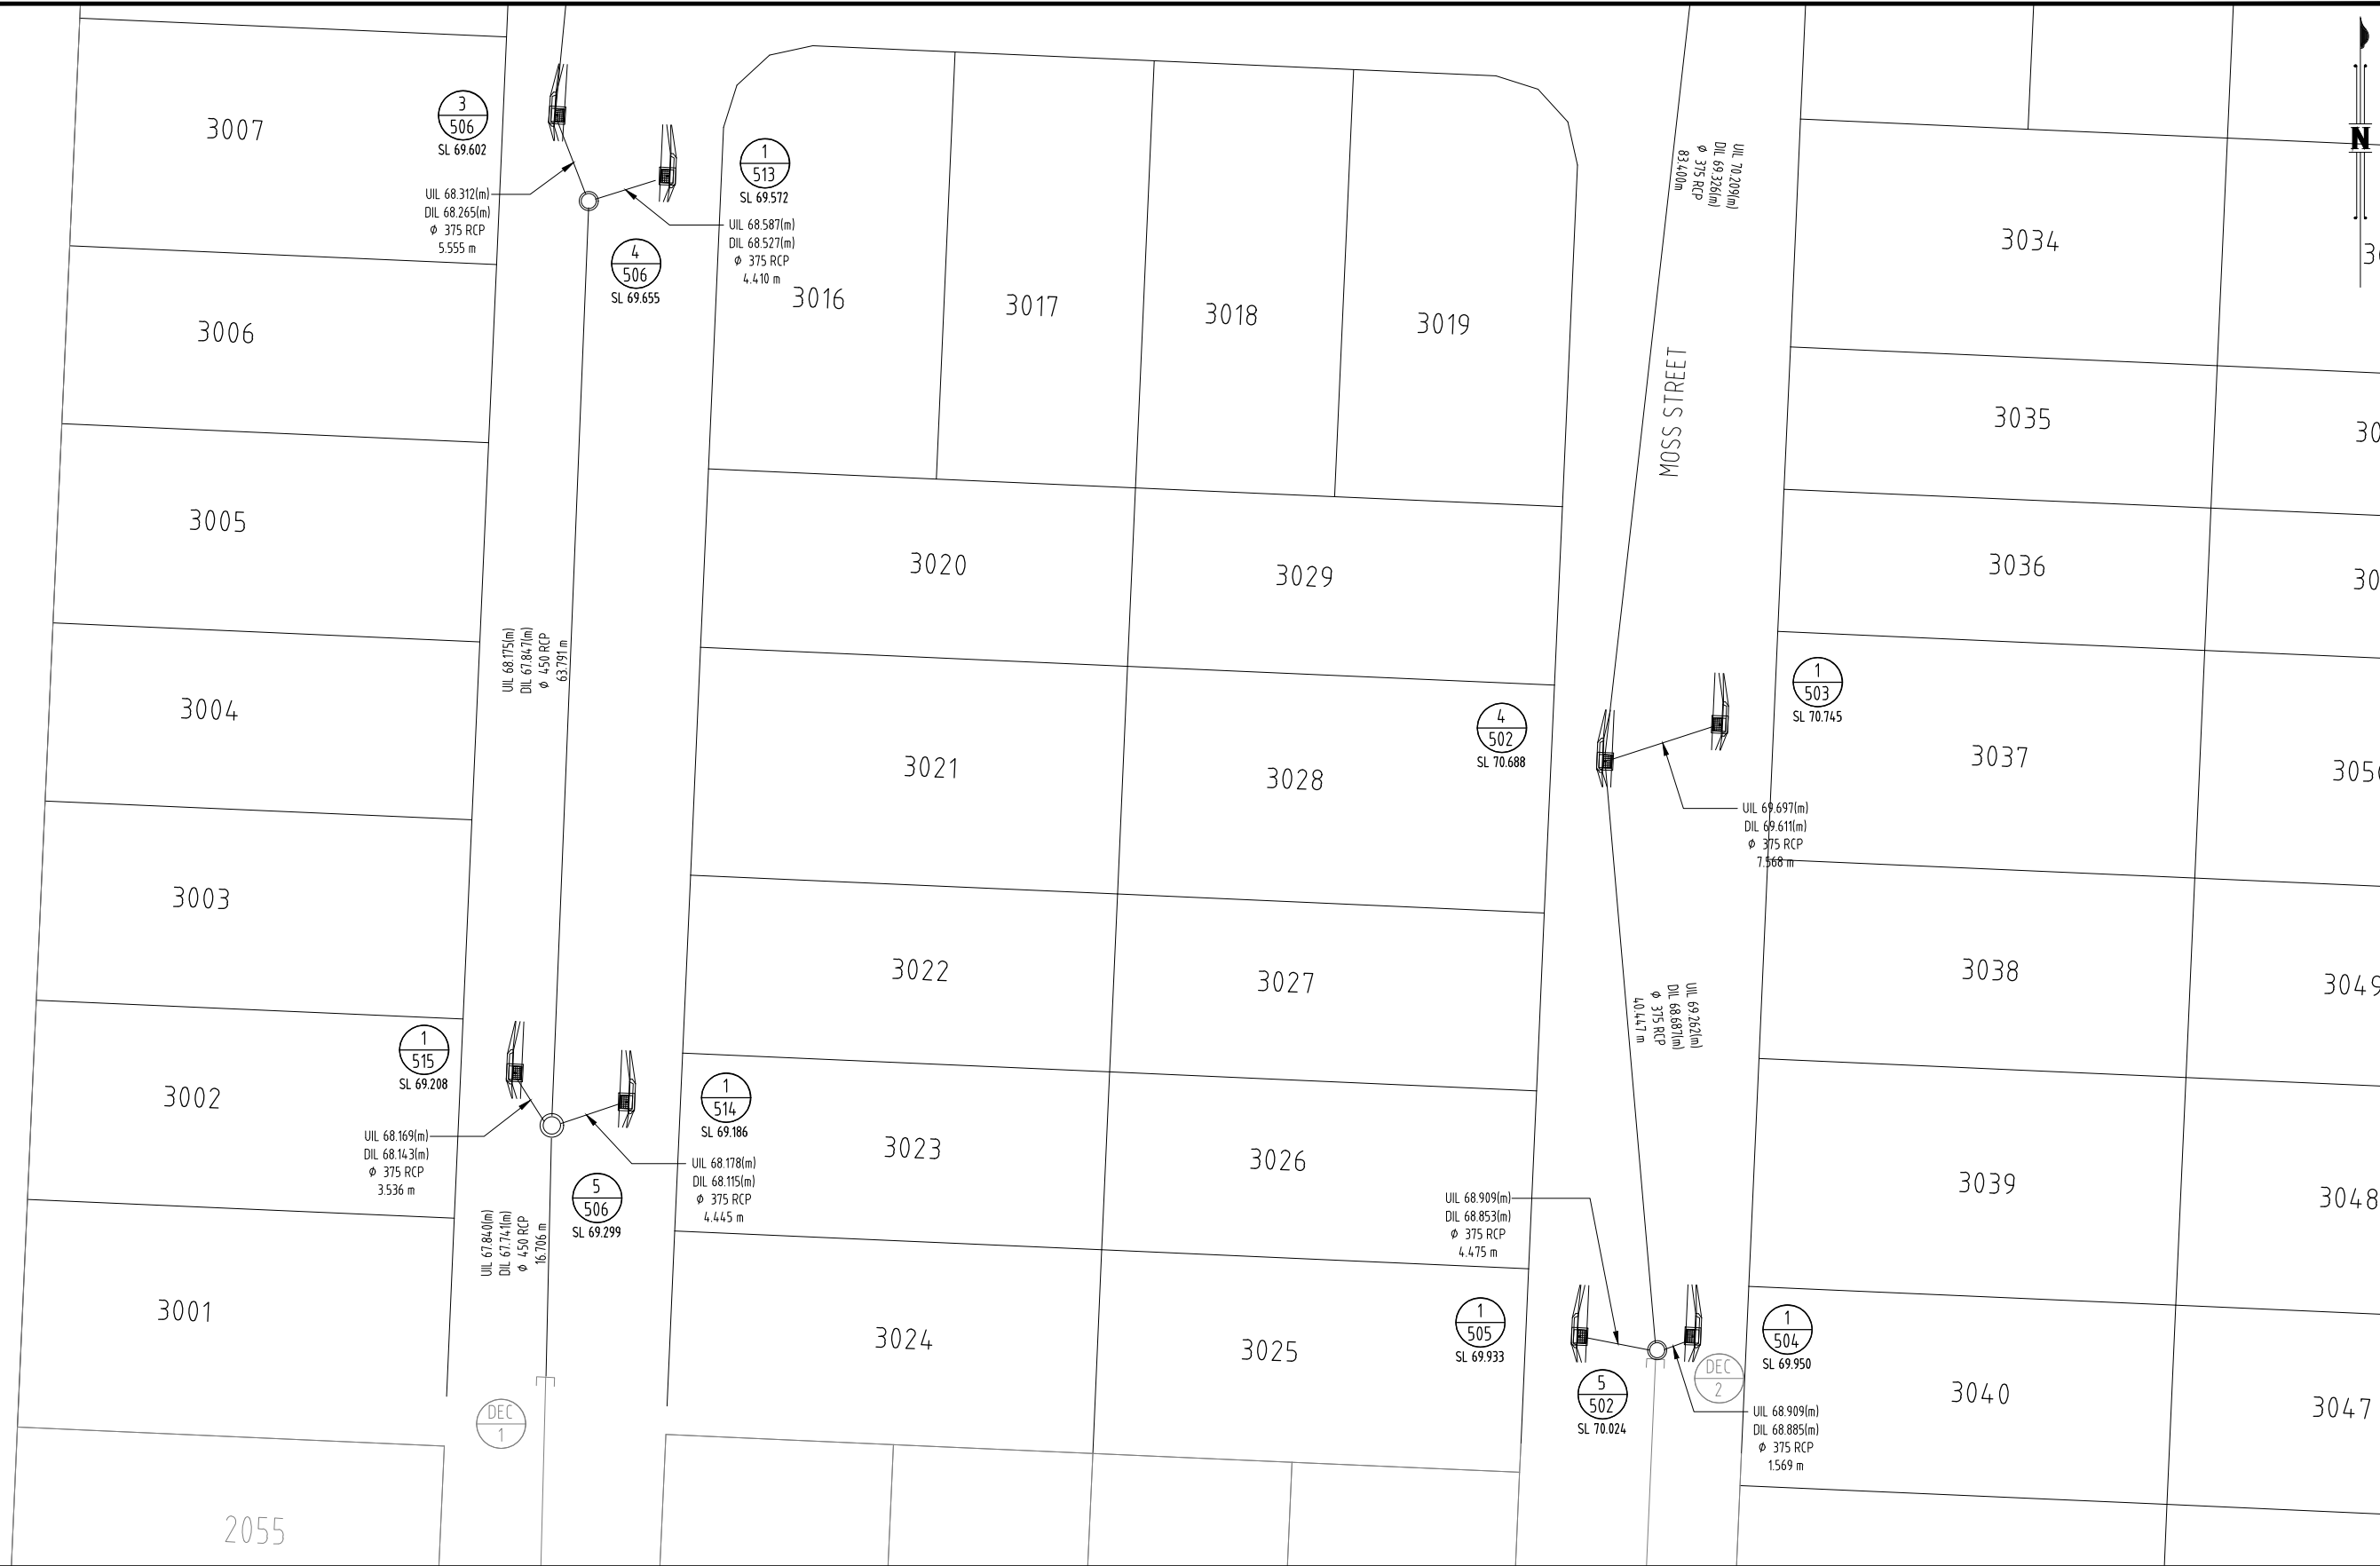

**REGISTERED SURVEYOR'S CERTIFICATION**  
 I, Gordon Nicholson, hereby certify that the vertical and horizontal locations and dimensions shown on this plan are a true and correct record and were located by survey.  
 Registered Surveyor (sig.) Reg. Surveyor No. SA 3405 Date: 13/05/2022

**ENGINEER'S CERTIFICATION**  
 I, \_\_\_\_\_, hereby certify that:  
 1. The information contained in this drawing / document is in compliance with approved drawings and design.  
 2. The new water and sewerage works defined by this drawing have been designed and constructed in accordance with the SEQ Code.  
 3. This represents an accurate record of as-constructed works.  
 4. I accept responsibility for the information contained in this drawing / document.  
 RPEQ (signature) RPEQ No. \_\_\_\_\_ Date: \_\_\_\_\_

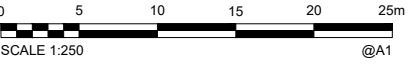

**AS CONSTRUCTED**

**COORDINATE DATUM NOTE:**  
 HORIZONTAL COORDINATES(E,N) SUPPLIED ARE MAPPING GRID OF AUSTRALIA(MGA), ZONE 56 BASED ON THE UNIVERSAL TRANSVERSE MERCATOR PROJECTION AND THE GEOCENTRIC DATUM OF AUSTRALIA 1994.  
 HORIZONTAL DATUM DERIVED FROM PSM 61308 E 498528.114 N 6931171.033.  
 LEVELS SUPPLIED ARE ON THE AUSTRALIAN HEIGHT DATUM(AHD)  
 LEVEL DATUM DERIVED FROM PSM 61308 RL54.660 (AHD)

<b>A1</b>	INDEX	DATE	REVISIONS	DRAWN	MW	13/05/2022
	A	13/05/2022	AS CONSTRUCTED	DC	DAM	CW
				CHECKED	DAM	13/05/2022
				PASSED	CW	13/05/2022
				INITIALS	DATE	



**LOGAN CITY COUNCIL**  
 MIRVAC MIR009-01  
 AS CONSTRUCTED SURVEY - SEWER  
 EVERLEIGH PRECINCT 9.1  
 GREENBANK QLD

SHEET 5 OF 5 SHEETS	SCALE 1:250 A1
REVISION DATE 13/05/2022	REVISION A
DISCIPLINE CODE -	
DRAWING NO. ASC-SEWER-05-9.1	