

COORDINATE DATUM NOTE:

HORIZONTAL COORDINATES(E,N) SUPPLIED ARE MAPPING GRID OF AUSTRALIA(MGA), ZONE 56 BASED ON THE UNIVERSAL TRANSVERSE MERCATOR PROJECTION AND THE GEOCENTRIC DATUM OF AUSTRALIA 1994.
 HORIZONTAL DATUM DERIVED FROM PSM 61308 E 4 98528.114 N 6931171.033
 LEVELS SUPPLIED ARE ON THE AUSTRALIAN HEIGHT DATUM(AHD) LEVEL DATUM DERIVED FROM PSM 61308 RL54.660 (AHD)

REGISTERED SURVEYOR'S CERTIFICATION

I, Gordon Nicholson, hereby certify that the vertical and horizontal locations and dimensions shown on this plan are a true and correct record and were located by survey.

Registered Surveyor (sig.) Reg. Surveyor No. SA 3405 Date: 09/09/2022

ENGINEER'S CERTIFICATION


I, _____, hereby certify that:
 1. The information contained in this drawing / document is in compliance with approved drawings and design.
 2. The new water and sewerage works defined by this drawing have been designed and constructed in accordance with the SEQ Code.
 3. This represents an accurate record of as-constructed works.
 4. I accept responsibility for the information contained in this drawing / document.

RPEQ (signature) RPEQ No. _____ Date: _____

- SEWER MANHOLE
- × SEWER FITTING
- SEWER DEC
- SEWER PIPE CLASS AS SHOWN



AS CONSTRUCTED

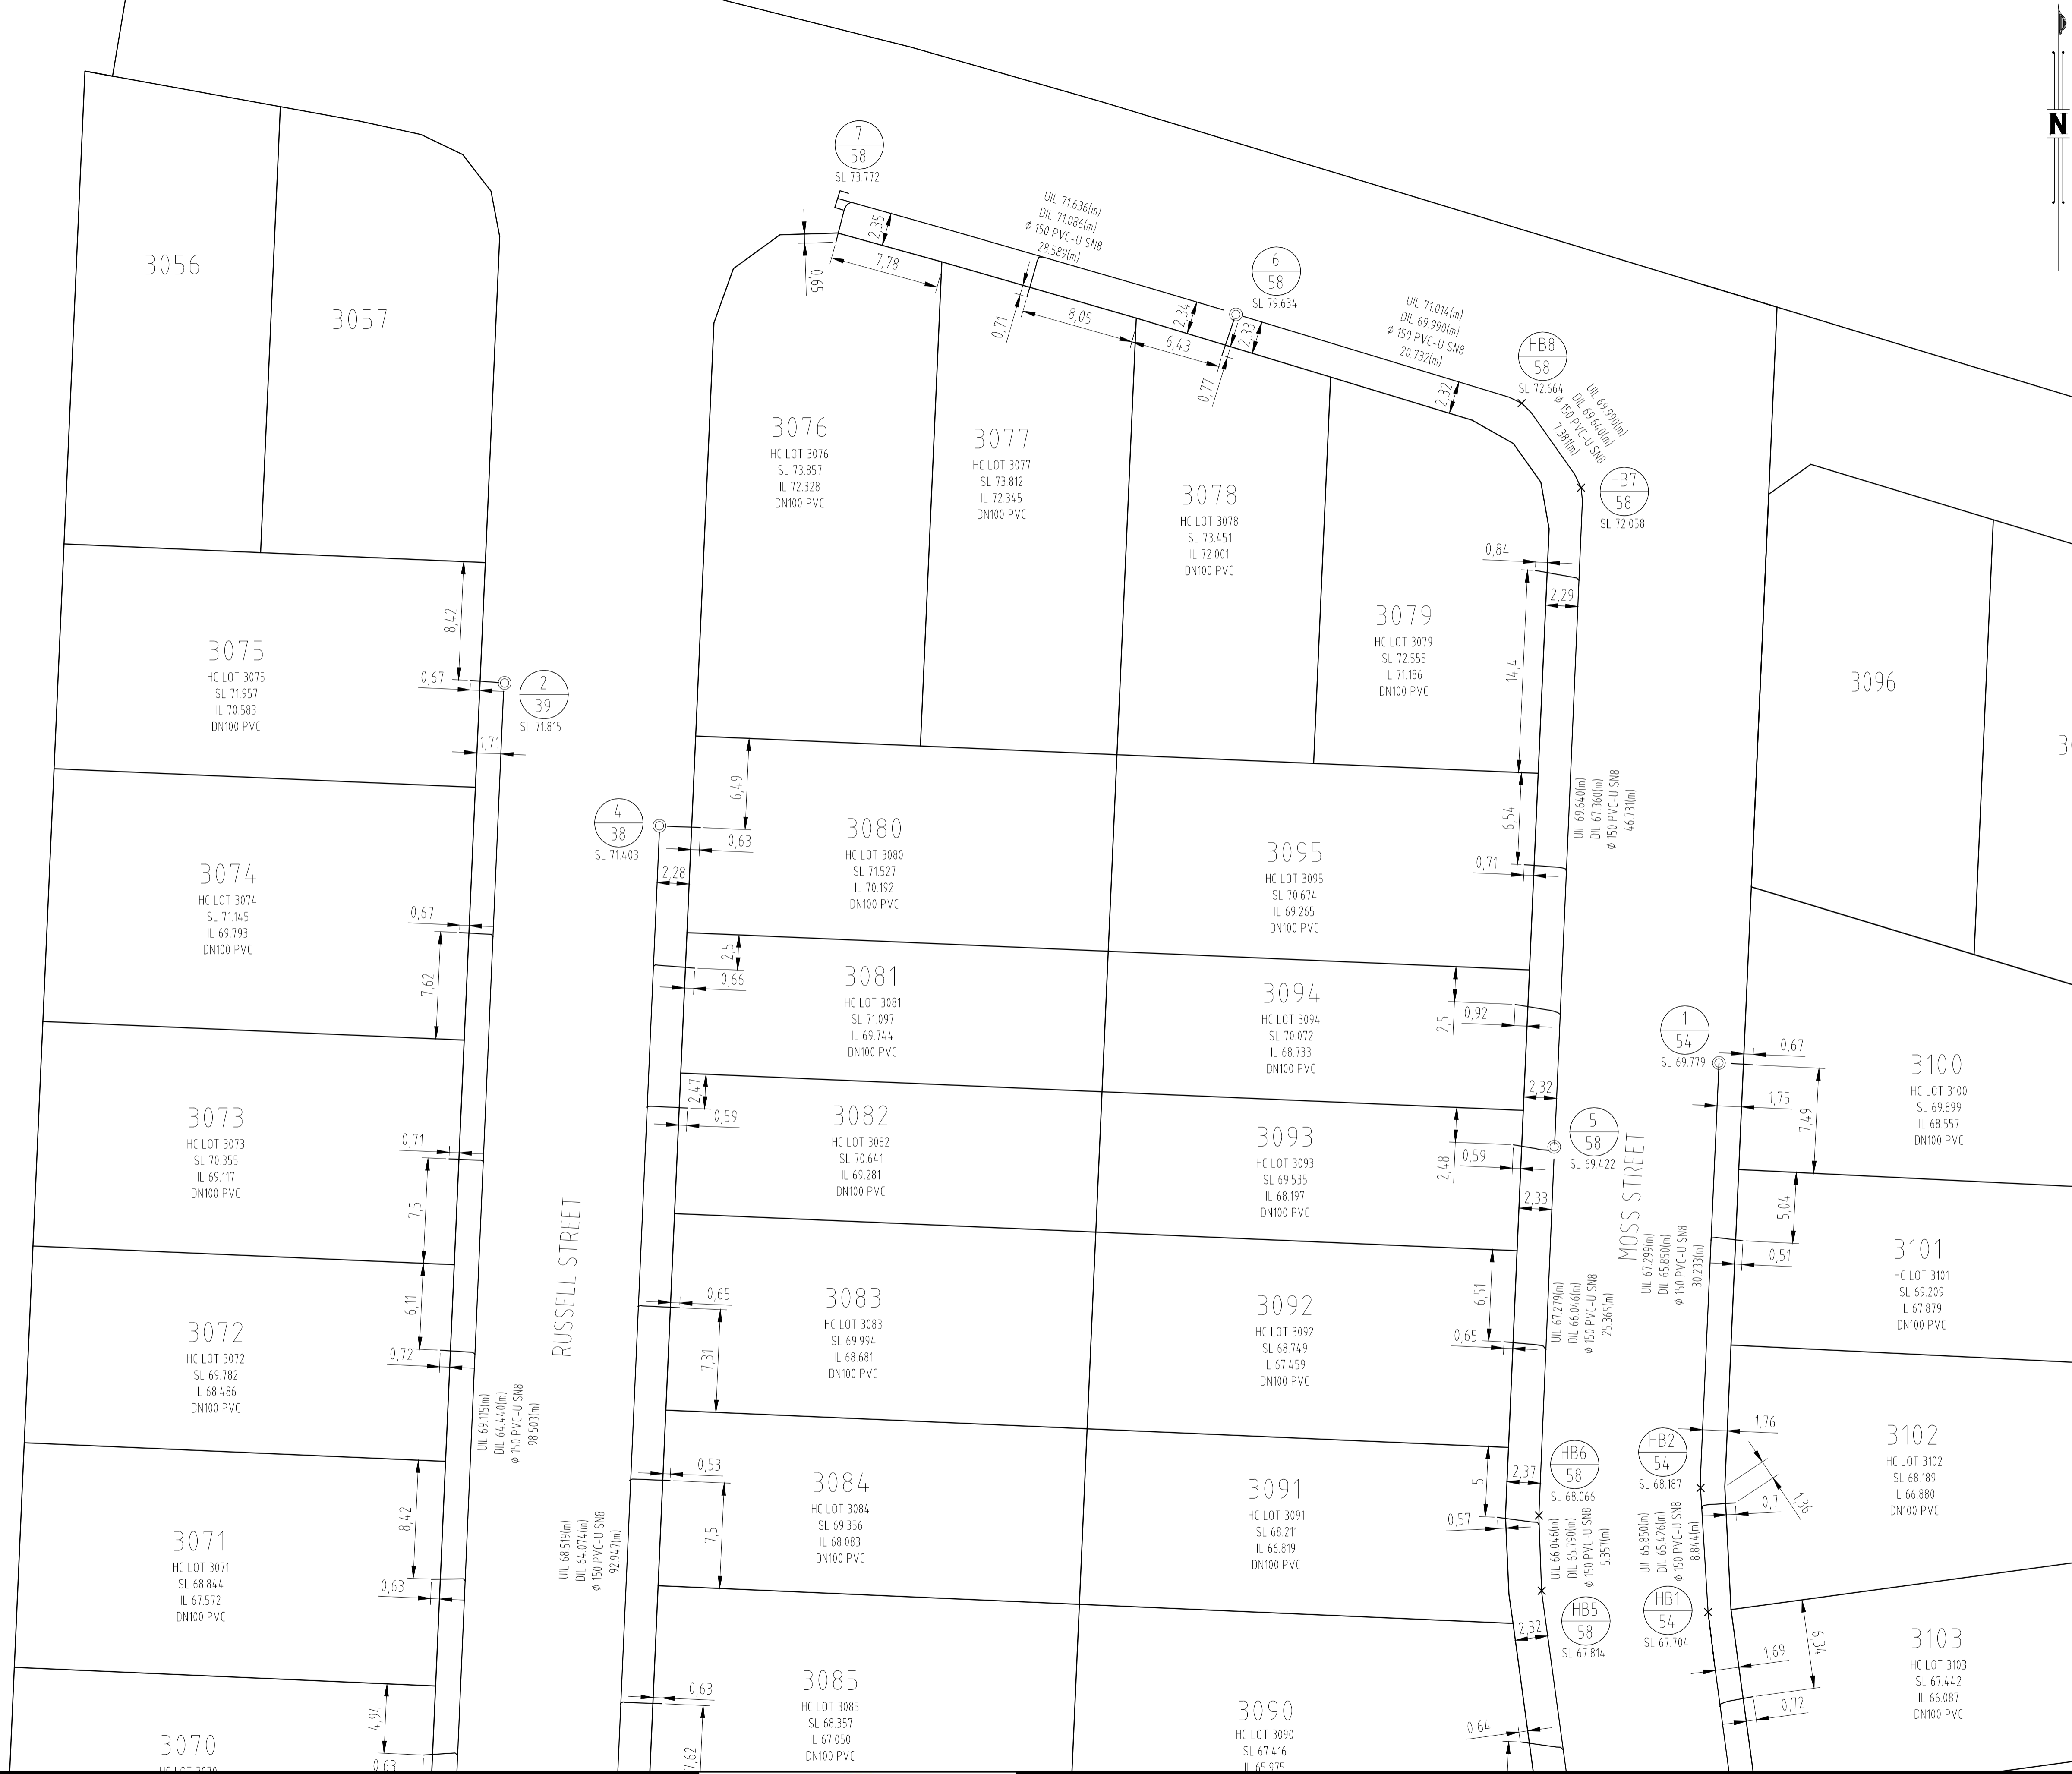

PM61308 RL
 E: 4 98528.114
 N: 6931171.033
 RL: 54.660m

A1	INDEX	DATE	REVISIONS	DRAWN	CHECKED	PASSED	INITIALS	DATE
	A	09/09/2022	AS CONSTRUCTED	NJA	DAM	CW		09/09/2022

shadforth
 99 Sandalwood Lane, Forest Glen QLD 4556
 P: 07 5438 3300 | F: 07 5438 3388 | E: adm@shadforth.com.au

LOGAN CITY COUNCIL

LOGAN CITY COUNCIL
 MIRVAC MIR012-02
 AS CONSTRUCTED SURVEY - SEWER
 EVERLEIGH PRECINCT 9.2
 GREENBANK QLD

SHEET 2 OF 4 SHEETS	SCALE 1:250 A1
REVISION DATE 22/06/2022	REVISION A
DISCIPLINE CODE -	
DRAWING NO. ASC-SEWER-02-9.2	

PM61308 RL
 E: 498528.114
 N: 6931171.033
 RL: 54.660m




ENGINEER'S CERTIFICATION

I, _____, hereby certify that:
 1. The information contained in this drawing / document is in compliance with approved drawings and design.
 2. The new water and sewerage works defined by this drawing have been designed and constructed in accordance with the SEQ Code.
 3. This represents an accurate record of as-constructed works.
 4. I accept responsibility for the information contained in this drawing / document.

 RPEQ (signature) RPEQ No. _____ Date: _____

- SEWER MANHOLE
- × SEWER FITTING
- SEWER DEC
- SEWER PIPE CLASS AS SHOWN

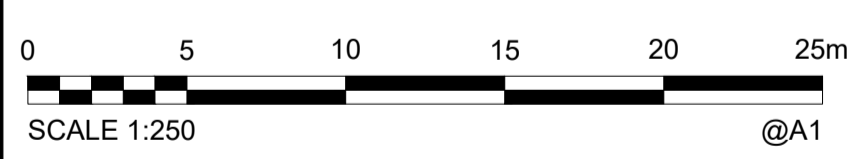

AS CONSTRUCTED

REGISTERED SURVEYOR'S CERTIFICATION

I, Gordon Nicholson, hereby certify that the vertical and horizontal locations and dimensions shown on this plan are a true and correct record and were located by survey.

 Registered Surveyor (sig.) Reg. Surveyor No. SA 3405 Date: 09/09/2022

COORDINATE DATUM NOTE:
 HORIZONTAL COORDINATES(E,N) SUPPLIED ARE MAPPING GRID OF AUSTRALIA(MGA), ZONE 56 BASED ON THE UNIVERSAL TRANSVERSE MERCATOR PROJECTION AND THE GEOCENTRIC DATUM OF AUSTRALIA 1994.
 HORIZONTAL DATUM DERIVED FROM PSM 61308 E 498528.114 N 6931171.033.
 LEVELS SUPPLIED ARE ON THE AUSTRALIAN HEIGHT DATUM(AHD) LEVEL DATUM DERIVED FROM PSM 61308 RL54.660 (AHD)

A1

INDEX	DATE	REVISIONS	DRAWN	CHECKED	PASSED	INITIALS	DATE
A	09/09/2022	AS CONSTRUCTED	NJA	DAM	CW		09/09/2022


99 Sandalwood Lane, Forest Glen QLD 4556
 P: 07 5438 3300 > F: 07 5438 3388 > E: adm@shadforth.com.au

LOGAN CITY COUNCIL

MIRVAC MIR012-02
 AS CONSTRUCTED SURVEY - SEWER
 EVERLEIGH PRECINCT 9.2
 GREENBANK QLD

SHEET 3 OF 4 SHEETS	SCALE 1:250 A1
REVISION DATE 09/09/2022	REVISION A
DISCIPLINE CODE -	
DRAWING NO. ASC-SEWER-03-9.2	

PM61308 RL
 E: 498528.114
 N: 6931171.033
 RL: 54.660m

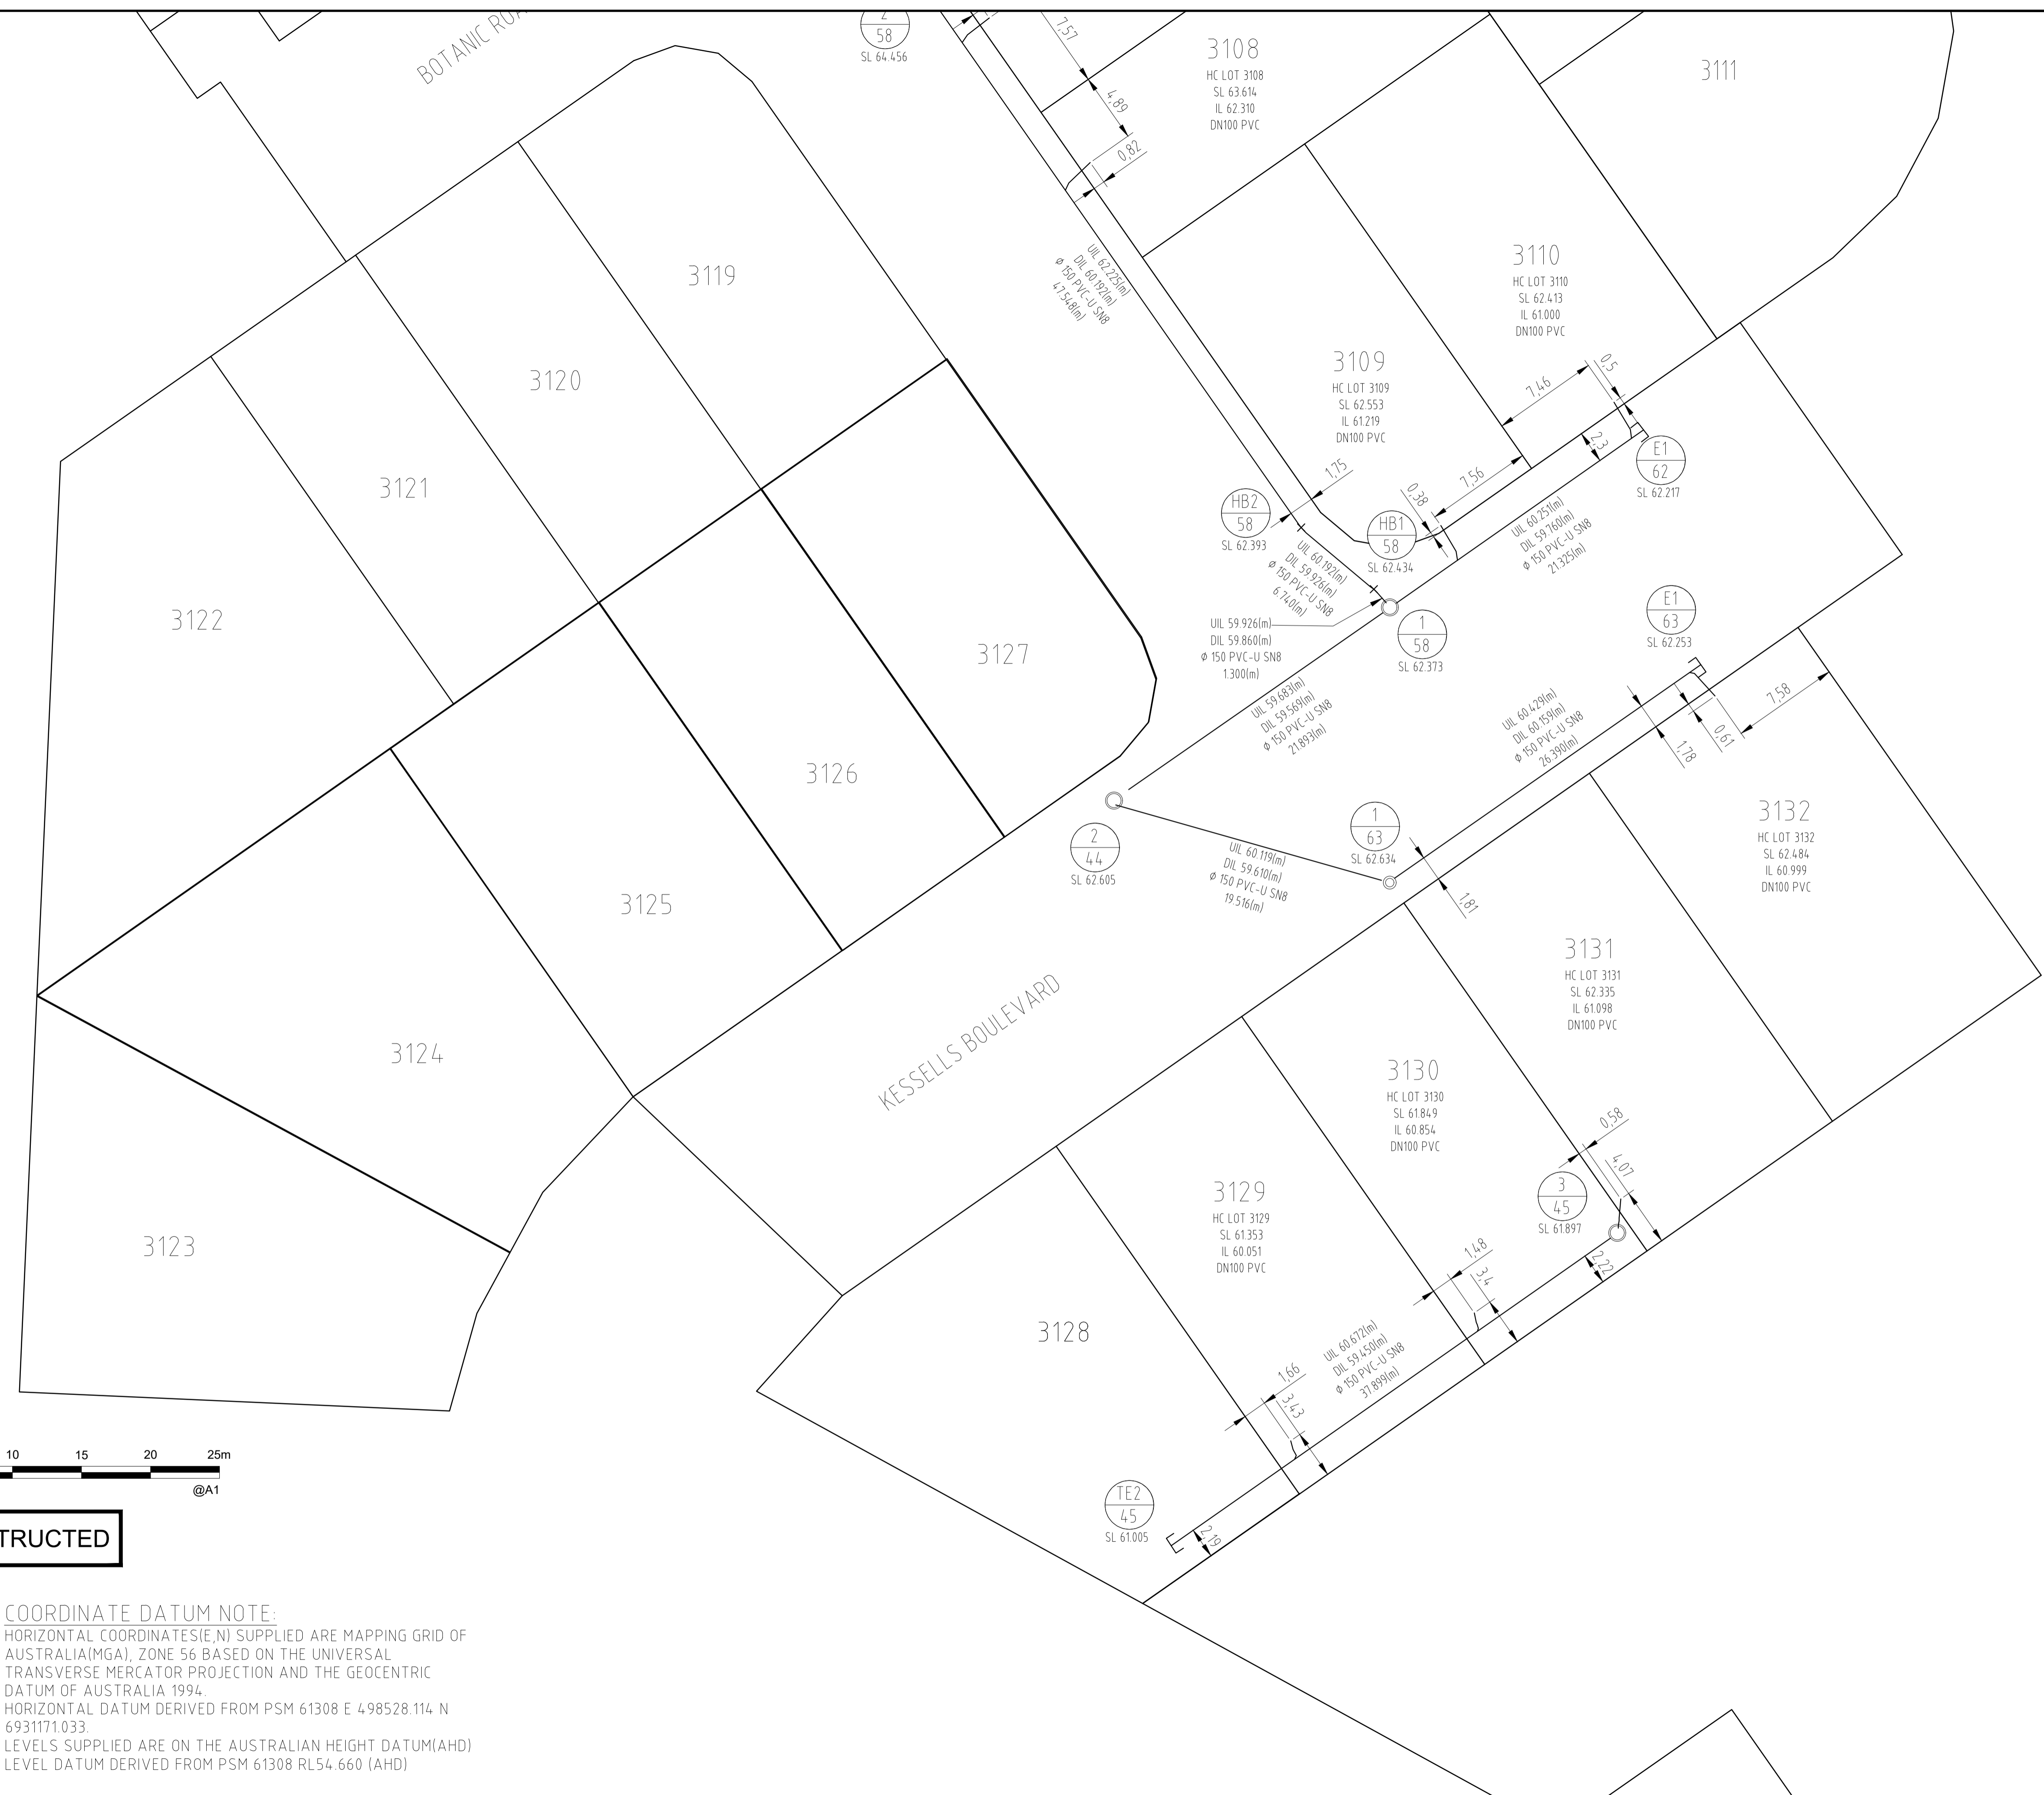


ENGINEER'S CERTIFICATION

I, _____, hereby certify that:
 1. The information contained in this drawing / document is in compliance with approved drawings and design.
 2. The new water and sewerage works defined by this drawing have been designed and constructed in accordance with the SEQ Code.
 3. This represents an accurate record of as-constructed works.
 4. I accept responsibility for the information contained in this drawing / document.

 RPEQ (signature) RPEQ No. _____ Date: _____

- SEWER MANHOLE
- × SEWER FITTING
- SEWER DEC
- _____ SEWER PIPE CLASS AS SHOWN

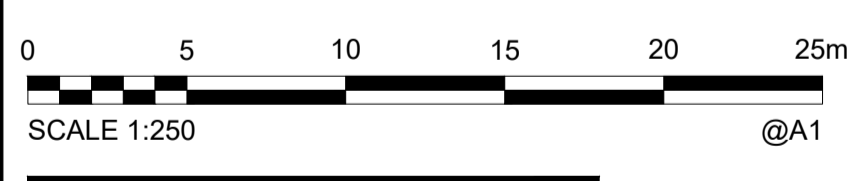

AS CONSTRUCTED

REGISTERED SURVEYOR'S CERTIFICATION

I, Gordon Nicholson, hereby certify that the vertical and horizontal locations and dimensions shown on this plan are a true and correct record and were located by survey.

 Registered Surveyor (sig) Reg. Surveyor No. SA 3405 Date: 09/09/2022

COORDINATE DATUM NOTE:
 HORIZONTAL COORDINATES(E,N) SUPPLIED ARE MAPPING GRID OF AUSTRALIA(MGA), ZONE 56 BASED ON THE UNIVERSAL TRANSVERSE MERCATOR PROJECTION AND THE GEOCENTRIC DATUM OF AUSTRALIA 1994.
 HORIZONTAL DATUM DERIVED FROM PSM 61308 E 498528.114 N 6931171.033.
 LEVELS SUPPLIED ARE ON THE AUSTRALIAN HEIGHT DATUM(AHD) LEVEL DATUM DERIVED FROM PSM 61308 RL54.660 (AHD)

A1	INDEX	DATE	REVISIONS	DRAWN	CHECKED	PASSED	INITIALS	DATE
	A	09/09/2022	AS CONSTRUCTED	NJA	DAM	CW		09/09/2022

DRAWN	NJA	09/09/2022
CHECKED	DAM	09/09/2022
PASSED	CW	09/09/2022



LOGAN CITY COUNCIL
 MIRVAC MIR012-02
 AS CONSTRUCTED SURVEY - SEWER
 EVERLEIGH PRECINCT 9.2
 GREENBANK QLD

SHEET 4 OF 4 SHEETS	SCALE 1:250 A1
REVISION DATE 09/09/2022	REVISION A
DISCIPLINE CODE -	
DRAWING NO. ASC-SEWER-04-9.2	


PM61308 RL
 E: 4.98528.114
 N: 6931171.033
 RL: 54.660m



REGISTERED SURVEYOR'S CERTIFICATION

I, Gordon Nicholson, hereby certify that the vertical and horizontal locations and dimensions shown on this plan are a true and correct record and were located by survey.

Registered Surveyor (Sig.) Gordon Nicholson Reg. Surveyor No. SA 3405 Date: 12/07/2021

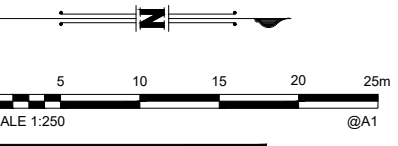

AS CONSTRUCTED

○ SEWER MANHOLE
 × SEWER FITTING
 L SEWER DEC
 — SEWER PIPE CLASS AS SHOWN

AS CONSTRUCTED CERTIFICATION

I, Patrick Brady, hereby certify that:

- The information contained in this drawing/document is generally in compliance with approved drawings and design.
- To the best of my knowledge, this represents an accurate record of as constructed works and I accept the responsibility for the information contained in this drawing/document. Excluding Survey Error.

7112 02/08/2021
 RPEQ (Signature) _____ RPEQ No. _____ Date: _____

COORDINATE DATUM NOTE:
 HORIZONTAL COORDINATES(E,N) SUPPLIED ARE MAPPING GRID OF AUSTRALIA(MGA), ZONE 56 BASED ON THE UNIVERSAL TRANSVERSE MERCATOR PROJECTION AND THE GEOCENTRIC DATUM OF AUSTRALIA 1994.
 HORIZONTAL DATUM DERIVED FROM PSM 61308 E 4.98528.114 N 6931171.033.
 LEVELS SUPPLIED ARE ON THE AUSTRALIAN HEIGHT DATUM(AHD)
 LEVEL DATUM DERIVED FROM PSM 61308 RL54.660 (AHD)

A1	A	12/07/2021	AS CONSTRUCTED	NJA	DAM	CW	PASSED	CW	12/07/2021
	INDEX	DATE	REVISIONS	DRAWN	CHECKED	PASSED	INITIALS	DATE	

shadforth

38 Shadforth Lane, Forest Glen QLD 4006
 07 5428 2000 • 07 5428 2008 • shadforth@shadforth.com.au

LOGAN CITY COUNCIL

LOGAN CITY COUNCIL

MIRVAC MI001-04
 AS CONSTRUCTED SURVEY - SEWER
 EVERLEIGH PRECINCT 12.1
 GREENBANK QLD



SHEET 4 OF 6 SHEETS	SCALE 1:250 A1
REVISION DATE 12/07/2021	REVISION A
DISCIPLINE CODE -	
DRAWING NO. ASC-SEWER-04-12.1	



REGISTERED SURVEYOR'S CERTIFICATION

I, Gordon Nicholson, hereby certify that the vertical and horizontal locations and dimensions shown on this plan are a true and correct record and were located by survey.

Gordon Nicholson
 Registered Surveyor (sig.) Reg. Surveyor No. SA 3405 Date: 16/11/2021

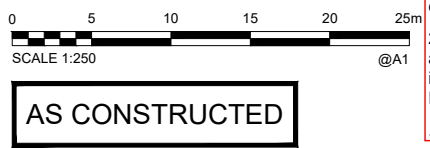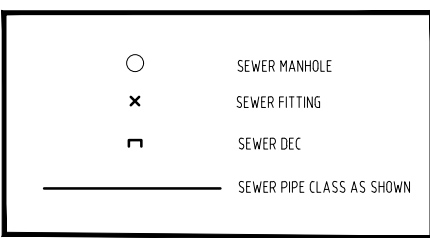

AS CONSTRUCTED CERTIFICATION

I, Patrick Brady, hereby certify that:

1. The information contained in this drawing/document is generally in compliance with approved drawings and design.

2. To the best of my knowledge, this represents an accurate record of as constructed works and I accept the responsibility for the information contained in this drawing/document. Excluding Survey Error.

7112 07/12/2021
 RPEQ No. _____ Date: _____

COORDINATE DATUM NOTE:
 HORIZONTAL COORDINATES (E, N) SUPPLIED ARE MAPPING GRID OF AUSTRALIA (MGA), ZONE 56 BASED ON THE UNIVERSAL TRANSVERSE MERCATOR PROJECTION AND THE GEOCENTRIC DATUM OF AUSTRALIA 1994.
 HORIZONTAL DATUM DERIVED FROM PSM 61308 E 4.98528.114 N 6931171.033.
 LEVELS SUPPLIED ARE ON THE AUSTRALIAN HEIGHT DATUM (AHD)
 LEVEL DATUM DERIVED FROM PSM 61308 RL54.660 (AHD)


A1	INDEX	DATE	REVISIONS	DRAWN	CHECKED	PASSED	INITIALS	DATE
	A	16/11/2021	AS CONSTRUCTED	NJA	DAM	CW		



LOGAN CITY COUNCIL

MIRVAC MIR012-02
 AS CONSTRUCTED SURVEY - SEWER
 EVERLEIGH PRECINCT 12.2
 GREENBANK QLD

SHEET 4 OF 5 SHEETS	SCALE 1:250 A1
REVISION DATE 16/11/2021	REVISION A
DISCIPLINE CODE -	
DRAWING NO. ASC-SEWER-04-12.2	

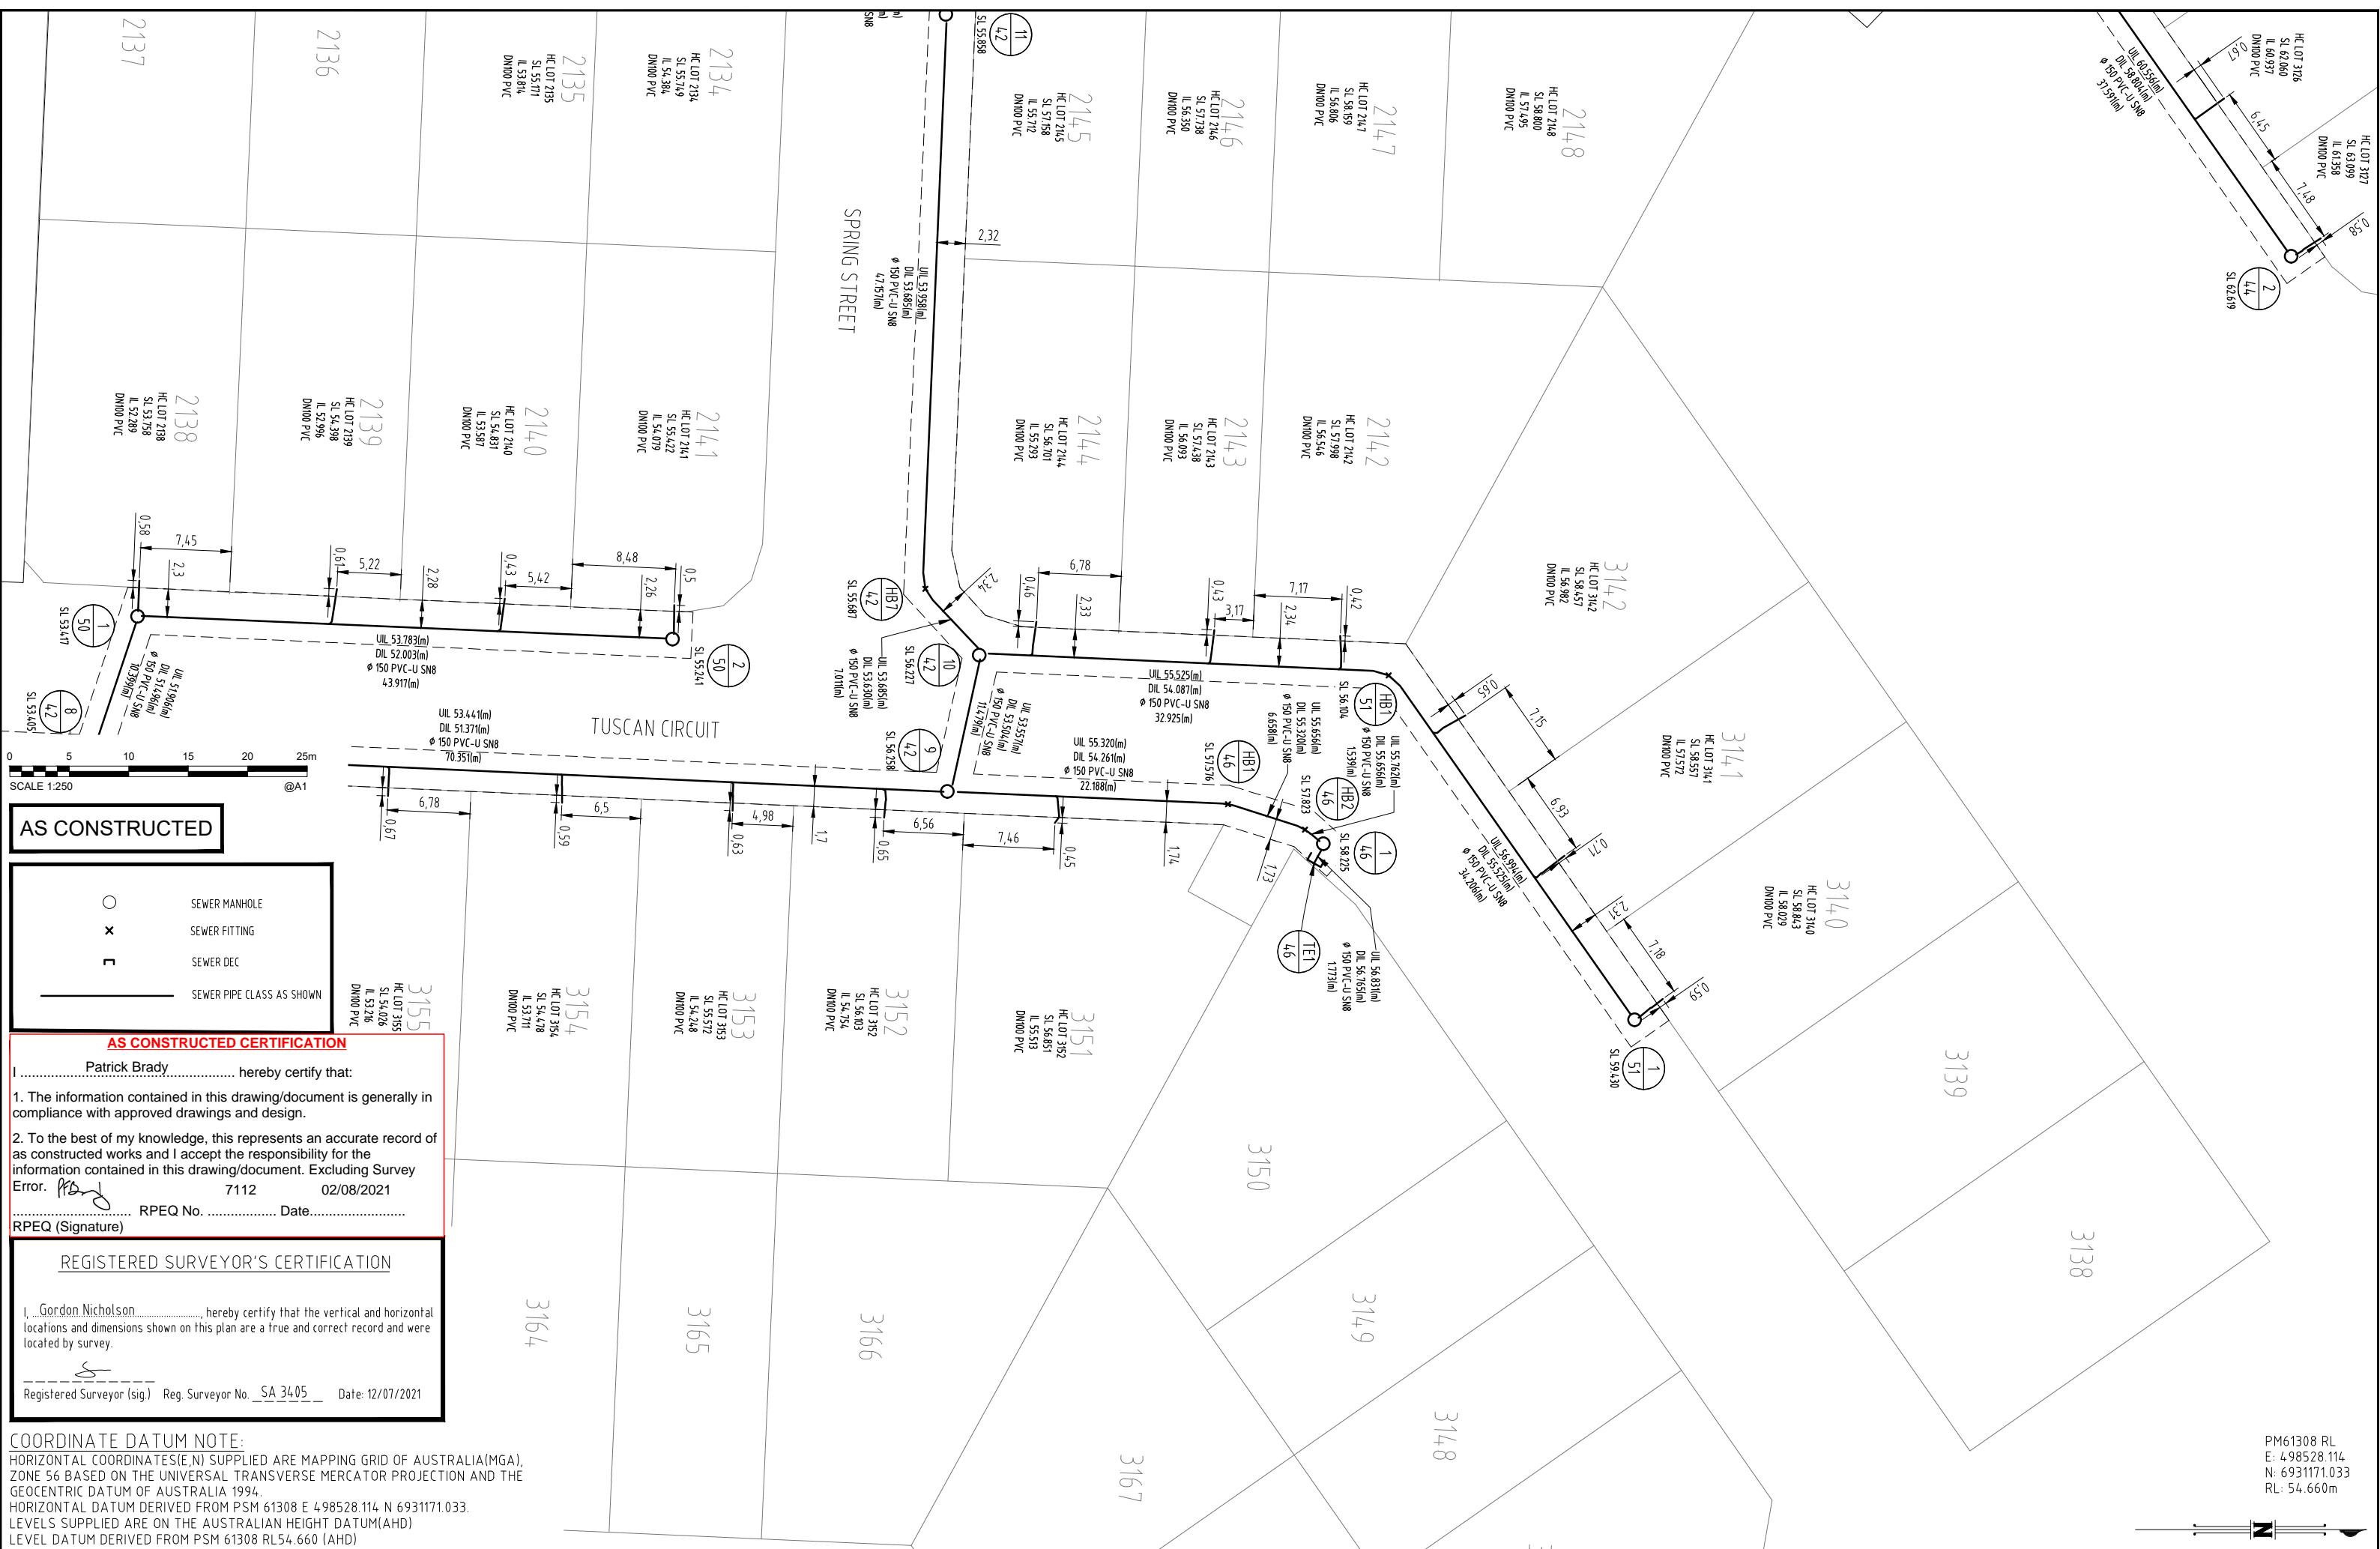

AS CONSTRUCTED

○	SEWER MANHOLE
×	SEWER FITTING
□	SEWER DEC
—	SEWER PIPE CLASS AS SHOWN

AS CONSTRUCTED CERTIFICATION

I, Patrick Brady, hereby certify that:

- The information contained in this drawing/document is generally in compliance with approved drawings and design.
- To the best of my knowledge, this represents an accurate record of as constructed works and I accept the responsibility for the information contained in this drawing/document. Excluding Survey Error.

RPEQ No. 7112 Date 02/08/2021

Patrick Brady RPEQ (Signature)

REGISTERED SURVEYOR'S CERTIFICATION

I, Gordon Nicholson, hereby certify that the vertical and horizontal locations and dimensions shown on this plan are a true and correct record and were located by survey.

Gordon Nicholson Registered Surveyor (sig.) Reg. Surveyor No. SA 34.05 Date: 12/07/2021

COORDINATE DATUM NOTE:
 HORIZONTAL COORDINATES (E, N) SUPPLIED ARE MAPPING GRID OF AUSTRALIA (MGA), ZONE 56 BASED ON THE UNIVERSAL TRANSVERSE MERCATOR PROJECTION AND THE GEOCENTRIC DATUM OF AUSTRALIA 1994.
 HORIZONTAL DATUM DERIVED FROM PSM 61308 E 4.98528.114 N 6931171.033.
 LEVELS SUPPLIED ARE ON THE AUSTRALIAN HEIGHT DATUM (AHD).
 LEVEL DATUM DERIVED FROM PSM 61308 RL54.660 (AHD).

PM61308 RL
 E: 4.98528.114
 N: 6931171.033
 RL: 54.660m

A1	INDEX	DATE	REVISIONS	DRAWN	CHECKED	PASSED	INITIALS	DATE
	A	12/07/2021	AS CONSTRUCTED	NJA	DAM	CW		

shadforth


38 Southshore Lane, Forest Glen QLD 4086
 07 5438 2000 • 07 5438 2008 • shadforth@shadforth.com.au

LOGAN CITY COUNCIL

LOGAN CITY COUNCIL



MIRVAC MIR001-04
 AS CONSTRUCTED SURVEY - SEWER
 EVERLEIGH PRECINCT 12.1
 GREENBANK QLD

SHEET 5 OF 6 SHEETS	SCALE 1:250 A1
REVISION DATE 12/07/2021	REVISION A
DISCIPLINE CODE	
DRAWING NO.	
ASC-SEWER-05-12.1	

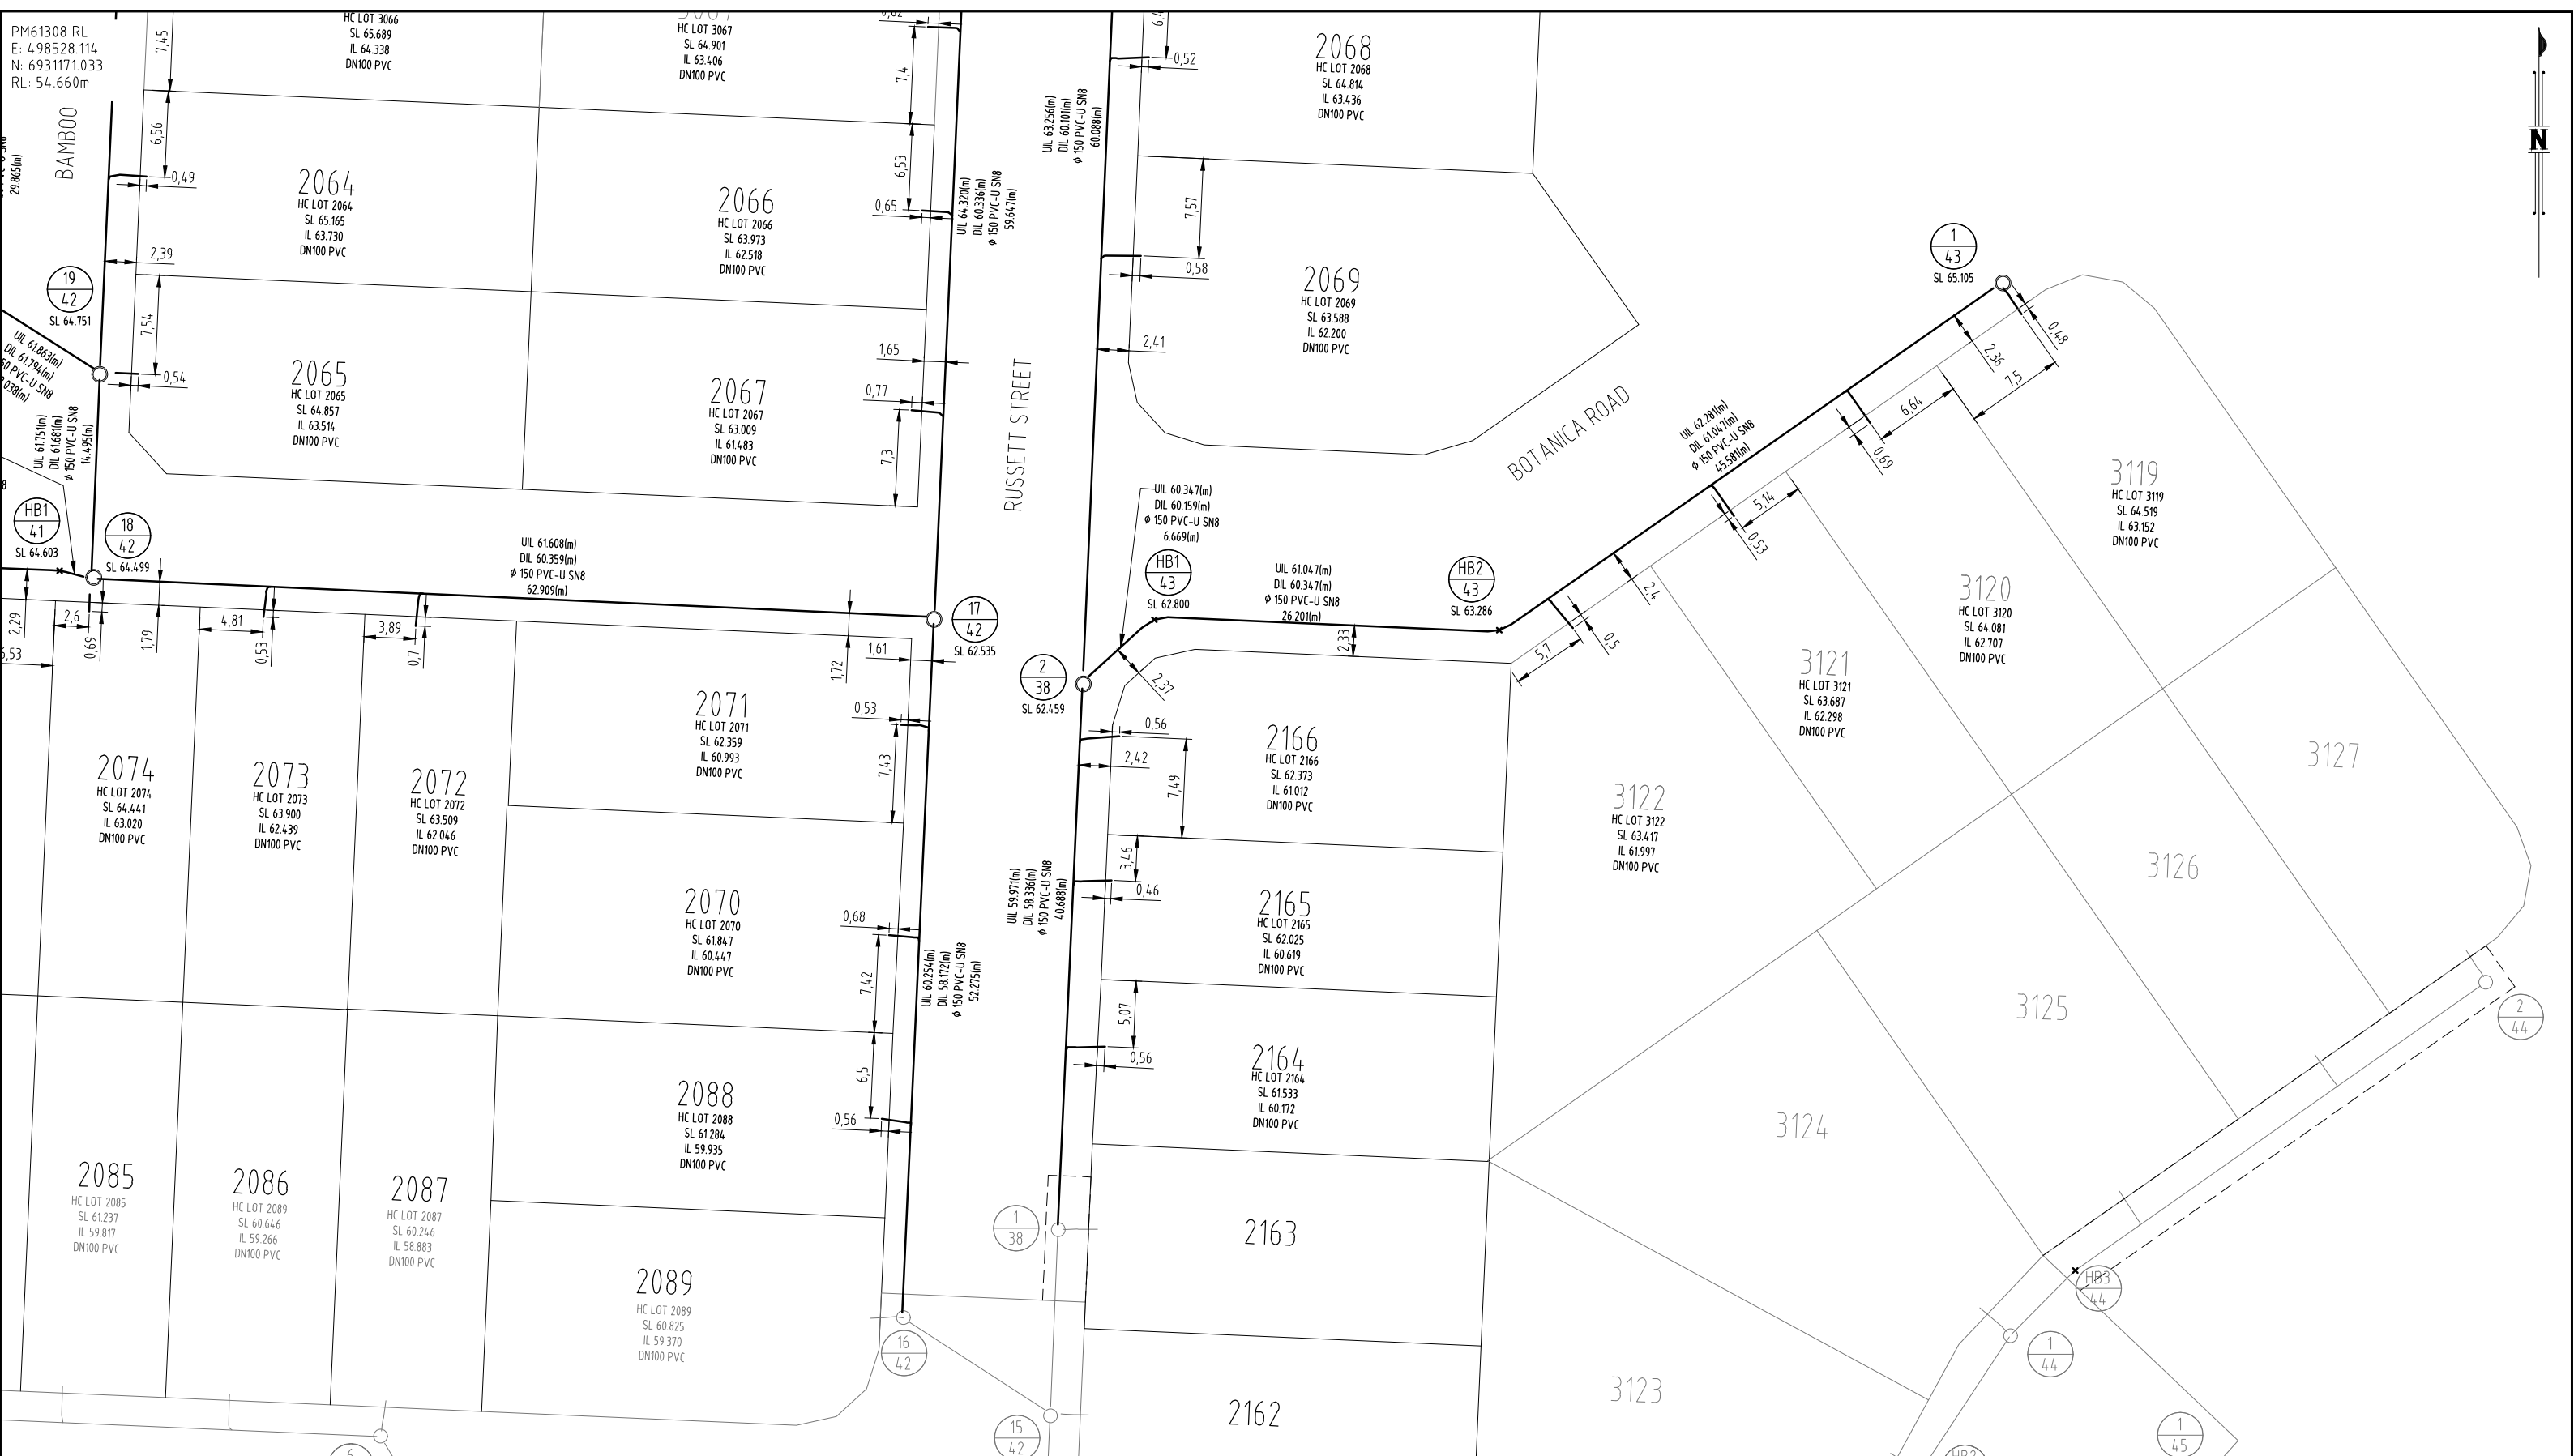

COORDINATE DATUM NOTE:
 HORIZONTAL COORDINATES(E,N) SUPPLIED ARE MAPPING GRID OF AUSTRALIA(MGA), ZONE 56 BASED ON THE UNIVERSAL TRANSVERSE MERCATOR PROJECTION AND THE GEOCENTRIC DATUM OF AUSTRALIA 1994.
 HORIZONTAL DATUM DERIVED FROM PSM 61308 E 4.98528.114 N 6931171.033.
 LEVELS SUPPLIED ARE ON THE AUSTRALIAN HEIGHT DATUM(AHD)
 LEVEL DATUM DERIVED FROM PSM 61308 RL54.660 (AHD)

REGISTERED SURVEYOR'S CERTIFICATION
 I, Gordon Nicholson, hereby certify that the vertical and horizontal locations and dimensions shown on this plan are a true and correct record and were located by survey.
 Registered Surveyor (sig.) [Signature] Reg. Surveyor No. SA 3405 Date: 16/11/2021

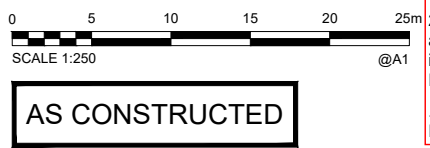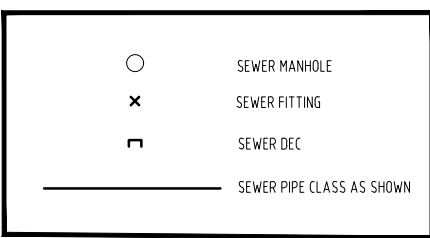

AS CONSTRUCTED CERTIFICATION
 I, Patrick Brady, hereby certify that:
 1. The information contained in this drawing/document is generally in compliance with approved drawings and design.
 2. To the best of my knowledge, this represents an accurate record of as constructed works and I accept the responsibility for the information contained in this drawing/document. Excluding Survey Error. [Signature] 7112 07/12/2021
 RPEQ No. Date.....
 RPEQ (Signature)

A1	A	16/11/2021	AS CONSTRUCTED	NJA	DAM	CW	DRAWN	CHECKED	PASSED	INITIALS	DATE
	INDEX	DATE	REVISIONS	DRAWN	CHECKED	PASSED					



LOGAN CITY COUNCIL
 MIRVAC MIR012-02
 AS CONSTRUCTED SURVEY - SEWER
 EVERLEIGH PRECINCT 12.2
 GREENBANK QLD

SHEET 5 OF 5 SHEETS	SCALE 1:250 A1
REVISION DATE 16/11/2021	REVISION A
DISCIPLINE CODE -	
DRAWING NO. ASC-SEWER-05-12.2	