


PM61308 RL
 E: 498528.114
 N: 6931171.033
 RL: 54.660m

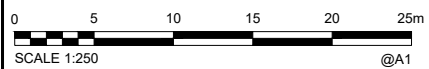

AS CONSTRUCTED	
	WATER METER BOX
	WATER REDUCER
	WATER BEND
	WATER TAPING BAND
	WATER BALL VALVE/STOP VALVE
	WATER FIRE HYDRANT
	WATERMAIN LINE (SIZE AND CLASS AS SHOWN)

AS CONSTRUCTED CERTIFICATION
 I, Patrick Brady hereby certify that:
 1. The information contained in this drawing/document is generally in compliance with approved drawings and design.
 2. To the best of my knowledge, this represents an accurate record of as constructed works and I accept the responsibility for the information contained in this drawing/document. Excluding Survey Error.
 Error: PK 7112 15/07/2022
 RPEQ No. _____ Date: _____
 RPEQ (Signature)

REGISTERED SURVEYOR'S CERTIFICATION
 I, Gordon Nicholson hereby certify that the vertical and horizontal locations and dimensions shown on this plan are a true and correct record and were located by survey.

 Registered Surveyor (sig.) Reg. Surveyor No. SA 3405 Date: 24/06/2022



COORDINATE DATUM NOTE:
 HORIZONTAL COORDINATES(E,N) SUPPLIED ARE MAPPING GRID OF AUSTRALIA(MGA), ZONE 56 BASED ON THE UNIVERSAL TRANSVERSE MERCATOR PROJECTION AND THE GEOCENTRIC DATUM OF AUSTRALIA 1994.
 HORIZONTAL DATUM DERIVED FROM PSM 61308 E 498528.114 N 6931171.033.
 LEVELS SUPPLIED ARE ON THE AUSTRALIAN HEIGHT DATUM(AHD)
 LEVEL DATUM DERIVED FROM PSM 61308 RL54.660 (AHD)

A1	INDEX	DATE	REVISIONS	DRAWN	CHECKED	PASSED	INITIALS	DATE
	A	24/06/2022	AS CONSTRUCTED	DAM	DAM	CW		
				DRAWN	CHECKED	PASSED		
				DAM	DAM	CW		




LOGAN CITY COUNCIL
 MIRVAC MIR001-04
 AS CONSTRUCTED SURVEY - WATERMAIN
 EVERLEIGH PRECINCT 9.2
 GREENBANK QLD

SHEET 1 OF 4 SHEETS	SCALE 1:250 A1
REVISION DATE 24/06/2022	REVISION A
DISCIPLINE CODE -	
DRAWING NO. ASC-WATER-01-9.2	



PM61308 RL
 E: 498528.114
 N: 6931171.033
 RL: 54.660m

AS CONSTRUCTED

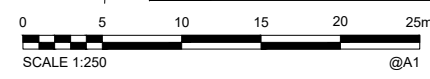

	WATER METER BOX
	WATER REDUCER
	WATER BEND
	WATER TAPING BAND
	WATER BALL VALVE/STOP VALVE
	WATER FIRE HYDRANT
	WATERMAIN LINE (SIZE AND CLASS AS SHOWN)

AS CONSTRUCTED CERTIFICATION
 I, Patrick Brady, hereby certify that:
 1. The information contained in this drawing/document is generally in compliance with approved drawings and design.
 2. To the best of my knowledge, this represents an accurate record of as constructed works and I accept the responsibility for the information contained in this drawing/document. Excluding Survey Error. 7112 15/07/2022
Patrick Brady RPEQ No. Date.....
 RPEQ (Signature)

REGISTERED SURVEYOR'S CERTIFICATION
 I, Gordon Nicholson, hereby certify that the vertical and horizontal locations and dimensions shown on this plan are a true and correct record and were located by survey.
Gordon Nicholson
 Registered Surveyor (sig.) Reg. Surveyor No. SA 3405 Date: 24/06/2022

COORDINATE DATUM NOTE:
 HORIZONTAL COORDINATES(E,N) SUPPLIED ARE MAPPING GRID OF AUSTRALIA(MGA), ZONE 56 BASED ON THE UNIVERSAL TRANSVERSE MERCATOR PROJECTION AND THE GEOCENTRIC DATUM OF AUSTRALIA 1994.
 HORIZONTAL DATUM DERIVED FROM PSM 61308 E 498528.114 N 6931171.033.
 LEVELS SUPPLIED ARE ON THE AUSTRALIAN HEIGHT DATUM(AHD) LEVEL DATUM DERIVED FROM PSM 61308 RL54.660 (AHD)


A1	INDEX	DATE	REVISIONS	DRAWN	CHECKED	PASSED	INITIALS	DATE
		24/06/2022	AS CONSTRUCTED	DAM	DAM	CW		24/06/2022

LOGAN CITY COUNCIL


MIRVAC MIR001-04
 AS CONSTRUCTED SURVEY - WATERMAIN
 EVERLEIGH PRECINCT 9.2
 GREENBANK QLD

SHEET 2 OF 4 SHEETS	SCALE 1:250 A1
REVISION DATE 24/06/2022	REVISION A
DISCIPLINE CODE	
DRAWING NO.	
ASC-WATER-02-9.2	

PM61308 RL
 E: 498528.114
 N: 6931171.033
 RL: 54.660m

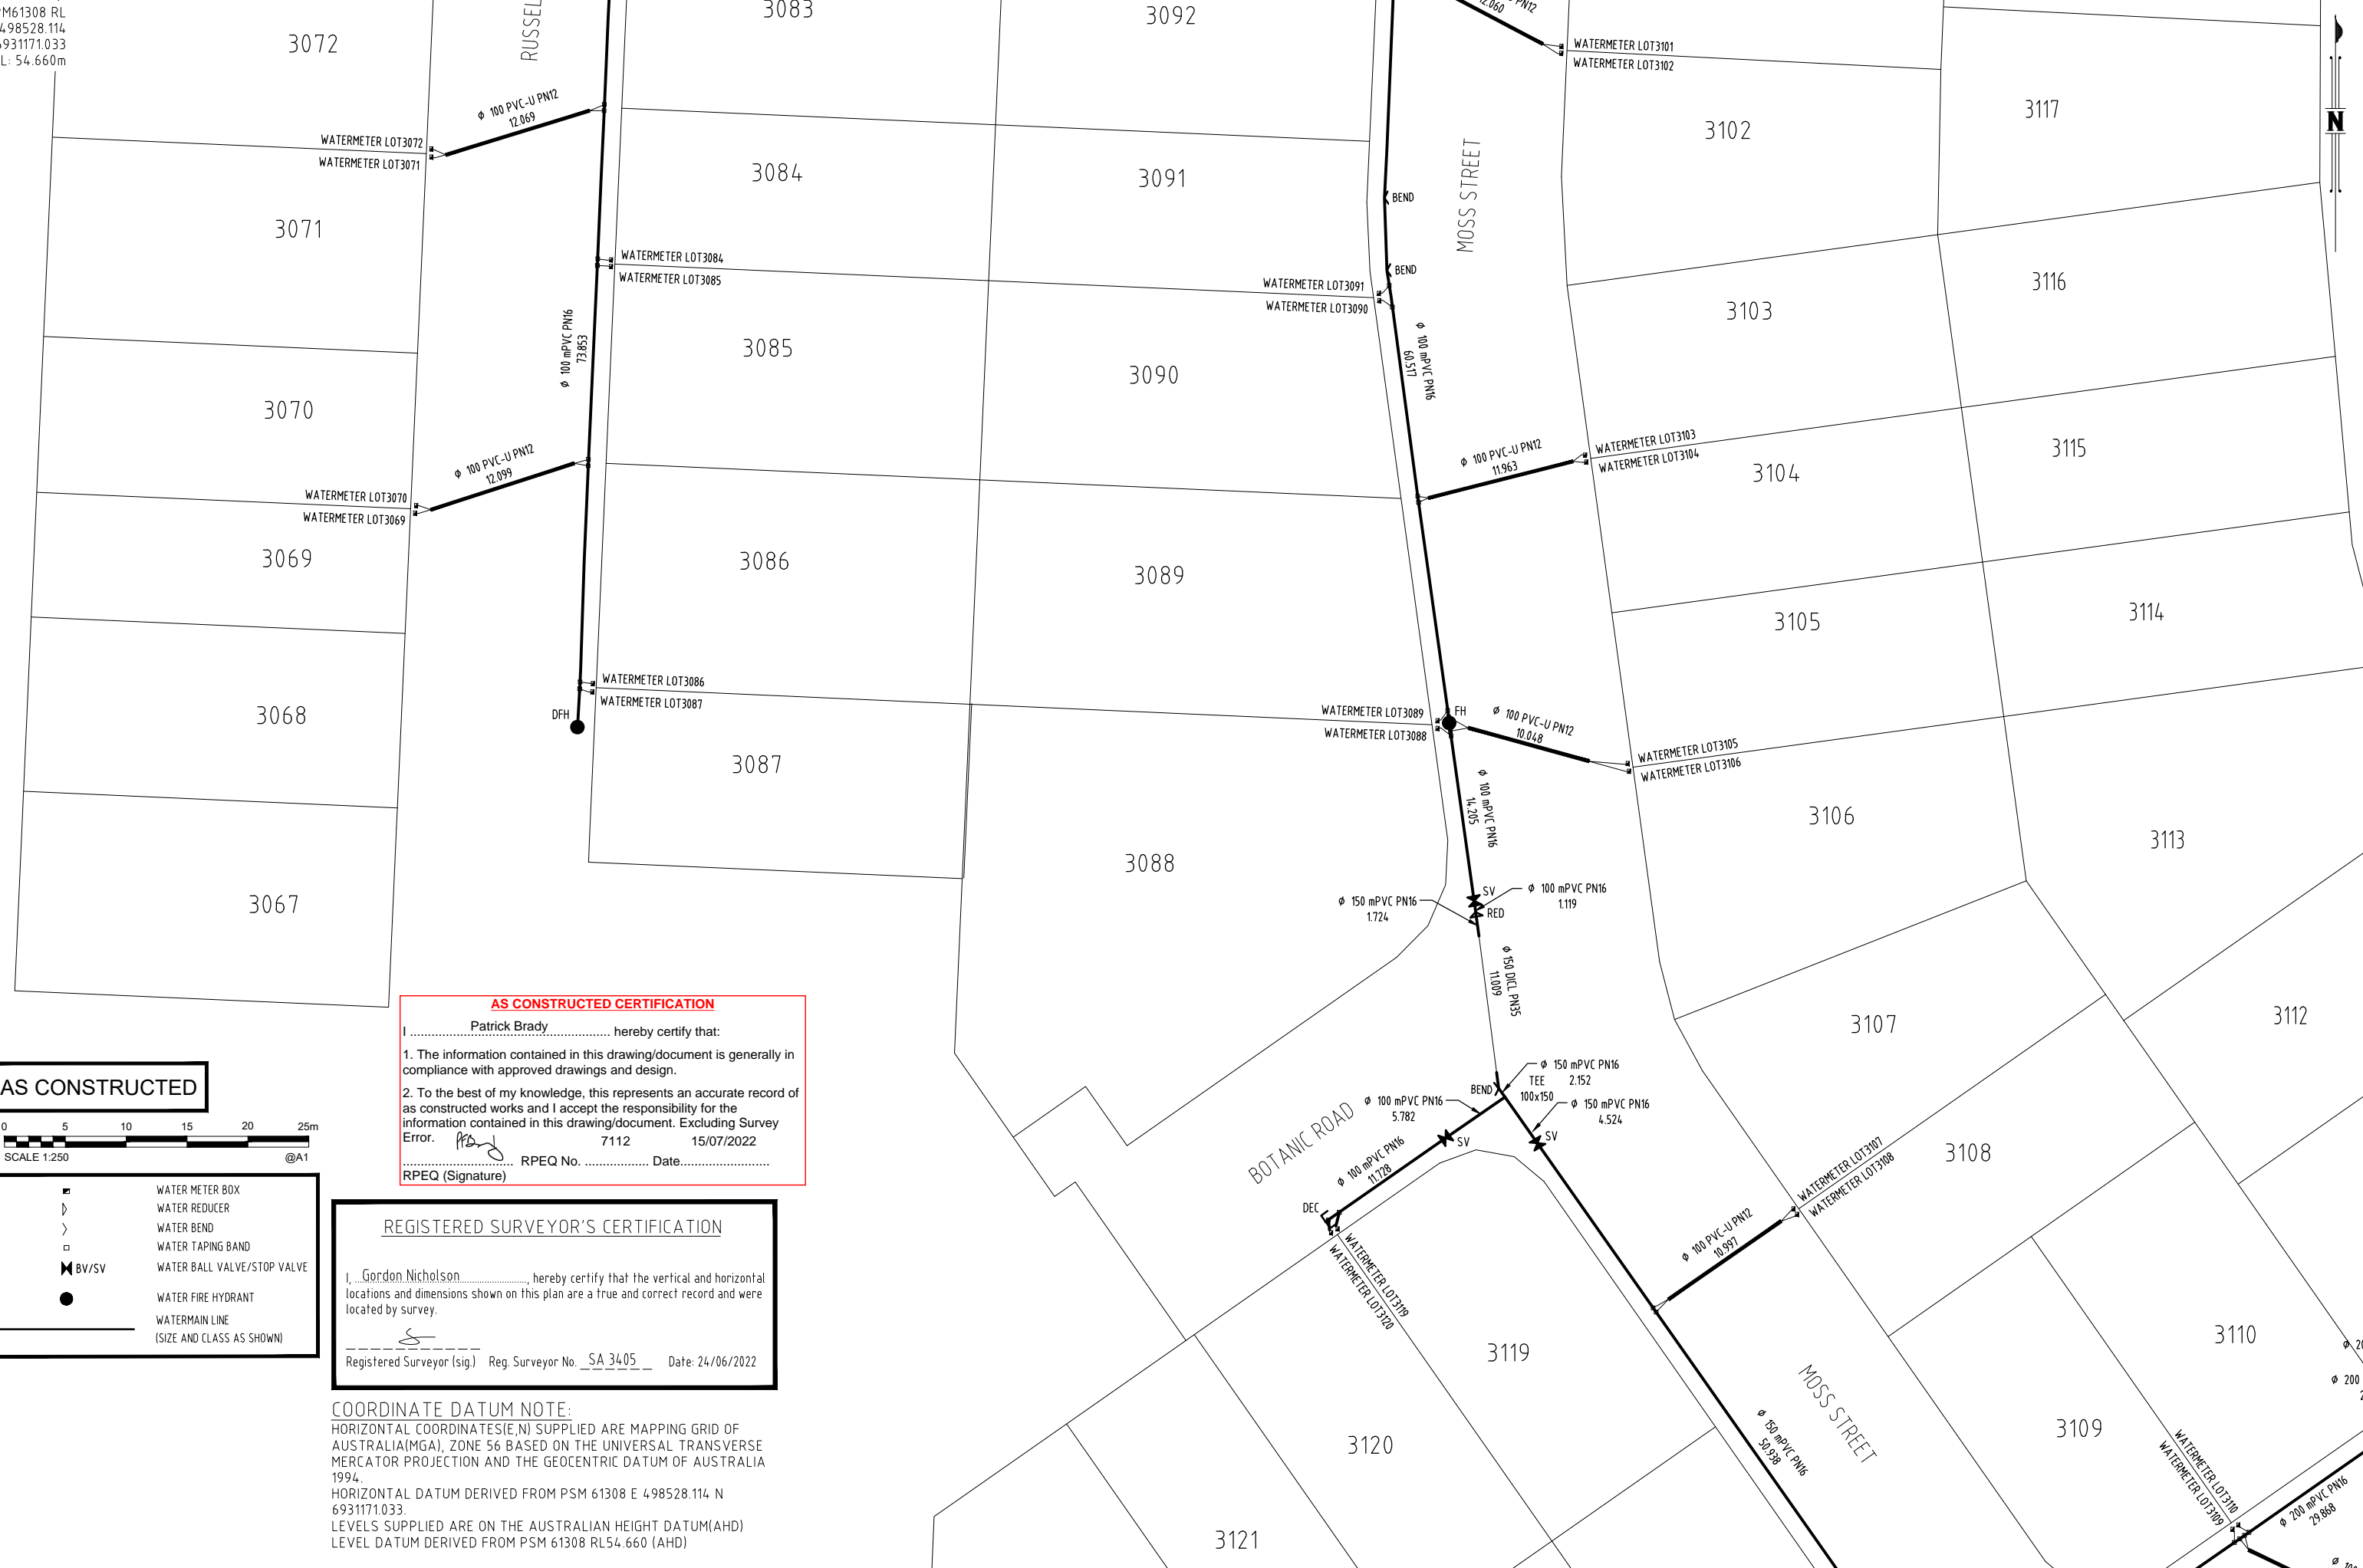

AS CONSTRUCTED

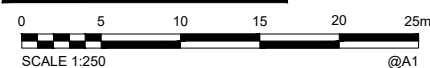

- WATER METER BOX
- WATER REDUCER
- WATER BEND
- WATER TAPING BAND
- WATER BALL VALVE/STOP VALVE
- WATER FIRE HYDRANT
- WATERMAIN LINE (SIZE AND CLASS AS SHOWN)

AS CONSTRUCTED CERTIFICATION

I, Patrick Brady, hereby certify that:

- The information contained in this drawing/document is generally in compliance with approved drawings and design.
- To the best of my knowledge, this represents an accurate record of as constructed works and I accept the responsibility for the information contained in this drawing/document. Excluding Survey Error.

7112 15/07/2022

..... RPEQ No. Date.....
 RPEQ (Signature)

REGISTERED SURVEYOR'S CERTIFICATION

I, Gordon Nicholson, hereby certify that the vertical and horizontal locations and dimensions shown on this plan are a true and correct record and were located by survey.

.....
 Registered Surveyor (sig.) Reg. Surveyor No. SA 3405 Date: 24/06/2022

COORDINATE DATUM NOTE:
 HORIZONTAL COORDINATES(E,N) SUPPLIED ARE MAPPING GRID OF AUSTRALIA(MGA), ZONE 56 BASED ON THE UNIVERSAL TRANSVERSE MERCATOR PROJECTION AND THE GEOCENTRIC DATUM OF AUSTRALIA 1994.
 HORIZONTAL DATUM DERIVED FROM PSM 61308 E 498528.114 N 6931171.033.
 LEVELS SUPPLIED ARE ON THE AUSTRALIAN HEIGHT DATUM(AHD)
 LEVEL DATUM DERIVED FROM PSM 61308 RL54.660 (AHD)

A1	INDEX	DATE	REVISIONS	DRAWN	CHECKED	PASSED	INITIALS	DATE
	A	24/06/2022	AS CONSTRUCTED	DC	DAM	CW		
				DRAWN	CHECKED	PASSED		
				DRAWN	CHECKED	PASSED		



LOGAN CITY COUNCIL

MIRVAC MIR001-04
 AS CONSTRUCTED SURVEY - WATERMAIN
 EVERLEIGH PRECINCT 9.2
 GREENBANK QLD

SHEET 3 OF 4 SHEETS	SCALE 1:250 A1
REVISION DATE 24/06/2022	REVISION A
DISCIPLINE CODE	
DRAWING NO.	
ASC-WATER-03-9.2	



AS CONSTRUCTED	
	WATER METER BOX
	WATER REDUCER
	WATER BEND
	WATER TAPING BAND
	WATER BALL VALVE/STOP VALVE
	WATER FIRE HYDRANT
	WATERMAIN LINE (SIZE AND CLASS AS SHOWN)

AS CONSTRUCTED CERTIFICATION

I, Patrick Brady, hereby certify that:

- The information contained in this drawing/document is generally in compliance with approved drawings and design.
- To the best of my knowledge, this represents an accurate record of as constructed works and I accept the responsibility for the information contained in this drawing/document. Excluding Survey Error.

RPEQ No. 7112 Date: 14/06/2022
 RPEQ (Signature)

REGISTERED SURVEYOR'S CERTIFICATION

I, Gordon Nicholson, hereby certify that the vertical and horizontal locations and dimensions shown on this plan are a true and correct record and were located by survey.

Registered Surveyor (sig.) Reg. Surveyor No. SA 3405 Date: 27/01/2022

COORDINATE DATUM NOTE:
 HORIZONTAL COORDINATES(E,N) SUPPLIED ARE MAPPING GRID OF AUSTRALIA(MGA), ZONE 56 BASED ON THE UNIVERSAL TRANSVERSE MERCATOR PROJECTION AND THE GEOCENTRIC DATUM OF AUSTRALIA 1994.
 HORIZONTAL DATUM DERIVED FROM PSM 61308 E 4.98528.114 N 6931171.033.
 LEVELS SUPPLIED ARE ON THE AUSTRALIAN HEIGHT DATUM(AHD)
 LEVEL DATUM DERIVED FROM PSM 61308 RL54.660 (AHD)

A1	INDEX	DATE	REVISIONS	DRAWN	CHECKED	PASSED	INITIALS	DATE
	A	27/01/2022	AS CONSTRUCTED	DC	DAM	CW		27/01/2022


20 Shadforth Lane, Forest Glen QLD 4086
 Ph: 07 5498 3300 Fax: 07 5498 3300 Email: info@shadforth.com.au

LOGAN CITY COUNCIL

MIRVAC MIR001-04
 AS CONSTRUCTED SURVEY - WATERMAIN
 EVERLEIGH PRECINCT 9.1
 GREENBANK QLD

SHEET 3 OF 5 SHEETS	SCALE 1:250 A1
REVISION DATE 27/01/2022	REVISION A
DISCIPLINE CODE -	
DRAWING NO. ASC-WATERMAIN-03-9.1	

PM61308 RL
 E: 4.98528.114
 N: 6931171.033
 RL: 54.660m

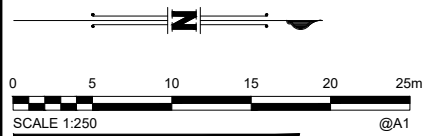

AS CONSTRUCTED

- WATER METER
- WATER REDUCER
- WATER BEND
- WATER TAPING BAND
- WATER BALL VALVE/STOP VALVE
- WATER FIRE HYDRANT
- WATERMAIN LINE (SIZE AND CLASS AS SHOWN)

AS CONSTRUCTED CERTIFICATION

I, Patrick Brady hereby certify that:

- The information contained in this drawing/document is generally in compliance with approved drawings and design.
- To the best of my knowledge, this represents an accurate record of as constructed works and I accept the responsibility for the information contained in this drawing/document. Excluding Survey Error.

7112 02/08/2021

RPEQ No. _____ Date _____

RPEQ (Signature) _____

REGISTERED SURVEYOR'S CERTIFICATION

I, Gordon Nicholson hereby certify that the vertical and horizontal locations and dimensions shown on this plan are a true and correct record and were located by survey.

Registered Surveyor (sig.) Reg. Surveyor No. SA 34.05 Date: 21/06/2021

COORDINATE DATUM NOTE:
 HORIZONTAL COORDINATES(E,N) SUPPLIED ARE MAPPING GRID OF AUSTRALIA(MGA), ZONE 56 BASED ON THE UNIVERSAL TRANSVERSE MERCATOR PROJECTION AND THE GEOCENTRIC DATUM OF AUSTRALIA 1994.
 HORIZONTAL DATUM DERIVED FROM PSM 61308 E 4.98528.114 N 6931171.033.
 LEVELS SUPPLIED ARE ON THE AUSTRALIAN HEIGHT DATUM(AHD)
 LEVEL DATUM DERIVED FROM PSM 61308 RL54.660 (AHD)

A1	INDEX	DATE	REVISIONS	DRAWN	CHECKED	PASSED	INITIALS	DATE
	A	21/06/2021	AS CONSTRUCTED	NJA	DAM	CW		

shadforth

58 Shadforth Lane, Forest Glen QLD 4086
 07 5438 2000 • 07 5438 2088 • shadforth@shadforth.com.au

LOGAN
CITY COUNCIL

LOGAN CITY COUNCIL

MIRVAC MIR001-04
 AS CONSTRUCTED SURVEY - WATERMAIN
 EVERLEIGH PRECINCT 12.1
 GREENBANK QLD

SHEET 4 OF 4 SHEETS	SCALE 1:250 A1
REVISION DATE 21/06/2021	REVISION A
DISCIPLINE CODE -	
DRAWING NO. ASC-WATERMAIN-04-12.1	