




AS CONSTRUCTED

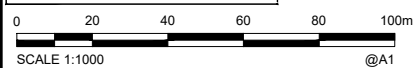

COORDINATE DATUM NOTE:
 HORIZONTAL COORDINATES(E,N) SUPPLIED ARE MAPPING GRID OF AUSTRALIA(MGA), ZONE 56 BASED ON THE UNIVERSAL TRANSVERSE MERCATOR PROJECTION AND THE GEOCENTRIC DATUM OF AUSTRALIA 1994.
 HORIZONTAL DATUM DERIVED FROM PSM 61308 E 4 98528 114 N 6931171.033
 LEVELS SUPPLIED ARE ON THE AUSTRALIAN HEIGHT DATUM(AHD) LEVEL DATUM DERIVED FROM PSM 61308 RLS4.660 (AHD)

PAVEMENT DESIGN		
TUSCAN CIRCUIT AC(mm)- 35 BASE(2.1)(mm) - 150 SUBBASE(2.3)(mm) - 150	OCHRE CIRCUIT AC(mm)- 35 BASE(2.1)(mm) - 150 SUBBASE(2.3)(mm) - 150	DESERT ROAD AC(mm)- 35 BASE(2.1)(mm) - 150 SUBBASE(2.3)(mm) - 150
COPPER CRESCENT AC(mm)- 35 BASE(2.1)(mm) - 150 SUBBASE(2.3)(mm) - 150		

RETAINING WALLS	SPOT HEIGHTS + 56.36
ACCOUSTIC WALLS	WALL HEIGHTS 56.600 55.524

ENGINEER'S CERTIFICATION
 I, _____, hereby certify that:
 1. The information contained in this drawing / document is in compliance with approved drawings and design.
 2. This represents an accurate record of as-constructed works
 3. I accept responsibility for the information contained in this drawing / document.
 RPEQ (signature) RPEQ No. _____ Date: _____

REGISTERED SURVEYING ASSOCIATE CERTIFICATION
 I, Gordon Nicholson, hereby certify that the vertical and horizontal locations and dimensions shown on this plan are a true and correct record and were located by survey.
 Registered Surveying Associate (sig.)
 Surveyor No. SA 3405 Date: 03/05/2023

A1									
	A	03/05/2023	AS CONSTRUCTED		RDE	DAM	CW		
	INDEX	DATE	REVISIONS	DRAWN	CHECKED	PASSED	INITIALS	DATE	

shadforth
 99 Sandstone Lane, Forest Glen QLD 4055
 04754093000 > 04754093000 > 04754093000




LOGAN CITY COUNCIL
 MIRVAC MIR009-04
 AS CONSTRUCTED SURVEY - ROADS AND EARTHWORKS
 EVERLEIGH PRECINCT 9.4C
 GREENBANK QLD

SHEET 1 OF 4 SHEETS	SCALE 1:1000 A1
REVISION DATE 03/05/2023	REVISION A
DISCIPLINE CODE -	
DRAWING NO. ASC-RDS AND EWKS-01-9.4C	



AS CONSTRUCTED

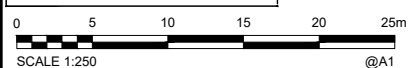

COORDINATE DATUM NOTE:
 HORIZONTAL COORDINATES (N) SUPPLIED ARE MAPPING GRID OF AUSTRALIA (MGA), ZONE 56 BASED ON THE UNIVERSAL TRANSVERSE MERCATOR PROJECTION AND THE GEOCENTRIC DATUM OF AUSTRALIA 1994.
 HORIZONTAL DATUM DERIVED FROM PSM 61308 E 4 98528 114 N 6931171.033.
 LEVELS SUPPLIED ARE ON THE AUSTRALIAN HEIGHT DATUM (AHD) LEVEL DATUM DERIVED FROM PSM 61308 RL54.660 (AHD)

TUSCAN CIRCUIT
 AC(mm) - 35
 BASE(2.1)(mm) - 150
 SUBBASE(2.3)(mm) - 150

OCHRE CIRCUIT
 AC(mm) - 35
 BASE(2.1)(mm) - 150
 SUBBASE(2.3)(mm) - 150

DESERT ROAD
 AC(mm) - 35
 BASE(2.1)(mm) - 150
 SUBBASE(2.3)(mm) - 150

COPPER CRESCENT
 AC(mm) - 35
 BASE(2.1)(mm) - 150
 SUBBASE(2.3)(mm) - 150

PAVEMENT DESIGN

RETAINING WALLS
 ACQUSTIC WALLS

SPOT HEIGHTS + 56.36
 WALL HEIGHTS 55.524

ENGINEER'S CERTIFICATION

I, _____, hereby certify that:
 1. The information contained in this drawing / document is in compliance with approved drawings and design.
 2. This represents an accurate record of as-constructed works
 3. I accept responsibility for the information contained in this drawing / document.

RPEQ (signature) RPEQ No. _____ Date: _____

REGISTERED SURVEYING ASSOCIATE CERTIFICATION

I, Gordon Nicholson, hereby certify that the vertical and horizontal locations and dimensions shown on this plan are a true and correct record and were located by survey.

Registered Surveying Associate (sig)
 Surveyor No. SA 3405 Date: 03/05/2023


A1	INDEX	DATE	AS CONSTRUCTED	REVISIONS	DRAWN	CHECKED	PASSED	INITIALS	DATE
	A	03/05/2023	AS CONSTRUCTED		RDE	DAM	CW		03/05/2023



LOGAN CITY COUNCIL

MIRVAC MIR009-04
 AS CONSTRUCTED SURVEY - ROADS AND EARTHWORKS
 EVERLEIGH PRECINCT 9.4C
 GREENBANK QLD

SHEET 2 OF 4 SHEETS	SCALE 1:250 A1
REVISION DATE 03/05/2023	REVISION A
DISCIPLINE CODE -	
DRAWING NO. ASC-RDS AND EWKS-02-9.4C	

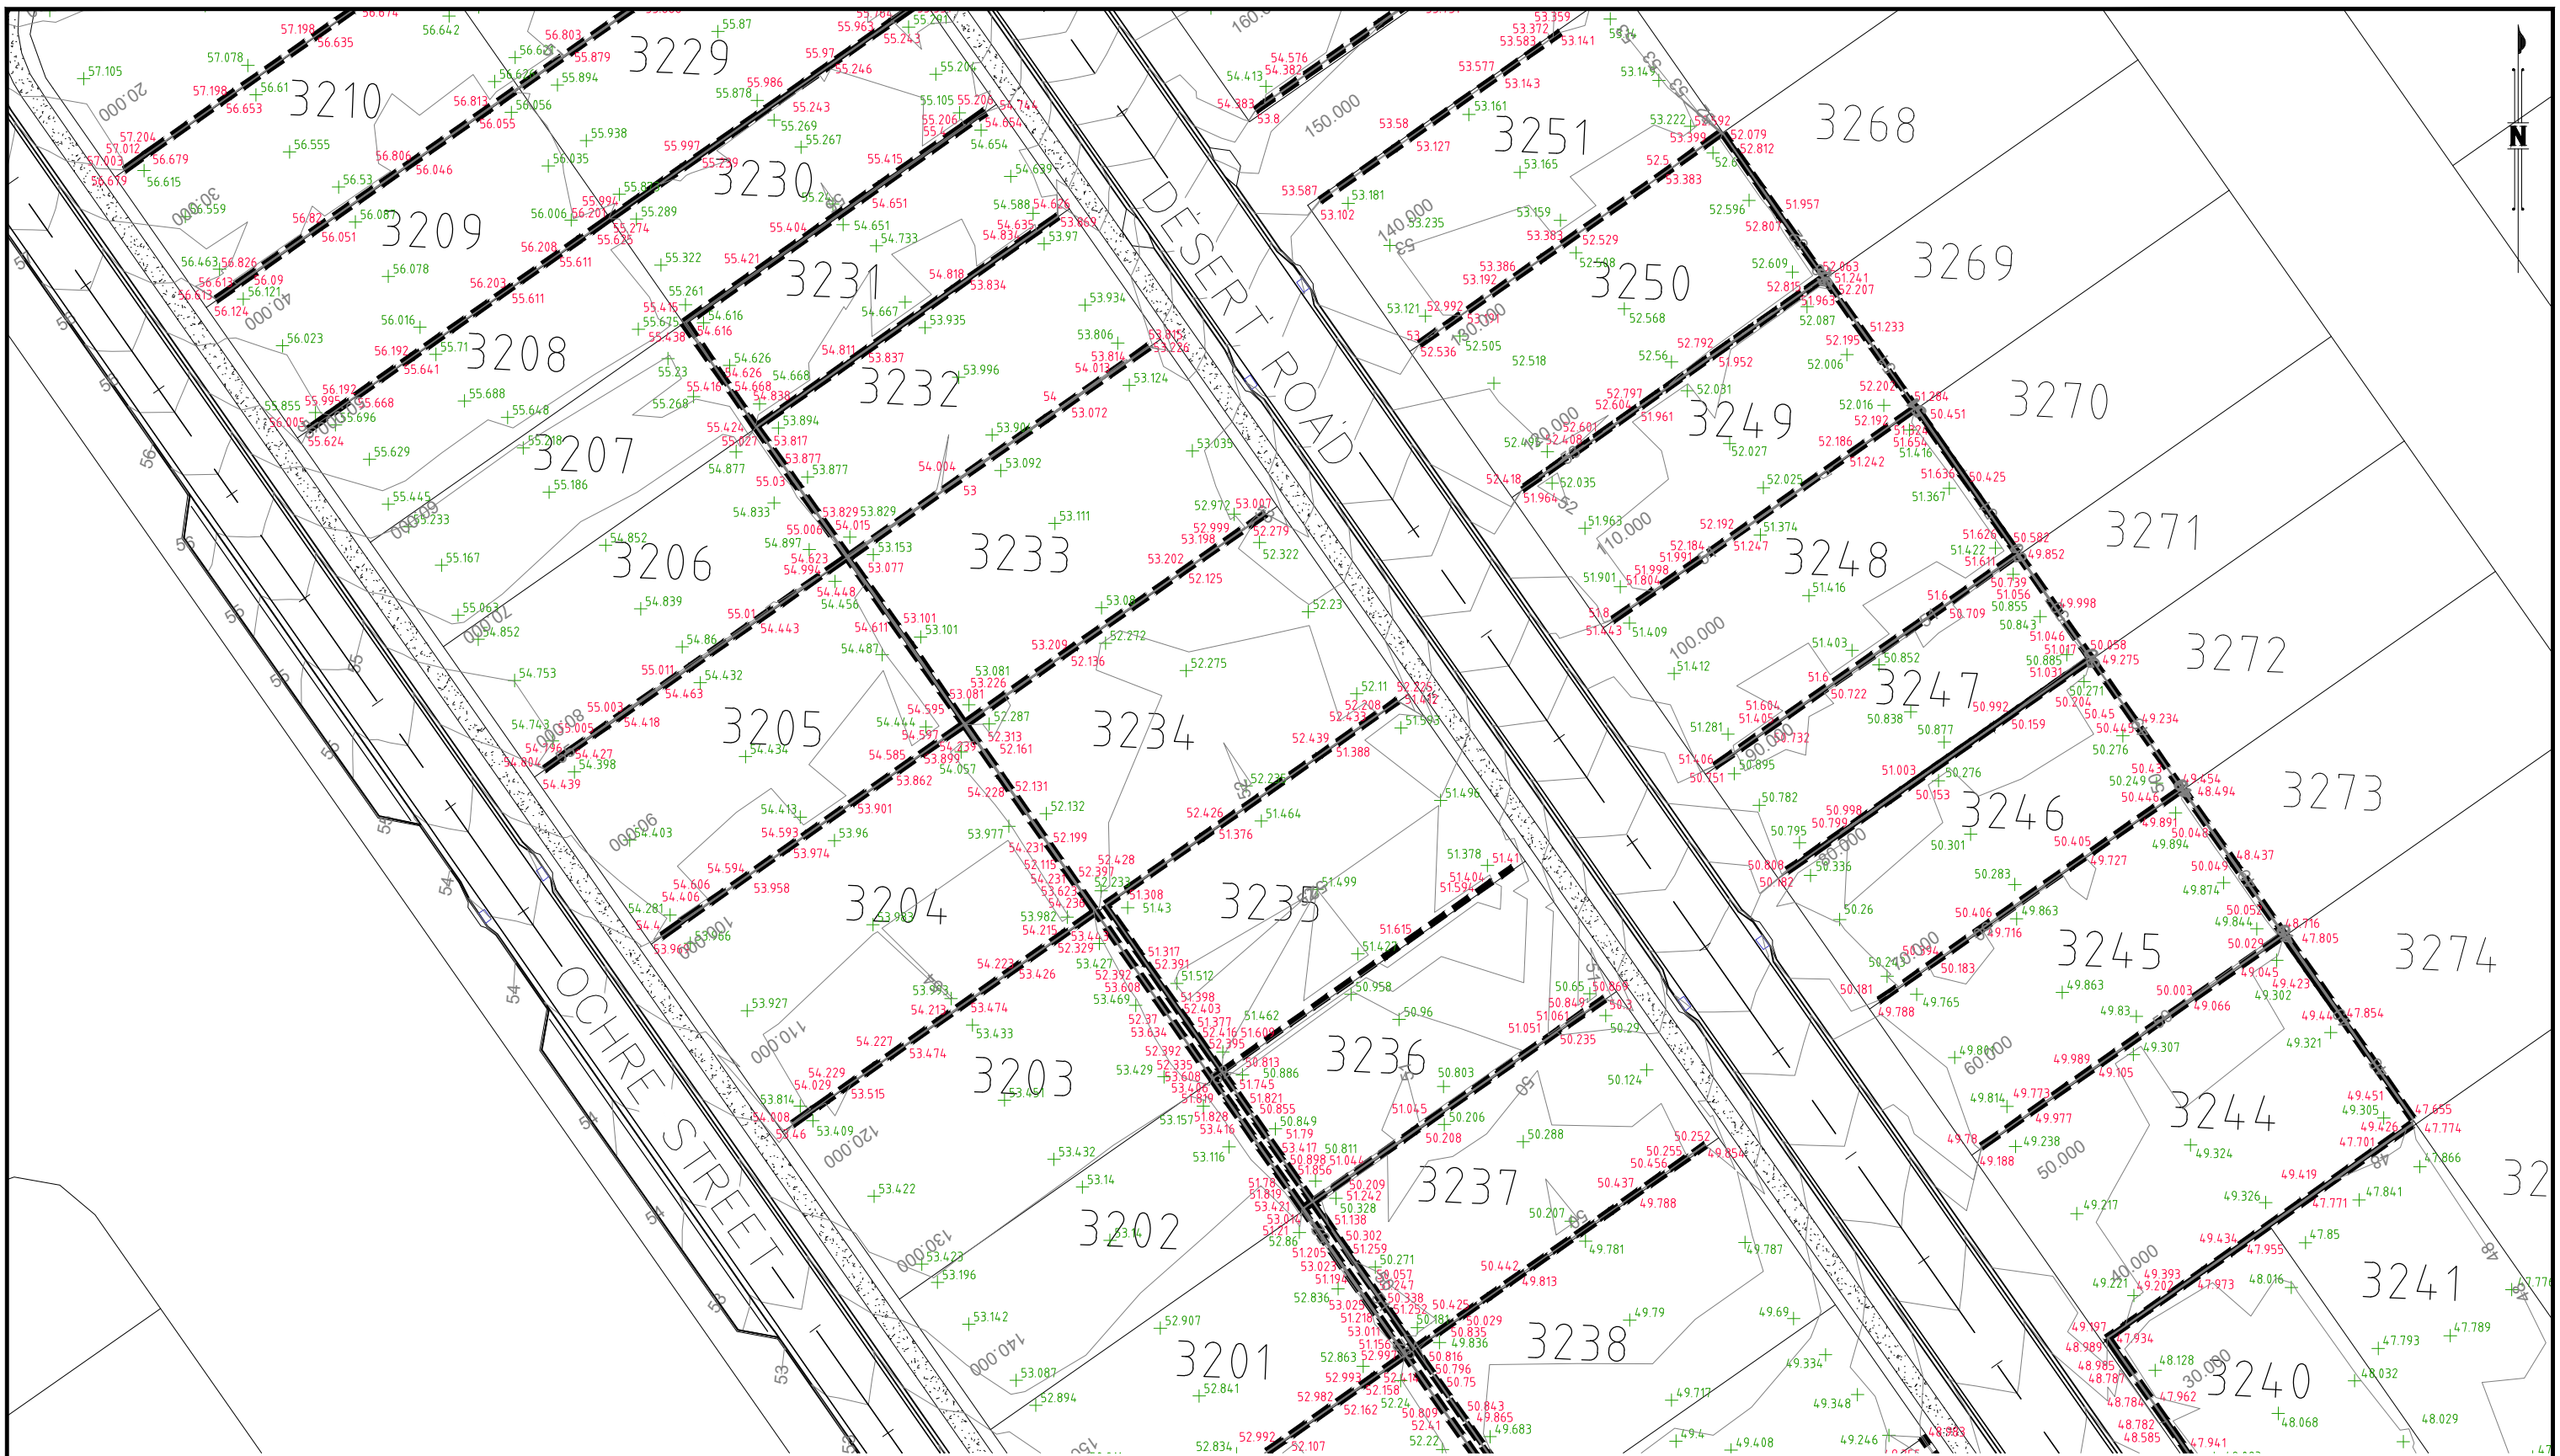

AS CONSTRUCTED



COORDINATE DATUM NOTE:
 HORIZONTAL COORDINATES (E,N) SUPPLIED ARE MAPPING GRID OF AUSTRALIA (MGA), ZONE 56 BASED ON THE UNIVERSAL TRANSVERSE MERCATOR PROJECTION AND THE GEOCENTRIC DATUM OF AUSTRALIA 1994.
 HORIZONTAL DATUM DERIVED FROM PSM 61308 E 498528 114 N 6931171.033
 LEVELS SUPPLIED ARE ON THE AUSTRALIAN HEIGHT DATUM (AHD) LEVEL DATUM DERIVED FROM PSM 61308 RL54.660 (AHD)

PAVEMENT DESIGN

TUSCAN CIRCUIT AC(mm)- 35 BASE(2.1)(mm) - 150 SUBBASE(2.3)(mm) - 150	OCHRE CIRCUIT AC(mm)- 35 BASE(2.1)(mm) - 150 SUBBASE(2.3)(mm) - 150	DESERT ROAD AC(mm)- 35 BASE(2.1)(mm) - 150 SUBBASE(2.3)(mm) - 150
COPPER CRESCENT AC(mm)- 35 BASE(2.1)(mm) - 150 SUBBASE(2.3)(mm) - 150		

RETAINING WALLS
ACCOUSTIC WALLS

SPOT HEIGHTS
+ 56.36
WALL HEIGHTS
56.600
55.524

ENGINEER'S CERTIFICATION

I, _____, hereby certify that:
 1. The information contained in this drawing / document is in compliance with approved drawings and design.
 2. This represents an accurate record of as-constructed works
 3. I accept responsibility for the information contained in this drawing / document.

RPEQ (signature) RPEQ No. _____ Date: _____

REGISTERED SURVEYING ASSOCIATE CERTIFICATION

I, Gordon Nicholson, hereby certify that the vertical and horizontal locations and dimensions shown on this plan are a true and correct record and were located by survey.

Registered Surveying Associate (sig.) _____
 Surveyor No. SA 3405 Date: 03/05/2023



A1	INDEX	DATE	AS CONSTRUCTED	REVISIONS	DRAWN	CHECKED	PASSED	INITIALS	DATE
	A	03/05/2023	AS CONSTRUCTED		RDE	DAM	CW		03/05/2023



LOGAN CITY COUNCIL

MIRVAC MIR009-04
 AS CONSTRUCTED SURVEY - ROADS AND EARTHWORKS
 EVERLEIGH PRECINCT 94C
 GREENBANK QLD

SHEET 3 OF 4 SHEETS	SCALE 1:250 A1
REVISION DATE 03/05/2023	REVISION A
DISCIPLINE CODE -	
DRAWING NO. ASC-RDS AND EWKS-03-9.4C	

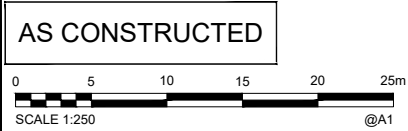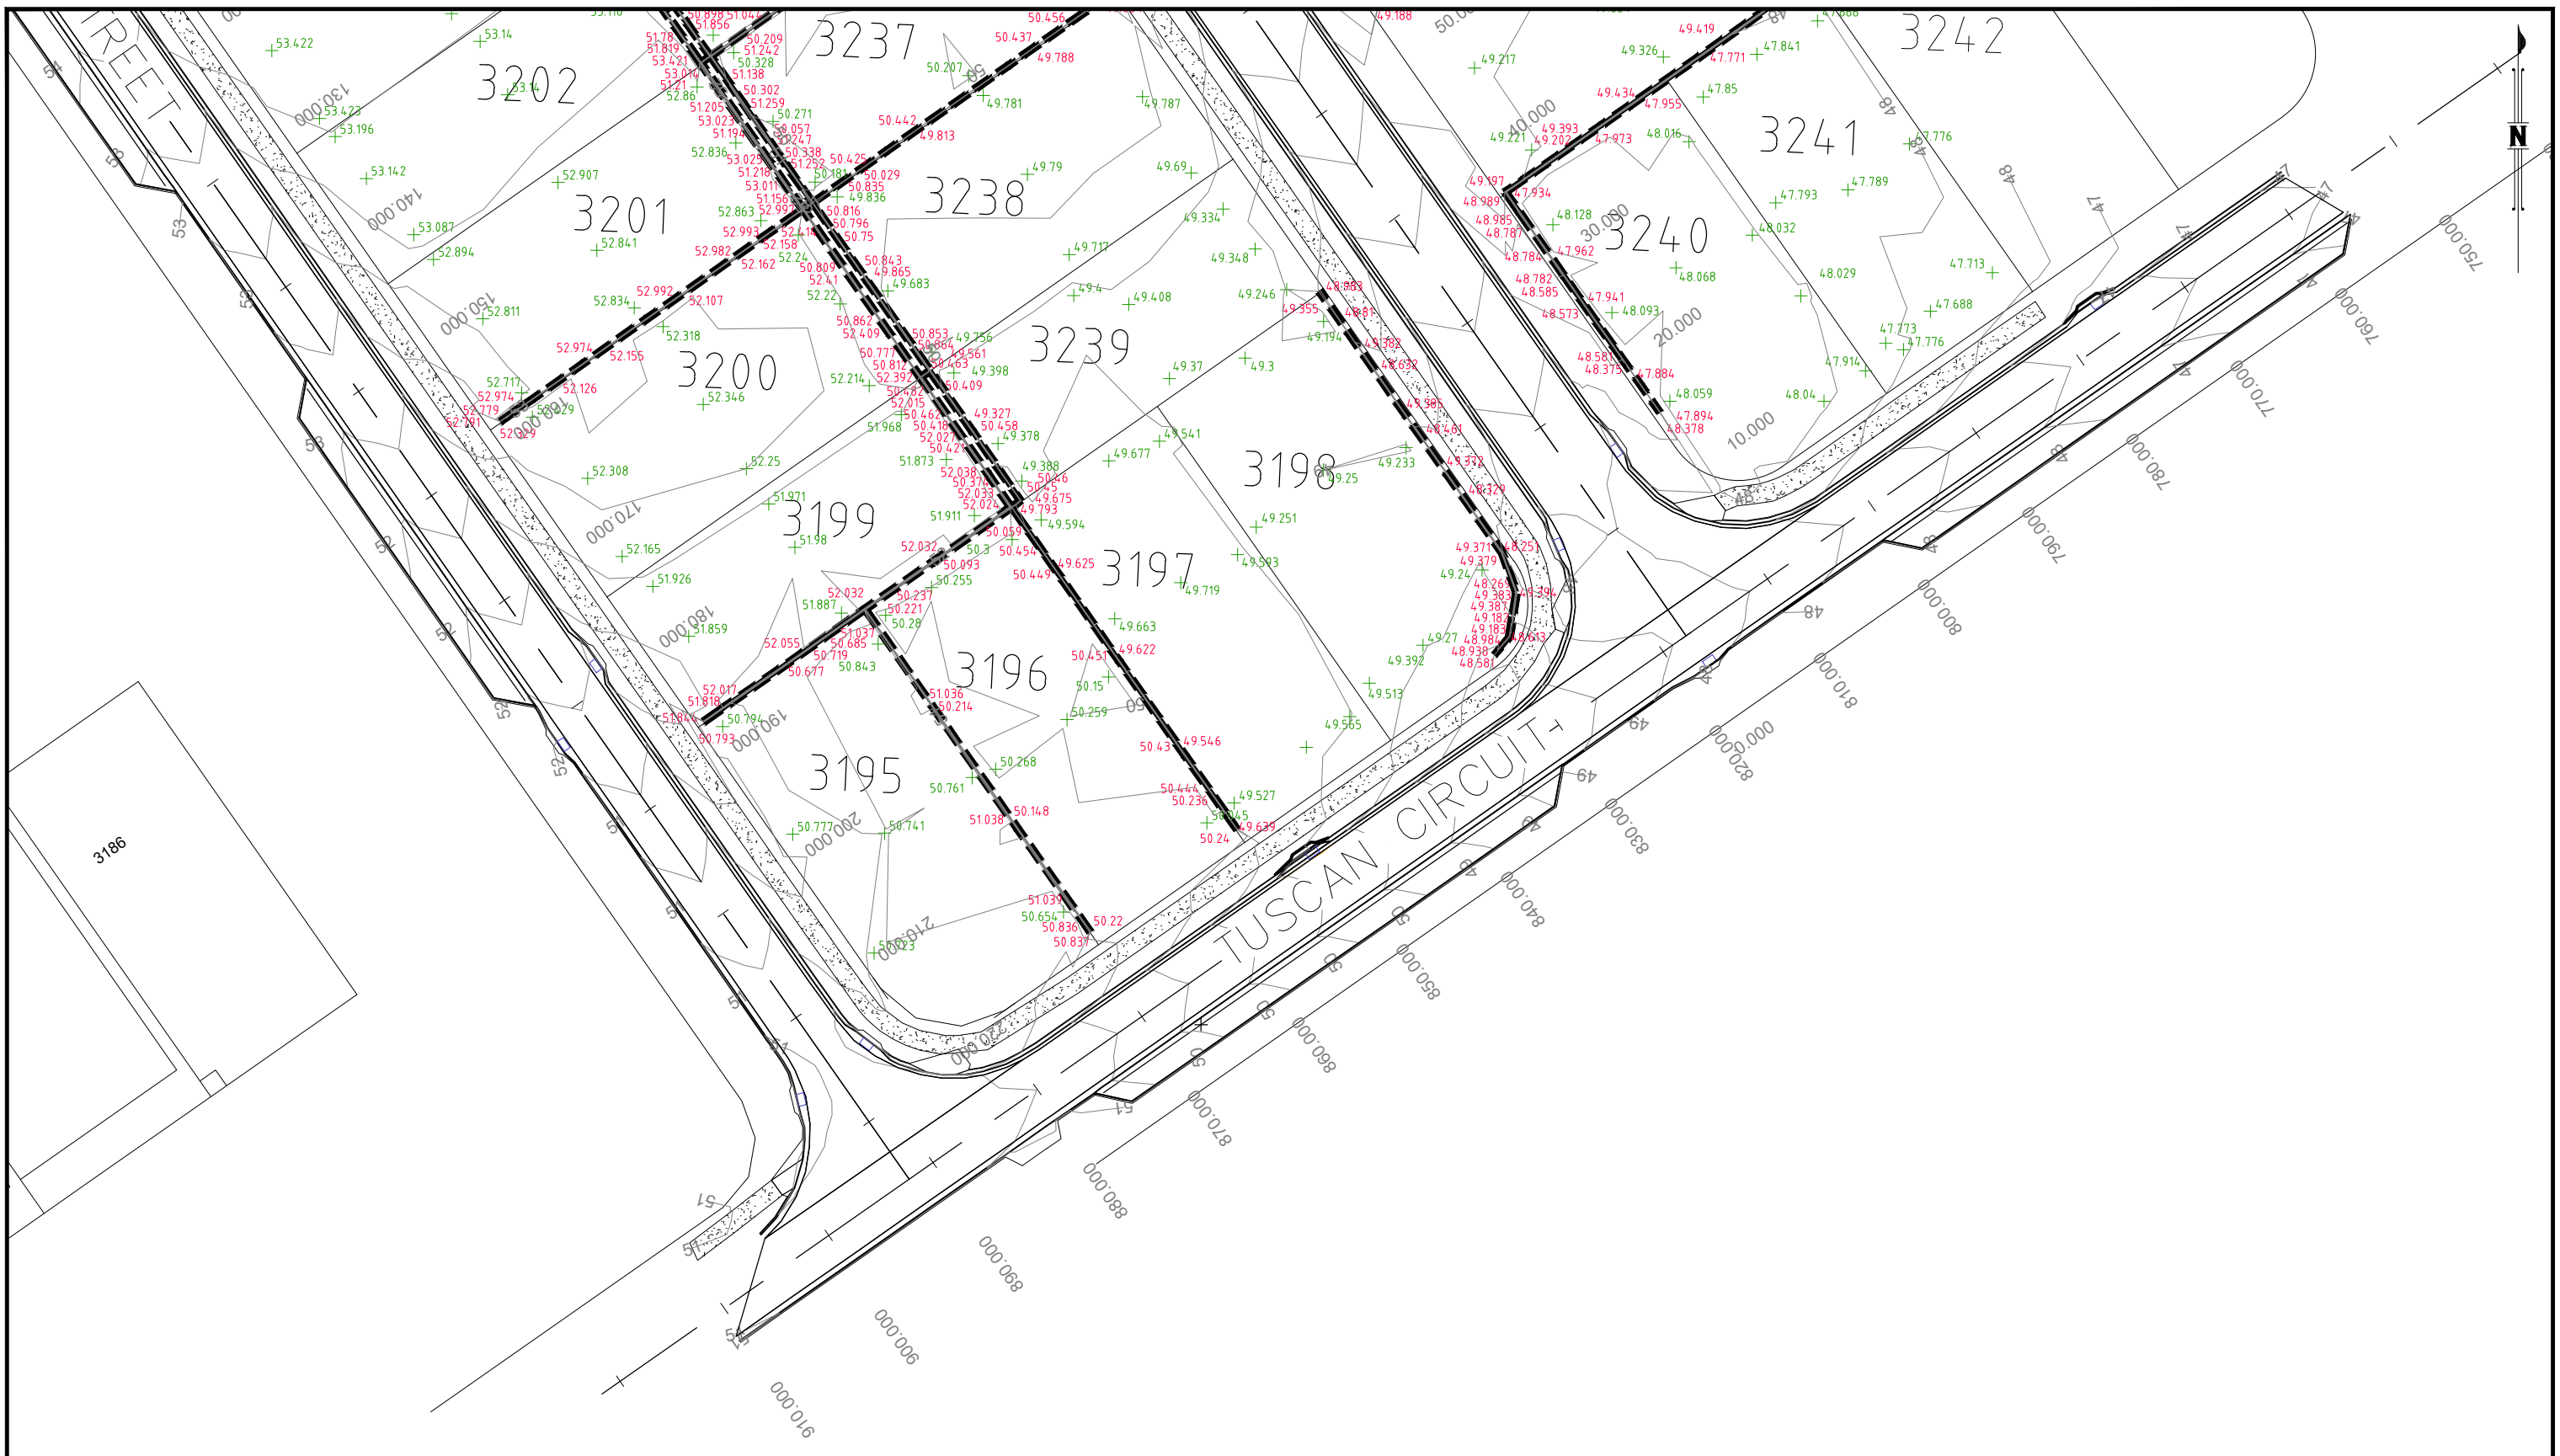

COORDINATE DATUM NOTE:

HORIZONTAL COORDINATES (N) SUPPLIED ARE MAPPING GRID OF AUSTRALIA (MGA), ZONE 56 BASED ON THE UNIVERSAL TRANSVERSE MERCATOR PROJECTION AND THE GEOCENTRIC DATUM OF AUSTRALIA 1994.

HORIZONTAL DATUM DERIVED FROM PSM 61308 E 498528 114 N 6931171.033

LEVELS SUPPLIED ARE ON THE AUSTRALIAN HEIGHT DATUM (AHD) LEVEL DATUM DERIVED FROM PSM 61308 RL54.660 (AHD)

TUSCAN CIRCUIT			OCHRE CIRCUIT			DESERT ROAD		
AC(mm)- 35	AC(mm)- 35	AC(mm)- 35	AC(mm)- 35	AC(mm)- 35	AC(mm)- 35	AC(mm)- 35	AC(mm)- 35	AC(mm)- 35
BASE(2.1)(mm) - 150	BASE(2.1)(mm) - 150	BASE(2.1)(mm) - 150	BASE(2.1)(mm) - 150	BASE(2.1)(mm) - 150	BASE(2.1)(mm) - 150	BASE(2.1)(mm) - 150	BASE(2.1)(mm) - 150	BASE(2.1)(mm) - 150
SUBBASE(2.3)(mm) - 150	SUBBASE(2.3)(mm) - 150	SUBBASE(2.3)(mm) - 150	SUBBASE(2.3)(mm) - 150	SUBBASE(2.3)(mm) - 150	SUBBASE(2.3)(mm) - 150	SUBBASE(2.3)(mm) - 150	SUBBASE(2.3)(mm) - 150	SUBBASE(2.3)(mm) - 150

COPPER CRESCENT		
AC(mm)- 35	AC(mm)- 35	AC(mm)- 35
BASE(2.1)(mm) - 150	BASE(2.1)(mm) - 150	BASE(2.1)(mm) - 150
SUBBASE(2.3)(mm) - 150	SUBBASE(2.3)(mm) - 150	SUBBASE(2.3)(mm) - 150

PAVEMENT DESIGN	
RETAINING WALLS	SPOT HEIGHTS
ACCOUSTIC WALLS	+ 56.36
	WALL HEIGHTS
	55.524

ENGINEER'S CERTIFICATION

I, _____, hereby certify that:

- The information contained in this drawing / document is in compliance with approved drawings and design.
- This represents an accurate record of as-constructed works
- I accept responsibility for the information contained in this drawing / document.

RPEQ (signature) RPEQ No. _____ Date: _____

REGISTERED SURVEYING ASSOCIATE CERTIFICATION

I, Gordon Nicholson, hereby certify that the vertical and horizontal locations and dimensions shown on this plan are a true and correct record and were located by survey.

Registered Surveying Associate(sig.)

Surveyor No. SA 3405 Date: 03/05/2023

A1	INDEX	DATE	AS CONSTRUCTED	RDE	DAM	CW	PASSED	INITIALS	DATE
	A	03/05/2023	AS CONSTRUCTED	RDE	DAM	CW	PASSED		03/05/2023

shadforth

LOGAN CITY COUNCIL

LOGAN CITY COUNCIL

MIRVAC MIR009-04
AS CONSTRUCTED SURVEY - ROADS AND EARTHWORKS
EVERLEIGH PRECINCT 94C
GREENBANK QLD

SHEET 4 OF 4 SHEETS	SCALE 1:250 A1
REVISION DATE 03/05/2023	REVISION A
DISCIPLINE CODE -	
DRAWING NO. ASC-RDS AND EWKS-04-9.4C	