




**AS CONSTRUCTED**

**REGISTERED SURVEYING ASSOCIATE CERTIFICATION**

I, Gordon Nicholson, hereby certify that the vertical and horizontal locations and dimensions shown on this plan are a true and correct record and were located by survey.

Registered Surveying Associate(sig.) Surveyor No. SA 3405 Date: 09/05/2023

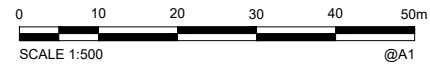

**COORDINATE DATUM NOTE:**  
 HORIZONTAL COORDINATES(E,N) SUPPLIED ARE MAPPING GRID OF AUSTRALIA(MGA), ZONE 56 BASED ON THE UNIVERSAL TRANSVERSE MERCATOR PROJECTION AND THE GEOCENTRIC DATUM OF AUSTRALIA 1994.  
 HORIZONTAL DATUM DERIVED FROM PSM 61308 E 498528.114 N 6931171.033.  
 LEVELS SUPPLIED ARE ON THE AUSTRALIAN HEIGHT DATUM(AHD)  
 LEVEL DATUM DERIVED FROM PSM 61308 RL54.660 (AHD)

	WATER METER BOX
	WATER REDUCER
	WATER BEND
	WATER TAPING BAND
	WATER BALL VALVE/STOP VALVE
	WATER FIRE HYDRANT
	WATERMAIN LINE (SIZE AND CLASS AS SHOWN)

**ENGINEER'S CERTIFICATION**

I, \_\_\_\_\_, hereby certify that:

- The information contained in this drawing / document is in compliance with approved drawings and design.
- The new water and sewerage works defined by this drawing have been designed and constructed in accordance with the SEQ Code.
- This represents an accurate record of as-constructed works
- I accept responsibility for the information contained in this drawing / document.

RPEQ (signature) RPEQ No. \_\_\_\_\_ Date: \_\_\_\_\_

<b>A1</b>	INDEX	DATE	REVISIONS	DRAWN	CHECKED	PASSED	INITIALS	DATE
	A	09/05/2023	AS CONSTRUCTED	RDE	DAM	CW		09/05/2023
								09/05/2023
								09/05/2023



**LOGAN CITY COUNCIL**

MIRVAC M1009-04  
 AS CONSTRUCTED SURVEY - WATERMAIN  
 EVERLEIGH PRECINCT 9.4  
 GREENBANK QLD


SHEET 1 OF 3 SHEETS	SCALE 1:500 A1
REVISION DATE 09/05/2023	REVISION <b>A</b>
DISCIPLINE CODE -	
DRAWING NO. <b>ASC-WATERMAIN-01-9.4C</b>	

PM61308 RL  
 E: 498528.114  
 N: 6931171.033  
 RL: 54.660m



**AS CONSTRUCTED**

**REGISTERED SURVEYING ASSOCIATE CERTIFICATION**  
 I, Gordon Nicholson, hereby certify that the vertical and horizontal locations and dimensions shown on this plan are a true and correct record and were located by survey.  
 Registered Surveying Associate(sig.) Surveyor No. SA 3405 Date: 09/05/2023

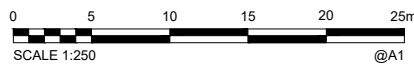

**COORDINATE DATUM NOTE:**  
 HORIZONTAL COORDINATES(E,N) SUPPLIED ARE MAPPING GRID OF AUSTRALIA(MGA), ZONE 56 BASED ON THE UNIVERSAL TRANSVERSE MERCATOR PROJECTION AND THE GEOCENTRIC DATUM OF AUSTRALIA 1994.  
 HORIZONTAL DATUM DERIVED FROM PSM 61308 E 498528.114 N 6931171.033.  
 LEVELS SUPPLIED ARE ON THE AUSTRALIAN HEIGHT DATUM(AHD)  
 LEVEL DATUM DERIVED FROM PSM 61308 RL54.660 (AHD)

	WATER METER BOX
	WATER REDUCER
	WATER BEND
	WATER TAPING BAND
	WATER BALL VALVE/STOP VALVE
	WATER FIRE HYDRANT
	WATERMAIN LINE (SIZE AND CLASS AS SHOWN)

**ENGINEER'S CERTIFICATION**  
 I, \_\_\_\_\_, hereby certify that:  
 1. The information contained in this drawing / document is in compliance with approved drawings and design.  
 2. The new water and sewerage works defined by this drawing have been designed and constructed in accordance with the SEQ Code.  
 3. This represents an accurate record of as-constructed works.  
 4. I accept responsibility for the information contained in this drawing / document.  
 RPEQ (signature) RPEQ No. \_\_\_\_\_ Date: \_\_\_\_\_



<b>A1</b>	INDEX	DATE	REVISIONS	DRAWN	CHECKED	PASSED	INITIALS	DATE
	A	09/05/2023	AS CONSTRUCTED	RDE	DAM	CW		



**LOGAN CITY COUNCIL**  
 MIRVAC MIR009-04  
 AS CONSTRUCTED SURVEY - WATERMAIN  
 EVERLEIGH PRECINCT 9.4  
 GREENBANK QLD

SHEET 2 OF 3 SHEETS	SCALE 1:250 A1
REVISION DATE 09/05/2023	REVISION A
DISCIPLINE CODE -	
DRAWING NO. <b>ASC-WATERMAIN-02-9.4C</b>	

PM61308 RL  
E: 4.98528.114  
N: 6931171.033  
RL: 54.660m

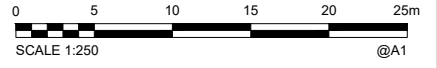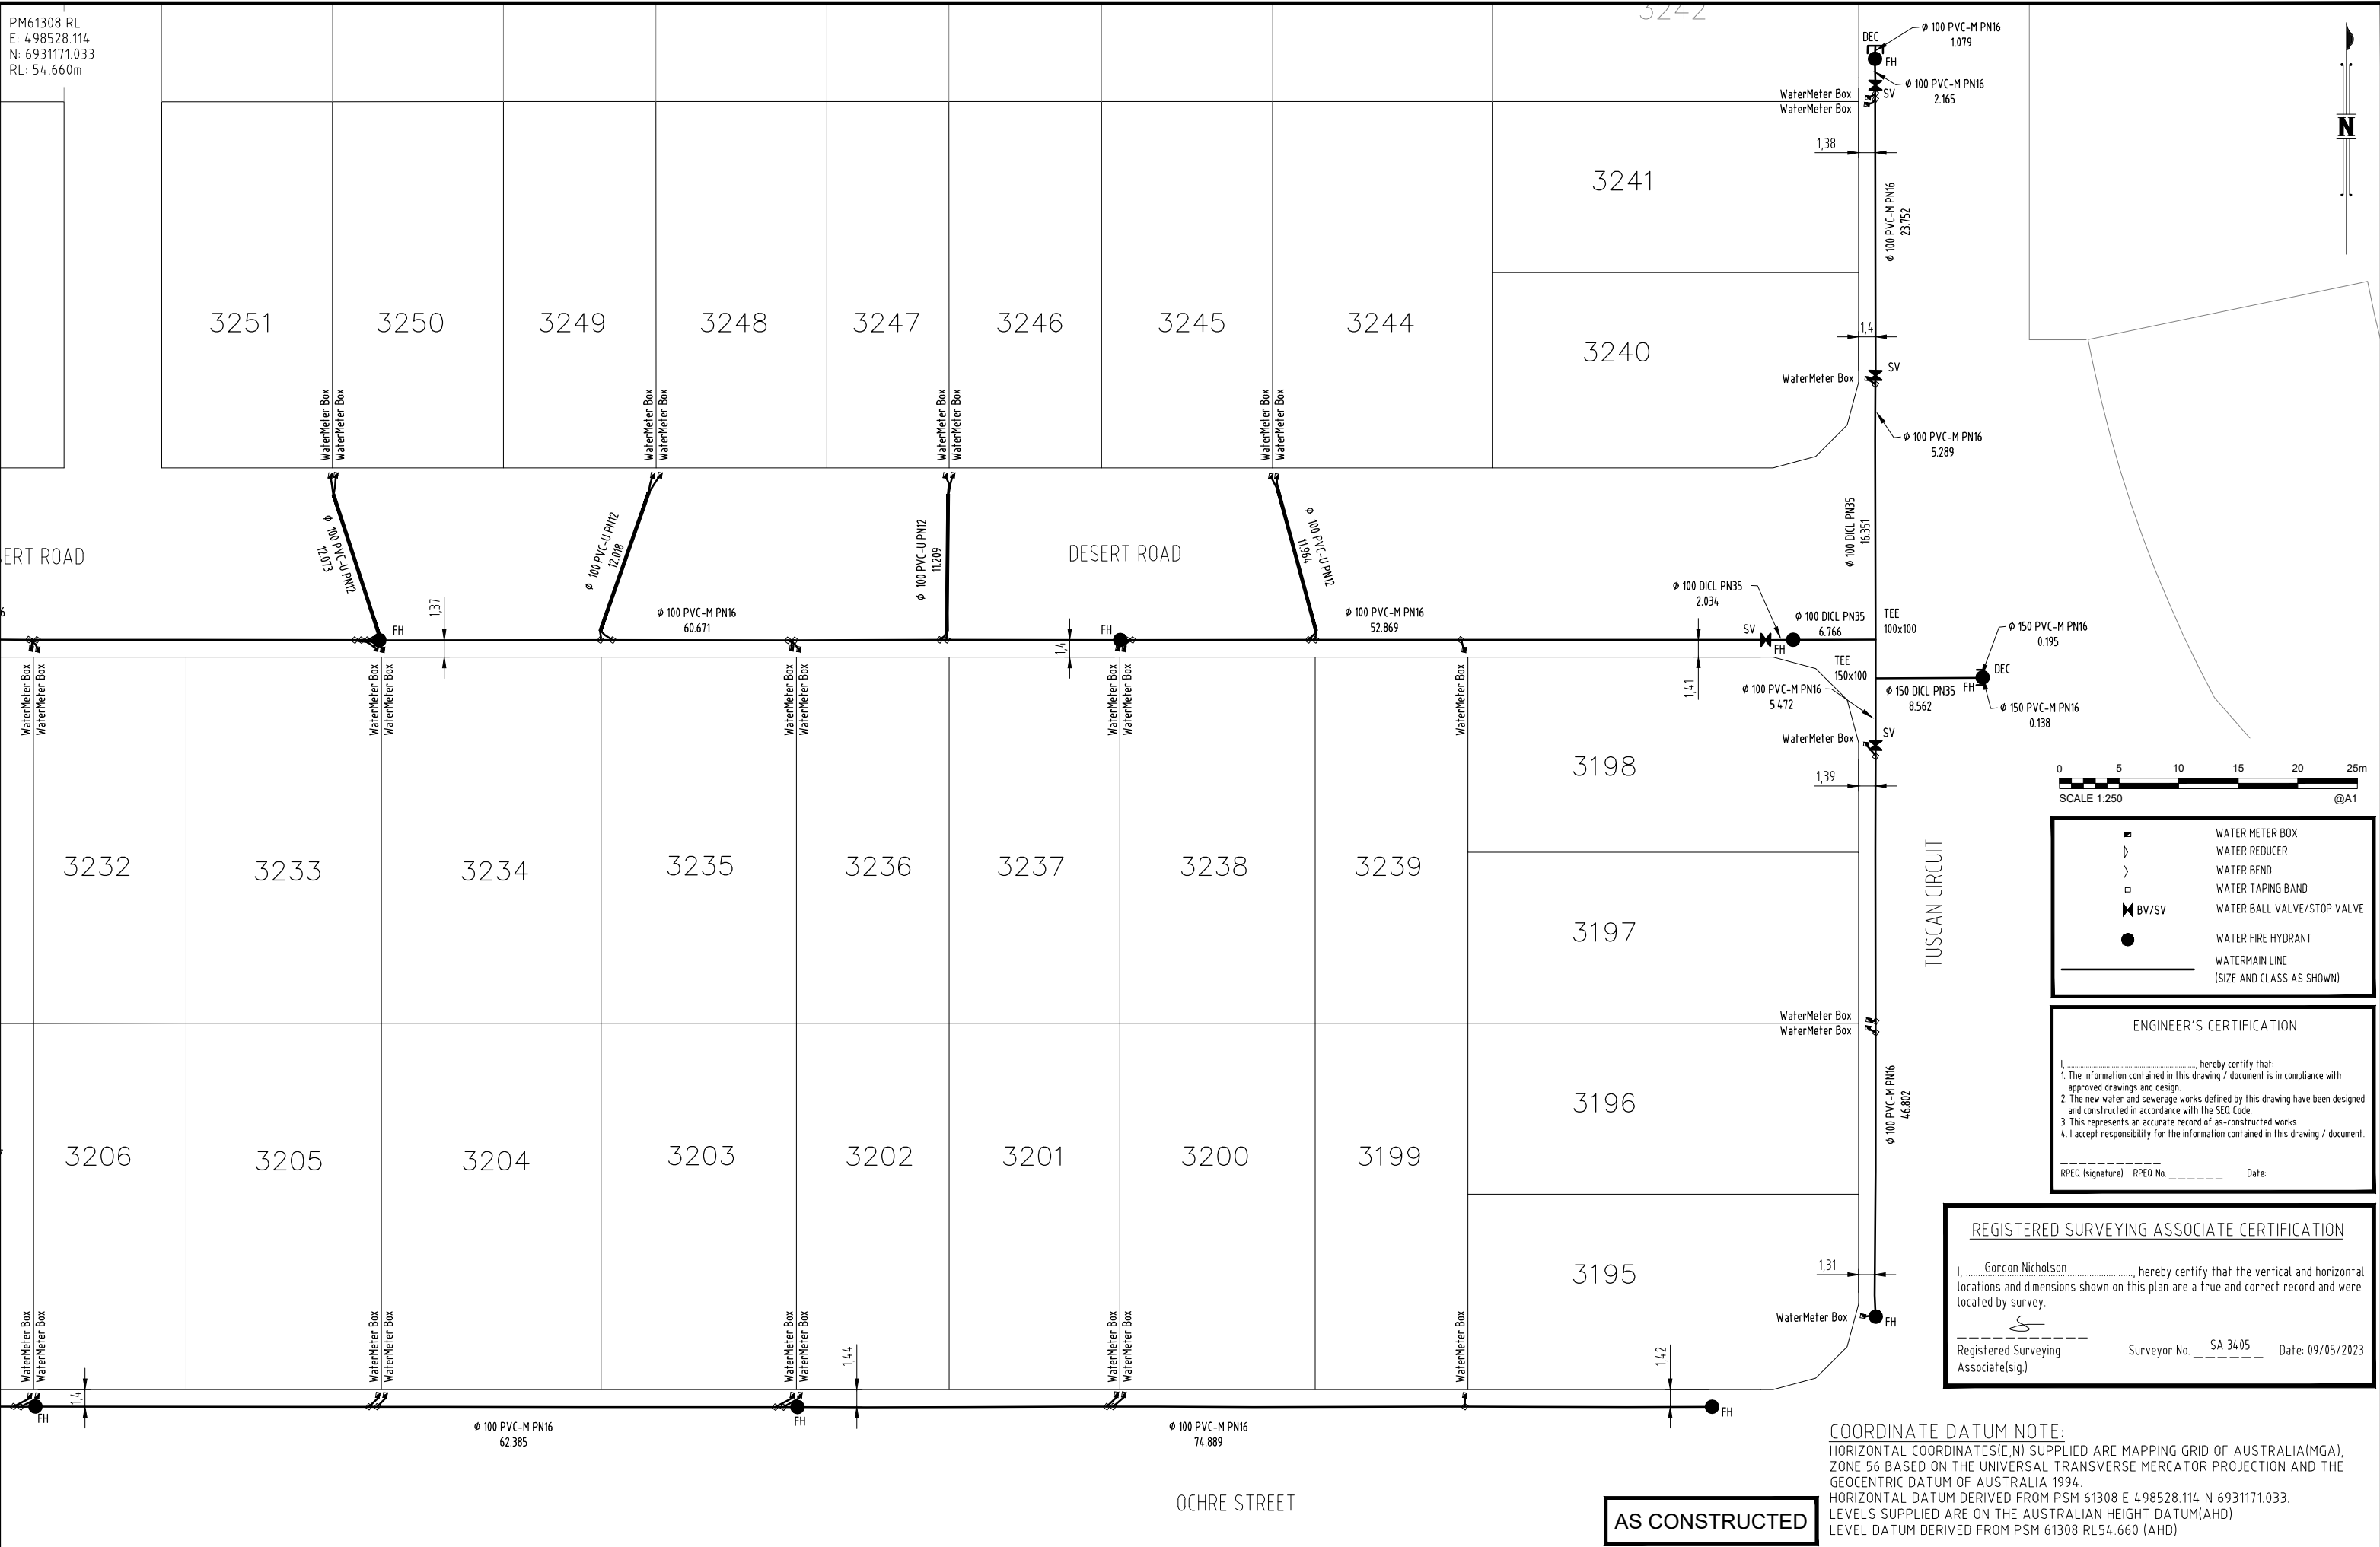

	WATER METER BOX
	WATER REDUCER
	WATER BEND
	WATER TAPING BAND
	WATER BALL VALVE/STOP VALVE
	WATER FIRE HYDRANT
	WATERMAIN LINE (SIZE AND CLASS AS SHOWN)

**ENGINEER'S CERTIFICATION**

I, \_\_\_\_\_, hereby certify that:

- The information contained in this drawing / document is in compliance with approved drawings and design.
- The new water and sewerage works defined by this drawing have been designed and constructed in accordance with the SEQ Code.
- This represents an accurate record of as-constructed works.
- I accept responsibility for the information contained in this drawing / document.

RPEQ (signature) RPEQ No. \_\_\_\_\_ Date: \_\_\_\_\_

**REGISTERED SURVEYING ASSOCIATE CERTIFICATION**

I, Gordon Nicholson, hereby certify that the vertical and horizontal locations and dimensions shown on this plan are a true and correct record and were located by survey.

Registered Surveying Associate(s) (sig.) Surveyor No. SA 3405 Date: 09/05/2023

**COORDINATE DATUM NOTE:**  
HORIZONTAL COORDINATES(E,N) SUPPLIED ARE MAPPING GRID OF AUSTRALIA(MGA), ZONE 56 BASED ON THE UNIVERSAL TRANSVERSE MERCATOR PROJECTION AND THE GEOCENTRIC DATUM OF AUSTRALIA 1994.  
HORIZONTAL DATUM DERIVED FROM PSM 61308 E 4.98528.114 N 6931171.033.  
LEVELS SUPPLIED ARE ON THE AUSTRALIAN HEIGHT DATUM(AHD)  
LEVEL DATUM DERIVED FROM PSM 61308 RL54.660 (AHD)

**AS CONSTRUCTED**

<b>A1</b>	INDEX	DATE	REVISIONS	DRAWN	CHECKED	PASSED	INITIALS	DATE
	A	09/05/2023	AS CONSTRUCTED	RDE	DAM	CW		09/05/2023

**shadforth**

29 Shadforth Lane, Forest Glen QLD 4056  
07 5498 3300 • 07 5498 3300 • info@shadforth.com.au



**LOGAN CITY COUNCIL**

MIRVAC MIR009-04  
AS CONSTRUCTED SURVEY - WATERMAIN  
EVERLEIGH PRECINCT 9.4  
GREENBANK QLD

SHEET 3 OF 3 SHEETS	SCALE 1:250 A1
REVISION DATE 09/05/2023	REVISION A
DISCIPLINE CODE -	
DRAWING NO. <b>ASC-WATERMAIN-03-9.4C</b>	