


COORDINATE DATUM NOTE:

HORIZONTAL COORDINATES(E,N) SUPPLIED ARE MAPPING GRID OF AUSTRALIA(MGA), ZONE 56 BASED ON THE UNIVERSAL TRANSVERSE MERCATOR PROJECTION AND THE GEOCENTRIC DATUM OF AUSTRALIA 1994.
 HORIZONTAL DATUM DERIVED FROM PSM 61308 E 4 98528.114 N 6931171.033.
 LEVELS SUPPLIED ARE ON THE AUSTRALIAN HEIGHT DATUM(AHD)
 LEVEL DATUM DERIVED FROM PSM 61308 RL54.660 (AHD)

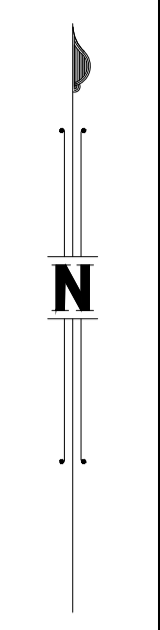

○	SEWER MANHOLE
×	SEWER FITTING
□	SEWER DEC
—	SEWER PIPE CLASS AS SHOWN

ENGINEER'S CERTIFICATION

I, _____ hereby certify that:

- The information contained in this drawing / document is in compliance with approved drawings and design.
- The new water and sewerage works defined by this drawing have been designed and constructed in accordance with the SEQ Code.
- This represents an accurate record of as-constructed works
- I accept responsibility for the information contained in this drawing / document.

 RPEQ (signature) RPEQ No. _____ Date: _____

REGISTERED SURVEYING ASSOCIATE CERTIFICATION

I, Gordon Nicholson, hereby certify that the vertical and horizontal locations and dimensions shown on this plan are a true and correct record and were located by survey.

 Registered Surveying Associate(sig) Surveyor No. SA 3405 Date: 17/08/2023

0 15 30 45 60 75m
 SCALE 1:750 @A1

AS CONSTRUCTED

A1	INDEX	DATE	AS CONSTRUCTED	REVISIONS	DRAWN	CHECKED	PASSED
	A	17/08/2023	AS CONSTRUCTED		RDE	DAM	CW

DRAWN	RDE	17/08/2023
CHECKED	DAM	17/08/2023
PASSED	CW	17/08/2023
INITIALS	DATE	



99 Sandalwood Lane, Forest Glen QLD 4556
 Ph: 07 5438 3300 ▶ R: 07 5438 3388 ▶ E: admin@shadforth.com.au

LOGAN CITY COUNCIL

MIRVAC MIR-0905
 AS CONSTRUCTED SURVEY - SEWER
 EVERLEIGH PRECINCT 9.5C
 GREENBANK QLD

SHEET 1 OF 6 SHEETS	SCALE 1:750 A1
REVISION DATE 17/08/2023	REVISION A
DISCIPLINE CODE -	
DRAWING NO.	
ASC-SEWER-01-9.5C	

PM61308 RL
E: 4.98528.114
N: 6931171.033
RL: 54.660m

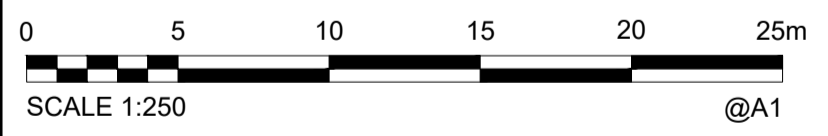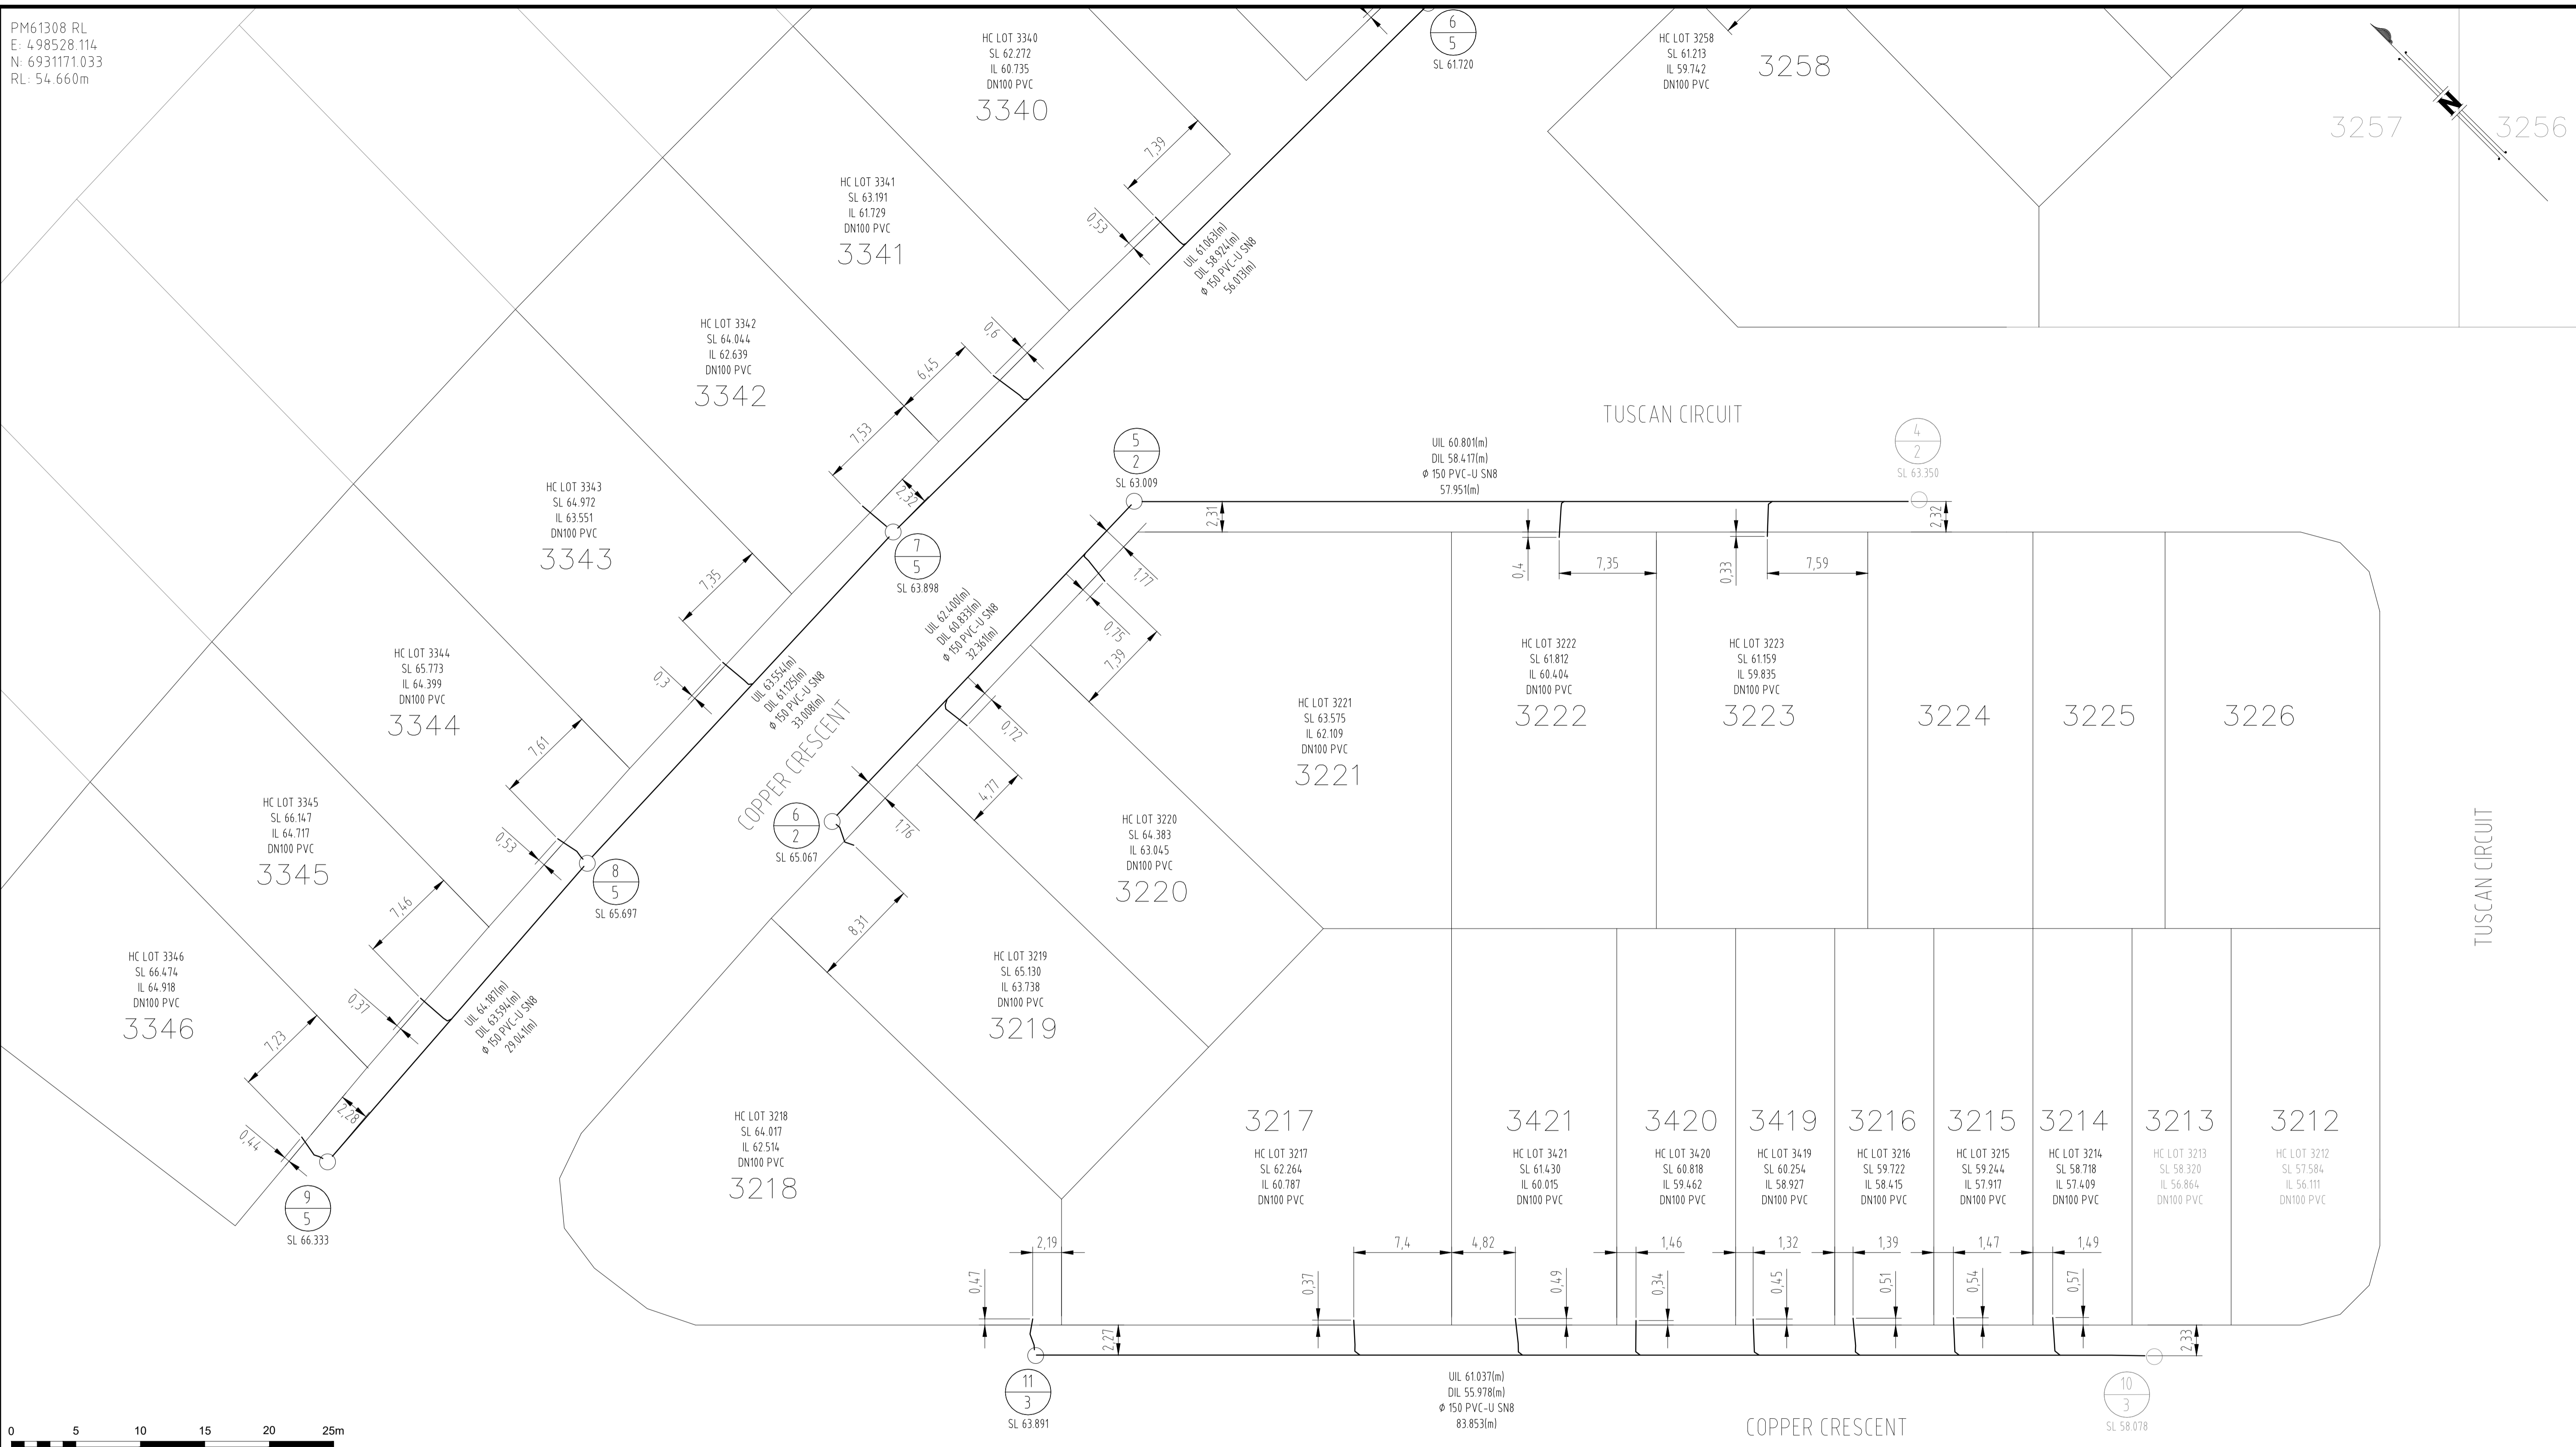


AS CONSTRUCTED

COORDINATE DATUM NOTE:
HORIZONTAL COORDINATES(E,N) SUPPLIED ARE MAPPING GRID OF AUSTRALIA(MGA), ZONE 56 BASED ON THE UNIVERSAL TRANSVERSE MERCATOR PROJECTION AND THE GEOCENTRIC DATUM OF AUSTRALIA 1994.
HORIZONTAL DATUM DERIVED FROM PSM 61308 E 4.98528.114 N 6931171.033.
LEVELS SUPPLIED ARE ON THE AUSTRALIAN HEIGHT DATUM(AHD)
LEVEL DATUM DERIVED FROM PSM 61308 RL54.660 (AHD)

REGISTERED SURVEYING ASSOCIATE CERTIFICATION
I, Gordon Nicholson, hereby certify that the vertical and horizontal locations and dimensions shown on this plan are a true and correct record and were located by survey.
Registered Surveying Associate(sig) Surveyor No. SA 3405 Date: 17/08/2023

ENGINEER'S CERTIFICATION
I, _____, hereby certify that:
1. The information contained in this drawing / document is in compliance with approved drawings and design.
2. The new water and sewerage works defined by this drawing have been designed and constructed in accordance with the SEQ Code.
3. This represents an accurate record of as-constructed works.
4. I accept responsibility for the information contained in this drawing / document.
RPEQ (signature) RPEQ No. _____ Date: _____

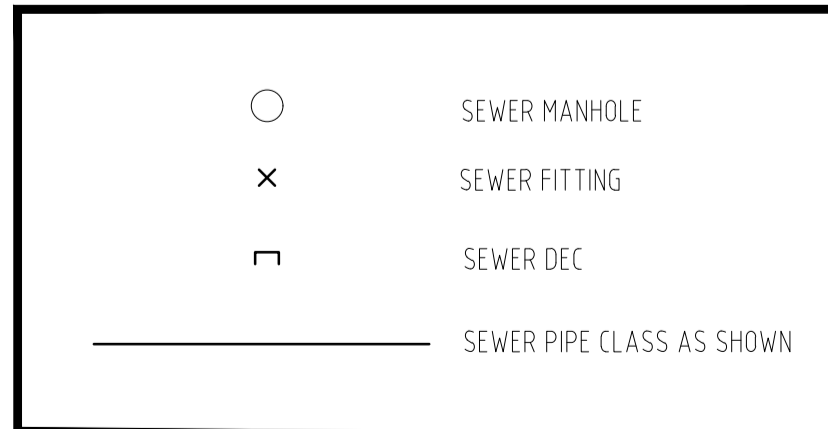


A1	INDEX	DATE	REVISIONS	DRAWN	CHECKED	PASSED	INITIALS	DATE
	A	17/08/2023	AS CONSTRUCTED	RDE	DAM	CW		



LOGAN CITY COUNCIL
MIRVAC MIR-0905
AS CONSTRUCTED SURVEY - SEWER
EVERLEIGH PRECINCT 9.5C
GREENBANK QLD

SHEET 2 OF 6 SHEETS	SCALE 1:250 A1
REVISION DATE 17/08/2023	REVISION A
DISCIPLINE CODE -	
DRAWING NO. ASC-SEWER-02-9.5C	

PM61308 RL
 E: 498528.114
 N: 6931171.033
 RL: 54.660m

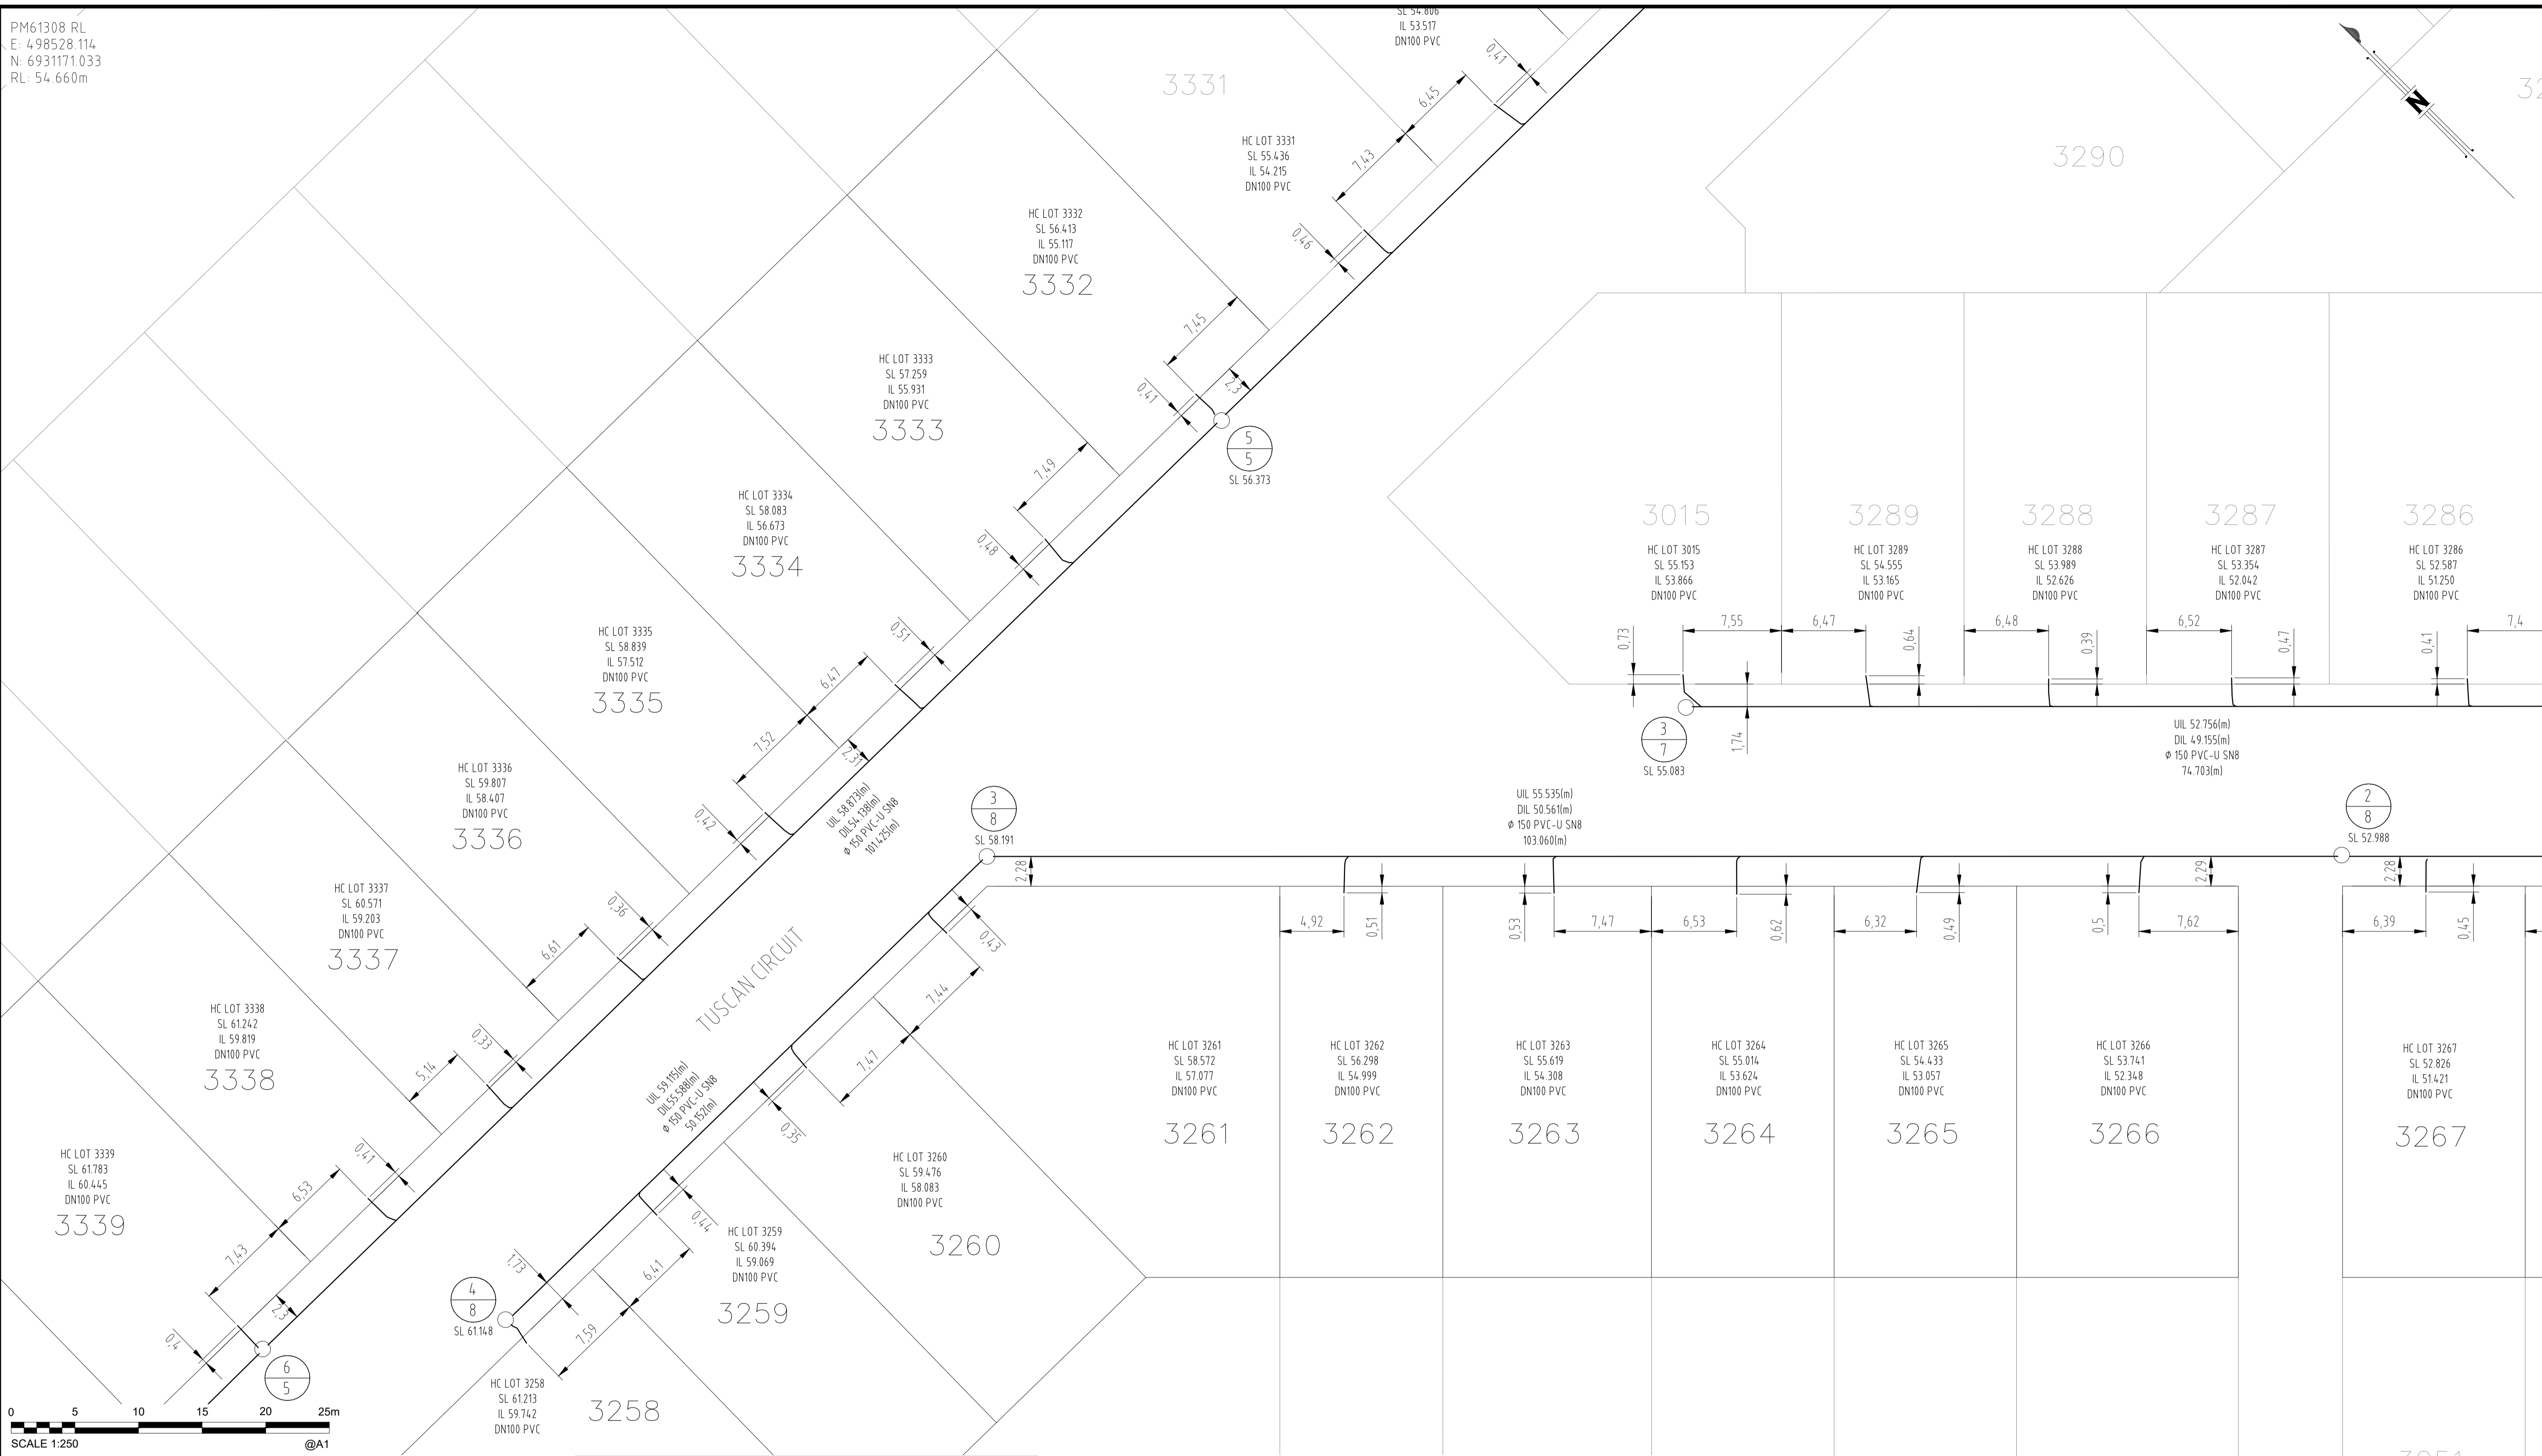

AS CONSTRUCTED

COORDINATE DATUM NOTE:
 HORIZONTAL COORDINATES(E,N) SUPPLIED ARE MAPPING GRID OF AUSTRALIA(MGA), ZONE 56 BASED ON THE UNIVERSAL TRANSVERSE MERCATOR PROJECTION AND THE GEOCENTRIC DATUM OF AUSTRALIA 1994.
 HORIZONTAL DATUM DERIVED FROM PSM 61308 E 498528.114 N 6931171.033.
 LEVELS SUPPLIED ARE ON THE AUSTRALIAN HEIGHT DATUM(AHD)
 LEVEL DATUM DERIVED FROM PSM 61308 RL54.660 (AHD)

REGISTERED SURVEYING ASSOCIATE CERTIFICATION
 I, Gordon Nicholson, hereby certify that the vertical and horizontal locations and dimensions shown on this plan are a true and correct record and were located by survey.
 Registered Surveying Associate(s)g. Surveyor No. SA 3405 Date: 17/08/2023

ENGINEER'S CERTIFICATION
 I, _____, hereby certify that:
 1. The information contained in this drawing / document is in compliance with approved drawings and design.
 2. The new water and sewerage works defined by this drawing have been designed and constructed in accordance with the SEQ Code.
 3. This represents an accurate record of as-constructed works.
 4. I accept responsibility for the information contained in this drawing / document.
 RPEQ (signature) RPEQ No. _____ Date: _____

○	SEWER MANHOLE
×	SEWER FITTING
□	SEWER DEC
—	SEWER PIPE CLASS AS SHOWN




A1	INDEX	DATE	REVISIONS
	A	17/08/2023	AS CONSTRUCTED
	DRAWN	CHECKED	PASSED
	RDE	DAM	CW
	17/08/2023	17/08/2023	17/08/2023

99 Sandalwood Lane, Forest Glen QLD 4556
 Ph: 07 5438 3300 ▶ F: 07 5438 3388 ▶ E: acnsh@shadforth.com.au

LOGAN CITY COUNCIL
 MIRVAC MIR-0905
 AS CONSTRUCTED SURVEY - SEWER
 EVERLEIGH PRECINCT 95C
 GREENBANK QLD

SHEET 3 OF 6	SHEETS	SCALE 1:250 A1
REVISION DATE 17/08/2023	REVISION A	
DISCIPLINE CODE		
DRAWING NO.		
ASC-SEWER-03-9.5C		

PM61308 RL
E: 498528.114
N: 6931171.033
RL: 54.660m

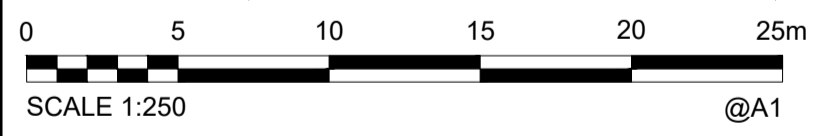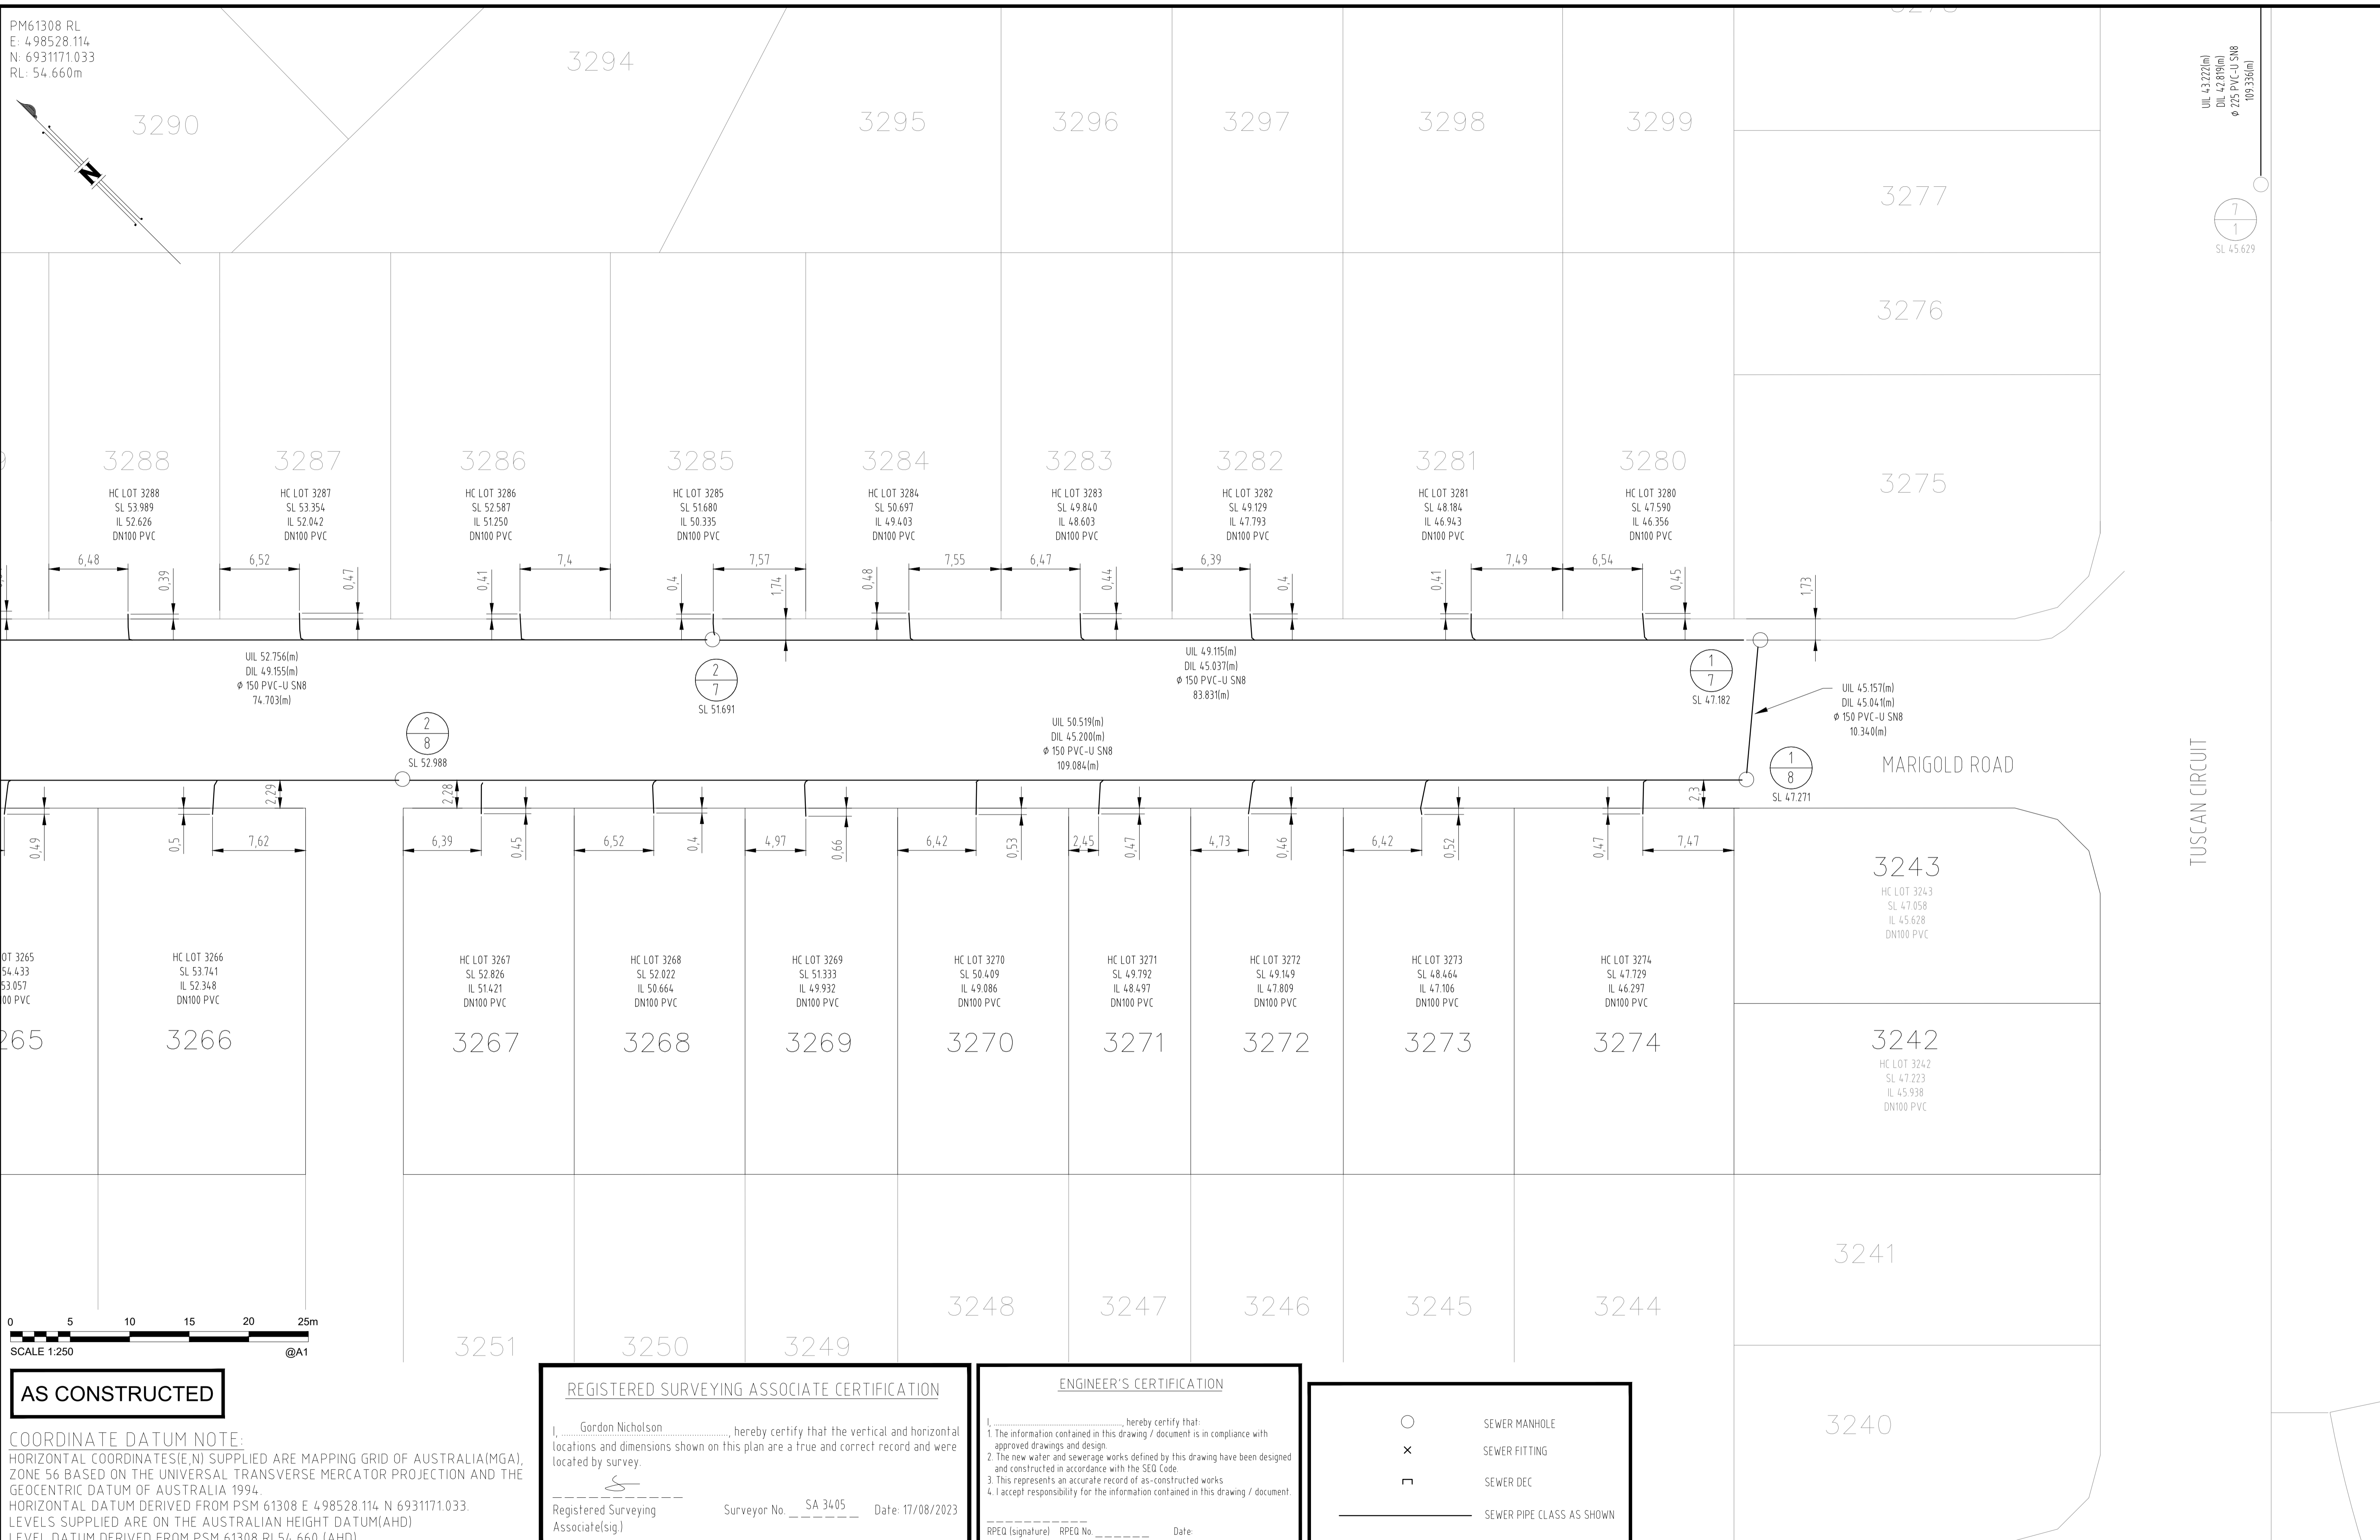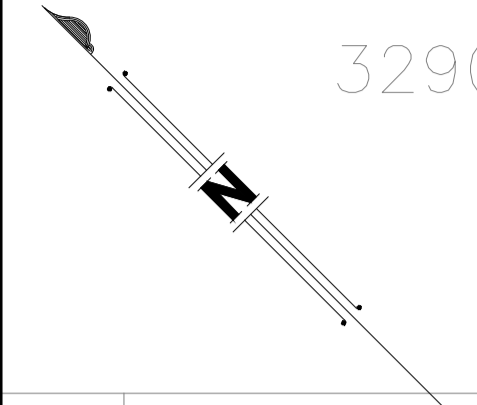

AS CONSTRUCTED

COORDINATE DATUM NOTE:
HORIZONTAL COORDINATES(E,N) SUPPLIED ARE MAPPING GRID OF AUSTRALIA(MGA), ZONE 56 BASED ON THE UNIVERSAL TRANSVERSE MERCATOR PROJECTION AND THE GEOCENTRIC DATUM OF AUSTRALIA 1994.
HORIZONTAL DATUM DERIVED FROM PSM 61308 E 498528.114 N 6931171.033.
LEVELS SUPPLIED ARE ON THE AUSTRALIAN HEIGHT DATUM(AHD)
LEVEL DATUM DERIVED FROM PSM 61308 RL54.660 (AHD)

REGISTERED SURVEYING ASSOCIATE CERTIFICATION
I, Gordon Nicholson, hereby certify that the vertical and horizontal locations and dimensions shown on this plan are a true and correct record and were located by survey.
Registered Surveying Associate(sig) Surveyor No. SA 3405 Date: 17/08/2023

ENGINEER'S CERTIFICATION
I, _____, hereby certify that:
1. The information contained in this drawing / document is in compliance with approved drawings and design.
2. The new water and sewerage works defined by this drawing have been designed and constructed in accordance with the SEQ Code.
3. This represents an accurate record of as-constructed works.
4. I accept responsibility for the information contained in this drawing / document.
RPEQ (signature) RPEQ No. _____ Date: _____

- SEWER MANHOLE
- × SEWER FITTING
- SEWER DEC
- SEWER PIPE CLASS AS SHOWN

A1	INDEX	DATE	REVISIONS	DRAWN	CHECKED	PASSED	DRAWN	CHECKED	PASSED
	A	17/08/2023	AS CONSTRUCTED	RDE	DAM	CW			



LOGAN CITY COUNCIL
MIRVAC MIR-095
AS CONSTRUCTED SURVEY - SEWER
EVERLEIGH PRECINCT 95C
GREENBANK QLD

SHEET 4 OF 6 SHEETS	SCALE 1:250 A1
REVISION DATE 17/08/2023	REVISION A
DISCIPLINE CODE -	
DRAWING NO. ASC-SEWER-04-9.5C	

PM61308 RL
 E: 498528.114
 N: 6931171.033
 RL: 54.660m



AS CONSTRUCTED

COORDINATE DATUM NOTE:
 HORIZONTAL COORDINATES(E,N) SUPPLIED ARE MAPPING GRID OF AUSTRALIA(MGA), ZONE 56 BASED ON THE UNIVERSAL TRANSVERSE MERCATOR PROJECTION AND THE GEOCENTRIC DATUM OF AUSTRALIA 1994.
 HORIZONTAL DATUM DERIVED FROM PSM 61308 E 498528.114 N 6931171.033.
 LEVELS SUPPLIED ARE ON THE AUSTRALIAN HEIGHT DATUM(AHD)
 LEVEL DATUM DERIVED FROM PSM 61308 RL54.660 (AHD)

REGISTERED SURVEYING ASSOCIATE CERTIFICATION

I, Gordon Nicholson, hereby certify that the vertical and horizontal locations and dimensions shown on this plan are a true and correct record and were located by survey.

Registered Surveying Associate(sig) Surveyor No. SA 3405 Date: 17/08/2023

ENGINEER'S CERTIFICATION

I, _____, hereby certify that:
 1. The information contained in this drawing / document is in compliance with approved drawings and design.
 2. The new water and sewerage works defined by this drawing have been designed and constructed in accordance with the SEQ Code.
 3. This represents an accurate record of as-constructed works.
 4. I accept responsibility for the information contained in this drawing / document.

RPEQ (signature) RPEQ No. _____ Date: _____

- SEWER MANHOLE
- × SEWER FITTING
- SEWER DEC
- SEWER PIPE CLASS AS SHOWN


A1	INDEX	DATE	REVISIONS	DRAWN	CHECKED	PASSED	INITIALS	DATE
	A	17/08/2023	AS CONSTRUCTED	RDE	DAM	CW		17/08/2023
								17/08/2023






LOGAN CITY COUNCIL

MIRVAC MIR-095
 AS CONSTRUCTED SURVEY - SEWER
 EVERLEIGH PRECINCT 95C
 GREENBANK QLD

SHEET 5 OF 6	SHEETS	SCALE 1:250 A1
REVISION DATE	17/08/2023	REVISION A
DISCIPLINE CODE	—	
DRAWING NO.	ASC-SEWER-05-9.5C	

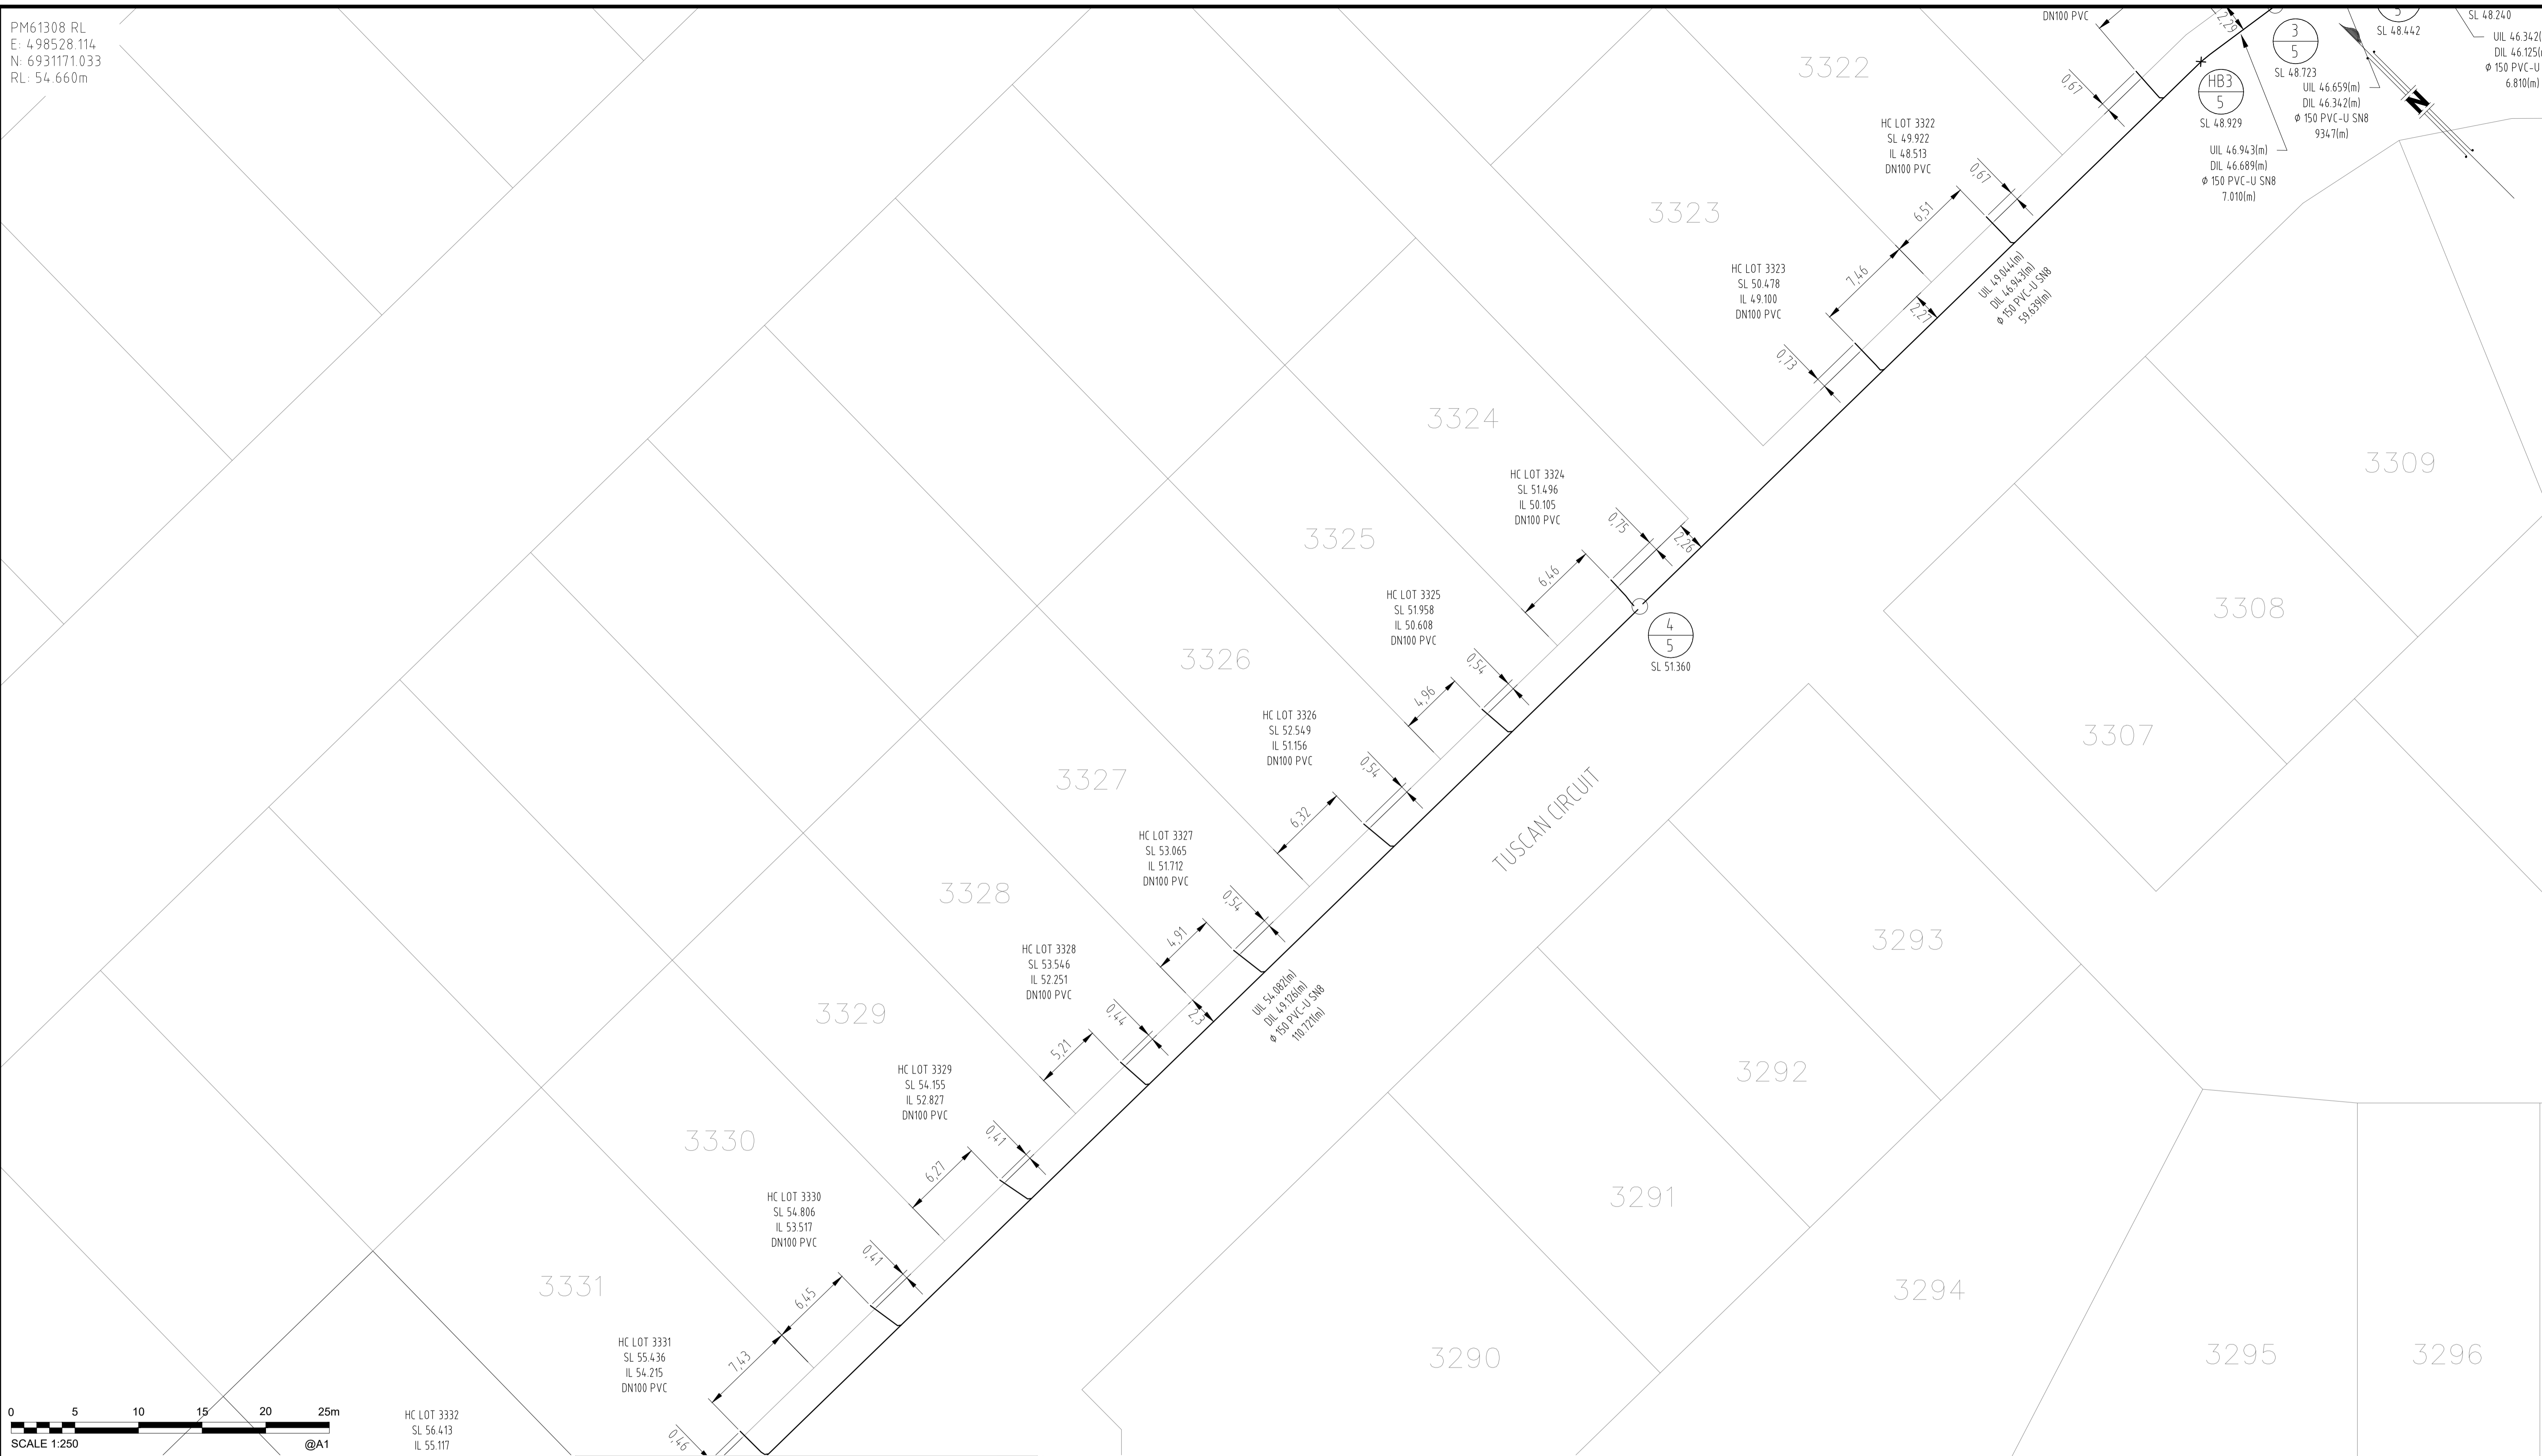

PM61308 RL
 E: 498528.114
 N: 6931171.033
 RL: 54.660m

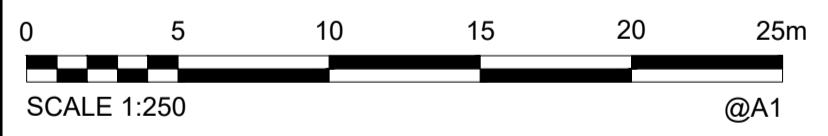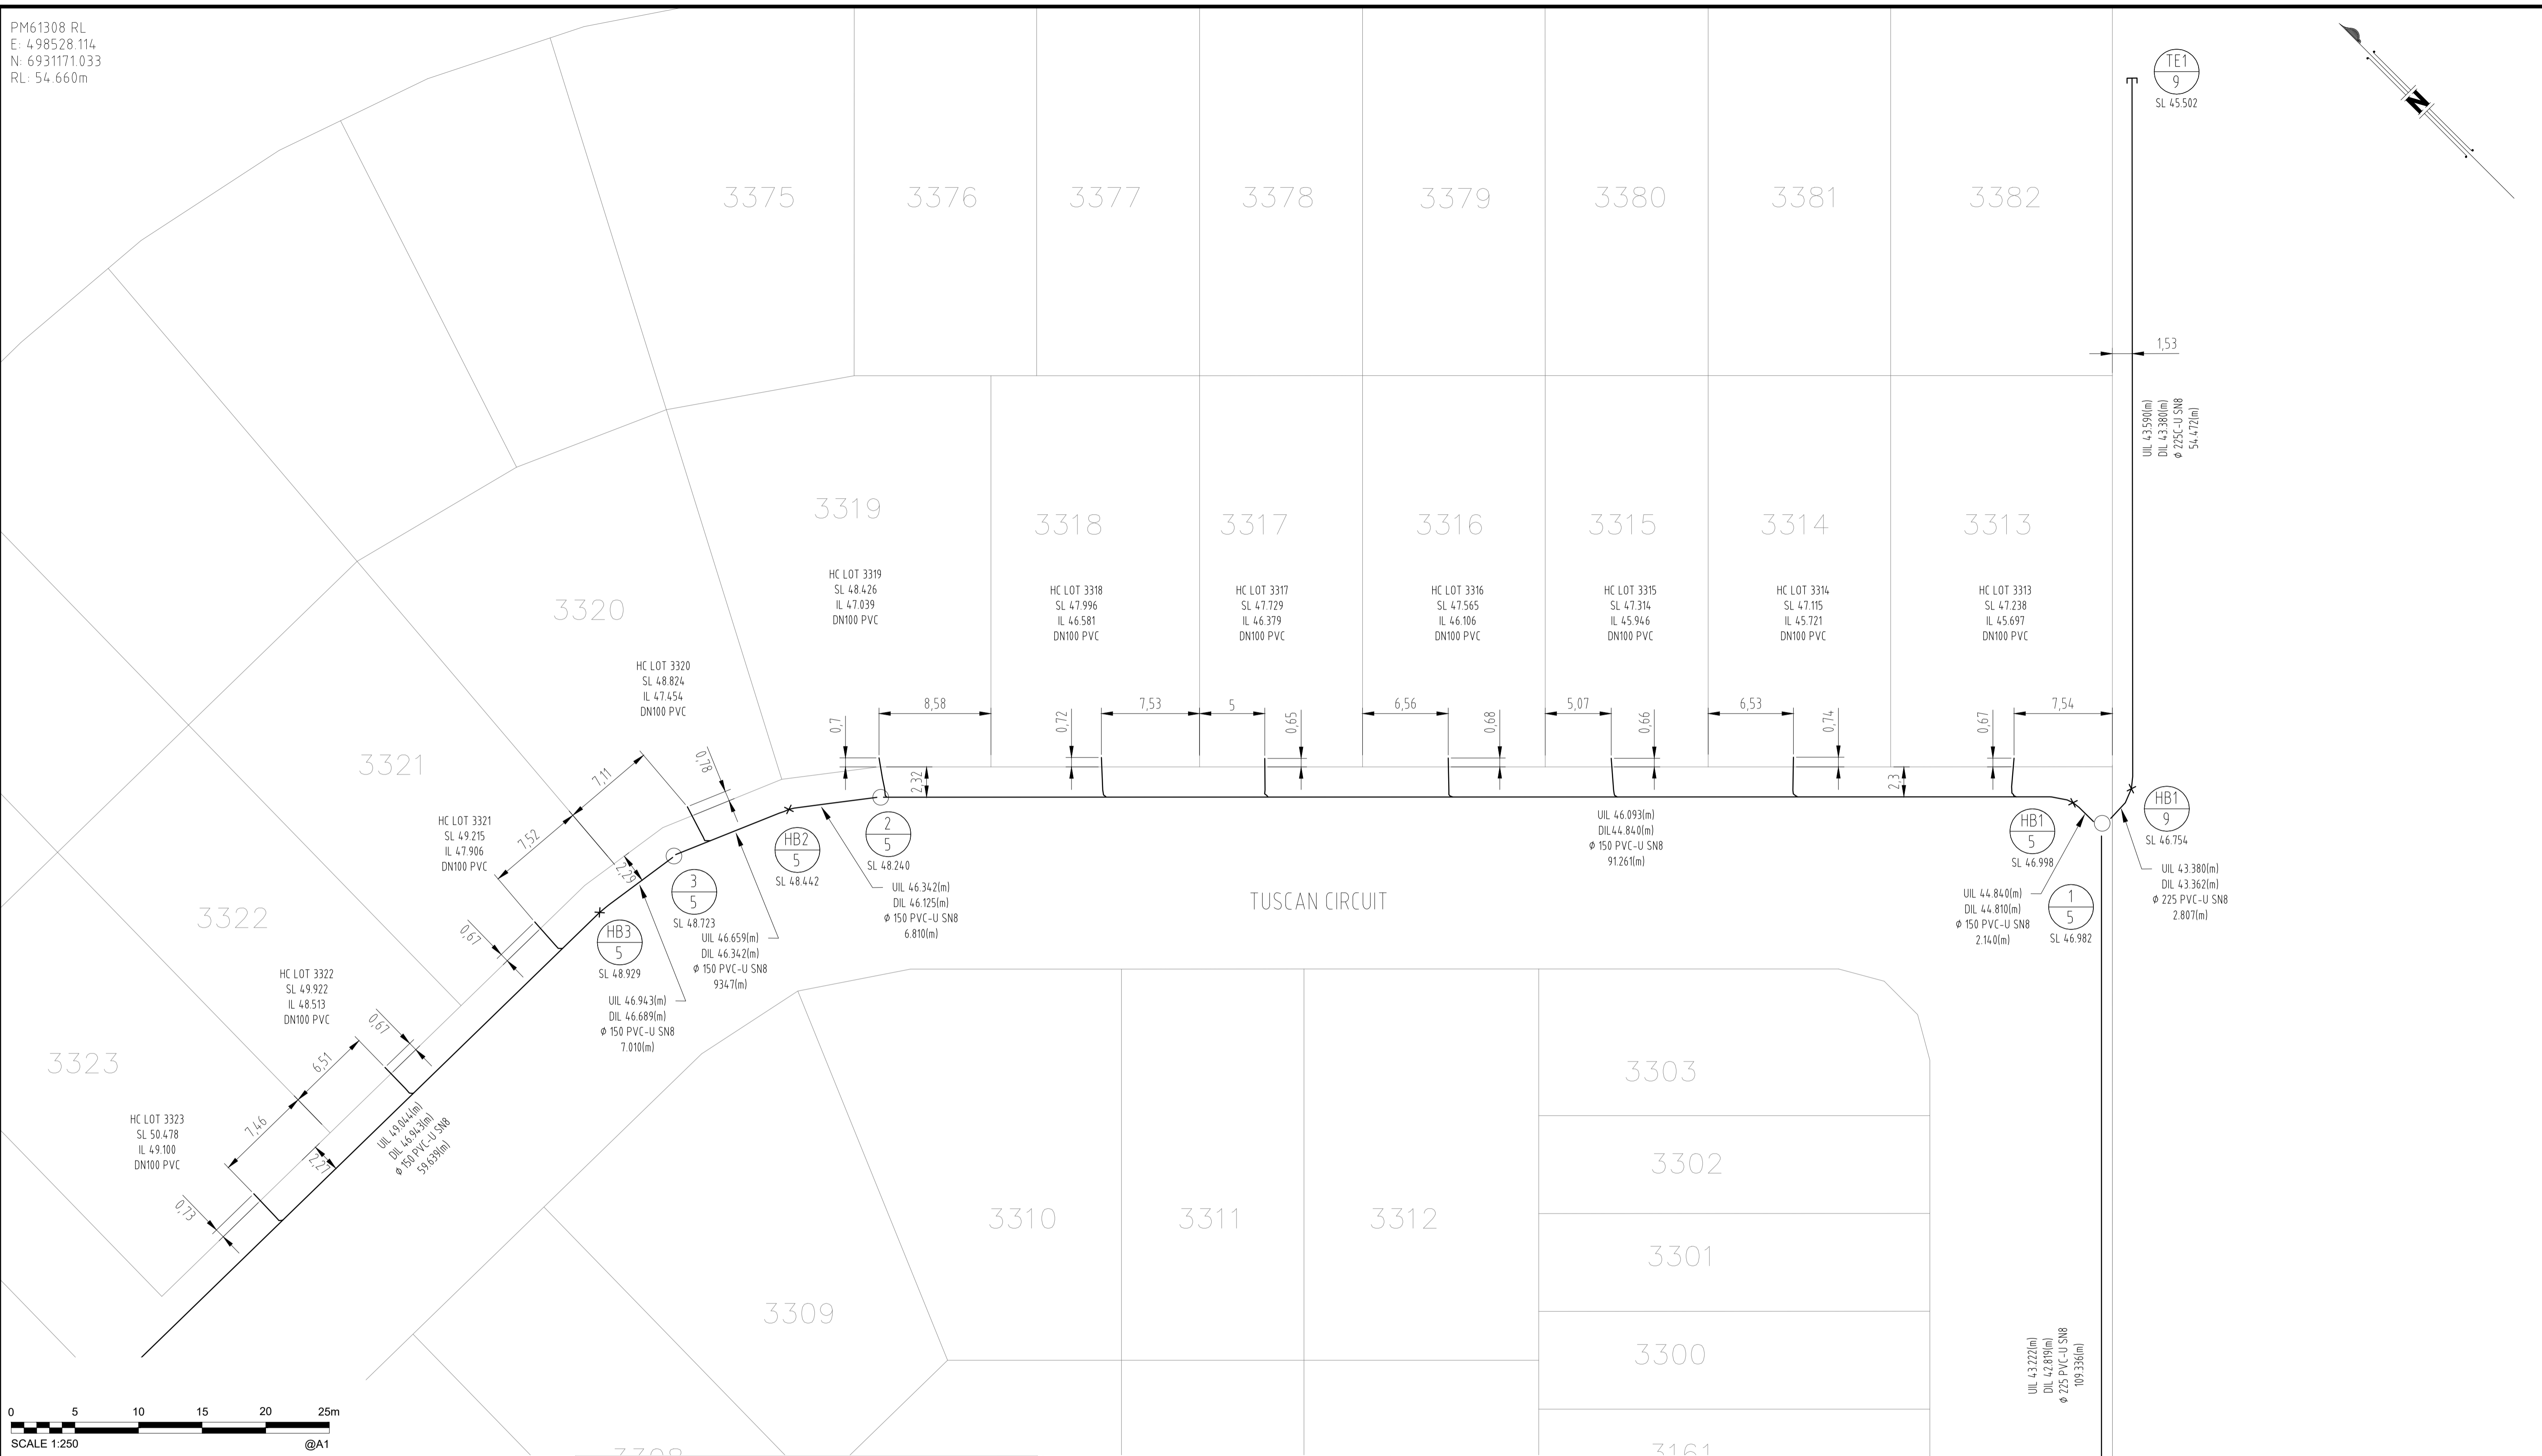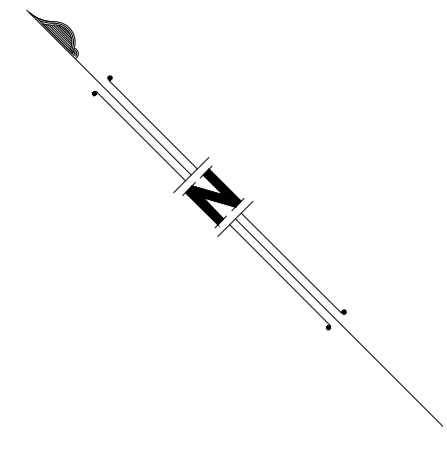


AS CONSTRUCTED

COORDINATE DATUM NOTE:
 HORIZONTAL COORDINATES(E,N) SUPPLIED ARE MAPPING GRID OF AUSTRALIA(MGA), ZONE 56 BASED ON THE UNIVERSAL TRANSVERSE MERCATOR PROJECTION AND THE GEOCENTRIC DATUM OF AUSTRALIA 1994.
 HORIZONTAL DATUM DERIVED FROM PSM 61308 E 498528.114 N 6931171.033.
 LEVELS SUPPLIED ARE ON THE AUSTRALIAN HEIGHT DATUM(AHD)
 LEVEL DATUM DERIVED FROM PSM 61308 RL54.660 (AHD)

REGISTERED SURVEYING ASSOCIATE CERTIFICATION
 I, Gordon Nicholson, hereby certify that the vertical and horizontal locations and dimensions shown on this plan are a true and correct record and were located by survey.
 Registered Surveying Associate(sig) Surveyor No. SA 3405 Date: 17/08/2023

ENGINEER'S CERTIFICATION
 I, _____, hereby certify that:
 1. The information contained in this drawing / document is in compliance with approved drawings and design.
 2. The new water and sewerage works defined by this drawing have been designed and constructed in accordance with the SEQ Code.
 3. This represents an accurate record of as-constructed works.
 4. I accept responsibility for the information contained in this drawing / document.
 RPEQ (signature) RPEQ No. _____ Date: _____

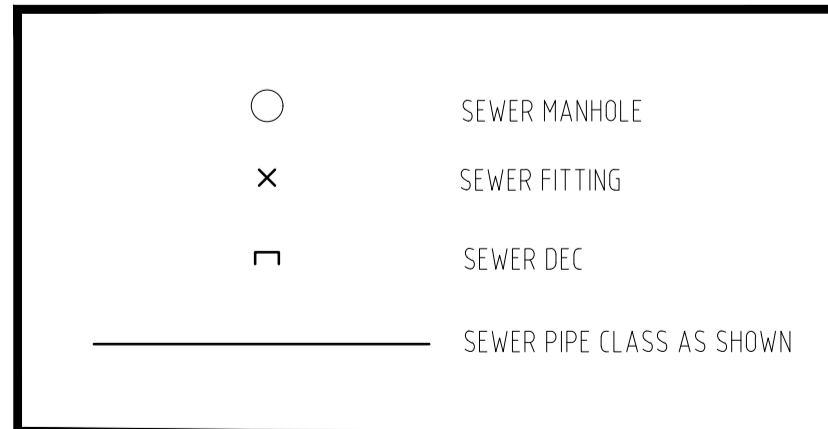

A1	INDEX	DATE	REVISIONS	DRAWN	CHECKED	PASSED	INITIALS	DATE
	A	17/08/2023	AS CONSTRUCTED	RDE	DAM	CW		17/08/2023



LOGAN CITY COUNCIL
 MIRVAC MIR-095
 AS CONSTRUCTED SURVEY - SEWER
 EVERLEIGH PRECINCT 95C
 GREENBANK QLD

SHEET 6 OF 6	SHEETS	SCALE 1:250 A1
REVISION DATE	17/08/2023	REVISION A
DISCIPLINE CODE	-	
DRAWING NO.	ASC-SEWER-06-9.5C	