

**ENGINEER'S CERTIFICATION**

I, \_\_\_\_\_, hereby certify that:

- The information contained in this drawing / document is in compliance with approved drawings and design.
- The new water and sewerage works defined by this drawing have been designed and constructed in accordance with the SEQ Code.
- This represents an accurate record of as-constructed works
- I accept responsibility for the information contained in this drawing / document.


\_\_\_\_\_  
RPEQ (signature) RPEQ No. \_\_\_\_\_ Date: \_\_\_\_\_

**AS CONSTRUCTED**

**REGISTERED SURVEYING ASSOCIATE CERTIFICATION**

I, Gordon Nicholson, hereby certify that the vertical and horizontal locations and dimensions shown on this plan are a true and correct record and were located by survey.

Gordon Nicholson  
Registered Surveying Associate (sig.) Surveyor No. SA 3405 Date: 04/07/2023

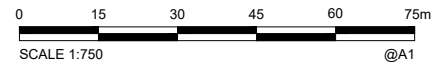

**COORDINATE DATUM NOTE:**  
 HORIZONTAL COORDINATES(E,N) SUPPLIED ARE MAPPING GRID OF AUSTRALIA(MGA), ZONE 56 BASED ON THE UNIVERSAL TRANSVERSE MERCATOR PROJECTION AND THE GEOCENTRIC DATUM OF AUSTRALIA 1994.  
 HORIZONTAL DATUM DERIVED FROM PSM 61308 E 4 98528.114 N 6931171.033.  
 LEVELS SUPPLIED ARE ON THE AUSTRALIAN HEIGHT DATUM(AHD)  
 LEVEL DATUM DERIVED FROM PSM 61308 RL54.660 (AHD)

**A1**

INDEX	DATE	REVISIONS	DRAWN	CHECKED	PASSED	INITIALS	DATE
A	04/07/2023	AS CONSTRUCTED	RDE	DAM	LS		





**LOGAN CITY COUNCIL**

MIRVAC MIR-0905  
 AS CONSTRUCTED SURVEY - STORMWATER  
 EVERLEIGH PRECINCT 95C  
 GREENBANK QLD

SHEET 1 OF 4 SHEETS	SCALE 1:750 A1
REVISION DATE 04/07/2023	REVISION <b>A</b>
DISCIPLINE CODE -	
DRAWING NO. <b>ASC-STORM-01-9.5C</b>	

PM61308 RL  
 E: 498528.114  
 N: 6931171.033  
 RL: 54.660m

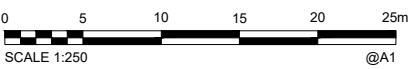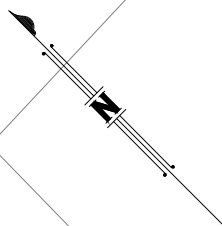

**AS CONSTRUCTED**

**ENGINEER'S CERTIFICATION**

I, \_\_\_\_\_, hereby certify that:

- The information contained in this drawing / document is in compliance with approved drawings and design.
- The new water and sewerage works defined by this drawing have been designed and constructed in accordance with the SEQ Code.
- This represents an accurate record of as-constructed works.
- I accept responsibility for the information contained in this drawing / document.


RPQC (signature) RPQC No. \_\_\_\_\_ Date: \_\_\_\_\_

**REGISTERED SURVEYING ASSOCIATE CERTIFICATION**

I, Gordon Nicholson, hereby certify that the vertical and horizontal locations and dimensions shown on this plan are a true and correct record and were located by survey.

Registered Surveying Associate(sig) Surveyor No. SA 34.05 Date: 04/07/2023

**COORDINATE DATUM NOTE:**  
 HORIZONTAL COORDINATES(E,N) SUPPLIED ARE MAPPING GRID OF AUSTRALIA(MGA), ZONE 56 BASED ON THE UNIVERSAL TRANSVERSE MERCATOR PROJECTION AND THE GEOCENTRIC DATUM OF AUSTRALIA 1994.  
 HORIZONTAL DATUM DERIVED FROM PSM 61308 E 498528.114 N 6931171.033.  
 LEVELS SUPPLIED ARE ON THE AUSTRALIAN HEIGHT DATUM(AHD)  
 LEVEL DATUM DERIVED FROM PSM 61308 RL54.660 (AHD)

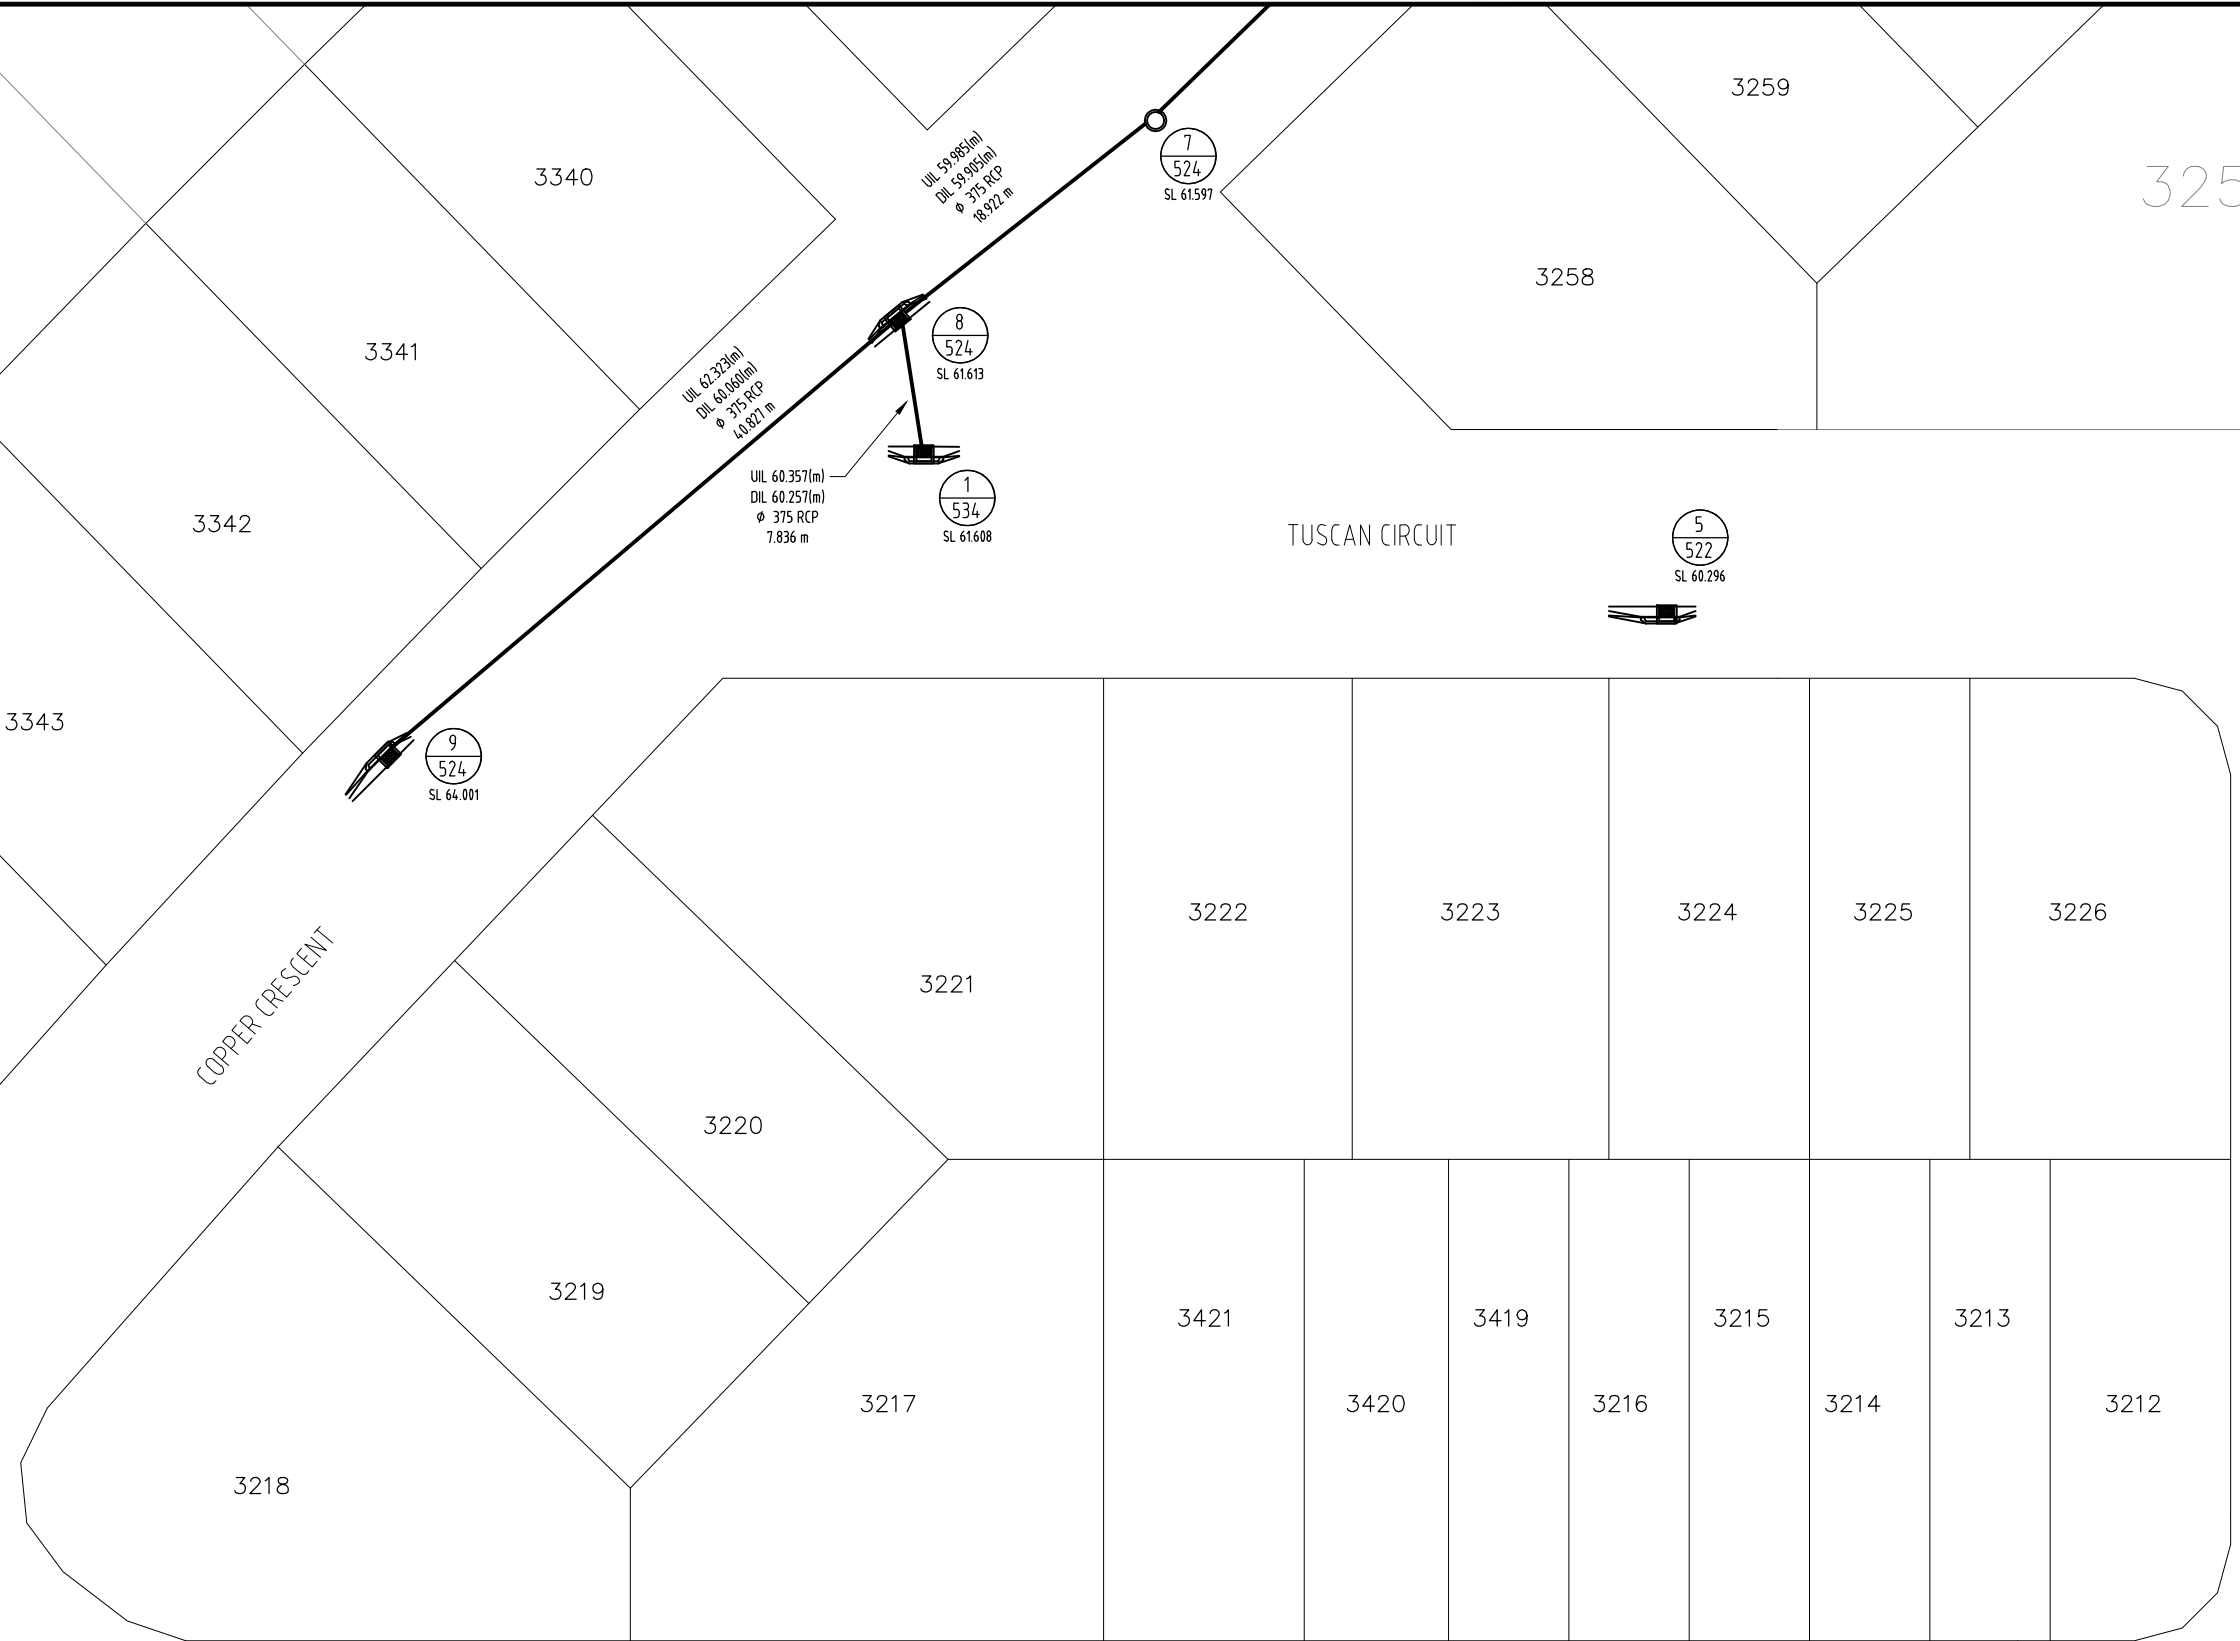

A1	INDEX	DATE	REVISIONS	DRAWN	CHECKED	PASSED	INITIALS	DATE
	A	04/07/2023	AS CONSTRUCTED	RDE	DAM	LS		

DRAWN	RDE	04/07/2023
CHECKED	DAM	04/07/2023
PASSED	LS	04/07/2023





**LOGAN CITY COUNCIL**

MIRVAC MIR-0905  
 AS CONSTRUCTED SURVEY - STORMWATER  
 EVERLEIGH PRECINCT 95C  
 GREENBANK QLD

SHEET 2 OF 4 SHEETS	SCALE 1:250 A1
REVISION DATE 04/07/2023	REVISION A
DISCIPLINE CODE -	
DRAWING NO. ASC-STORM-02-9.5C	

PM61308 RL  
 E: 498528.114  
 N: 6931171.033  
 RL: 54.660m

3290

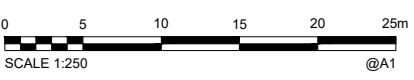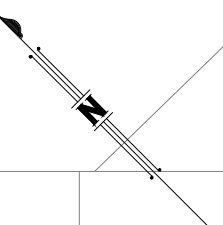


**AS CONSTRUCTED**

**ENGINEER'S CERTIFICATION**  
 I, \_\_\_\_\_, hereby certify that:  
 1. The information contained in this drawing / document is in compliance with approved drawings and design.  
 2. The new water and sewerage works defined by this drawing have been designed and constructed in accordance with the SEQ Code.  
 3. This represents an accurate record of as-constructed works.  
 4. I accept responsibility for the information contained in this drawing / document.  
 RPEQ (signature) RPEQ No. \_\_\_\_\_ Date: \_\_\_\_\_

**REGISTERED SURVEYING ASSOCIATE CERTIFICATION**  
 I, Gordon Nicholson, hereby certify that the vertical and horizontal locations and dimensions shown on this plan are a true and correct record and were located by survey.  
 Registered Surveying Associate(sig) Surveyor No. SA 34.05 Date: 04/07/2023

**COORDINATE DATUM NOTE:**  
 HORIZONTAL COORDINATES(E,N) SUPPLIED ARE MAPPING GRID OF AUSTRALIA(MGA), ZONE 56 BASED ON THE UNIVERSAL TRANSVERSE MERCATOR PROJECTION AND THE GEOCENTRIC DATUM OF AUSTRALIA 1994.  
 HORIZONTAL DATUM DERIVED FROM PSM 61308 E 498528.114 N 6931171.033.  
 LEVELS SUPPLIED ARE ON THE AUSTRALIAN HEIGHT DATUM(AHD)  
 LEVEL DATUM DERIVED FROM PSM 61308 RL54.660 (AHD)

<b>A1</b>											
	A	04/07/2023	AS CONSTRUCTED		RDE	DAM	LS				
	INDEX	DATE	REVISIONS	DRAWN	CHECKED	PASSED	INITIALS	DATE			

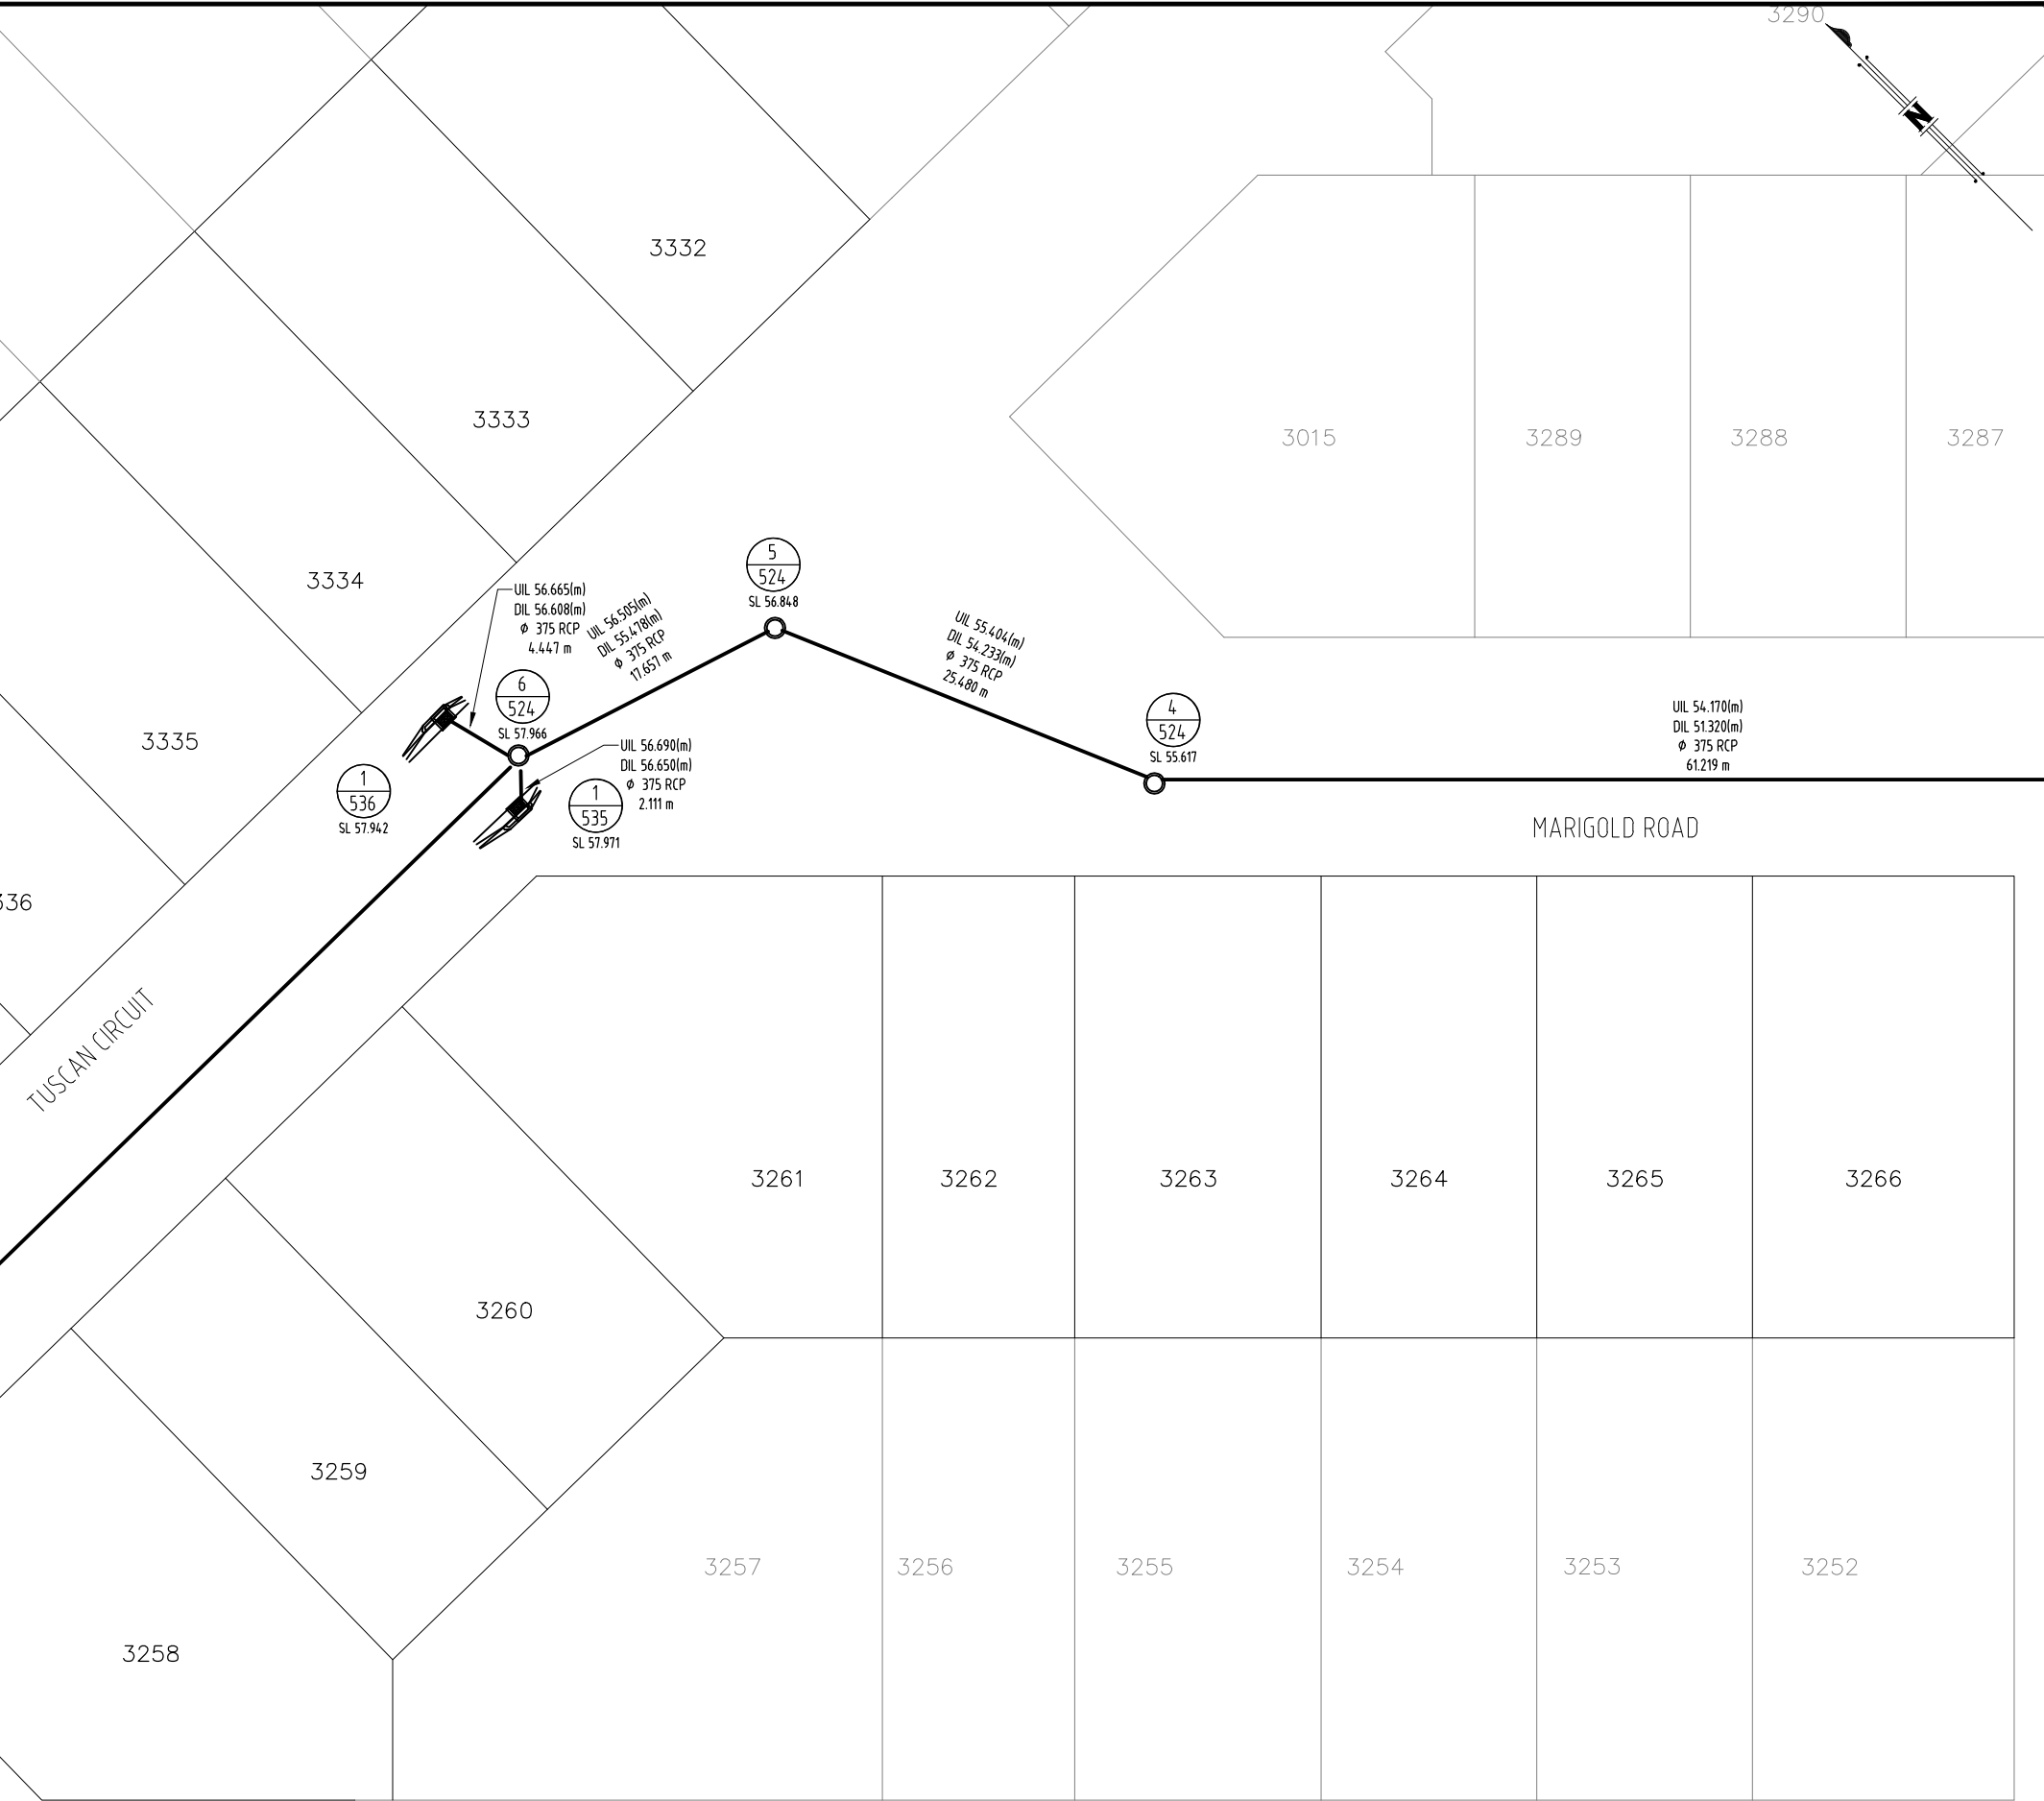

5  
522  
SL 60.296



**LOGAN CITY COUNCIL**  
 MIRVAC MIR-0905  
 AS CONSTRUCTED SURVEY - STORMWATER  
 EVERLEIGH PRECINCT 9.5C  
 GREENBANK QLD

SHEET 3 OF 4 SHEETS	SCALE 1:250 A1
REVISION DATE 04/07/2023	REVISION <b>A</b>
DISCIPLINE CODE	
DRAWING NO.	
<b>ASC-STORM-03-9.5C</b>	


PM61308 RL  
 E: 498528.114  
 N: 6931171.033  
 RL: 54.660m



MARIGOLD ROAD

MARIGOLD ROAD

TUSCAN CIRCUIT

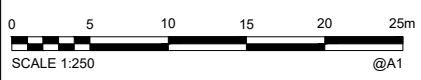

**AS CONSTRUCTED**

**ENGINEER'S CERTIFICATION**

I, \_\_\_\_\_, hereby certify that:


- The information contained in this drawing / document is in compliance with approved drawings and design.
- The new sewer and sewerage works defined by this drawing have been designed and constructed in accordance with the SEQ Code.
- This represents an accurate record of as-constructed works.
- I accept responsibility for the information contained in this drawing / document.

RPQC (signature) \_\_\_\_\_ RPQC No. \_\_\_\_\_ Date: \_\_\_\_\_

**REGISTERED SURVEYING ASSOCIATE CERTIFICATION**

I, Gordon Nicholson, hereby certify that the vertical and horizontal locations and dimensions shown on this plan are a true and correct record and were located by survey.

Registered Surveying Associate(sig) \_\_\_\_\_ Surveyor No. SA 34.05 Date: 04/07/2023

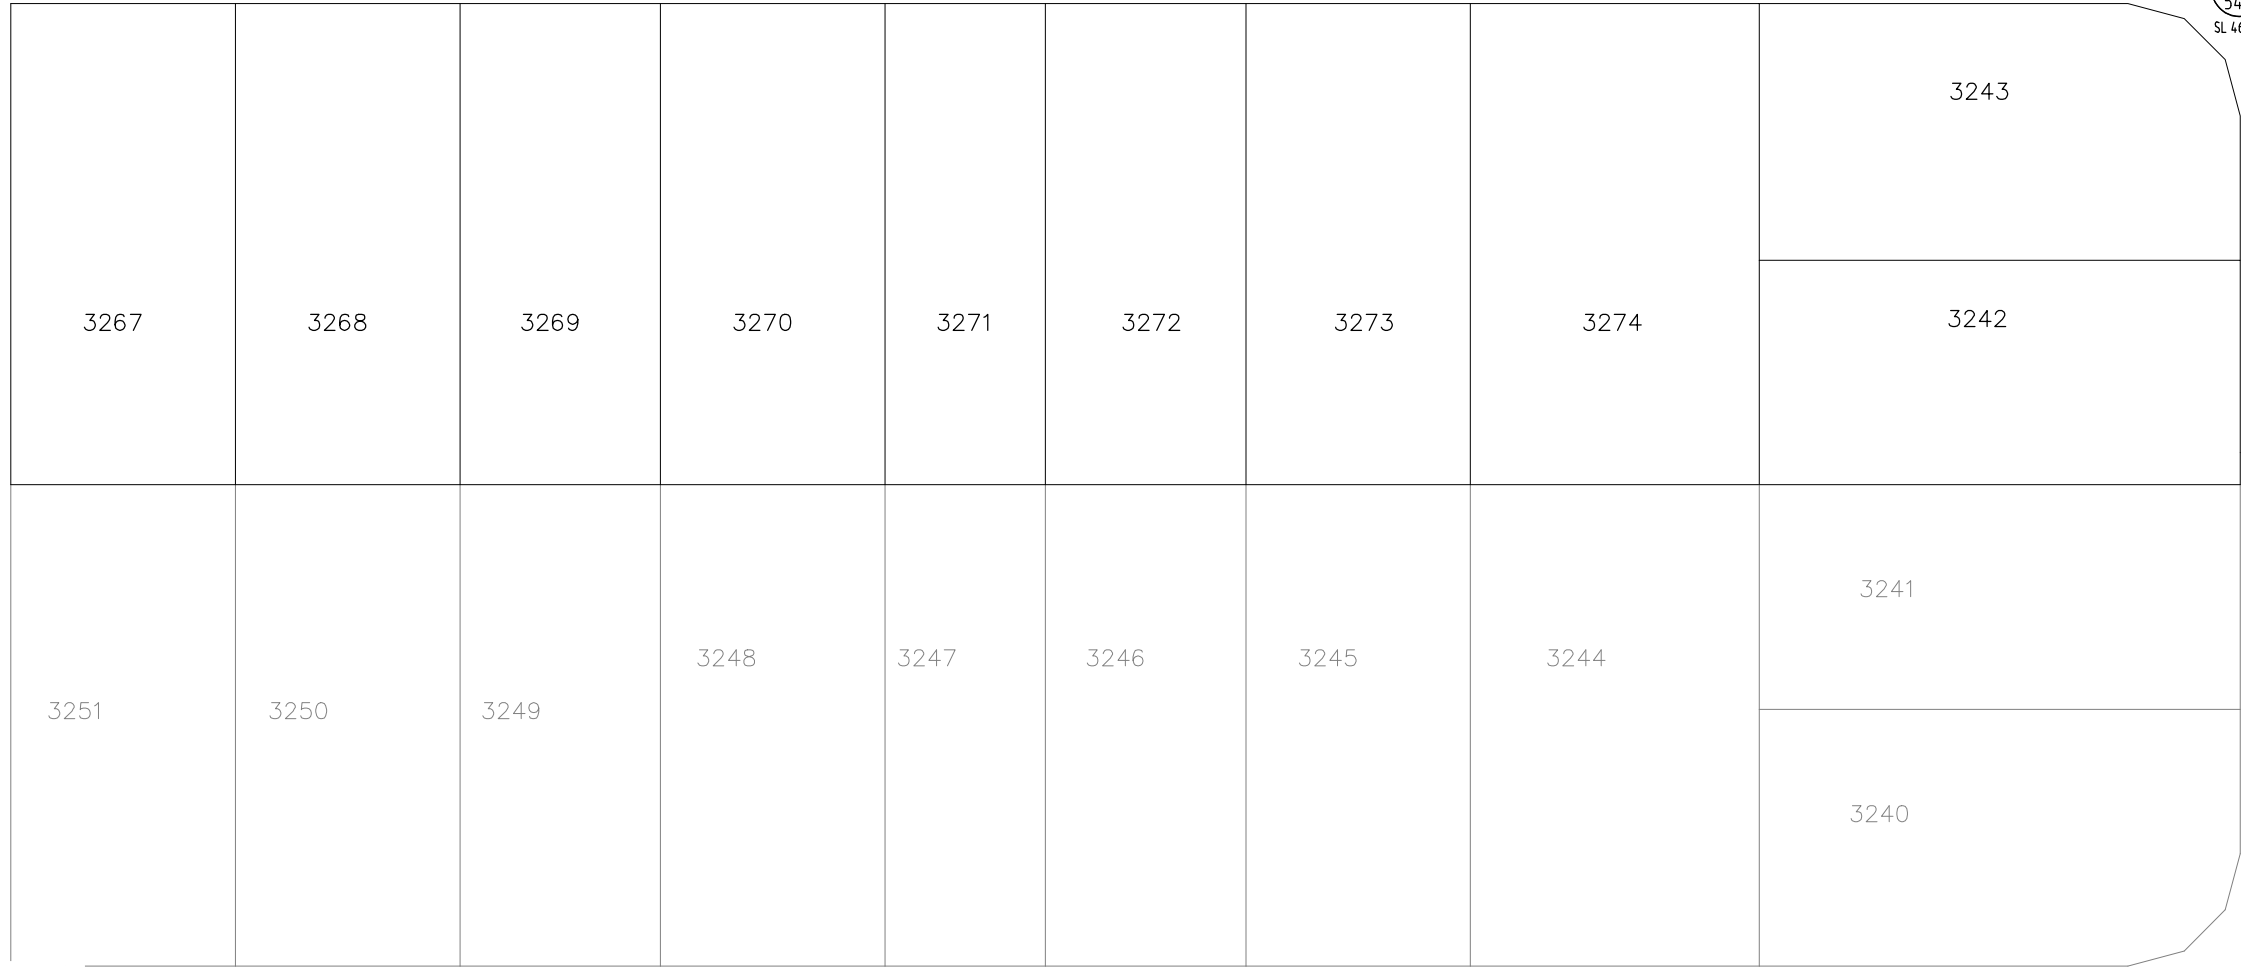

DESERT ROAD

**COORDINATE DATUM NOTE:**  
 HORIZONTAL COORDINATES(E,N) SUPPLIED ARE MAPPING GRID OF AUSTRALIA(MGA), ZONE 56 BASED ON THE UNIVERSAL TRANSVERSE MERCATOR PROJECTION AND THE GEOCENTRIC DATUM OF AUSTRALIA 1994.  
 HORIZONTAL DATUM DERIVED FROM PSM 61308 E 498528.114 N 6931171.033.  
 LEVELS SUPPLIED ARE ON THE AUSTRALIAN HEIGHT DATUM(AHD)  
 LEVEL DATUM DERIVED FROM PSM 61308 RL54.660 (AHD)

<b>A1</b>	INDEX	DATE	REVISIONS	DRAWN	CHECKED	PASSED	INITIALS	DATE
	A	04/07/2023	AS CONSTRUCTED	RDE	DAM	LS		

20 Shadforth Lane, Forest Glen QLD 4086  
 Ph: 07 5498 3300 Fax: 07 5498 3300 Email: info@shadforth.com.au

**LOGAN CITY COUNCIL**

MIRVAC MIR-0905  
 AS CONSTRUCTED SURVEY - STORMWATER  
 EVERLEIGH PRECINCT 9.5C  
 GREENBANK QLD

SHEET 4 OF 4 SHEETS	SCALE 1:250 A1
REVISION DATE 04/07/2023	REVISION <b>A</b>
DISCIPLINE CODE -	
DRAWING NO. <b>ASC-STORM-04-9.5C</b>	