




**AS CONSTRUCTED**

**REGISTERED SURVEYING ASSOCIATE CERTIFICATION**

I, Gordon Nicholson, hereby certify that the vertical and horizontal locations and dimensions shown on this plan are a true and correct record and were located by survey.

Registered Surveying Associate(sig.) Surveyor No. SA 3405 Date: 04/07/2023

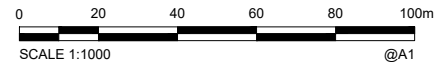

**COORDINATE DATUM NOTE:**  
 HORIZONTAL COORDINATES(E,N) SUPPLIED ARE MAPPING GRID OF AUSTRALIA(MGA), ZONE 56 BASED ON THE UNIVERSAL TRANSVERSE MERCATOR PROJECTION AND THE GEOCENTRIC DATUM OF AUSTRALIA 1994.  
 HORIZONTAL DATUM DERIVED FROM PSM 61308 E 4 98528.114 N 6931171.033.  
 LEVELS SUPPLIED ARE ON THE AUSTRALIAN HEIGHT DATUM(AHD)  
 LEVEL DATUM DERIVED FROM PSM 61308 RL54.660 (AHD)

	WATER METER BOX
	WATER REDUCER
	WATER BEND
	WATER TAPING BAND
	WATER BALL VALVE/STOP VALVE
	WATER FIRE HYDRANT
	WATERMAIN LINE (SIZE AND CLASS AS SHOWN)

**ENGINEER'S CERTIFICATION**

I, \_\_\_\_\_, hereby certify that:

- The information contained in this drawing / document is in compliance with approved drawings and design.
- The new water and sewerage works defined by this drawing have been designed and constructed in accordance with the SEQ Code.
- This represents an accurate record of as-constructed works
- I accept responsibility for the information contained in this drawing / document.

RPEQ (signature) RPEQ No. \_\_\_\_\_ Date: \_\_\_\_\_

**A1**

INDEX	DATE	REVISIONS	DRAWN	CHECKED	PASSED	INITIALS	DATE
A	04/07/2023	AS CONSTRUCTED	RDE	DAM	CW		04/07/2023





\\Desktop\LOGAN CITY COUNCIL LOGO.png

**LOGAN CITY COUNCIL**

MIRVAC MIR-0905  
 AS CONSTRUCTED SURVEY - WATERMAIN  
 EVERLEIGH PRECINCT 9.5  
 GREENBANK QLD


SHEET 1 OF 4 SHEETS	SCALE 1:1000 A1
REVISION DATE 04/07/2023	REVISION A
DISCIPLINE CODE -	
DRAWING NO.	
<b>ASC-WATERMAIN-01-9.5C</b>	

PM61308 RL  
 E: 498528.114  
 N: 6931171.033  
 RL: 54.660m

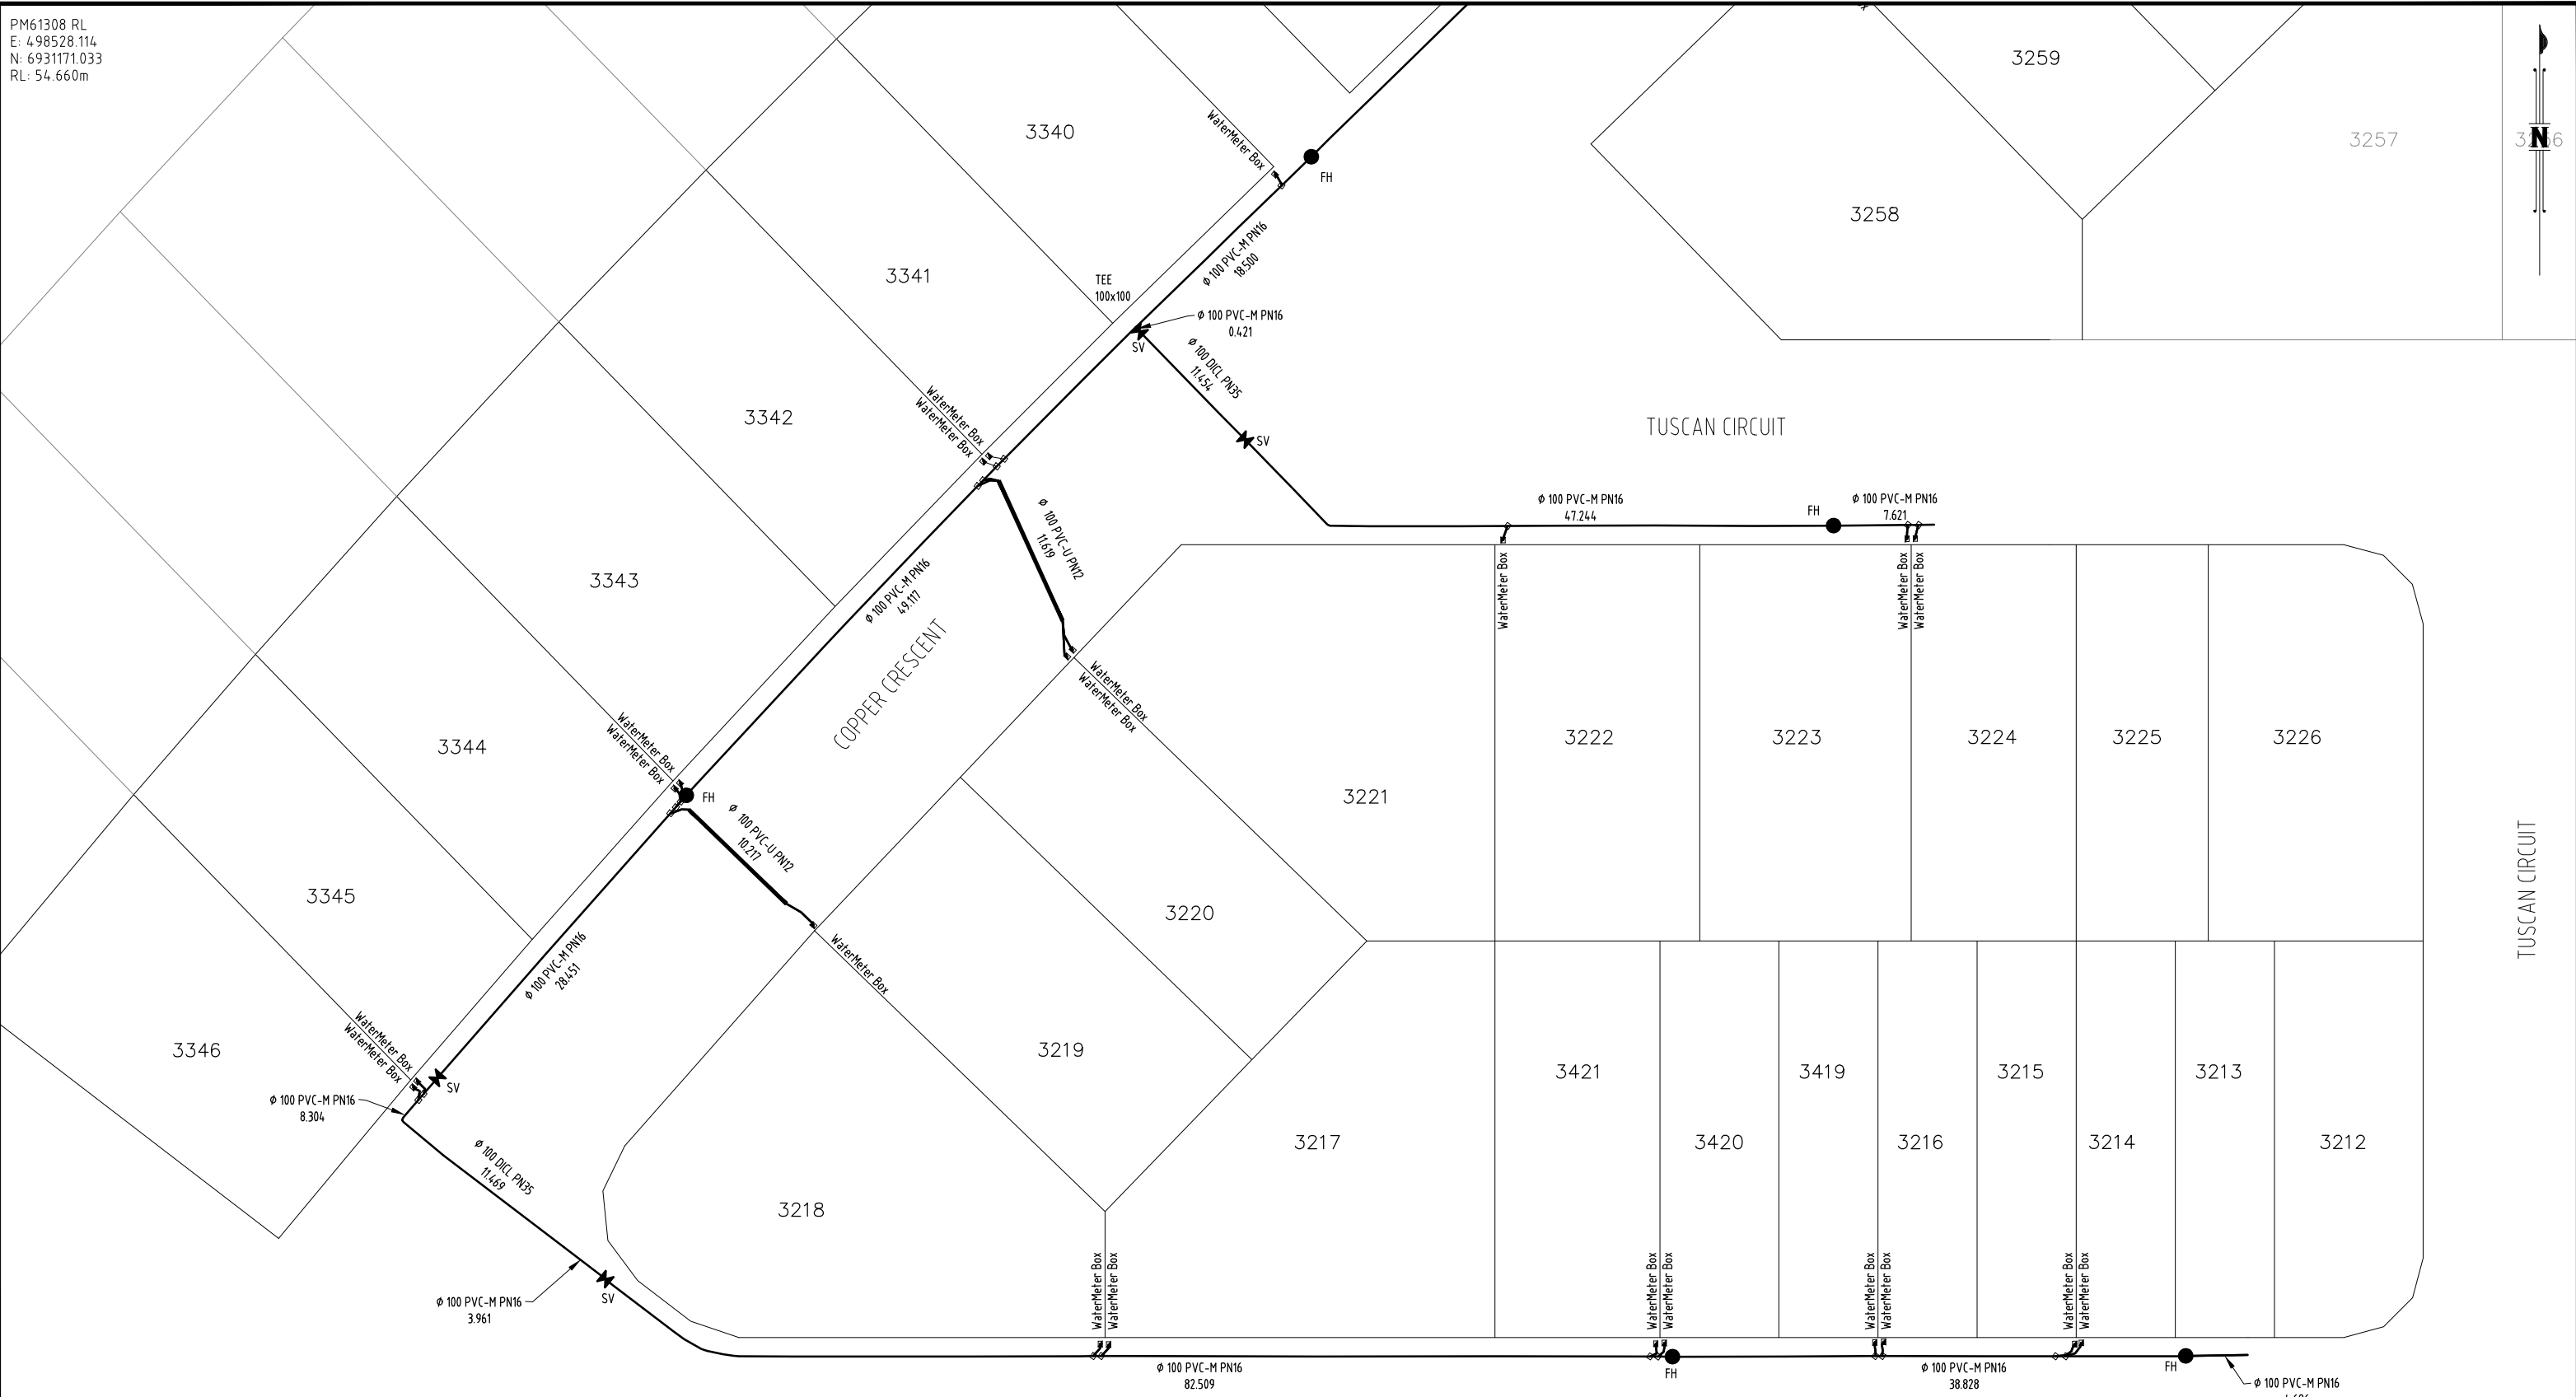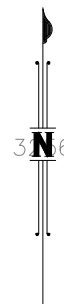

**AS CONSTRUCTED**

**REGISTERED SURVEYING ASSOCIATE CERTIFICATION**  
 I, Gordon Nicholson, hereby certify that the vertical and horizontal locations and dimensions shown on this plan are a true and correct record and were located by survey.  
 Registered Surveying Associate[sig.] Surveyor No. SA 3405 Date: 04/07/2023

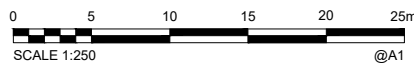

**COORDINATE DATUM NOTE:**  
 HORIZONTAL COORDINATES(E,N) SUPPLIED ARE MAPPING GRID OF AUSTRALIA(MGA), ZONE 56 BASED ON THE UNIVERSAL TRANSVERSE MERCATOR PROJECTION AND THE GEOCENTRIC DATUM OF AUSTRALIA 1994.  
 HORIZONTAL DATUM DERIVED FROM PSM 61308 E 498528.114 N 6931171.033.  
 LEVELS SUPPLIED ARE ON THE AUSTRALIAN HEIGHT DATUM(AHD)  
 LEVEL DATUM DERIVED FROM PSM 61308 RL54.660 (AHD)

	WATER METER BOX
	WATER REDUCER
	WATER BEND
	WATER TAPING BAND
	WATER BALL VALVE/STOP VALVE
	WATER FIRE HYDRANT
	WATERMAIN LINE (SIZE AND CLASS AS SHOWN)

**ENGINEER'S CERTIFICATION**  
 I, \_\_\_\_\_, hereby certify that:  
 1. The information contained in this drawing / document is in compliance with approved drawings and design.  
 2. The new water and sewerage works defined by this drawing have been designed and constructed in accordance with the SEQ Code.  
 3. This represents an accurate record of as-constructed works.  
 4. I accept responsibility for the information contained in this drawing / document.  
 RPEQ (signature) RPEQ No. \_\_\_\_\_ Date: \_\_\_\_\_

<b>A1</b>	INDEX	DATE	REVISIONS	DRAWN	CHECKED	PASSED	INITIALS	DATE
	A	04/07/2023	AS CONSTRUCTED	RDE	DAM	CW		



\\Desktop\LOGAN CITY COUNCIL LOGO.png

**LOGAN CITY COUNCIL**  
 MIRVAC MIR-0905  
 AS CONSTRUCTED SURVEY - WATERMAIN  
 EVERLEIGH PRECINCT 9.5  
 GREENBANK QLD

SHEET 2 OF 4 SHEETS	SCALE 1:250 A1
REVISION DATE 04/07/2023	REVISION A
DISCIPLINE CODE -	
DRAWING NO. ASC-WATERMAIN-02-9.5C	


PM61308 RL  
 E: 498528.114  
 N: 6931171.033  
 RL: 54.660m

**AS CONSTRUCTED**

**REGISTERED SURVEYING ASSOCIATE CERTIFICATION**

I, Gordon Nicholson, hereby certify that the vertical and horizontal locations and dimensions shown on this plan are a true and correct record and were located by survey.

Registered Surveying Surveyor No. SA 3405 Date: 04/07/2023 Associate(sig.)

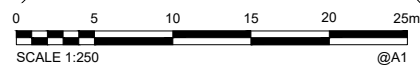

**COORDINATE DATUM NOTE:**  
 HORIZONTAL COORDINATES(E,N) SUPPLIED ARE MAPPING GRID OF AUSTRALIA(MGA), ZONE 56 BASED ON THE UNIVERSAL TRANSVERSE MERCATOR PROJECTION AND THE GEOCENTRIC DATUM OF AUSTRALIA 1994.  
 HORIZONTAL DATUM DERIVED FROM PSM 61308 E 498528.114 N 6931171.033.  
 LEVELS SUPPLIED ARE ON THE AUSTRALIAN HEIGHT DATUM(AHD)  
 LEVEL DATUM DERIVED FROM PSM 61308 RL54.660 (AHD)

	WATER METER BOX
	WATER REDUCER
	WATER BEND
	WATER TAPING BAND
	WATER BALL VALVE/STOP VALVE
	WATER FIRE HYDRANT
	WATERMAIN LINE (SIZE AND CLASS AS SHOWN)

**ENGINEER'S CERTIFICATION**

I, \_\_\_\_\_, hereby certify that:

- The information contained in this drawing / document is in compliance with approved drawings and design.
- The new water and sewerage works defined by this drawing have been designed and constructed in accordance with the SEQ Code.
- This represents an accurate record of as-constructed works.
- I accept responsibility for the information contained in this drawing / document.

\_\_\_\_\_  
 RPEQ (signature) RPEQ No. \_\_\_\_\_ Date: \_\_\_\_\_

<b>A1</b>	INDEX	DATE	REVISIONS	DRAWN	CHECKED	PASSED	INITIALS	DATE
	A	04/07/2023	AS CONSTRUCTED	RDE	DAM	CW	PASSED	04/07/2023

**shadforth**


29 Shadforth Lane, Forest Glen QLD 4086  
 Ph: 07 5498 3300 Fax: 07 5498 3300 Email: info@shadforth.com.au

\\Desktop\LOGAN CITY COUNCIL\LOGO.png


**LOGAN CITY COUNCIL**

MIRVAC MIR-0905  
 AS CONSTRUCTED SURVEY - WATERMAIN  
 EVERLEIGH PRECINCT 9.5  
 GREENBANK QLD

SHEET 3 OF 4 SHEETS	SCALE 1:250 A1
REVISION DATE 04/07/2023	REVISION <b>A</b>
DISCIPLINE CODE -	
DRAWING NO. <b>ASC-WATERMAIN-03-9.5C</b>	

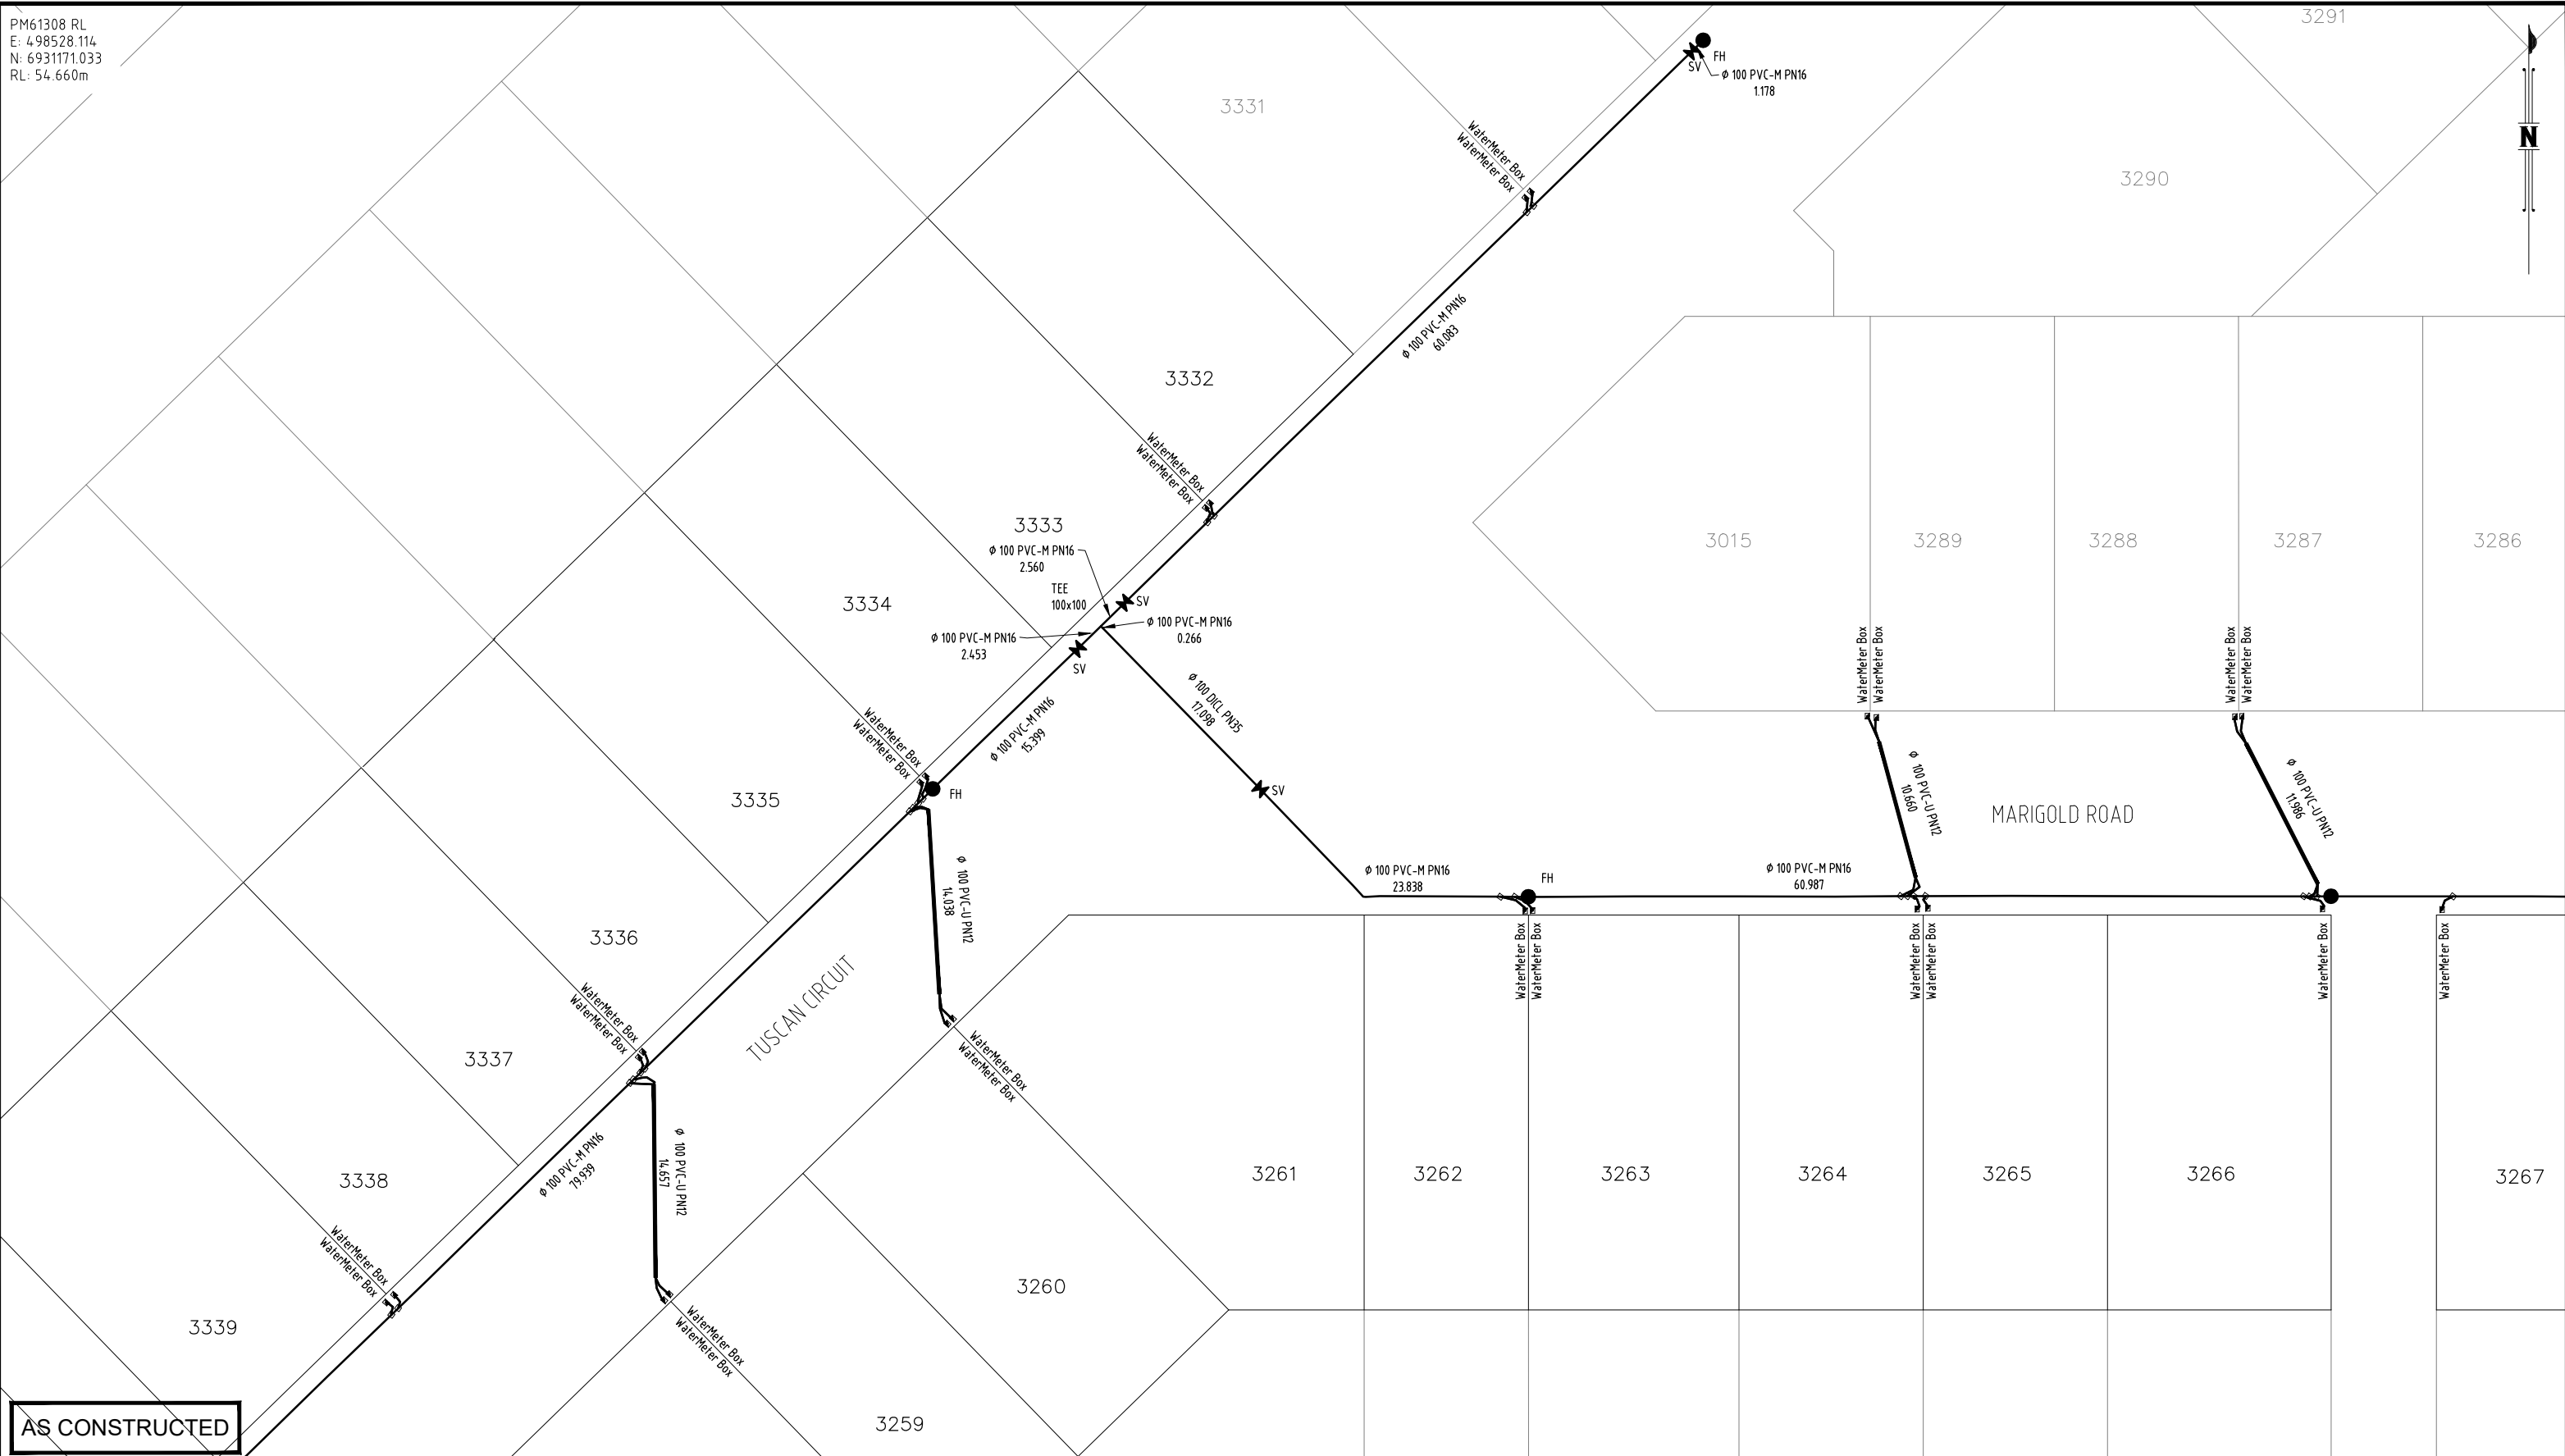


PM61308 RL  
E: 498528.114  
N: 6931171.033  
RL: 54.660m

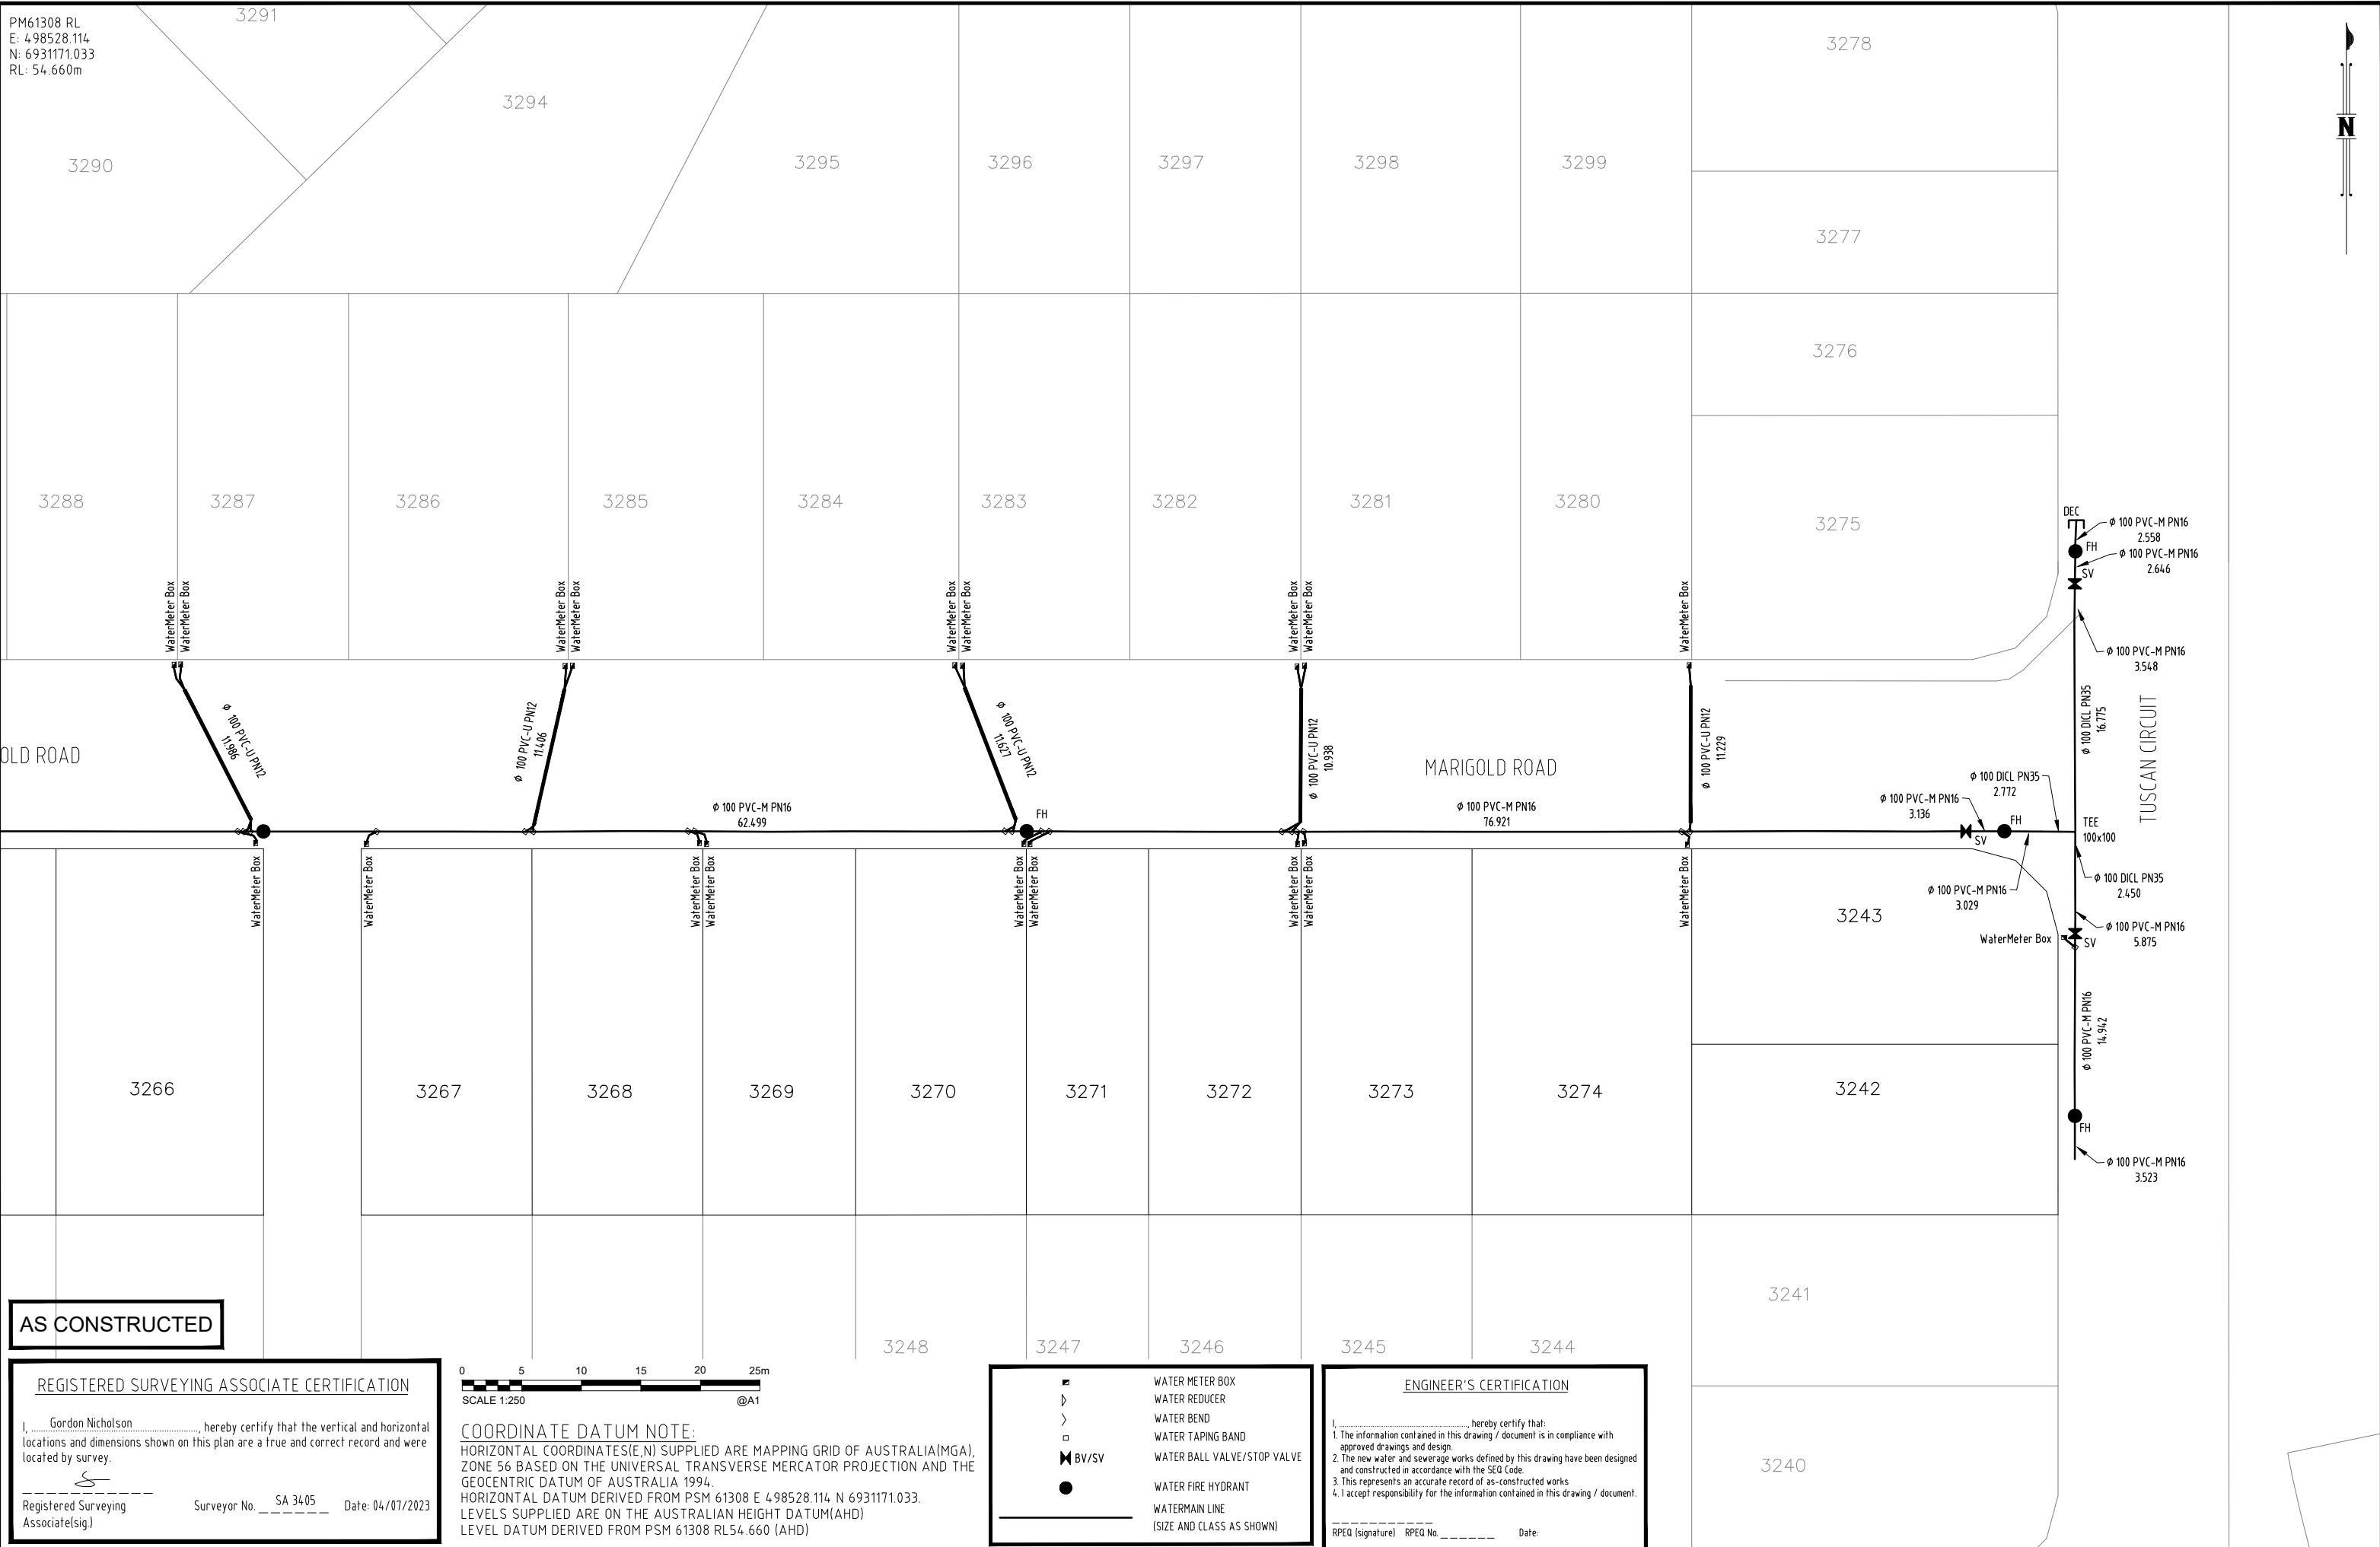

**AS CONSTRUCTED**

**REGISTERED SURVEYING ASSOCIATE CERTIFICATION**  
I, Gordon Nicholson, hereby certify that the vertical and horizontal locations and dimensions shown on this plan are a true and correct record and were located by survey.  
Registered Surveying Associate[sig.] Surveyor No. SA 3405 Date: 04/07/2023

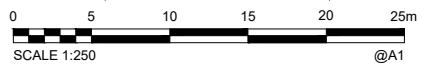

**COORDINATE DATUM NOTE:**  
HORIZONTAL COORDINATES(E,N) SUPPLIED ARE MAPPING GRID OF AUSTRALIA(MGA), ZONE 56 BASED ON THE UNIVERSAL TRANSVERSE MERCATOR PROJECTION AND THE GEOCENTRIC DATUM OF AUSTRALIA 1994.  
HORIZONTAL DATUM DERIVED FROM PSM 61308 E 498528.114 N 6931171.033.  
LEVELS SUPPLIED ARE ON THE AUSTRALIAN HEIGHT DATUM(AHD)  
LEVEL DATUM DERIVED FROM PSM 61308 RL54.660 (AHD)

	WATER METER BOX
	WATER REDUCER
	WATER BEND
	WATER TAPING BAND
	WATER BALL VALVE/STOP VALVE
	WATER FIRE HYDRANT
	WATERMAIN LINE (SIZE AND CLASS AS SHOWN)

**ENGINEER'S CERTIFICATION**  
I, \_\_\_\_\_, hereby certify that:  
1. The information contained in this drawing / document is in compliance with approved drawings and design.  
2. The new water and sewerage works defined by this drawing have been designed and constructed in accordance with the SEQ Code.  
3. This represents an accurate record of as-constructed works.  
4. I accept responsibility for the information contained in this drawing / document.  
RPEQ (signature) RPEQ No. \_\_\_\_\_ Date: \_\_\_\_\_

<b>A1</b>	INDEX	DATE	REVISIONS	DRAWN	CHECKED	PASSED	INITIALS	DATE
	A	04/07/2023	AS CONSTRUCTED	RDE	DAM	CW		

**shadforth**  
20 Shadforth Lane, Forest Glen QLD 4086  
Ph: 07 5498 3300 Fax: 07 5498 3300 Email: info@shadforth.com.au

\\Desktop\LOGAN CITY COUNCIL LOGO.png

**LOGAN CITY COUNCIL**  
MIRVAC MIR-0905  
AS CONSTRUCTED SURVEY - WATERMAIN  
EVERLEIGH PRECINCT 9.5  
GREENBANK QLD

SHEET 4 OF 4 SHEETS	SCALE 1:250 A1
REVISION DATE 04/07/2023	REVISION <b>A</b>
DISCIPLINE CODE	
DRAWING NO.	
<b>ASC-WATERMAIN-04-9.5C</b>	