


AS CONSTRUCTED

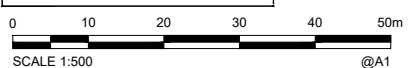

COORDINATE DATUM NOTE:
 HORIZONTAL COORDINATES (E, N) SUPPLIED ARE MAPPING GRID OF AUSTRALIA (MGA), ZONE 56 BASED ON THE UNIVERSAL TRANSVERSE MERCATOR PROJECTION AND THE GEOCENTRIC DATUM OF AUSTRALIA 1994.
 HORIZONTAL DATUM DERIVED FROM PSM 61308 E 4 98528.114 N 6931171.033.
 LEVELS SUPPLIED ARE ON THE AUSTRALIAN HEIGHT DATUM (AHD) LEVEL DATUM DERIVED FROM PSM 61308 RL54.660 (AHD)

PAVEMENT DESIGN

| | | |
|--|------------------------------------|---|
| TUSCAN CIRCUIT AC(mm) - 35 BASE(2.1)(mm) - 150 SUBBASE(2.3)(mm) - 150 | RETAINING WALLS ACCOUSTIC WALLS | SPOT HEIGHTS + 56.36 WALL HEIGHTS 55.524 |
|--|------------------------------------|---|

CLAY COURT
AC(mm) - 35
BASE(2.1)(mm) - 150
SUBBASE(2.3)(mm) - 150

ENGINEER'S CERTIFICATION

I, _____, hereby certify that:
 1. The information contained in this drawing / document is in compliance with approved drawings and design.
 2. This represents an accurate record of as-constructed works
 3. I accept responsibility for the information contained in this drawing / document.

RPEQ (signature) RPEQ No. _____ Date: _____

REGISTERED SURVEYING ASSOCIATE CERTIFICATION

I, Gordon Nicholson, hereby certify that the vertical and horizontal locations and dimensions shown on this plan are a true and correct record and were located by survey.

Registered Surveying Associate (sig) Surveyor No. SA 3405 Date: 27/09/2023



| | | | | | | | |
|----|-------|------------|----------------|-----------|-------|---------|--------|
| A1 | INDEX | DATE | AS CONSTRUCTED | REVISIONS | DRAWN | CHECKED | PASSED |
| | A | 27/09/2023 | AS CONSTRUCTED | | RDE | DAM | CW |

| | | |
|----------|------|------------|
| DRAWN | RDE | 27/09/2023 |
| CHECKED | DAM | 27/09/2023 |
| PASSED | CW | 27/09/2023 |
| INITIALS | DATE | |



LOGAN CITY COUNCIL
 MIRVAC MIR009-06
 AS CONSTRUCTED SURVEY - ROADS AND EARTHWORKS
 EVERLEIGH PRECINCT 9.6C
 GREENBANK QLD

| | |
|--------------------------------------|---------------|
| SHEET 1 OF 4 SHEETS | SCALE 1500 A1 |
| REVISION DATE 27/09/2023 | REVISION A |
| DISCIPLINE CODE - | |
| DRAWING NO. ASC-RDS AND EWKS-01-9.6C | |

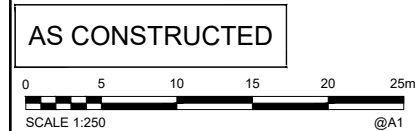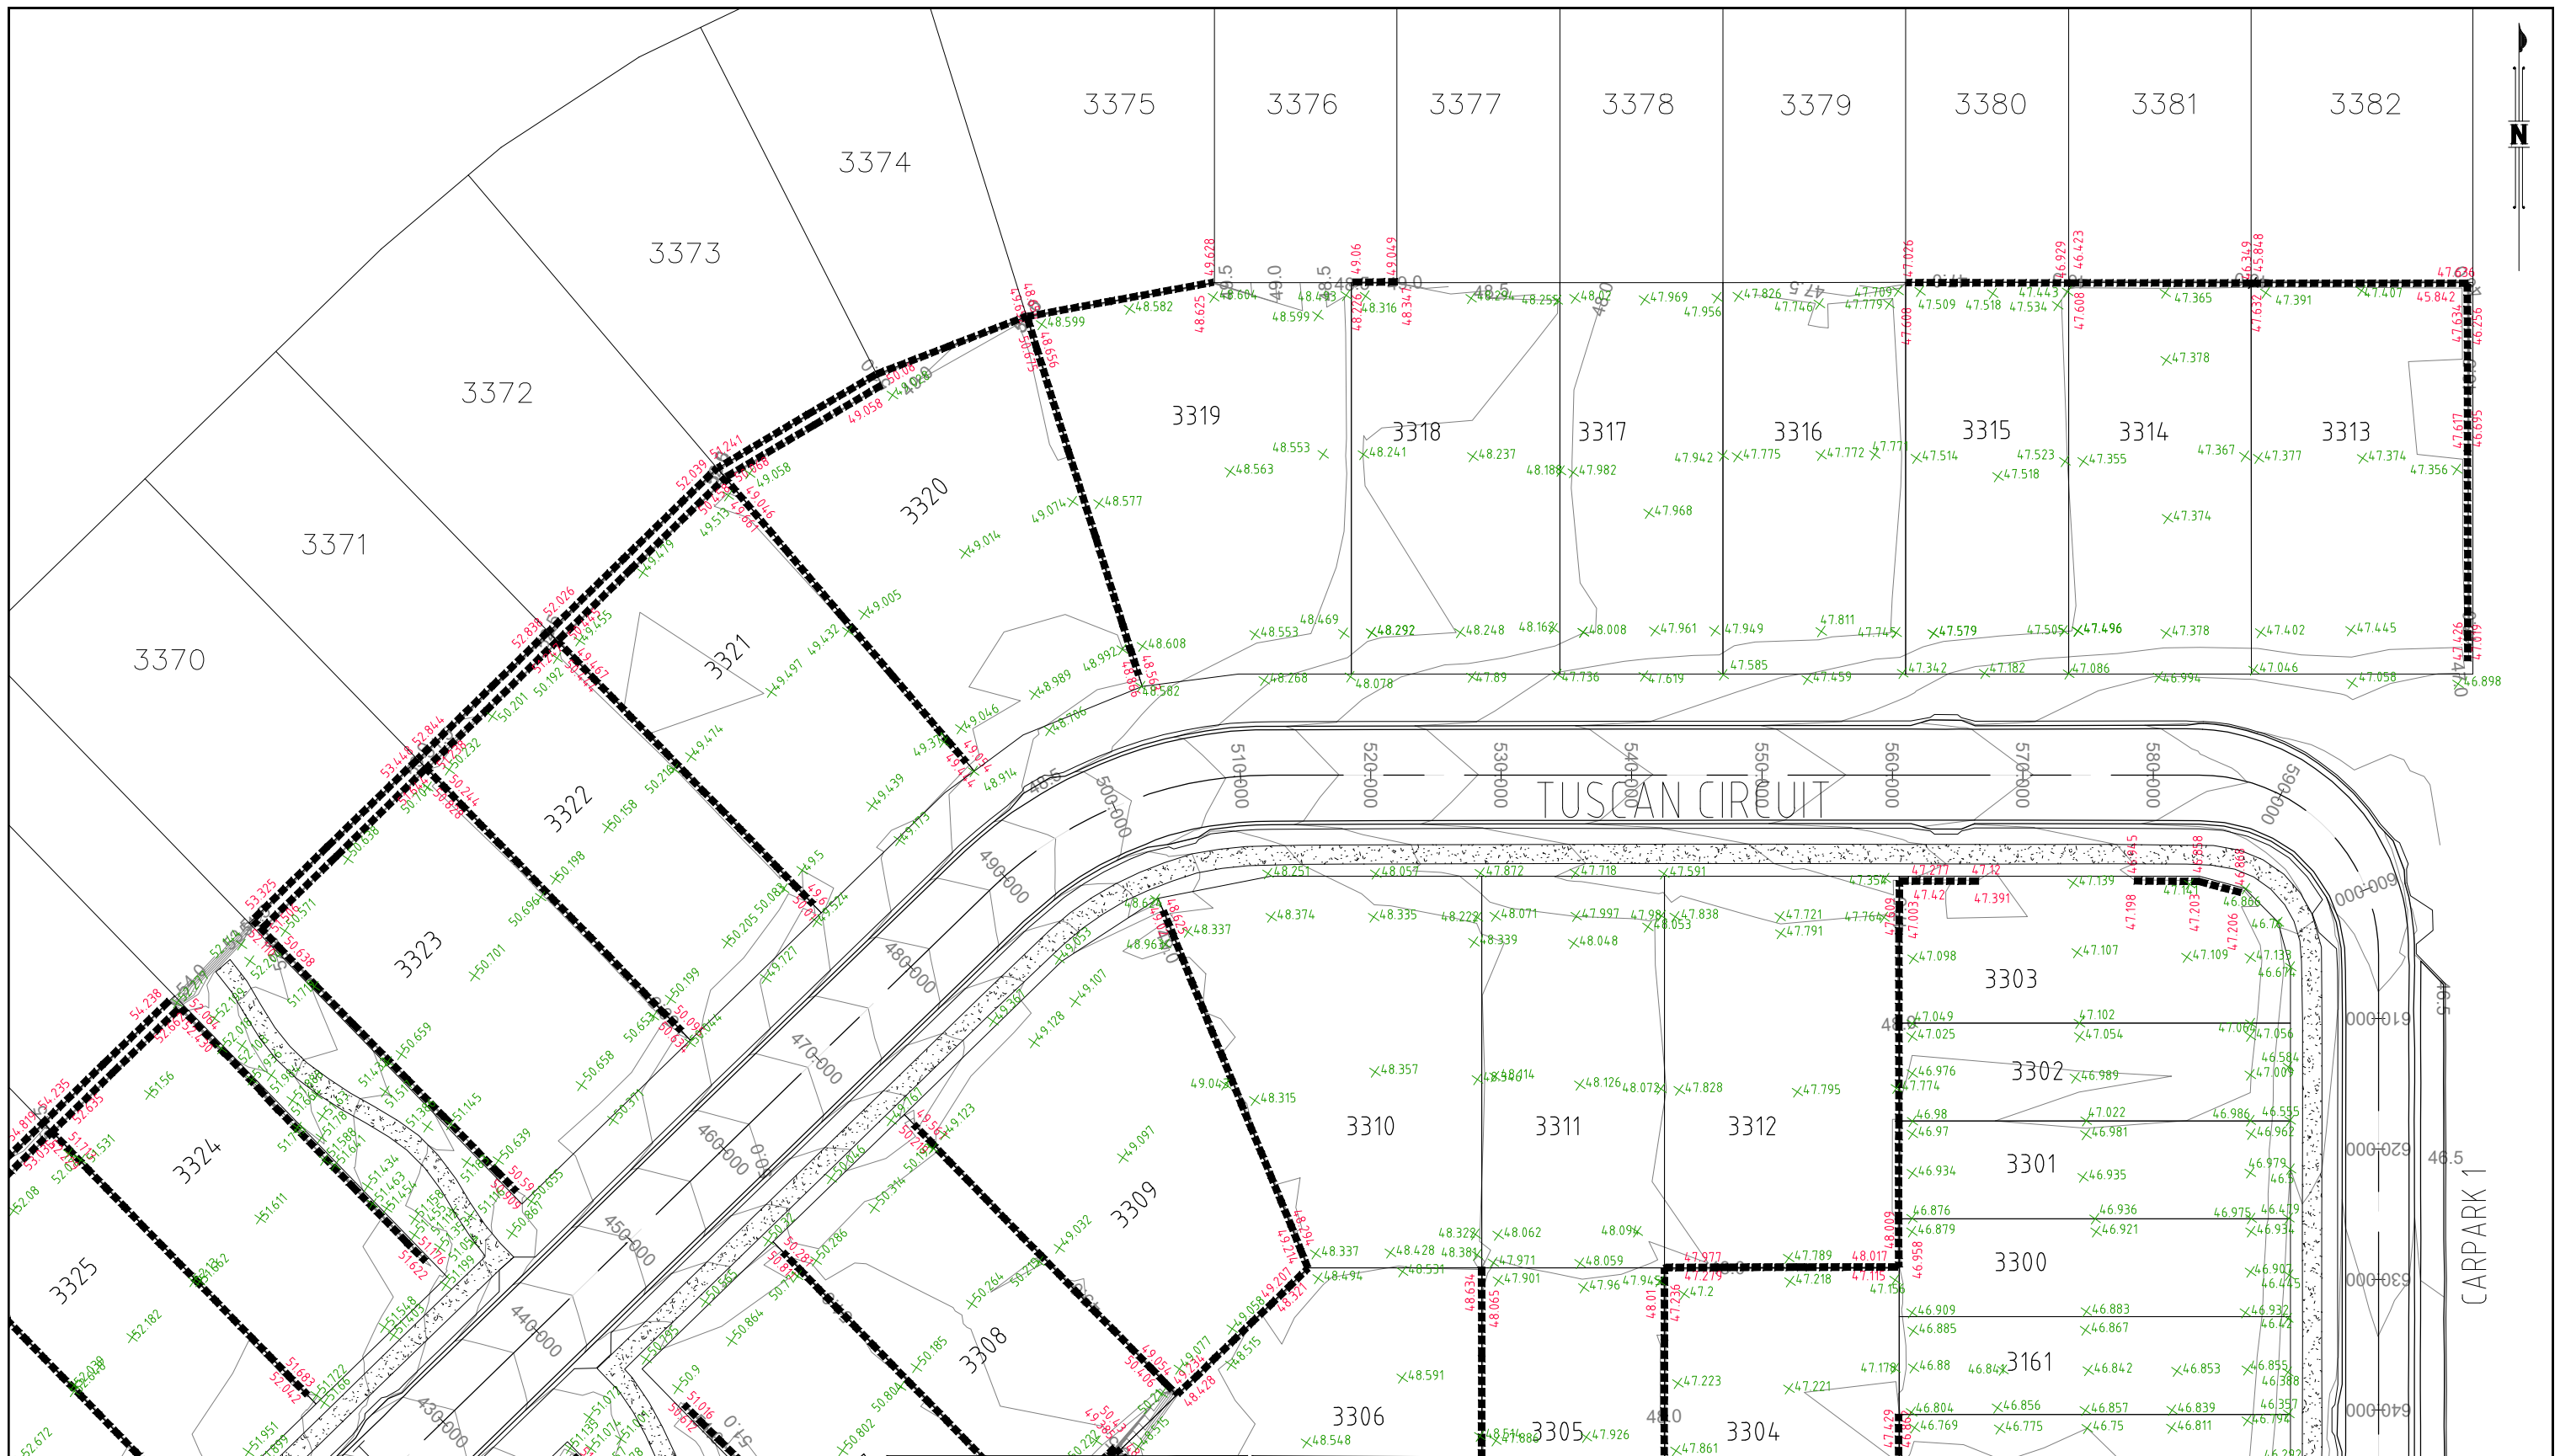

COORDINATE DATUM NOTE:

HORIZONTAL COORDINATES(E,N) SUPPLIED ARE MAPPING GRID OF AUSTRALIA(MGA), ZONE 56 BASED ON THE UNIVERSAL TRANSVERSE MERCATOR PROJECTION AND THE GEOCENTRIC DATUM OF AUSTRALIA 1994.

HORIZONTAL DATUM DERIVED FROM PSM 61308 E 4 98528.114 N 6931171.033

LEVELS SUPPLIED ARE ON THE AUSTRALIAN HEIGHT DATUM(AHD) LEVEL DATUM DERIVED FROM PSM 61308 RL54.660 (AHD)

PAVEMENT DESIGN

TUSCAN CIRCUIT
AC(mm)- 35
BASE(2.1)(mm) - 150
SUBBASE(2.3)(mm) - 150

RETAINING WALLS
ACOUSTIC WALLS

SPOT HEIGHTS
+ 56.36
WALL HEIGHTS
56.600
55.524

CLAY COURT
AC(mm)- 35
BASE(2.1)(mm) - 150
SUBBASE(2.3)(mm) - 150

ENGINEER'S CERTIFICATION

I, _____, hereby certify that:

- The information contained in this drawing / document is in compliance with approved drawings and design.
- This represents an accurate record of as-constructed works
- I accept responsibility for the information contained in this drawing / document.

RPEQ (signature) RPEQ No. _____ Date: _____

REGISTERED SURVEYING ASSOCIATE CERTIFICATION

I, Gordon Nicholson, hereby certify that the vertical and horizontal locations and dimensions shown on this plan are a true and correct record and were located by survey.

Registered Surveying Associate(s) _____ Surveyor No. SA 3405 Date: 27/09/2023

| | | | | | | | |
|-----------|-------|------------|----------------|-----------|-------|---------|--------|
| A1 | INDEX | DATE | AS CONSTRUCTED | REVISIONS | DRAWN | CHECKED | PASSED |
| | A | 27/09/2023 | AS CONSTRUCTED | | RDE | DAM | CW |

| | | |
|----------|------|------------|
| DRAWN | RDE | 27/09/2023 |
| CHECKED | DAM | 27/09/2023 |
| PASSED | CW | 27/09/2023 |
| INITIALS | DATE | |




LOGAN CITY COUNCIL

MIRVAC MIR009-06
AS CONSTRUCTED SURVEY - ROADS AND EARTHWORKS
EVERLEIGH PRECINCT 9.6C
GREENBANK QLD

| | |
|--------------------------------------|----------------|
| SHEET 2 OF 4 SHEETS | SCALE 1:250 A1 |
| REVISION DATE 27/09/2023 | REVISION A |
| DISCIPLINE CODE - | |
| DRAWING NO. ASC-RDS AND EWKS-02-9.6C | |



AS CONSTRUCTED

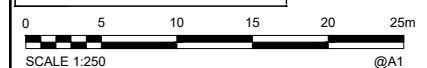

COORDINATE DATUM NOTE:
 HORIZONTAL COORDINATES (E, N) SUPPLIED ARE MAPPING GRID OF AUSTRALIA (MGA), ZONE 56 BASED ON THE UNIVERSAL TRANSVERSE MERCATOR PROJECTION AND THE GEOCENTRIC DATUM OF AUSTRALIA 1994.
 HORIZONTAL DATUM DERIVED FROM PSM 61308 E 4 98528.114 N 6931171.033.
 LEVELS SUPPLIED ARE ON THE AUSTRALIAN HEIGHT DATUM (AHD) LEVEL DATUM DERIVED FROM PSM 61308 RL54.660 (AHD)

PAVEMENT DESIGN
 TUSCAN CIRCUIT
 AC(mm) - 35
 BASE(2.1)(mm) - 150
 SUBBASE(2.3)(mm) - 150

RETAINING WALLS
ACCOUSTIC WALLS

SPOT HEIGHTS
 + 56.36
WALL HEIGHTS
 56.600
 55.524

ENGINEER'S CERTIFICATION
 I, _____, hereby certify that:
 1. The information contained in this drawing / document is in compliance with approved drawings and design.
 2. This represents an accurate record of as-constructed works
 3. I accept responsibility for the information contained in this drawing / document.
 RPEQ (signature) RPEQ No. _____ Date: _____

REGISTERED SURVEYING ASSOCIATE CERTIFICATION
 I, Gordon Nicholson, hereby certify that the vertical and horizontal locations and dimensions shown on this plan are a true and correct record and were located by survey.
 Registered Surveying Associate (sig.)
 Surveyor No. SA 3405 Date: 27/09/2023



| | | | | | | | |
|-----------|-------|------------|----------------|-----------|-------|---------|--------|
| A1 | INDEX | DATE | AS CONSTRUCTED | REVISIONS | DRAWN | CHECKED | PASSED |
| | A | 27/09/2023 | AS CONSTRUCTED | | RDE | DAM | CW |
| | | | | | | | |
| | | | | | | | |

| | | |
|----------|------|------------|
| DRAWN | RDE | 27/09/2023 |
| CHECKED | DAM | 27/09/2023 |
| PASSED | CW | 27/09/2023 |
| INITIALS | DATE | |



LOGAN CITY COUNCIL
 MIRVAC MIR009-06
 AS CONSTRUCTED SURVEY - ROADS AND EARTHWORKS
 EVERLEIGH PRECINCT 9.6C
 GREENBANK QLD

| | |
|--------------------------------------|----------------|
| SHEET 3 OF 4 SHEETS | SCALE 1:250 A1 |
| REVISION DATE 27/09/2023 | REVISION A |
| DISCIPLINE CODE - | |
| DRAWING NO. ASC-RDS AND EWKS-03-9.6C | |

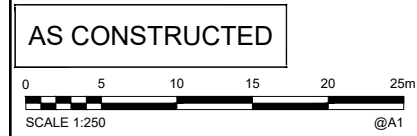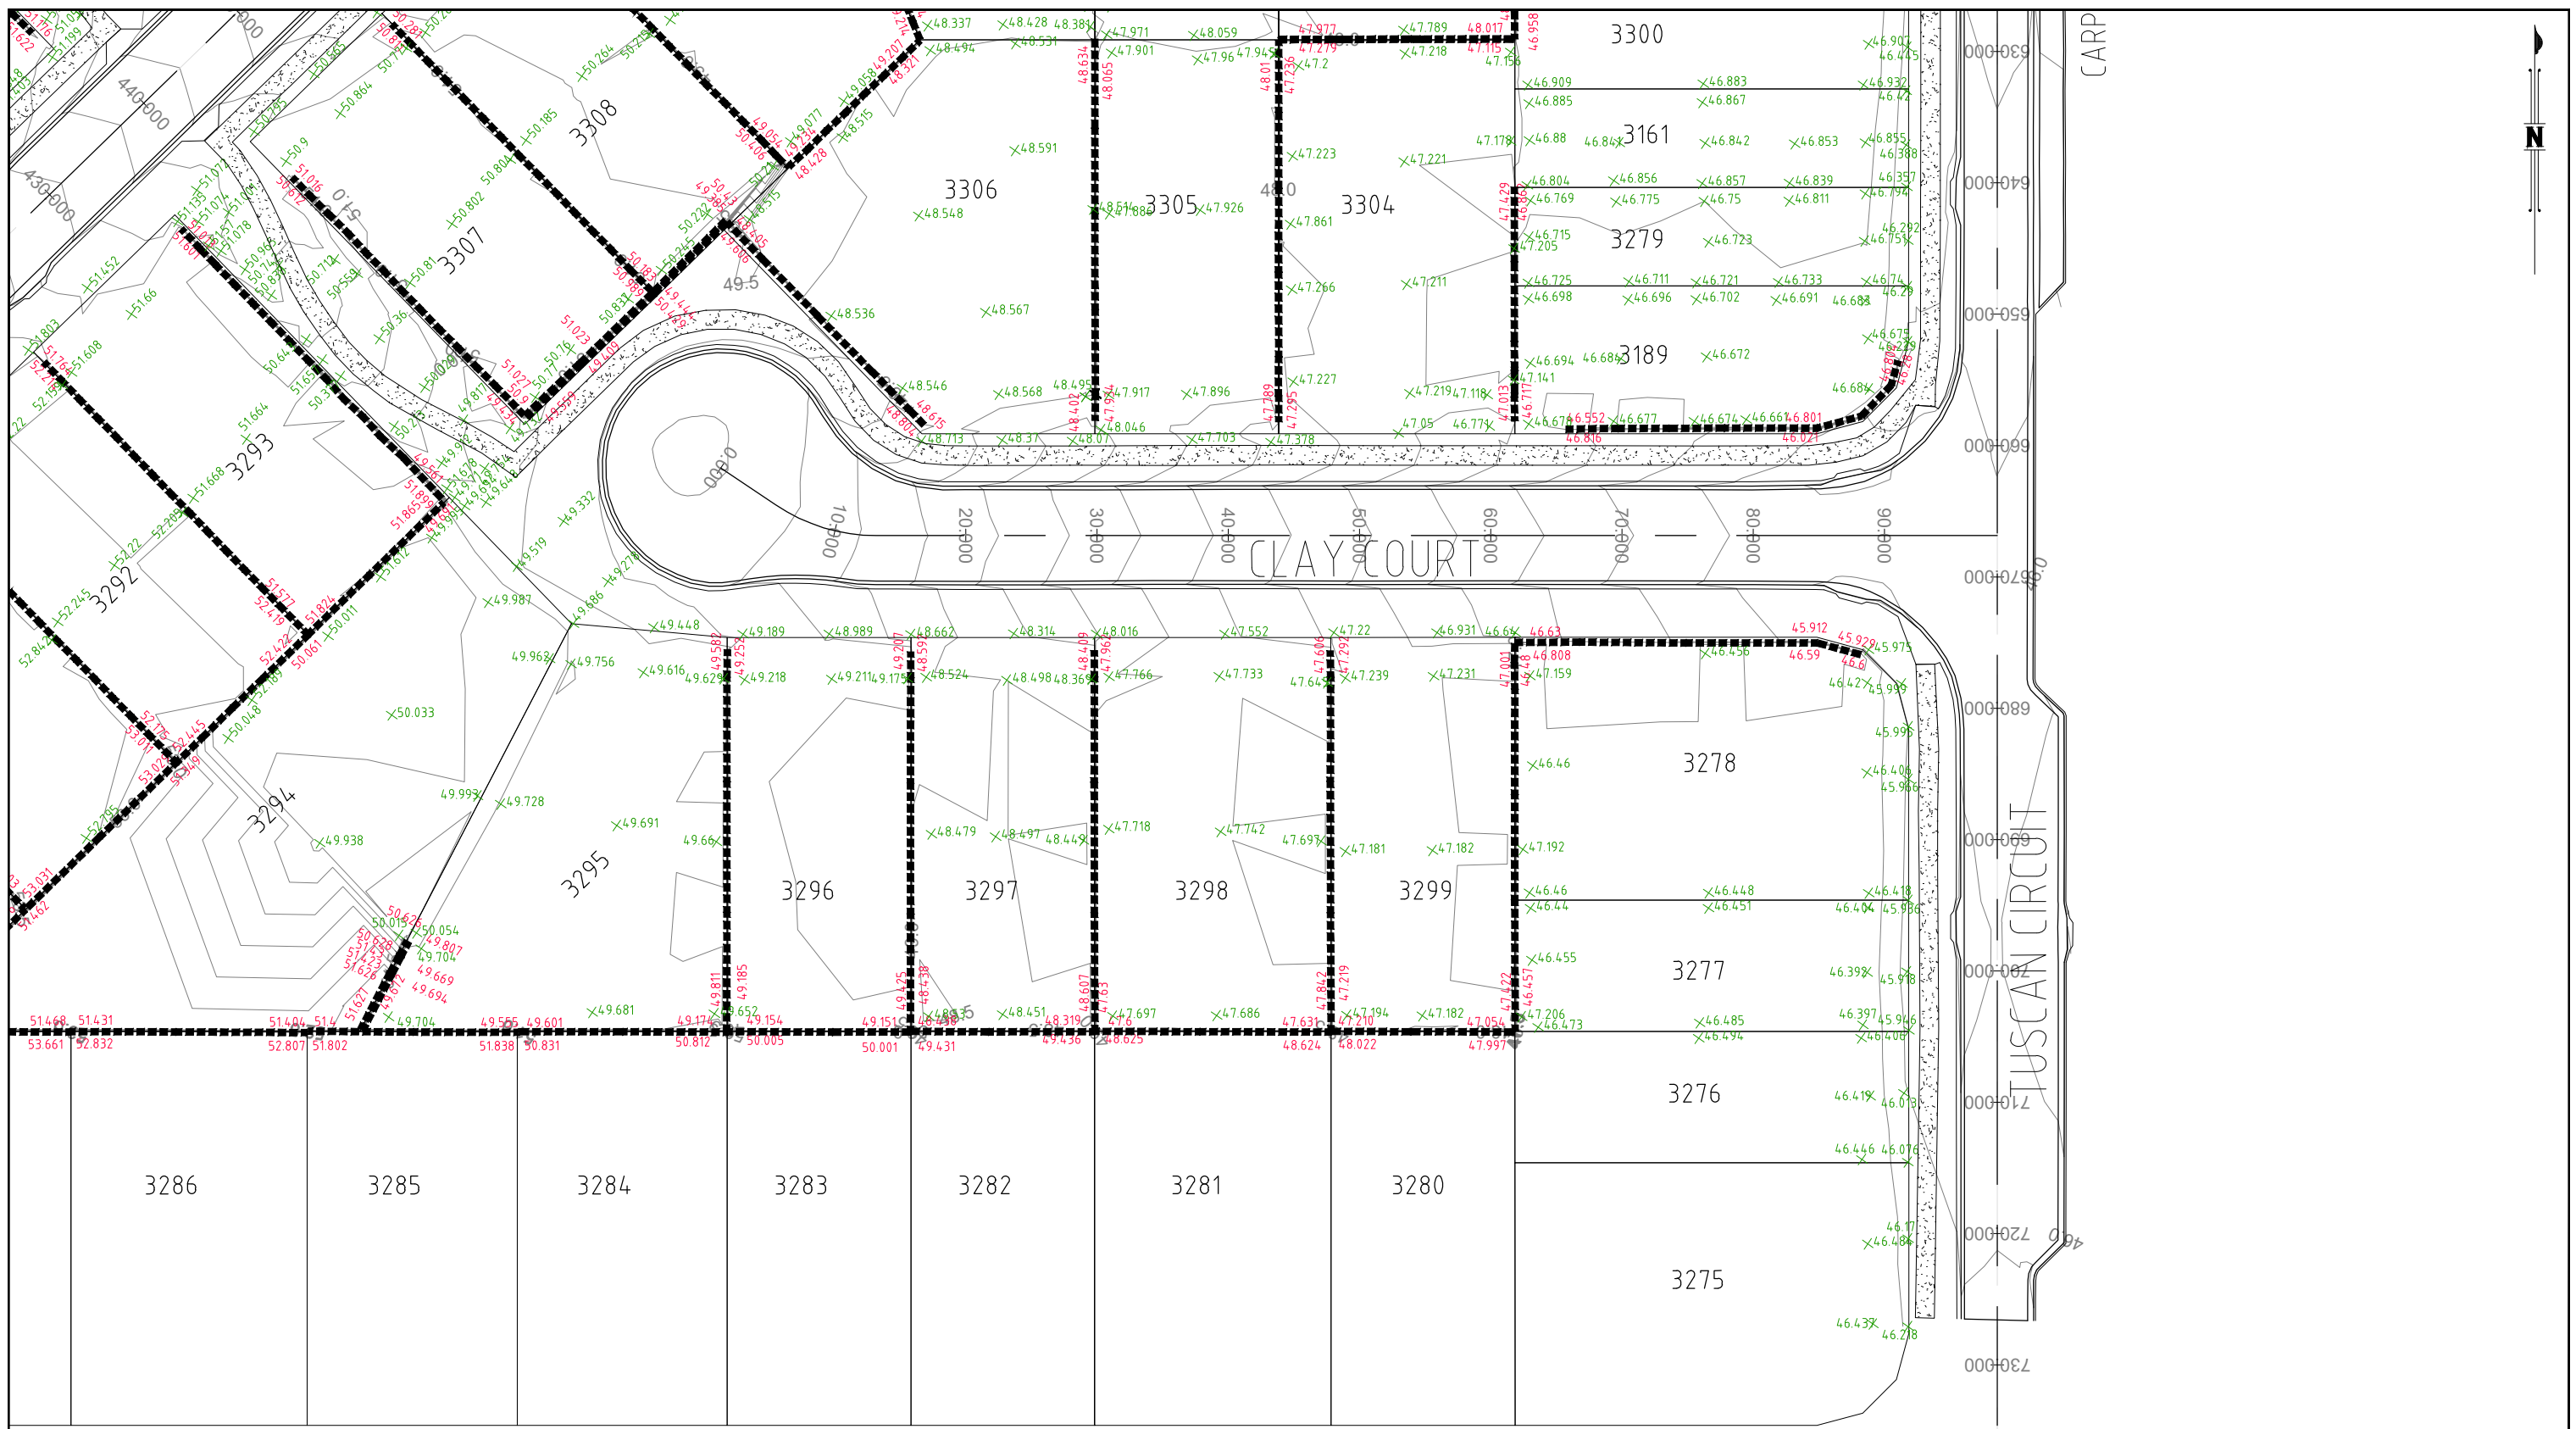

COORDINATE DATUM NOTE:

HORIZONTAL COORDINATES(E,N) SUPPLIED ARE MAPPING GRID OF AUSTRALIA(MGA), ZONE 56 BASED ON THE UNIVERSAL TRANSVERSE MERCATOR PROJECTION AND THE GEOCENTRIC DATUM OF AUSTRALIA 1994.

HORIZONTAL DATUM DERIVED FROM PSM 61308 E 498528.114 N 6931171.033.

LEVELS SUPPLIED ARE ON THE AUSTRALIAN HEIGHT DATUM(AHD) LEVEL DATUM DERIVED FROM PSM 61308 RLS4.660 (AHD)

PAVEMENT DESIGN

TUSCAN CIRCUIT
 AC(mm)- 35
 BASE(2.1)(mm) - 150
 SUBBASE(2.3)(mm) - 150

RETAINING WALLS
 ACoustic WALLS

SPOT HEIGHTS
 + 56.36
 WALL HEIGHTS
 55.524

CLAY COURT
 AC(mm)- 35
 BASE(2.1)(mm) - 150
 SUBBASE(2.3)(mm) - 150

ENGINEER'S CERTIFICATION

I, _____, hereby certify that:

- The information contained in this drawing / document is in compliance with approved drawings and design.
- This represents an accurate record of as-constructed works
- I accept responsibility for the information contained in this drawing / document.

RPEQ (signature) RPEQ No. _____ Date: _____

REGISTERED SURVEYING ASSOCIATE CERTIFICATION

I, Gordon Nicholson, hereby certify that the vertical and horizontal locations and dimensions shown on this plan are a true and correct record and were located by survey.

Registered Surveying Associate(Sig.) _____ Surveyor No. SA 3405 Date: 27/09/2023

| | | | | | | | |
|-----------|-------|------------|----------------|-----------|-------|---------|--------|
| A1 | INDEX | DATE | AS CONSTRUCTED | REVISIONS | DRAWN | CHECKED | PASSED |
| | A | 27/09/2023 | AS CONSTRUCTED | | RDE | DAM | CW |

| | | |
|----------|------|------------|
| DRAWN | RDE | 27/09/2023 |
| CHECKED | DAM | 27/09/2023 |
| PASSED | CW | 27/09/2023 |
| INITIALS | DATE | |



LOGAN CITY COUNCIL

MIRVAC MIR009-06
 AS CONSTRUCTED SURVEY - ROADS AND EARTHWORKS
 EVERLEIGH PRECINCT 9.6C
 GREENBANK QLD

| | |
|--------------------------------------|----------------|
| SHEET 4 OF 4 SHEETS | SCALE 1:250 A1 |
| REVISION DATE 27/09/2023 | REVISION A |
| DISCIPLINE CODE - | |
| DRAWING NO. ASC-RDS AND EWKS-04-9.6C | |