

**ENGINEER'S CERTIFICATION**

I, \_\_\_\_\_, hereby certify that:

- The information contained in this drawing / document is in compliance with approved drawings and design.
- The new water and sewerage works defined by this drawing have been designed and constructed in accordance with the SEQ Code.
- This represents an accurate record of as-constructed works.
- I accept responsibility for the information contained in this drawing / document.

\_\_\_\_\_  
RPEQ (signature) RPEQ No. \_\_\_\_\_ Date: \_\_\_\_\_

**AS CONSTRUCTED**

**REGISTERED SURVEYING ASSOCIATE CERTIFICATION**

I, Gordon Nicholson, hereby certify that the vertical and horizontal locations and dimensions shown on this plan are a true and correct record and were located by survey.

\_\_\_\_\_  
Registered Surveying Associate (sig.) Surveyor No. SA 3405 Date: 03/10/23



**COORDINATE DATUM NOTE:**  
 HORIZONTAL COORDINATES(E,N) SUPPLIED ARE MAPPING GRID OF AUSTRALIA(MGA), ZONE 56 BASED ON THE UNIVERSAL TRANSVERSE MERCATOR PROJECTION AND THE GEOCENTRIC DATUM OF AUSTRALIA 1994.  
 HORIZONTAL DATUM DERIVED FROM PSM 61308 E 4.98528.114 N 6931171.033.  
 LEVELS SUPPLIED ARE ON THE AUSTRALIAN HEIGHT DATUM(AHD)  
 LEVEL DATUM DERIVED FROM PSM 61308 RL54.660 (AHD)

<b>A1</b>																				
	INDEX	DATE	AS CONSTRUCTED	REVISIONS	DRAWN	CHECKED	DAM	LS	PASSED	INITIALS	DATE									

DRAWN	RDE	03/10/23
CHECKED	DAM	03/10/23
PASSED	LS	03/10/23





**LOGAN CITY COUNCIL**

MIRVAC MIR-0906  
 AS CONSTRUCTED SURVEY - STORMWATER  
 EVERLEIGH PRECINCT 9.6C  
 GREENBANK QLD

SHEET 1 OF 4 SHEETS	SCALE 1:500 A1
REVISION DATE 03/10/23	REVISION A
DISCIPLINE CODE -	
DRAWING NO. <b>ASC-STORM-01-9.6C</b>	

PM61308 RL  
 E: 498528.114  
 N: 6931171.033  
 RL: 54.660m

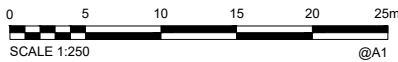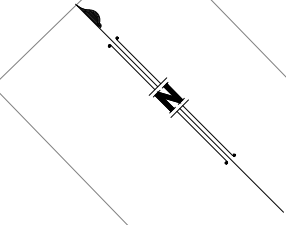


**AS CONSTRUCTED**

**ENGINEER'S CERTIFICATION**  
 I, \_\_\_\_\_, hereby certify that:  
 1. The information contained in this drawing / document is in compliance with approved drawings and design.  
 2. The new water and sewerage works defined by this drawing have been designed and constructed in accordance with the SEQ Code.  
 3. This represents an accurate record of as-constructed works.  
 4. I accept responsibility for the information contained in this drawing / document.  
 RPEQ (signature) RPEQ No. \_\_\_\_\_ Date: \_\_\_\_\_

**REGISTERED SURVEYING ASSOCIATE CERTIFICATION**  
 I, Gordon Nicholson, hereby certify that the vertical and horizontal locations and dimensions shown on this plan are a true and correct record and were located by survey.  
 \_\_\_\_\_  
 Registered Surveying Associate(sig.) Surveyor No. SA 3405 Date: 03/10/23

**COORDINATE DATUM NOTE:**  
 HORIZONTAL COORDINATES(E,N) SUPPLIED ARE MAPPING GRID OF AUSTRALIA(MGA), ZONE 56 BASED ON THE UNIVERSAL TRANSVERSE MERCATOR PROJECTION AND THE GEOCENTRIC DATUM OF AUSTRALIA 1994.  
 HORIZONTAL DATUM DERIVED FROM PSM 61308 E 498528.114 N 6931171.033.  
 LEVELS SUPPLIED ARE ON THE AUSTRALIAN HEIGHT DATUM(AHD)  
 LEVEL DATUM DERIVED FROM PSM 61308 RL54.660 (AHD)

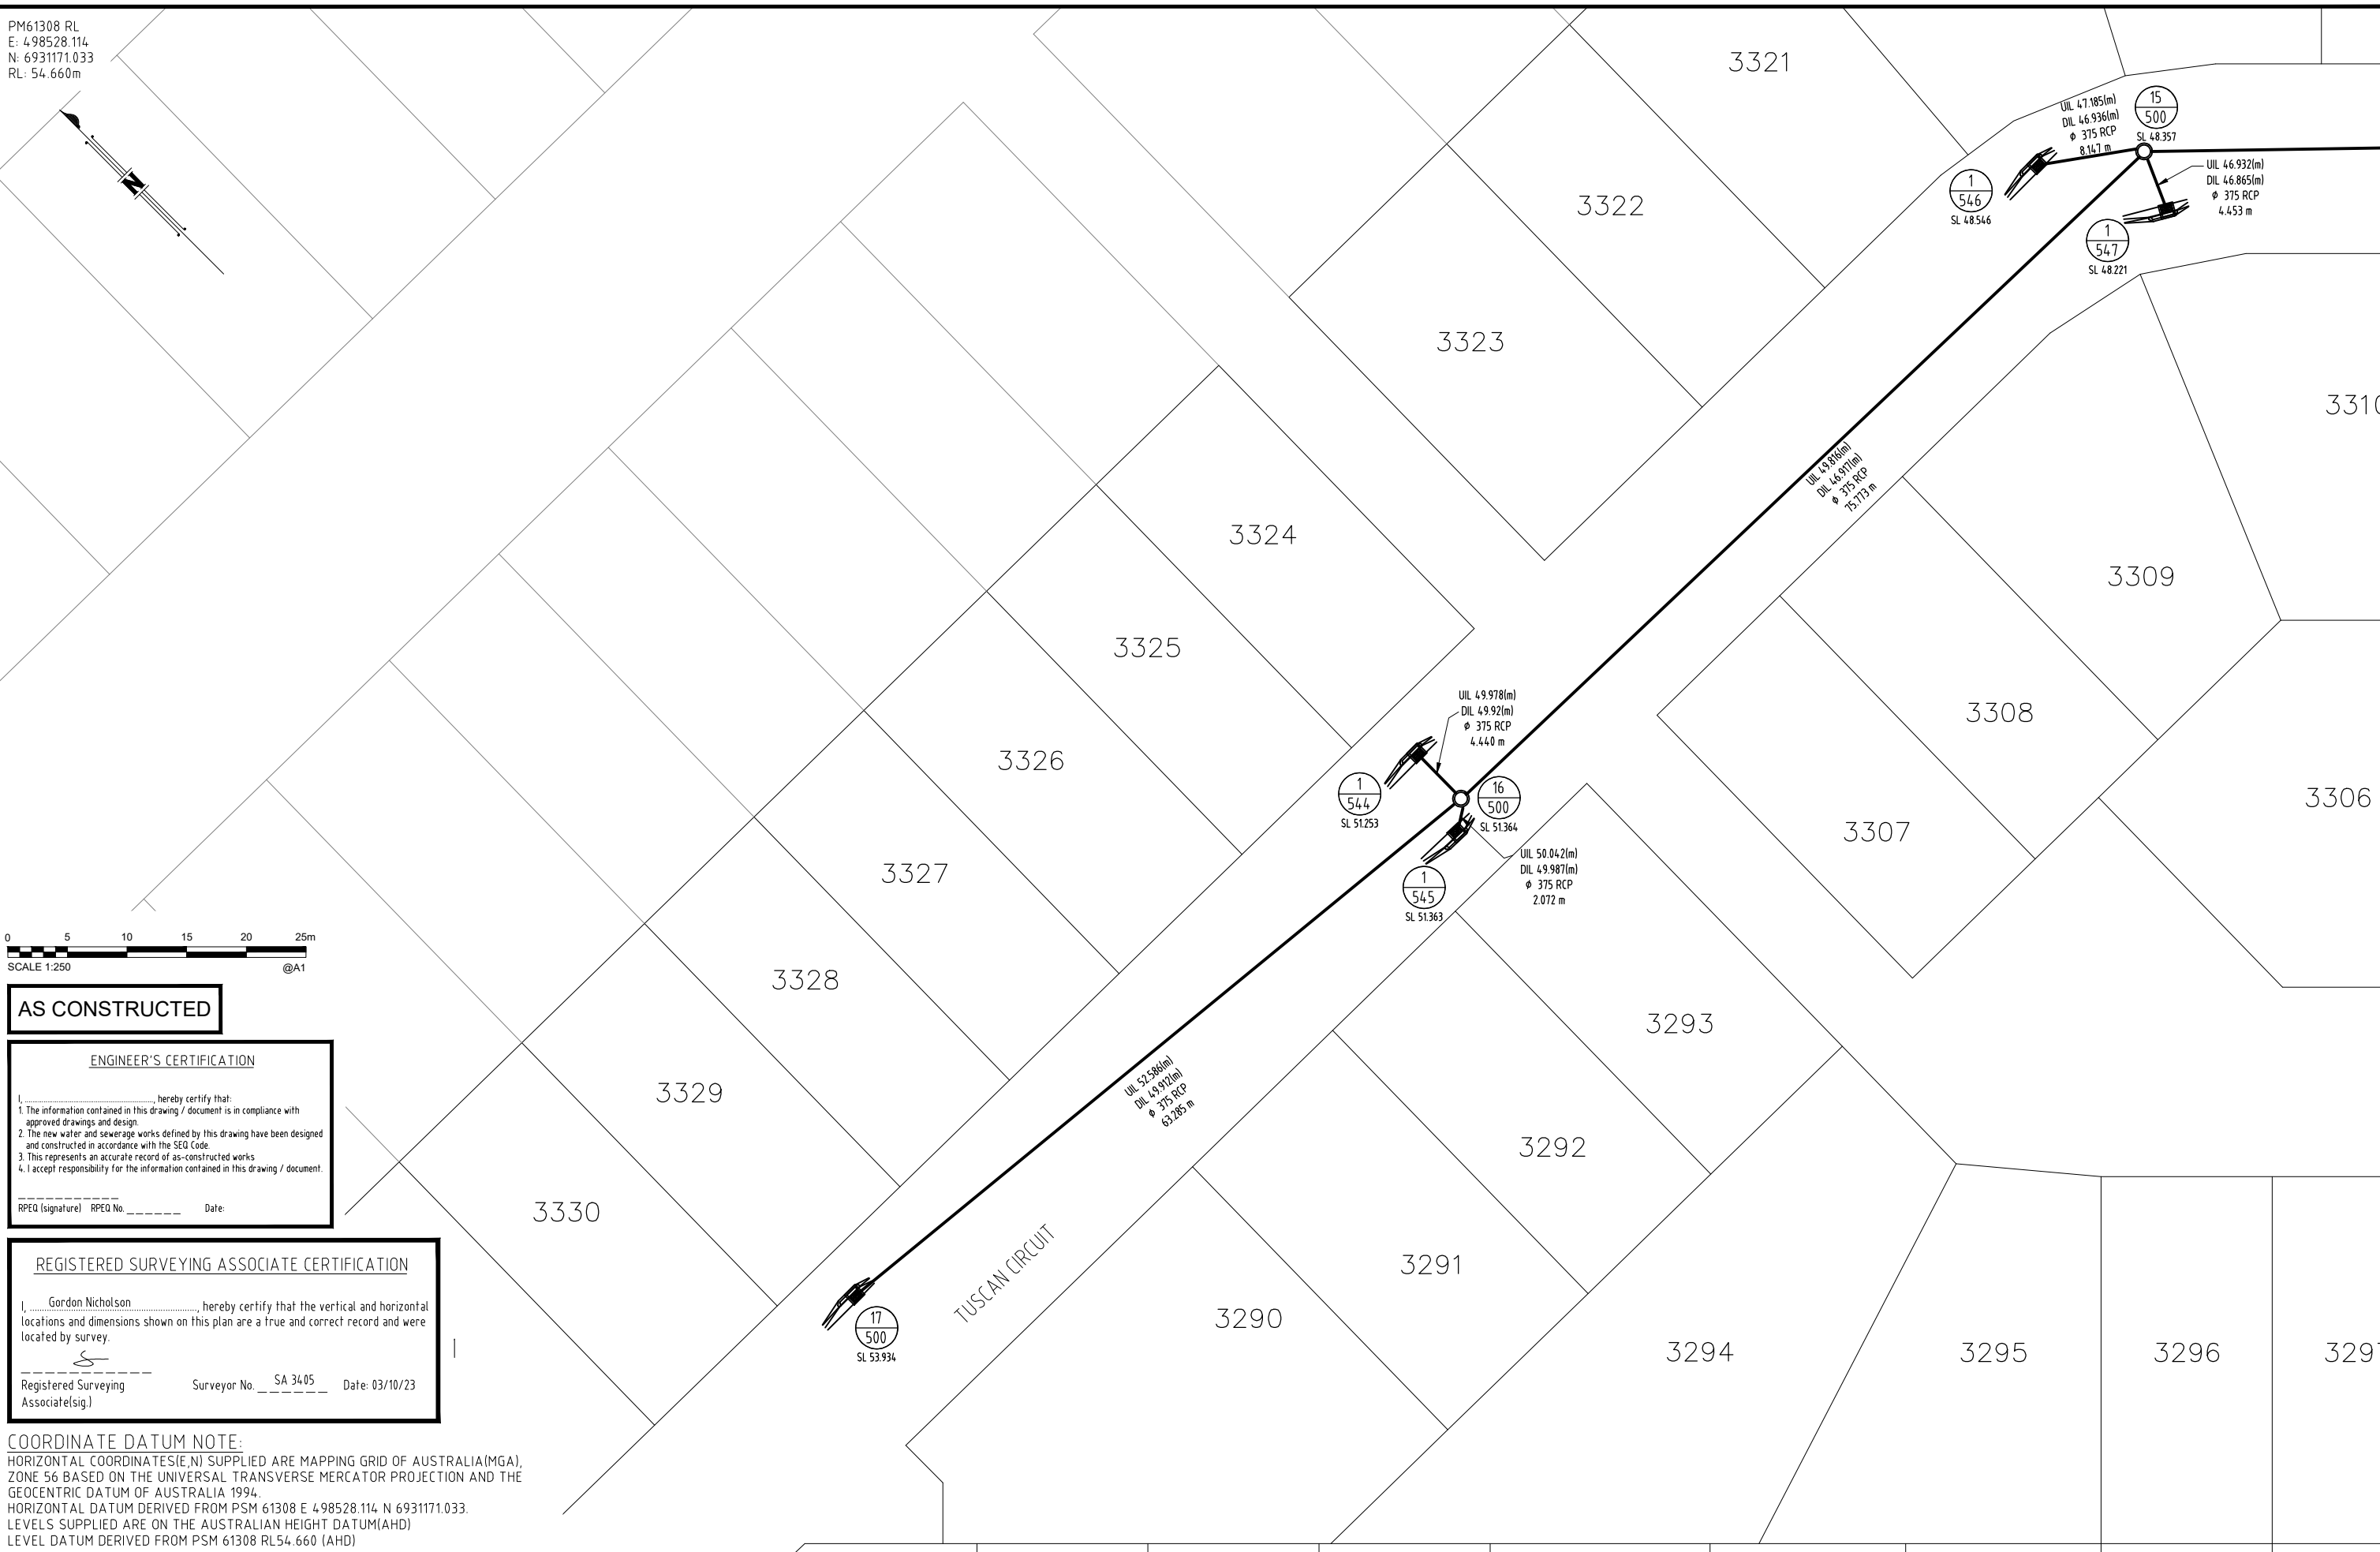

<b>A1</b>	INDEX	DATE	REVISIONS	DRAWN	CHECKED	PASSED
	A	03/10/23	AS CONSTRUCTED	RDE	DAM	LS




DRAWN	RDE	03/10/23
CHECKED	DAM	03/10/23
PASSED	LS	03/10/23
INITIALS	DATE	



**LOGAN CITY COUNCIL**  
 MIRVAC MIR-0906  
 AS CONSTRUCTED SURVEY - STORMWATER  
 EVERLEIGH PRECINCT 9.6C  
 GREENBANK QLD

SHEET 2 OF 4	SHEETS	SCALE 1:250 A1
REVISION DATE	03/10/23	REVISION A
DISCIPLINE CODE	-	
DRAWING NO.	<b>ASC-STORM-02-9.6C</b>	

PM61308 RL  
 E: 498528.114  
 N: 6931171.033  
 RL: 54.660m

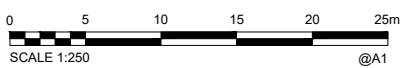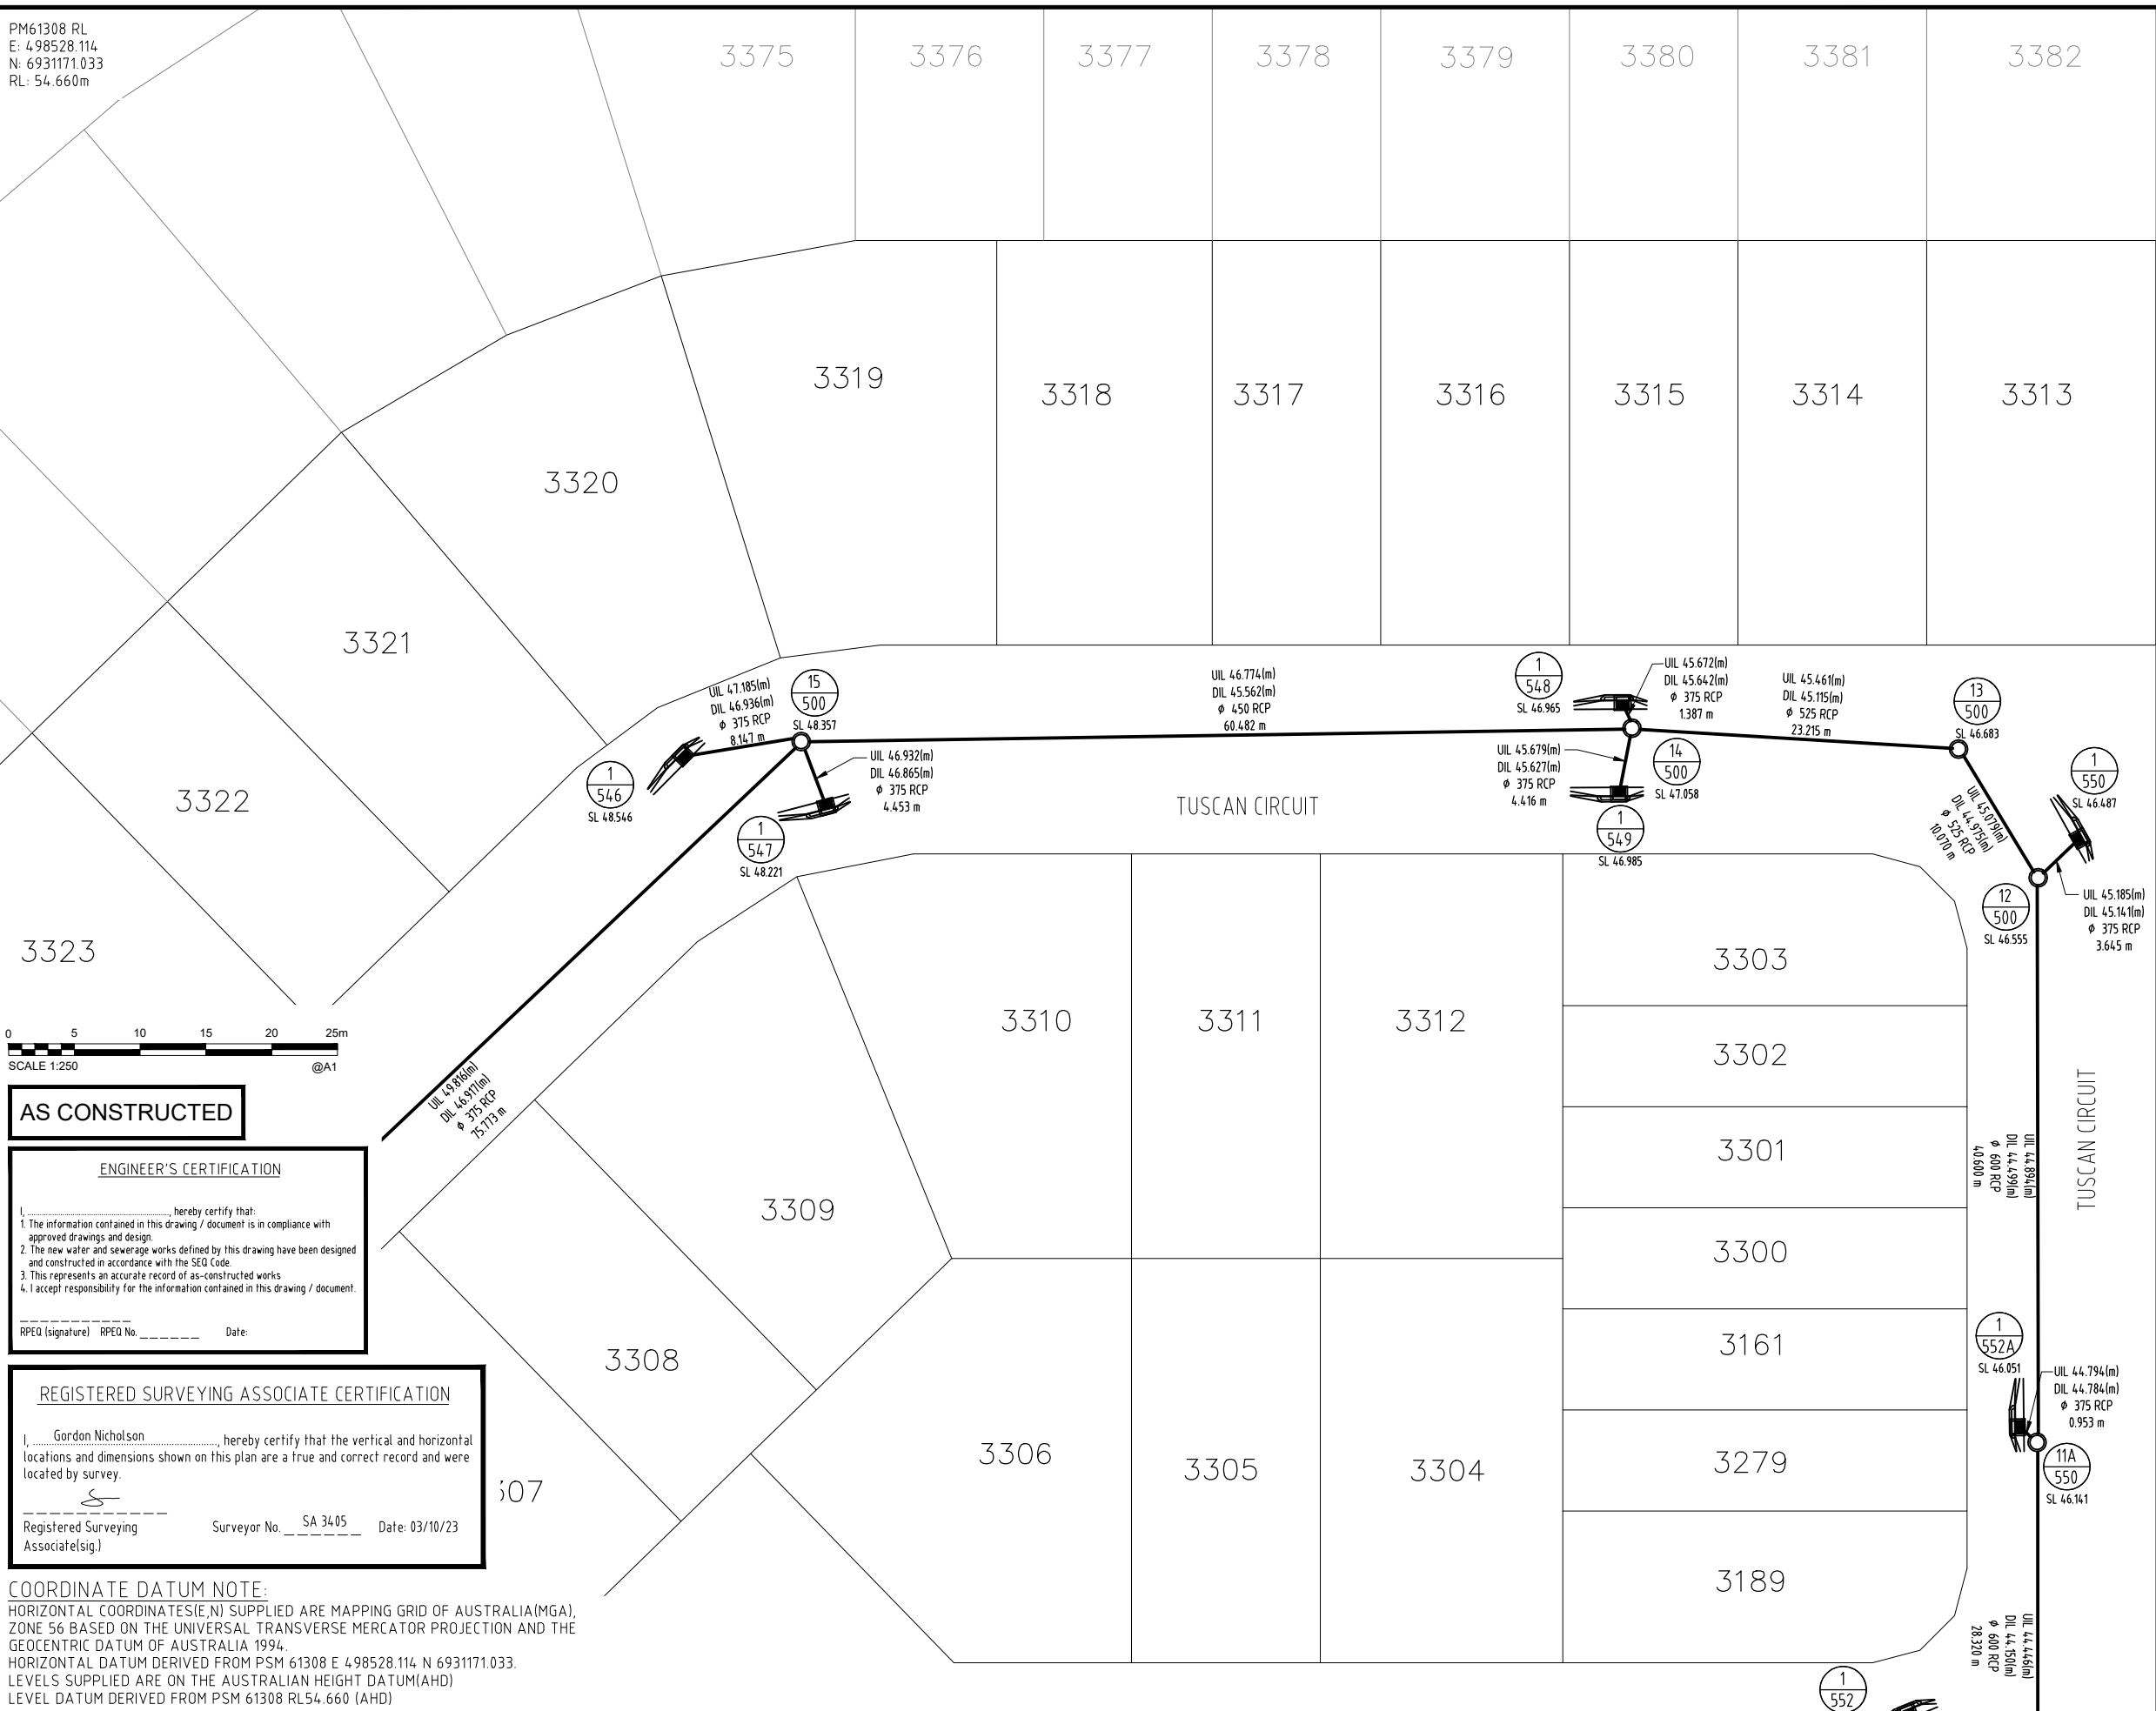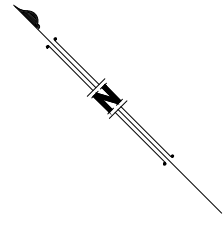

**AS CONSTRUCTED**

**ENGINEER'S CERTIFICATION**  
 I, \_\_\_\_\_, hereby certify that:  
 1. The information contained in this drawing / document is in compliance with approved drawings and design.  
 2. The new water and sewerage works defined by this drawing have been designed and constructed in accordance with the SEQ Code.  
 3. This represents an accurate record of as-constructed works.  
 4. I accept responsibility for the information contained in this drawing / document.  
 RPEQ (signature) RPEQ No. \_\_\_\_\_ Date: \_\_\_\_\_

**REGISTERED SURVEYING ASSOCIATE CERTIFICATION**  
 I, Gordon Nicholson, hereby certify that the vertical and horizontal locations and dimensions shown on this plan are a true and correct record and were located by survey.  
 Registered Surveying Associate (sig.) Surveyor No. SA 3405 Date: 03/10/23

**COORDINATE DATUM NOTE:**  
 HORIZONTAL COORDINATES(E,N) SUPPLIED ARE MAPPING GRID OF AUSTRALIA(MGA), ZONE 56 BASED ON THE UNIVERSAL TRANSVERSE MERCATOR PROJECTION AND THE GEOCENTRIC DATUM OF AUSTRALIA 1994.  
 HORIZONTAL DATUM DERIVED FROM PSM 61308 E 498528.114 N 6931171.033.  
 LEVELS SUPPLIED ARE ON THE AUSTRALIAN HEIGHT DATUM(AHD)  
 LEVEL DATUM DERIVED FROM PSM 61308 RL54.660 (AHD)

<b>A1</b>	INDEX	DATE	AS CONSTRUCTED	REVISIONS	DRAWN	CHECKED	PASSED
	A	03/10/23	AS CONSTRUCTED		RDE	DAM	LS




DRAWN	RDE	03/10/23
CHECKED	DAM	03/10/23
PASSED	LS	03/10/23
INITIALS	DATE	



**LOGAN CITY COUNCIL**  
 MIRVAC MIR-0906  
 AS CONSTRUCTED SURVEY - STORMWATER  
 EVERLEIGH PRECINCT 9.6C  
 GREENBANK QLD

SHEET 3 OF 4 SHEETS	SCALE 1:250 A1
REVISION DATE 03/10/23	REVISION A
DISCIPLINE CODE -	
DRAWING NO. <b>ASC-STORM-03-9.6C</b>	

PM61308 RL  
E: 4.98528.114  
N: 6931171.033  
RL: 54.660m

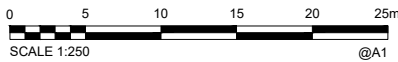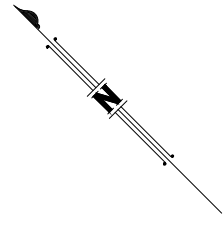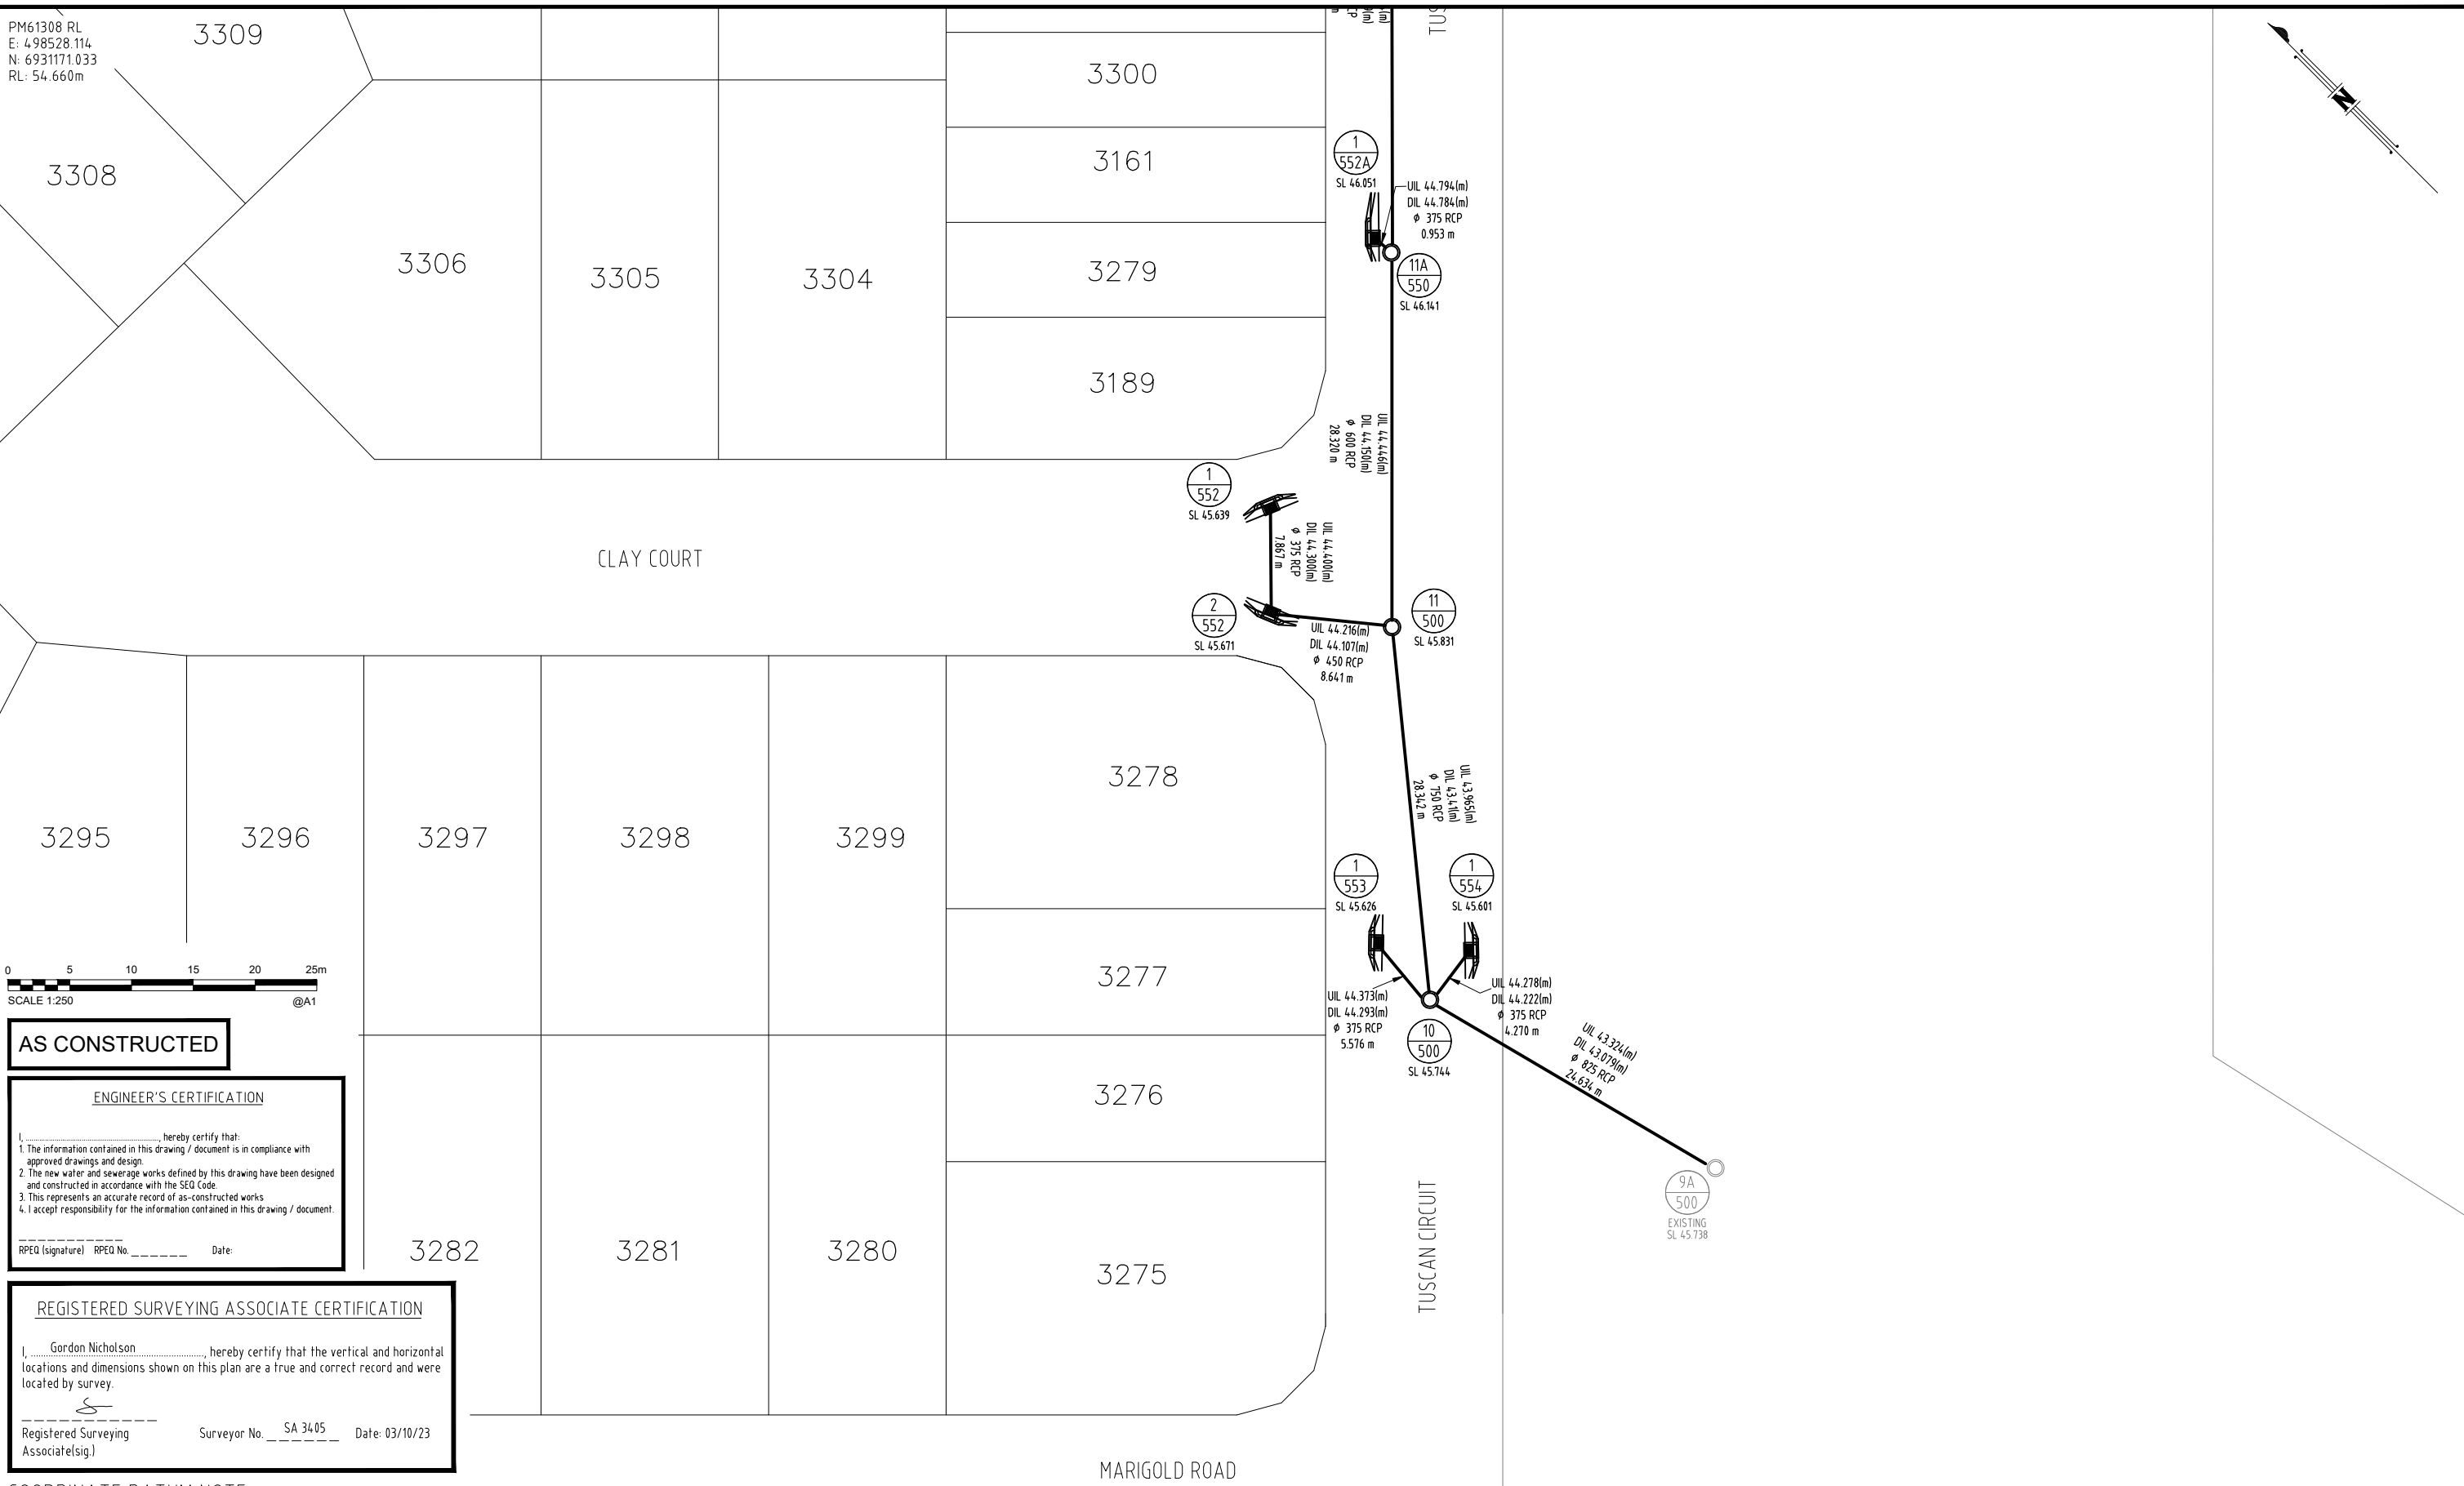

**AS CONSTRUCTED**

**ENGINEER'S CERTIFICATION**  
I, \_\_\_\_\_, hereby certify that:  
1. The information contained in this drawing / document is in compliance with approved drawings and design.  
2. The new water and sewerage works defined by this drawing have been designed and constructed in accordance with the SEQ Code.  
3. This represents an accurate record of as-constructed works.  
4. I accept responsibility for the information contained in this drawing / document.  
RPEQ (signature) RPEQ No. \_\_\_\_\_ Date: \_\_\_\_\_

**REGISTERED SURVEYING ASSOCIATE CERTIFICATION**  
I, Gordon Nicholson, hereby certify that the vertical and horizontal locations and dimensions shown on this plan are a true and correct record and were located by survey.  
Registered Surveying Associate (sig.) Surveyor No. SA 3405 Date: 03/10/23

**COORDINATE DATUM NOTE:**  
HORIZONTAL COORDINATES(E,N) SUPPLIED ARE MAPPING GRID OF AUSTRALIA(MGA), ZONE 56 BASED ON THE UNIVERSAL TRANSVERSE MERCATOR PROJECTION AND THE GEOCENTRIC DATUM OF AUSTRALIA 1994.  
HORIZONTAL DATUM DERIVED FROM PSM 61308 E 4.98528.114 N 6931171.033.  
LEVELS SUPPLIED ARE ON THE AUSTRALIAN HEIGHT DATUM(AHD)  
LEVEL DATUM DERIVED FROM PSM 61308 RL54.660 (AHD)

A1	INDEX	DATE	REVISIONS	DRAWN	CHECKED	PASSED
	A	03/10/23	AS CONSTRUCTED	RDE	DAM	LS

DRAWN	RDE	03/10/23
CHECKED	DAM	03/10/23
PASSED	LS	03/10/23
INITIALS	DATE	



**LOGAN CITY COUNCIL**  
MIRVAC MIR-0906  
AS CONSTRUCTED SURVEY - STORMWATER  
EVERLEIGH PRECINCT 9.6C  
GREENBANK QLD

SHEET 4 OF 4 SHEETS	SCALE 1:250 A1
REVISION DATE 03/10/23	REVISION A
DISCIPLINE CODE -	
DRAWING NO. <b>ASC-STORM-04-9.6C</b>	