


AS CONSTRUCTED

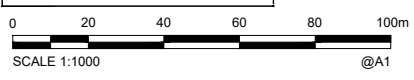

**COORDINATE DATUM NOTE:**  
 HORIZONTAL COORDINATES (E, N) SUPPLIED ARE MAPPING GRID OF AUSTRALIA (MGA), ZONE 56 BASED ON THE UNIVERSAL TRANSVERSE MERCATOR PROJECTION AND THE GEOCENTRIC DATUM OF AUSTRALIA 1994.  
 HORIZONTAL DATUM DERIVED FROM PSM 61308 E 4 985 28 114 N 6931171.033.  
 LEVELS SUPPLIED ARE ON THE AUSTRALIAN HEIGHT DATUM (AHD) LEVEL DATUM DERIVED FROM PSM 61308 RL54.660 (AHD)

PAVEMENT DESIGN		RETAINING WALLS		SPOT HEIGHTS	
ANDERSON DRIVE				+	56.36
AC(mm) - 50					
BASE(2.1)(mm) - 300					
SUBBASE(2.3)(mm) - 100					56.600
					55.524

**ENGINEER'S CERTIFICATION**  
 Patrick Brady, hereby certify that:  
 1. The information contained in this drawing / document is in compliance with approved drawings and design.  
 2. This represents an accurate record of as-constructed works.  
 3. I accept responsibility for the information contained in this drawing / document.  
 RPEQ (signature) RPEQ No. 7112 Date: \_\_\_\_\_

**REGISTERED SURVEYING ASSOCIATE CERTIFICATION**  
 Gordon Nicholson, hereby certify that the vertical and horizontal locations and dimensions shown on this plan are a true and correct record and were located by survey.  
 Registered Surveying Associate (sig.) Surveyor No. SA 3405 Date: 29/01/2024

A1	INDEX	DATE	AS CONSTRUCTED	REVISIONS	DRAWN	CHECKED	PASSED
	A	29/01/2024	AS CONSTRUCTED		RDE	DAM	CW

DRAWN	RDE	29/01/2024
CHECKED	DAM	29/01/2024
PASSED	CW	29/01/2024
INITIALS	DATE	




**LOGAN CITY COUNCIL**  
 MIRVAC MIR-0907  
 AS CONSTRUCTED SURVEY - ROADS AND EARTHWORKS  
 EVERLEIGH PRECINCT 9.7C  
 GREENBANK QLD

SHEET 1 OF 6 SHEETS	SCALE 1:500 A1
REVISION DATE 29/01/2024	REVISION A
DISCIPLINE CODE -	
DRAWING NO. ASC-RDS AND EWKS-01-9.7C	



AS CONSTRUCTED

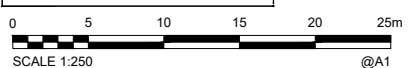

**COORDINATE DATUM NOTE:**  
 HORIZONTAL COORDINATES (E,N) SUPPLIED ARE MAPPING GRID OF AUSTRALIA (MGA), ZONE 56 BASED ON THE UNIVERSAL TRANSVERSE MERCATOR PROJECTION AND THE GEOCENTRIC DATUM OF AUSTRALIA 1994.  
 HORIZONTAL DATUM DERIVED FROM PSM 61308 E 498528.114 N 6931171.033.  
 LEVELS SUPPLIED ARE ON THE AUSTRALIAN HEIGHT DATUM (AHD) LEVEL DATUM DERIVED FROM PSM 61308 RLS4.660 (AHD)

**PAVEMENT DESIGN**  
 ANDERSON DRIVE  
 AC(mm) - 50  
 BASE(2.1)(mm) - 300  
 SUBBASE(2.3)(mm) - 100

**RETAINING WALLS**

**SPOT HEIGHTS**  
 + 56.36  
**WALL HEIGHTS**  
 56.600  
 55.524

**ENGINEER'S CERTIFICATION**  
 Patrick Brady, hereby certify that:  
 1. The information contained in this drawing / document is in compliance with approved drawings and design.  
 2. This represents an accurate record of as-constructed works.  
 3. I accept responsibility for the information contained in this drawing / document.  
 RPEQ (signature) RPEQ No. 7112 Date: \_\_\_\_\_

**REGISTERED SURVEYING ASSOCIATE CERTIFICATION**  
 Gordon Nicholson, hereby certify that the vertical and horizontal locations and dimensions shown on this plan are a true and correct record and were located by survey.  
 Registered Surveying Surveyor No. SA 3405 Date: 29/01/2024  
 Associate(s)ig)


A1	INDEX	DATE	AS CONSTRUCTED	REVISIONS	DRAWN	CHECKED	PASSED
	A	29/01/2024	AS CONSTRUCTED		RDE	DAM	CW

DRAWN	RDE	29/01/2024
CHECKED	DAM	29/01/2024
PASSED	CW	29/01/2024
INITIALS	DATE	




**LOGAN CITY COUNCIL**  
 MIRVAC MIR-007  
 AS CONSTRUCTED SURVEY - ROADS AND EARTHWORKS  
 EVERLEIGH PRECINCT 9.7C  
 GREENBANK QLD

SHEET 2 OF 6 SHEETS	SCALE 1:250 A1
REVISION DATE 29/01/2024	REVISION A
DISCIPLINE CODE -	
DRAWING NO. ASC-RDS AND EWKS-02-9.7C	

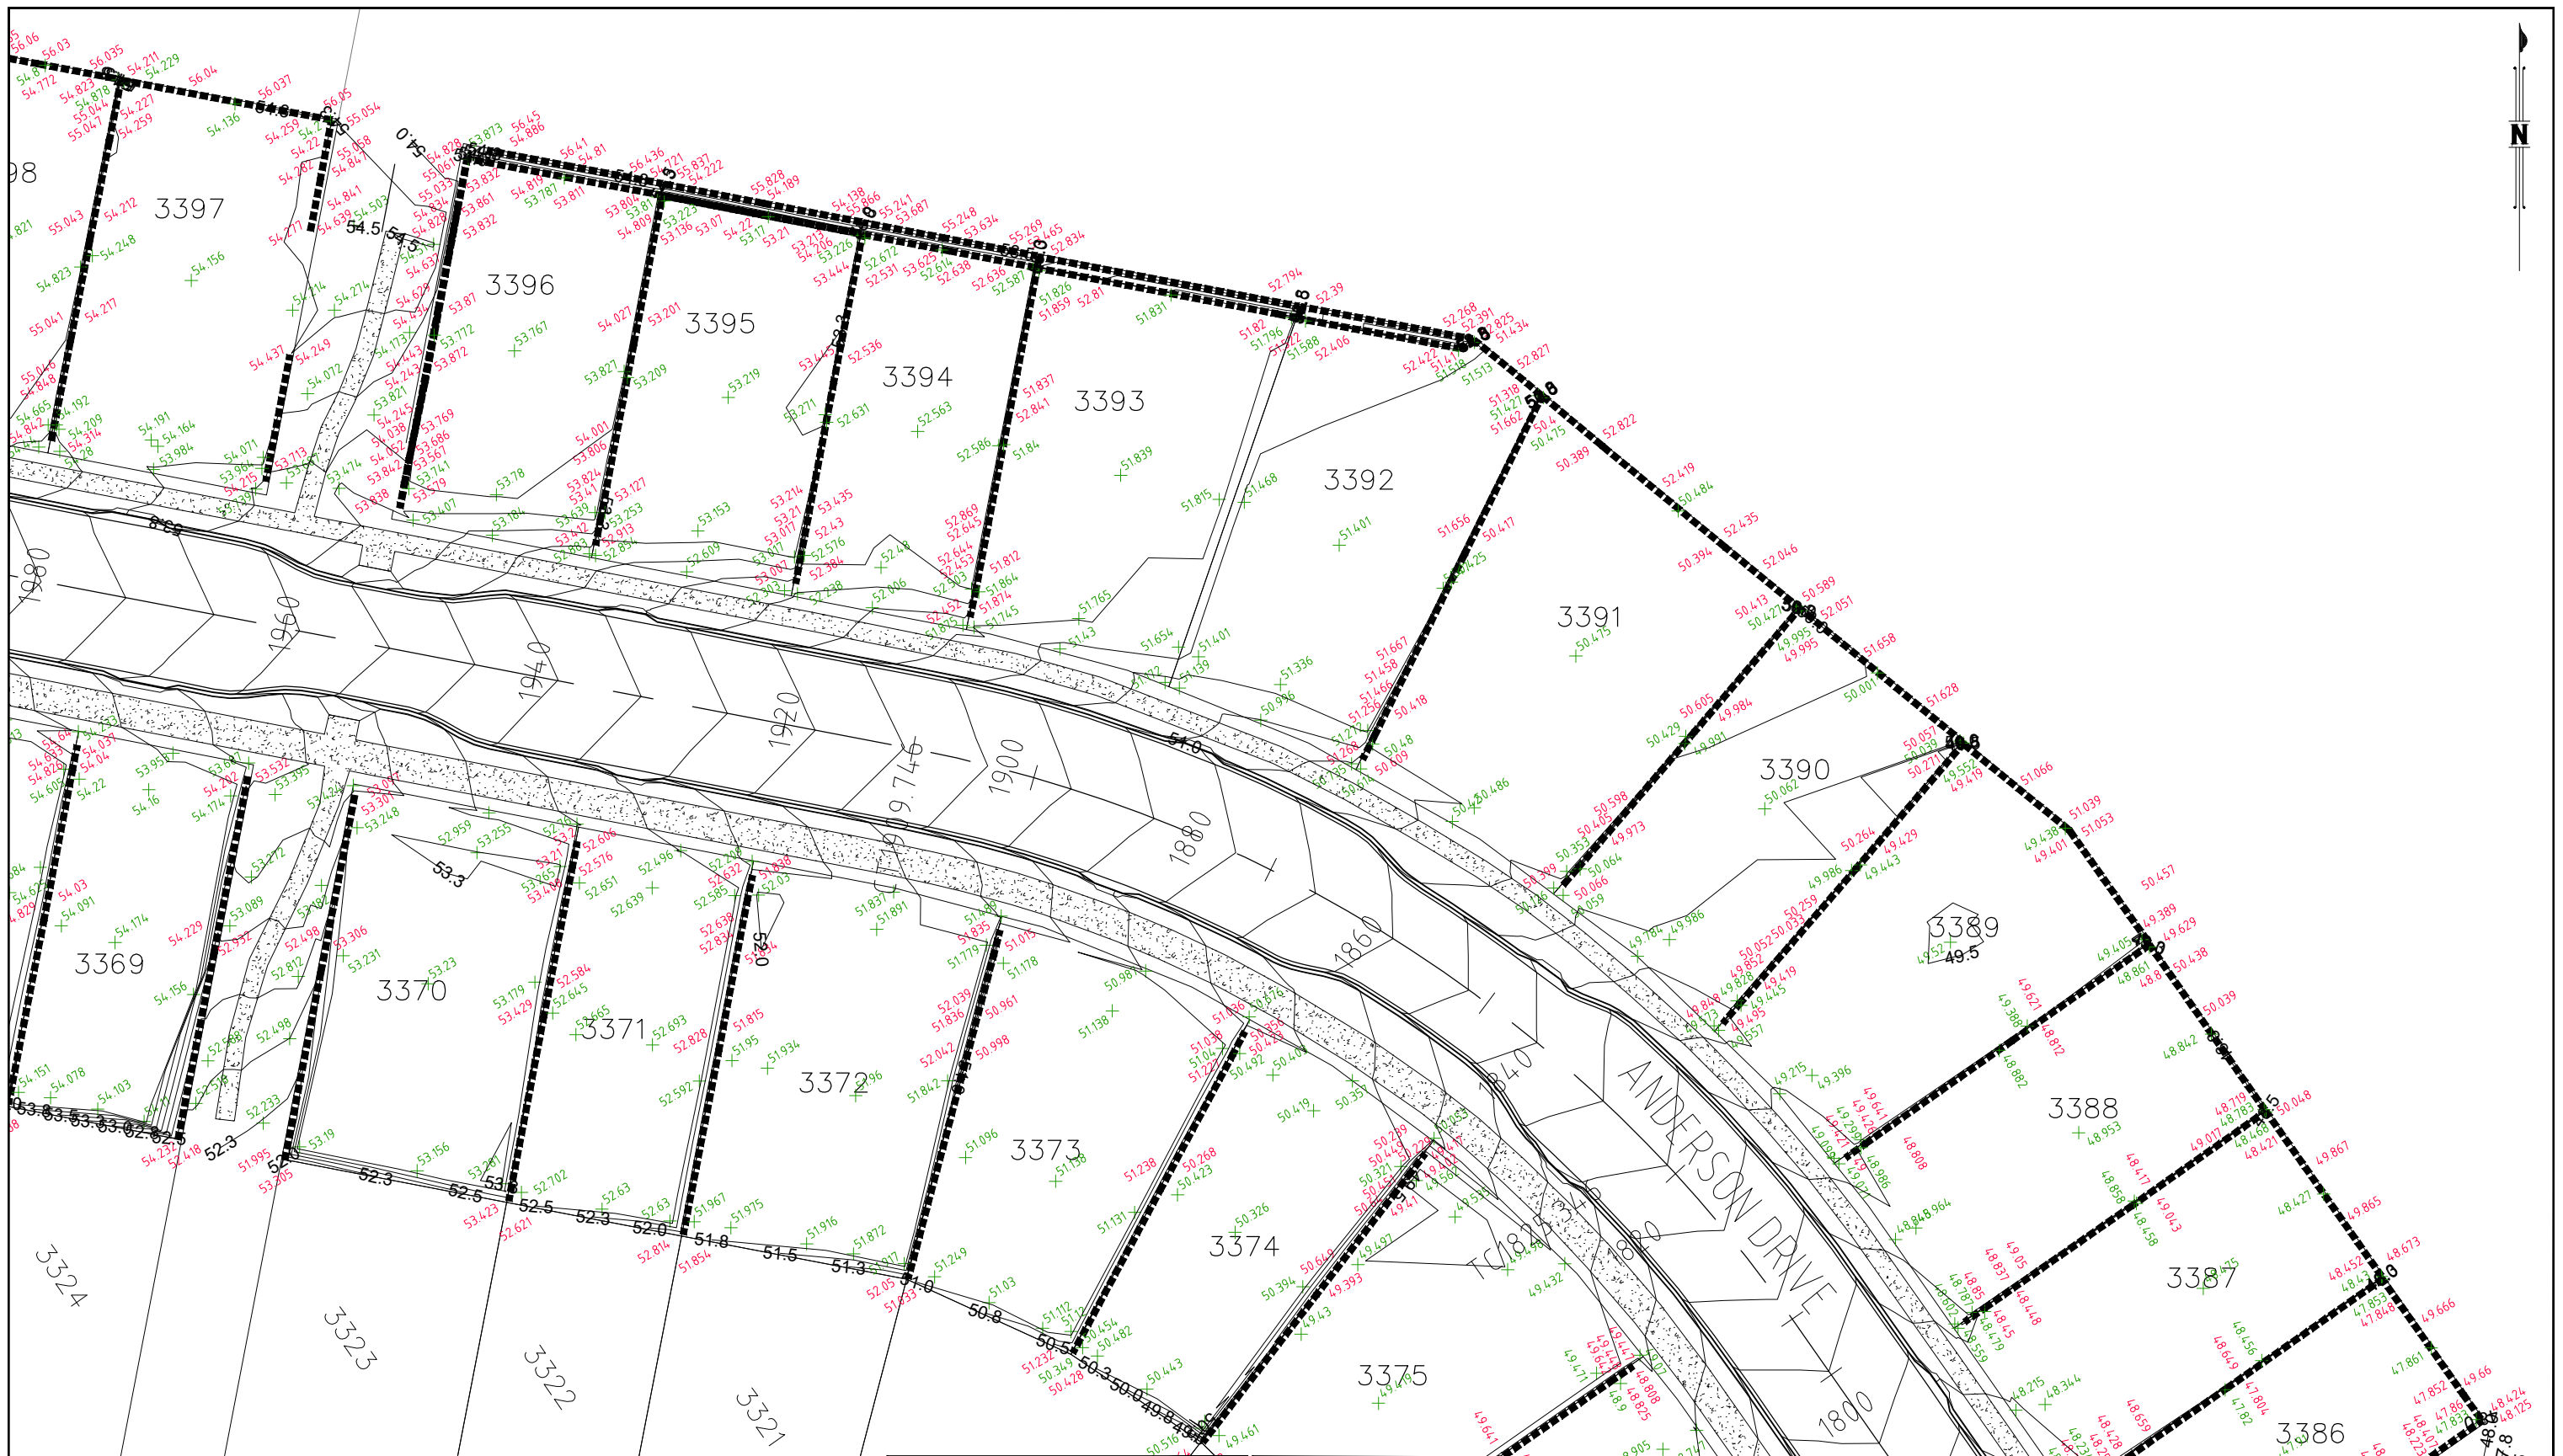

AS CONSTRUCTED

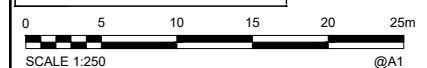

**COORDINATE DATUM NOTE:**  
 HORIZONTAL COORDINATES (E, N) SUPPLIED ARE MAPPING GRID OF AUSTRALIA (MGA), ZONE 56 BASED ON THE UNIVERSAL TRANSVERSE MERCATOR PROJECTION AND THE GEOCENTRIC DATUM OF AUSTRALIA 1994.  
 HORIZONTAL DATUM DERIVED FROM PSM 61308 E 498528.114 N 6931171.033  
 LEVELS SUPPLIED ARE ON THE AUSTRALIAN HEIGHT DATUM (AHD) LEVEL DATUM DERIVED FROM PSM 61308 RLS 4.660 (AHD)

**PAVEMENT DESIGN**

ANDERSON DRIVE	RETAINING WALLS	SPOT HEIGHTS
AC(mm) - 50	+	56.36
BASE(2.1)(mm) - 300		WALL HEIGHTS
SUBBASE(2.3)(mm) - 100		56.600
		55.524

**ENGINEER'S CERTIFICATION**

Patrick Brady, hereby certify that:  
 1. The information contained in this drawing / document is in compliance with approved drawings and design.  
 2. This represents an accurate record of as-constructed works.  
 3. I accept responsibility for the information contained in this drawing / document.

RPEQ (signature) RPEQ No. 7112 Date

**REGISTERED SURVEYING ASSOCIATE CERTIFICATION**

Gordon Nicholson, hereby certify that the vertical and horizontal locations and dimensions shown on this plan are a true and correct record and were located by survey.

Registered Surveying Surveyor No. SA 3405 Date: 29/01/2024  
 Associate(s)g

A1	INDEX	DATE	AS CONSTRUCTED	REVISIONS	DRAWN	CHECKED	PASSED
	A	29/01/2024	AS CONSTRUCTED		RDE	DAM	CW


DRAWN	RDE	29/01/2024
CHECKED	DAM	29/01/2024
PASSED	CW	29/01/2024
INITIALS	DATE	




**LOGAN CITY COUNCIL**

MIRVAC MIR-007  
 AS CONSTRUCTED SURVEY - ROADS AND EARTHWORKS  
 EVERLEIGH PRECINCT 9.7C  
 GREENBANK QLD

SHEET 3 OF 6 SHEETS	SCALE 1:250 A1
REVISION DATE 29/01/2024	REVISION A
DISCIPLINE CODE -	
DRAWING NO. ASC-RDS AND EWKS-03-9.7C	

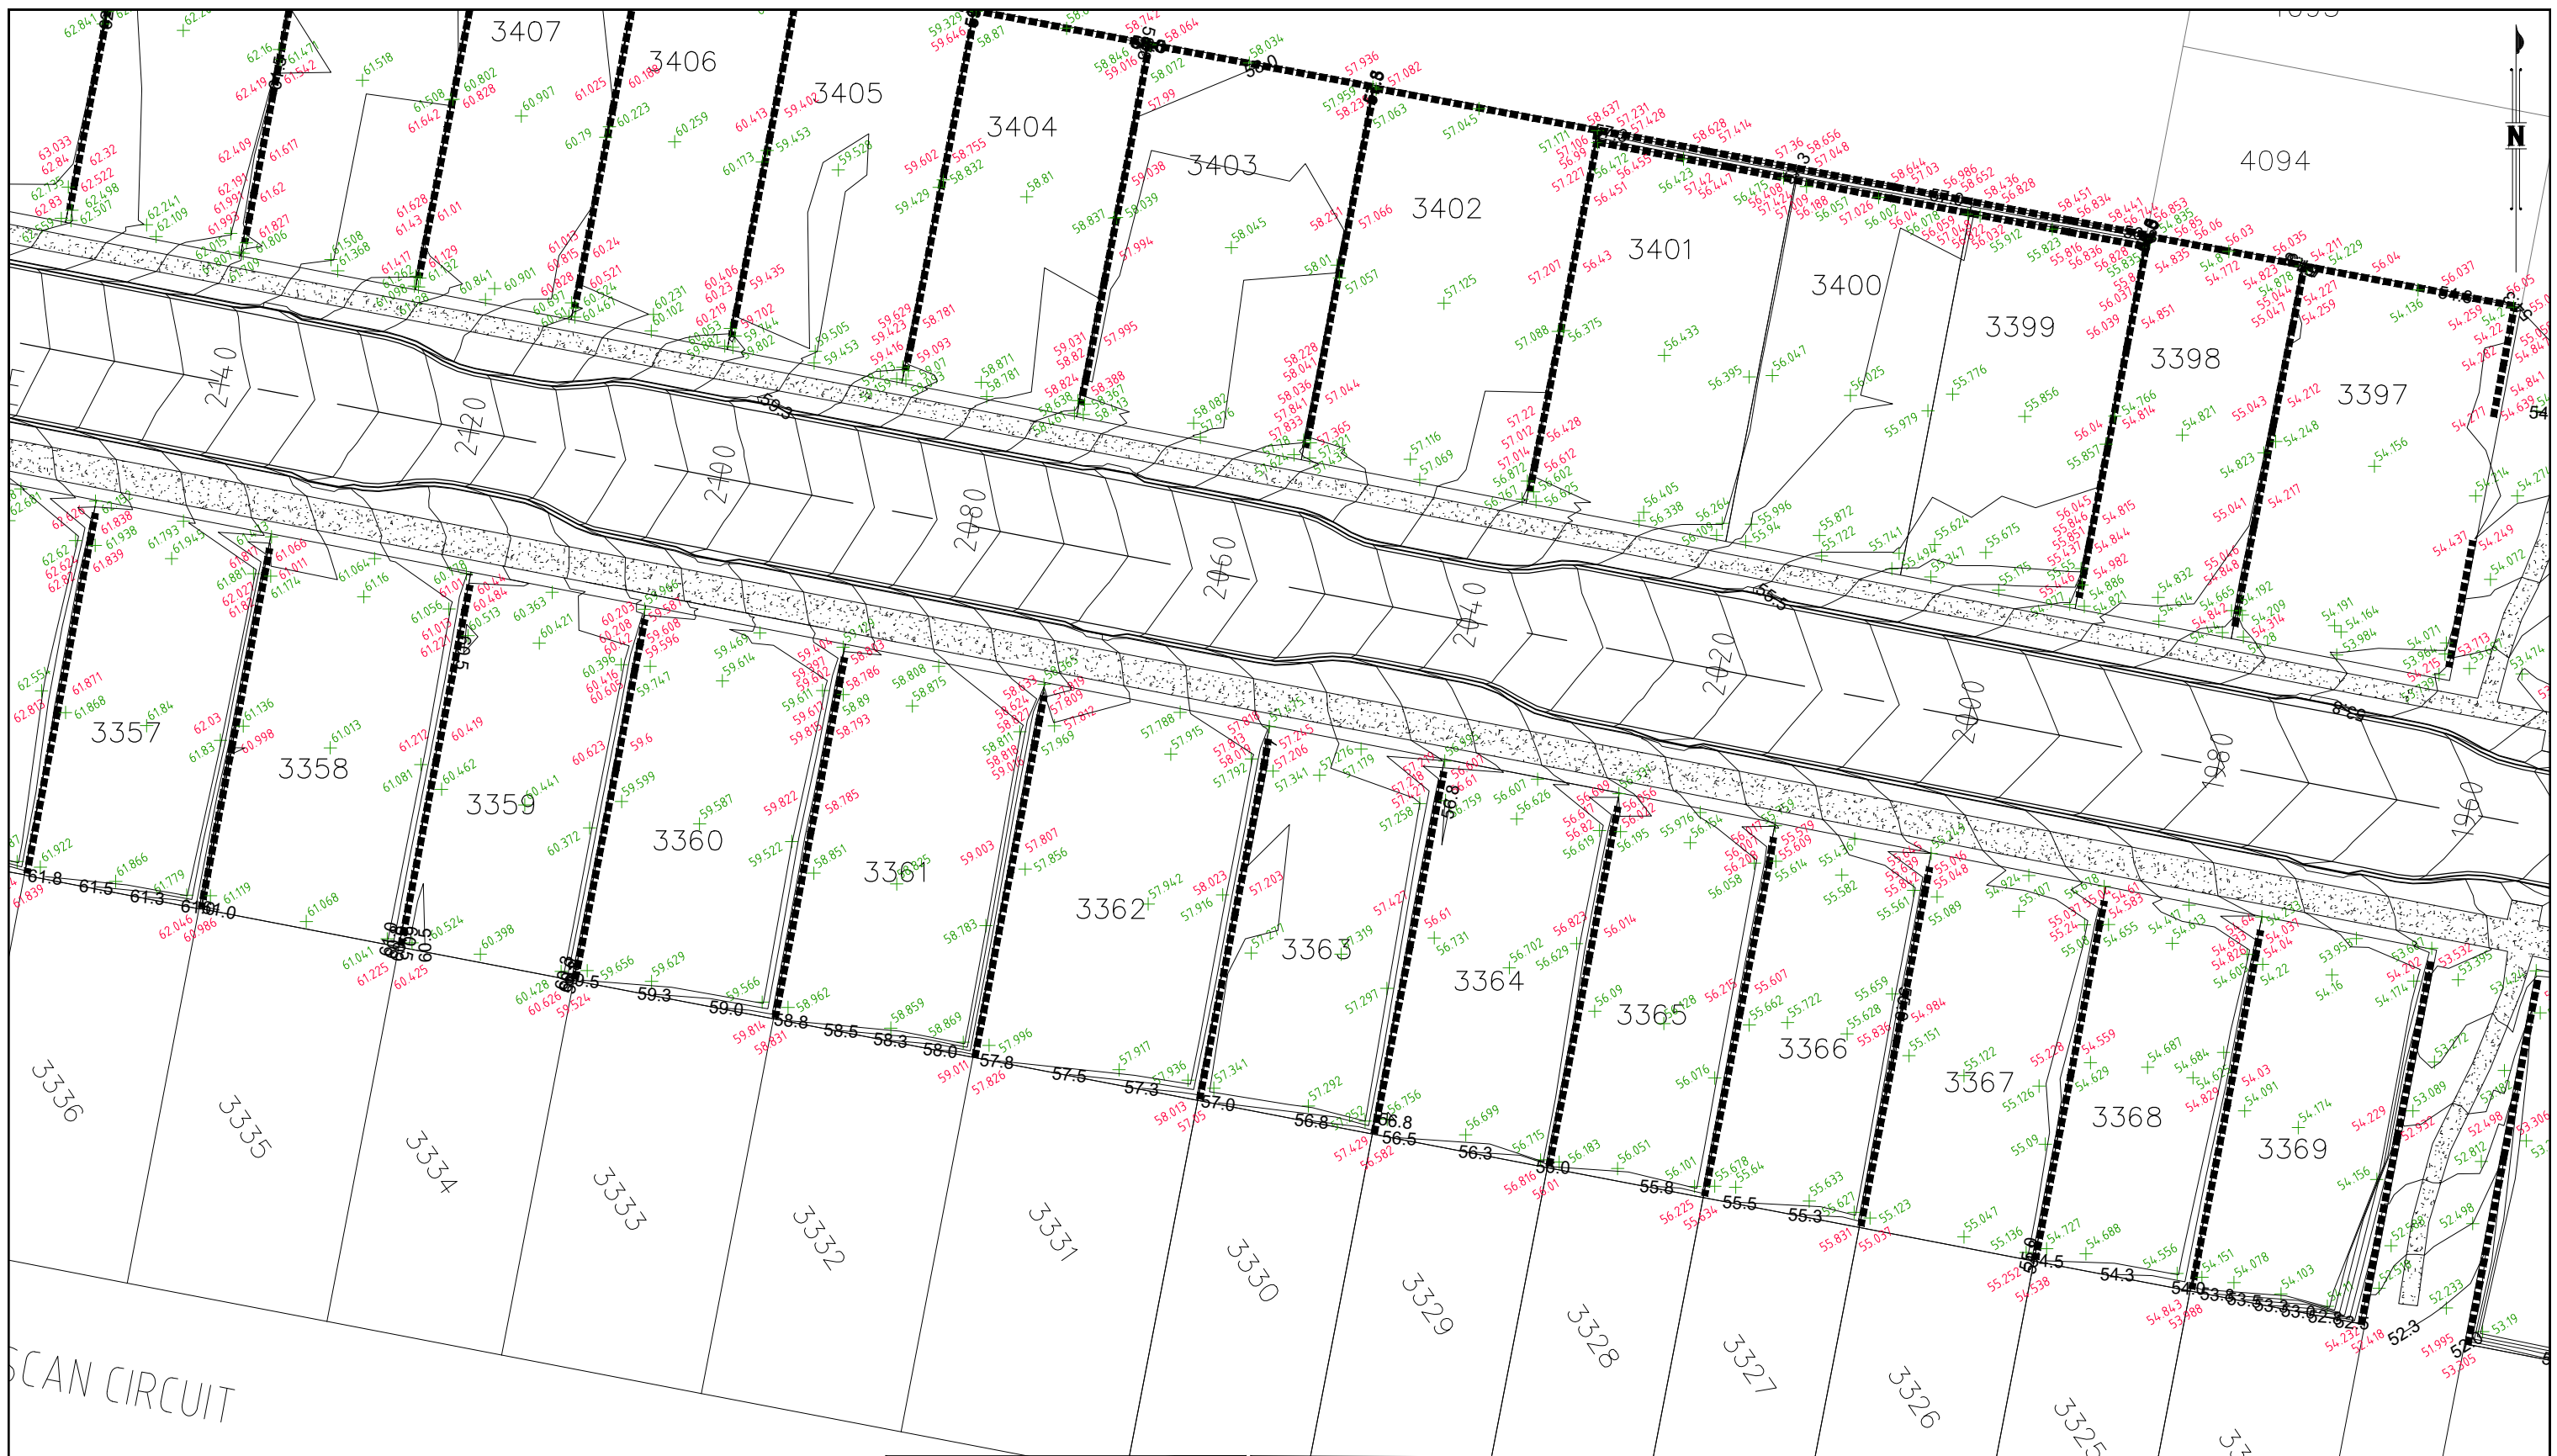

AS CONSTRUCTED

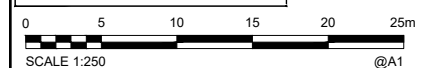

**COORDINATE DATUM NOTE:**  
 HORIZONTAL COORDINATES (E, N) SUPPLIED ARE MAPPING GRID OF AUSTRALIA (MGA), ZONE 56 BASED ON THE UNIVERSAL TRANSVERSE MERCATOR PROJECTION AND THE GEOCENTRIC DATUM OF AUSTRALIA 1994.  
 HORIZONTAL DATUM DERIVED FROM PSM 61308 E 4 98528.114 N 6931171.033.  
 LEVELS SUPPLIED ARE ON THE AUSTRALIAN HEIGHT DATUM (AHD) LEVEL DATUM DERIVED FROM PSM 61308 RLS 4.660 (AHD)

**PAVEMENT DESIGN**

ANDERSON DRIVE	RETAINING WALLS	SPOT HEIGHTS
A(1mm) - 50	-----	+ 56.36
BASE(2.1mm) - 300	-----	WALL HEIGHTS
SUBBASE(2.3mm) - 100	-----	55.524

**ENGINEER'S CERTIFICATION**

Patrick Brady, hereby certify that:

- The information contained in this drawing / document is in compliance with approved drawings and design.
- This represents an accurate record of as-constructed works.
- I accept responsibility for the information contained in this drawing / document.

RPEQ (signature) RPEQ No. 7112 Date

**REGISTERED SURVEYING ASSOCIATE CERTIFICATION**

Gordon Nicholson, hereby certify that the vertical and horizontal locations and dimensions shown on this plan are a true and correct record and were located by survey.

Registered Surveying Associate (S) SA 3405 Date: 29/01/2024

A1	INDEX	DATE	AS CONSTRUCTED	REVISIONS	DRAWN	CHECKED	PASSED
	A	29/01/2024	AS CONSTRUCTED		RDE	DAM	CW

DRAWN	RDE	29/01/2024
CHECKED	DAM	29/01/2024
PASSED	CW	29/01/2024
INITIALS	DATE	




**LOGAN CITY COUNCIL**

MIRVAC MIR-007  
 AS CONSTRUCTED SURVEY - ROADS AND EARTHWORKS  
 EVERLEIGH PRECINCT 9.7C  
 GREENBANK QLD

SHEET 4 OF 6 SHEETS	SCALE 1:250 A1
REVISION DATE 29/01/2024	REVISION A
DISCIPLINE CODE -	
DRAWING NO. ASC-RDS AND EWKS-04-9.7C	



AS CONSTRUCTED

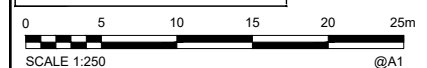

**COORDINATE DATUM NOTE:**  
 HORIZONTAL COORDINATES (E,N) SUPPLIED ARE MAPPING GRID OF AUSTRALIA (MGA), ZONE 56 BASED ON THE UNIVERSAL TRANSVERSE MERCATOR PROJECTION AND THE GEOCENTRIC DATUM OF AUSTRALIA 1994.  
 HORIZONTAL DATUM DERIVED FROM PSM 61308 E 4 98528.114 N 6931171.033.  
 LEVELS SUPPLIED ARE ON THE AUSTRALIAN HEIGHT DATUM (AHD) LEVEL DATUM DERIVED FROM PSM 61308 RLS4.660 (AHD)

**PAVEMENT DESIGN**

ANDERSON DRIVE	RETAINING WALLS	SPOT HEIGHTS
AC(mm)- 50	---	+ 56.36
BASE(2.1)(mm) - 300	---	WALL HEIGHTS
SUBBASE(2.3)(mm) - 100	---	56.600
		55.524

**ENGINEER'S CERTIFICATION**

Patrick Brady, hereby certify that:

- The information contained in this drawing / document is in compliance with approved drawings and design.
- This represents an accurate record of as-constructed works.
- I accept responsibility for the information contained in this drawing / document.

RPEQ (signature) RPEQ No. 7112 Date: \_\_\_\_\_

**REGISTERED SURVEYING ASSOCIATE CERTIFICATION**

Gordon Nicholson, hereby certify that the vertical and horizontal locations and dimensions shown on this plan are a true and correct record and were located by survey.

Registered Surveying Associate (S) SA 3405 Date: 29/01/2024

A1	INDEX	DATE	AS CONSTRUCTED	REVISIONS	DRAWN	CHECKED	PASSED
	A	29/01/2024	AS CONSTRUCTED		RDE	DAM	CW


DRAWN	RDE	29/01/2024
CHECKED	DAM	29/01/2024
PASSED	CW	29/01/2024
INITIALS	DATE	



**LOGAN CITY COUNCIL**

MIRVAC MIR-007  
 AS CONSTRUCTED SURVEY - ROADS AND EARTHWORKS  
 EVERLEIGH PRECINCT 9.7C  
 GREENBANK QLD

SHEET 5 OF 6 SHEETS	SCALE 1:250 A1
REVISION DATE 29/01/2024	REVISION A
DISCIPLINE CODE -	
DRAWING NO. ASC-RDS AND EWKS-05-9.7C	

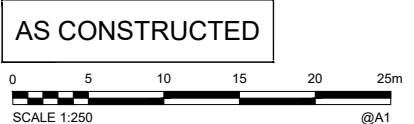

**COORDINATE DATUM NOTE:**  
 HORIZONTAL COORDINATES (N) SUPPLIED ARE MAPPING GRID OF AUSTRALIA (MGA), ZONE 56 BASED ON THE UNIVERSAL TRANSVERSE MERCATOR PROJECTION AND THE GEOCENTRIC DATUM OF AUSTRALIA 1994.  
 HORIZONTAL DATUM DERIVED FROM PSM 61308 E 498528.114 N 6931171.033.  
 LEVELS SUPPLIED ARE ON THE AUSTRALIAN HEIGHT DATUM (AHD) LEVEL DATUM DERIVED FROM PSM 61308 RLS4.660 (AHD)

**PAVEMENT DESIGN**

ANDERSON DRIVE  
 AC(11mm) - 50  
 BASE(2.1mm) - 300  
 SUBBASE(2.3mm) - 100

**RETAINING WALLS**

**SPOT HEIGHTS**  
 + 56.36  
**WALL HEIGHTS**  
 56.600  
 55.524

**ENGINEER'S CERTIFICATION**

Patrick Brady, hereby certify that:  
 1. The information contained in this drawing / document is in compliance with approved drawings and design.  
 2. This represents an accurate record of as-constructed works.  
 3. I accept responsibility for the information contained in this drawing / document.

RPEQ (signature) RPEQ No. 7112 Date:

**REGISTERED SURVEYING ASSOCIATE CERTIFICATION**

Gordon Nicholson, hereby certify that the vertical and horizontal locations and dimensions shown on this plan are a true and correct record and were located by survey.

Registered Surveying Associate (S) SA 3405 Date: 29/01/2024

<b>A1</b>	INDEX	DATE	AS CONSTRUCTED	REVISIONS	DRAWN	CHECKED	PASSED	DRAWN	CHECKED	PASSED	INITIALS	DATE
	A	29/01/2024	AS CONSTRUCTED		RDE	DAM	CW					



**LOGAN CITY COUNCIL**

MIRVAC MIR-007  
 AS CONSTRUCTED SURVEY - ROADS AND EARTHWORKS  
 EVERLEIGH PRECINCT 9.7C  
 GREENBANK QLD

SHEET 6 OF 6 SHEETS	SCALE 1:250 A1
REVISION DATE 29/01/2024	REVISION A
DISCIPLINE CODE -	
DRAWING NO. ASC-RDS AND EWKS-06-9.7C	