


PM61308 RL
 E: 498528.114
 N: 6931171.033
 RL: 54.660m



AS CONSTRUCTED CERTIFICATION

I, Patrick Brady, hereby certify that:
 1. The information contained in this drawing/document is generally in compliance with approved drawings and design.
 2. To the best of my knowledge, this represents an accurate record of as constructed works and I accept the responsibility for the information contained in this drawing/document. Excluding Survey Error.
 RPEQ (Signature) *Patrick Brady* RPEQ No. 7112 Date: 08/02/2024

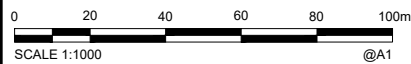


AS CONSTRUCTED

COORDINATE DATUM NOTE:
 HORIZONTAL COORDINATES(E,N) SUPPLIED ARE MAPPING GRID OF AUSTRALIA(MGA), ZONE 56 BASED ON THE UNIVERSAL TRANSVERSE MERCATOR PROJECTION AND THE GEOCENTRIC DATUM OF AUSTRALIA 1994.
 HORIZONTAL DATUM DERIVED FROM PSM 61308 E 498528.114 N 6931171.033.
 LEVELS SUPPLIED ARE ON THE AUSTRALIAN HEIGHT DATUM(AHD)
 LEVEL DATUM DERIVED FROM PSM 61308 RL54.660 (AHD)

REGISTERED SURVEYING ASSOCIATE CERTIFICATION

I, Gordon Nicholson, hereby certify that the vertical and horizontal locations and dimensions shown on this plan are a true and correct record and were located by survey.
 Registered Surveying Associate(sig) *Gordon Nicholson* Surveyor No. SA 3405 Date: 07/12/2023

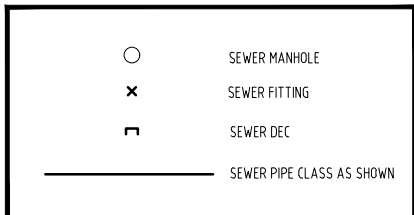


A1	INDEX	DATE	AS CONSTRUCTED	REVISIONS	DRAWN	CHECKED	PASSED	DRAWN	CHECKED	PASSED	INITIALS	DATE

99 Sandstone Lane, Forest Glen QLD 4055
 0-7 5490 3000 • 0-7 5490 3000 • info@shadforth.com.au

LOGAN CITY COUNCIL
 MIRVAC MIR-007
 AS CONSTRUCTED SURVEY - SEWER
 EVERLEIGH PRECINCT 9.7C
 GREENBANK QLD

SHEET 1 OF 5 SHEETS	SCALE 1:1000 A1
REVISION DATE 7/12/2023	REVISION -
DISCIPLINE CODE -	
DRAWING NO. ASC-SEWER-01-9.7C	

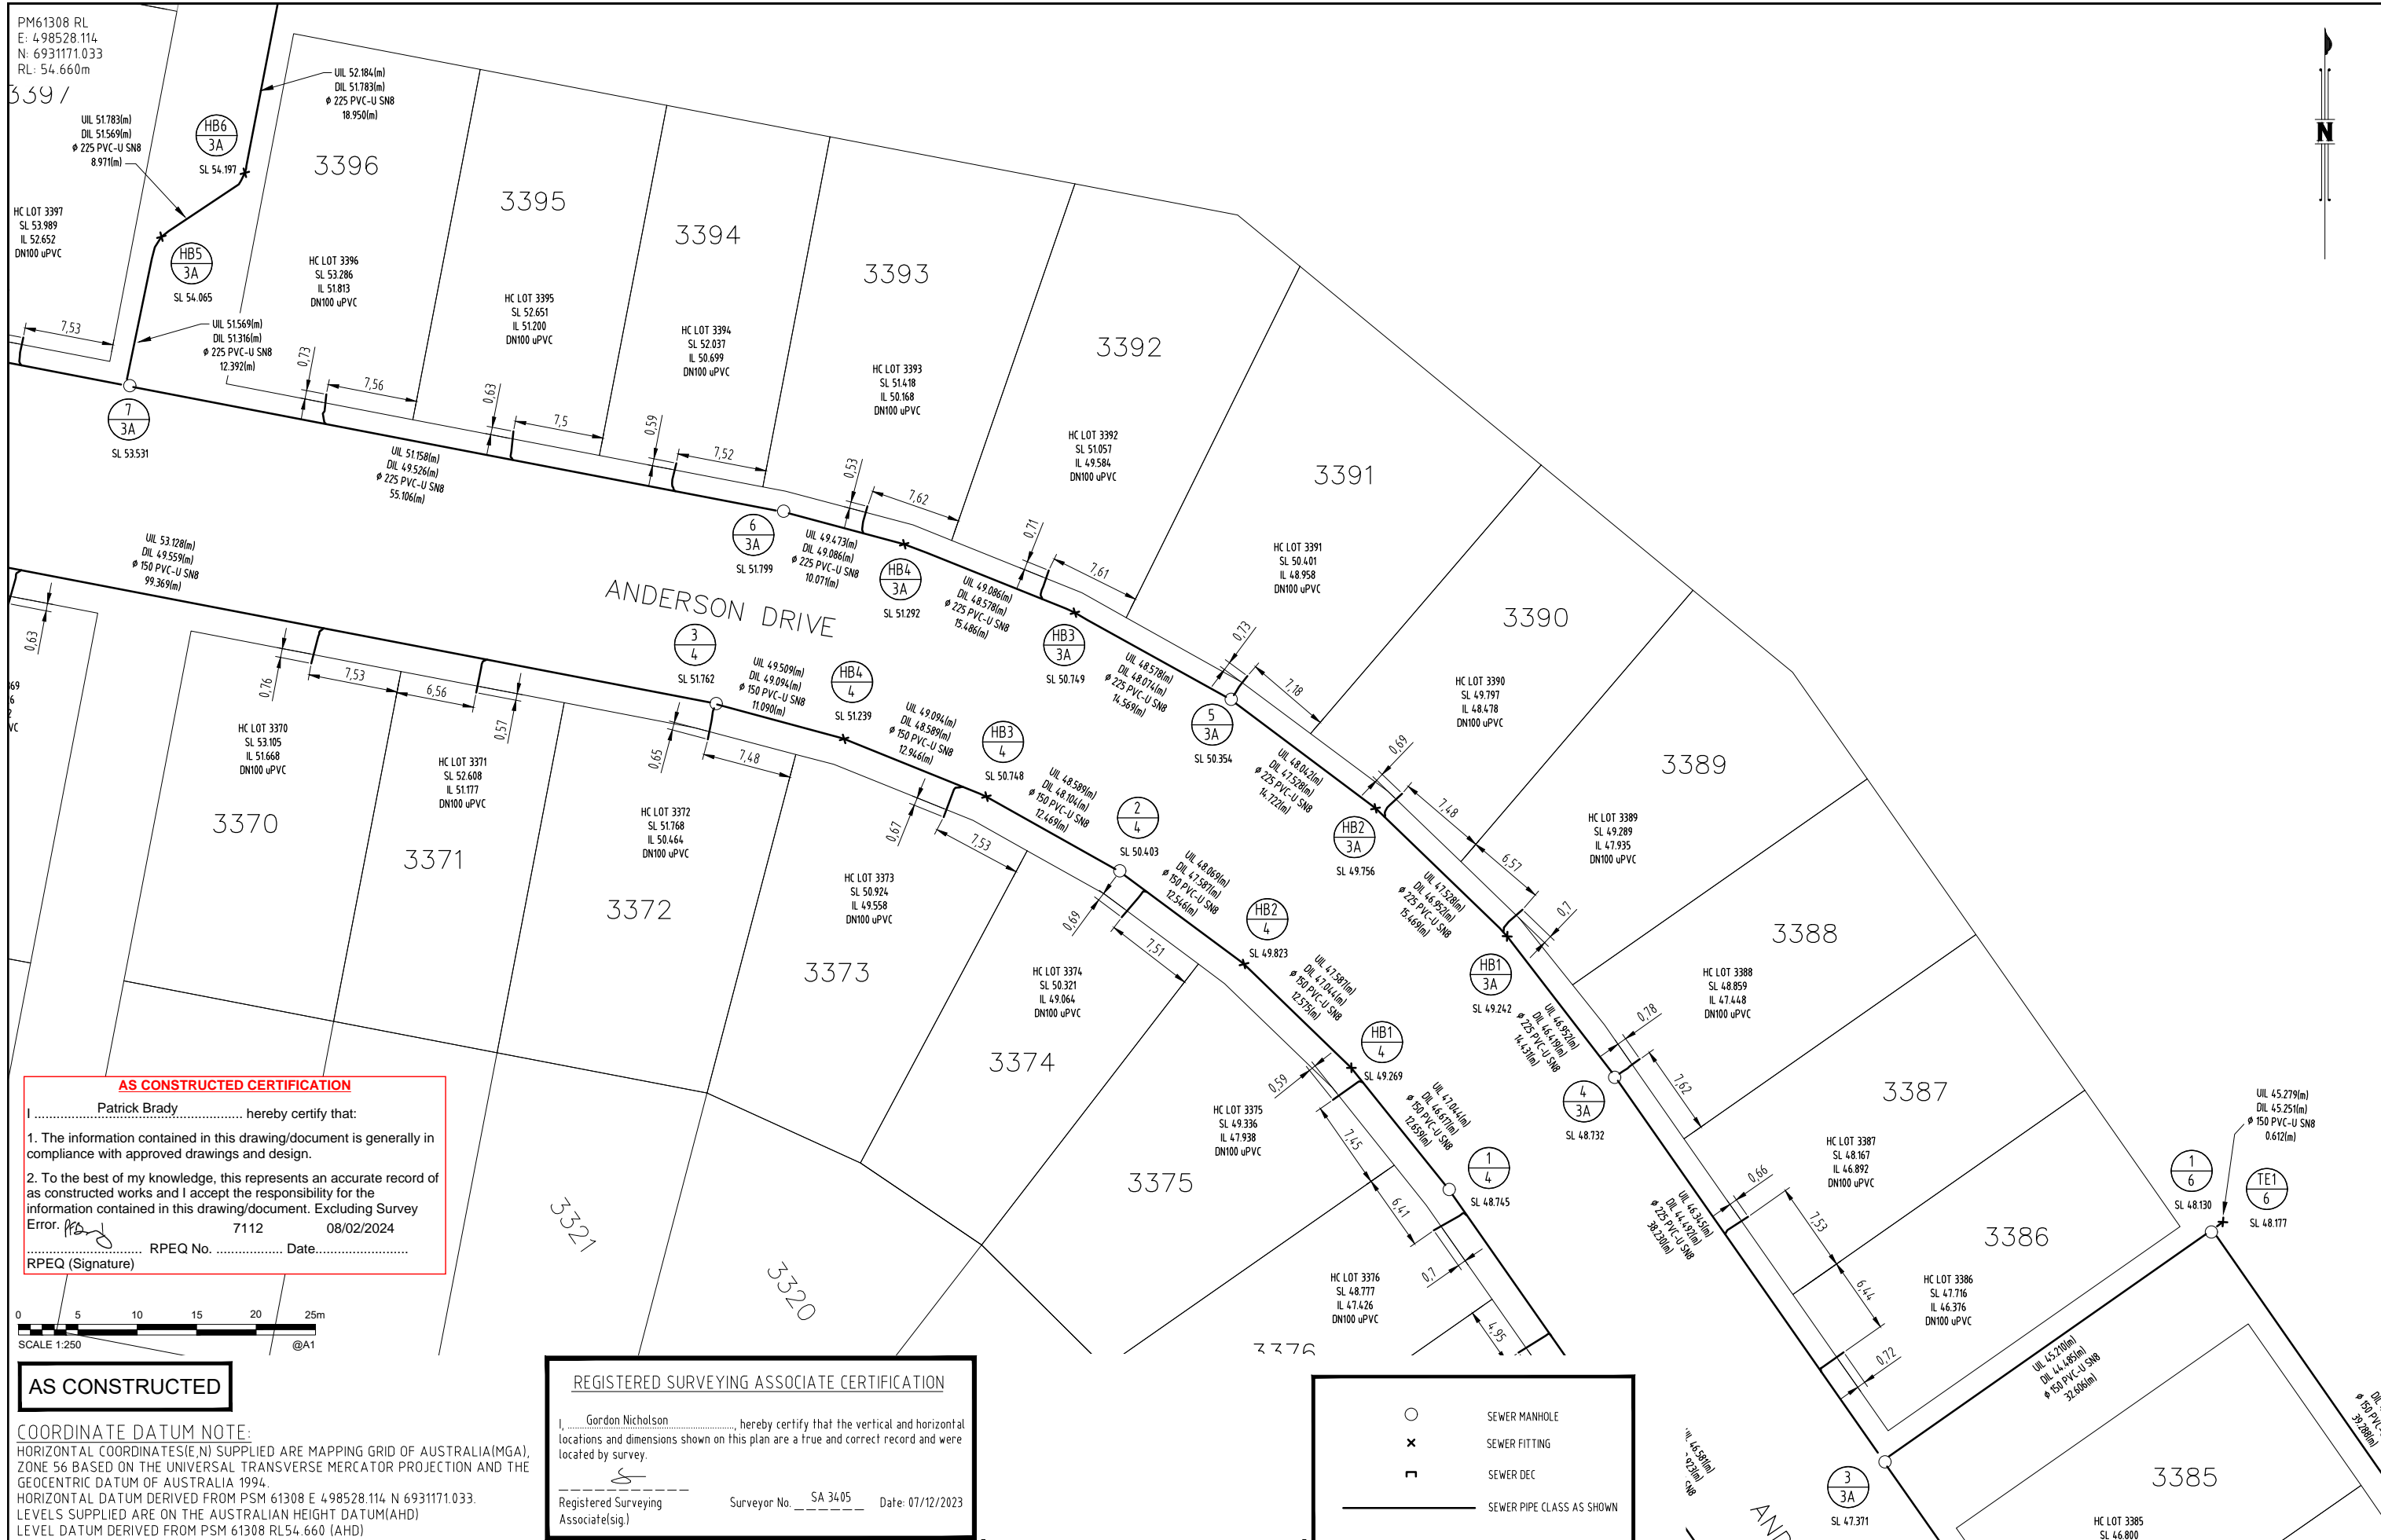

PM61308 RL
 E: 498528.114
 N: 6931171.033
 RL: 54.660m



AS CONSTRUCTED CERTIFICATION


I, Patrick Brady, hereby certify that:

- The information contained in this drawing/document is generally in compliance with approved drawings and design.
- To the best of my knowledge, this represents an accurate record of as constructed works and I accept the responsibility for the information contained in this drawing/document. Excluding Survey Error.

7112 08/02/2024

RPEQ No. _____ Date: _____

RPEQ (Signature) _____

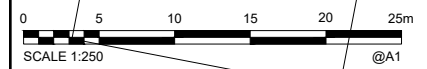


AS CONSTRUCTED

COORDINATE DATUM NOTE:
 HORIZONTAL COORDINATES(E,N) SUPPLIED ARE MAPPING GRID OF AUSTRALIA(MGA), ZONE 56 BASED ON THE UNIVERSAL TRANSVERSE MERCATOR PROJECTION AND THE GEOCENTRIC DATUM OF AUSTRALIA 1994.
 HORIZONTAL DATUM DERIVED FROM PSM 61308 E 498528.114 N 6931171.033.
 LEVELS SUPPLIED ARE ON THE AUSTRALIAN HEIGHT DATUM(AHD)
 LEVEL DATUM DERIVED FROM PSM 61308 RL54.660 (AHD)

REGISTERED SURVEYING ASSOCIATE CERTIFICATION

I, Gordon Nicholson, hereby certify that the vertical and horizontal locations and dimensions shown on this plan are a true and correct record and were located by survey.

Registered Surveying Associate(sig) _____ Surveyor No. SA 3405 Date: 07/12/2023

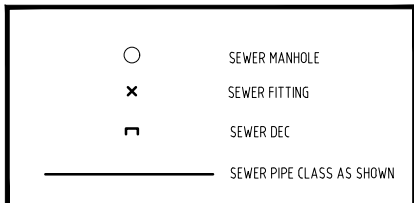

A1	INDEX	DATE	AS CONSTRUCTED	REVISIONS	DRAWN	CHECKED	PASSED	DRAWN	CHECKED	PASSED	DRAWN	CHECKED	PASSED



LOGAN CITY COUNCIL


MIRVAC MIR-007
 AS CONSTRUCTED SURVEY - SEWER
 EVERLEIGH PRECINCT 9.7C
 GREENBANK QLD

SHEET 3 OF 5	SHEETS	SCALE 1:250 A1
REVISION DATE	7/12/2023	REVISION -
DISCIPLINE CODE	-	
DRAWING NO.	ASC-SEWER-03-9.7C	

PM61308 RL
 E: 498528.114
 N: 6931171.033
 RL: 54.660m




AS CONSTRUCTED CERTIFICATION
 I, Patrick Brady, hereby certify that:
 1. The information contained in this drawing/document is generally in compliance with approved drawings and design.
 2. To the best of my knowledge, this represents an accurate record of as constructed works and I accept the responsibility for the information contained in this drawing/document. Excluding Survey Error.
 RPEQ No. 7112 Date: 08/02/2024
 RPEQ (Signature)

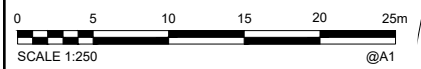

AS CONSTRUCTED

COORDINATE DATUM NOTE:
 HORIZONTAL COORDINATES(E,N) SUPPLIED ARE MAPPING GRID OF AUSTRALIA(MGA), ZONE 56 BASED ON THE UNIVERSAL TRANSVERSE MERCATOR PROJECTION AND THE GEOCENTRIC DATUM OF AUSTRALIA 1994.
 HORIZONTAL DATUM DERIVED FROM PSM 61308 E 498528.114 N 6931171.033.
 LEVELS SUPPLIED ARE ON THE AUSTRALIAN HEIGHT DATUM(AHD)
 LEVEL DATUM DERIVED FROM PSM 61308 RL54.660 (AHD)

REGISTERED SURVEYING ASSOCIATE CERTIFICATION
 I, Gordon Nicholson, hereby certify that the vertical and horizontal locations and dimensions shown on this plan are a true and correct record and were located by survey.
 Registered Surveying Associate(sig) Surveyor No. SA 3405 Date: 07/12/2023

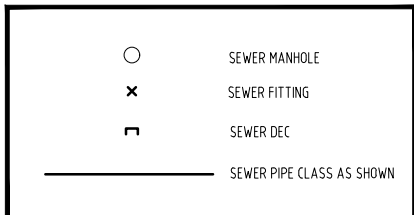

A1	INDEX	DATE	AS CONSTRUCTED	REVISIONS	DRAWN	CHECKED	PASSED	DRAWN	CHECKED	PASSED



LOGAN CITY COUNCIL
 MIRVAC MIR-007
 AS CONSTRUCTED SURVEY - SEWER
 EVERLEIGH PRECINCT 9.7C
 GREENBANK QLD


SHEET 4 OF 5 SHEETS	SCALE 1:250 A1
REVISION DATE 7/12/2023	REVISION -
DISCIPLINE CODE -	
DRAWING NO. ASC-SEWER-04-9.7C	

PM61308 RL
 E: 498528.114
 N: 6931171.033
 RL: 54.660m



AS CONSTRUCTED CERTIFICATION

I, Patrick Brady, hereby certify that:
 1. The information contained in this drawing/document is generally in compliance with approved drawings and design.
 2. To the best of my knowledge, this represents an accurate record of as constructed works and I accept the responsibility for the information contained in this drawing/document. Excluding Survey Error.
 RPEQ (Signature) _____ RPEQ No. 7112 Date: 08/02/2024

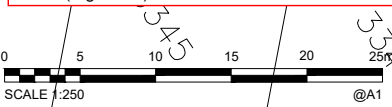

AS CONSTRUCTED

REGISTERED SURVEYING ASSOCIATE CERTIFICATION

I, Gordon Nicholson, hereby certify that the vertical and horizontal locations and dimensions shown on this plan are a true and correct record and were located by survey.
 Registered Surveying Associate (sig) _____ Surveyor No. SA 3405 Date: 07/12/2023

Legend for symbols:
 ○ SEWER MANHOLE
 × SEWER FITTING
 □ SEWER DEC
 — SEWER PIPE CLASS AS SHOWN

COORDINATE DATUM NOTE:
 HORIZONTAL COORDINATES(E,N) SUPPLIED ARE MAPPING GRID OF AUSTRALIA(MGA), ZONE 56 BASED ON THE UNIVERSAL TRANSVERSE MERCATOR PROJECTION AND THE GEOCENTRIC DATUM OF AUSTRALIA 1994.
 HORIZONTAL DATUM DERIVED FROM PSM 61308 E 498528.114 N 6931171.033.
 LEVELS SUPPLIED ARE ON THE AUSTRALIAN HEIGHT DATUM(AHD)
 LEVEL DATUM DERIVED FROM PSM 61308 RL54.660 (AHD)

A1	INDEX	DATE	AS CONSTRUCTED	REVISIONS	DRAWN	CHECKED	PASSED	DRAWN	CHECKED	PASSED



LOGAN CITY COUNCIL
 MIRVAC MIR-0907
 AS CONSTRUCTED SURVEY - SEWER
 EVERLEIGH PRECINCT 9.7C
 GREENBANK QLD

SHEET 5 OF 5 SHEETS	SCALE 1:250 A1
REVISION DATE 7/12/2023	REVISION -
DISCIPLINE CODE -	
DRAWING NO. ASC-SEWER-05-9.7C	