

REFER TO PLAN ASC-STORMWATER-04-9.7C

REFER TO PLAN ASC-STORMWATER-03-9.7C

33. REFER TO PLAN ASC-STORMWATER-02-9.7C

**Patrick Brady**, hereby certify that:  
 the information contained in this drawing / document is in compliance with  
 approved drawings and design.  
 the new water and sewerage works defined by this drawing have been designed  
 and constructed in accordance with the SEQ Code.  
 this represents an accurate record of as-constructed works  
 I accept responsibility for the information contained in this drawing / document.

\_\_\_\_\_  
RPEQ (signature) RPEQ No. 7112 Date: \_\_\_\_\_

REGISTERED SURVEYING ASSOCIATE CERTIFICATION

I, Gordon Nicholson, hereby certify that the vertical and horizontal locations and dimensions shown on this plan are a true and correct record and were located by survey.

Registered Surveying Associate(sig.)      Surveyor No. SA 3405      Date: 18/01/2024

0 20 40 60 80 100m

SCALE 1:1000 @A1

COORDINATE DATUM NOTE:

HORIZONTAL DATUM DERIVED FROM PSM 61308 E 498528.114 N 6931171.033.  
LEVELS SUPPLIED ARE ON THE AUSTRALIAN HEIGHT DATUM(AHD)  
LEVEL DATUM DERIVED FROM PSM 61308 RL54.660 (AHD)

# A1

[illegible]

DRAWN	RDE	18/01/2024
CHECKED	DAM	18/01/2024
PASSED	LS	18/01/2024
	INITIALS	DATE



LOGAN CITY COUNCIL

MIRVAC MIR-0907  
AS CONSTRUCTED SURVEY - STORMWATER  
EVERLEIGH PRECINCT 9.7C  
GREENBANK QLD

SHEET 1 OF 5 SHEETS		SCALE 1:500 A1	
REVISION DATE	18/01/2024	REVISION	A
DISCIPLINE CODE		—	
DRAWING NO.			
ASC-STORM-01-9.7C			



PM61308 RL  
E: 498528.114  
N: 6931171.033  
Z RL: 54.660m



AS CONSTRUCTED

ENGINEER'S CERTIFICATION

I, Patrick Brady, hereby certify that:  
1. The information contained in this drawing / document is in compliance with approved drawings and design.  
2. The new water and sewerage works defined by this drawing have been designed and constructed in accordance with the SEQ Code.  
3. This represents an accurate record of as-constructed works.  
4. I accept responsibility for the information contained in this drawing / document.  
RPEQ (signature) RPEQ No. 7112 Date:

REGISTERED SURVEYING ASSOCIATE CERTIFICATION

I, Gordon Nicholson, hereby certify that the vertical and horizontal locations and dimensions shown on this plan are a true and correct record and were located by survey.  
Registered Surveying Associate(sig.) Surveyor No. SA 3405 Date: 18/01/2024

COORDINATE DATUM NOTE:  
HORIZONTAL COORDINATES(E,N) SUPPLIED ARE MAPPING GRID OF AUSTRALIA(MGA), ZONE 56 BASED ON THE UNIVERSAL TRANSVERSE MERCATOR PROJECTION AND THE GEOCENTRIC DATUM OF AUSTRALIA 1994.  
HORIZONTAL DATUM DERIVED FROM PSM 61308 E 498528.114 N 6931171.033.  
LEVELS SUPPLIED ARE ON THE AUSTRALIAN HEIGHT DATUM(AHD)  
LEVEL DATUM DERIVED FROM PSM 61308 RL54.660 (AHD)

A1

INDEX	DATE	REVISIONS	DRAWN	CHECKED	PASSED
A	18/01/2024	AS CONSTRUCTED	RDE	DAM	LS

DRAWN	RDE	18/01/2024
CHECKED	DAM	18/01/2024
PASSED	LS	18/01/2024
INITIALS	DATE	




LOGAN CITY COUNCIL

MIRVAC MIR-0907  
AS CONSTRUCTED SURVEY - STORMWATER  
EVERLEIGH PRECINCT 9.7C  
GREENBANK QLD

SHEET 2 OF 5 SHEETS	SCALE 1:250 A1
REVISION DATE 18/01/2024	REVISION A
DISCIPLINE CODE -	
DRAWING NO. ASC-STORM-02-9.7C	




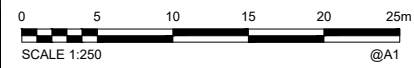

RPEQ (signature) RPEQ No. 7112 Date: \_\_\_\_\_


# A1

 **shadforth**  
39 Shadsworth Lane, Forest Glen QLD 4066  
t: 07 5438 3300 f: 07 5438 3388 e: shad@shadforth.com.au

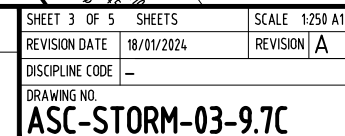



# N

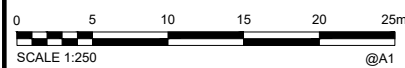

### ENGINEER'S CERTIFICATION

1. The information contained in this drawing / document is in compliance with approved drawings and design.
2. The new water and sewerage works defined by this drawing have been designed and constructed in accordance with the SEQ Code.
3. This represents an accurate record of as-constructed works
4. I accept responsibility for the information contained in this drawing / document.

RPEQ (signature) RPEQ No. 7112 Date

I, Gordon Nicholson, hereby certify that the vertical and horizontal locations and dimensions shown on this plan are a true and correct record and were located by survey.

Registered Surveying  
Associate(siq.)

Surveyor No. SA 3405 Date: 18/01/2024

HORIZONTAL DATUM DERIVED FROM PSM 61308 E 498528.114 N 6931171.033.  
LEVELS SUPPLIED ARE ON THE AUSTRALIAN HEIGHT DATUM(AHD)  
LEVEL DATUM DERIVED FROM PSM 61308 RL54.660 (AHD)



**shadforth**  
 30 Churchwood Lane, Forest Glen QLD 4086  
 ☎ 07 4306 5370 ✉ info@shadforth.com.au




MIRVAC MIR-0907  
AS CONSTRUCTED SURVEY - STORMWATER  
EVERLEIGH PRECINCT 9.7C  
GREENBANK QLD

SHEET 4 OF 5 SHEETS		SCALE 1:250 A1	
REVISION DATE	18/01/2024	REVISION	A
DISCIPLINE CODE		—	
DRAWING NO. <b>ASC-STORM-04-9.7C</b>			



PM61308 RL  
E: 498528.114  
N: 6931171.033  
RL: 54.660m

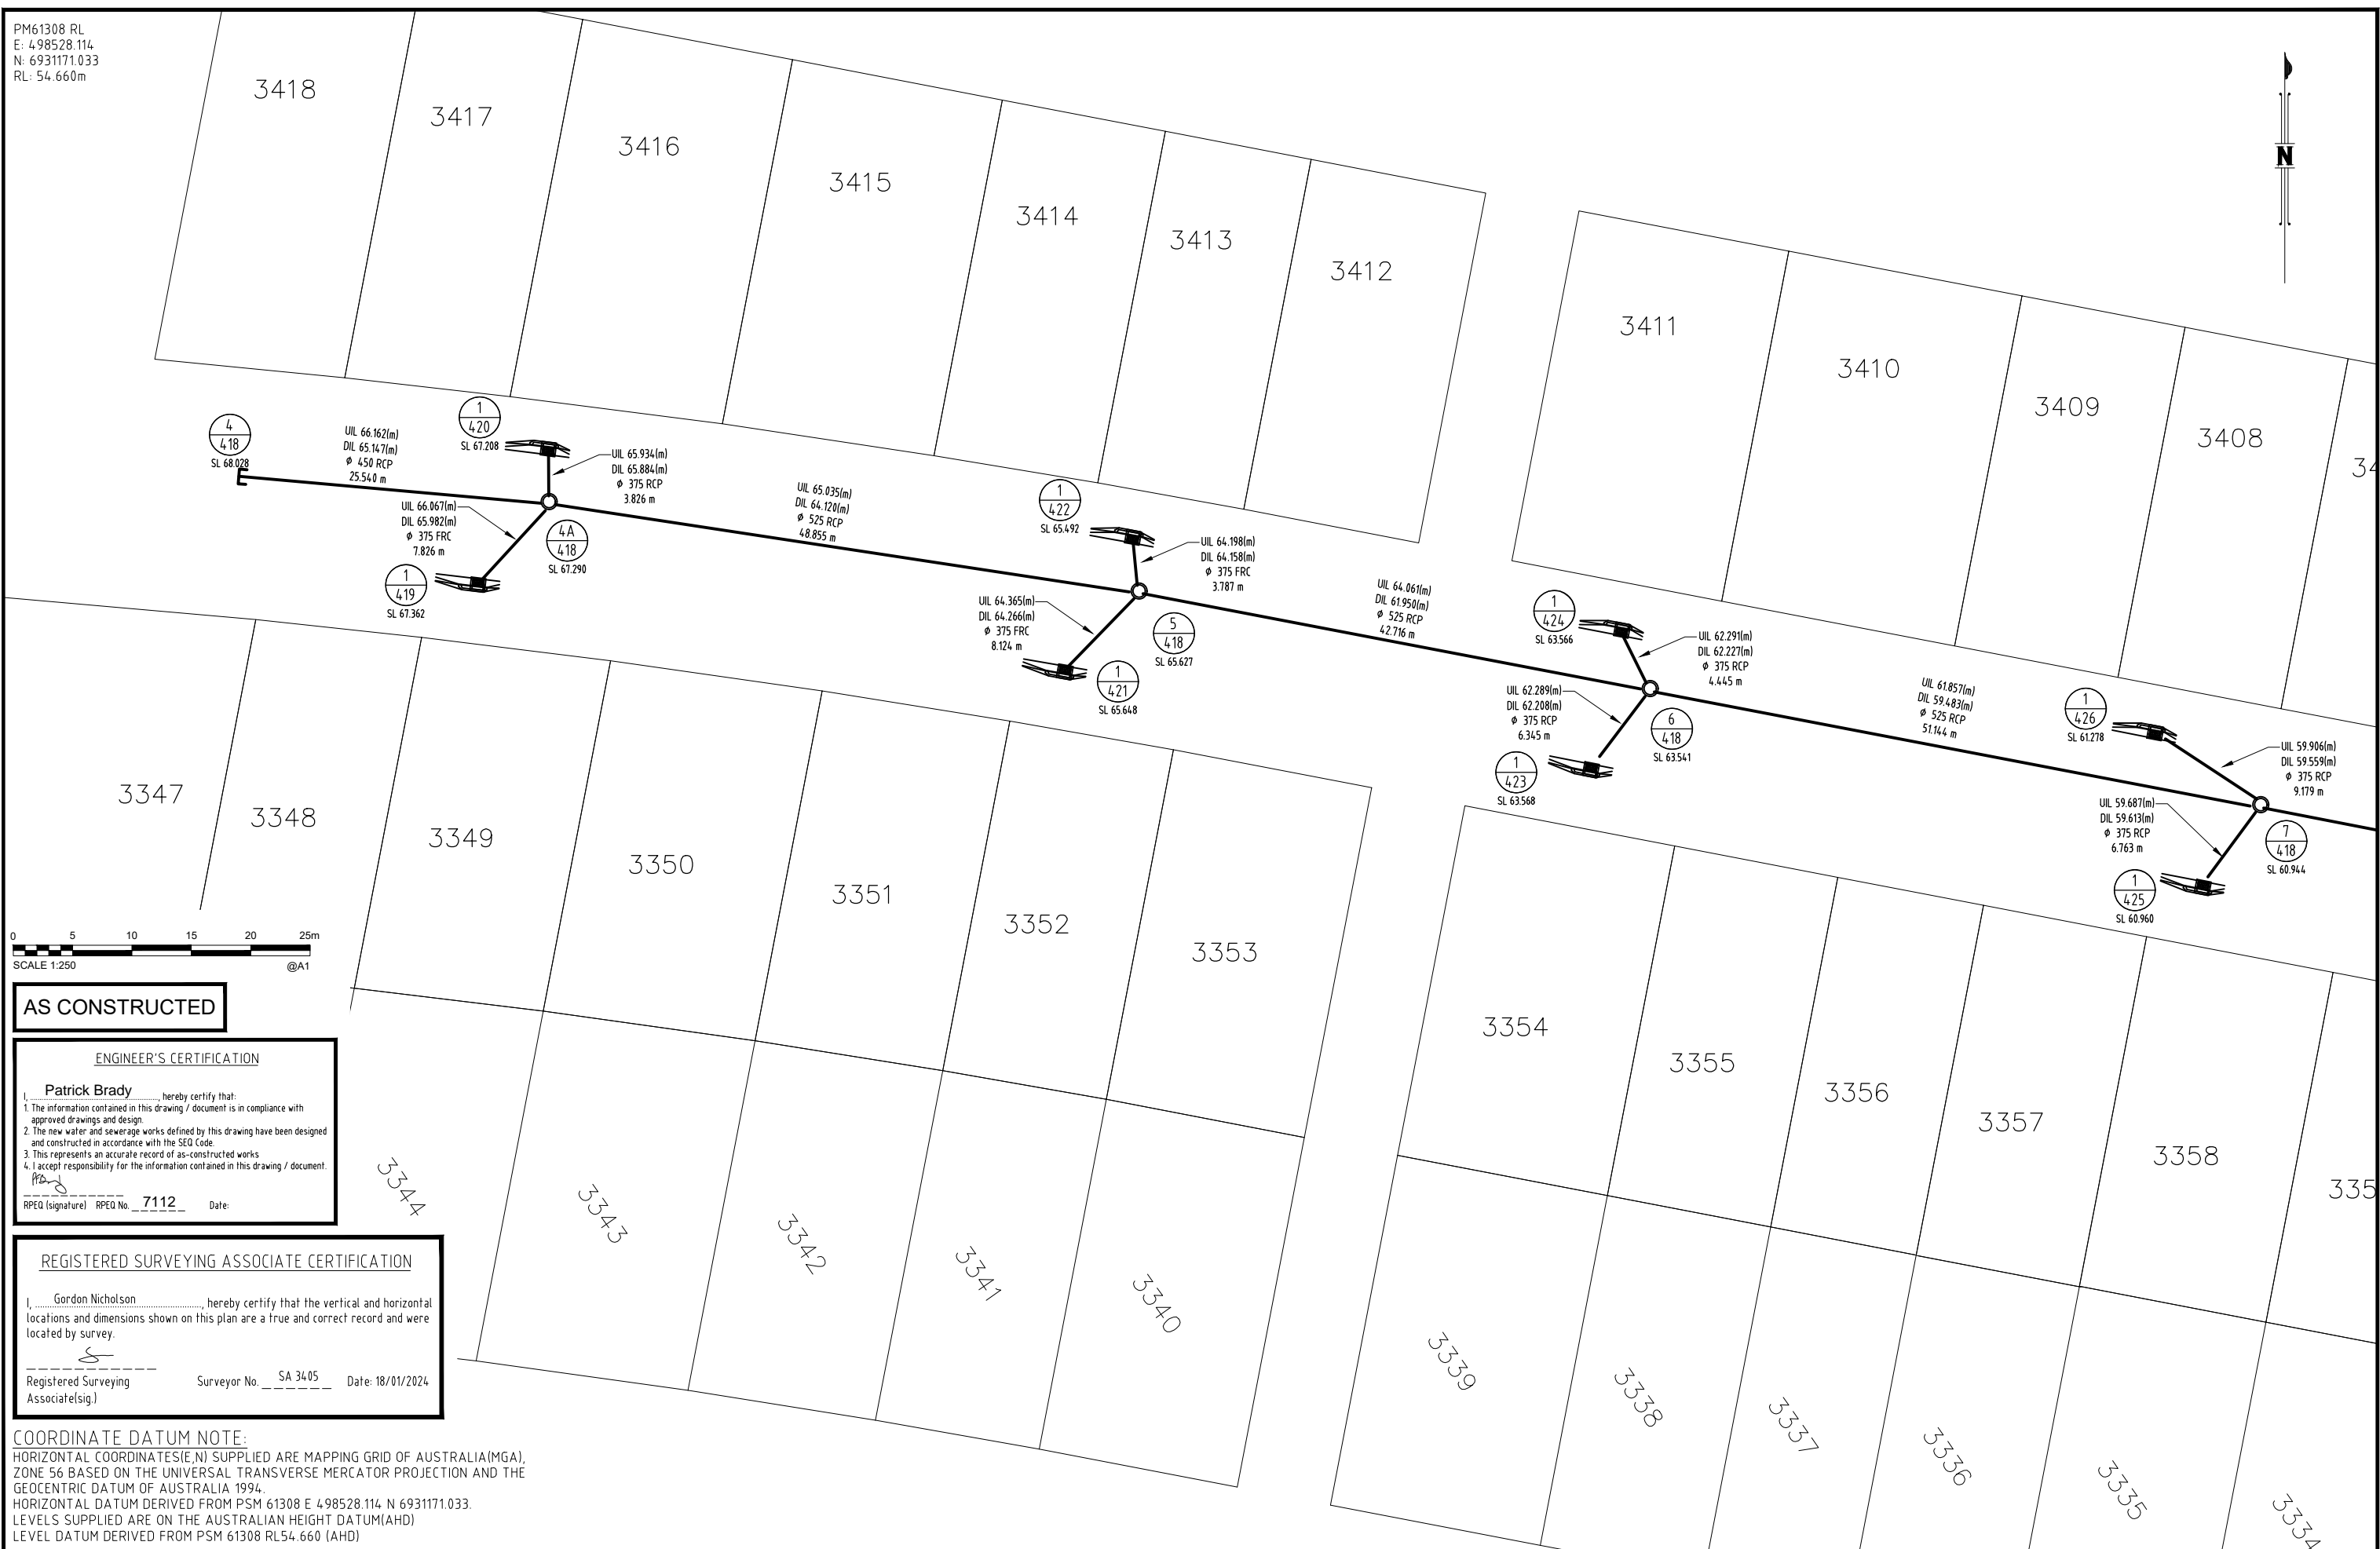


AS CONSTRUCTED

## ENGINEER'S CERTIFICATION

I, Patrick Brady, hereby certify that:

1. The information contained in this drawing / document is in compliance with approved drawings and design.
2. The new water and sewerage works defined by this drawing have been designed and constructed in accordance with the SGO Code
3. This represents an accurate record of as-constructed works
4. I accept responsibility for the information contained in this drawing / document.



\_\_\_\_\_  
RPEO (signature)    RPEO No. 7112    Date: \_\_\_\_\_

REGISTERED SURVEYING ASSOCIATE CERTIFICATION

I, Gordon Nicholson, hereby certify that the vertical and horizontal locations and dimensions shown on this plan are a true and correct record and were located by survey.

S \_\_\_\_\_

Registered Surveying      Surveyor No. SA 3405      Date: 18/01/2024  
Associate(sig.)

**COORDINATE DATUM NOTE:**  
HORIZONTAL COORDINATES(E,N) SUPPLIED ARE MAPPING GRID OF AUSTRALIA(MGA),  
ZONE 56 BASED ON THE UNIVERSAL TRANSVERSE MERCATOR PROJECTION AND THE  
GEOCENTRIC DATUM OF AUSTRALIA 1994.  
HORIZONTAL DATUM DERIVED FROM PSM 61308 E 4 98528.114 N 6931171.033.  
LEVELS SUPPLIED ARE ON THE AUSTRALIAN HEIGHT DATUM(AHD)  
LEVEL DATUM DERIVED FROM PSM 61308 RL54.660 (AHD)

A1																																																																																																																																																																																																																																																																																																																																																																																																																																																																																																																																																																																																																																																																																																																																																																																																																																																																																																																																																																																																																																																																																																																																																																																																																																																																																																																																																																																																																			
----	--	--	