

PM61308 RL
 E: 498528.701
 N: 6931172.421
 RL: 54.660m





REFER TO PLAN ASC-SEWER-02-10.1C

REFER TO PLAN ASC-SEWER-03-10.1C

REFER TO PLAN ASC-SEWER-04-10.1C

REFER TO PLAN ASC-SEWER-05-10.1C

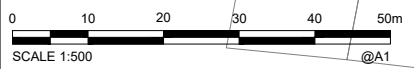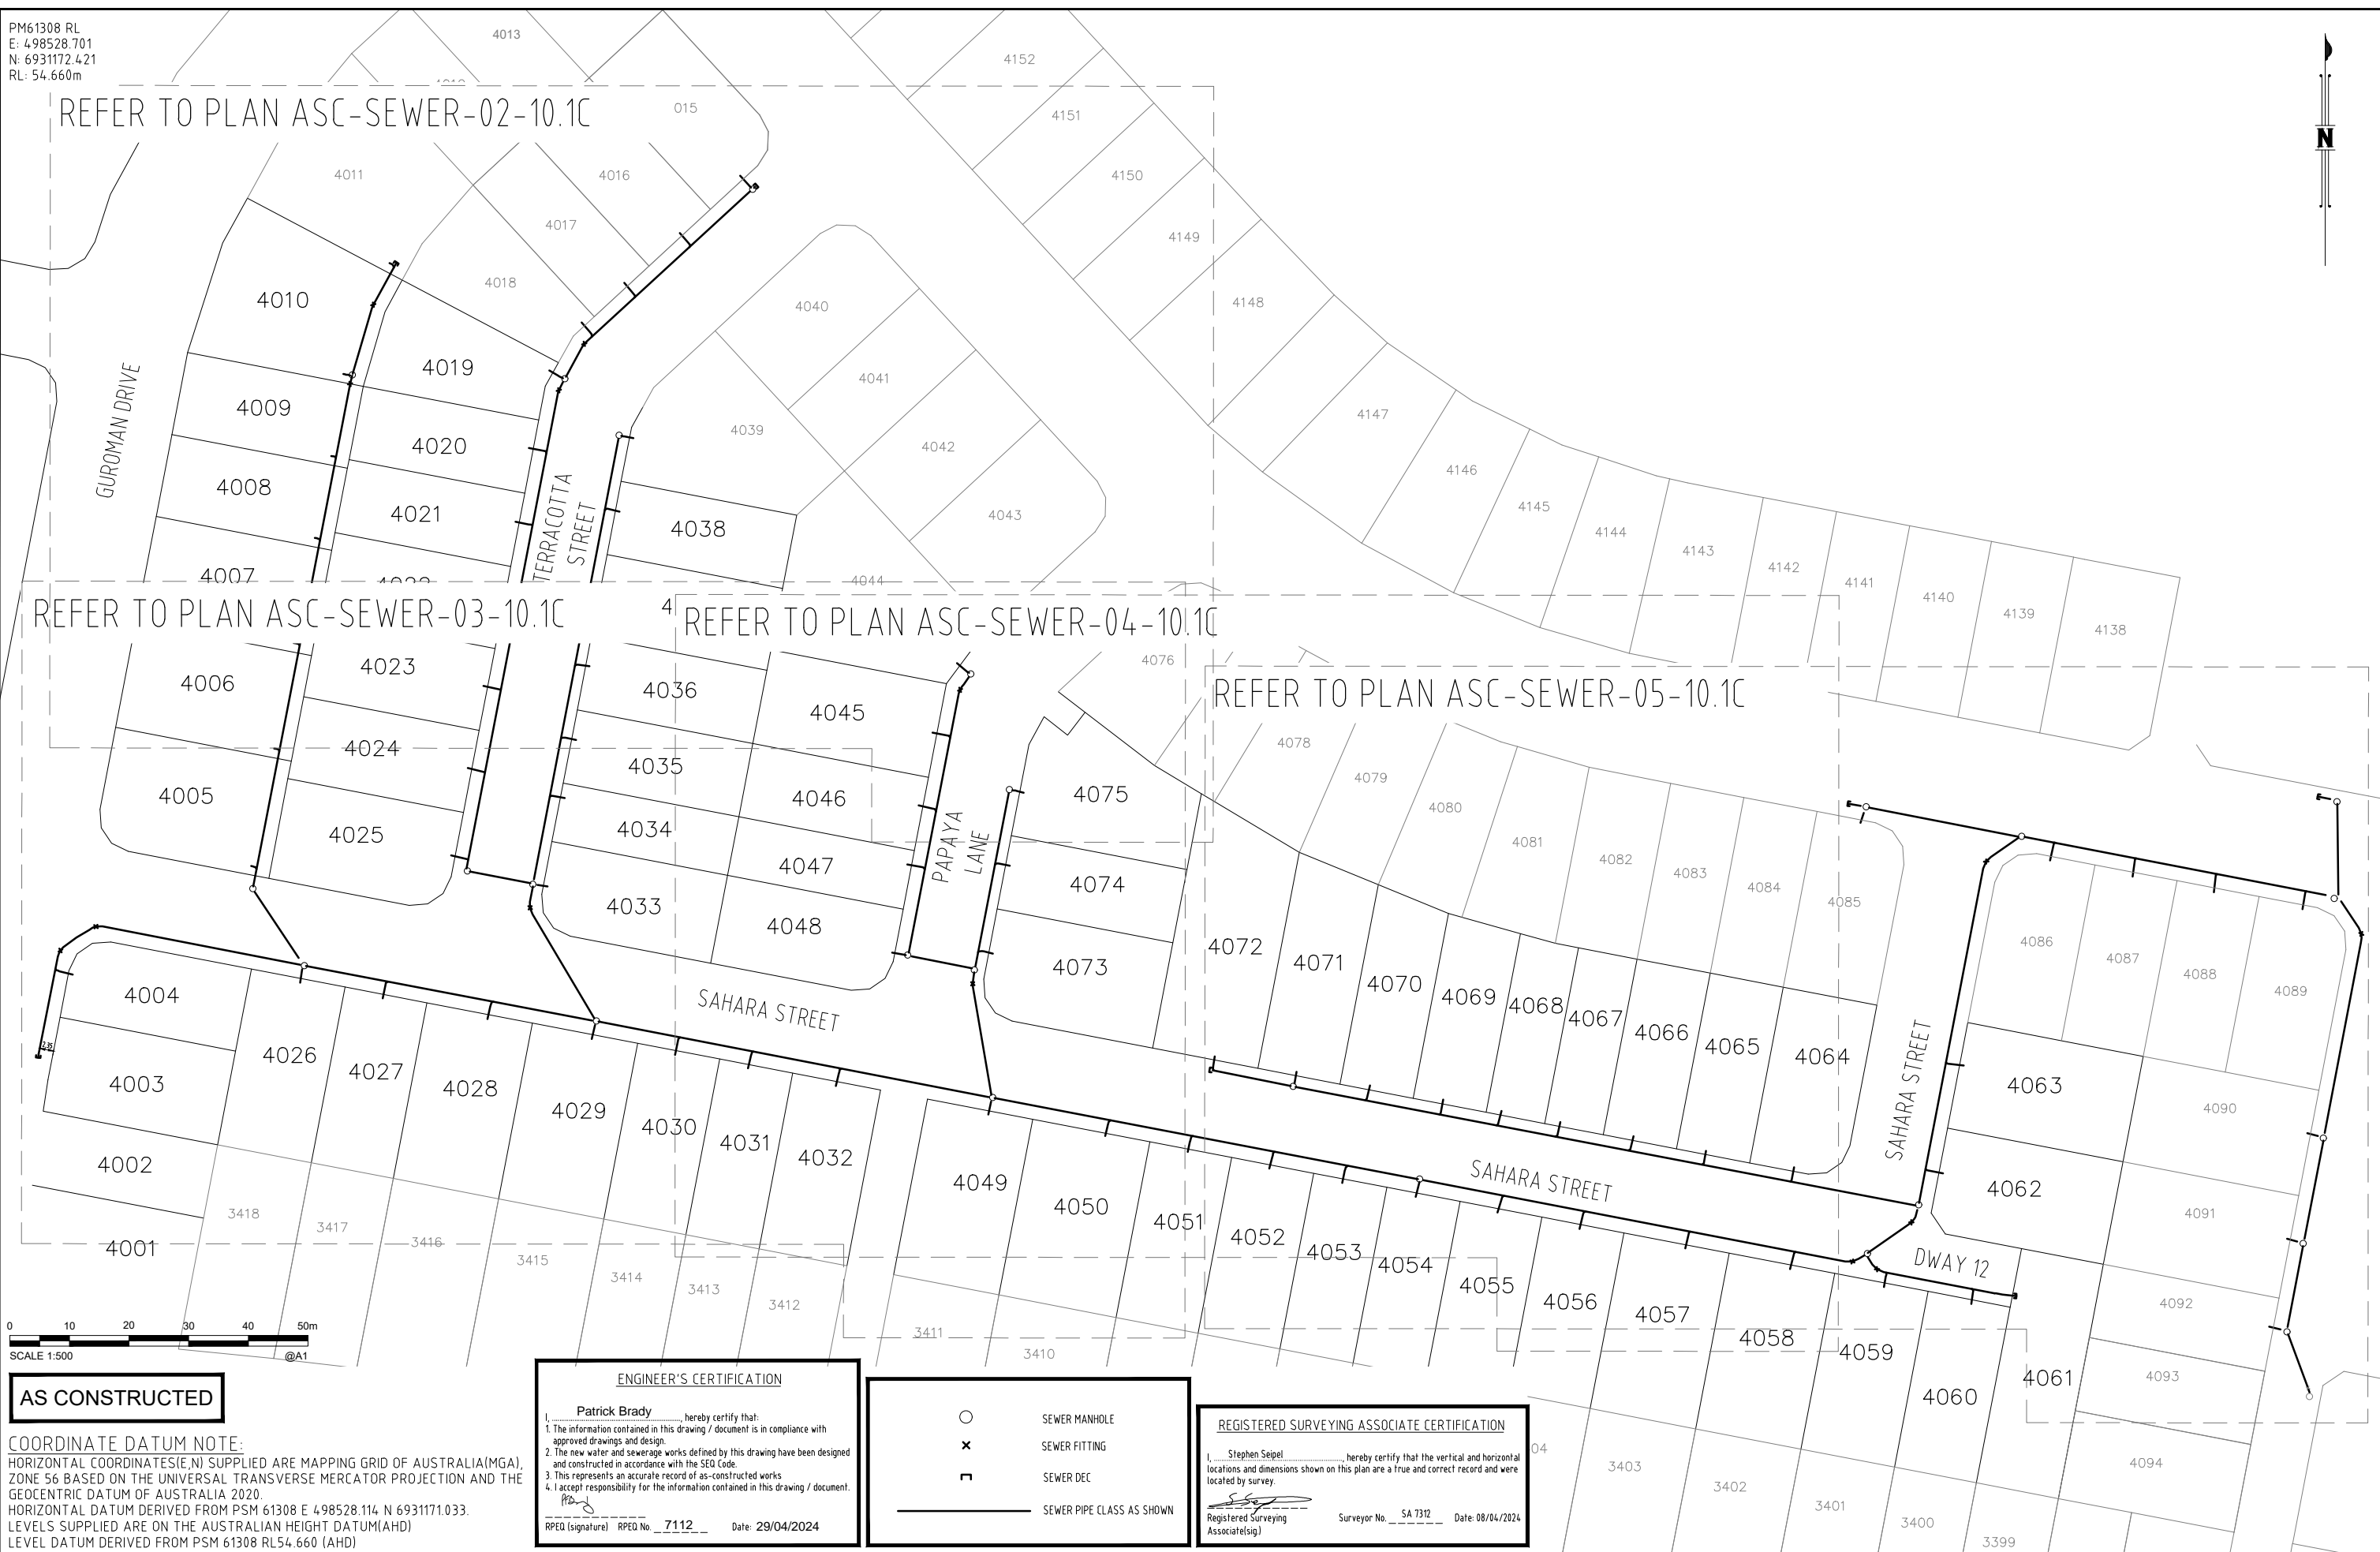

AS CONSTRUCTED

COORDINATE DATUM NOTE:
 HORIZONTAL COORDINATES(E,N) SUPPLIED ARE MAPPING GRID OF AUSTRALIA(MGA), ZONE 56 BASED ON THE UNIVERSAL TRANSVERSE MERCATOR PROJECTION AND THE GEOCENTRIC DATUM OF AUSTRALIA 2020.
 HORIZONTAL DATUM DERIVED FROM PSM 61308 E 498528.114 N 6931171.033.
 LEVELS SUPPLIED ARE ON THE AUSTRALIAN HEIGHT DATUM(AHD)
 LEVEL DATUM DERIVED FROM PSM 61308 RL54.660 (AHD)

ENGINEER'S CERTIFICATION
 Patrick Brady hereby certify that:
 1. The information contained in this drawing / document is in compliance with approved drawings and design.
 2. The new water and sewerage works defined by this drawing have been designed and constructed in accordance with the SEQ Code.
 3. This represents an accurate record of as-constructed works.
 4. I accept responsibility for the information contained in this drawing / document.
 RPED (signature) RPED No. 7112 Date: 29/04/2024

○ SEWER MANHOLE
 x SEWER FITTING
 □ SEWER DEC
 — SEWER PIPE CLASS AS SHOWN

REGISTERED SURVEYING ASSOCIATE CERTIFICATION
 Stephen Seipel hereby certify that the vertical and horizontal locations and dimensions shown on this plan are a true and correct record and were located by survey.
 Registered Surveying Associate(sig) Surveyor No. SA 7312 Date: 08/04/2024

A1	INDEX	DATE	AS CONSTRUCTED	REVISIONS	DRAWN	CHECKED	PASSED

DRAWN	RDE	7/12/2023
CHECKED	DAM	7/12/2023
PASSED		
INITIALS	DATE	



LOGAN CITY COUNCIL
 MIRVAC MIR-1001
 AS CONSTRUCTED SURVEY - SEWER
 EVERLEIGH PRECINCT 10.1C
 GREENBANK QLD

SHEET 1 OF 5 SHEETS	SCALE 1500 A1
REVISION DATE 7/12/2023	REVISION -
DISCIPLINE CODE -	
DRAWING NO. ASC-SEWER-01-10.1C	

PM61308 RL
 E: 498528.701
 N: 6931172.421
 RL: 54.660m




GUROMAN DRIVE

TERRACOTTA STREET

TERRACOTTA STREET

PAPAYA LANE

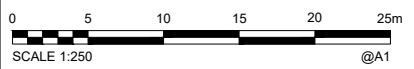

AS CONSTRUCTED

COORDINATE DATUM NOTE:
 HORIZONTAL COORDINATES(E,N) SUPPLIED ARE MAPPING GRID OF AUSTRALIA(MGA), ZONE 56 BASED ON THE UNIVERSAL TRANSVERSE MERCATOR PROJECTION AND THE GEOCENTRIC DATUM OF AUSTRALIA 2020.
 HORIZONTAL DATUM DERIVED FROM PSM 61308 E 498528.114 N 6931171.033.
 LEVELS SUPPLIED ARE ON THE AUSTRALIAN HEIGHT DATUM(AHD)
 LEVEL DATUM DERIVED FROM PSM 61308 RL54.660 (AHD)

ENGINEER'S CERTIFICATION
 Patrick Brady, hereby certify that:
 1. The information contained in this drawing / document is in compliance with approved drawings and design.
 2. The new water and sewerage works defined by this drawing have been designed and constructed in accordance with the SEQ Code.
 3. This represents an accurate record of as-constructed works.
 4. I accept responsibility for the information contained in this drawing / document.
 RPEQ (signature) RPEQ No. 7112 Date: 29/04/2024

○ SEWER MANHOLE
 x SEWER FITTING
 ┌ SEWER DEC
 — SEWER PIPE CLASS AS SHOWN


REGISTERED SURVEYING ASSOCIATE CERTIFICATION
 Stephen Seipel, hereby certify that the vertical and horizontal locations and dimensions shown on this plan are a true and correct record and were located by survey.
 Registered Surveying Associate (sig) Surveyor No. SA 7312 Date: 08/04/2024

A1	INDEX	DATE	AS CONSTRUCTED	DRAWN	CHECKED	PASSED	DRAWN	CHECKED	PASSED	INITIALS	DATE





LOGAN CITY COUNCIL
 MIRVAC MIR-1001
 AS CONSTRUCTED SURVEY - SEWER
 EVERLEIGH PRECINCT 10.1C
 GREENBANK QLD

SHEET 2 OF 5	SHEETS	SCALE 1:250 A1
REVISION DATE	REVISION	
DISCIPLINE CODE		
DRAWING NO.		
ASC-SEWER-02-10.1C		

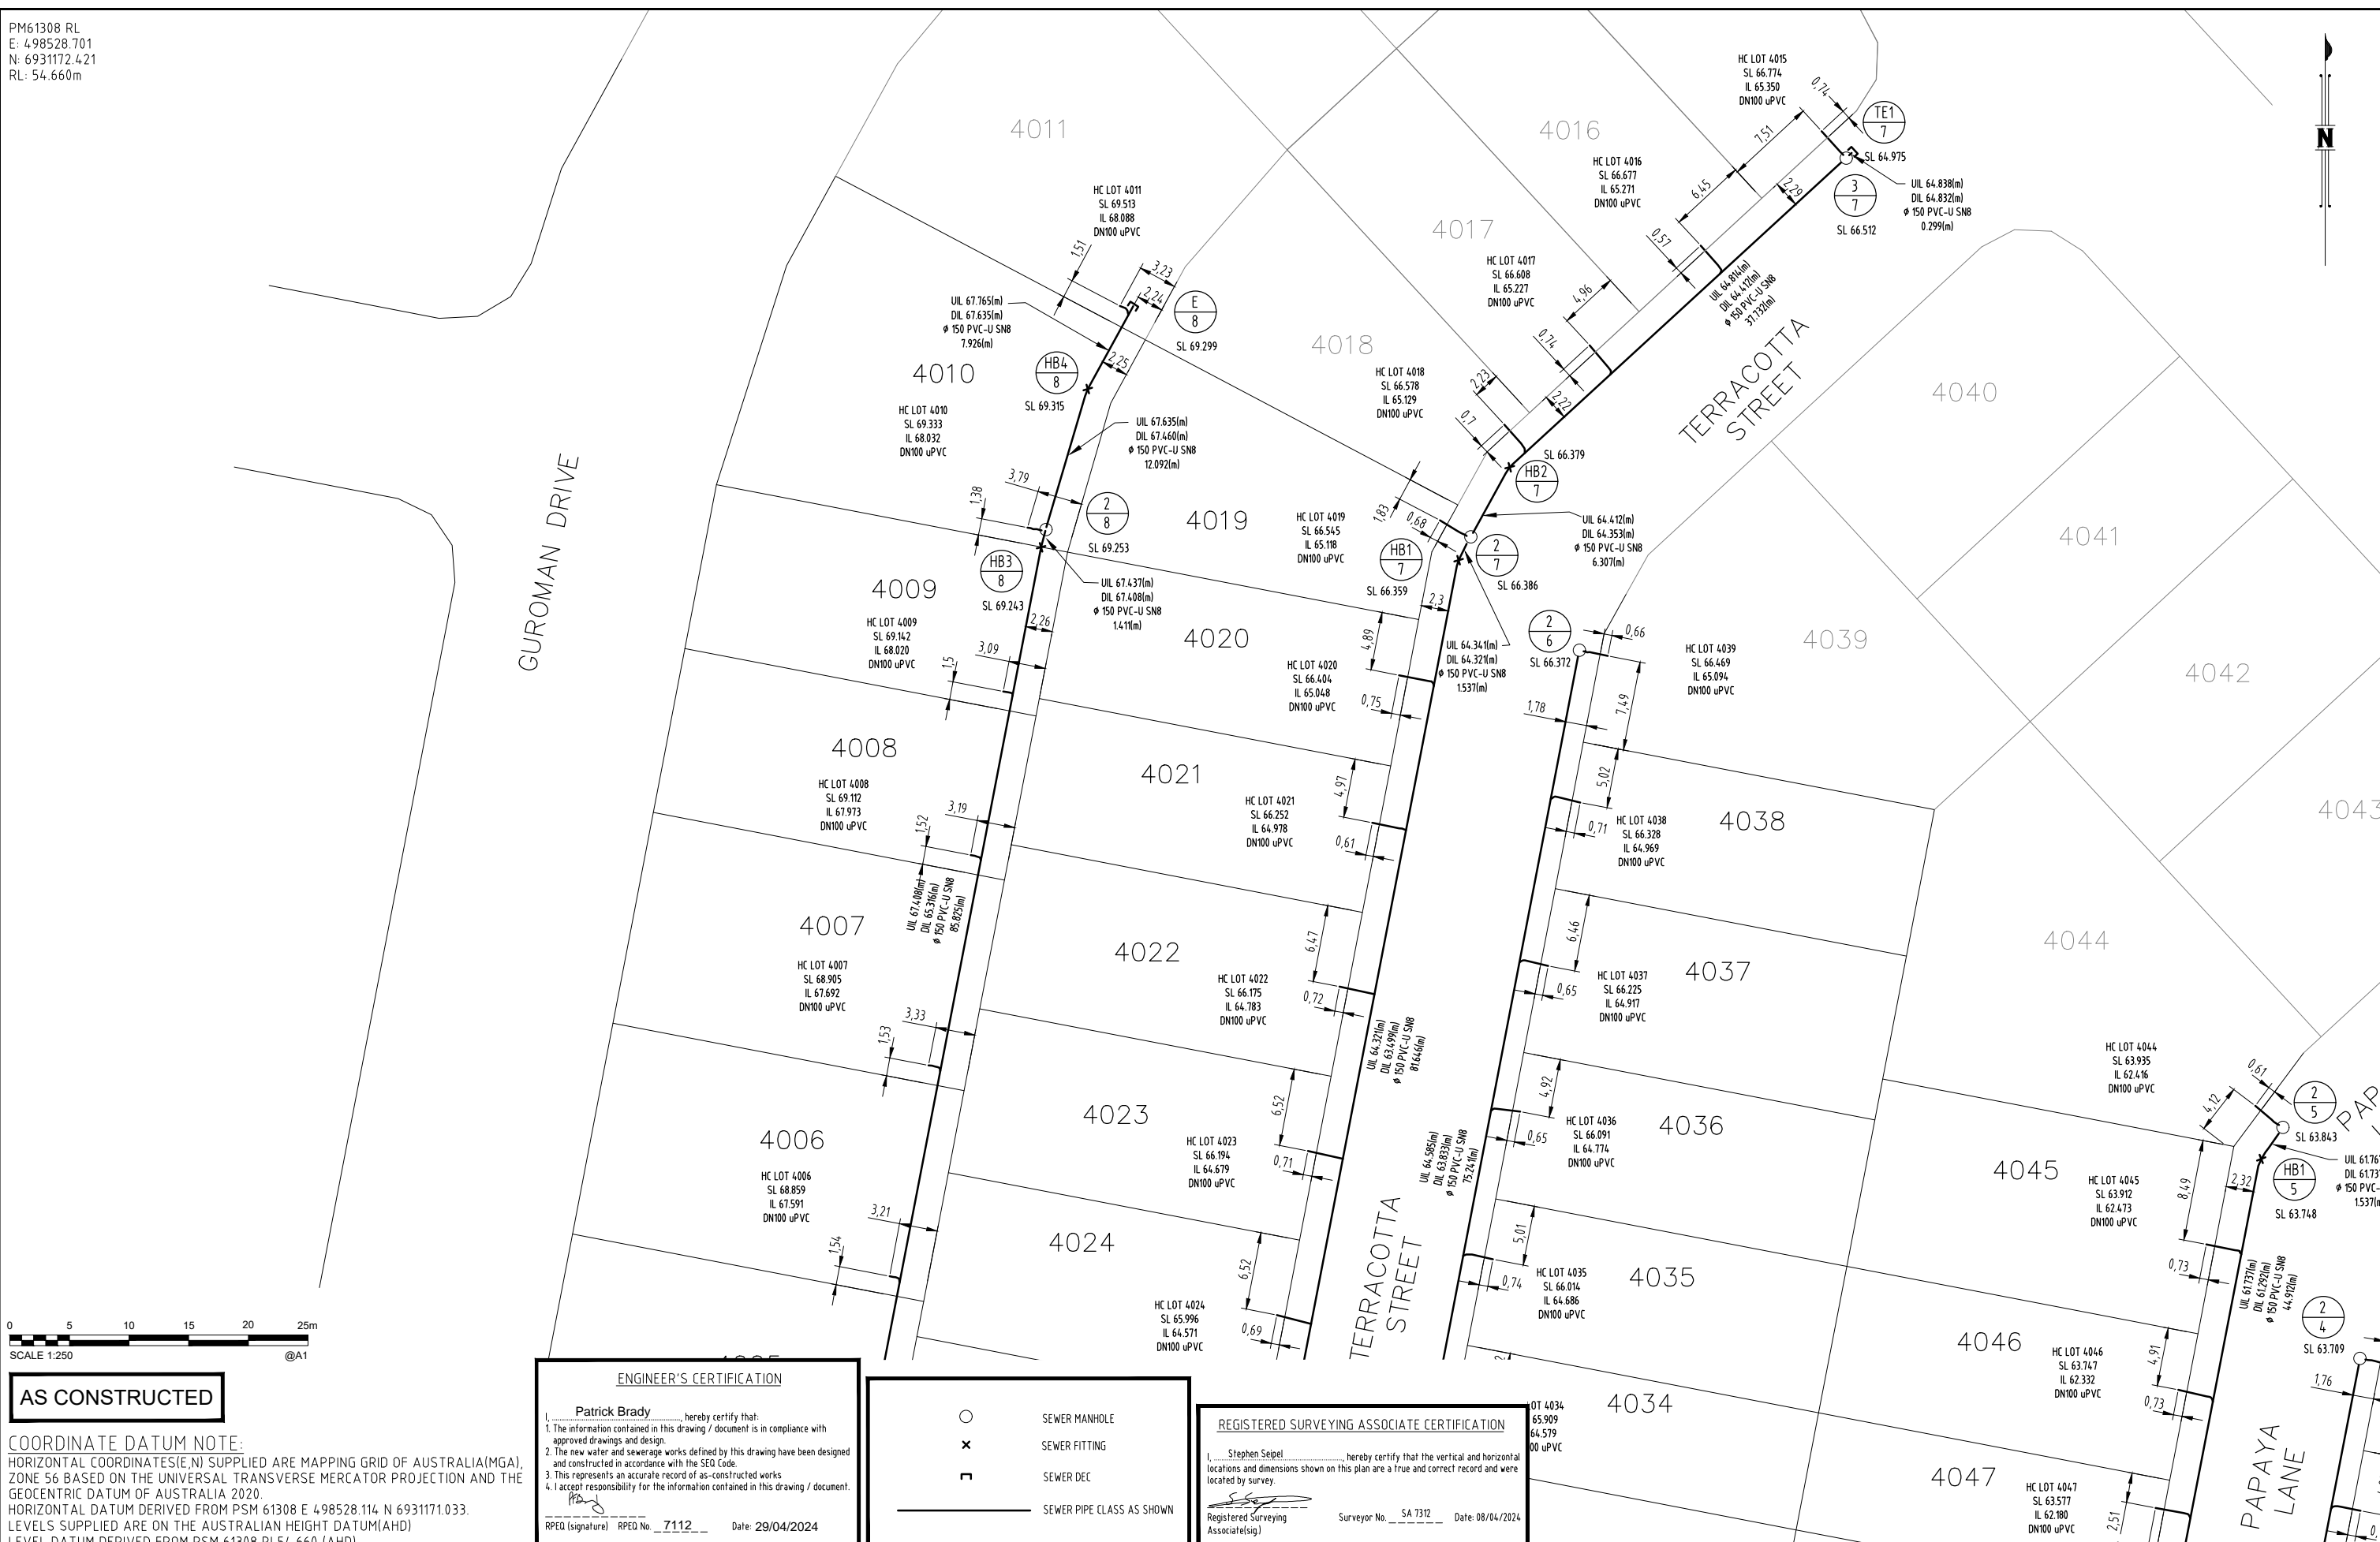


PM61308 RL
 E: 498528.701
 N: 6931172.421
 RL: 54.660m

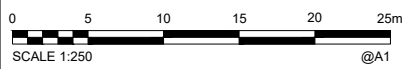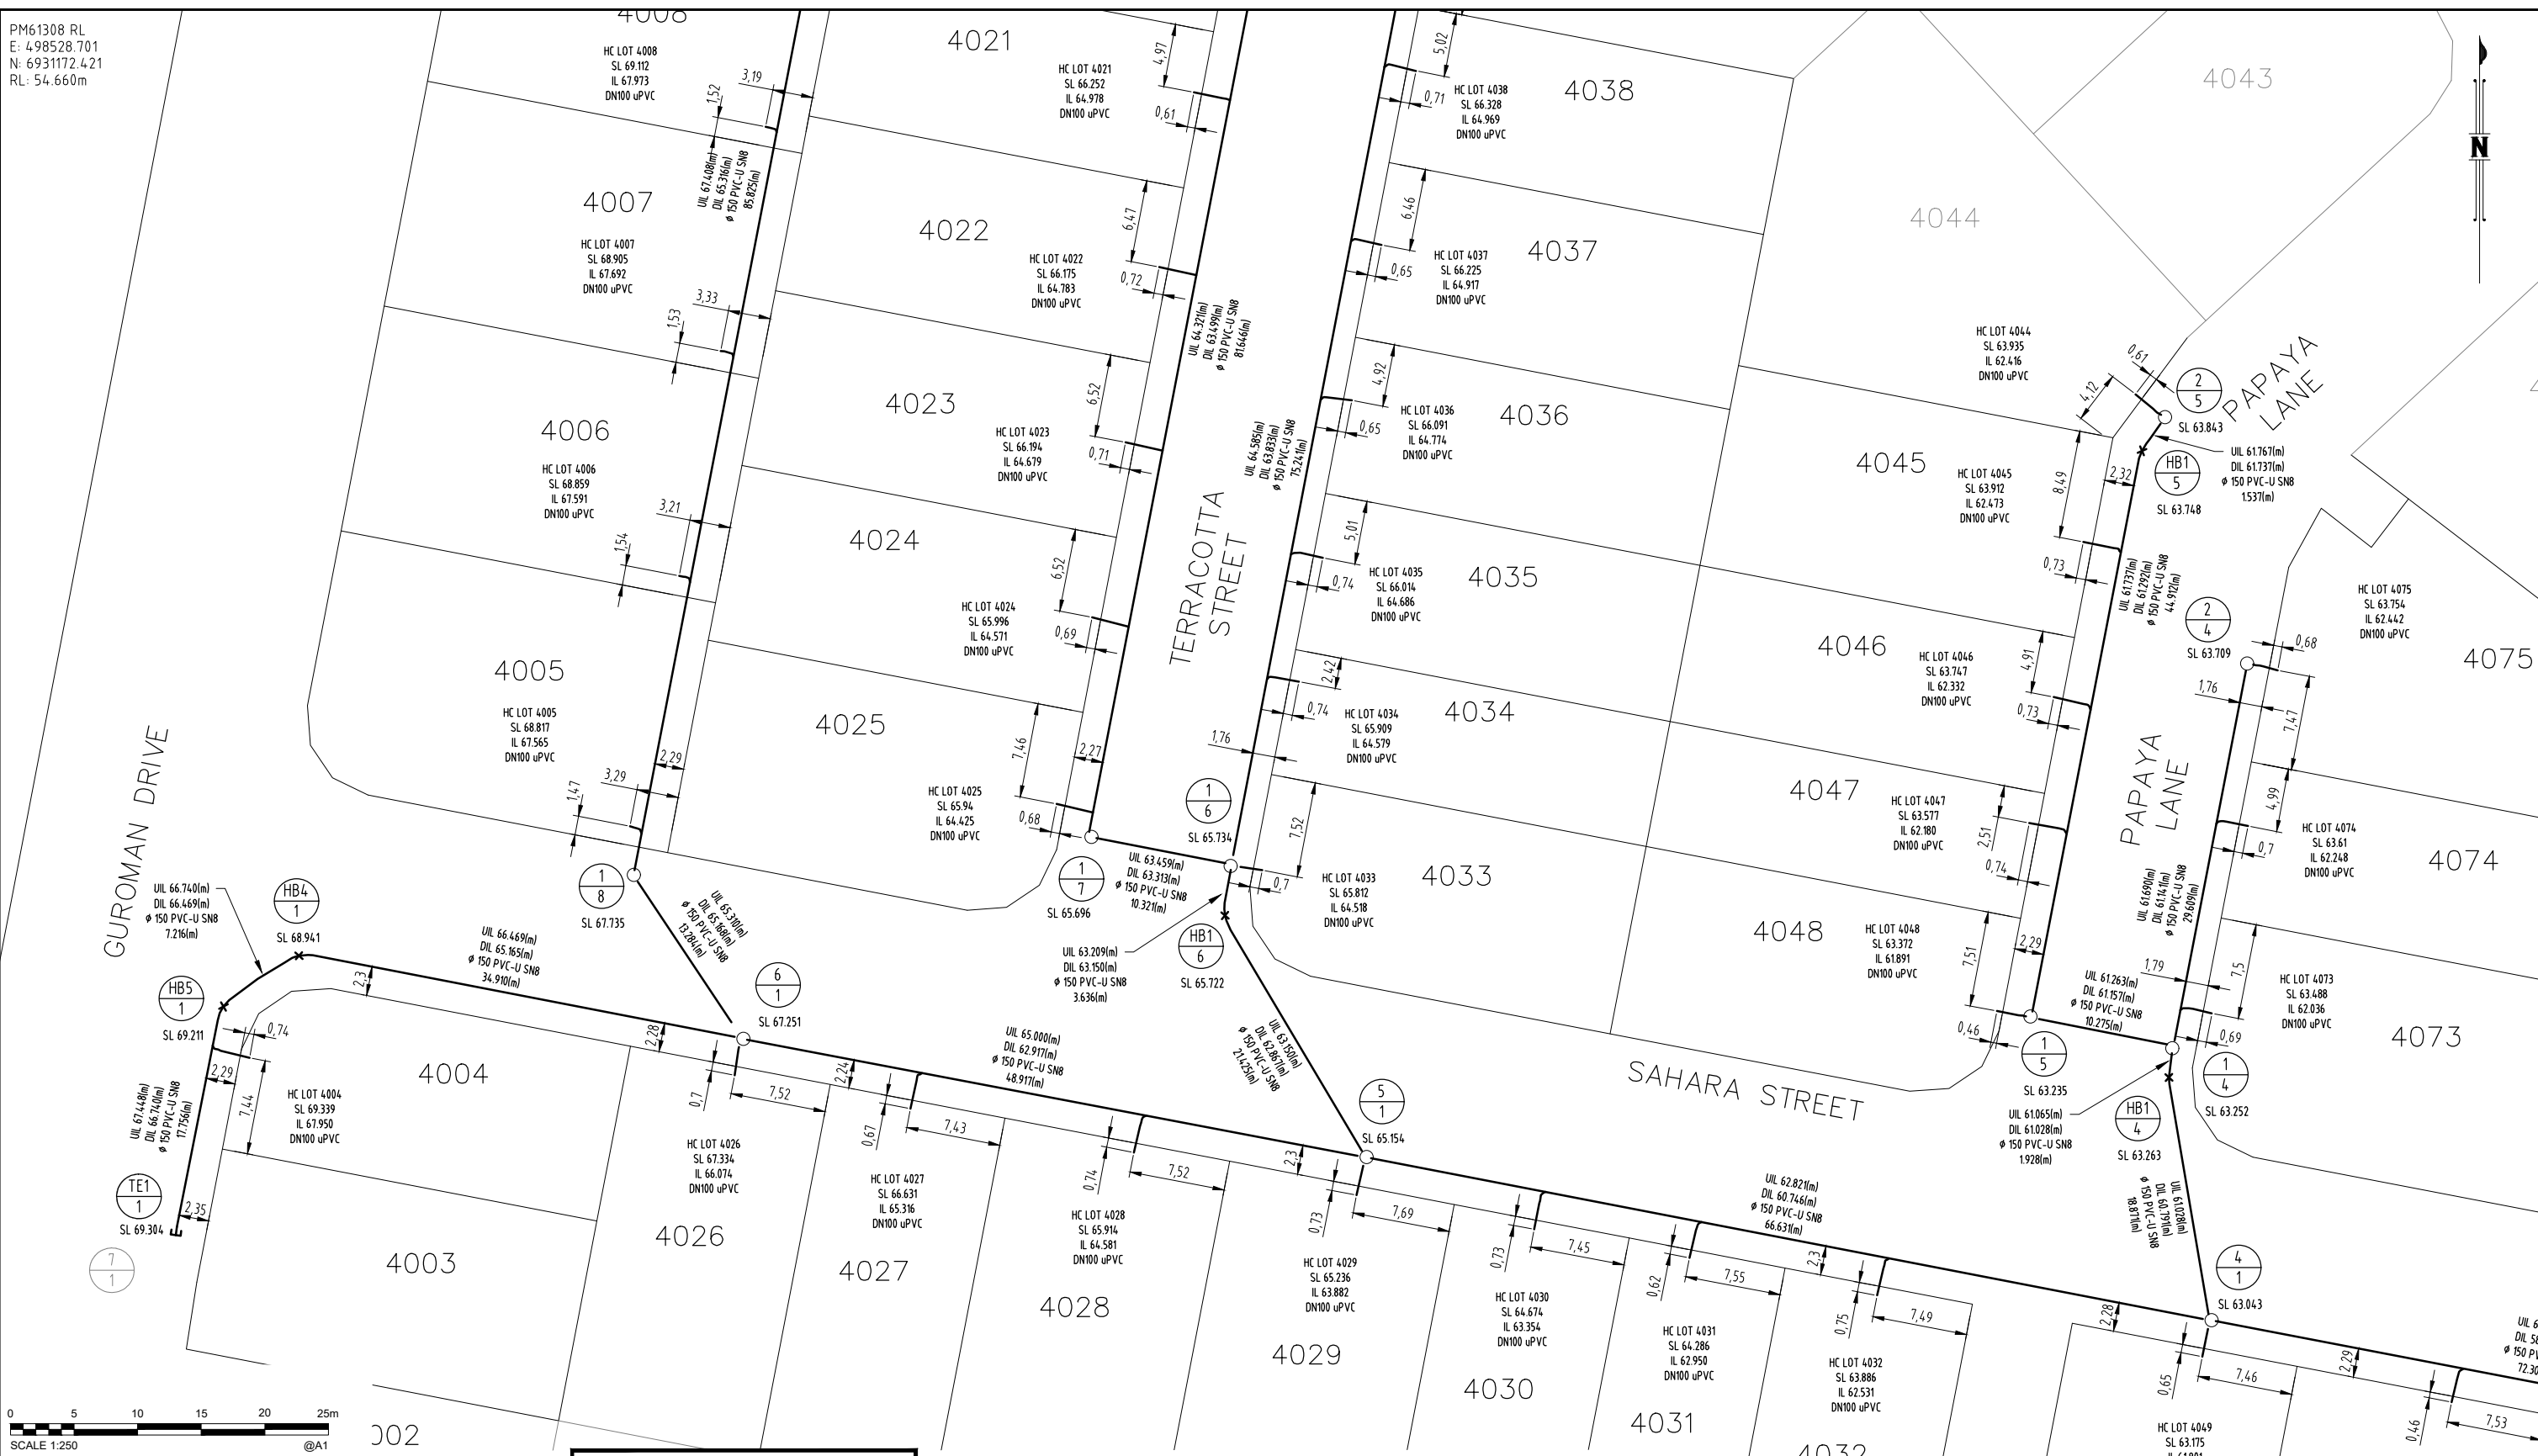

AS CONSTRUCTED

COORDINATE DATUM NOTE:
 HORIZONTAL COORDINATES(E,N) SUPPLIED ARE MAPPING GRID OF AUSTRALIA(MGA), ZONE 56 BASED ON THE UNIVERSAL TRANSVERSE MERCATOR PROJECTION AND THE GEOCENTRIC DATUM OF AUSTRALIA 2020.
 HORIZONTAL DATUM DERIVED FROM PSM 61308 E 498528.114 N 6931171.033.
 LEVELS SUPPLIED ARE ON THE AUSTRALIAN HEIGHT DATUM(AHD)
 LEVEL DATUM DERIVED FROM PSM 61308 RL54.660 (AHD)

ENGINEER'S CERTIFICATION
 Patrick Brady, hereby certify that:
 1. The information contained in this drawing / document is in compliance with approved drawings and design.
 2. The new water and sewerage works defined by this drawing have been designed and constructed in accordance with the SEQ Code.
 3. This represents an accurate record of as-constructed works.
 4. I accept responsibility for the information contained in this drawing / document.
 RPED (signature) RPED No. 7112 Date: 29/04/2024

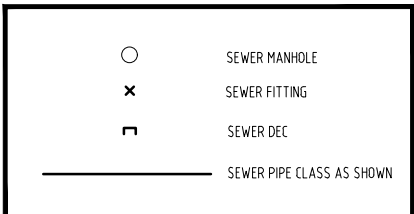



REGISTERED SURVEYING ASSOCIATE CERTIFICATION
 Stephen Seipel, hereby certify that the vertical and horizontal locations and dimensions shown on this plan are a true and correct record and were located by survey.
 Registered Surveying Associate (sig) Surveyor No. SA 7312 Date: 08/04/2024

A1	INDEX	DATE	AS CONSTRUCTED	DRAWN	CHECKED	PASSED	DRAWN	CHECKED	PASSED	INITIALS	DATE



LOGAN CITY COUNCIL
 MIRVAC MIR-1001
 AS CONSTRUCTED SURVEY - SEWER
 EVERLEIGH PRECINCT 10.1C
 GREENBANK QLD

SHEET 3 OF 5 SHEETS	SCALE 1:250 A1
REVISION DATE	REVISION
DISCIPLINE CODE	
DRAWING NO.	ASC-SEWER-03-10.1C

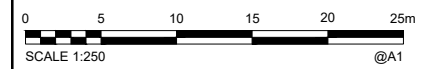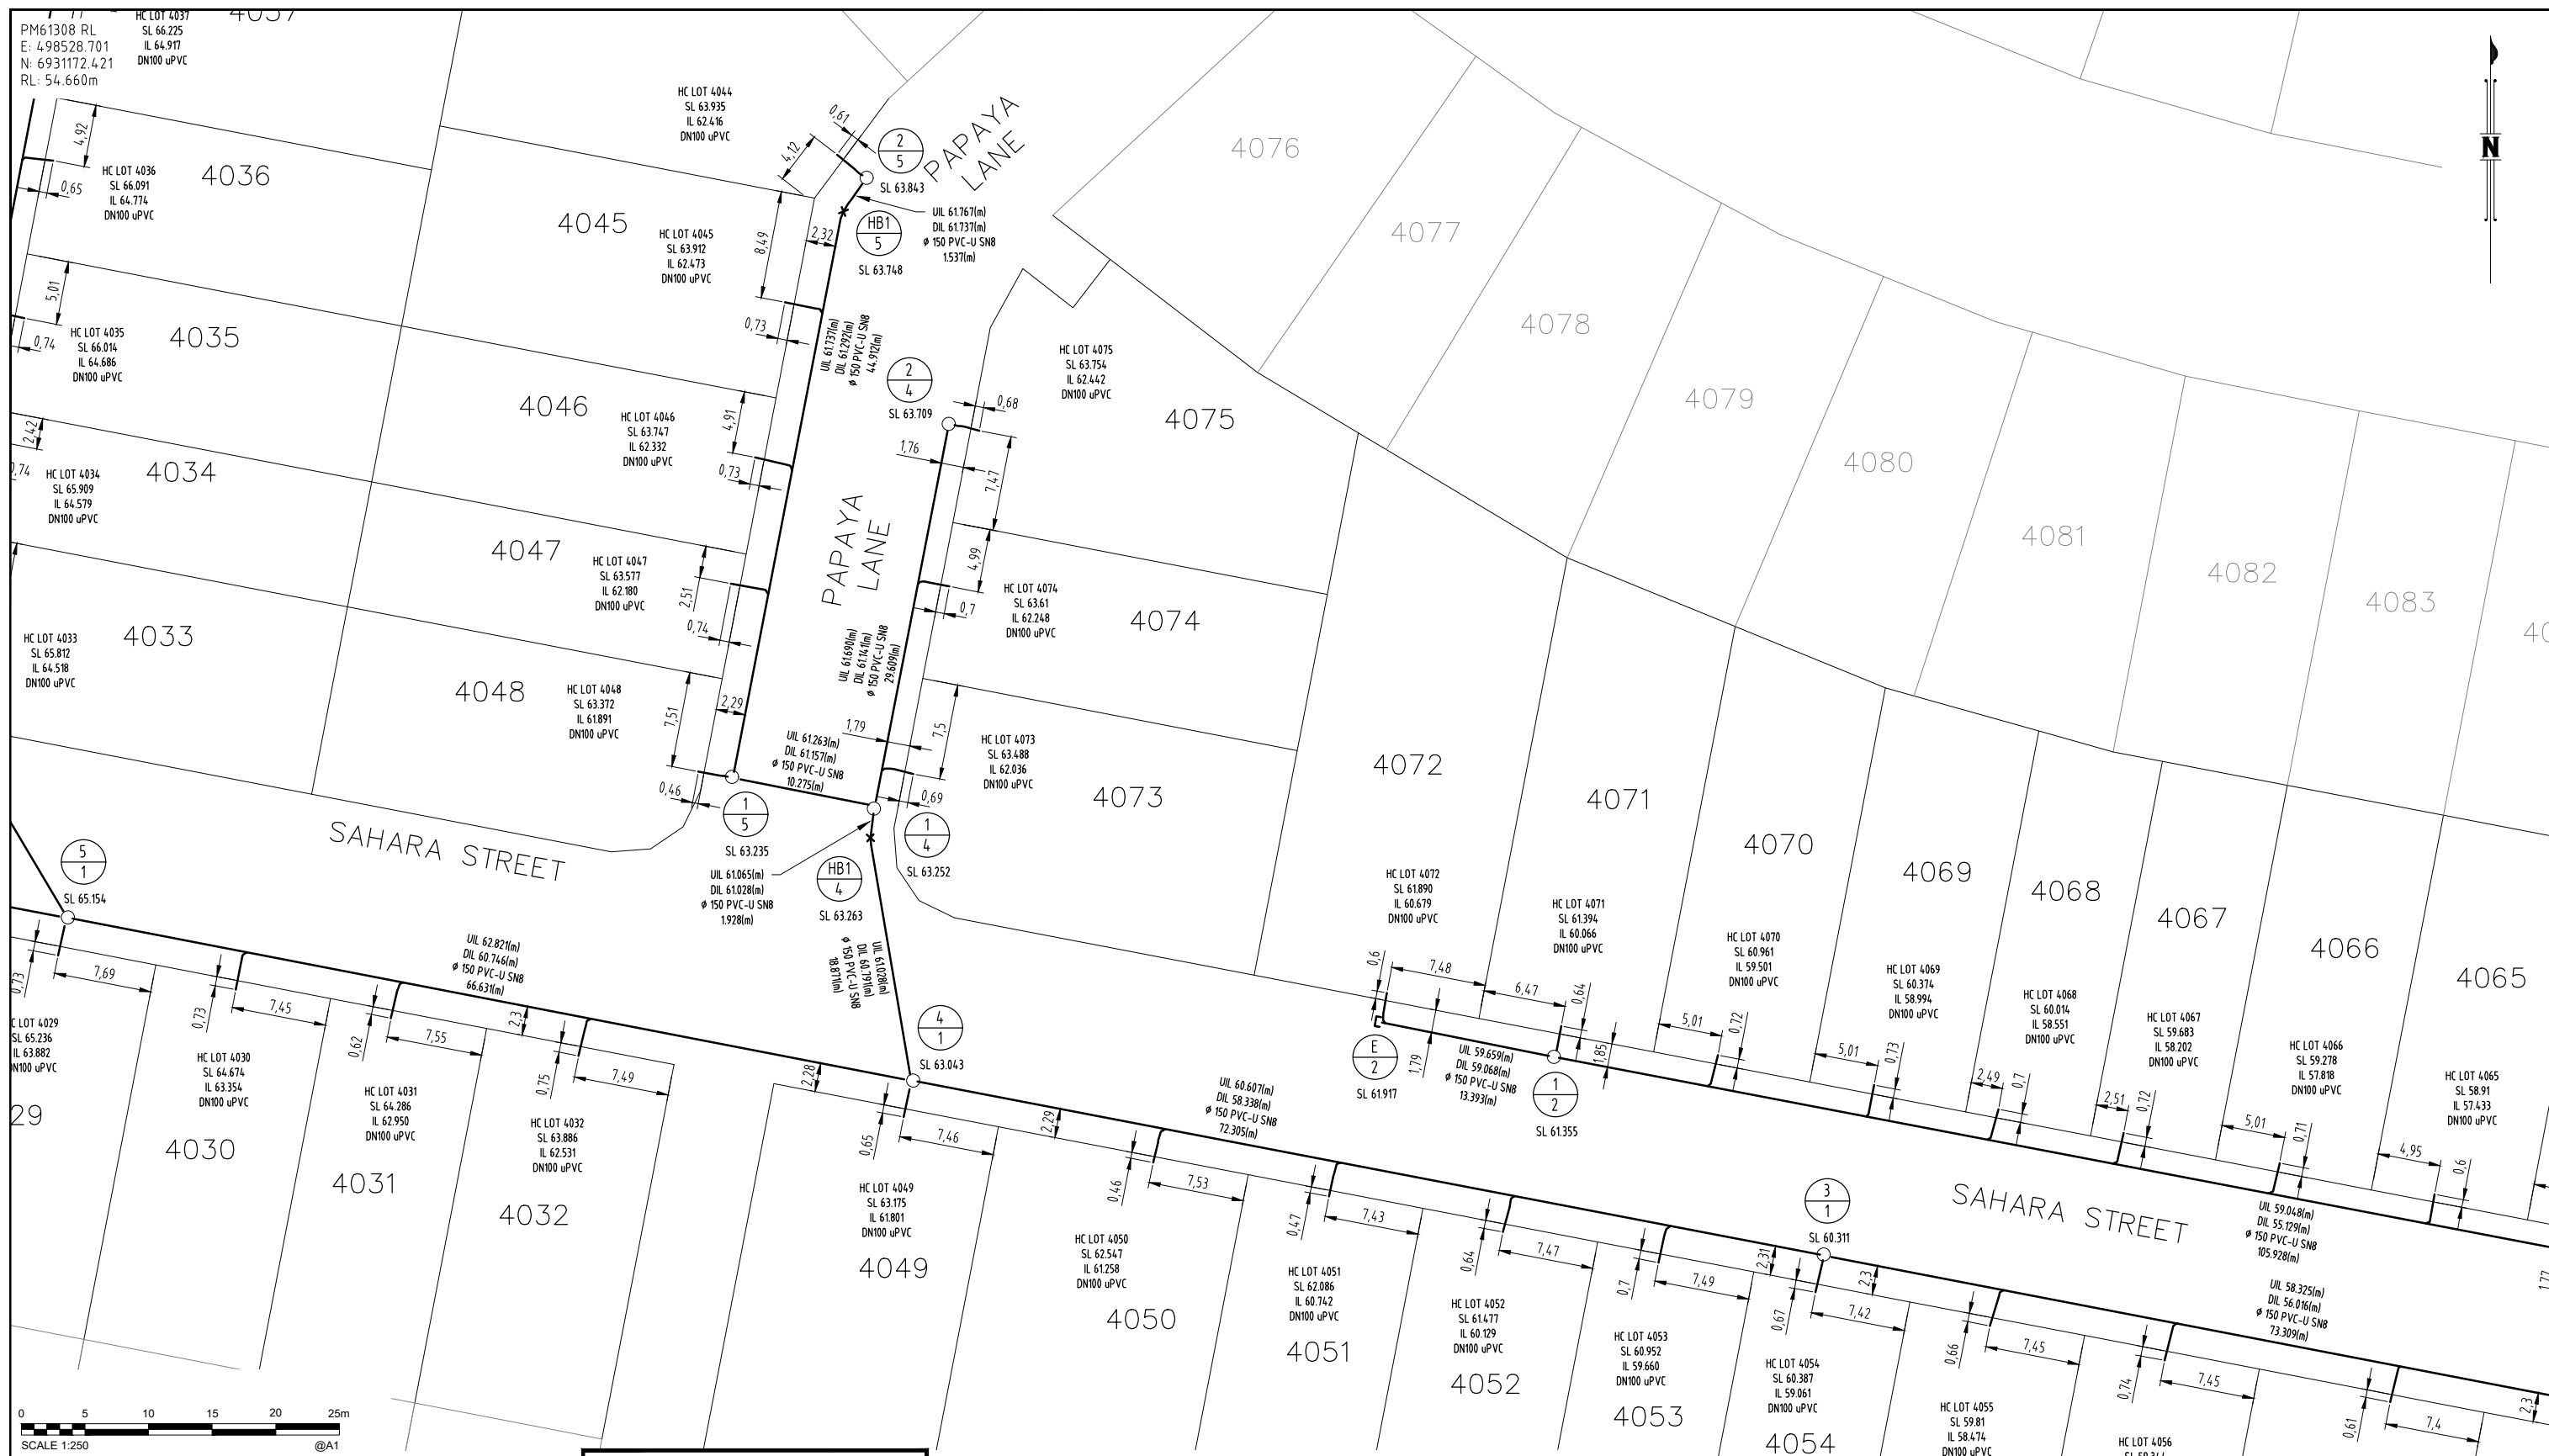

AS CONSTRUCTED

COORDINATE DATUM NOTE:
 HORIZONTAL COORDINATES(E,N) SUPPLIED ARE MAPPING GRID OF AUSTRALIA(MGA), ZONE 56 BASED ON THE UNIVERSAL TRANSVERSE MERCATOR PROJECTION AND THE GEOCENTRIC DATUM OF AUSTRALIA 2020.
 HORIZONTAL DATUM DERIVED FROM PSM 61308 E 4 98528.114 N 6931171.033.
 LEVELS SUPPLIED ARE ON THE AUSTRALIAN HEIGHT DATUM(AHD)
 LEVEL DATUM DERIVED FROM PSM 61308 RL54.660 (AHD)

ENGINEER'S CERTIFICATION
 Patrick Brady, hereby certify that:
 1. The information contained in this drawing / document is in compliance with approved drawings and design.
 2. The new water and sewerage works defined by this drawing have been designed and constructed in accordance with the SEQ Code.
 3. This represents an accurate record of as-constructed works.
 4. I accept responsibility for the information contained in this drawing / document.
 RPEO (signature) RPEO No. 7112 Date: 29/04/2024

- SEWER MANHOLE
- x SEWER FITTING
- D SEWER DEC
- SEWER PIPE CLASS AS SHOWN

REGISTERED SURVEYING ASSOCIATE CERTIFICATION
 Stephen Seipel, hereby certify that the vertical and horizontal locations and dimensions shown on this plan are a true and correct record and were located by survey.
 Registered Surveying Associate (sig) Surveyor No. SA 7312 Date: 08/04/2024

A1	INDEX	DATE	AS CONSTRUCTED	DRAWN	CHECKED	PASSED
				DRAWN	CHECKED	PASSED
				INITIALS	DATE	



LOGAN CITY COUNCIL
 MIRVAC MIR-1001
 AS CONSTRUCTED SURVEY - SEWER
 EVERLEIGH PRECINCT 10.1C
 GREENBANK QLD

SHEET 4 OF 5 SHEETS	SCALE 1:250 A1
REVISION DATE	REVISION
DISCIPLINE CODE	
DRAWING NO.	
ASC-SEWER-04-10.1C	



AS CONSTRUCTED

COORDINATE DATUM NOTE:
 HORIZONTAL COORDINATES(E,N) SUPPLIED ARE MAPPING GRID OF AUSTRALIA(MGA), ZONE 56 BASED ON THE UNIVERSAL TRANSVERSE MERCATOR PROJECTION AND THE GEOCENTRIC DATUM OF AUSTRALIA 2020.
 HORIZONTAL DATUM DERIVED FROM PSM 61308 E 4 98528.114 N 6931171.033.
 LEVELS SUPPLIED ARE ON THE AUSTRALIAN HEIGHT DATUM(AHD)
 LEVEL DATUM DERIVED FROM PSM 61308 RL54.660 (AHD)

ENGINEER'S CERTIFICATION
 Patrick Brady, hereby certify that:
 1. The information contained in this drawing / document is in compliance with approved drawings and design.
 2. The new water and sewerage works defined by this drawing have been designed and constructed in accordance with the SEQ Code.
 3. This represents an accurate record of as-constructed works.
 4. I accept responsibility for the information contained in this drawing / document.
 RPEQ (signature) RPEQ No. 7112 Date: 29/04/2024

- SEWER MANHOLE
- × SEWER FITTING
- ┌ SEWER DEC
- SEWER PIPE CLASS AS SHOWN

REGISTERED SURVEYING ASSOCIATE CERTIFICATION
 Stephen Seipel, hereby certify that the vertical and horizontal locations and dimensions shown on this plan are a true and correct record and were located by survey.
 Registered Surveying Associate (sig) Surveyor No. SA 7312 Date: 08/04/2024

A1	INDEX	DATE	AS CONSTRUCTED	REVISIONS	DRAWN	CHECKED	PASSED	INITIALS	DATE



LOGAN CITY COUNCIL
 MIRVAC MIR-1001
 AS CONSTRUCTED SURVEY - SEWER
 EVERLEIGH PRECINCT 10.1C
 GREENBANK QLD

SHEET 5 OF 5 SHEETS	SCALE 1:250 A1
REVISION DATE	REVISION
DISCIPLINE CODE	
DRAWING NO.	ASC-SEWER-05-10.1C