

PM61308 RL
 E: 498528.701
 N: 6931172.421
 RL: 54.660m




REFER TO PLAN ASC-WATER-02-10.1C

REFER TO PLAN ASC-WATER-03-10.1C

REFER TO PLAN ASC-WATER-04-10.1C

PARK LOT 824

AS CONSTRUCTED

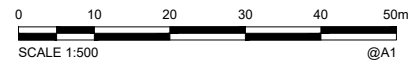

REGISTERED SURVEYING ASSOCIATE CERTIFICATION

I, Stephen Seipel, hereby certify that the vertical and horizontal locations and dimensions shown on this plan are a true and correct record and were located by survey.

Stephen Seipel
 Registered Surveying Associate (sig) Surveyor No. SA 7312 Date: 08/04/2024

COORDINATE DATUM NOTE:

HORIZONTAL COORDINATES(E,N) SUPPLIED ARE MAPPING GRID OF AUSTRALIA(MGA), ZONE 56 BASED ON THE UNIVERSAL TRANSVERSE MERCATOR PROJECTION AND THE GEOCENTRIC DATUM OF AUSTRALIA 2020.
 HORIZONTAL DATUM DERIVED FROM PSM 61308 E 498528.114 N 6931171.033.
 LEVELS SUPPLIED ARE ON THE AUSTRALIAN HEIGHT DATUM(AHD)
 LEVEL DATUM DERIVED FROM PSM 61308 RL54.660 (AHD)

| | |
|--|---|
| | WATER METER BOX |
| | WATER REDUCER |
| | WATER BEND |
| | WATER TAPING BAND |
| | WATER BALL VALVE/STOP VALVE |
| | WATER FIRE HYDRANT |
| | WATERMAIN LINE (SIZE AND CLASS AS SHOWN) |

ENGINEER'S CERTIFICATION

I, Patrick Brady, hereby certify that:

- The information contained in this drawing / document is in compliance with approved drawings and design.
- The new water and sewerage works defined by this drawing have been designed and constructed in accordance with the SEQ Code.
- This represents an accurate record of as-constructed works.
- I accept responsibility for the information contained in this drawing / document.

Patrick Brady
 RPEQ (signature) RPEQ No. 7112 Date: _____

| | | | | | | | |
|-----------|-------|------|----------------|-----------|-------|---------|--------|
| A1 | INDEX | DATE | AS CONSTRUCTED | REVISIONS | DRAWN | CHECKED | PASSED |
| | | | | | | | |

| | | |
|----------|------|------------|
| DRAWN | RDE | 08/04/2024 |
| CHECKED | DAM | 08/04/2024 |
| PASSED | | |
| INITIALS | DATE | |





LOGAN CITY COUNCIL

MIRVAC MIR-1001
 AS CONSTRUCTED SURVEY - WATERMAIN
 EVERLEIGH PRECINCT 10.1C
 GREENBANK QLD

| | |
|------------------------------------|---------------|
| SHEET 1 OF 4 SHEETS | SCALE 1500 A1 |
| REVISION DATE 08/04/2024 | REVISION - |
| DISCIPLINE CODE - | |
| DRAWING NO. ASC-WATERMAIN-01-10.1C | |

PM61308 RL
 E: 498528.701
 N: 6931172.421
 RL: 54.660m

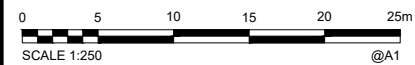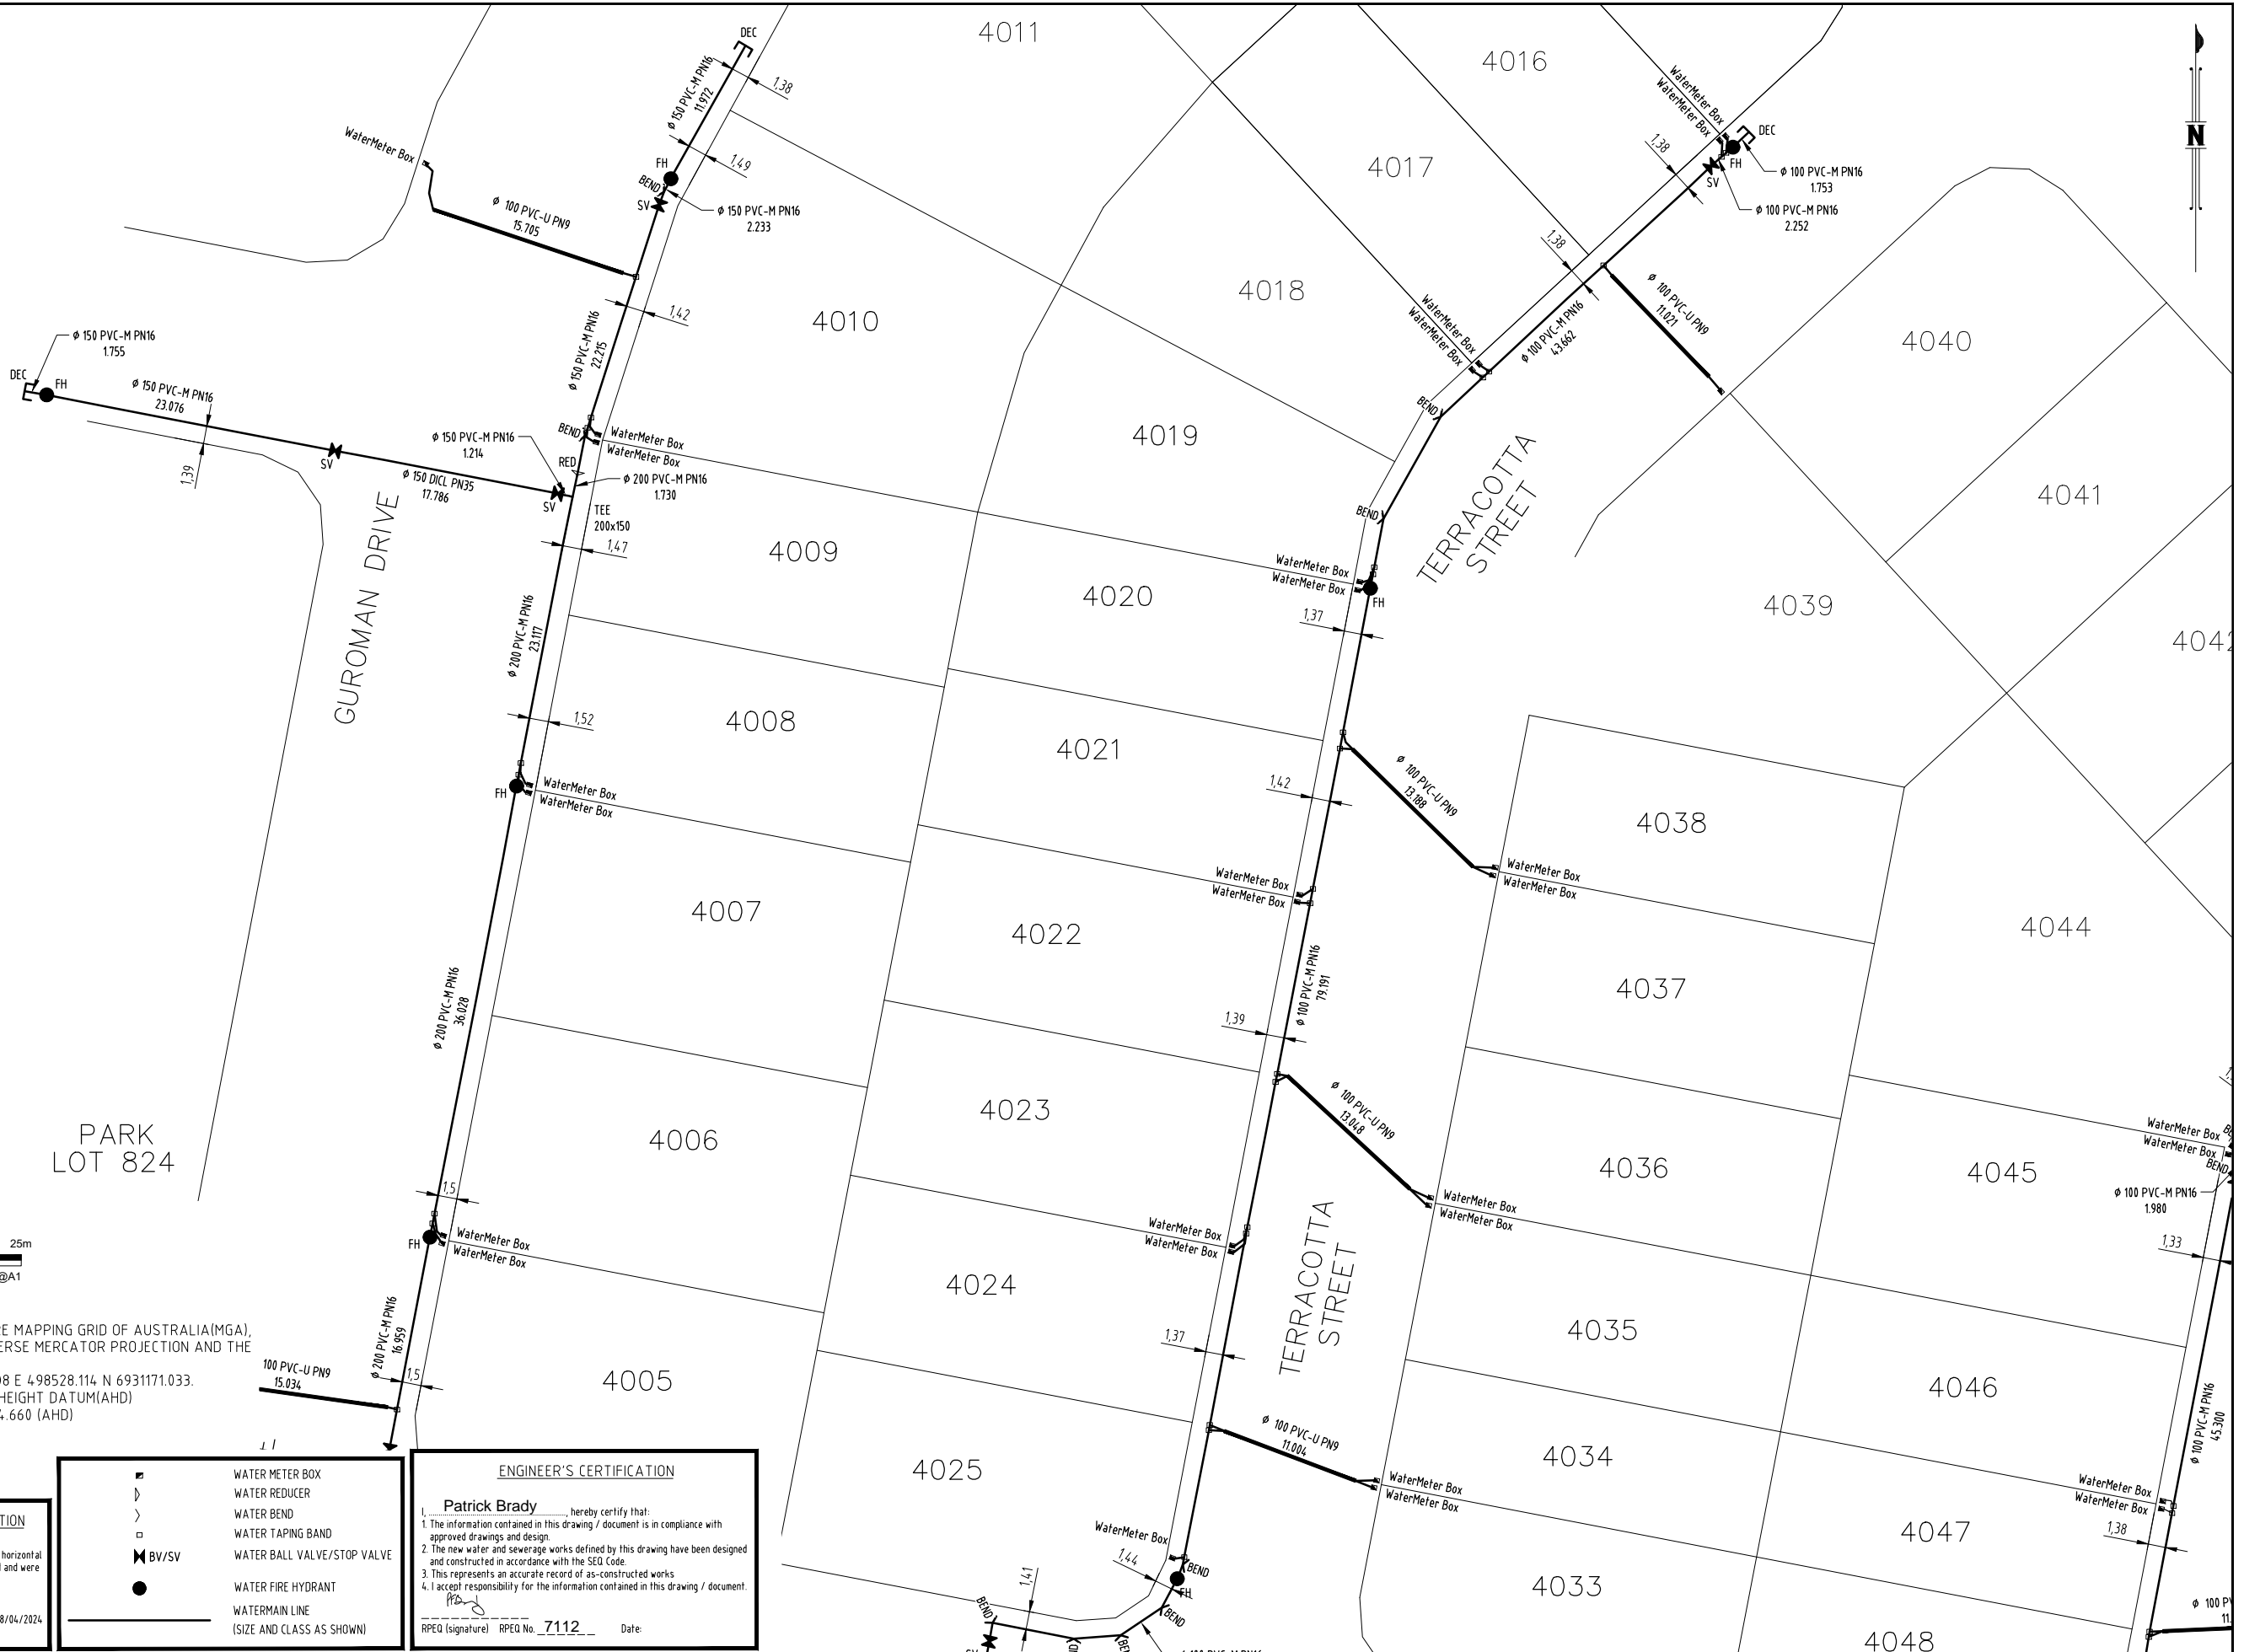

COORDINATE DATUM NOTE:
 HORIZONTAL COORDINATES(E,N) SUPPLIED ARE MAPPING GRID OF AUSTRALIA(MGA), ZONE 56 BASED ON THE UNIVERSAL TRANSVERSE MERCATOR PROJECTION AND THE GEOCENTRIC DATUM OF AUSTRALIA 2020.
 HORIZONTAL DATUM DERIVED FROM PSM 61308 E 498528.114 N 6931171.033.
 LEVELS SUPPLIED ARE ON THE AUSTRALIAN HEIGHT DATUM(AHD)
 LEVEL DATUM DERIVED FROM PSM 61308 RL54.660 (AHD)

AS CONSTRUCTED

REGISTERED SURVEYING ASSOCIATE CERTIFICATION

I, Stephen Seipel hereby certify that the vertical and horizontal locations and dimensions shown on this plan are a true and correct record and were located by survey.
 Registered Surveying Associate(sig) Surveyor No. SA 7312 Date: 08/04/2024

| | |
|---------|--|
| ■ | WATER METER BOX |
| ▸ | WATER REDUCER |
| > | WATER BEND |
| □ | WATER TAPING BAND |
| ⊕ BV/SV | WATER BALL VALVE/STOP VALVE |
| ● | WATER FIRE HYDRANT |
| — | WATERMAIN LINE (SIZE AND CLASS AS SHOWN) |

ENGINEER'S CERTIFICATION
 Patrick Brady hereby certify that:
 1. The information contained in this drawing / document is in compliance with approved drawings and design.
 2. The new water and sewerage works defined by this drawing have been designed and constructed in accordance with the SEQ Code.
 3. This represents an accurate record of as-constructed works
 4. I accept responsibility for the information contained in this drawing / document.
 RPEQ (signature) RPEQ No. 7112 Date:

| | | | | | | | | | | |
|----|-------|------|----------------|-----------|-------|---------|--------|-------|---------|--------|
| A1 | INDEX | DATE | AS CONSTRUCTED | REVISIONS | DRAWN | CHECKED | PASSED | DRAWN | CHECKED | PASSED |
| | | | | | | | | | | |





LOGAN CITY COUNCIL
 MIRVAC MIR-1001
 AS CONSTRUCTED SURVEY - WATERMAIN
 EVERLEIGH PRECINCT 10.1C
 GREENBANK QLD

| | |
|------------------------------------|----------------|
| SHEET 2 OF 4 SHEETS | SCALE 1:250 A1 |
| REVISION DATE 08/04/2024 | REVISION - |
| DISCIPLINE CODE - | |
| DRAWING NO. ASC-WATERMAIN-02-10.1C | |

PM61308 RL
 E: 4.98528.701
 N: 6931172.421
 RL: 54.660m

PARK
 LOT 824

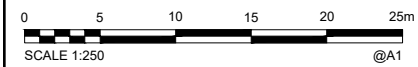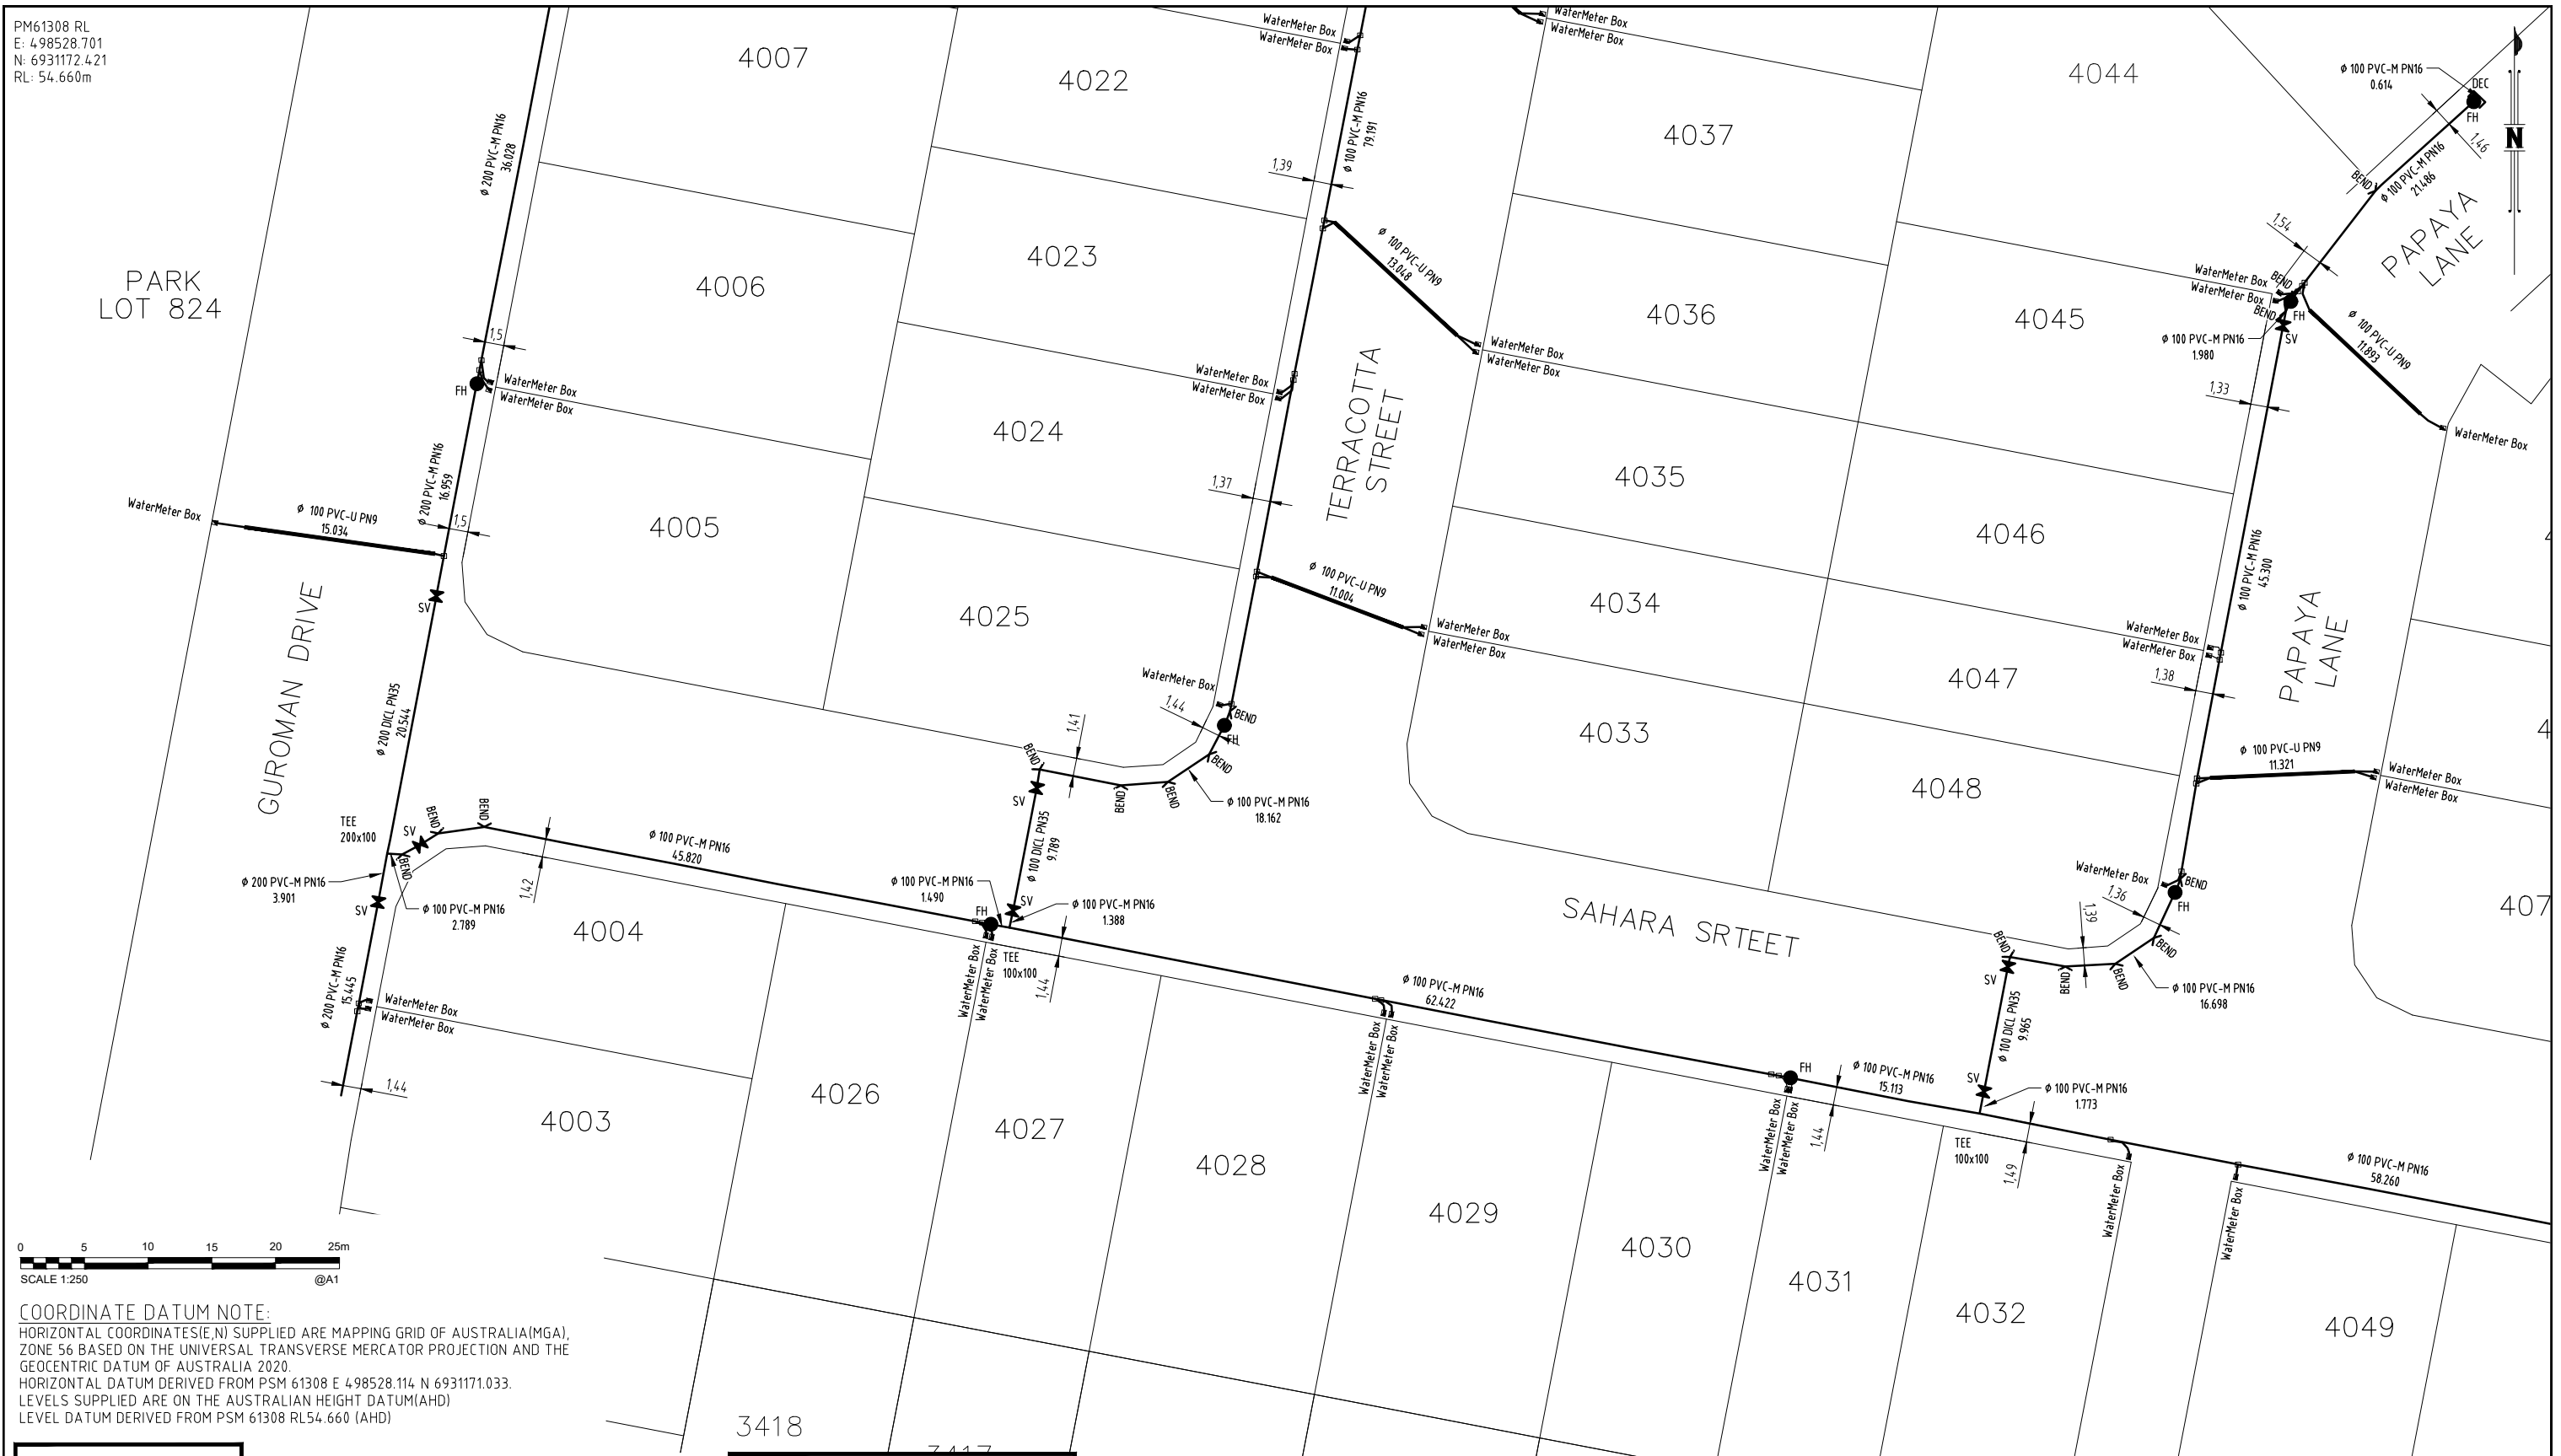

COORDINATE DATUM NOTE:
 HORIZONTAL COORDINATES(E,N) SUPPLIED ARE MAPPING GRID OF AUSTRALIA(MGA), ZONE 56 BASED ON THE UNIVERSAL TRANSVERSE MERCATOR PROJECTION AND THE GEOCENTRIC DATUM OF AUSTRALIA 2020.
 HORIZONTAL DATUM DERIVED FROM PSM 61308 E 4.98528.114 N 6931171.033.
 LEVELS SUPPLIED ARE ON THE AUSTRALIAN HEIGHT DATUM(AHD)
 LEVEL DATUM DERIVED FROM PSM 61308 RL54.660 (AHD)

AS CONSTRUCTED

REGISTERED SURVEYING ASSOCIATE CERTIFICATION

I, Stephen Seipel, hereby certify that the vertical and horizontal locations and dimensions shown on this plan are a true and correct record and were located by survey.

Registered Surveying Associate [Signature]
 Surveyor No. SA 7312 Date: 08/04/2024

| | |
|---|--|
| ◻ | WATER METER BOX |
| ◻ | WATER REDUCER |
| > | WATER BEND |
| ◻ | WATER TAPING BAND |
| ◻ | WATER BALL VALVE/STOP VALVE |
| ● | WATER FIRE HYDRANT |
| — | WATERMAIN LINE (SIZE AND CLASS AS SHOWN) |

ENGINEER'S CERTIFICATION
 I, Patrick Brady, hereby certify that:
 1. The information contained in this drawing / document is in compliance with approved drawings and design.
 2. The new water and sewerage works defined by this drawing have been designed and constructed in accordance with the SEQ Code.
 3. This represents an accurate record of as-constructed works
 4. I accept responsibility for the information contained in this drawing / document.
 RPEQ (signature) [Signature] RPEQ No. 7112 Date: _____


| | | | | | | | |
|-----------|-------|------|----------------|-----------|-------|---------|--------|
| A1 | INDEX | DATE | AS CONSTRUCTED | REVISIONS | DRAWN | CHECKED | PASSED |
| | | | | | | | |

| | | |
|----------|------|------------|
| DRAWN | RDE | 08/04/2024 |
| CHECKED | DAM | 08/04/2024 |
| PASSED | | |
| INITIALS | DATE | |



LOGAN CITY COUNCIL
 MIRVAC MIR-1001
 AS CONSTRUCTED SURVEY - WATERMAIN
 EVERLEIGH PRECINCT 10.1C
 GREENBANK QLD


| | |
|------------------------------------|----------------|
| SHEET 3 OF 4 SHEETS | SCALE 1:250 A1 |
| REVISION DATE 08/04/2024 | REVISION - |
| DISCIPLINE CODE - | |
| DRAWING NO. ASC-WATERMAIN-03-10.1C | |

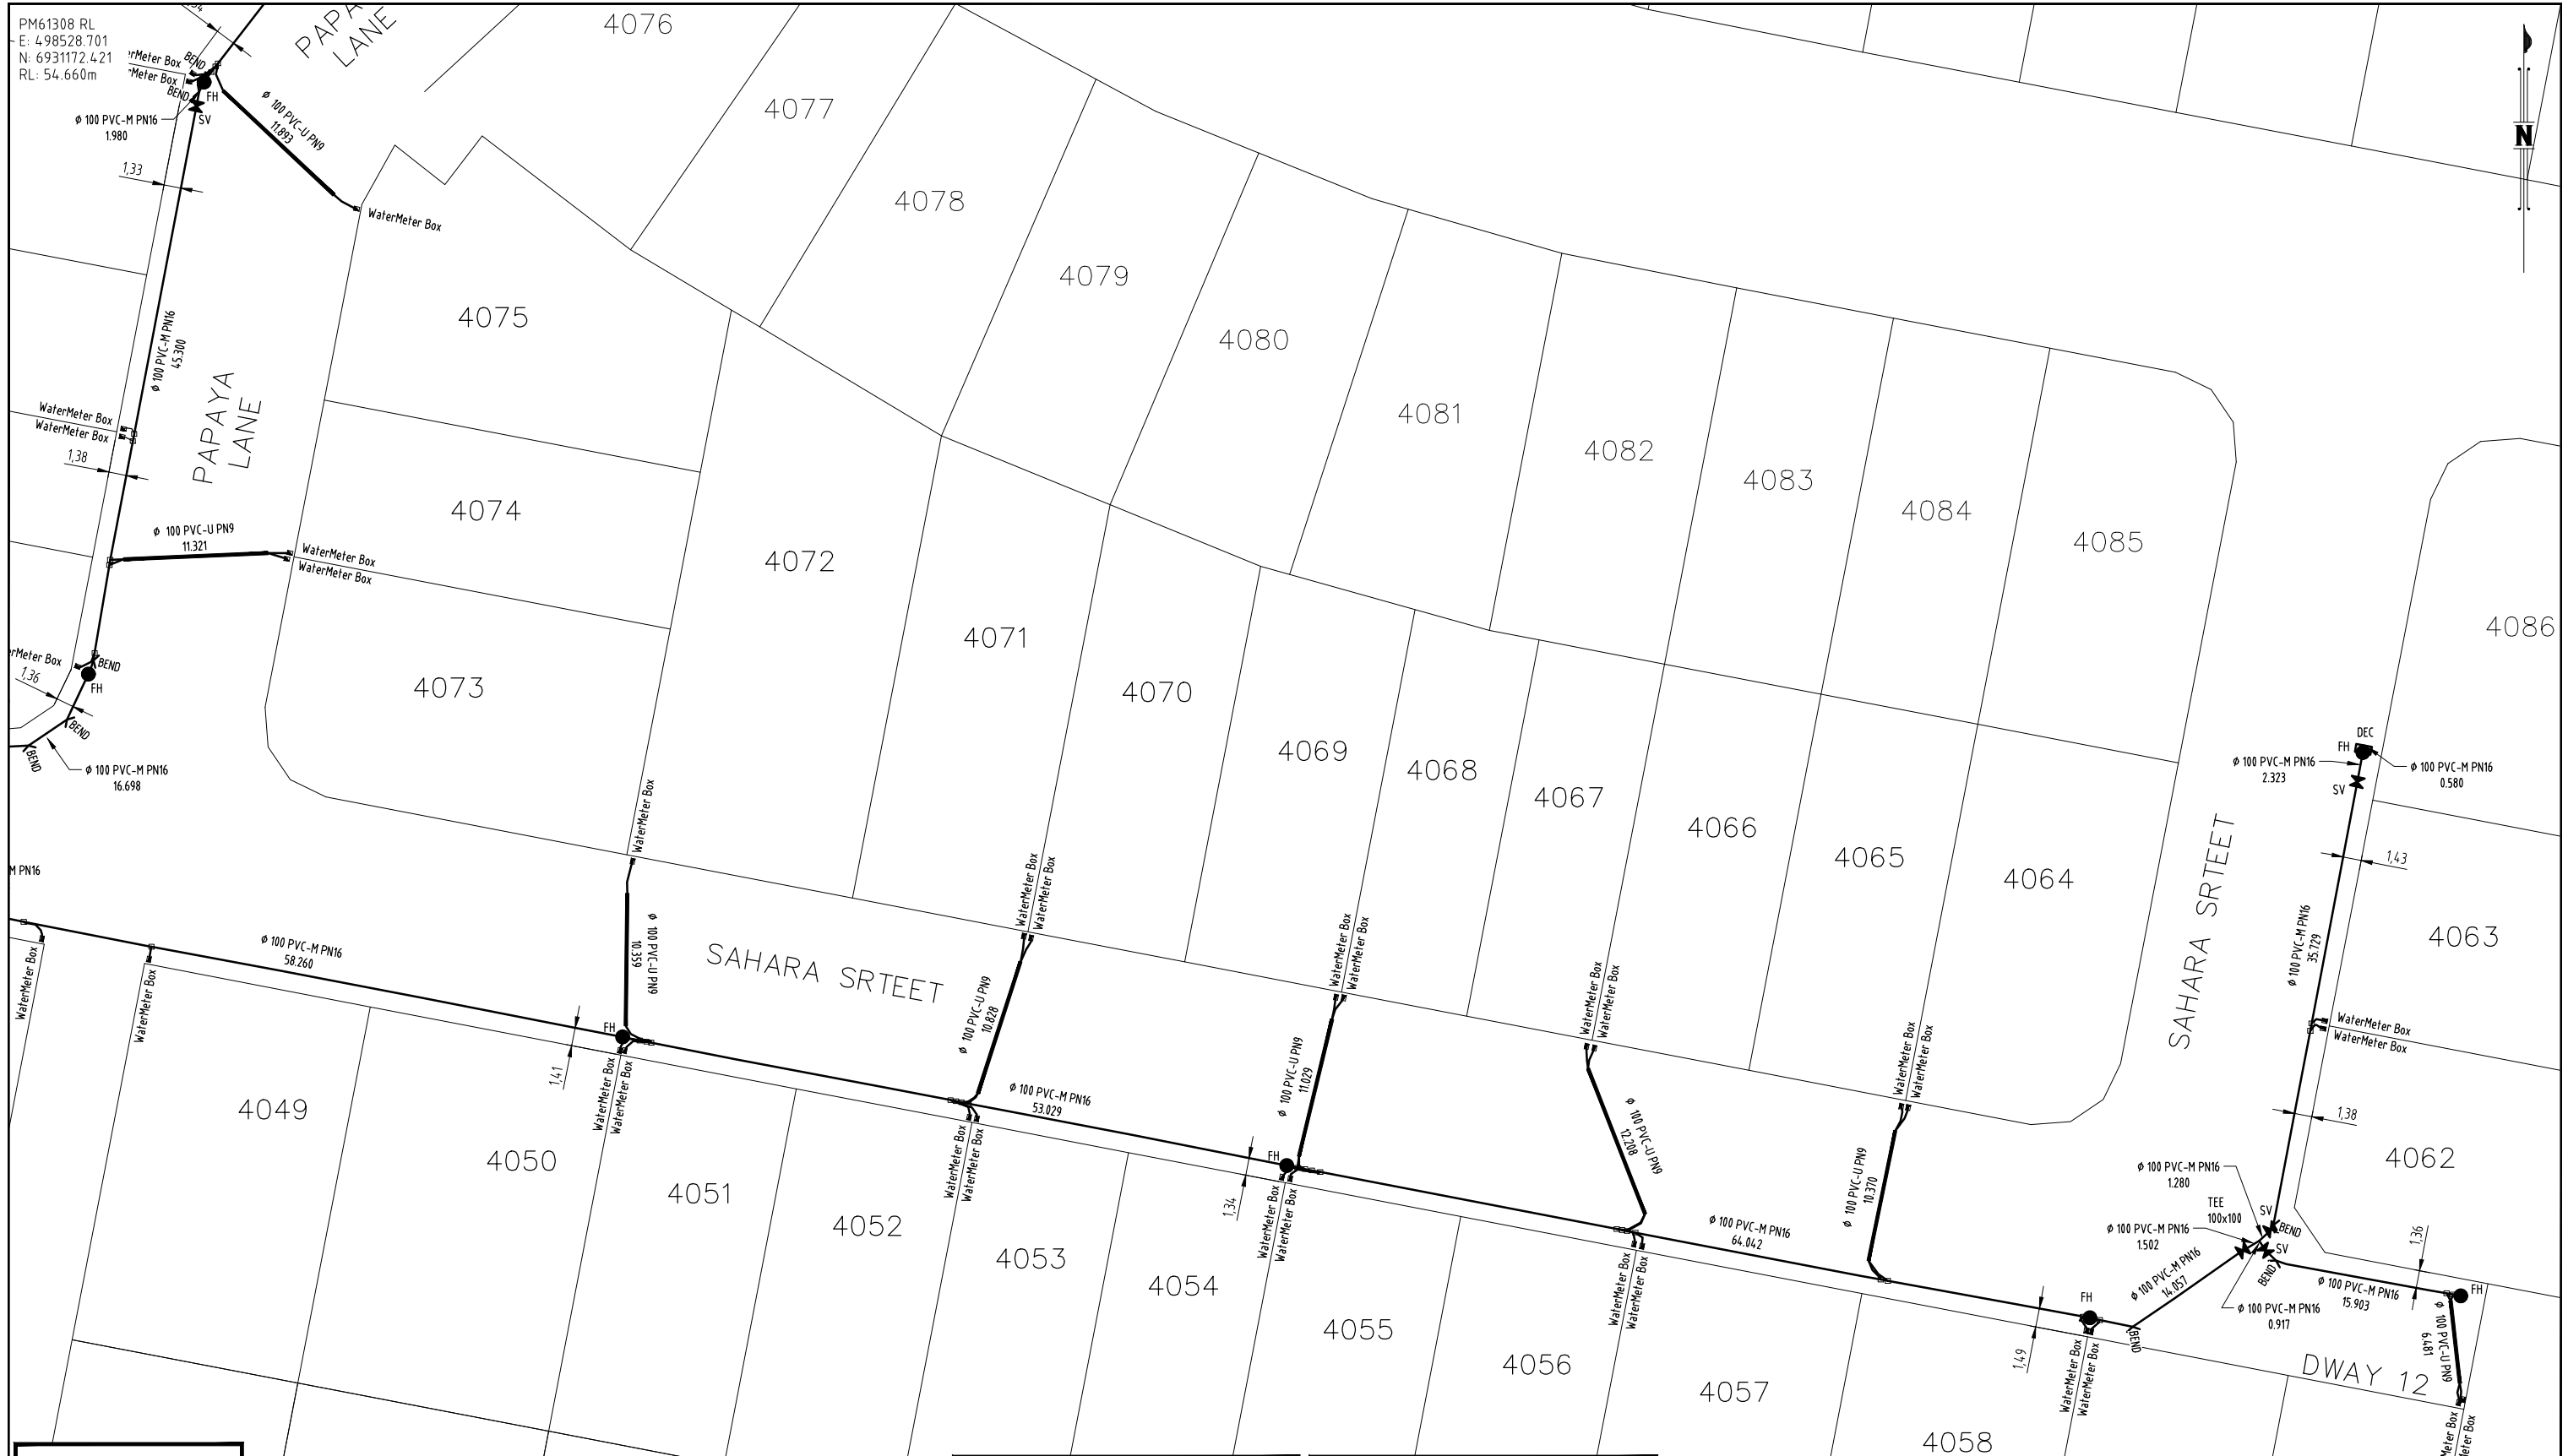

AS CONSTRUCTED

REGISTERED SURVEYING ASSOCIATE CERTIFICATION
 I, Stephen Seipelt, hereby certify that the vertical and horizontal locations and dimensions shown on this plan are a true and correct record and were located by survey.
 Registered Surveying Associate (sig) Surveyor No. SA 7312 Date: 08/04/2024

COORDINATE DATUM NOTE:
 HORIZONTAL COORDINATES (E,N) SUPPLIED ARE MAPPING GRID OF AUSTRALIA (MGA), ZONE 56 BASED ON THE UNIVERSAL TRANSVERSE MERCATOR PROJECTION AND THE GEOCENTRIC DATUM OF AUSTRALIA 2020.
 HORIZONTAL DATUM DERIVED FROM PSM 61308 E 4 98528.114 N 6931171.033.
 LEVELS SUPPLIED ARE ON THE AUSTRALIAN HEIGHT DATUM (AHD).
 LEVEL DATUM DERIVED FROM PSM 61308 RL 54.660 (AHD)

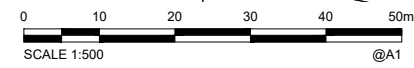

- WATER METER BOX
- WATER REDUCER
- WATER BEND
- WATER TAPING BAND
- BV/SV WATER BALL VALVE/STOP VALVE
- WATER FIRE HYDRANT
- WATERMAIN LINE (SIZE AND CLASS AS SHOWN)

ENGINEER'S CERTIFICATION
 I, Patrick Brady, hereby certify that:
 1. The information contained in this drawing / document is in compliance with approved drawings and design.
 2. The new water and sewerage works defined by this drawing have been designed and constructed in accordance with the SEO Code.
 3. This represents an accurate record of as-constructed works.
 4. I accept responsibility for the information contained in this drawing / document.
 RPEQ (signature) RPEQ No. 7112 Date:

| | | | | | | | |
|----|-------|------|----------------|-----------|-------|---------|--------|
| A1 | INDEX | DATE | AS CONSTRUCTED | REVISIONS | DRAWN | CHECKED | PASSED |
| | | | | | | | |

| | | |
|----------|------|------------|
| DRAWN | RDE | 08/04/2024 |
| CHECKED | DAM | 08/04/2024 |
| PASSED | | |
| INITIALS | DATE | |



LOGAN CITY COUNCIL
 MIRVAC MIR-1001
 AS CONSTRUCTED SURVEY - WATERMAIN
 EVERLEIGH PRECINCT 10.1C
 GREENBANK QLD

| | |
|------------------------------------|----------------|
| SHEET 4 OF 4 SHEETS | SCALE 1:250 A1 |
| REVISION DATE 08/04/2024 | REVISION - |
| DISCIPLINE CODE - | |
| DRAWING NO. ASC-WATERMAIN-04-10.1C | |