




AS CONSTRUCTED

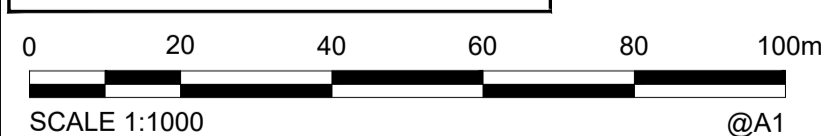

COORDINATE DATUM NOTE:
 HORIZONTAL COORDINATES (N) SUPPLIED ARE MAPPING GRID OF AUSTRALIA (MGA), ZONE 56 BASED ON THE UNIVERSAL TRANSVERSE MERCATOR PROJECTION AND THE GEOCENTRIC DATUM OF AUSTRALIA 1994.
 HORIZONTAL DATUM DERIVED FROM PSM 61308 E 498528.114 N 6931171.033
 LEVELS SUPPLIED ARE ON THE AUSTRALIAN HEIGHT DATUM (AHD) LEVEL DATUM DERIVED FROM PSM 61308 RL54.660 (AHD)

ENGINEER'S CERTIFICATION
 I, _____, hereby certify that:
 1. The information contained in this drawing / document is in compliance with approved drawings and design.
 2. This represents an accurate record of as-constructed works
 3. I accept responsibility for the information contained in this drawing / document.
 RPEQ (signature) RPEQ No. _____ Date _____

REGISTERED SURVEYING ASSOCIATE CERTIFICATION
 I, Stephen Seigel, hereby certify that the vertical and horizontal locations and dimensions shown on this plan are a true and correct record and were located by survey.
 Registered Surveying Associate (sig.)
 Surveyor No. SA 7312 Date: 03/06/2024


PAVEMENT DESIGN		
GUROMAN DRIVE	PAPAYA LANE	ROAD 132 CH0-4.05
AC(mm) - 50	AC(mm) - 35	AC(mm) - 50
BASE(2.1)(mm) - 300	BASE(2.1)(mm) - 150	BASE(2.1)(mm) - 300
SUBBASE(2.3)(mm) - 100	SUBBASE(2.3)(mm) - 150	SUBBASE(2.3)(mm) - 100
SAHARA STREET CH0-5.73	TERRACOTTA STREET	ROAD 132 CH4.05-32.07
AC(mm) - 50	AC(mm) - 35	AC(mm) - 35
BASE(2.1)(mm) - 300	BASE(2.1)(mm) - 150	BASE(2.1)(mm) - 150
SUBBASE(2.3)(mm) - 100	SUBBASE(2.3)(mm) - 150	SUBBASE(2.3)(mm) - 150
SAHARA STREET CH5.73-350.60		DRIVEWAY 12
AC(mm) - 35		AC(mm) - 35
BASE(2.1)(mm) - 150		BASE(2.1)(mm) - 150
SUBBASE(2.3)(mm) - 150		SUBBASE(2.3)(mm) - 100
SPOT HEIGHTS	WALL HEIGHTS	RETAINING WALLS
+ 56.36	56.60 55.524	

A1	INDEX	DATE	AS CONSTRUCTED	REVISIONS	DRAWN	CHECKED	PASSED	INITIALS	DATE
	A	03/06/2024	AS CONSTRUCTED		RDE	DAM	CW		03/06/2024




LOGAN CITY COUNCIL
 MIRVAC MIR-1001
 AS CONSTRUCTED SURVEY - ROADS AND EARTHWORKS
 EVERLEIGH PRECINCT 10.1C
 GREENBANK QLD

SHEET 1 OF 5	SHEETS	SCALE 1:500 A1
REVISION DATE	03/06/2024	REVISION A
DISCIPLINE CODE	-	
DRAWING NO.	ASC-RDS AND EWKS-01-10.1C	

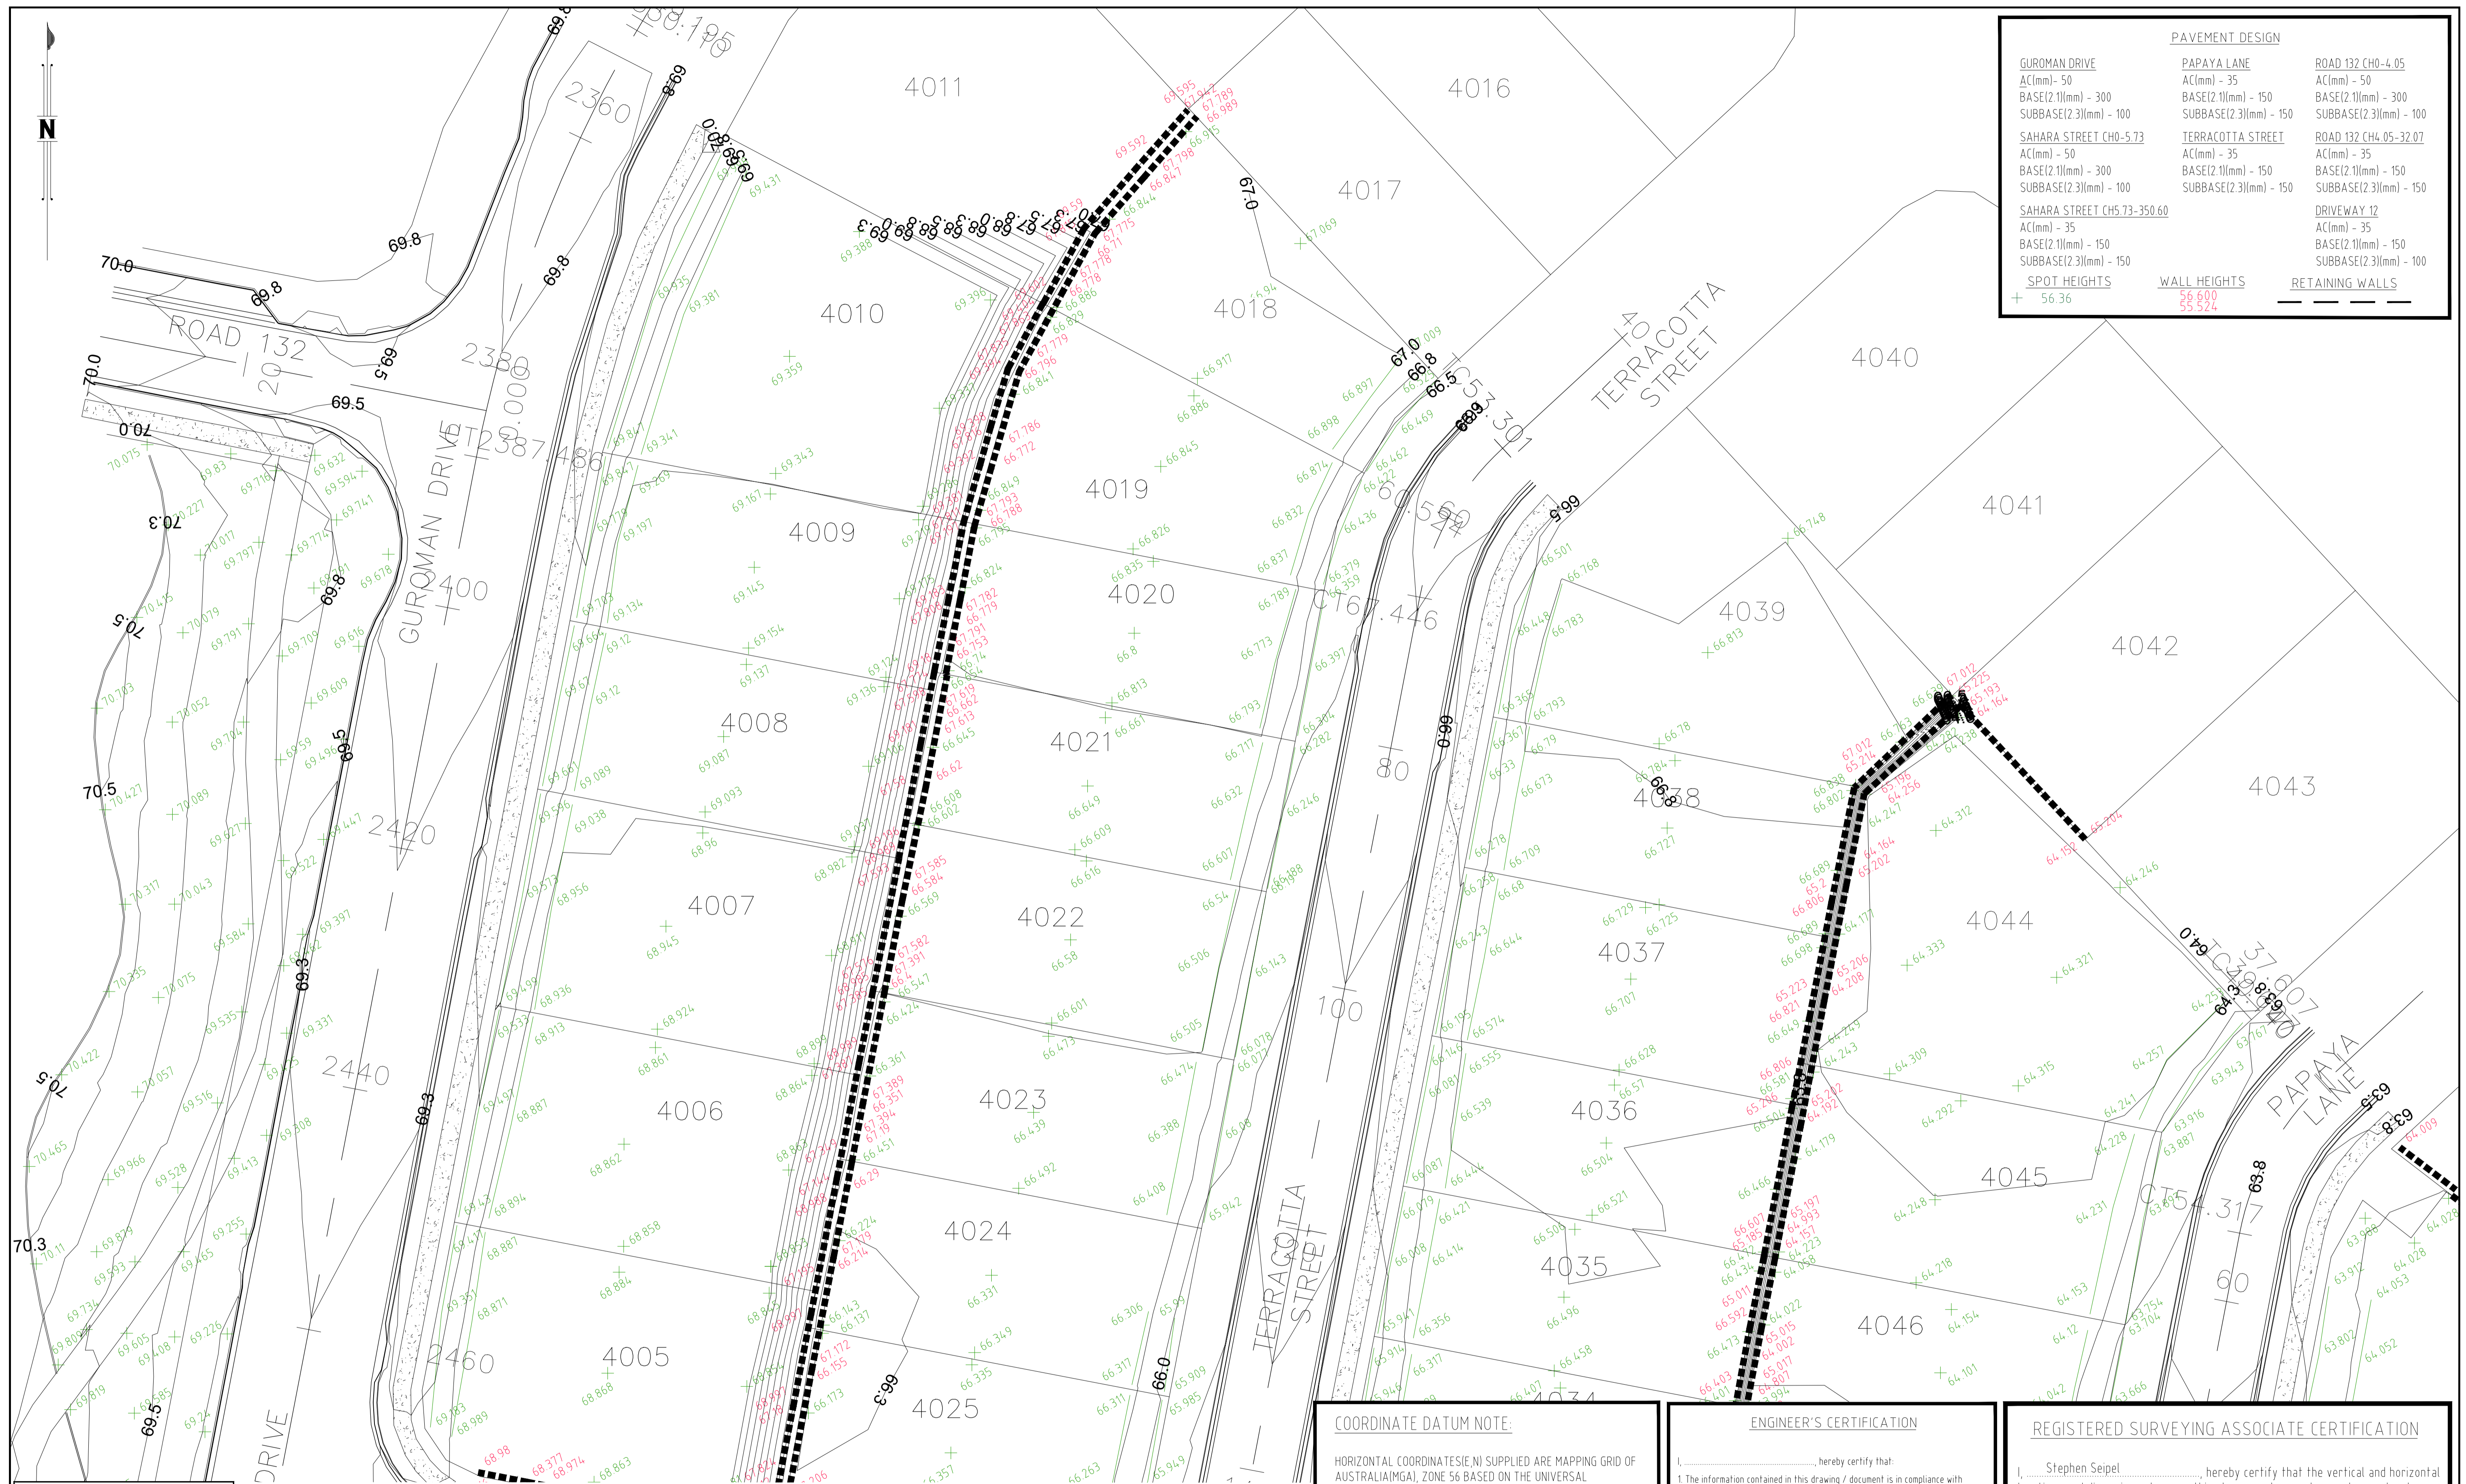

PAVEMENT DESIGN		
GUROMAN DRIVE	PAPAYA LANE	ROAD 132 CH0-4.05
AC(mm) - 50	AC(mm) - 35	AC(mm) - 50
BASE(2.1)(mm) - 300	BASE(2.1)(mm) - 150	BASE(2.1)(mm) - 300
SUBBASE(2.3)(mm) - 100	SUBBASE(2.3)(mm) - 150	SUBBASE(2.3)(mm) - 100
SAHARA STREET CH0-5.73	TERRACOTTA STREET	ROAD 132 CH4.05-32.07
AC(mm) - 50	AC(mm) - 35	AC(mm) - 35
BASE(2.1)(mm) - 300	BASE(2.1)(mm) - 150	BASE(2.1)(mm) - 150
SUBBASE(2.3)(mm) - 100	SUBBASE(2.3)(mm) - 150	SUBBASE(2.3)(mm) - 150
SAHARA STREET CH5.73-350.60		DRIVEWAY 12
AC(mm) - 35		AC(mm) - 35
BASE(2.1)(mm) - 150		BASE(2.1)(mm) - 150
SUBBASE(2.3)(mm) - 150		SUBBASE(2.3)(mm) - 100
SPOT HEIGHTS	WALL HEIGHTS	RETAINING WALLS
+ 56.36	56.600 55.524	

AS CONSTRUCTED

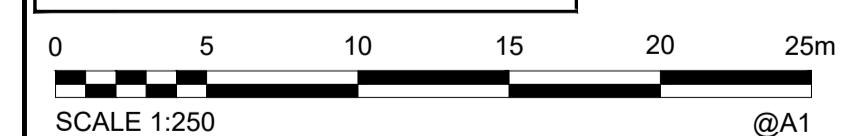

COORDINATE DATUM NOTE:
 HORIZONTAL COORDINATES (E, N) SUPPLIED ARE MAPPING GRID OF AUSTRALIA (MGA), ZONE 56 BASED ON THE UNIVERSAL TRANSVERSE MERCATOR PROJECTION AND THE GEOCENTRIC DATUM OF AUSTRALIA 1994.
 HORIZONTAL DATUM DERIVED FROM PSM 61308 E 4.98528 114 N 6931171.033
 LEVELS SUPPLIED ARE ON THE AUSTRALIAN HEIGHT DATUM (AHD)
 LEVEL DATUM DERIVED FROM PSM 61308 RLS4.660 (AHD)

ENGINEER'S CERTIFICATION
 I, _____, hereby certify that:
 1. The information contained in this drawing / document is in compliance with approved drawings and design.
 2. This represents an accurate record of as-constructed works
 3. I accept responsibility for the information contained in this drawing / document.
 RPED (signature) RPED No. _____ Date _____

REGISTERED SURVEYING ASSOCIATE CERTIFICATION
 I, Stephen Seipel, hereby certify that the vertical and horizontal locations and dimensions shown on this plan are a true and correct record and were located by survey.
 Registered Surveying Associate (sig) _____
 Surveyor No. SA 7312 Date: 03/06/2024

A1	INDEX	DATE	AS CONSTRUCTED	REVISIONS	DRAWN	CHECKED	PASSED
	A	03/06/2024	AS CONSTRUCTED		RDE	DAM	CW

DRAWN	RDE	03/06/2024
CHECKED	DAM	03/06/2024
PASSED	CW	03/06/2024
INITIALS	DATE	




LOGAN CITY COUNCIL
 MIRVAC MIR-1001
 AS CONSTRUCTED SURVEY - ROADS AND EARTHWORKS
 EVERLEIGH PRECINCT 10.1C
 GREENBANK QLD

SHEET 2 OF 5 SHEETS	SCALE 1:250 A1
REVISION DATE 03/06/2024	REVISION A
DISCIPLINE CODE -	
DRAWING NO. ASC-RDS AND EWKS-02-10.1C	



AS CONSTRUCTED

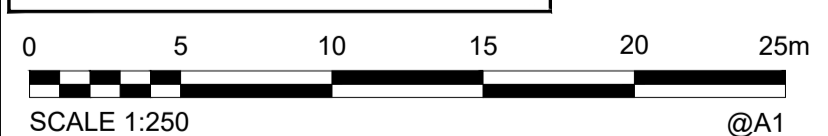

PAVEMENT DESIGN		
GUROMAN DRIVE	PAPAYA LANE	ROAD 132 CH0-4.05
AC(mm) - 50	AC(mm) - 35	AC(mm) - 50
BASE(2.1lmm) - 300	BASE(2.1lmm) - 150	BASE(2.1lmm) - 300
SUBBASE(2.3lmm) - 100	SUBBASE(2.3lmm) - 150	SUBBASE(2.3lmm) - 100
SAHARA STREET CH0-5.73	TERRACOTTA STREET	ROAD 132 CH4.05-32.07
AC(mm) - 50	AC(mm) - 35	AC(mm) - 35
BASE(2.1lmm) - 300	BASE(2.1lmm) - 150	BASE(2.1lmm) - 150
SUBBASE(2.3lmm) - 100	SUBBASE(2.3lmm) - 150	SUBBASE(2.3lmm) - 150
SAHARA STREET CH5.73-350.60	DRIVEWAY 12	
AC(mm) - 35	AC(mm) - 35	
BASE(2.1lmm) - 150	BASE(2.1lmm) - 150	
SUBBASE(2.3lmm) - 150	SUBBASE(2.3lmm) - 100	
SPOT HEIGHTS	WALL HEIGHTS	RETAINING WALLS
+ 56.36	56.600 55.524	

COORDINATE DATUM NOTE:

HORIZONTAL COORDINATES (E, N) SUPPLIED ARE MAPPING GRID OF AUSTRALIA (MGA), ZONE 56 BASED ON THE UNIVERSAL TRANSVERSE MERCATOR PROJECTION AND THE GEOCENTRIC DATUM OF AUSTRALIA 1994.

HORIZONTAL DATUM DERIVED FROM PSM 613008 E 4.98528 114 N 6931171033

LEVELS SUPPLIED ARE ON THE AUSTRALIAN HEIGHT DATUM (AHD) LEVEL DATUM DERIVED FROM PSM 613008 RL54.660 (AHD)

ENGINEER'S CERTIFICATION


I, _____, hereby certify that:

- The information contained in this drawing / document is in compliance with approved drawings and design.
- This represents an accurate record of as-constructed works.
- I accept responsibility for the information contained in this drawing / document.

RPED (signature) RPED No. _____ Date _____

REGISTERED SURVEYING ASSOCIATE CERTIFICATION

I, Stephen Seipel, hereby certify that the vertical and horizontal locations and dimensions shown on this plan are a true and correct record and were located by survey.



Registered Surveying Associate (sig) Surveyor No. SA 7312 Date: 03/06/2024

A1	INDEX	DATE	AS CONSTRUCTED	REVISIONS	DRAWN	CHECKED	PASSED
	A	03/06/2024	AS CONSTRUCTED		RDE	DAM	CW

DRAWN	RDE	03/06/2024
CHECKED	DAM	03/06/2024
PASSED	CW	03/06/2024
INITIALS	DATE	



LOGAN CITY COUNCIL


MIRVAC MIR-1001
AS CONSTRUCTED SURVEY - ROADS AND EARTHWORKS
EVERLEIGH PRECINCT 10.1C
GREENBANK QLD

SHEET 3 OF 5 SHEETS	SCALE 1:250 A1
REVISION DATE 03/06/2024	REVISION A
DISCIPLINE CODE -	
DRAWING NO. ASC-RDS AND EWKS-03-10.1C	



PAVEMENT DESIGN		
GUROMAN DRIVE	PAPAYA LANE	ROAD 132 CH0-4.05
AC(mm) - 50	AC(mm) - 35	AC(mm) - 50
BASE(2.1)(mm) - 300	BASE(2.1)(mm) - 150	BASE(2.1)(mm) - 300
SUBBASE(2.3)(mm) - 100	SUBBASE(2.3)(mm) - 150	SUBBASE(2.3)(mm) - 100
SAHARA STREET CH0-5.73	TERRACOTTA STREET	ROAD 132 CH4.05-32.07
AC(mm) - 50	AC(mm) - 35	AC(mm) - 35
BASE(2.1)(mm) - 300	BASE(2.1)(mm) - 150	BASE(2.1)(mm) - 150
SUBBASE(2.3)(mm) - 100	SUBBASE(2.3)(mm) - 150	SUBBASE(2.3)(mm) - 150
SAHARA STREET CH5.73-350.60	DRIVEWAY 12	
AC(mm) - 35	AC(mm) - 35	
BASE(2.1)(mm) - 150	BASE(2.1)(mm) - 150	
SUBBASE(2.3)(mm) - 150	SUBBASE(2.3)(mm) - 100	
SPOT HEIGHTS	WALL HEIGHTS	RETAINING WALLS
+ 56.36	56.600	
	55.524	

AS CONSTRUCTED

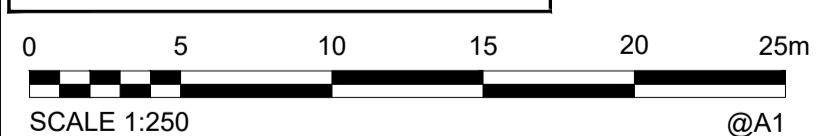

COORDINATE DATUM NOTE:
 HORIZONTAL COORDINATES(E,N) SUPPLIED ARE MAPPING GRID OF AUSTRALIA(MGA), ZONE 56 BASED ON THE UNIVERSAL TRANSVERSE MERCATOR PROJECTION AND THE GEOCENTRIC DATUM OF AUSTRALIA 1994.
 HORIZONTAL DATUM DERIVED FROM PSM 61308 E 4.98528 114 N 6931171033
 LEVELS SUPPLIED ARE ON THE AUSTRALIAN HEIGHT DATUM(AHD) LEVEL DATUM DERIVED FROM PSM 61308 RL54.660 (AHD)

ENGINEER'S CERTIFICATION
 I, _____, hereby certify that:
 1. The information contained in this drawing / document is in compliance with approved drawings and design.
 2. This represents an accurate record of as-constructed works
 3. I accept responsibility for the information contained in this drawing / document
 RPED (signature) RPED No. _____ Date _____

REGISTERED SURVEYING ASSOCIATE CERTIFICATION
 I, Stephen Seipel, hereby certify that the vertical and horizontal locations and dimensions shown on this plan are a true and correct record and were located by survey.
 Registered Surveying Associate (sig) _____
 Surveyor No. SA 7312 Date: 03/06/2024

A1	INDEX	DATE	AS CONSTRUCTED	REVISIONS	DRAWN	CHECKED	PASSED
	A	03/06/2024	AS CONSTRUCTED		RDE	DAM	CW
					DRAWN	CHECKED	PASSED

shadforth
 99 Sandalwood Lane, Forest Glen QLD 4056
 P: 07 5438 3300 E: 07 5438 3308 F: e:ac@shadforth.com.au


LOGAN CITY COUNCIL

LOGAN CITY COUNCIL
 MIRVAC MIR-1001
 AS CONSTRUCTED SURVEY - ROADS AND EARTHWORKS
 EVERLEIGH PRECINCT 10.1C
 GREENBANK QLD

SHEET 4 OF 5 SHEETS	SCALE 1:250 A1
REVISION DATE 03/06/2024	REVISION A
DISCIPLINE CODE -	
DRAWING NO. ASC-RDS AND EWKS-04-10.1C	



AS CONSTRUCTED

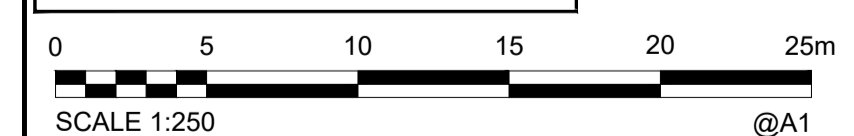

PAVEMENT DESIGN		
GUROMAN DRIVE	PAPAYA LANE	ROAD 132 CH0-4.05
AC(mm) - 50	AC(mm) - 35	AC(mm) - 50
BASE(2.1)(mm) - 300	BASE(2.1)(mm) - 150	BASE(2.1)(mm) - 300
SUBBASE(2.3)(mm) - 100	SUBBASE(2.3)(mm) - 150	SUBBASE(2.3)(mm) - 100
SAHARA STREET CH0-5.73	TERRACOTTA STREET	ROAD 132 CH4.05-32.07
AC(mm) - 50	AC(mm) - 35	AC(mm) - 35
BASE(2.1)(mm) - 300	BASE(2.1)(mm) - 150	BASE(2.1)(mm) - 150
SUBBASE(2.3)(mm) - 100	SUBBASE(2.3)(mm) - 150	SUBBASE(2.3)(mm) - 150
SAHARA STREET CH5.73-350.60	DRIVEWAY 12	
AC(mm) - 35	AC(mm) - 35	
BASE(2.1)(mm) - 150	BASE(2.1)(mm) - 150	
SUBBASE(2.3)(mm) - 150	SUBBASE(2.3)(mm) - 100	
SPOT HEIGHTS	WALL HEIGHTS	RETAINING WALLS
+ 56.36	58.600 55.524	

COORDINATE DATUM NOTE:
 HORIZONTAL COORDINATES (E, N) SUPPLIED ARE MAPPING GRID OF AUSTRALIA (MGA), ZONE 56 BASED ON THE UNIVERSAL TRANSVERSE MERCATOR PROJECTION AND THE GEOCENTRIC DATUM OF AUSTRALIA 1994.
 HORIZONTAL DATUM DERIVED FROM PSM 61308 E 4.98528.114 N 6931171.033
 LEVELS SUPPLIED ARE ON THE AUSTRALIAN HEIGHT DATUM (AHD)
 LEVEL DATUM DERIVED FROM PSM 61308 RL54.660 (AHD)

ENGINEER'S CERTIFICATION
 I, _____, hereby certify that:
 1. The information contained in this drawing / document is in compliance with approved drawings and design.
 2. This represents an accurate record of as-constructed works
 3. I accept responsibility for the information contained in this drawing / document.
 RPED (signature) RPED No. _____ Date: _____

REGISTERED SURVEYING ASSOCIATE CERTIFICATION
 I, Stephen Seipel, hereby certify that the vertical and horizontal locations and dimensions shown on this plan are a true and correct record and were located by survey.
 Registered Surveying Associate (sig) _____
 Surveyor No. SA 7312 Date: 03/06/2024

A1	INDEX	DATE	AS CONSTRUCTED	REVISIONS	DRAWN	CHECKED	PASSED
	A	03/06/2024	AS CONSTRUCTED		RDE	DAM	CW

DRAWN	RDE	03/06/2024
CHECKED	DAM	03/06/2024
PASSED	CW	03/06/2024
INITIALS	DATE	



LOGAN CITY COUNCIL
 MIRVAC MIR-1001
 AS CONSTRUCTED SURVEY - ROADS AND EARTHWORKS
 EVERLEIGH PRECINCT 10.1C
 GREENBANK QLD

SHEET 5 OF 5 SHEETS	SCALE 1:250 A1
REVISION DATE 03/06/2024	REVISION A
DISCIPLINE CODE -	
DRAWING NO. ASC-RDS AND EWKS-05-10.1C	