

PM61308 RL
 E: 498528.701
 N: 6931172.421
 RL: 54.660m




REFER TO PLAN ASC-SEWER-02-10.2C


REFER TO PLAN ASC-SEWER-03-10.2C

REFER TO PLAN ASC-SEWER-04-10.2C

REFER TO PLAN ASC-SEWER-05-10.2C

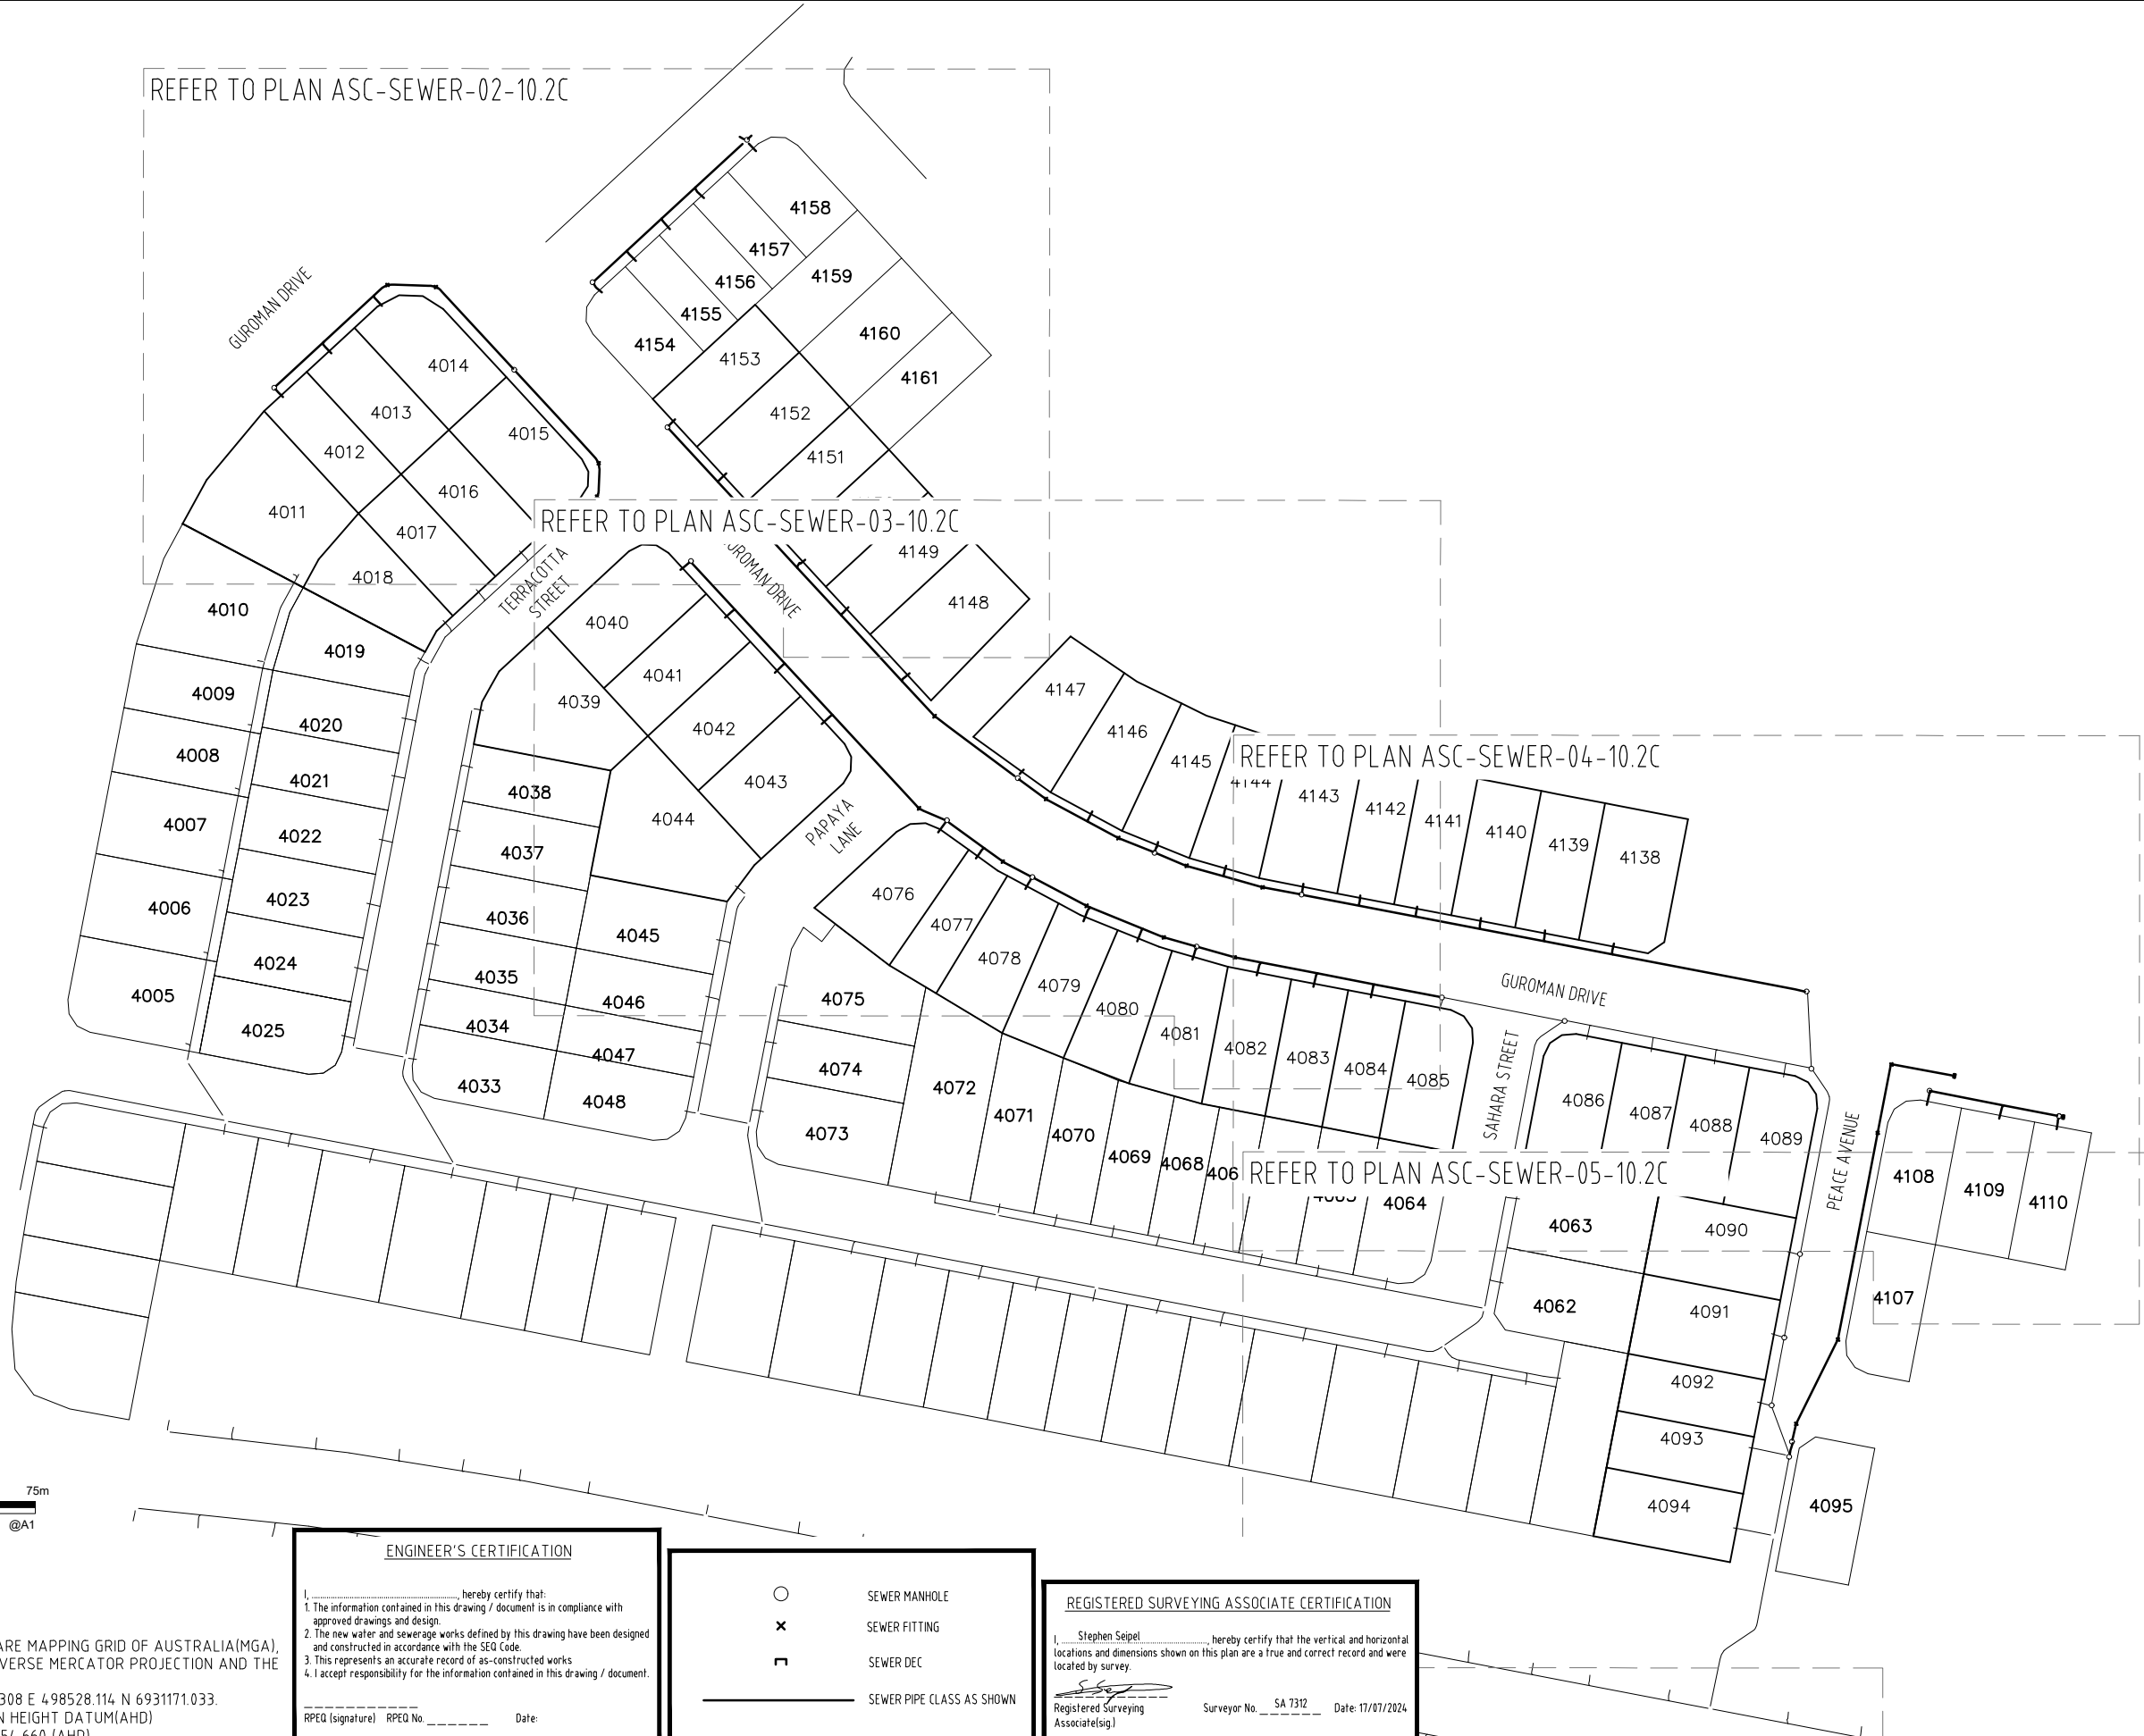

PARK LOT 824

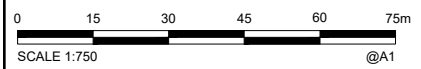

AS CONSTRUCTED

COORDINATE DATUM NOTE:
 HORIZONTAL COORDINATES(E,N) SUPPLIED ARE MAPPING GRID OF AUSTRALIA(MGA), ZONE 56 BASED ON THE UNIVERSAL TRANSVERSE MERCATOR PROJECTION AND THE GEOCENTRIC DATUM OF AUSTRALIA 2020.
 HORIZONTAL DATUM DERIVED FROM PSM 61308 E 498528.114 N 6931171.033.
 LEVELS SUPPLIED ARE ON THE AUSTRALIAN HEIGHT DATUM(AHD)
 LEVEL DATUM DERIVED FROM PSM 61308 RL54.660 (AHD)

ENGINEER'S CERTIFICATION
 I, _____, hereby certify that:
 1. The information contained in this drawing / document is in compliance with approved drawings and design.
 2. The new water and sewerage works defined by this drawing have been designed and constructed in accordance with the SEQ Code.
 3. This represents an accurate record of as-constructed works.
 4. I accept responsibility for the information contained in this drawing / document.
 RPEQ (signature) RPEQ No. _____ Date: _____

○	SEWER MANHOLE
×	SEWER FITTING
□	SEWER DEC
—	SEWER PIPE CLASS AS SHOWN

REGISTERED SURVEYING ASSOCIATE CERTIFICATION
 I, Stephen Seigel, hereby certify that the vertical and horizontal locations and dimensions shown on this plan are a true and correct record and were located by survey.
 Registered Surveying Associate (sig) Surveyor No. SA 7312 Date: 17/07/2024

A1	INDEX	DATE	AS CONSTRUCTED	DRAWN	CHECKED	PASSED



DRAWN	RDE	17/07/2024
CHECKED	DAM	17/07/2024
PASSED		
INITIALS	DATE	



LOGAN CITY COUNCIL
 MIRVAC MIR-1002
 AS CONSTRUCTED SURVEY - SEWER
 EVERLEIGH PRECINCT 10.2C
 GREENBANK QLD

SHEET 1 OF 5 SHEETS	SCALE 1:500 A1
REVISION DATE 17/07/2024	REVISION -
DISCIPLINE CODE -	
DRAWING NO. ASC-SEWER-01-10.2C	

PM61308 RL
 E: 498528.701
 N: 6931172.421
 RL: 54.660m

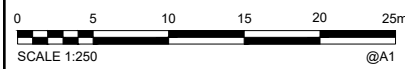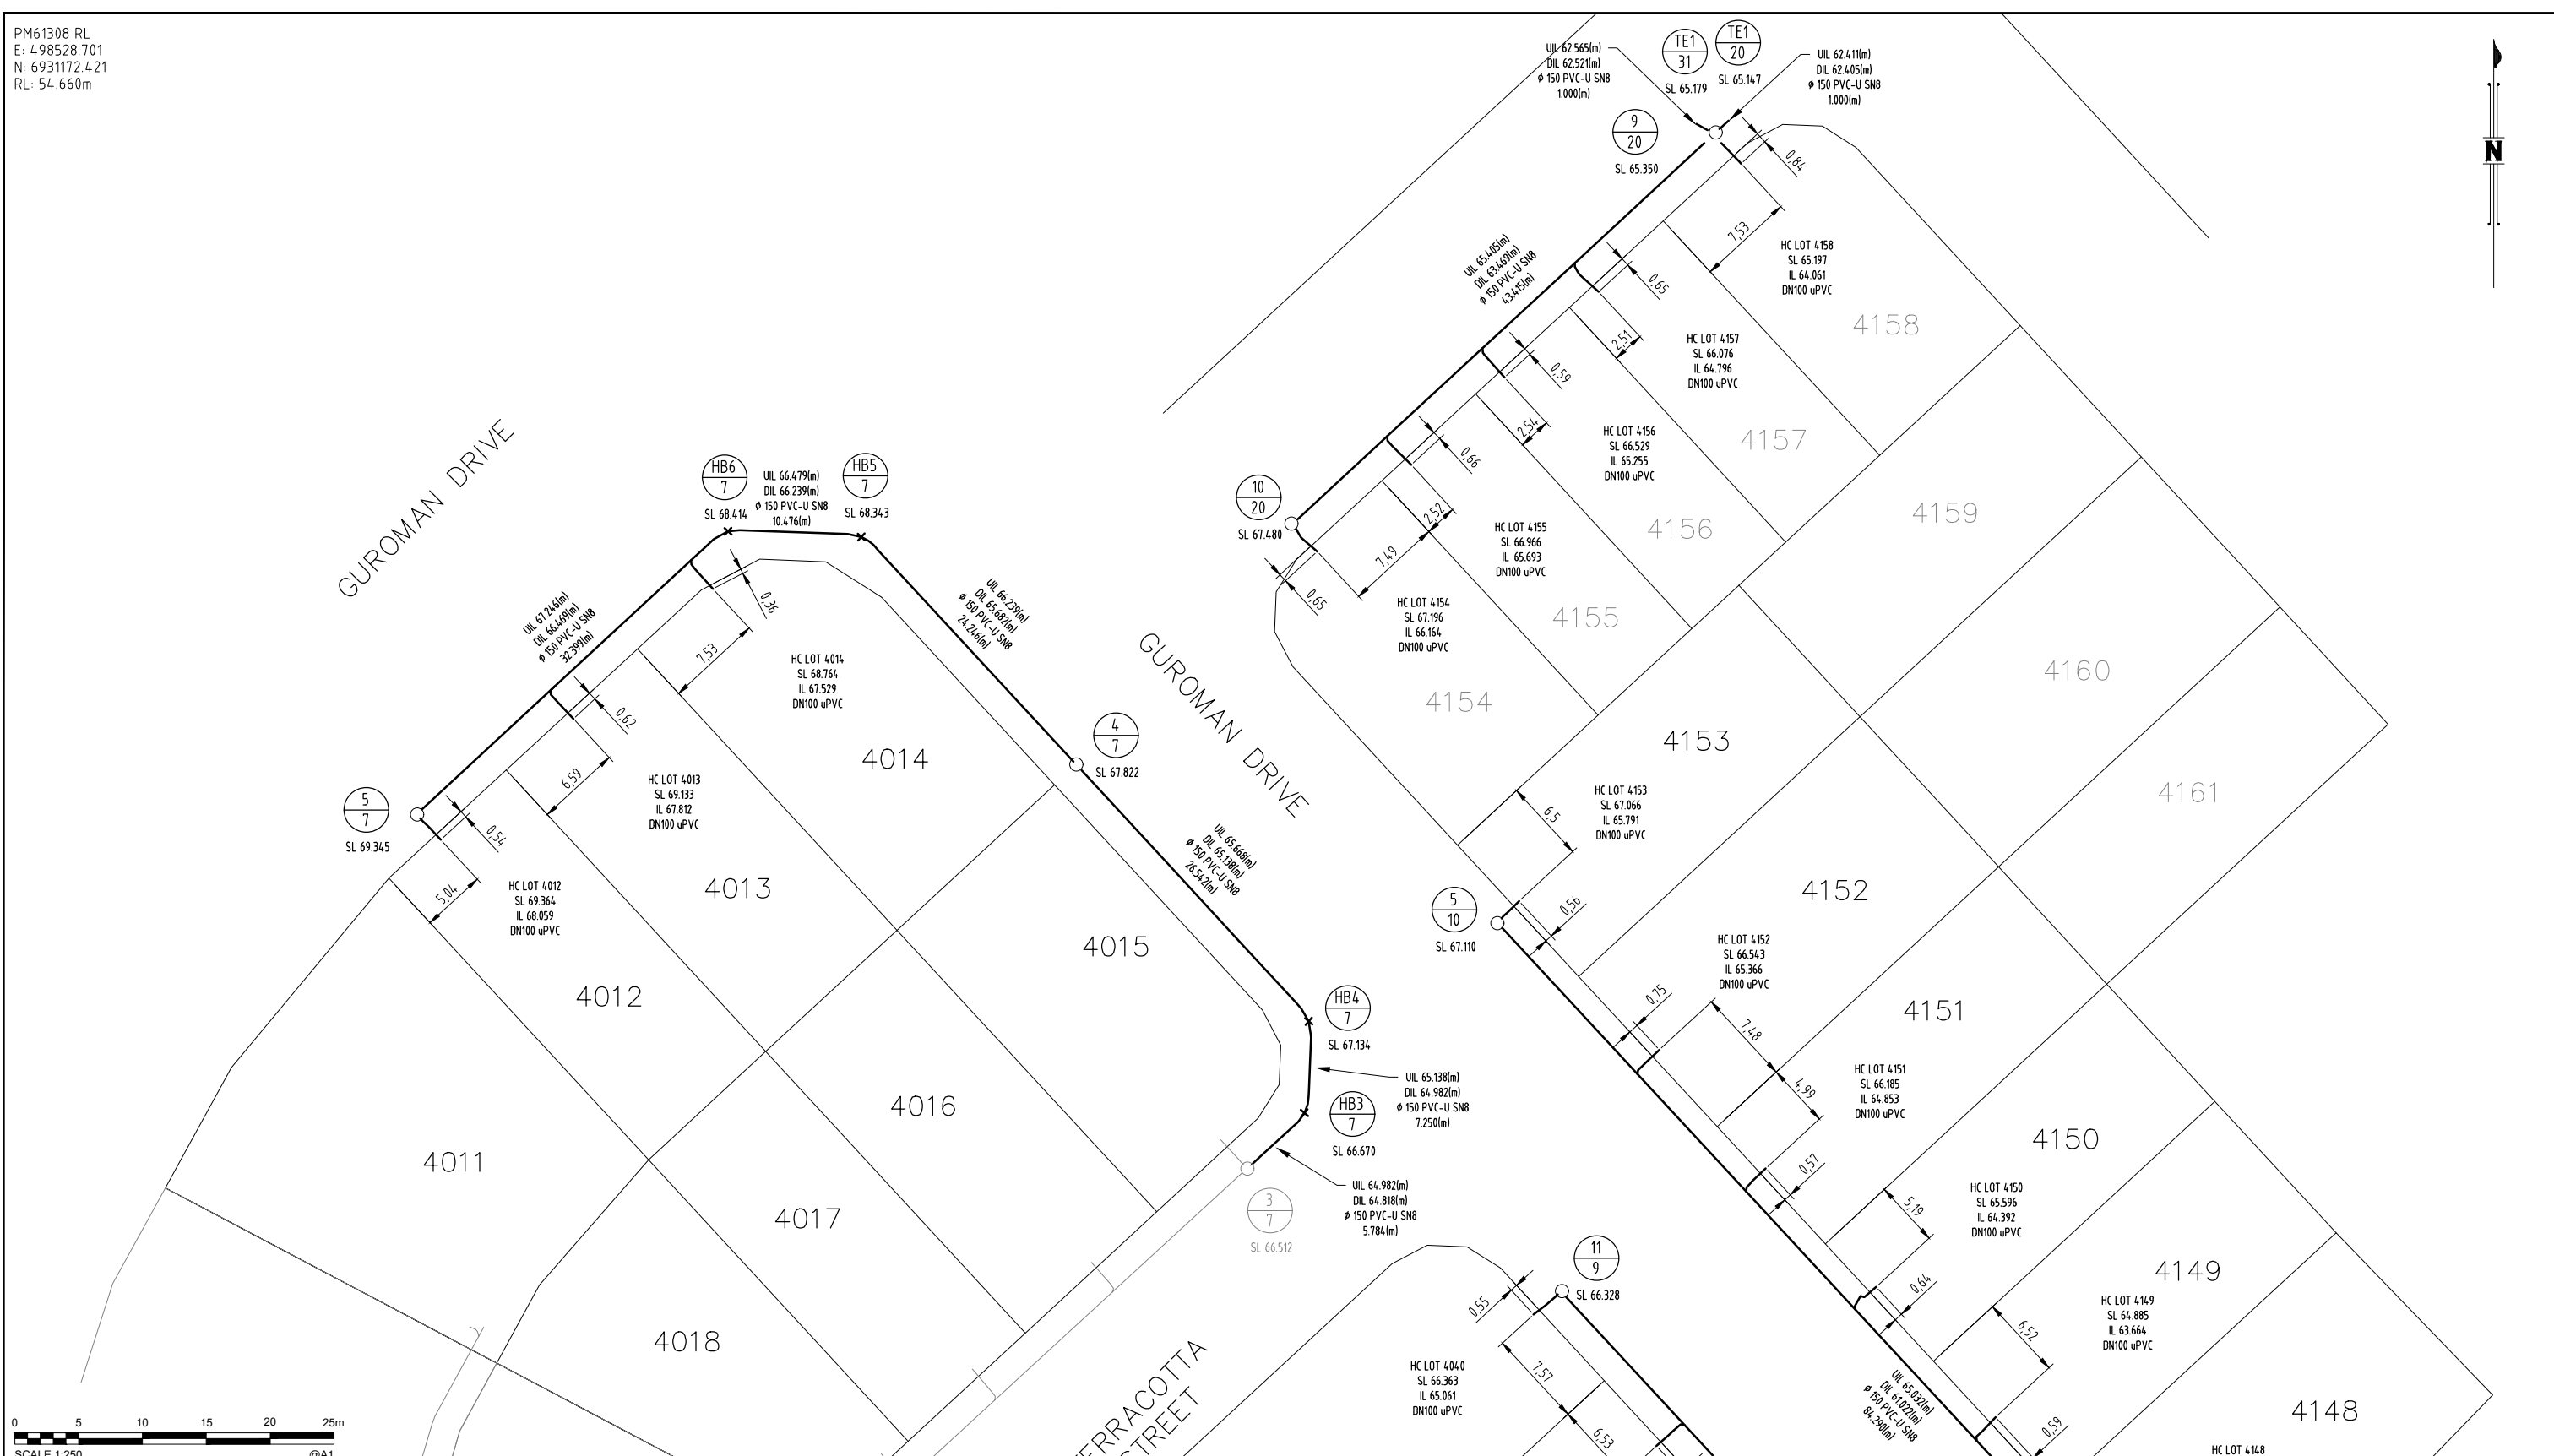

AS CONSTRUCTED

COORDINATE DATUM NOTE:
 HORIZONTAL COORDINATES(E,N) SUPPLIED ARE MAPPING GRID OF AUSTRALIA(MGA), ZONE 56 BASED ON THE UNIVERSAL TRANSVERSE MERCATOR PROJECTION AND THE GEOCENTRIC DATUM OF AUSTRALIA 2020.
 HORIZONTAL DATUM DERIVED FROM PSM 61308 E 498528.114 N 6931171.033.
 LEVELS SUPPLIED ARE ON THE AUSTRALIAN HEIGHT DATUM(AHD)
 LEVEL DATUM DERIVED FROM PSM 61308 RL54.660 (AHD)

ENGINEER'S CERTIFICATION
 I, _____ hereby certify that:
 1. The information contained in this drawing / document is in compliance with approved drawings and design.
 2. The new water and sewerage works defined by this drawing have been designed and constructed in accordance with the SEQ Code.
 3. This represents an accurate record of as-constructed works
 4. I accept responsibility for the information contained in this drawing / document.
 RPEQ (signature) RPEQ No. _____ Date: _____

- SEWER MANHOLE
- x SEWER FITTING
- SEWER DEC
- SEWER PIPE CLASS AS SHOWN

REGISTERED SURVEYING ASSOCIATE CERTIFICATION
 I, Stephen Seipel, hereby certify that the vertical and horizontal locations and dimensions shown on this plan are a true and correct record and were located by survey.
 Registered Surveying Associate (sig) Surveyor No. SA 7312 Date: 17/07/2024


A1	INDEX	DATE	AS CONSTRUCTED	DRAWN	CHECKED	PASSED

DRAWN	RDE	17/07/2024
CHECKED	DAM	17/07/2024
PASSED		
INITIALS	DATE	




LOGAN CITY COUNCIL
 MIRVAC MIR-1002
 AS CONSTRUCTED SURVEY - SEWER
 EVERLEIGH PRECINCT 10.2C
 GREENBANK QLD

SHEET 2 OF 5 SHEETS	SCALE 1:250 A1
REVISION DATE	REVISION
DISCIPLINE CODE	
DRAWING NO.	
ASC-SEWER-02-10.2C	

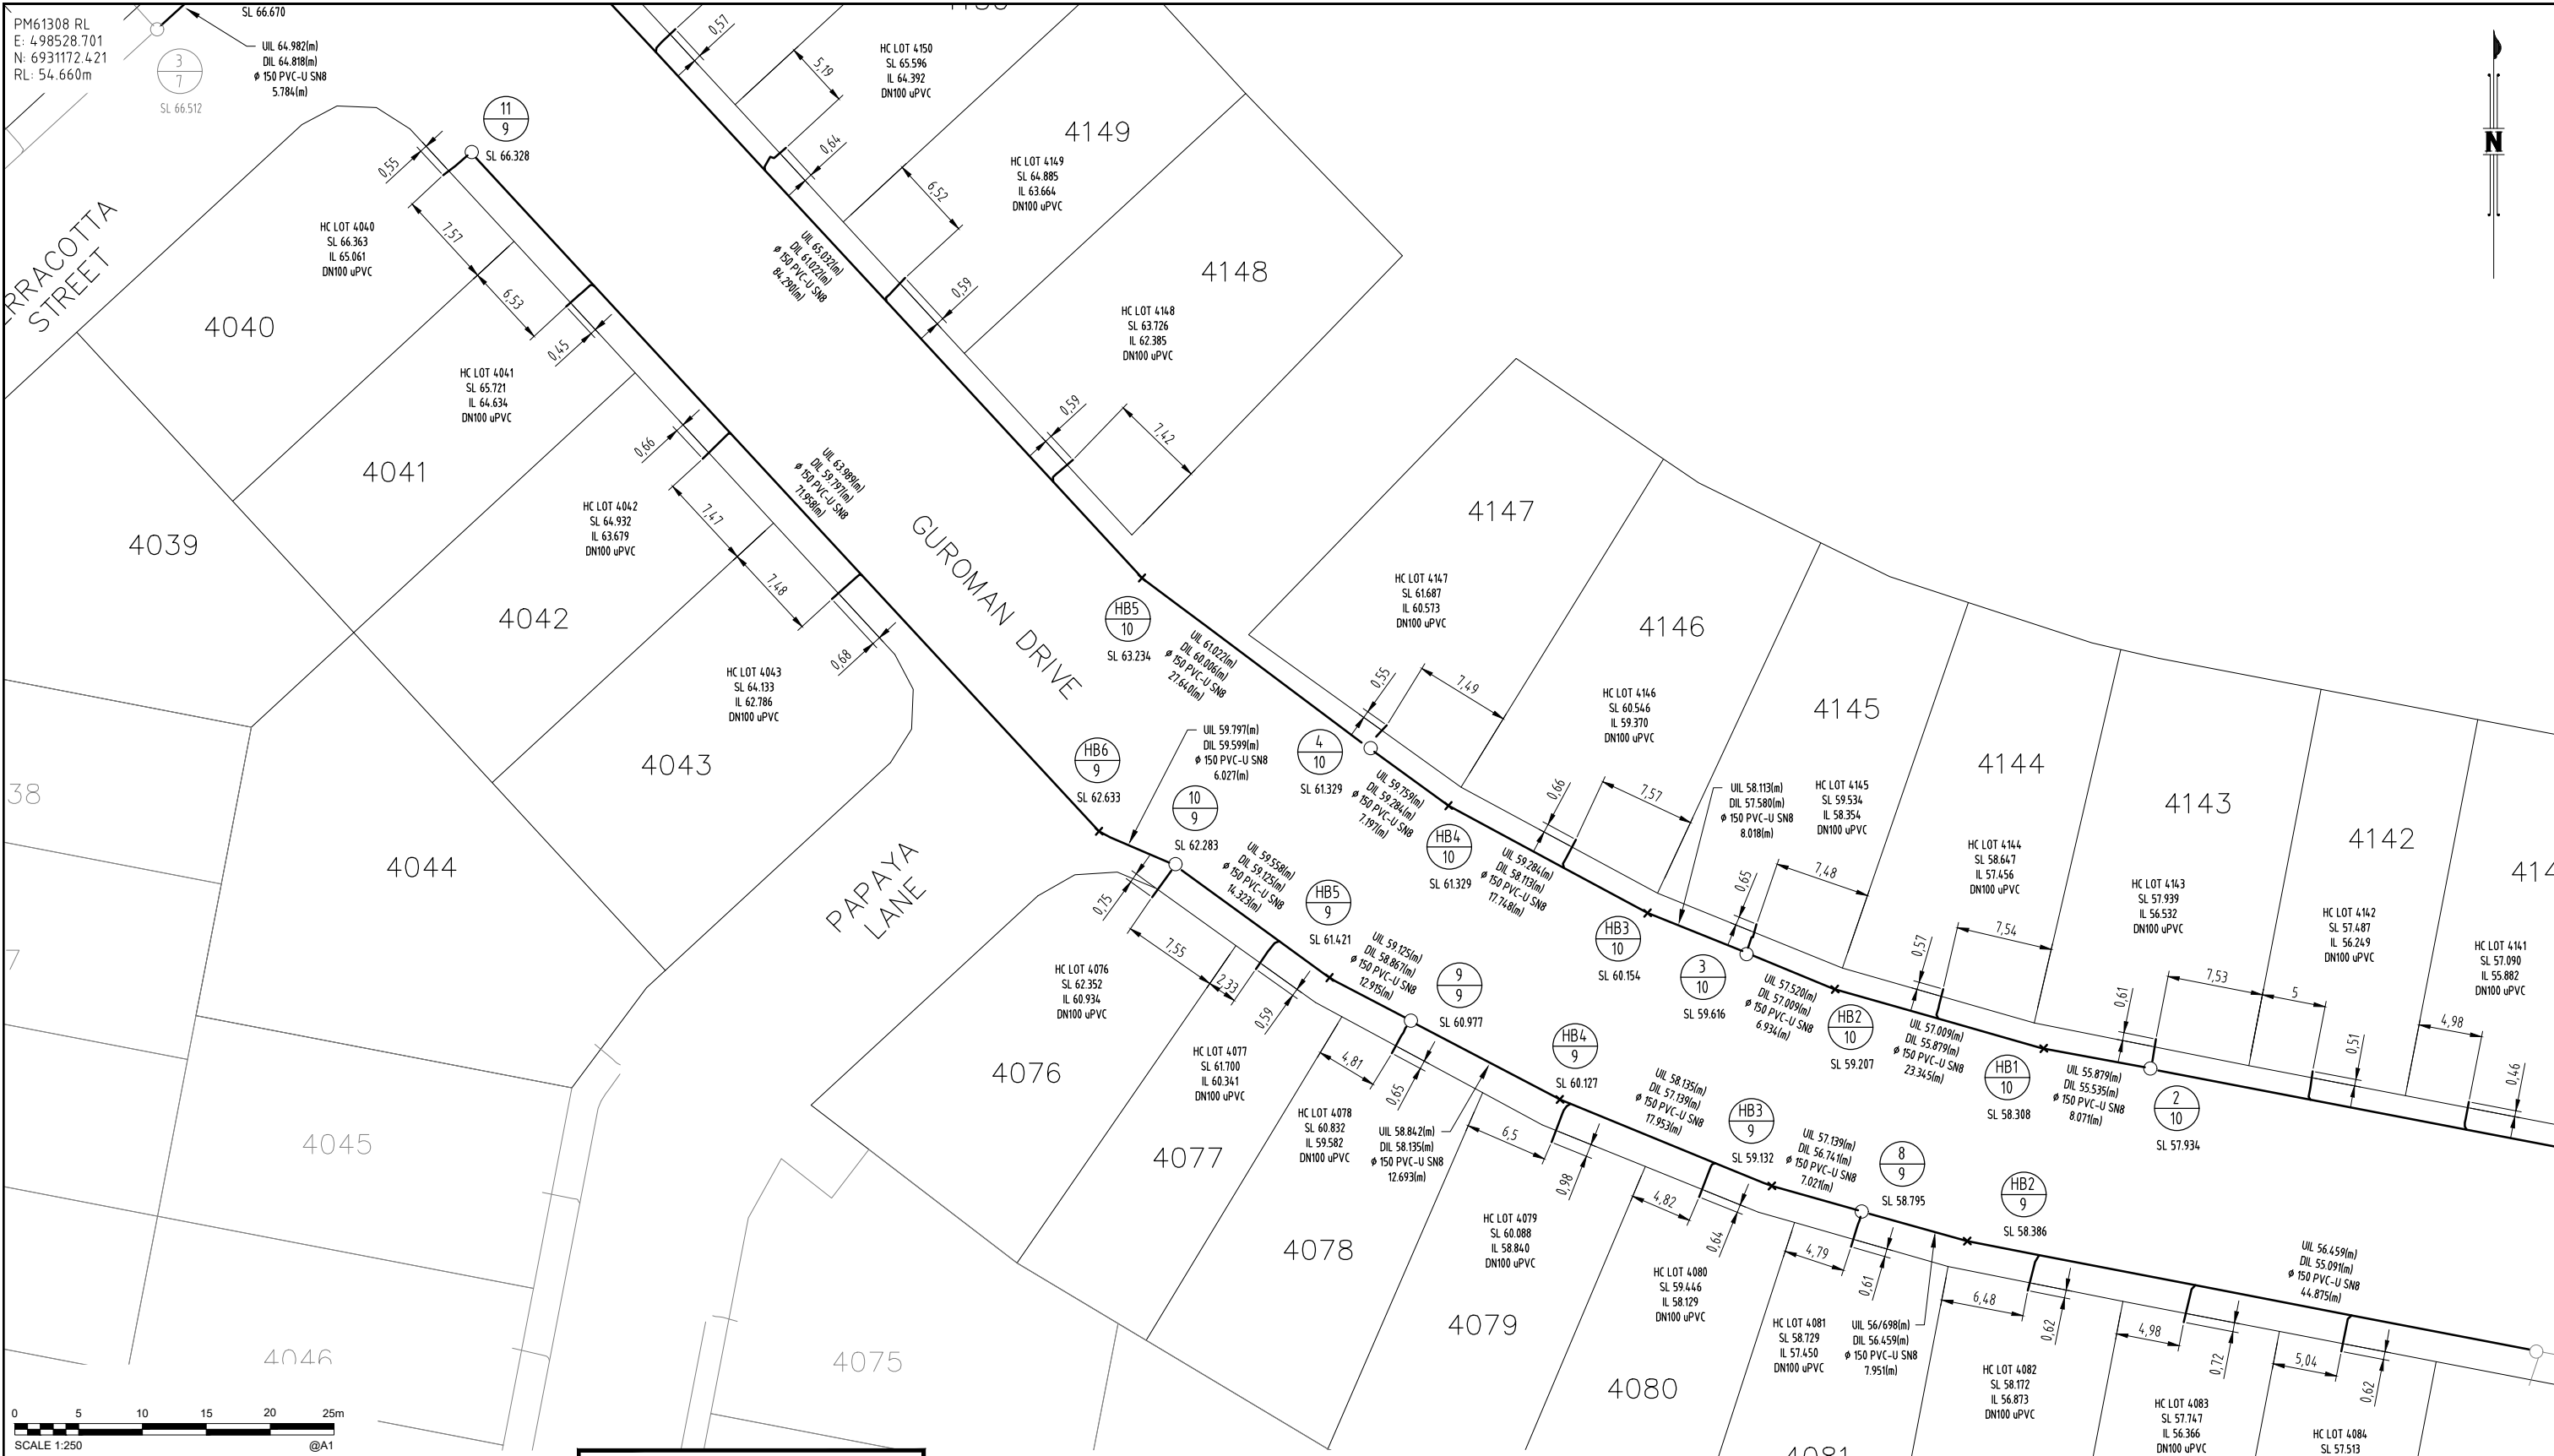


PM61308 RL
 E: 498528.701
 N: 6931172.421
 RL: 54.660m

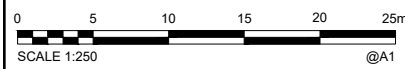

AS CONSTRUCTED

COORDINATE DATUM NOTE:
 HORIZONTAL COORDINATES(E,N) SUPPLIED ARE MAPPING GRID OF AUSTRALIA(MGA), ZONE 56 BASED ON THE UNIVERSAL TRANSVERSE MERCATOR PROJECTION AND THE GEOCENTRIC DATUM OF AUSTRALIA 2020.
 HORIZONTAL DATUM DERIVED FROM PSM 61308 E 498528.114 N 6931171.033.
 LEVELS SUPPLIED ARE ON THE AUSTRALIAN HEIGHT DATUM(AHD)
 LEVEL DATUM DERIVED FROM PSM 61308 RL54.660 (AHD)

ENGINEER'S CERTIFICATION
 I, _____, hereby certify that:
 1. The information contained in this drawing / document is in compliance with approved drawings and design.
 2. The new water and sewerage works defined by this drawing have been designed and constructed in accordance with the SEQ Code.
 3. This represents an accurate record of as-constructed works
 4. I accept responsibility for the information contained in this drawing / document.
 RPEQ (signature) RPEQ No. _____ Date: _____

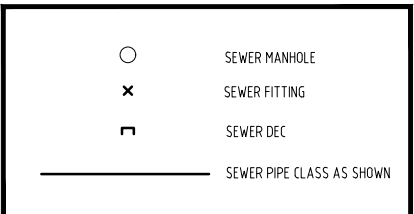


REGISTERED SURVEYING ASSOCIATE CERTIFICATION
 I, Stephen Seipel, hereby certify that the vertical and horizontal locations and dimensions shown on this plan are a true and correct record and were located by survey.
 Registered Surveying Associate (sig) Surveyor No. SA 7312 Date: 17/07/2024

A1	INDEX	DATE	AS CONSTRUCTED	DRAWN	CHECKED	PASSED	DRAWN	CHECKED	PASSED

LOGAN CITY COUNCIL
 MIRVAC MIR-1002
 AS CONSTRUCTED SURVEY - SEWER
 EVERLEIGH PRECINCT 10.2C
 GREENBANK QLD

SHEET 3 OF 5 SHEETS	SCALE 1:250 A1
REVISION DATE	REVISION
DISCIPLINE CODE	
DRAWING NO.	
ASC-SEWER-03-10.2C	


PM61308 RL
 E: 498528.701
 N: 6931172.421
 RL: 54.660m

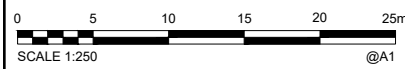

AS CONSTRUCTED

COORDINATE DATUM NOTE:
 HORIZONTAL COORDINATES(E,N) SUPPLIED ARE MAPPING GRID OF AUSTRALIA(MGA), ZONE 56 BASED ON THE UNIVERSAL TRANSVERSE MERCATOR PROJECTION AND THE GEOCENTRIC DATUM OF AUSTRALIA 2020.
 HORIZONTAL DATUM DERIVED FROM PSM 61308 E 498528.114 N 6931171.033.
 LEVELS SUPPLIED ARE ON THE AUSTRALIAN HEIGHT DATUM(AHD)
 LEVEL DATUM DERIVED FROM PSM 61308 RL54.660 (AHD)

ENGINEER'S CERTIFICATION
 I, _____ hereby certify that:
 1. The information contained in this drawing / document is in compliance with approved drawings and design.
 2. The new water and sewerage works defined by this drawing have been designed and constructed in accordance with the SEQ Code.
 3. This represents an accurate record of as-constructed works.
 4. I accept responsibility for the information contained in this drawing / document.
 RPEQ (signature) RPEQ No. _____ Date: _____

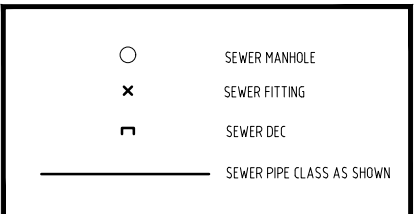

REGISTERED SURVEYING ASSOCIATE CERTIFICATION
 I, Stephen Seigel, hereby certify that the vertical and horizontal locations and dimensions shown on this plan are a true and correct record and were located by survey.
 Registered Surveying Associate (sig) Surveyor No. SA 7312 Date: 17/07/2024

A1	INDEX	DATE	AS CONSTRUCTED	DRAWN	CHECKED	PASSED
			REVISIONS			

DRAWN	RDE	17/07/2024
CHECKED	DAM	17/07/2024
PASSED		
INITIALS	DATE	




LOGAN CITY COUNCIL
 MIRVAC MIR-1002
 AS CONSTRUCTED SURVEY - SEWER
 EVERLEIGH PRECINCT 10.2C
 GREENBANK QLD

SHEET 4 OF 5 SHEETS	SCALE 1:250 A1
REVISION DATE	REVISION
DISCIPLINE CODE	
DRAWING NO.	ASC-SEWER-04-10.2C

PM61308 RL
E: 498528.701
N: 6931172.421
RL: 54.660m


067

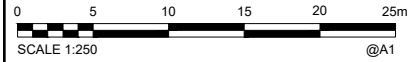

AS CONSTRUCTED

COORDINATE DATUM NOTE:
HORIZONTAL COORDINATES(E,N) SUPPLIED ARE MAPPING GRID OF AUSTRALIA(MGA), ZONE 56 BASED ON THE UNIVERSAL TRANSVERSE MERCATOR PROJECTION AND THE GEOCENTRIC DATUM OF AUSTRALIA 2020.
HORIZONTAL DATUM DERIVED FROM PSM 61308 E 498528.114 N 6931171.033.
LEVELS SUPPLIED ARE ON THE AUSTRALIAN HEIGHT DATUM(AHD)
LEVEL DATUM DERIVED FROM PSM 61308 RL54.660 (AHD)

ENGINEER'S CERTIFICATION
I, _____, hereby certify that:
1. The information contained in this drawing / document is in compliance with approved drawings and design.
2. The new water and sewerage works defined by this drawing have been designed and constructed in accordance with the SEQ Code.
3. This represents an accurate record of as-constructed works.
4. I accept responsibility for the information contained in this drawing / document.
RPEQ (signature) RPEQ No. _____ Date: _____

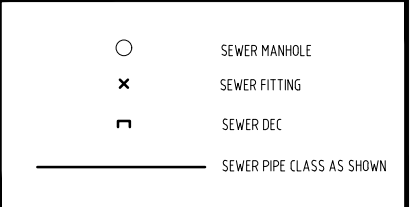

REGISTERED SURVEYING ASSOCIATE CERTIFICATION
I, Stephen Seipel, hereby certify that the vertical and horizontal locations and dimensions shown on this plan are a true and correct record and were located by survey.
Registered Surveying Associate (sig) SA 7312 Date: 17/07/2024

A1	INDEX	DATE	AS CONSTRUCTED	DRAWN	CHECKED	PASSED

DRAWN	RDE	17/07/2024
CHECKED	DAM	17/07/2024
PASSED		
INITIALS	DATE	



LOGAN CITY COUNCIL
MIRVAC MIR-1002
AS CONSTRUCTED SURVEY - SEWER
EVERLEIGH PRECINCT 10.2C
GREENBANK QLD

SHEET 5 OF 5 SHEETS	SCALE 1:250 A1
REVISION DATE	REVISION
DISCIPLINE CODE	
DRAWING NO.	ASC-SEWER-05-10.2C