


PM61308 RL
 E: 498528.701
 N: 6931172.421
 RL: 54.660m



AS CONSTRUCTED

ENGINEER'S CERTIFICATION
 I, _____, hereby certify that:
 1. The information contained in this drawing / document is in compliance with approved drawings and design.
 2. The new water and sewerage works defined by this drawing have been designed and constructed in accordance with the SEQ Code.
 3. This represents an accurate record of as-constructed works.
 4. I accept responsibility for the information contained in this drawing / document.


 RPEQ (signature) RPEQ No. _____ Date: _____

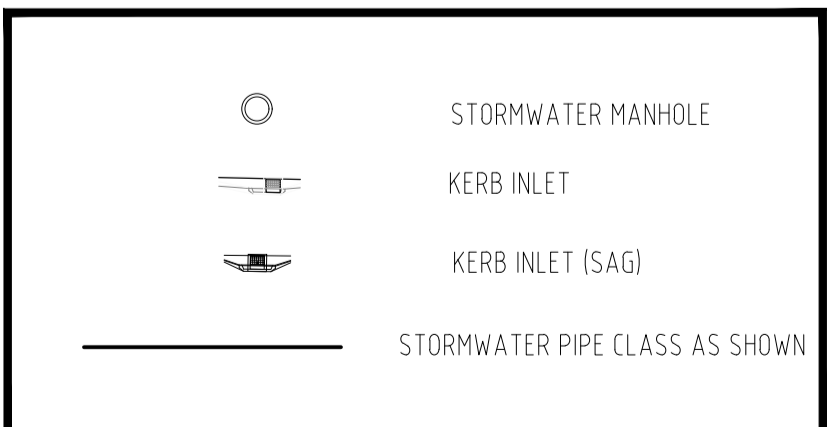

REGISTERED SURVEYING ASSOCIATE CERTIFICATION
 I, Stephen Seipel, hereby certify that the vertical and horizontal locations and dimensions shown on this plan are a true and correct record and were located by survey.

 Registered Surveying Associate (sig) Surveyor No. SA 7312 Date: 28/08/2024

COORDINATE DATUM NOTE:
 HORIZONTAL COORDINATES(E,N) SUPPLIED ARE MAPPING GRID OF AUSTRALIA(MGA), ZONE 56 BASED ON THE UNIVERSAL TRANSVERSE MERCATOR PROJECTION AND THE GEOCENTRIC DATUM OF AUSTRALIA 2020.
 HORIZONTAL DATUM DERIVED FROM PSM 61308 E 498528.114 N 6931171.033.
 LEVELS SUPPLIED ARE ON THE AUSTRALIAN HEIGHT DATUM(AHD)
 LEVEL DATUM DERIVED FROM PSM 61308 RL54.660 (AHD)

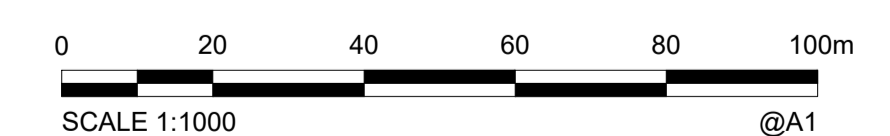



A1	INDEX	DATE	AS CONSTRUCTED	DRAWN	CHECKED	PASSED	DRAWN	CHECKED	PASSED	INITIALS	DATE



LOGAN CITY COUNCIL
 MIRVAC MIR-1002
 AS CONSTRUCTED SURVEY - STORMWATER
 EVERLEIGH PRECINCT 10.2C
 GREENBANK QLD


SHEET 1 OF 4 SHEETS	SCALE 1:1000 A1
REVISION DATE -	REVISION -
DISCIPLINE CODE -	
DRAWING NO. ASC-STORMWATER-01-10.2C	

PM61308 RL
 E: 498528.701
 N: 6931172.421
 RL: 54.660m

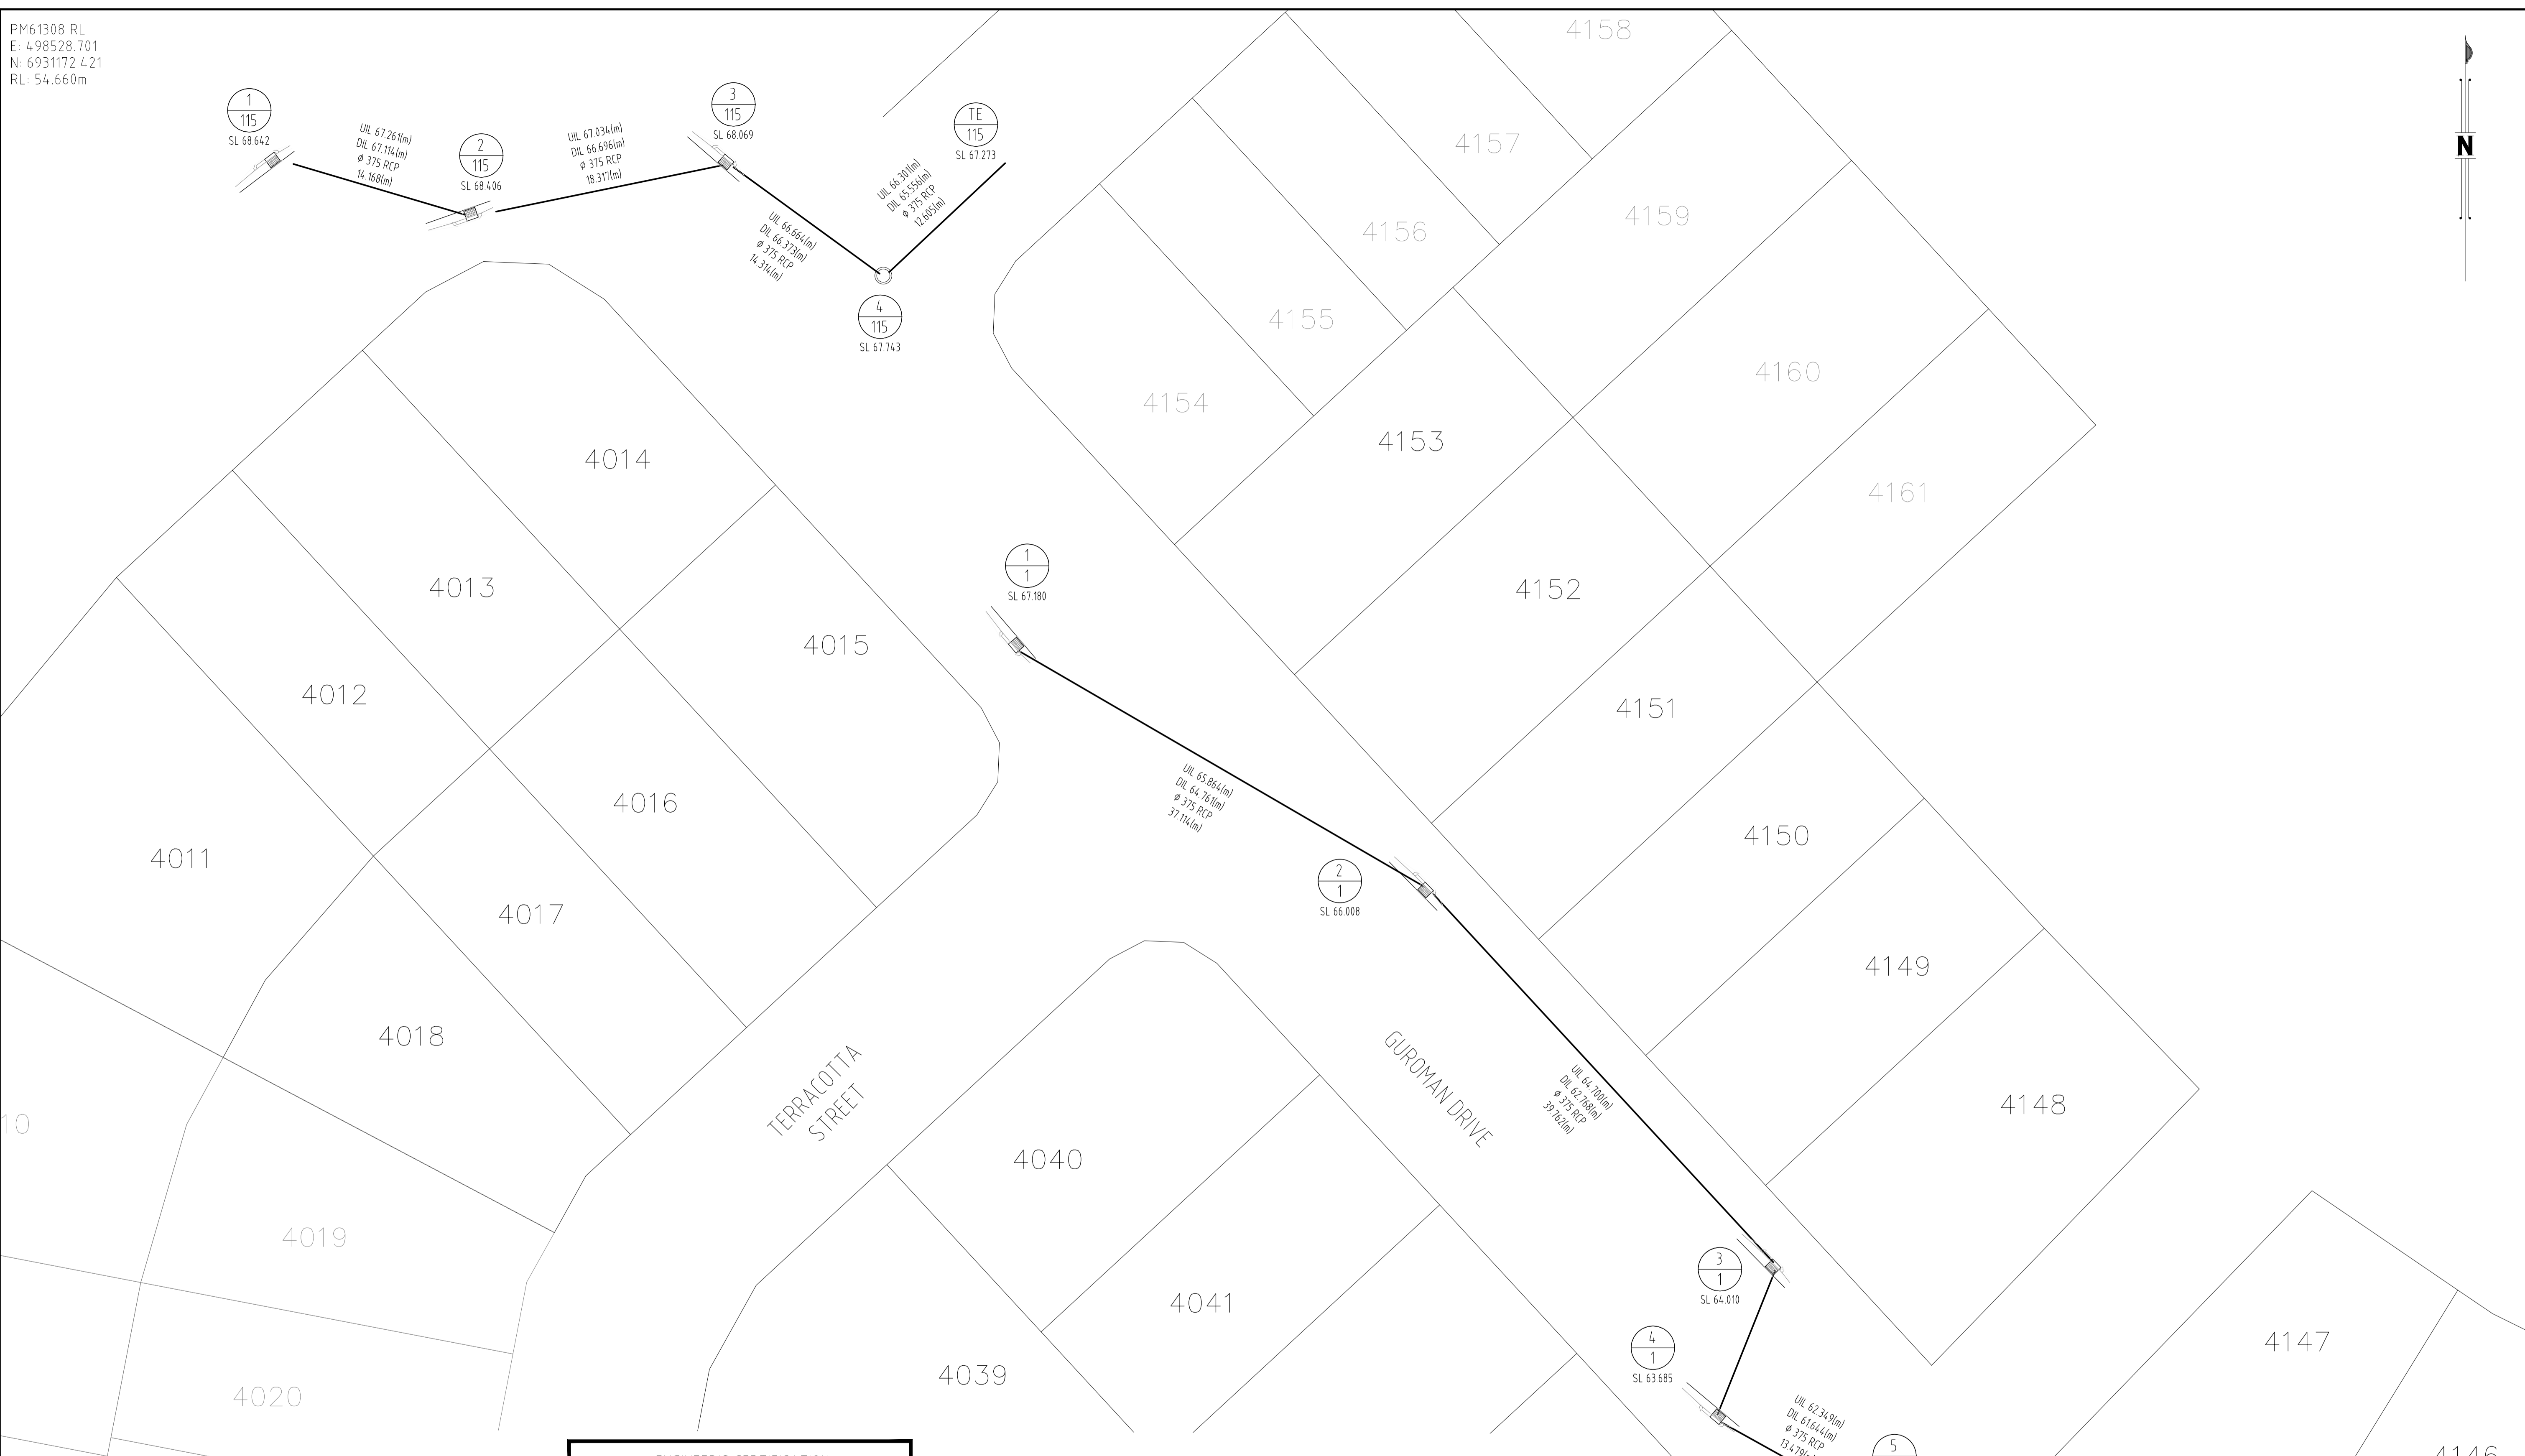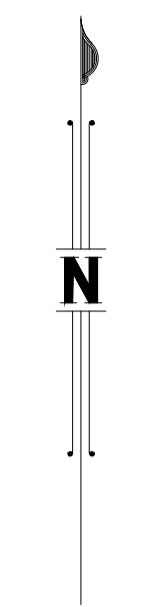

AS CONSTRUCTED

ENGINEER'S CERTIFICATION
 I, _____ hereby certify that:
 1. The information contained in this drawing / document is in compliance with approved drawings and design.
 2. The new water and sewerage works defined by this drawing have been designed and constructed in accordance with the SEQ Code.
 3. This represents an accurate record of as-constructed works.
 4. I accept responsibility for the information contained in this drawing / document.
 RPEQ (signature) RPEQ No. _____ Date: _____

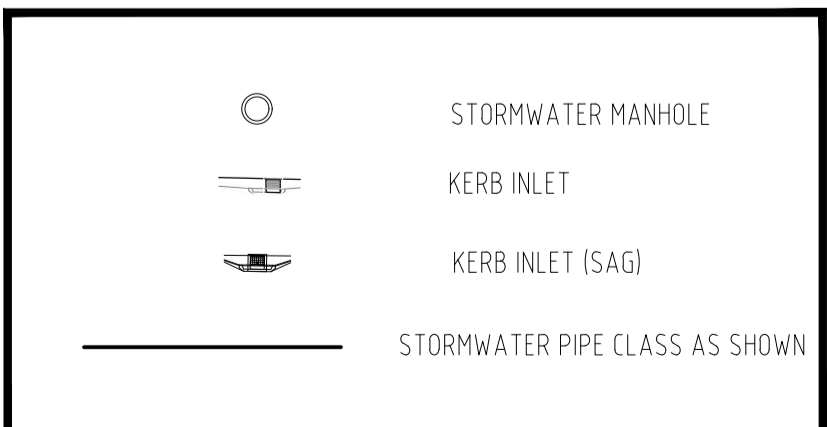

REGISTERED SURVEYING ASSOCIATE CERTIFICATION
 I, Stephen Seipel, hereby certify that the vertical and horizontal locations and dimensions shown on this plan are a true and correct record and were located by survey.
 Registered Surveying Associate (sig) Surveyor No. SA 7312 Date: 28/08/2024

COORDINATE DATUM NOTE:
 HORIZONTAL COORDINATES(E,N) SUPPLIED ARE MAPPING GRID OF AUSTRALIA(MGA), ZONE 56 BASED ON THE UNIVERSAL TRANSVERSE MERCATOR PROJECTION AND THE GEOCENTRIC DATUM OF AUSTRALIA 2020.
 HORIZONTAL DATUM DERIVED FROM PSM 61308 E 498528.114 N 6931171.033.
 LEVELS SUPPLIED ARE ON THE AUSTRALIAN HEIGHT DATUM(AHD)
 LEVEL DATUM DERIVED FROM PSM 61308 RL54.660 (AHD)




A1	INDEX	DATE	AS CONSTRUCTED	DRAWN	CHECKED	PASSED	DRAWN	CHECKED	PASSED	INITIALS	DATE




LOGAN CITY COUNCIL
 MIRVAC MIR-1002
 AS CONSTRUCTED SURVEY - STORMWATER
 EVERLEIGH PRECINCT 10.2C
 GREENBANK QLD

SHEET 2 OF 4 SHEETS	SCALE 1500 A1
REVISION DATE -	REVISION -
DISCIPLINE CODE -	
DRAWING NO. ASC-STORMWATER-02-10.2C	

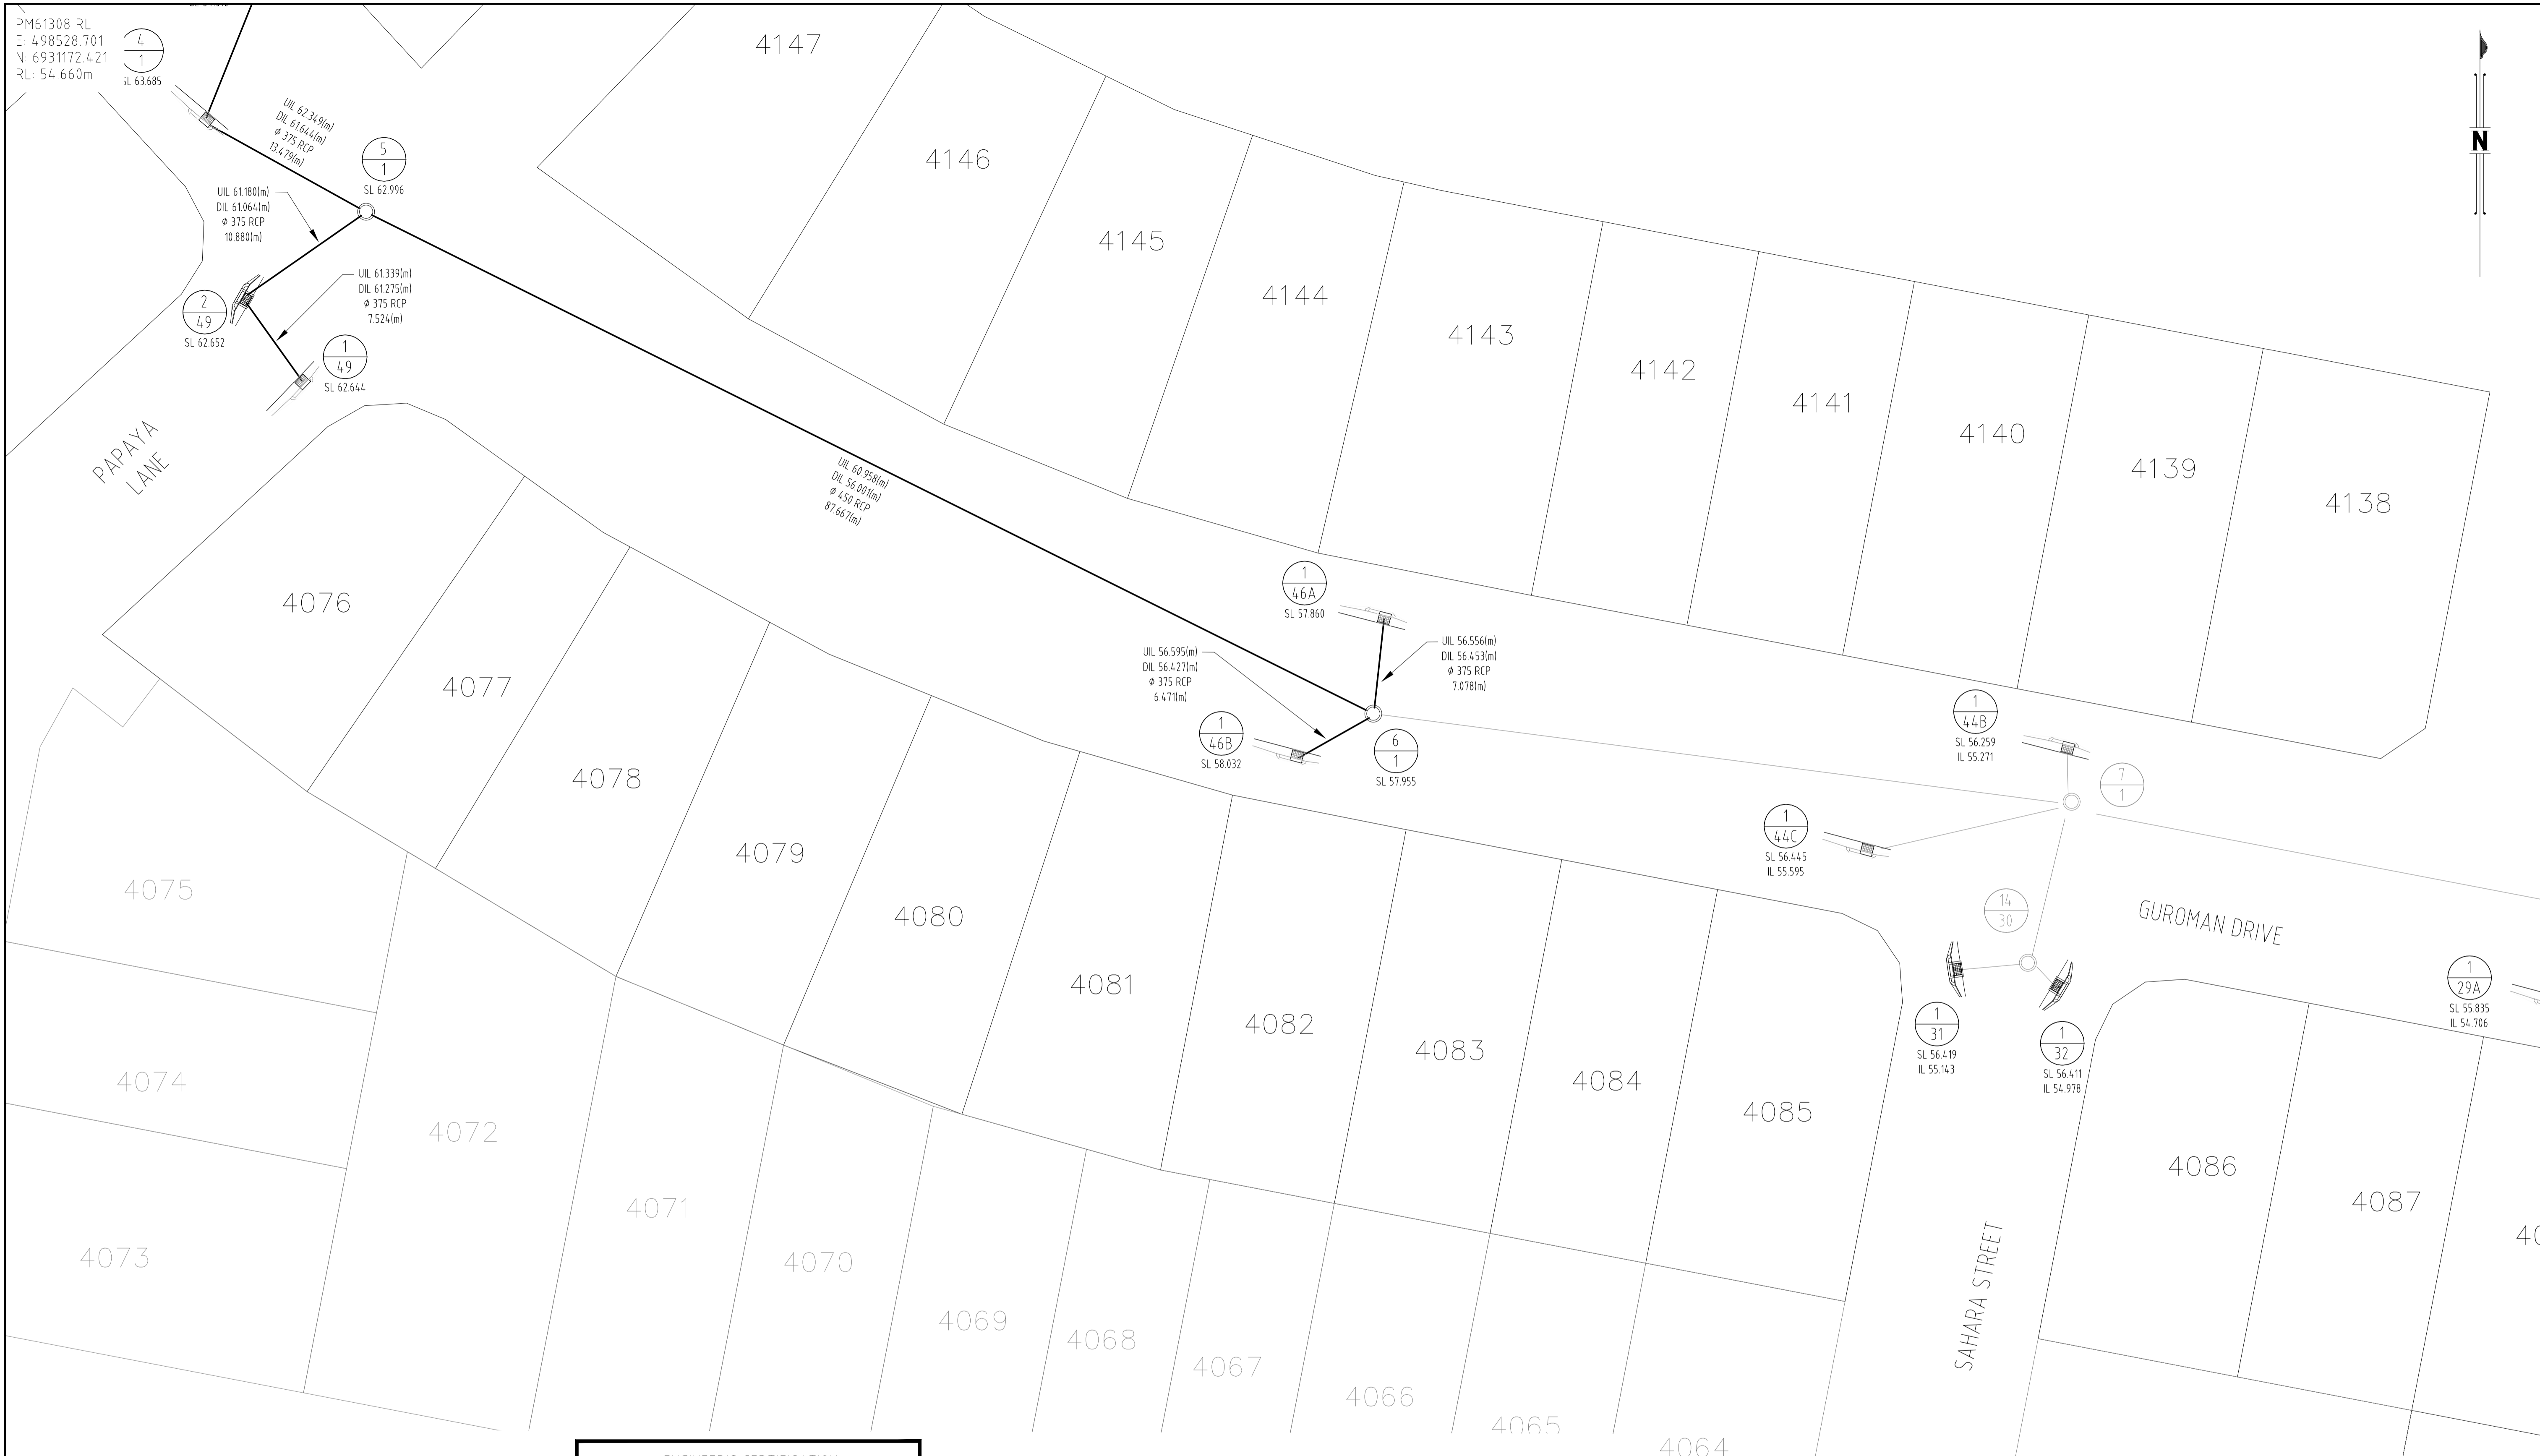

PM61308 RL
 E: 498528.701
 N: 6931172.421
 RL: 54.660m

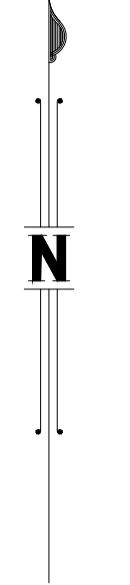


AS CONSTRUCTED

COORDINATE DATUM NOTE:
 HORIZONTAL COORDINATES(E,N) SUPPLIED ARE MAPPING GRID OF AUSTRALIA(MGA), ZONE 56 BASED ON THE UNIVERSAL TRANSVERSE MERCATOR PROJECTION AND THE GEOCENTRIC DATUM OF AUSTRALIA 2020.
 HORIZONTAL DATUM DERIVED FROM PSM 61308 E 498528.114 N 6931171.033.
 LEVELS SUPPLIED ARE ON THE AUSTRALIAN HEIGHT DATUM(AHD)
 LEVEL DATUM DERIVED FROM PSM 61308 RL54.660 (AHD)


ENGINEER'S CERTIFICATION
 I, _____ hereby certify that:
 1. The information contained in this drawing / document is in compliance with approved drawings and design.
 2. The new water and sewerage works defined by this drawing have been designed and constructed in accordance with the SEQ Code.
 3. This represents an accurate record of as-constructed works.
 4. I accept responsibility for the information contained in this drawing / document.

 RPEQ (signature) RPEQ No. _____ Date: _____

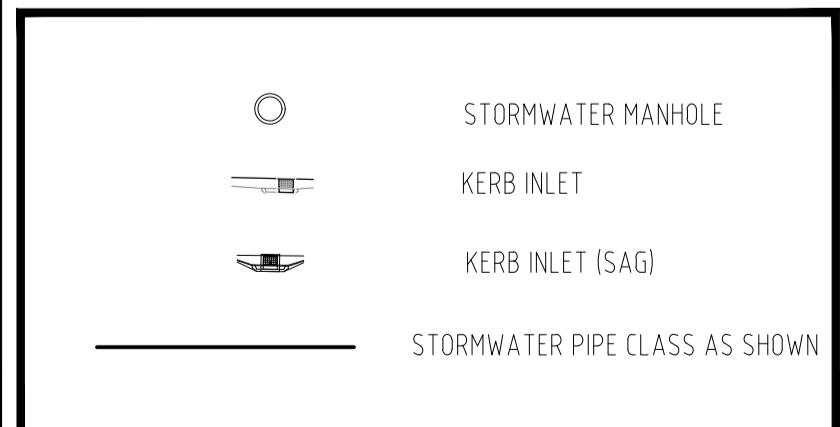

REGISTERED SURVEYING ASSOCIATE CERTIFICATION
 I, Stephen Seipel, hereby certify that the vertical and horizontal locations and dimensions shown on this plan are a true and correct record and were located by survey.

 Registered Surveying Associate (sig) Surveyor No. SA 7312 Date: 28/08/2024

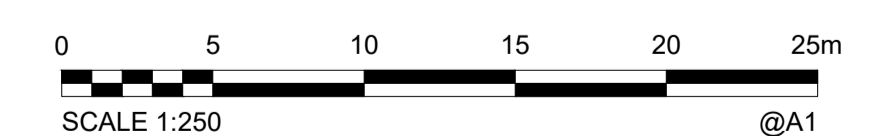

A1	INDEX	DATE	AS CONSTRUCTED	REVISIONS	DRAWN	CHECKED	PASSED	DRAWN	CHECKED	PASSED


DRAWN	RDE	30/08/2024
CHECKED	DAM	30/08/2024
PASSED		
INITIALS	DATE	



LOGAN CITY COUNCIL
 MIRVAC MIR-1002
 AS CONSTRUCTED SURVEY - STORMWATER
 EVERLEIGH PRECINCT 10.2C
 GREENBANK QLD

SHEET 3 OF 4 SHEETS	SCALE 1:250 A1
REVISION DATE -	REVISION -
DISCIPLINE CODE -	
DRAWING NO.	
ASC-STORMWATER-03-10.2C	

PM61308 RL
 E: 498528.701
 N: 6931172.421
 RL: 54.660m

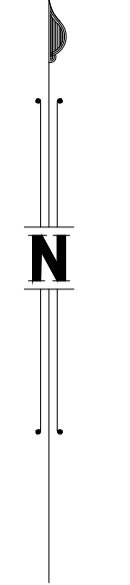


AS CONSTRUCTED

ENGINEER'S CERTIFICATION

I, _____, hereby certify that:
 1. The information contained in this drawing / document is in compliance with approved drawings and design.
 2. The new water and sewerage works defined by this drawing have been designed and constructed in accordance with the SEQ Code.
 3. This represents an accurate record of as-constructed works.
 4. I accept responsibility for the information contained in this drawing / document.

RPED (signature) _____ RPEQ No. _____ Date: _____

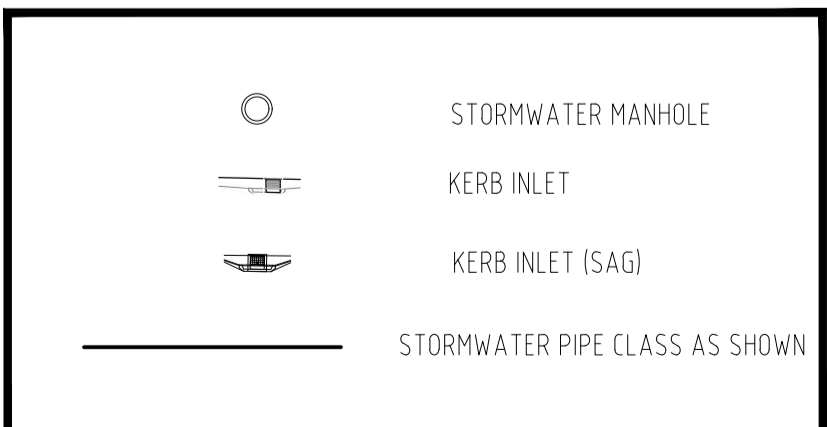

REGISTERED SURVEYING ASSOCIATE CERTIFICATION

I, Stephen Seipel, hereby certify that the vertical and horizontal locations and dimensions shown on this plan are a true and correct record and were located by survey.

Registered Surveying Associate (sig) _____ Surveyor No. SA 7312 Date: 28/08/2024

COORDINATE DATUM NOTE:
 HORIZONTAL COORDINATES(E,N) SUPPLIED ARE MAPPING GRID OF AUSTRALIA(MGA), ZONE 56 BASED ON THE UNIVERSAL TRANSVERSE MERCATOR PROJECTION AND THE GEOCENTRIC DATUM OF AUSTRALIA 2020.
 HORIZONTAL DATUM DERIVED FROM PSM 61308 E 498528.114 N 6931171.033.
 LEVELS SUPPLIED ARE ON THE AUSTRALIAN HEIGHT DATUM(AHD)
 LEVEL DATUM DERIVED FROM PSM 61308 RL54.660 (AHD)



A1	INDEX	DATE	AS CONSTRUCTED	DRAWN	CHECKED	PASSED	DRAWN	CHECKED	PASSED	INITIALS	DATE



LOGAN CITY COUNCIL

MIRVAC MIR-1002
 AS CONSTRUCTED SURVEY - STORMWATER
 EVERLEIGH PRECINCT 10.2C
 GREENBANK QLD

SHEET 4 OF 4 SHEETS	SCALE 1:250 A1
REVISION DATE -	REVISION -
DISCIPLINE CODE -	
DRAWING NO. ASC-STORMWATER-04-10.2C	