


PM61308 RL  
 E: 498528.701  
 N: 6931172.421  
 RL: 54.660m



**AS CONSTRUCTED**

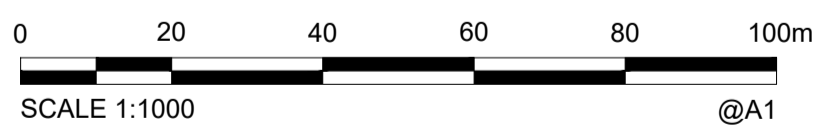

**REGISTERED SURVEYING ASSOCIATE CERTIFICATION**  
 I, Stephen Seipel, hereby certify that the vertical and horizontal locations and dimensions shown on this plan are a true and correct record and were located by survey.  
 Registered Surveying Associate (sig) Surveyor No. SA 7312 Date: 26/06/2024

**COORDINATE DATUM NOTE:**  
 HORIZONTAL COORDINATES (E, N) SUPPLIED ARE MAPPING GRID OF AUSTRALIA (MGA), ZONE 56 BASED ON THE UNIVERSAL TRANSVERSE MERCATOR PROJECTION AND THE GEOCENTRIC DATUM OF AUSTRALIA 2020.  
 HORIZONTAL DATUM DERIVED FROM PSM 61308 E 498528.114 N 6931171.033.  
 LEVELS SUPPLIED ARE ON THE AUSTRALIAN HEIGHT DATUM (AHD)  
 LEVEL DATUM DERIVED FROM PSM 61308 RL 54.660 (AHD)

- WATER METER BOX
- WATER REDUCER
- WATER BEND
- WATER TAPING BAND
- BV/SV WATER BALL VALVE/STOP VALVE
- WATER FIRE HYDRANT
- WATERMAIN LINE (SIZE AND CLASS AS SHOWN)

**ENGINEER'S CERTIFICATION**  
 I, \_\_\_\_\_, hereby certify that:  
 1. The information contained in this drawing / document is in compliance with approved drawings and design.  
 2. The new water and sewerage works defined by this drawing have been designed and constructed in accordance with the SEQ Code.  
 3. This represents an accurate record of as-constructed works.  
 4. I accept responsibility for the information contained in this drawing / document.  
 RPEQ (signature) RPEQ No. \_\_\_\_\_ Date: \_\_\_\_\_




<b>A1</b>	INDEX	DATE	AS CONSTRUCTED	DRAWN	CHECKED	PASSED	DRAWN	CHECKED	PASSED
				DRAWN	RDE	26/06/2024			
				CHECKED	DAM	26/06/2024			
				PASSED					
				INITIALS					
				DATE					



**LOGAN CITY COUNCIL**  
 MIRVAC MIR-1002  
 AS CONSTRUCTED SURVEY - WATERMAIN  
 EVERLEIGH PRECINCT 10.2C  
 GREENBANK QLD

SHEET 1 OF 5 SHEETS	SCALE 1:1000 A1
REVISION DATE 26/06/2024	REVISION -
DISCIPLINE CODE -	
DRAWING NO. ASC-WATERMAIN-01-10.2C	

PM61308 RL  
 E: 498528.701  
 N: 6931172.421  
 RL: 54.660m

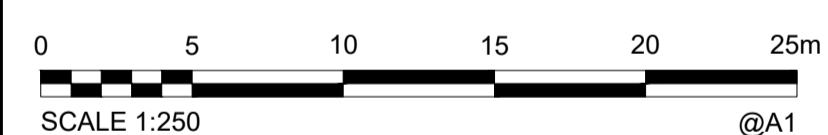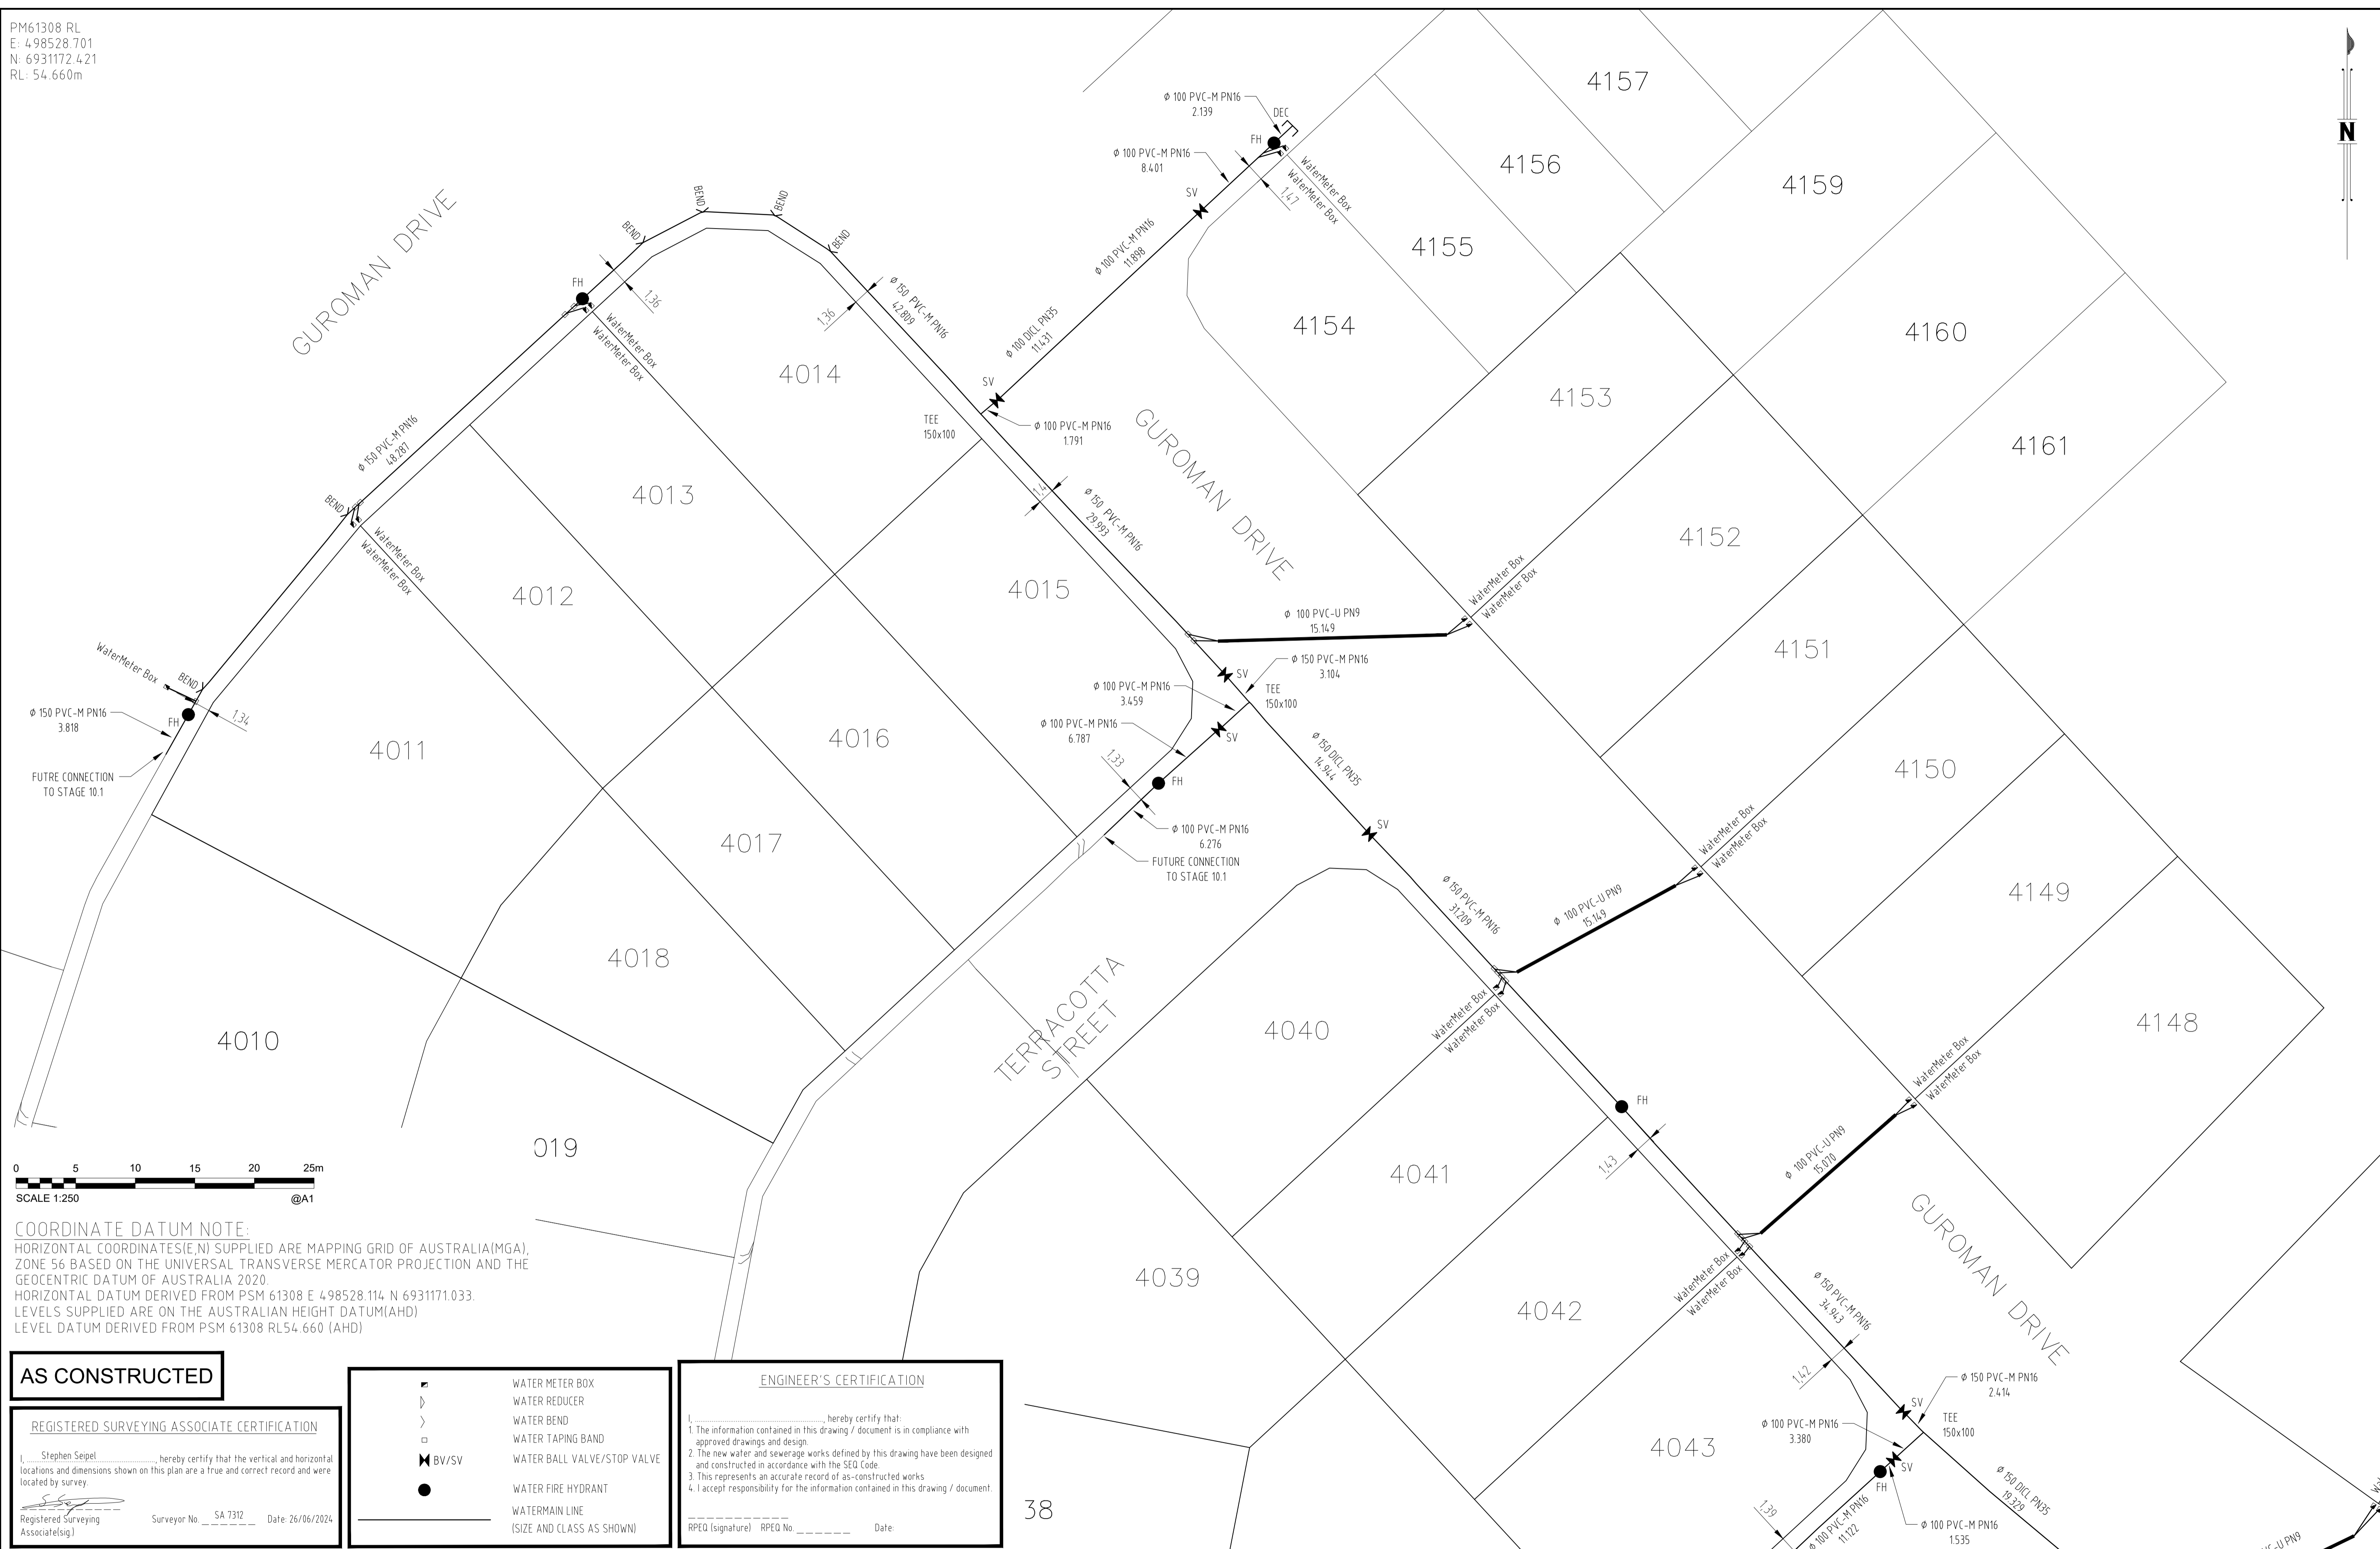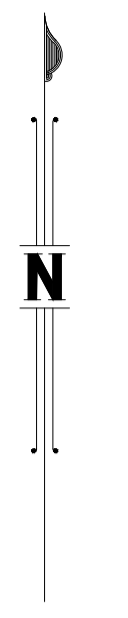

**COORDINATE DATUM NOTE:**  
 HORIZONTAL COORDINATES(E,N) SUPPLIED ARE MAPPING GRID OF AUSTRALIA(MGA), ZONE 56 BASED ON THE UNIVERSAL TRANSVERSE MERCATOR PROJECTION AND THE GEOCENTRIC DATUM OF AUSTRALIA 2020.  
 HORIZONTAL DATUM DERIVED FROM PSM 61308 E 498528.114 N 6931171.033.  
 LEVELS SUPPLIED ARE ON THE AUSTRALIAN HEIGHT DATUM(AHD) LEVEL DATUM DERIVED FROM PSM 61308 RL54.660 (AHD)

**AS CONSTRUCTED**

**REGISTERED SURVEYING ASSOCIATE CERTIFICATION**  
 I, Stephen Seipel, hereby certify that the vertical and horizontal locations and dimensions shown on this plan are a true and correct record and were located by survey.  
 Registered Surveying Associate (sig) Surveyor No SA 7312 Date: 26/06/2024

- ◻ WATER METER BOX
- ◻ WATER REDUCER
- ◻ WATER BEND
- ◻ WATER TAPING BAND
- ◻ BV/SV WATER BALL VALVE/STOP VALVE
- WATER FIRE HYDRANT
- WATERMAIN LINE (SIZE AND CLASS AS SHOWN)

**ENGINEER'S CERTIFICATION**

I, \_\_\_\_\_ hereby certify that:  
 1. The information contained in this drawing / document is in compliance with approved drawings and design.  
 2. The new water and sewerage works defined by this drawing have been designed and constructed in accordance with the SEQ Code.  
 3. This represents an accurate record of as-constructed works.  
 4. I accept responsibility for the information contained in this drawing / document.  
 RPEQ (signature) RPEQ No. \_\_\_\_\_ Date: \_\_\_\_\_


A1	INDEX	DATE	AS CONSTRUCTED	DRAWN	CHECKED	PASSED	DRAWN	CHECKED	PASSED

99 Sandalwood Lane, Forest Glen QLD 4056  
 Ph: 07 5438 3300 > F: 07 5438 3388 > E: acs@shadforth.com.au

**LOGAN CITY COUNCIL**  
 MIRVAC MIR-1002  
 AS CONSTRUCTED SURVEY - WATERMAIN  
 EVERLEIGH PRECINCT 10.2C  
 GREENBANK QLD

SHEET 2 OF 5 SHEETS	SCALE 1:250 A1
REVISION DATE 26/06/2024	REVISION -
DISCIPLINE CODE -	
DRAWING NO. ASC-WATERMAIN-02-10.2C	



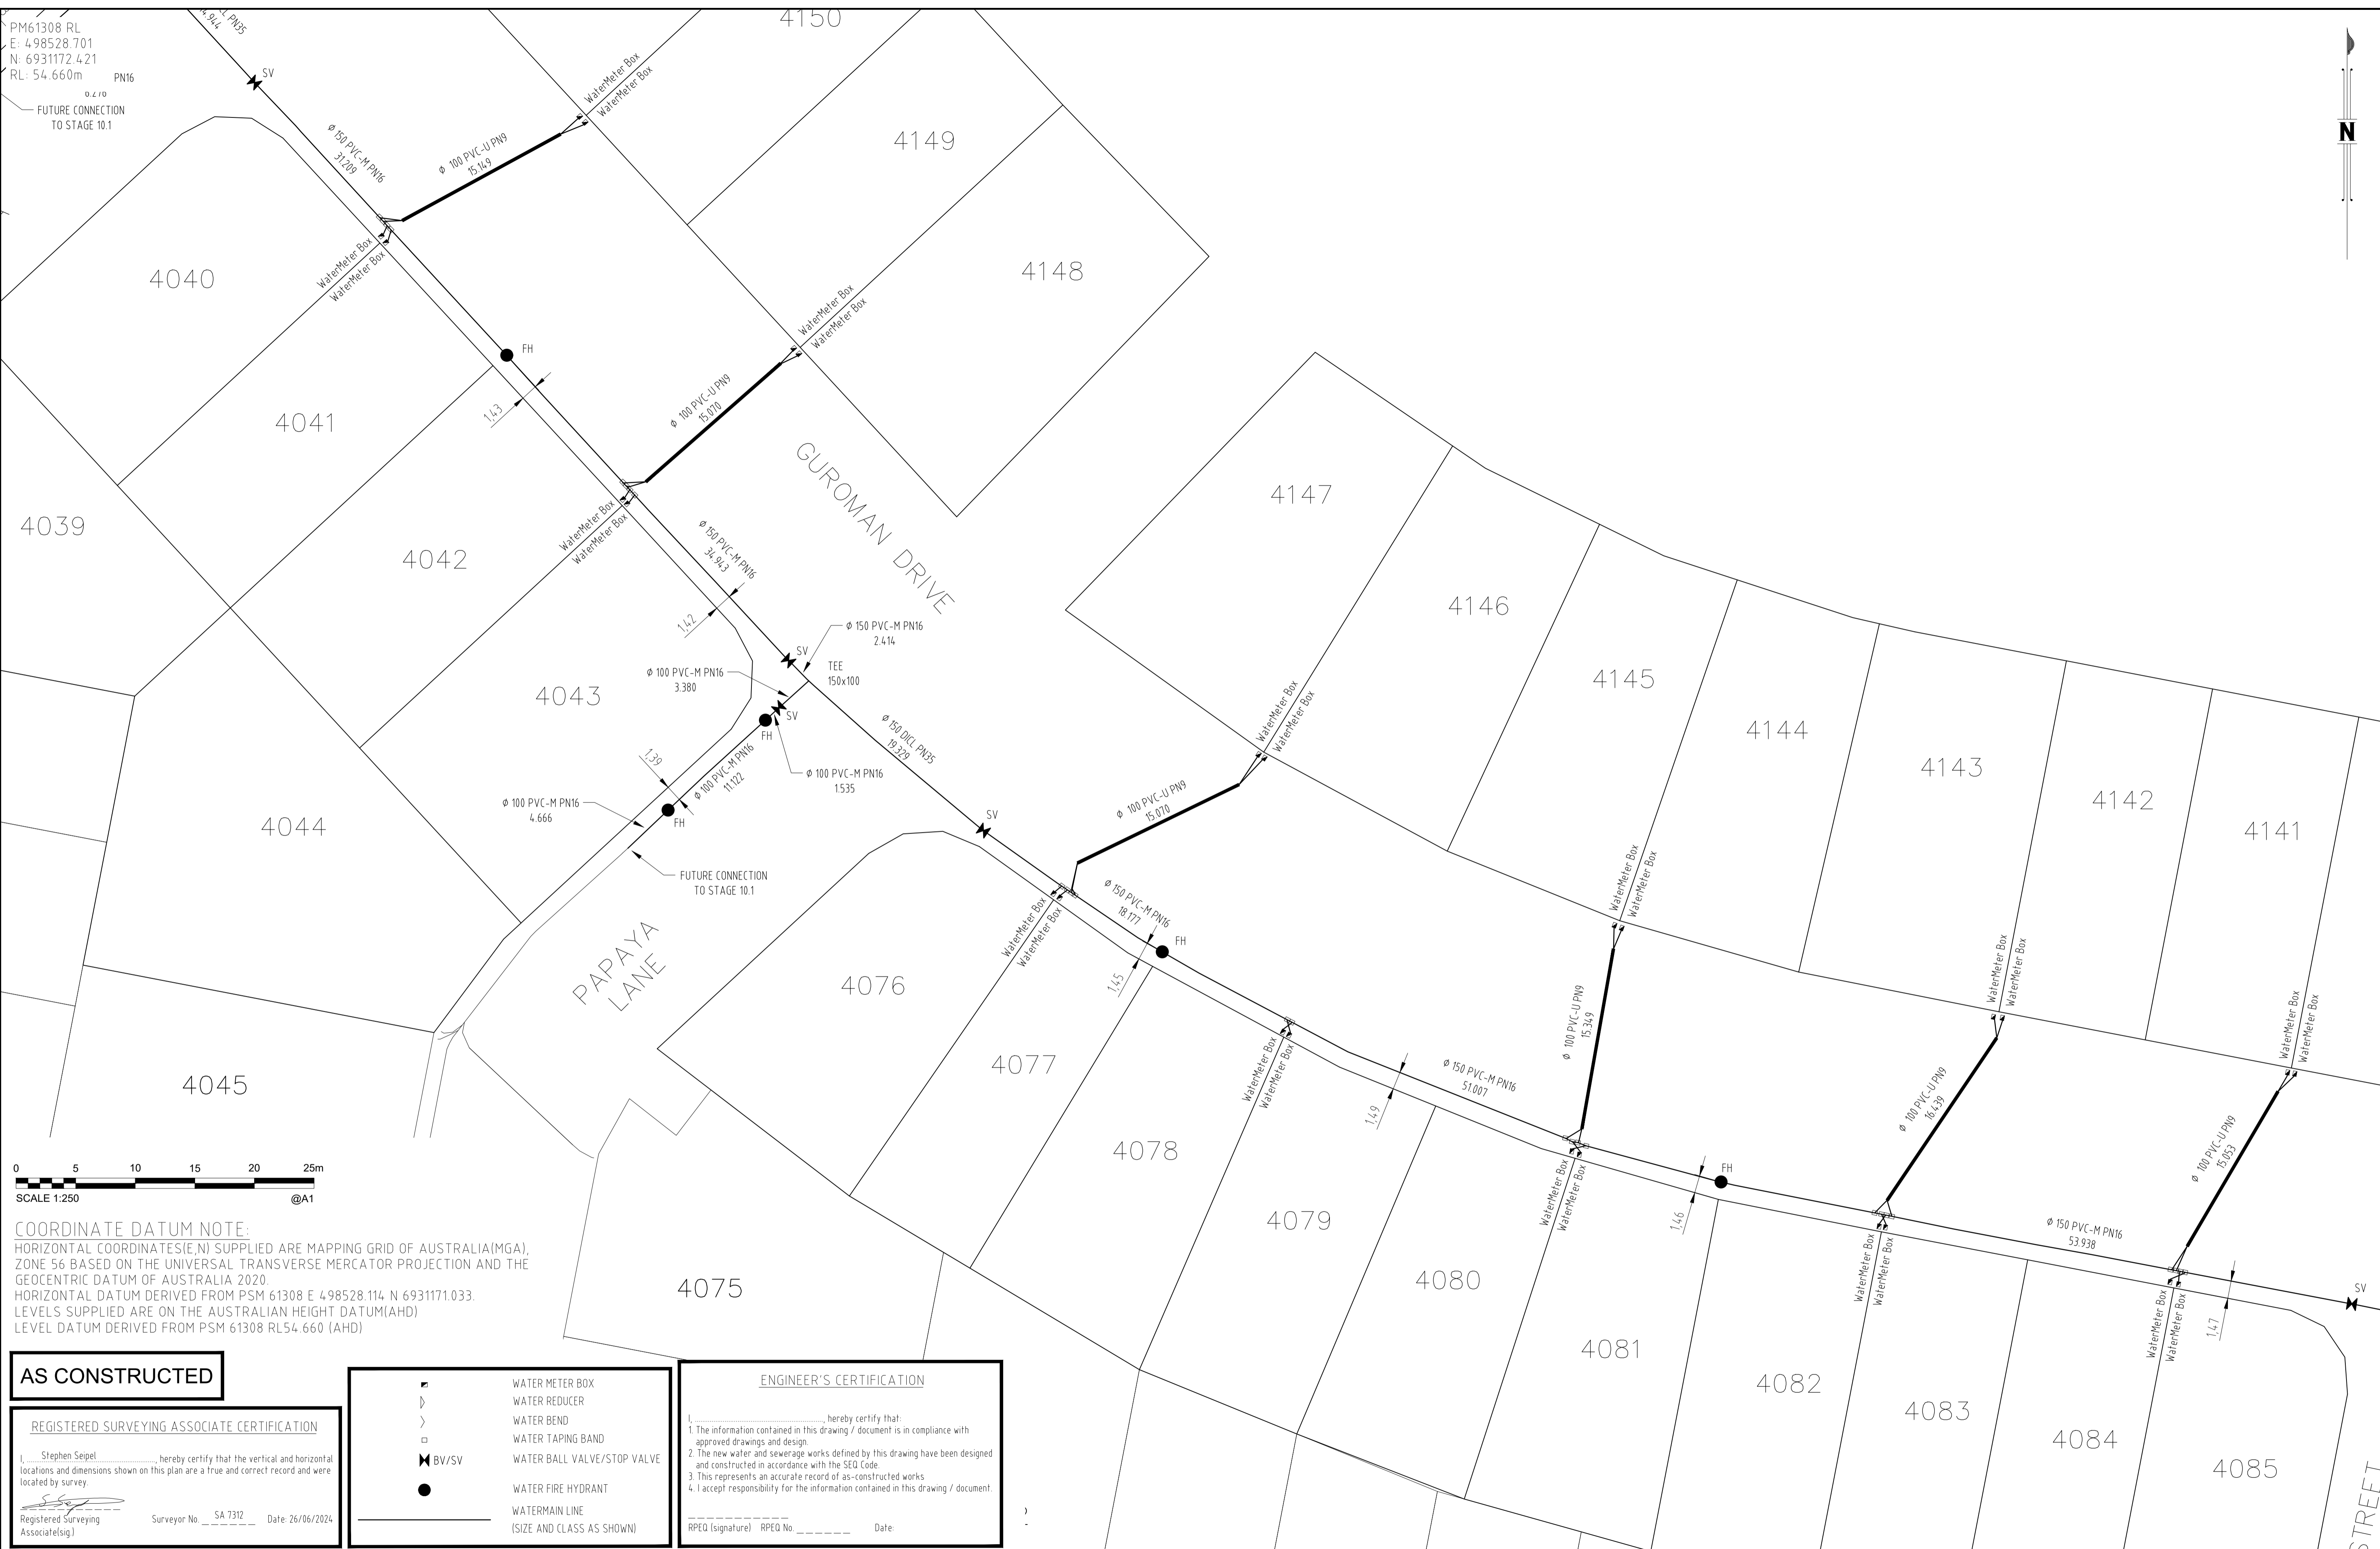

PM61308 RL  
 E: 498528.701  
 N: 6931172.421  
 RL: 54.660m

FUTURE CONNECTION  
 TO STAGE 10.1



**COORDINATE DATUM NOTE:**  
 HORIZONTAL COORDINATES(E,N) SUPPLIED ARE MAPPING GRID OF AUSTRALIA(MGA), ZONE 56 BASED ON THE UNIVERSAL TRANSVERSE MERCATOR PROJECTION AND THE GEOCENTRIC DATUM OF AUSTRALIA 2020.  
 HORIZONTAL DATUM DERIVED FROM PSM 61308 E 498528.114 N 6931171.033.  
 LEVELS SUPPLIED ARE ON THE AUSTRALIAN HEIGHT DATUM(AHD) LEVEL DATUM DERIVED FROM PSM 61308 RL54.660 (AHD)

**AS CONSTRUCTED**

**REGISTERED SURVEYING ASSOCIATE CERTIFICATION**

I, Stephen Seipel, hereby certify that the vertical and horizontal locations and dimensions shown on this plan are a true and correct record and were located by survey.  
 Registered Surveying Associate (sig) Surveyor No. SA 7312 Date: 26/06/2024

	WATER METER BOX
	WATER REDUCER
	WATER BEND
	WATER TAPING BAND
	WATER BALL VALVE/STOP VALVE
	WATER FIRE HYDRANT
	WATERMAIN LINE (SIZE AND CLASS AS SHOWN)

**ENGINEER'S CERTIFICATION**

I, \_\_\_\_\_, hereby certify that:  
 1. The information contained in this drawing / document is in compliance with approved drawings and design.  
 2. The new water and sewerage works defined by this drawing have been designed and constructed in accordance with the SEQ Code.  
 3. This represents an accurate record of as-constructed works.  
 4. I accept responsibility for the information contained in this drawing / document.  
 RPEQ (signature) RPEQ No. \_\_\_\_\_ Date: \_\_\_\_\_

<b>A1</b>	INDEX	DATE	AS CONSTRUCTED	DRAWN	CHECKED	PASSED	DRAWN	CHECKED	PASSED

DRAWN	RDE	26/06/2024
CHECKED	DAM	26/06/2024
PASSED		
INITIALS	DATE	




**LOGAN CITY COUNCIL**  
 MIRVAC MIR-1002  
 AS CONSTRUCTED SURVEY - WATERMAIN  
 EVERLEIGH PRECINCT 10.2C  
 GREENBANK QLD

SHEET 3 OF 5 SHEETS	SCALE 1:250 A1
REVISION DATE 26/06/2024	REVISION -
DISCIPLINE CODE -	
DRAWING NO. ASC-WATERMAIN-03-10.2C	

PM61308 RL  
 E: 498528.701  
 N: 6931172.421  
 RL: 54.660m



**AS CONSTRUCTED**

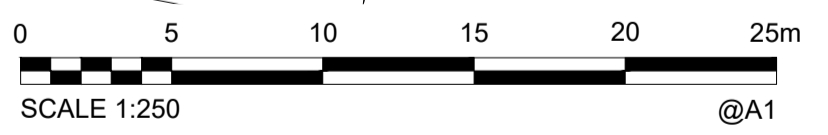

**REGISTERED SURVEYING ASSOCIATE CERTIFICATION**  
 I, Stephen Seipel, hereby certify that the vertical and horizontal locations and dimensions shown on this plan are a true and correct record and were located by survey.  
 Registered Surveying Associate (sig) Surveyor No. SA 7312 Date: 26/06/2024

**COORDINATE DATUM NOTE:**  
 HORIZONTAL COORDINATES (E, N) SUPPLIED ARE MAPPING GRID OF AUSTRALIA (MGA), ZONE 56 BASED ON THE UNIVERSAL TRANSVERSE MERCATOR PROJECTION AND THE GEOCENTRIC DATUM OF AUSTRALIA 2020.  
 HORIZONTAL DATUM DERIVED FROM PSM 61308 E 498528.114 N 6931171.033.  
 LEVELS SUPPLIED ARE ON THE AUSTRALIAN HEIGHT DATUM (AHD)  
 LEVEL DATUM DERIVED FROM PSM 61308 RLS4.660 (AHD)

- ◻ WATER METER BOX
- ◻ WATER REDUCER
- > WATER BEND
- ◻ WATER TAPING BAND
- ◻ BV/SV WATER BALL VALVE/STOP VALVE
- WATER FIRE HYDRANT
- WATERMAIN LINE (SIZE AND CLASS AS SHOWN)

**ENGINEER'S CERTIFICATION**  
 I, \_\_\_\_\_, hereby certify that:  
 1. The information contained in this drawing / document is in compliance with approved drawings and design.  
 2. The new water and sewerage works defined by this drawing have been designed and constructed in accordance with the SEQ Code.  
 3. This represents an accurate record of as-constructed works.  
 4. I accept responsibility for the information contained in this drawing / document.  
 RPEQ (signature) RPEQ No. \_\_\_\_\_ Date: \_\_\_\_\_

<b>A1</b>	INDEX	DATE	AS CONSTRUCTED	DRAWN	CHECKED	PASSED	DRAWN	CHECKED	PASSED

**shadforth**  
 99 Sandalwood Lane, Forest Glen QLD 4056  
 Ph: 07 5438 3300 > F: 07 5438 3388 > E: acs@shadforth.com.au



**LOGAN CITY COUNCIL**  
 MIRVAC MIR-1002  
 AS CONSTRUCTED SURVEY - WATERMAIN  
 EVERLEIGH PRECINCT 10.2C  
 GREENBANK QLD


SHEET 4 OF 5 SHEETS	SCALE 1:250 A1
REVISION DATE 26/06/2024	REVISION -
DISCIPLINE CODE -	
DRAWING NO. <b>ASC-WATERMAIN-04-10.2C</b>	



PM61308 RL  
 E: 498528.701  
 N: 6931172.421  
 RL: 54.660m



**AS CONSTRUCTED**

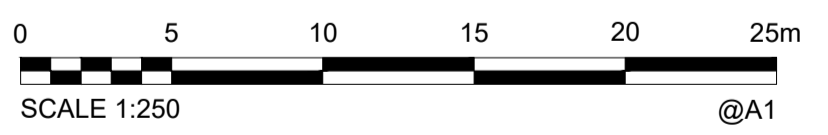

**REGISTERED SURVEYING ASSOCIATE CERTIFICATION**  
 I, Stephen Seipel, hereby certify that the vertical and horizontal locations and dimensions shown on this plan are a true and correct record and were located by survey.  
 Registered Surveying Associate (sig) Surveyor No. SA 7312 Date: 26/06/2024

**COORDINATE DATUM NOTE:**  
 HORIZONTAL COORDINATES (E, N) SUPPLIED ARE MAPPING GRID OF AUSTRALIA (MGA), ZONE 56 BASED ON THE UNIVERSAL TRANSVERSE MERCATOR PROJECTION AND THE GEOCENTRIC DATUM OF AUSTRALIA 2020.  
 HORIZONTAL DATUM DERIVED FROM PSM 61308 E 498528.114 N 6931171.033.  
 LEVELS SUPPLIED ARE ON THE AUSTRALIAN HEIGHT DATUM (AHD)  
 LEVEL DATUM DERIVED FROM PSM 61308 RL 54.660 (AHD)

- ▣ WATER METER BOX
- ▤ WATER REDUCER
- > WATER BEND
- ▣ WATER TAPING BAND
- ◻ BV/SV WATER BALL VALVE/STOP VALVE
- WATER FIRE HYDRANT
- WATERMAIN LINE (SIZE AND CLASS AS SHOWN)

**ENGINEER'S CERTIFICATION**  
 I, \_\_\_\_\_, hereby certify that:  
 1. The information contained in this drawing / document is in compliance with approved drawings and design.  
 2. The new water and sewerage works defined by this drawing have been designed and constructed in accordance with the SEQ Code.  
 3. This represents an accurate record of as-constructed works.  
 4. I accept responsibility for the information contained in this drawing / document.  
 RPEQ (signature) RPEQ No. \_\_\_\_\_ Date: \_\_\_\_\_

<b>A1</b>	INDEX	DATE	AS CONSTRUCTED	DRAWN	CHECKED	PASSED	DRAWN	CHECKED	PASSED
				DRAWN	RDE	26/06/2024			
				CHECKED	DAM	26/06/2024			
				PASSED					
				INITIALS	DATE				



**LOGAN CITY COUNCIL**  
 MIRVAC MIR-1002  
 AS CONSTRUCTED SURVEY - WATERMAIN  
 EVERLEIGH PRECINCT 10.2C  
 GREENBANK QLD

SHEET 5 OF 5 SHEETS	SCALE 1:250 A1
REVISION DATE 26/06/2024	REVISION -
DISCIPLINE CODE -	
DRAWING NO. ASC-WATERMAIN-05-10.2C	