

PARK LOT 824

AS CONSTRUCTED



COORDINATE DATUM NOTE:

HORIZONTAL COORDINATES (E, N) SUPPLIED ARE MAPPING GRID OF AUSTRALIA (MGA), ZONE 56 BASED ON THE UNIVERSAL TRANSVERSE MERCATOR PROJECTION AND THE GEOCENTRIC DATUM OF AUSTRALIA 2020.
 HORIZONTAL DATUM DERIVED FROM PSM 61308 E 498528 114 N 6931171.033
 LEVELS SUPPLIED ARE ON THE AUSTRALIAN HEIGHT DATUM (AHD) LEVEL DATUM DERIVED FROM PSM 61308 RL54.660 (AHD)

ENGINEER'S CERTIFICATION

I, _____, hereby certify that:

- The information contained in this drawing / document is in compliance with approved drawings and design.
- This represents an accurate record of as-constructed works
- I accept responsibility for the information contained in this drawing / document

RPEQ (signature) RPEQ No. _____ Date _____

REGISTERED SURVEYING ASSOCIATE CERTIFICATION

I, Stephen Seipel, hereby certify that the vertical and horizontal locations and dimensions shown on this plan are a true and correct record and were located by survey.

Stephen Seipel
 Registered Surveying Associate (sig) Surveyor No. SA 7312 Date: 30/08/2024

PAVEMENT DESIGN		
GUROMAN DRIVE	SAHARA STREET	TERRACOTTA STREET
AC(mm) - 50	AC(mm) - 35	AC(mm) - 35
BASE(2.1l(mm) - 300	BASE(2.1l(mm) - 150	BASE(2.1l(mm) - 150
SUBBASE(2.3l(mm) - 100	SUBBASE(2.3l(mm) - 150	SUBBASE(2.3l(mm) - 150
PEACE AVENUE	PAPAYA STREET	DRIVEWAY 11
AC(mm) - 35	AC(mm) - 35	AC(mm) - 35
BASE(2.1l(mm) - 150	BASE(2.1l(mm) - 150	BASE(2.1l(mm) - 150
SUBBASE(2.3l(mm) - 150	SUBBASE(2.3l(mm) - 150	SUBBASE(2.3l(mm) - 100
ROAD 115		
AC(mm) - 35		
BASE(2.1l(mm) - 150		
SUBBASE(2.3l(mm) - 150		
SPOT HEIGHTS	WALL HEIGHTS	RETAINING WALLS
+ 56.36	56.60	
	55.524	

A1	INDEX	DATE	AS CONSTRUCTED	REVISIONS	DRAWN	CHECKED	PASSED
	A	30/08/2024	AS CONSTRUCTED		RDE	DAM	CW

DRAWN	RDE	30/08/2024
CHECKED	DAM	30/08/2024
PASSED	CW	30/08/2024
INITIALS	DATE	





LOGAN CITY COUNCIL

MIRVAC MIR-1002
 AS CONSTRUCTED SURVEY - ROADS AND EARTHWORKS
 EVERLEIGH PRECINCT 10.2C
 GREENBANK QLD

SHEET 1 OF 5 SHEETS	SCALE 1:500 A1
REVISION DATE 30/08/2024	REVISION A
DISCIPLINE CODE -	
DRAWING NO. ASC-RDS AND EWKS-01-10.2C	



PAVEMENT DESIGN		
GUROMAN DRIVE	SAHARA STREET	TERRACOTTA STREET
AC(mm) - 50	AC(mm) - 35	AC(mm) - 35
BASE(2.1lmm) - 300	BASE(2.1lmm) - 150	BASE(2.1lmm) - 150
SUBBASE(2.3lmm) - 100	SUBBASE(2.3lmm) - 150	SUBBASE(2.3lmm) - 150
PEACE AVENUE	PAPAYA STREET	DRIVEWAY 11
AC(mm) - 50	AC(mm) - 35	AC(mm) - 35
BASE(2.1lmm) - 300	BASE(2.1lmm) - 150	BASE(2.1lmm) - 150
SUBBASE(2.3lmm) - 100	SUBBASE(2.3lmm) - 150	SUBBASE(2.3lmm) - 100
ROAD 115		
AC(mm) - 35		
BASE(2.1lmm) - 150		
SUBBASE(2.3lmm) - 150		
SPOT HEIGHTS	WALL HEIGHTS	RETAINING WALLS
+ 56.36	26.890	---
	55.524	---

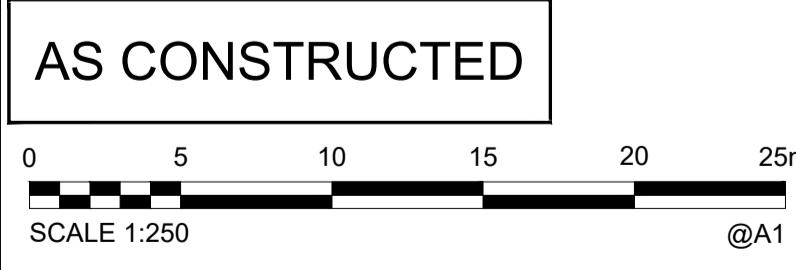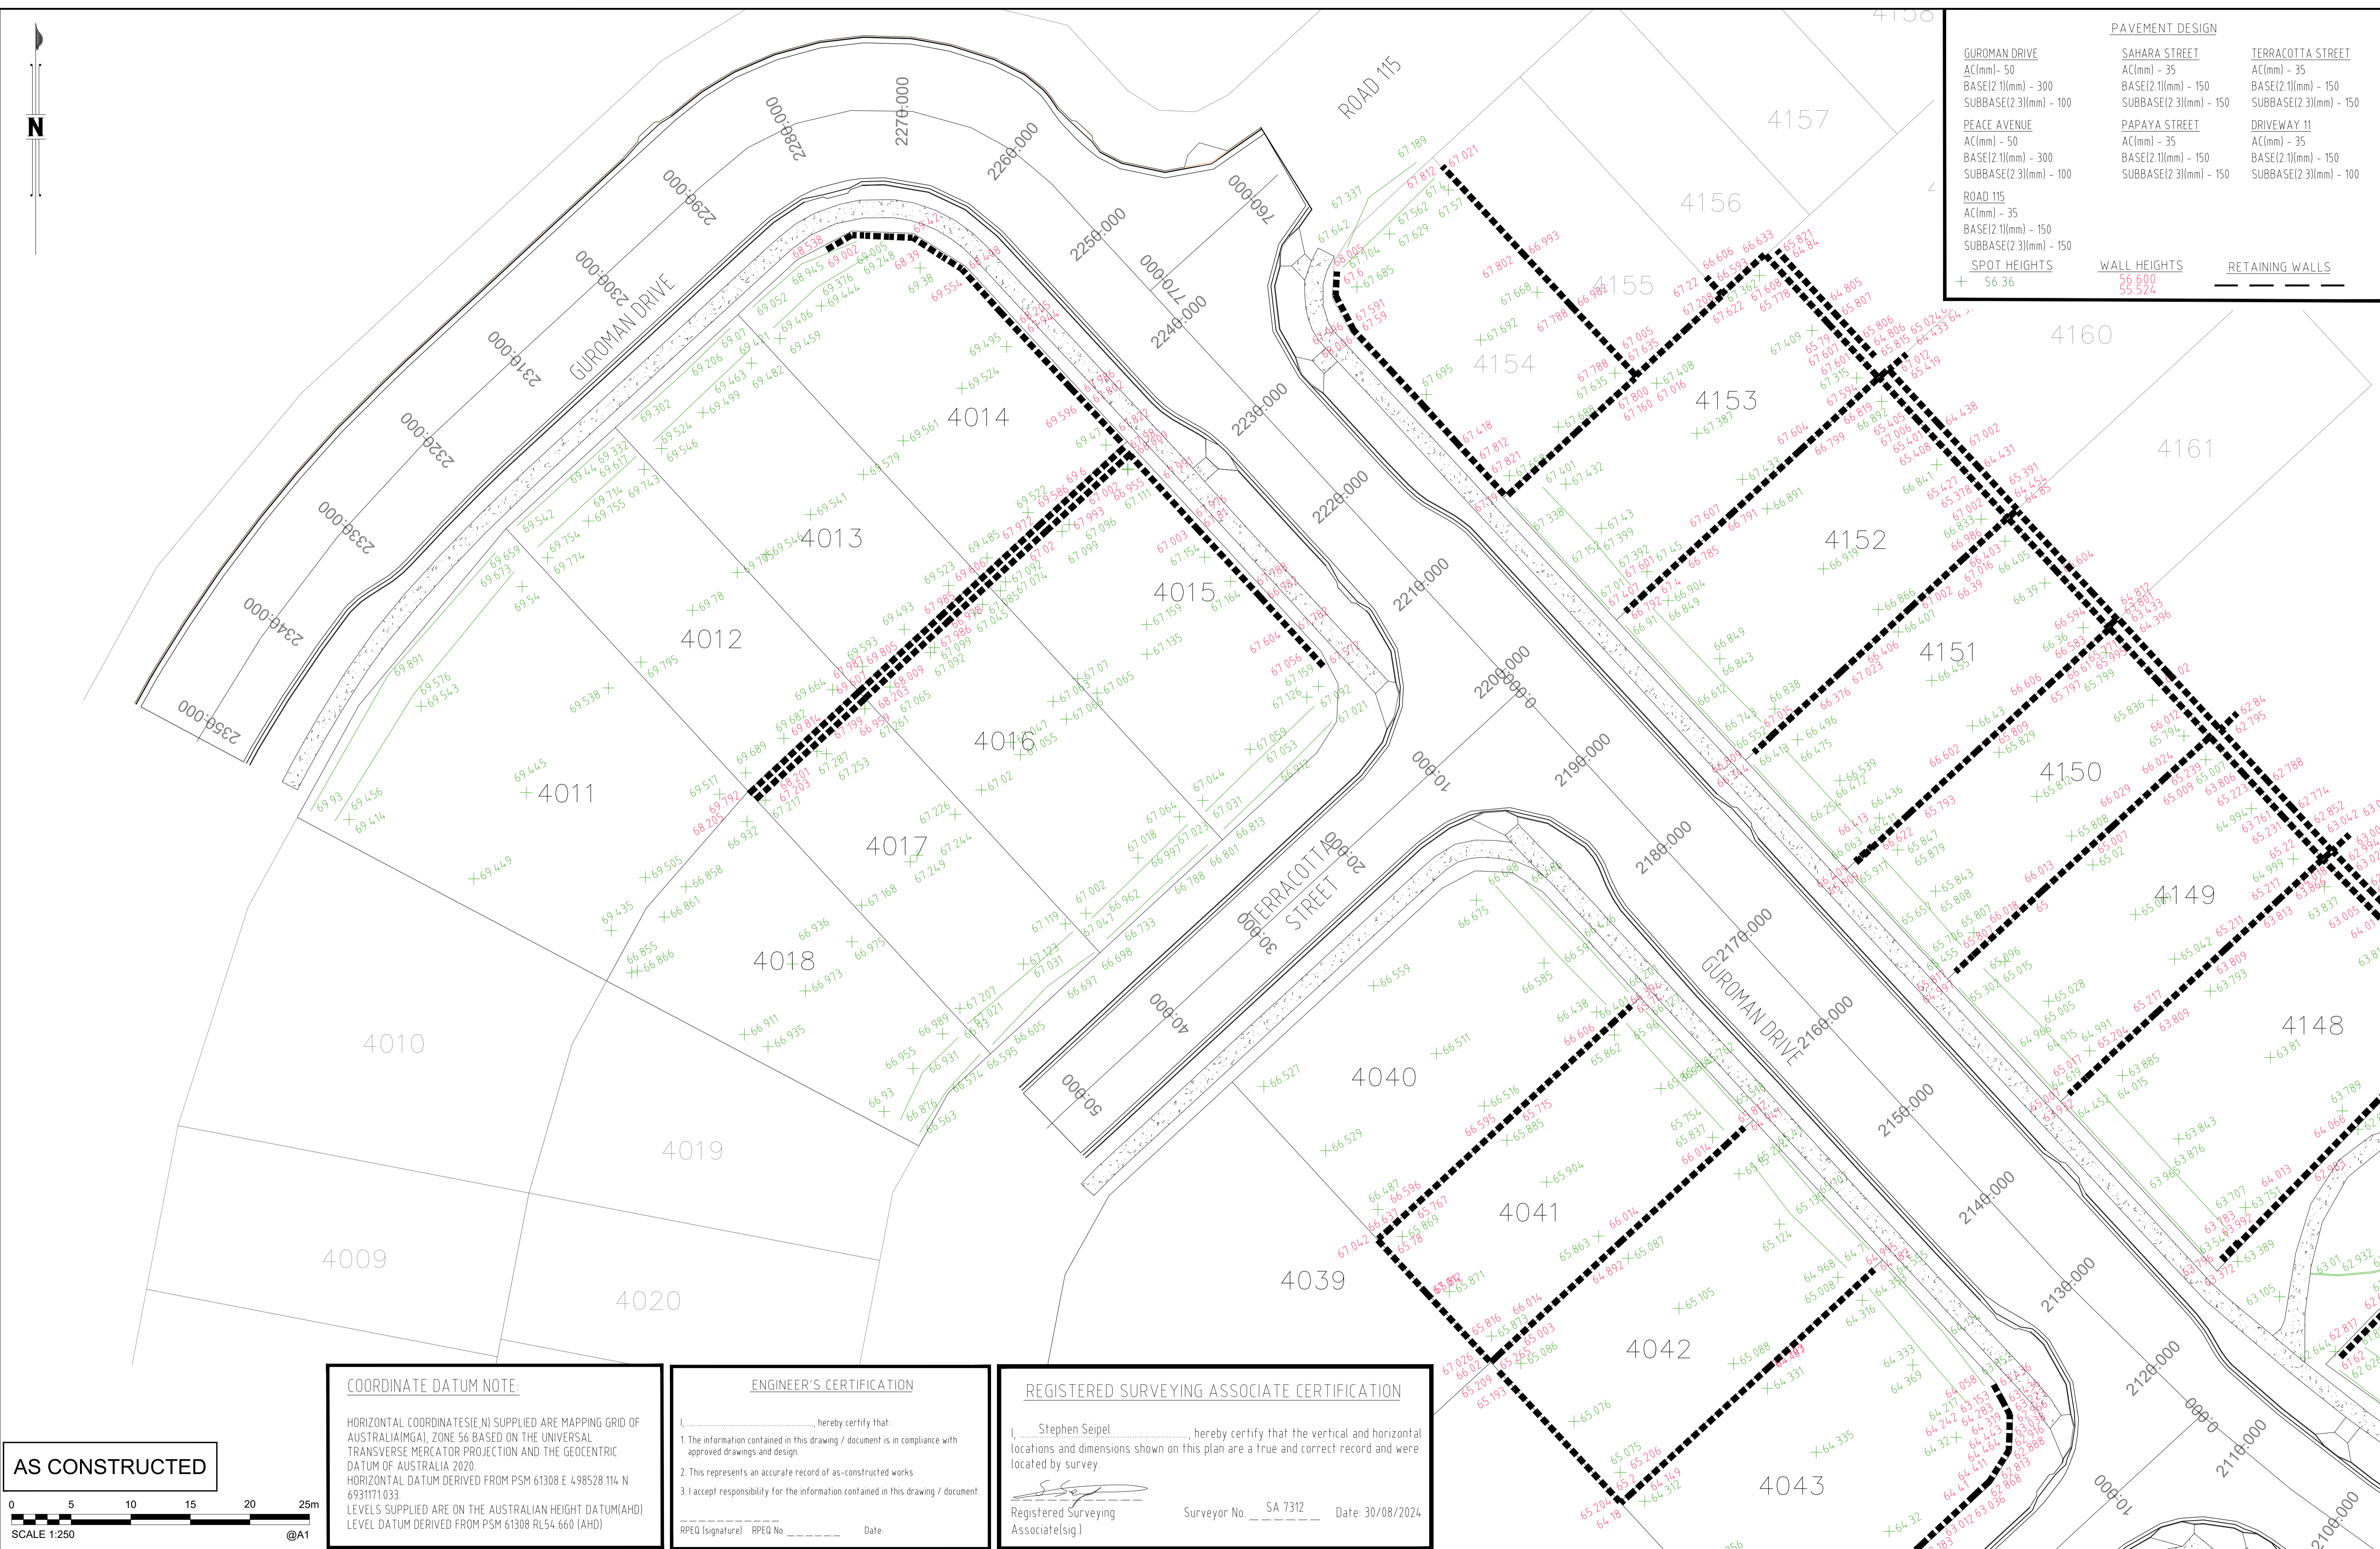

COORDINATE DATUM NOTE:

HORIZONTAL COORDINATES(E,N) SUPPLIED ARE MAPPING GRID OF AUSTRALIA(MGA), ZONE 56 BASED ON THE UNIVERSAL TRANSVERSE MERCATOR PROJECTION AND THE GEOCENTRIC DATUM OF AUSTRALIA 2020.

HORIZONTAL DATUM DERIVED FROM PSM 61308 E 4.98528.114 N 6931171.033

LEVELS SUPPLIED ARE ON THE AUSTRALIAN HEIGHT DATUM(AHD) LEVEL DATUM DERIVED FROM PSM 61308 RL54.660 (AHD)

ENGINEER'S CERTIFICATION

I, _____, hereby certify that:

- The information contained in this drawing / document is in compliance with approved drawings and design.
- This represents an accurate record of as-constructed works.
- I accept responsibility for the information contained in this drawing / document.

RPEQ (signature) RPEQ No. _____ Date: _____

REGISTERED SURVEYING ASSOCIATE CERTIFICATION

I, Stephen Seipel, hereby certify that the vertical and horizontal locations and dimensions shown on this plan are a true and correct record and were located by survey.

Registered Surveying Associate (sig) _____

Surveyor No. SA 7312 Date: 30/08/2024


A1	INDEX	DATE	AS CONSTRUCTED	REVISIONS	DRAWN	CHECKED	PASSED	INITIALS	DATE
	A	30/08/2024	AS CONSTRUCTED		RDE	DAM	CW		30/08/2024



LOGAN CITY COUNCIL

MIRVAC MIR-1002
AS CONSTRUCTED SURVEY - ROADS AND EARTHWORKS
EVERLEIGH PRECINCT 10.2C
GREENBANK QLD

SHEET 2 OF 5 SHEETS	REVISION DATE	SCALE
30/08/2024	1:250 A1	REVISION A
DISCIPLINE CODE	DRAWING NO.	
-	ASC-RDS AND EWKS-02-10.2C	

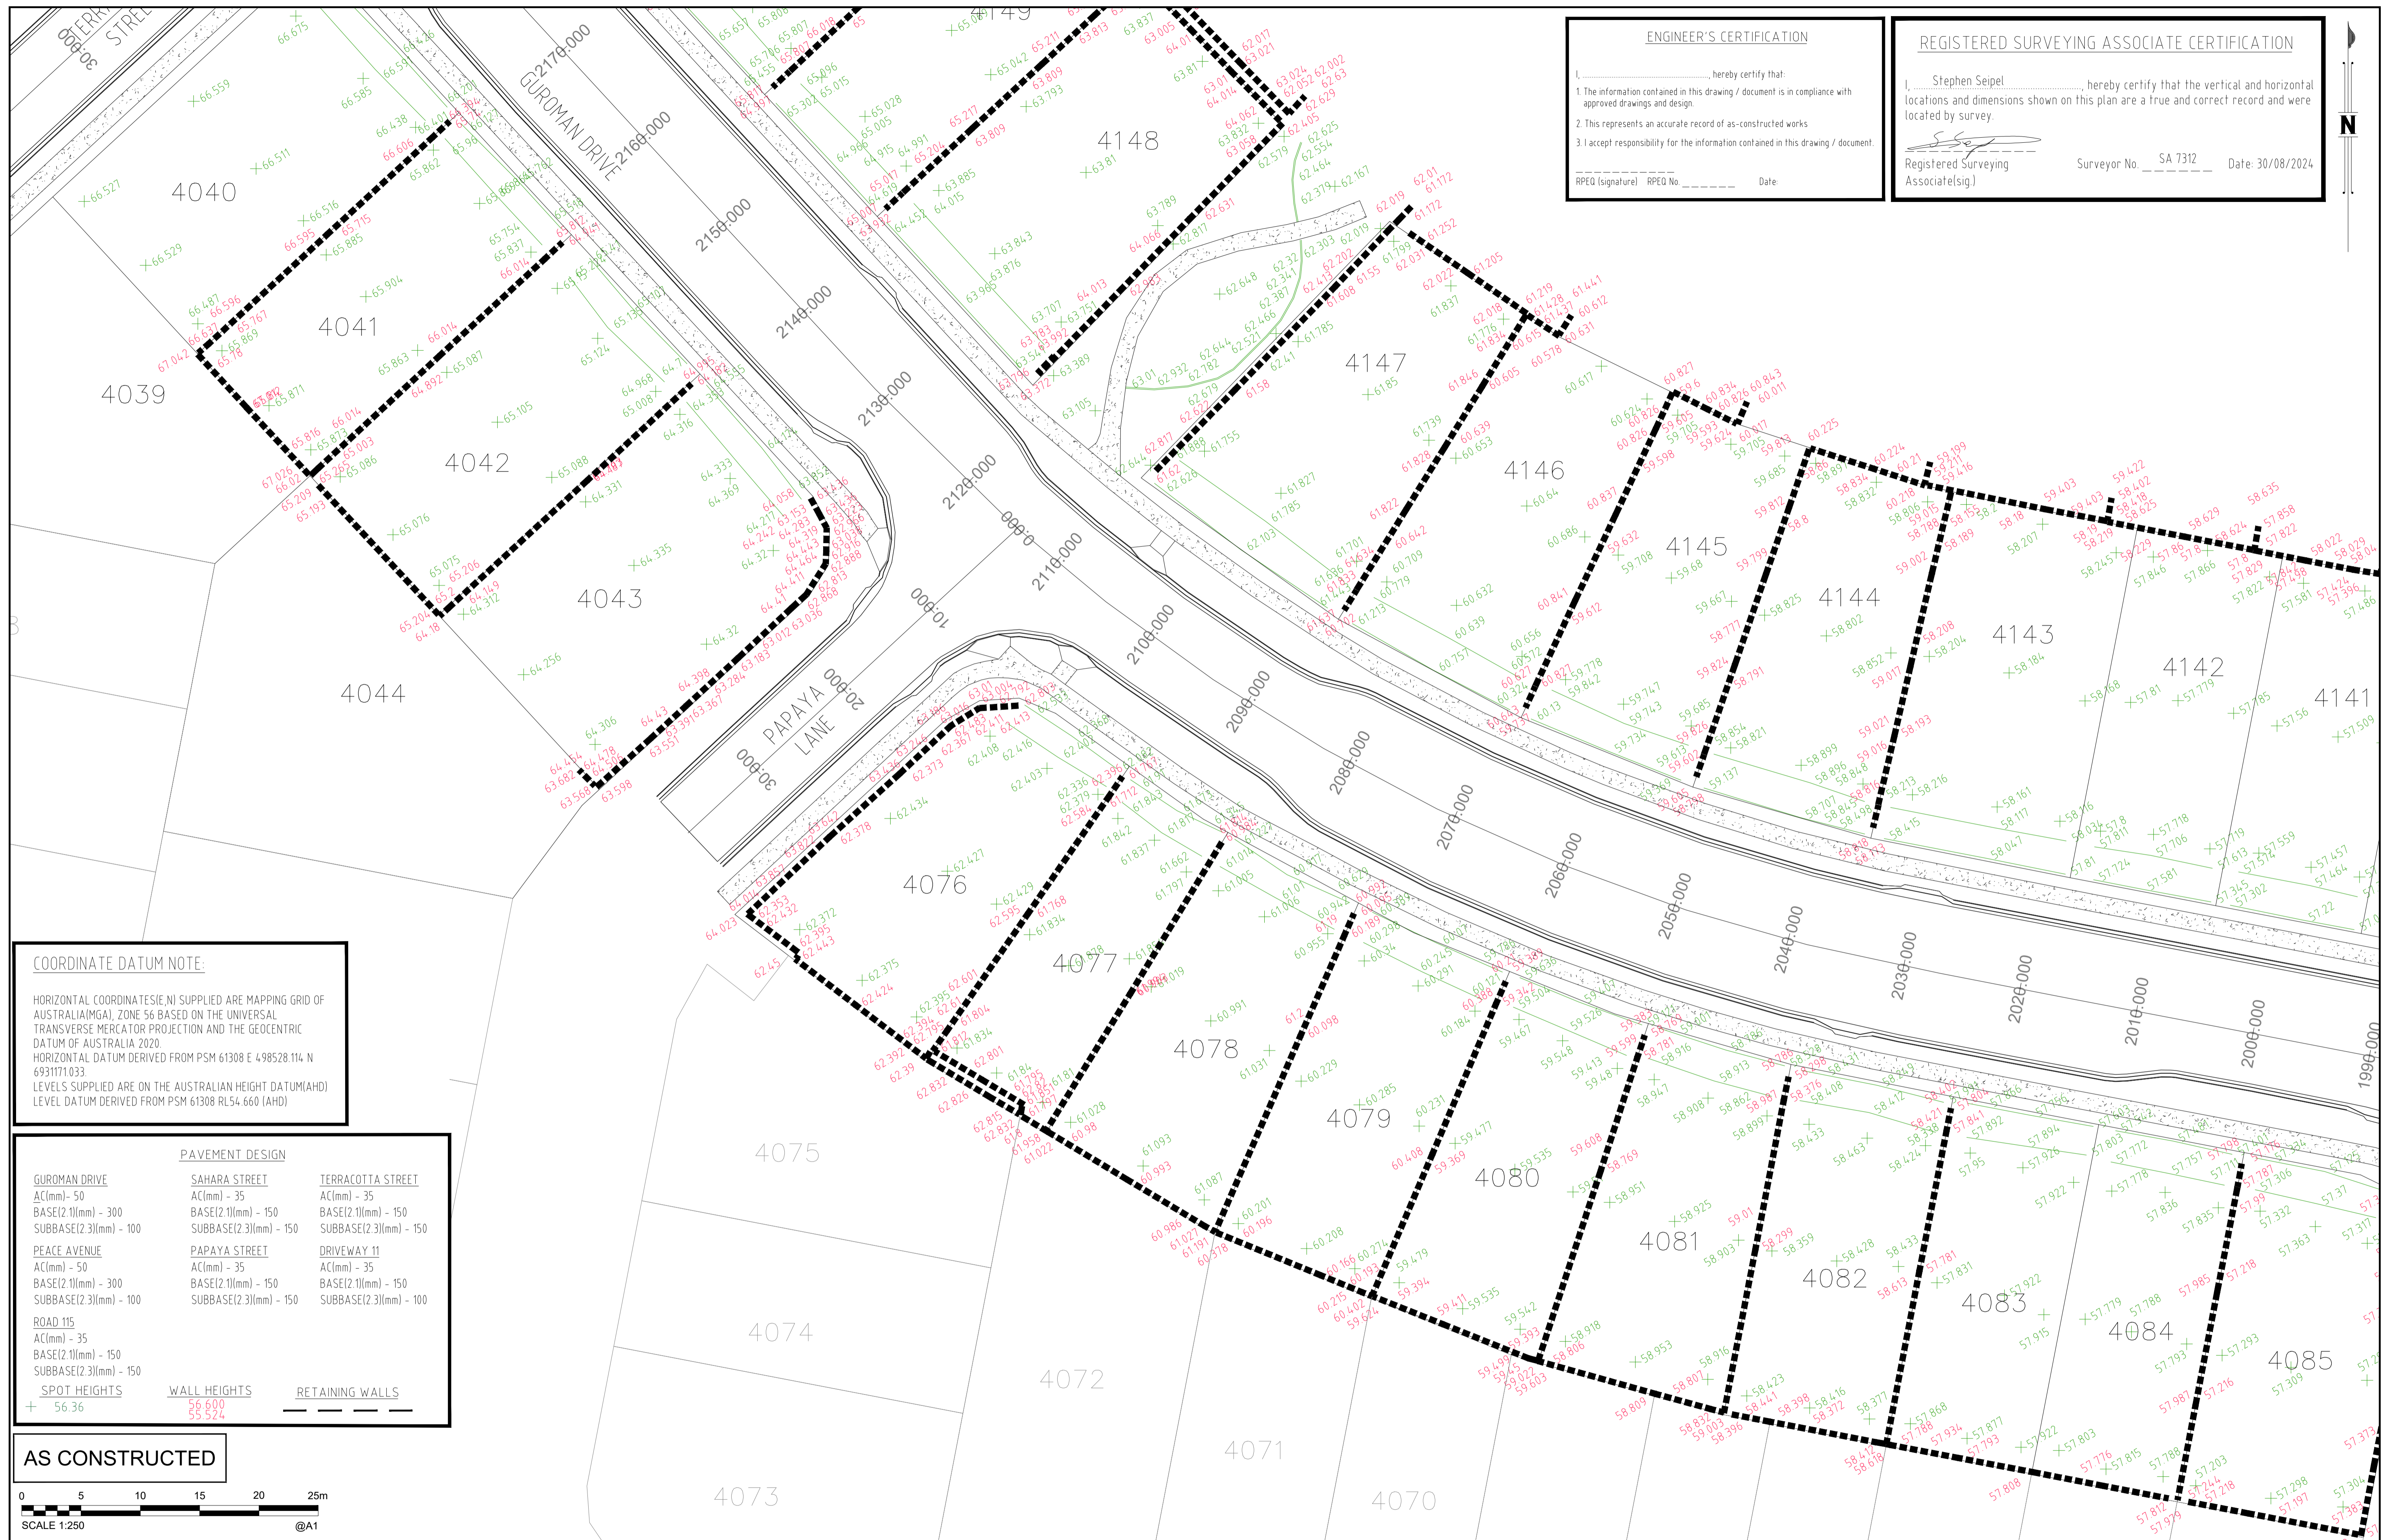

ENGINEER'S CERTIFICATION

I, _____, hereby certify that:

- The information contained in this drawing / document is in compliance with approved drawings and design.
- This represents an accurate record of as-constructed works.
- I accept responsibility for the information contained in this drawing / document.

RPEQ (Signature) RPEQ No. _____ Date: _____

REGISTERED SURVEYING ASSOCIATE CERTIFICATION

I, Stephen Seipel, hereby certify that the vertical and horizontal locations and dimensions shown on this plan are a true and correct record and were located by survey.

Registered Surveying Associate(s)g) Surveyor No. SA 7312 Date: 30/08/2024

COORDINATE DATUM NOTE:

HORIZONTAL COORDINATES(E,N) SUPPLIED ARE MAPPING GRID OF AUSTRALIA(MGA), ZONE 56 BASED ON THE UNIVERSAL TRANSVERSE MERCATOR PROJECTION AND THE GEOCENTRIC DATUM OF AUSTRALIA 2020.
 HORIZONTAL DATUM DERIVED FROM PSM 61308 E 4.98528.114 N 6931171.033
 LEVELS SUPPLIED ARE ON THE AUSTRALIAN HEIGHT DATUM(AHD)
 LEVEL DATUM DERIVED FROM PSM 61308 RL54.660 (AHD)

PAVEMENT DESIGN		
GUROMAN DRIVE	SAHARA STREET	TERRACOTTA STREET
AC(mm) - 50	AC(mm) - 35	AC(mm) - 35
BASE(2.1)(mm) - 300	BASE(2.1)(mm) - 150	BASE(2.1)(mm) - 150
SUBBASE(2.3)(mm) - 100	SUBBASE(2.3)(mm) - 150	SUBBASE(2.3)(mm) - 150
PEACE AVENUE	PAPAYA STREET	DRIVEWAY 11
AC(mm) - 50	AC(mm) - 35	AC(mm) - 35
BASE(2.1)(mm) - 300	BASE(2.1)(mm) - 150	BASE(2.1)(mm) - 150
SUBBASE(2.3)(mm) - 100	SUBBASE(2.3)(mm) - 150	SUBBASE(2.3)(mm) - 100
ROAD 115	WALL HEIGHTS	RETAINING WALLS
AC(mm) - 35	56.600	
BASE(2.1)(mm) - 150	55.524	
SUBBASE(2.3)(mm) - 150		
SPOT HEIGHTS		
+ 56.36		

AS CONSTRUCTED



A1	INDEX	DATE	AS CONSTRUCTED	REVISIONS	DRAWN	CHECKED	PASSED	INITIALS	DATE
	A	30/08/2024	AS CONSTRUCTED		RDE	DAM	CW		30/08/2024



LOGAN CITY COUNCIL


MIRVAC MIR-1002
 AS CONSTRUCTED SURVEY - ROADS AND EARTHWORKS
 EVERLEIGH PRECINCT 10.2C
 GREENBANK QLD

SHEET 3 OF 5 SHEETS	REVISION DATE	SCALE
30/08/2024	REVISION	1:250 A1
DISCIPLINE CODE		
DRAWING NO.		
ASC-RDS AND EWKS-03-10.2C		



PAVEMENT DESIGN		
GUROMAN DRIVE	SAHARA STREET	TERRACOTTA STREET
AC(mm) - 50	AC(mm) - 35	AC(mm) - 35
BASE(2.1)(mm) - 300	BASE(2.1)(mm) - 150	BASE(2.1)(mm) - 150
SUBBASE(2.3)(mm) - 100	SUBBASE(2.3)(mm) - 150	SUBBASE(2.3)(mm) - 150
PEACE AVENUE	PAPAYA STREET	DRIVEWAY 11
AC(mm) - 50	AC(mm) - 35	AC(mm) - 35
BASE(2.1)(mm) - 300	BASE(2.1)(mm) - 150	BASE(2.1)(mm) - 150
SUBBASE(2.3)(mm) - 100	SUBBASE(2.3)(mm) - 150	SUBBASE(2.3)(mm) - 150
ROAD 115	WALL HEIGHTS	RETAINING WALLS
AC(mm) - 35	56.600	
BASE(2.1)(mm) - 150	55.524	
SUBBASE(2.3)(mm) - 150		
SPOT HEIGHTS		
+ 56.36		

AS CONSTRUCTED

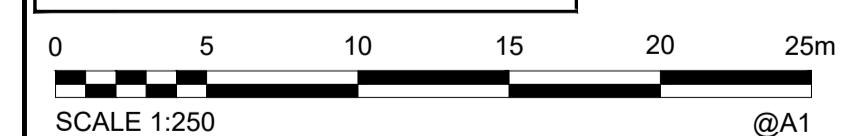

COORDINATE DATUM NOTE:
 HORIZONTAL COORDINATES(E,N) SUPPLIED ARE MAPPING GRID OF AUSTRALIA(MGA), ZONE 56 BASED ON THE UNIVERSAL TRANSVERSE MERCATOR PROJECTION AND THE GEOCENTRIC DATUM OF AUSTRALIA 2020.
 HORIZONTAL DATUM DERIVED FROM PSM 61308 E 4.98528 114 N 6931171033
 LEVEL DATUM DERIVED FROM PSM 61308 RL54.660 (AHD)

ENGINEER'S CERTIFICATION
 I, _____, hereby certify that:
 1. The information contained in this drawing / document is in compliance with approved drawings and design.
 2. This represents an accurate record of as-constructed works
 3. I accept responsibility for the information contained in this drawing / document.
 RPED (signature) RPED No. _____ Date _____

REGISTERED SURVEYING ASSOCIATE CERTIFICATION
 I, Stephen Seipel, hereby certify that the vertical and horizontal locations and dimensions shown on this plan are a true and correct record and were located by survey.
 Registered Surveying Associate(sig) _____
 Surveyor No. SA 7312 Date: 30/08/2024

A1	INDEX	DATE	AS CONSTRUCTED	REVISIONS	DRAWN	CHECKED	PASSED	INITIALS	DATE
	A	30/08/2024	AS CONSTRUCTED		RDE	DAM	CW		30/08/2024




LOGAN CITY COUNCIL
 MIRVAC MIR-1002
 AS CONSTRUCTED SURVEY - ROADS AND EARTHWORKS
 EVERLEIGH PRECINCT 10.2C
 GREENBANK QLD

SHEET 4 OF 5 SHEETS	SCALE 1:250 A1
REVISION DATE 30/08/2024	REVISION A
DISCIPLINE CODE -	
DRAWING NO. ASC-RDS AND EWKS-04-10.2C	



AS CONSTRUCTED

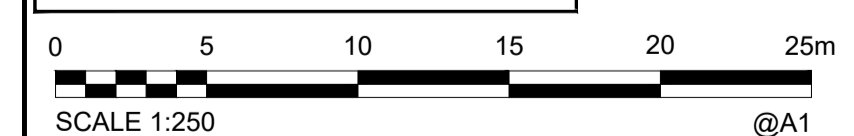

PAVEMENT DESIGN		
GUROMAN DRIVE	SAHARA STREET	TERRACOTTA STREET
AC(mm) - 50	AC(mm) - 35	AC(mm) - 35
BASE(2.1)(mm) - 300	BASE(2.1)(mm) - 150	BASE(2.1)(mm) - 150
SUBBASE(2.3)(mm) - 100	SUBBASE(2.3)(mm) - 150	SUBBASE(2.3)(mm) - 150
PEACE AVENUE	PAPAYA STREET	DRIVEWAY 11
AC(mm) - 50	AC(mm) - 35	AC(mm) - 35
BASE(2.1)(mm) - 300	BASE(2.1)(mm) - 150	BASE(2.1)(mm) - 150
SUBBASE(2.3)(mm) - 100	SUBBASE(2.3)(mm) - 150	SUBBASE(2.3)(mm) - 100
ROAD 115		
AC(mm) - 35		
BASE(2.1)(mm) - 150		
SUBBASE(2.3)(mm) - 150		
SPOT HEIGHTS	WALL HEIGHTS	RETAINING WALLS
+ 56.36	56.600 55.524	---

COORDINATE DATUM NOTE:
 HORIZONTAL COORDINATES (E, N) SUPPLIED ARE MAPPING GRID OF AUSTRALIA (MGA), ZONE 56 BASED ON THE UNIVERSAL TRANSVERSE MERCATOR PROJECTION AND THE GEOCENTRIC DATUM OF AUSTRALIA 2020.
 HORIZONTAL DATUM DERIVED FROM PSM 61308 E 4.98528.114 N 6931171.033
 LEVELS SUPPLIED ARE ON THE AUSTRALIAN HEIGHT DATUM (AHD) LEVEL DATUM DERIVED FROM PSM 61308 RL54.660 (AHD)

ENGINEER'S CERTIFICATION
 I, _____, hereby certify that:
 1. The information contained in this drawing / document is in compliance with approved drawings and design.
 2. This represents an accurate record of as-constructed works
 3. I accept responsibility for the information contained in this drawing / document.
 RPED (signature) RPED No. _____ Date _____

REGISTERED SURVEYING ASSOCIATE CERTIFICATION
 I, Stephen Seipel, hereby certify that the vertical and horizontal locations and dimensions shown on this plan are a true and correct record and were located by survey.
 Registered Surveying Associate (sig) Surveyor No. SA 7312 Date: 30/08/2024

A1	INDEX	DATE	AS CONSTRUCTED	REVISIONS	DRAWN	CHECKED	PASSED	INITIALS	DATE
	A	30/08/2024	AS CONSTRUCTED		RDE	DAM	CW		30/08/2024



LOGAN CITY COUNCIL
 MIRVAC MIR-1002
 AS CONSTRUCTED SURVEY - ROADS AND EARTHWORKS
 EVERLEIGH PRECINCT 10.2C
 GREENBANK QLD

SHEET 5 OF 5 SHEETS	SCALE 1:250 A1
REVISION DATE 30/08/2024	REVISION A
DISCIPLINE CODE -	
DRAWING NO. ASC-RDS AND EWKS-05-10.2C	