



PM61308 RL
 E: 498528.701
 N: 6931172.421
 RL: 54.660m

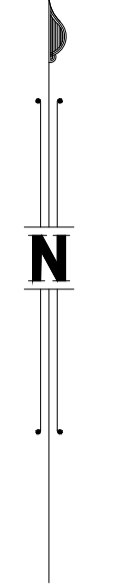

REFER TO PLAN ASC-SEWER-02-10.3C

REFER TO PLAN ASC-SEWER-03-10.3C

REFER TO PLAN ASC-SEWER-04-10.3C

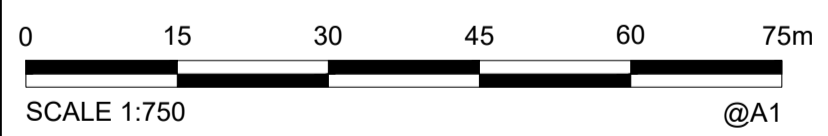


AS CONSTRUCTED

COORDINATE DATUM NOTE:
 HORIZONTAL COORDINATES(E,N) SUPPLIED ARE MAPPING GRID OF AUSTRALIA(MGA), ZONE 56 BASED ON THE UNIVERSAL TRANSVERSE MERCATOR PROJECTION AND THE GEOCENTRIC DATUM OF AUSTRALIA 2020.
 HORIZONTAL DATUM DERIVED FROM PSM 61308 E 498528.114 N 6931171.033.
 LEVELS SUPPLIED ARE ON THE AUSTRALIAN HEIGHT DATUM(AHD)
 LEVEL DATUM DERIVED FROM PSM 61308 RL54.660 (AHD)

ENGINEER'S CERTIFICATION
 I, _____, hereby certify that:
 1. The information contained in this drawing / document is in compliance with approved drawings and design.
 2. The new water and sewerage works defined by this drawing have been designed and constructed in accordance with the SEQ Code.
 3. This represents an accurate record of as-constructed works.
 4. I accept responsibility for the information contained in this drawing / document.

 RPEQ (signature) RPEQ No. _____ Date: _____

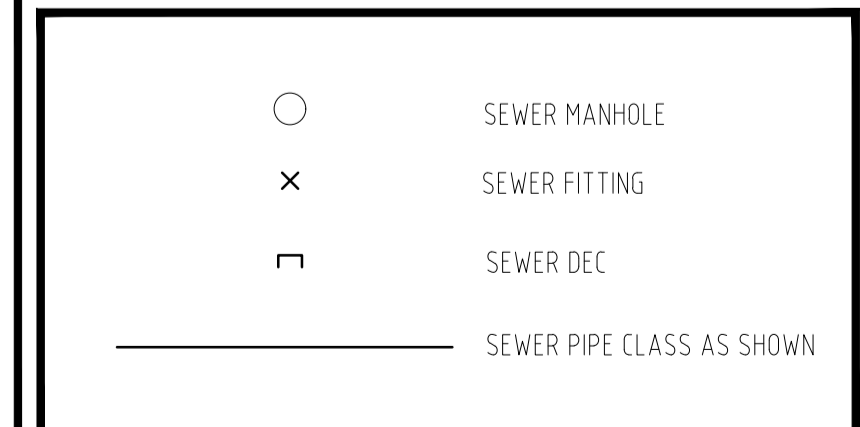

REGISTERED SURVEYING ASSOCIATE CERTIFICATION
 I, Stephen Seipel, hereby certify that the vertical and horizontal locations and dimensions shown on this plan are a true and correct record and were located by survey.

 Registered Surveying Associate(Sig) Surveyor No. SA 7312 Date: 19/09/2024



| | | | | | | | | | | | |
|-----------|-------|------|----------------|-------|---------|--------|-------|---------|--------|----------|------|
| A1 | INDEX | DATE | AS CONSTRUCTED | DRAWN | CHECKED | PASSED | DRAWN | CHECKED | PASSED | INITIALS | DATE |
| | | | | | | | | | | | |



LOGAN CITY COUNCIL
 MIRVAC MIR-1003
 AS CONSTRUCTED SURVEY - SEWER
 EVERLEIGH PRECINCT 10.3C
 GREENBANK QLD

| | |
|--------------------------------|----------------|
| SHEET 1 OF 4 SHEETS | SCALE 1:500 A1 |
| REVISION DATE 19/09/2024 | REVISION - |
| DISCIPLINE CODE - | |
| DRAWING NO. ASC-SEWER-01-10.3C | |

PM61308 RL
 E: 498528.701
 N: 6931172.421
 RL: 54.660m

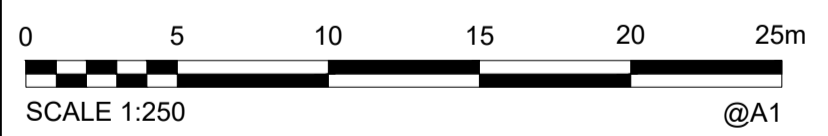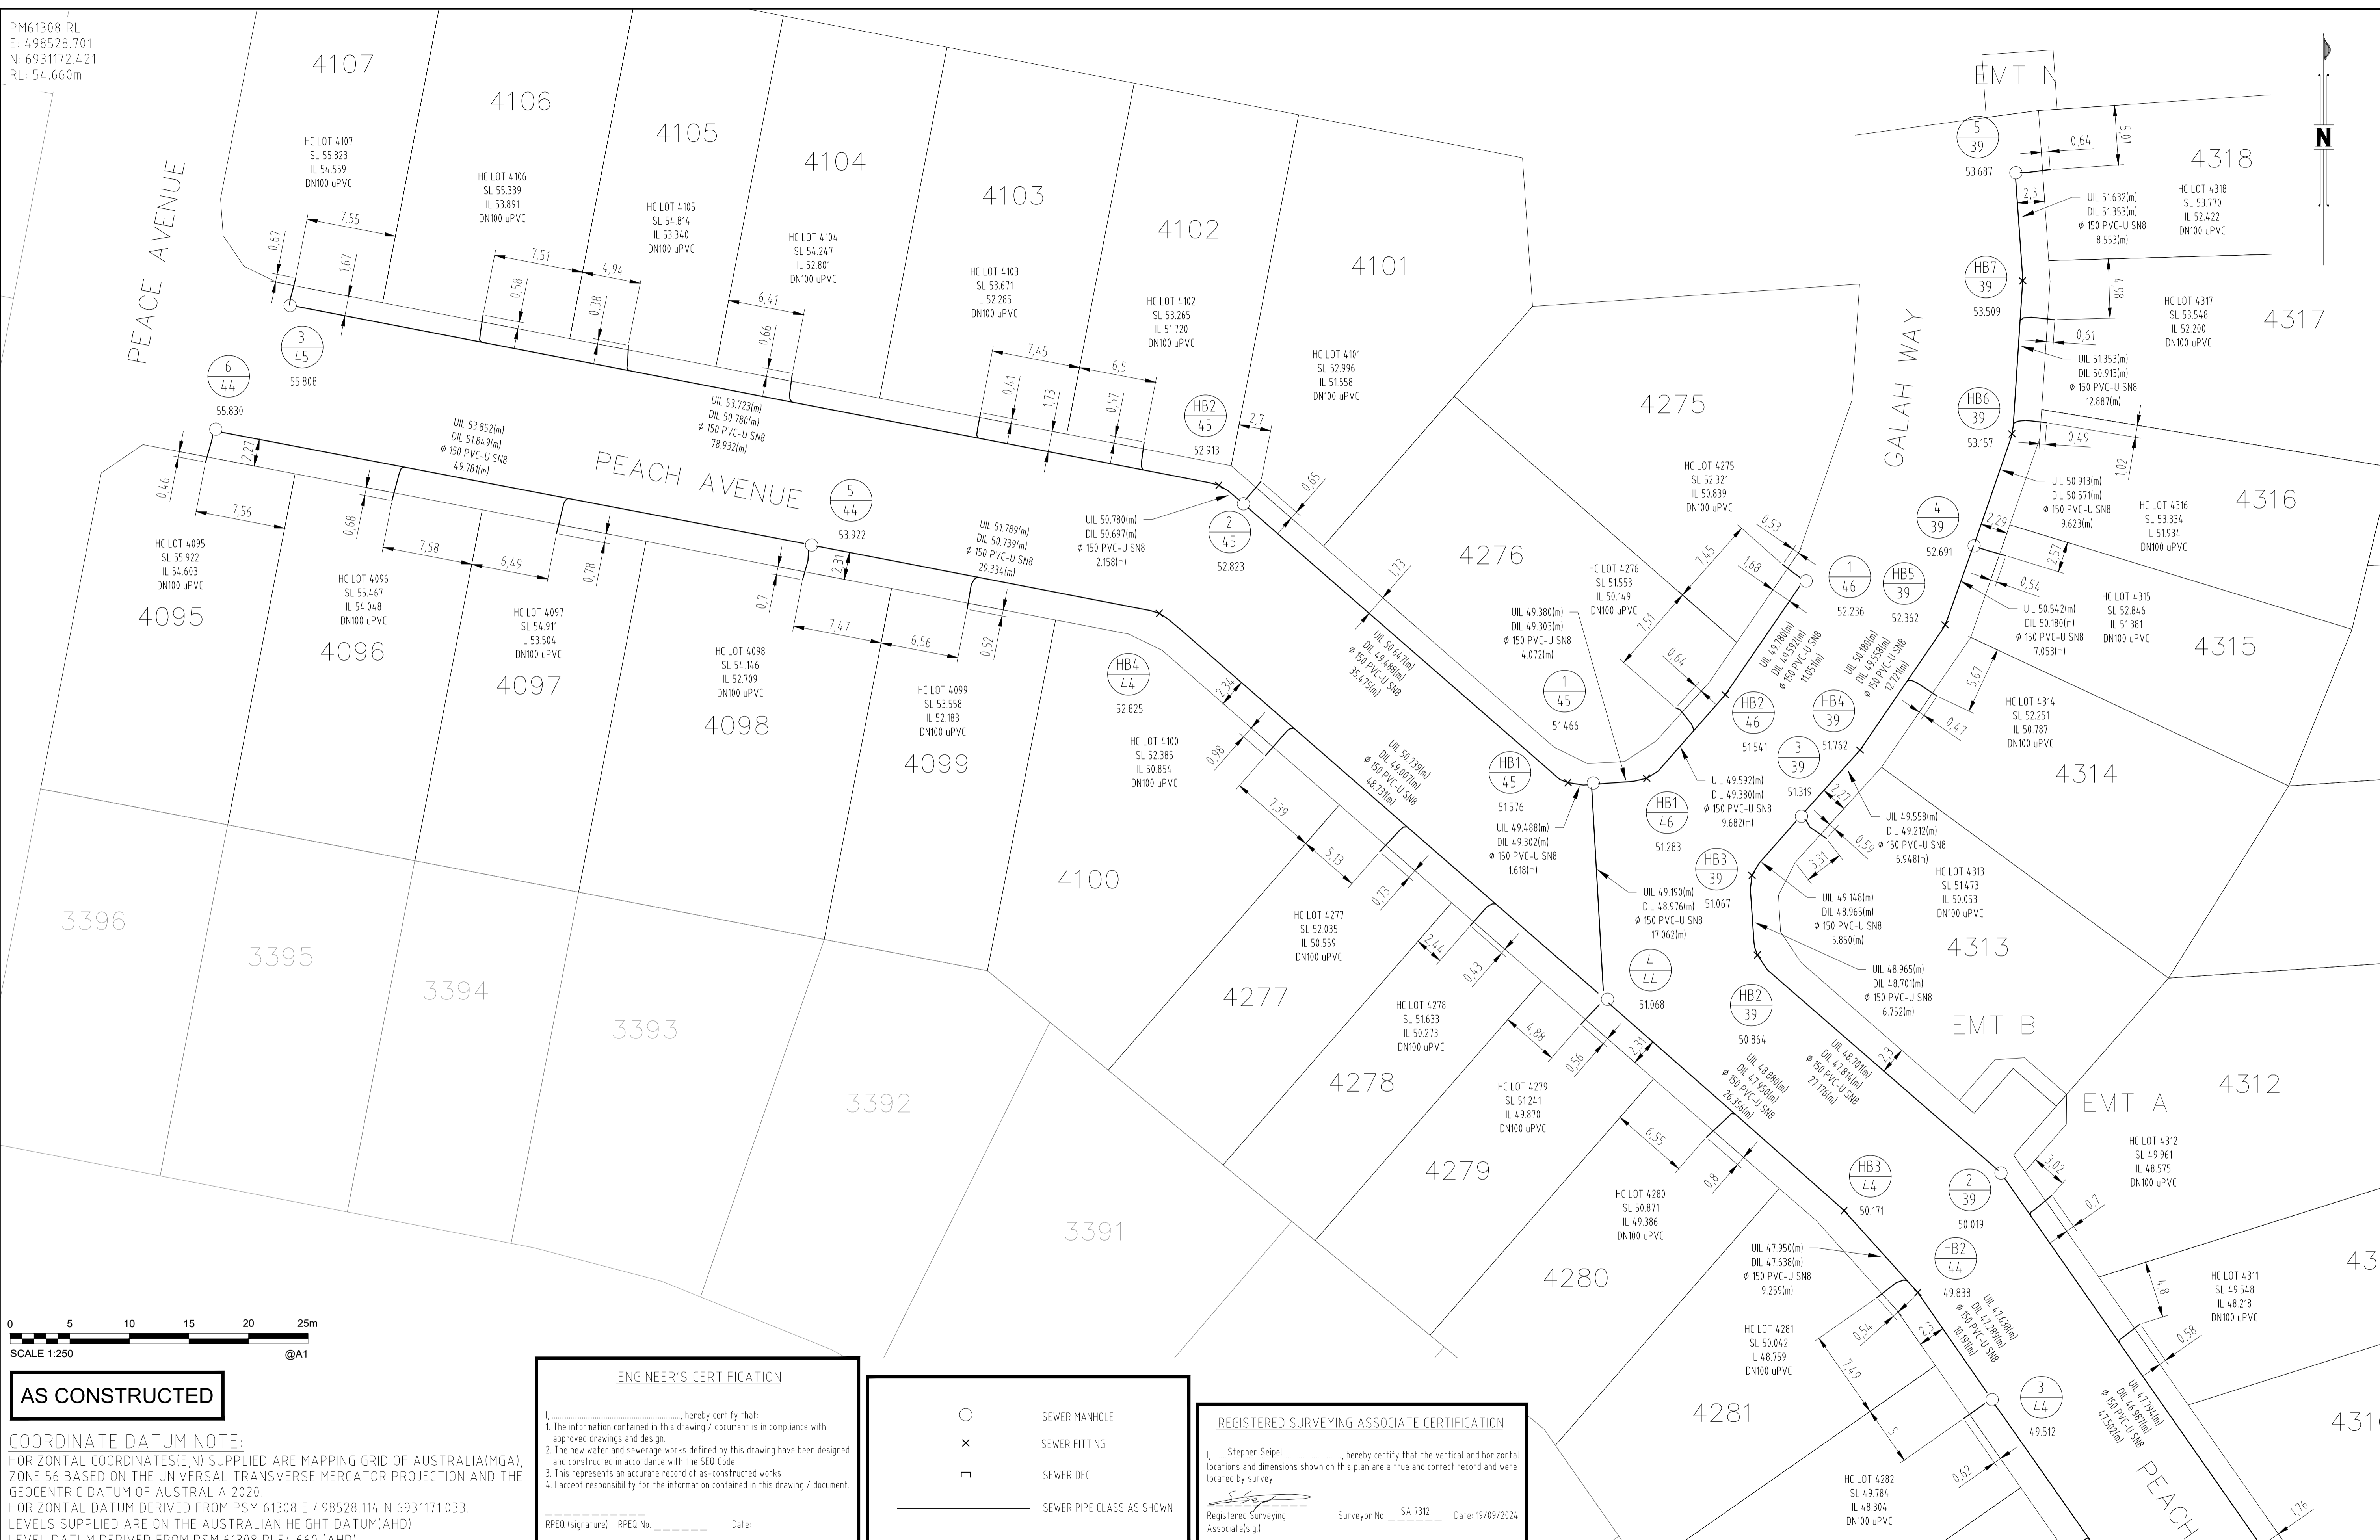


AS CONSTRUCTED

COORDINATE DATUM NOTE:
 HORIZONTAL COORDINATES(E,N) SUPPLIED ARE MAPPING GRID OF AUSTRALIA(MGA), ZONE 56 BASED ON THE UNIVERSAL TRANSVERSE MERCATOR PROJECTION AND THE GEOCENTRIC DATUM OF AUSTRALIA 2020.
 HORIZONTAL DATUM DERIVED FROM PSM 61308 E 498528.114 N 6931171.033.
 LEVELS SUPPLIED ARE ON THE AUSTRALIAN HEIGHT DATUM(AHD)
 LEVEL DATUM DERIVED FROM PSM 61308 RL54.660 (AHD)

ENGINEER'S CERTIFICATION

I, _____, hereby certify that:
 1. The information contained in this drawing / document is in compliance with approved drawings and design.
 2. The new water and sewerage works defined by this drawing have been designed and constructed in accordance with the SEQ Code.
 3. This represents an accurate record of as-constructed works.
 4. I accept responsibility for the information contained in this drawing / document.

RPED (signature) RPED No. _____ Date: _____

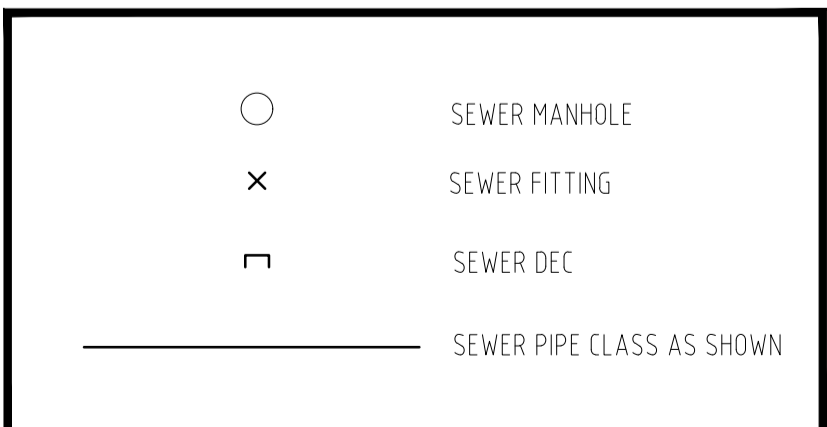

REGISTERED SURVEYING ASSOCIATE CERTIFICATION

I, Stephen Seipel, hereby certify that the vertical and horizontal locations and dimensions shown on this plan are a true and correct record and were located by survey.

Registered Surveying Associate (sig) _____
 Surveyor No. SA 7312 Date: 19/09/2024

| | | | | | | | | | | | |
|-----------|-------|------|----------------|-------|---------|--------|-------|---------|--------|----------|------|
| A1 | INDEX | DATE | AS CONSTRUCTED | DRAWN | CHECKED | PASSED | DRAWN | CHECKED | PASSED | INITIALS | DATE |
| | | | | | | | | | | | |




LOGAN CITY COUNCIL

MIRVAC MIR-1003
 AS CONSTRUCTED SURVEY - SEWER
 EVERLEIGH PRECINCT 10.3C
 GREENBANK QLD



| | |
|---------------------|--------------------|
| SHEET 2 OF 4 SHEETS | SCALE 1:250 A1 |
| REVISION DATE | REVISION |
| DISCIPLINE CODE | |
| DRAWING NO. | ASC-SEWER-02-10.3C |

PM61308 RL
 E: 498528.701
 N: 6931172.421
 RL: 54.660m

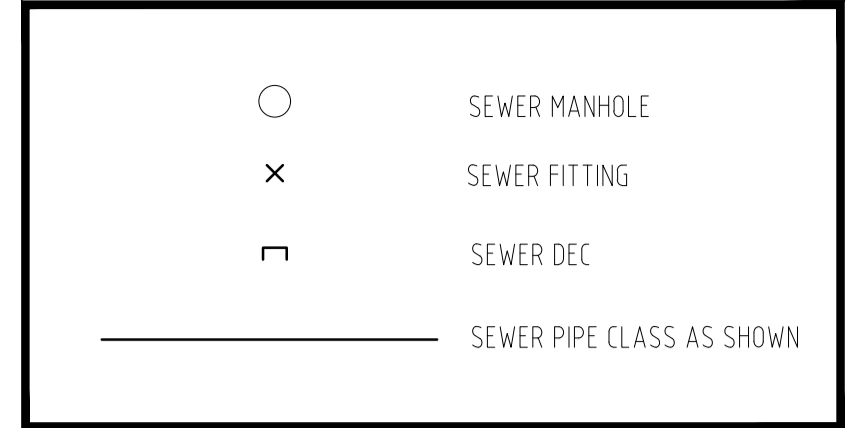

REGISTERED SURVEYING ASSOCIATE CERTIFICATION
 I, Stephen Seipel, hereby certify that the vertical and horizontal locations and dimensions shown on this plan are a true and correct record and were located by survey.
 Registered Surveying Associate (sig) SA 7312 Date: 19/09/2024

ENGINEER'S CERTIFICATION
 I, _____, hereby certify that:
 1. The information contained in this drawing / document is in compliance with approved drawings and design.
 2. The new water and sewerage works defined by this drawing have been designed and constructed in accordance with the SEQ Code.
 3. This represents an accurate record of as-constructed works.
 4. I accept responsibility for the information contained in this drawing / document.
 RPEO (signature) RPEO No. _____ Date: _____

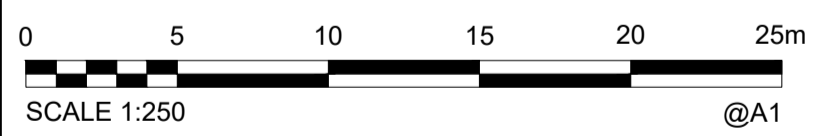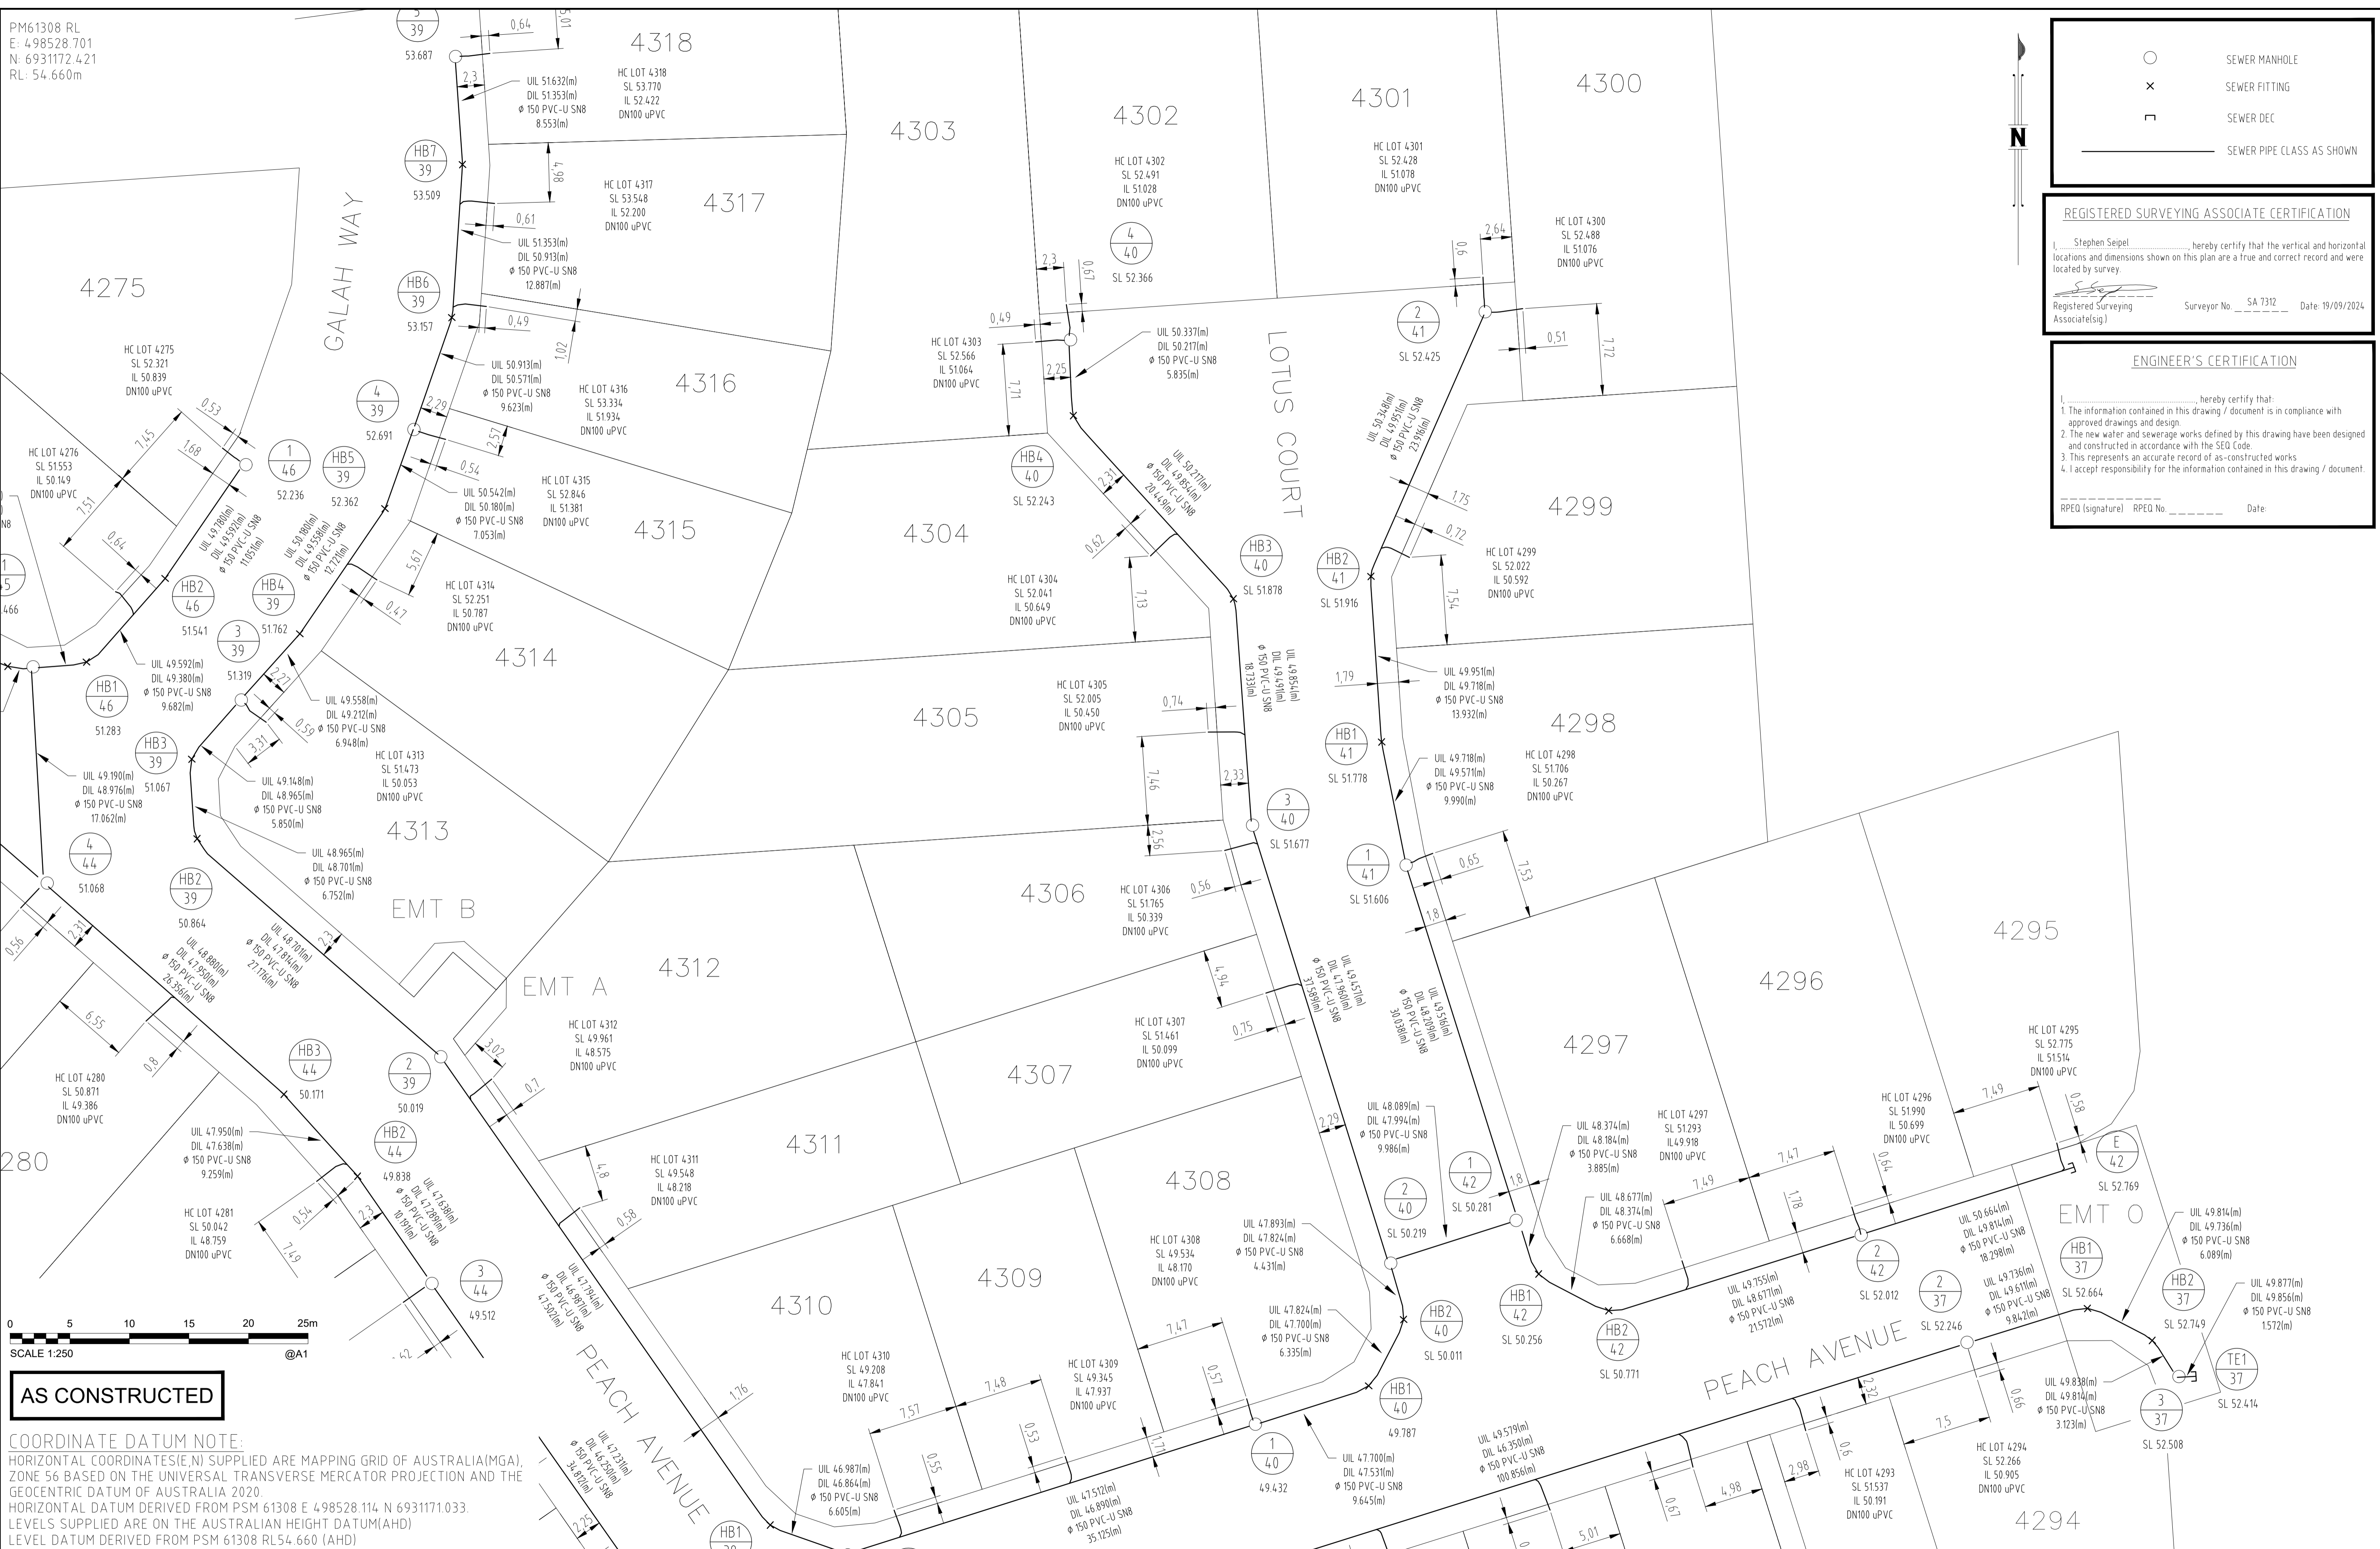

AS CONSTRUCTED

COORDINATE DATUM NOTE:
 HORIZONTAL COORDINATES(E,N) SUPPLIED ARE MAPPING GRID OF AUSTRALIA(MGA), ZONE 56 BASED ON THE UNIVERSAL TRANSVERSE MERCATOR PROJECTION AND THE GEOCENTRIC DATUM OF AUSTRALIA 2020.
 HORIZONTAL DATUM DERIVED FROM PSM 61308 E 498528.114 N 6931171.033.
 LEVELS SUPPLIED ARE ON THE AUSTRALIAN HEIGHT DATUM(AHD)
 LEVEL DATUM DERIVED FROM PSM 61308 RL54.660 (AHD)


| | | | | | | | | | | |
|----|-------|------|----------------|-----------|-------|---------|--------|-------|---------|--------|
| A1 | INDEX | DATE | AS CONSTRUCTED | REVISIONS | DRAWN | CHECKED | PASSED | DRAWN | CHECKED | PASSED |
| | | | | | | | | | | |

shadforth
 99 Sandshoof Lane, Forest Glen QLD 4556
 Ph: 07 5438 3300 E: 07 5438 3308 F: e.shadforth@shadforth.com.au

LOGAN CITY COUNCIL

LOGAN CITY COUNCIL
 MIRVAC MIR-1003
 AS CONSTRUCTED SURVEY - SEWER
 EVERLEIGH PRECINCT 10.3C
 GREENBANK QLD


| | |
|---------------------|--------------------|
| SHEET 3 OF 4 SHEETS | SCALE 1:250 A1 |
| REVISION DATE | REVISION |
| DISCIPLINE CODE | |
| DRAWING NO. | ASC-SEWER-03-10.3C |

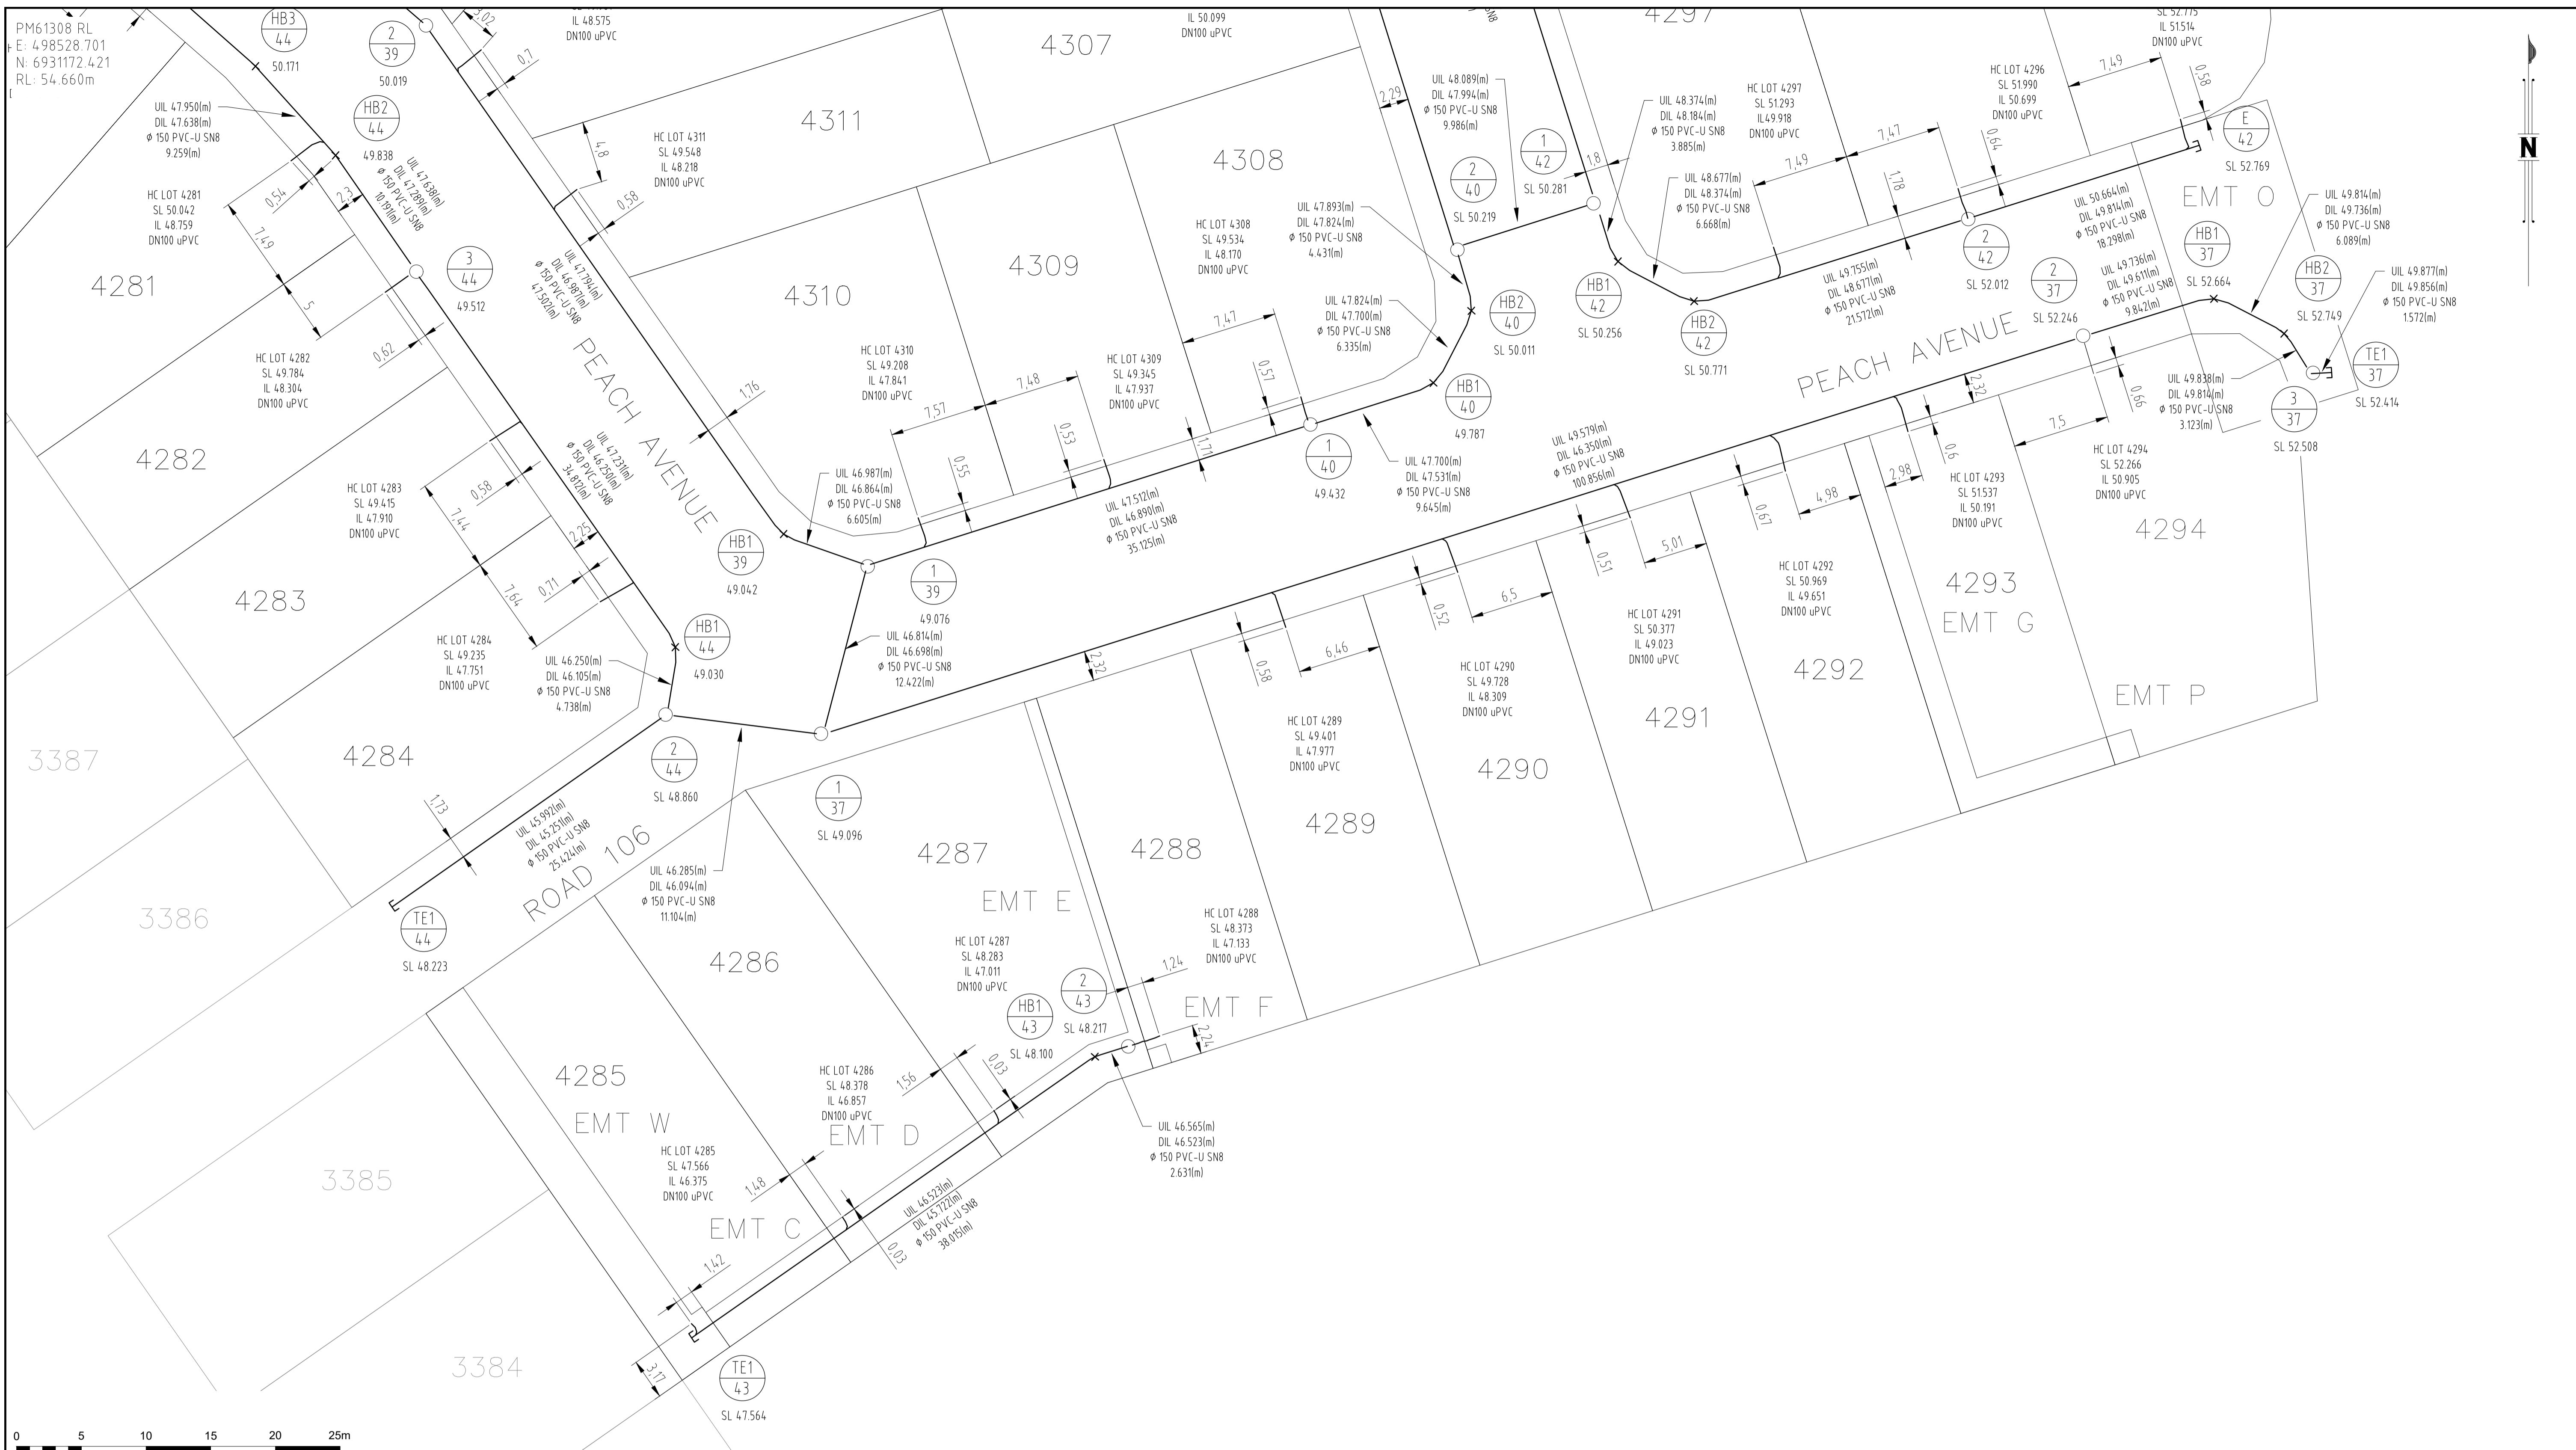

AS CONSTRUCTED

COORDINATE DATUM NOTE:
 HORIZONTAL COORDINATES(E,N) SUPPLIED ARE MAPPING GRID OF AUSTRALIA(MGA), ZONE 56 BASED ON THE UNIVERSAL TRANSVERSE MERCATOR PROJECTION AND THE GEOCENTRIC DATUM OF AUSTRALIA 2020.
 HORIZONTAL DATUM DERIVED FROM PSM 61308 E 498528 114 N 6931171.033.
 LEVELS SUPPLIED ARE ON THE AUSTRALIAN HEIGHT DATUM(AHD)
 LEVEL DATUM DERIVED FROM PSM 61308 RL54.660 (AHD)

ENGINEER'S CERTIFICATION
 I, _____, hereby certify that:
 1. The information contained in this drawing / document is in compliance with approved drawings and design.
 2. The new water and sewerage works defined by this drawing have been designed and constructed in accordance with the SEQ Code.
 3. This represents an accurate record of as-constructed works.
 4. I accept responsibility for the information contained in this drawing / document.
 RPEQ (signature) RPEQ No. _____ Date: _____

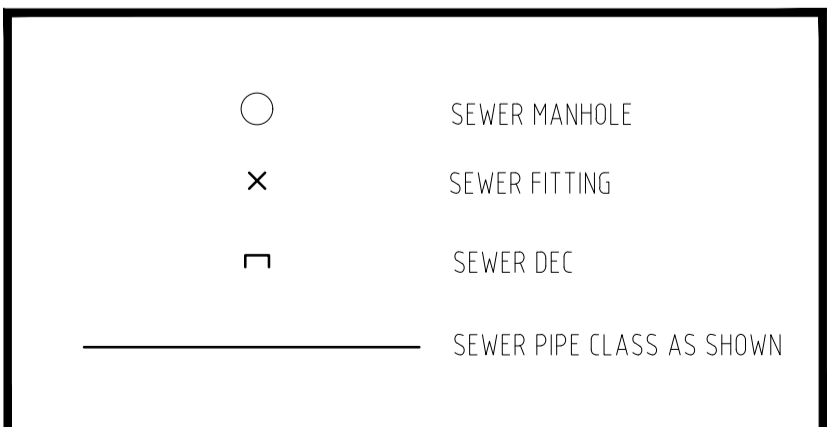

REGISTERED SURVEYING ASSOCIATE CERTIFICATION
 I, Stephen Seipel, hereby certify that the vertical and horizontal locations and dimensions shown on this plan are a true and correct record and were located by survey.
 Registered Surveying Associate(Sig) Surveyor No. SA 7312 Date: 19/09/2024

| | | | | | | |
|----|-------|------|----------------|----------|---------|--------|
| A1 | INDEX | DATE | AS CONSTRUCTED | DRAWN | CHECKED | PASSED |
| | | | | | | |
| | | | REVISIONS | DRAWN | CHECKED | PASSED |
| | | | | | | |
| | | | | DRAWN | CHECKED | PASSED |
| | | | | | | |
| | | | | INITIALS | DATE | |
| | | | | | | |



LOGAN CITY COUNCIL
 MIRVAC MIR-1003
 AS CONSTRUCTED SURVEY - SEWER
 EVERLEIGH PRECINCT 10.3C
 GREENBANK QLD

| | |
|---------------------|--------------------|
| SHEET 4 OF 4 SHEETS | SCALE 1:250 A1 |
| REVISION DATE | REVISION - |
| DISCIPLINE CODE | - |
| DRAWING NO. | ASC-SEWER-04-10.3C |