



PM61308 RL
 E: 498528.701
 N: 6931172.421
 RL: 54.660m

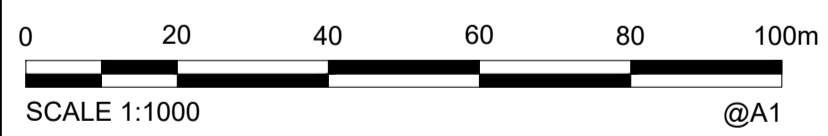

AS CONSTRUCTED

COORDINATE DATUM NOTE:
 HORIZONTAL COORDINATES(E,N) SUPPLIED ARE MAPPING GRID OF AUSTRALIA(MGA), ZONE 56 BASED ON THE UNIVERSAL TRANSVERSE MERCATOR PROJECTION AND THE GEOCENTRIC DATUM OF AUSTRALIA 2020.
 HORIZONTAL DATUM DERIVED FROM PSM 61308 E 498528.114 N 6931171.033.
 LEVELS SUPPLIED ARE ON THE AUSTRALIAN HEIGHT DATUM(AHD)
 LEVEL DATUM DERIVED FROM PSM 61308 RL54.660 (AHD)

ENGINEER'S CERTIFICATION
 I, _____ hereby certify that:
 1. The information contained in this drawing / document is in compliance with approved drawings and design.
 2. The new water and sewerage works defined by this drawing have been designed and constructed in accordance with the SEQ Code.
 3. This represents an accurate record of as-constructed works.
 4. I accept responsibility for the information contained in this drawing / document.
 RPEQ (signature) RPEQ No. _____ Date: _____

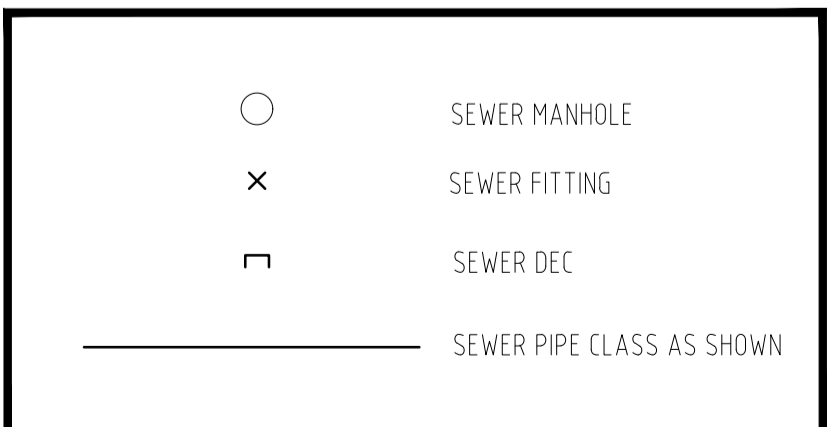



REGISTERED SURVEYING ASSOCIATE CERTIFICATION
 I, Stephen Seipel, hereby certify that the vertical and horizontal locations and dimensions shown on this plan are a true and correct record and were located by survey.
 Registered Surveying Associate (sig) Surveyor No. SA 7312 Date: 21/01/2025

A1	INDEX	DATE	AS CONSTRUCTED	DRAWN	CHECKED	PASSED	DRAWN	CHECKED	PASSED	INITIALS	DATE

LOGAN CITY COUNCIL
 MIRVAC MIR-1004
 AS CONSTRUCTED SURVEY - SEWER
 EVERLEIGH PRECINCT 10.4C
 GREENBANK QLD

SHEET 1 OF 8 SHEETS	SCALE 1:1000 A1
REVISION DATE 21/01/2025	REVISION -
DISCIPLINE CODE -	
DRAWING NO. ASC-SEWER-01-10.4C	


PM61308 RL
 E: 498528.701
 N: 6931172.421
 RL: 54.660m

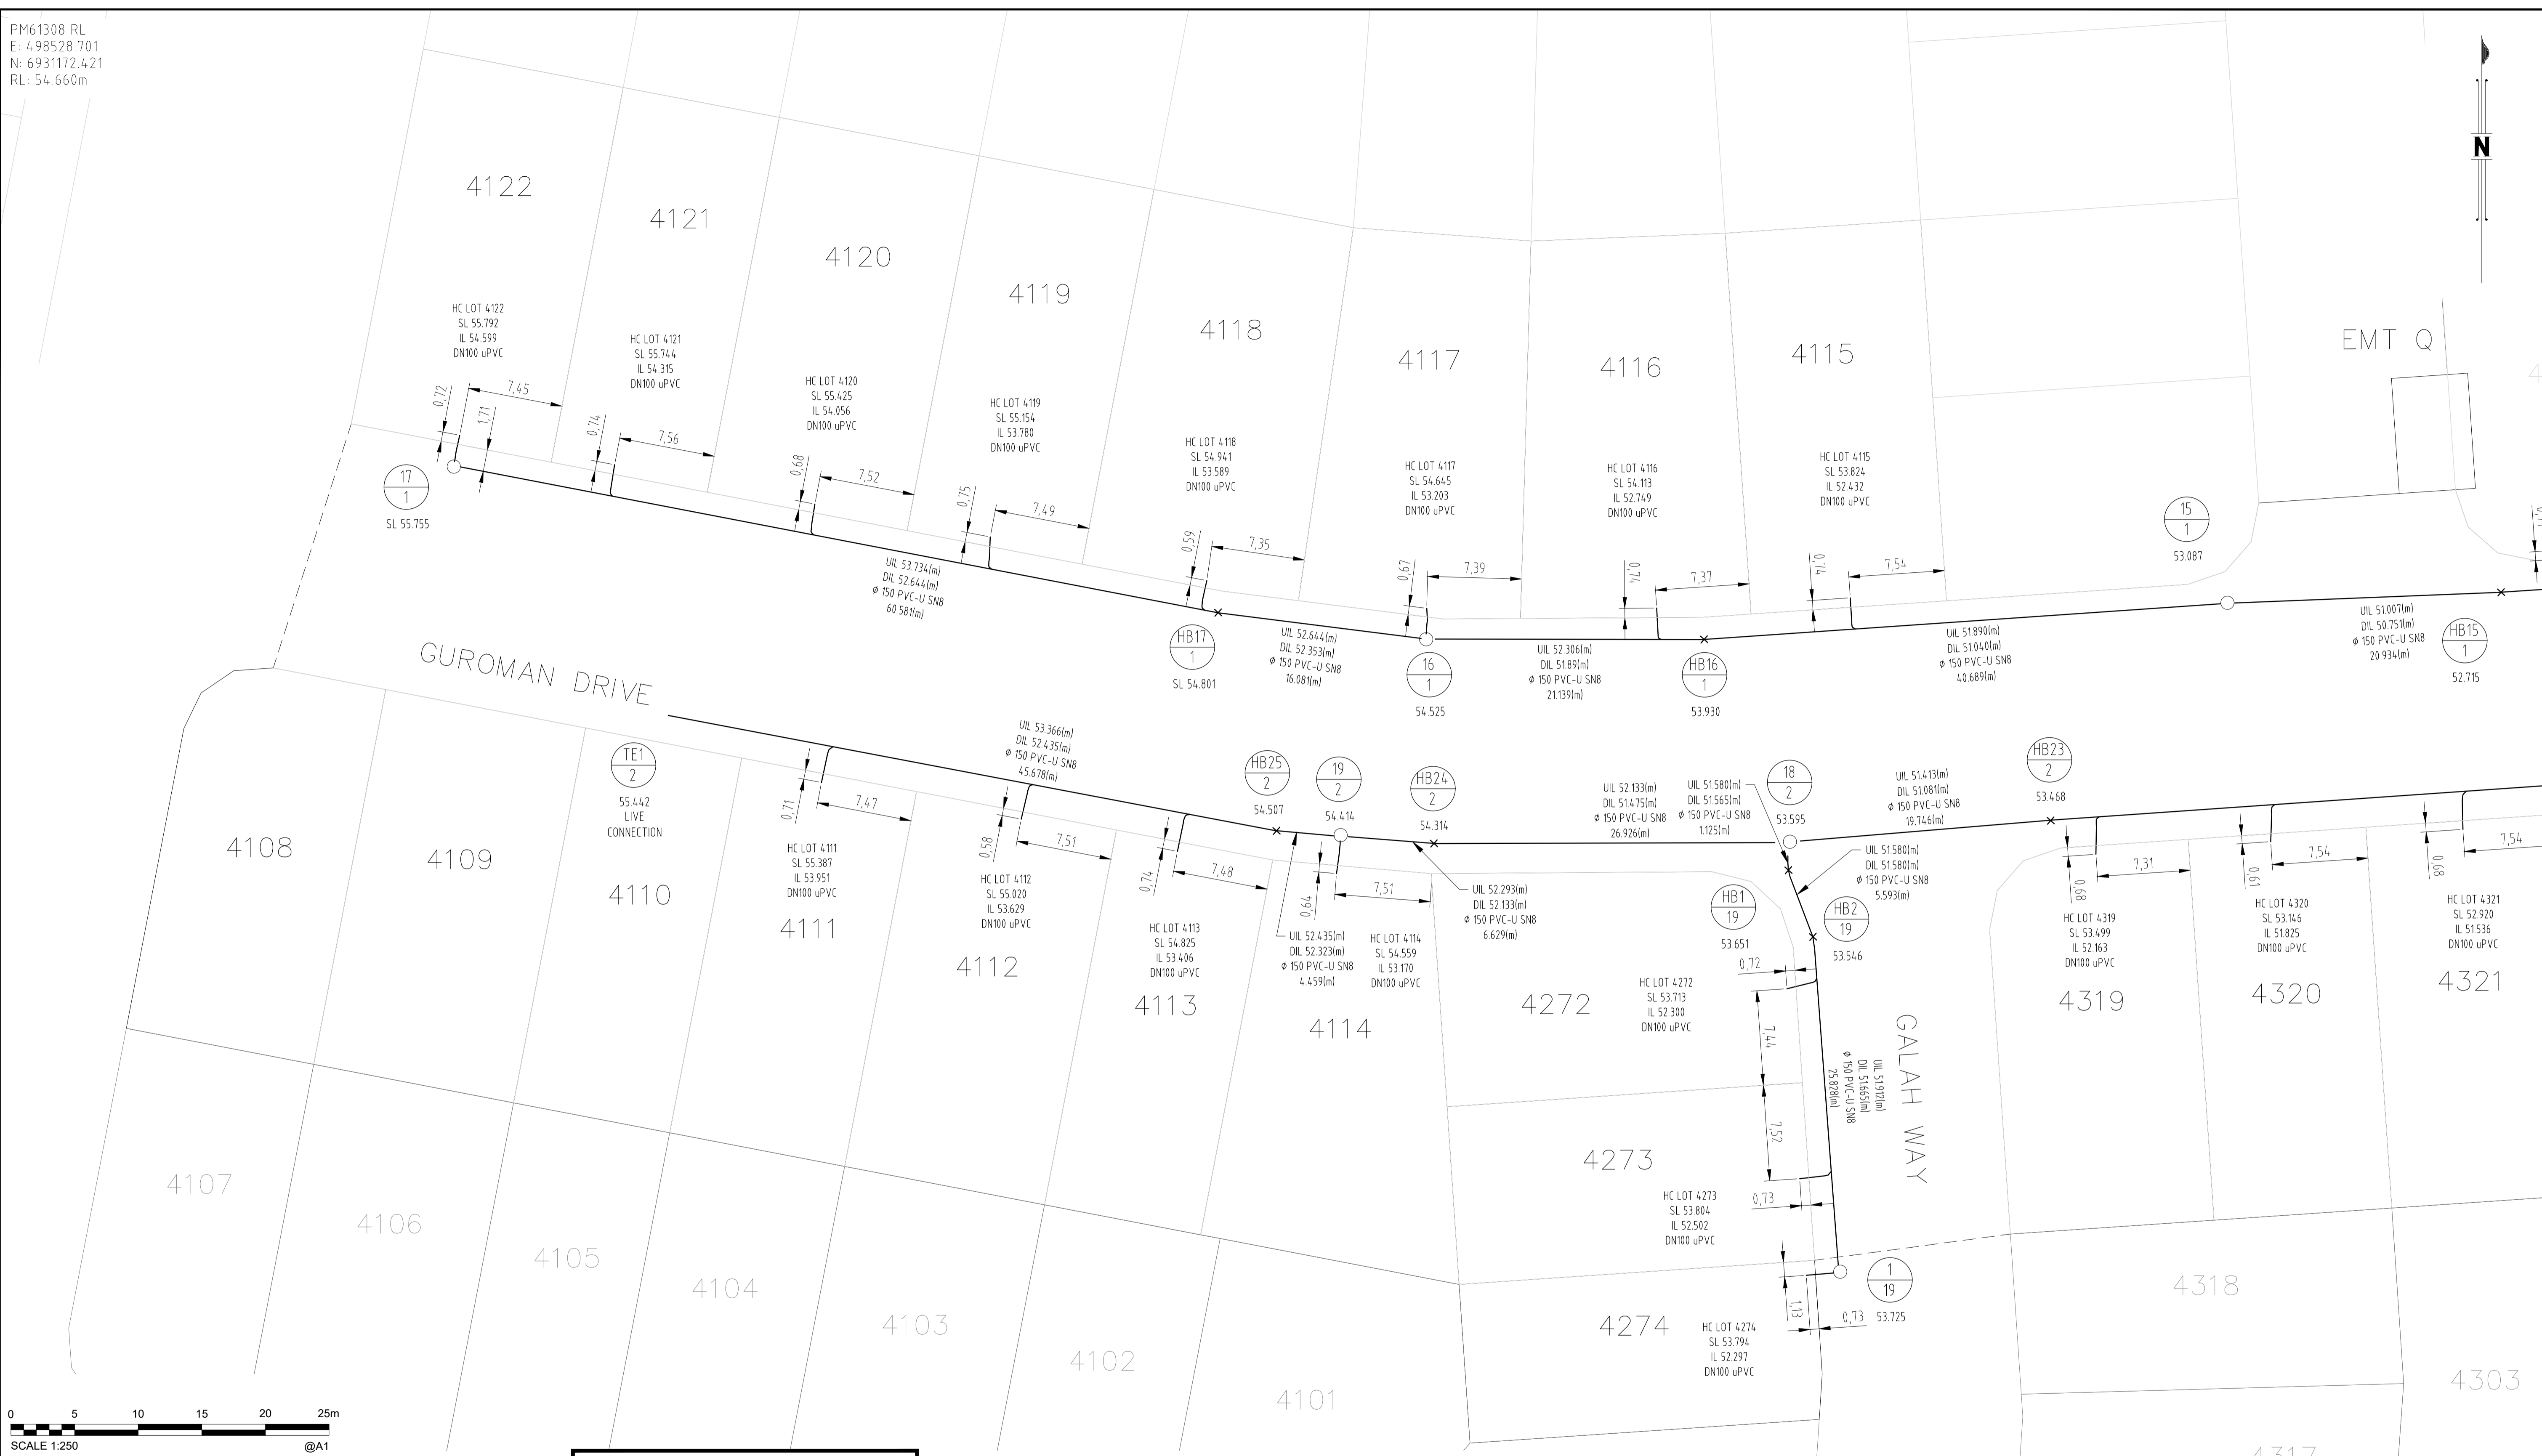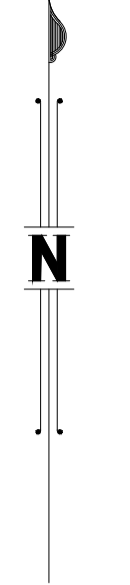

AS CONSTRUCTED

COORDINATE DATUM NOTE:
 HORIZONTAL COORDINATES(E,N) SUPPLIED ARE MAPPING GRID OF AUSTRALIA(MGA), ZONE 56 BASED ON THE UNIVERSAL TRANSVERSE MERCATOR PROJECTION AND THE GEOCENTRIC DATUM OF AUSTRALIA 2020.
 HORIZONTAL DATUM DERIVED FROM PSM 61308 E 498528.114 N 6931171.033.
 LEVELS SUPPLIED ARE ON THE AUSTRALIAN HEIGHT DATUM(AHD)
 LEVEL DATUM DERIVED FROM PSM 61308 RL54.660 (AHD)

ENGINEER'S CERTIFICATION
 I, _____, hereby certify that:
 1. The information contained in this drawing / document is in compliance with approved drawings and design.
 2. The new water and sewerage works defined by this drawing have been designed and constructed in accordance with the SEQ Code.
 3. This represents an accurate record of as-constructed works.
 4. I accept responsibility for the information contained in this drawing / document.
 RPEQ (signature) RPEQ No. _____ Date: _____

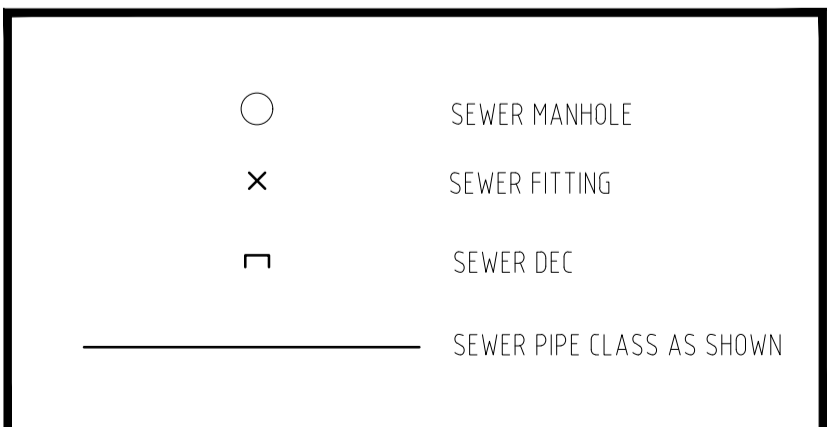

REGISTERED SURVEYING ASSOCIATE CERTIFICATION
 I, Stephen Seipel, hereby certify that the vertical and horizontal locations and dimensions shown on this plan are a true and correct record and were located by survey.
 Registered Surveying Associate (sig) Surveyor No. SA 7312 Date: 21/01/2025


A1	INDEX	DATE	AS CONSTRUCTED	DRAWN	CHECKED	PASSED	DRAWN	CHECKED	PASSED
				DRAWN	RDE	21/01/2025			
				CHECKED	DAM	21/01/2025			
				PASSED					
				INITIALS		DATE			




LOGAN CITY COUNCIL
 MIRVAC MIR-1004
 AS CONSTRUCTED SURVEY - SEWER
 EVERLEIGH PRECINCT 10.4C
 GREENBANK QLD

SHEET 2 OF 8	SHEETS	SCALE 1:250 A1
REVISION DATE	REVISION	
DISCIPLINE CODE		
DRAWING NO.		
ASC-SEWER-02-10.4C		

PM61308 RL
E: 498528.701
N: 6931172.421
RL: 54.660m

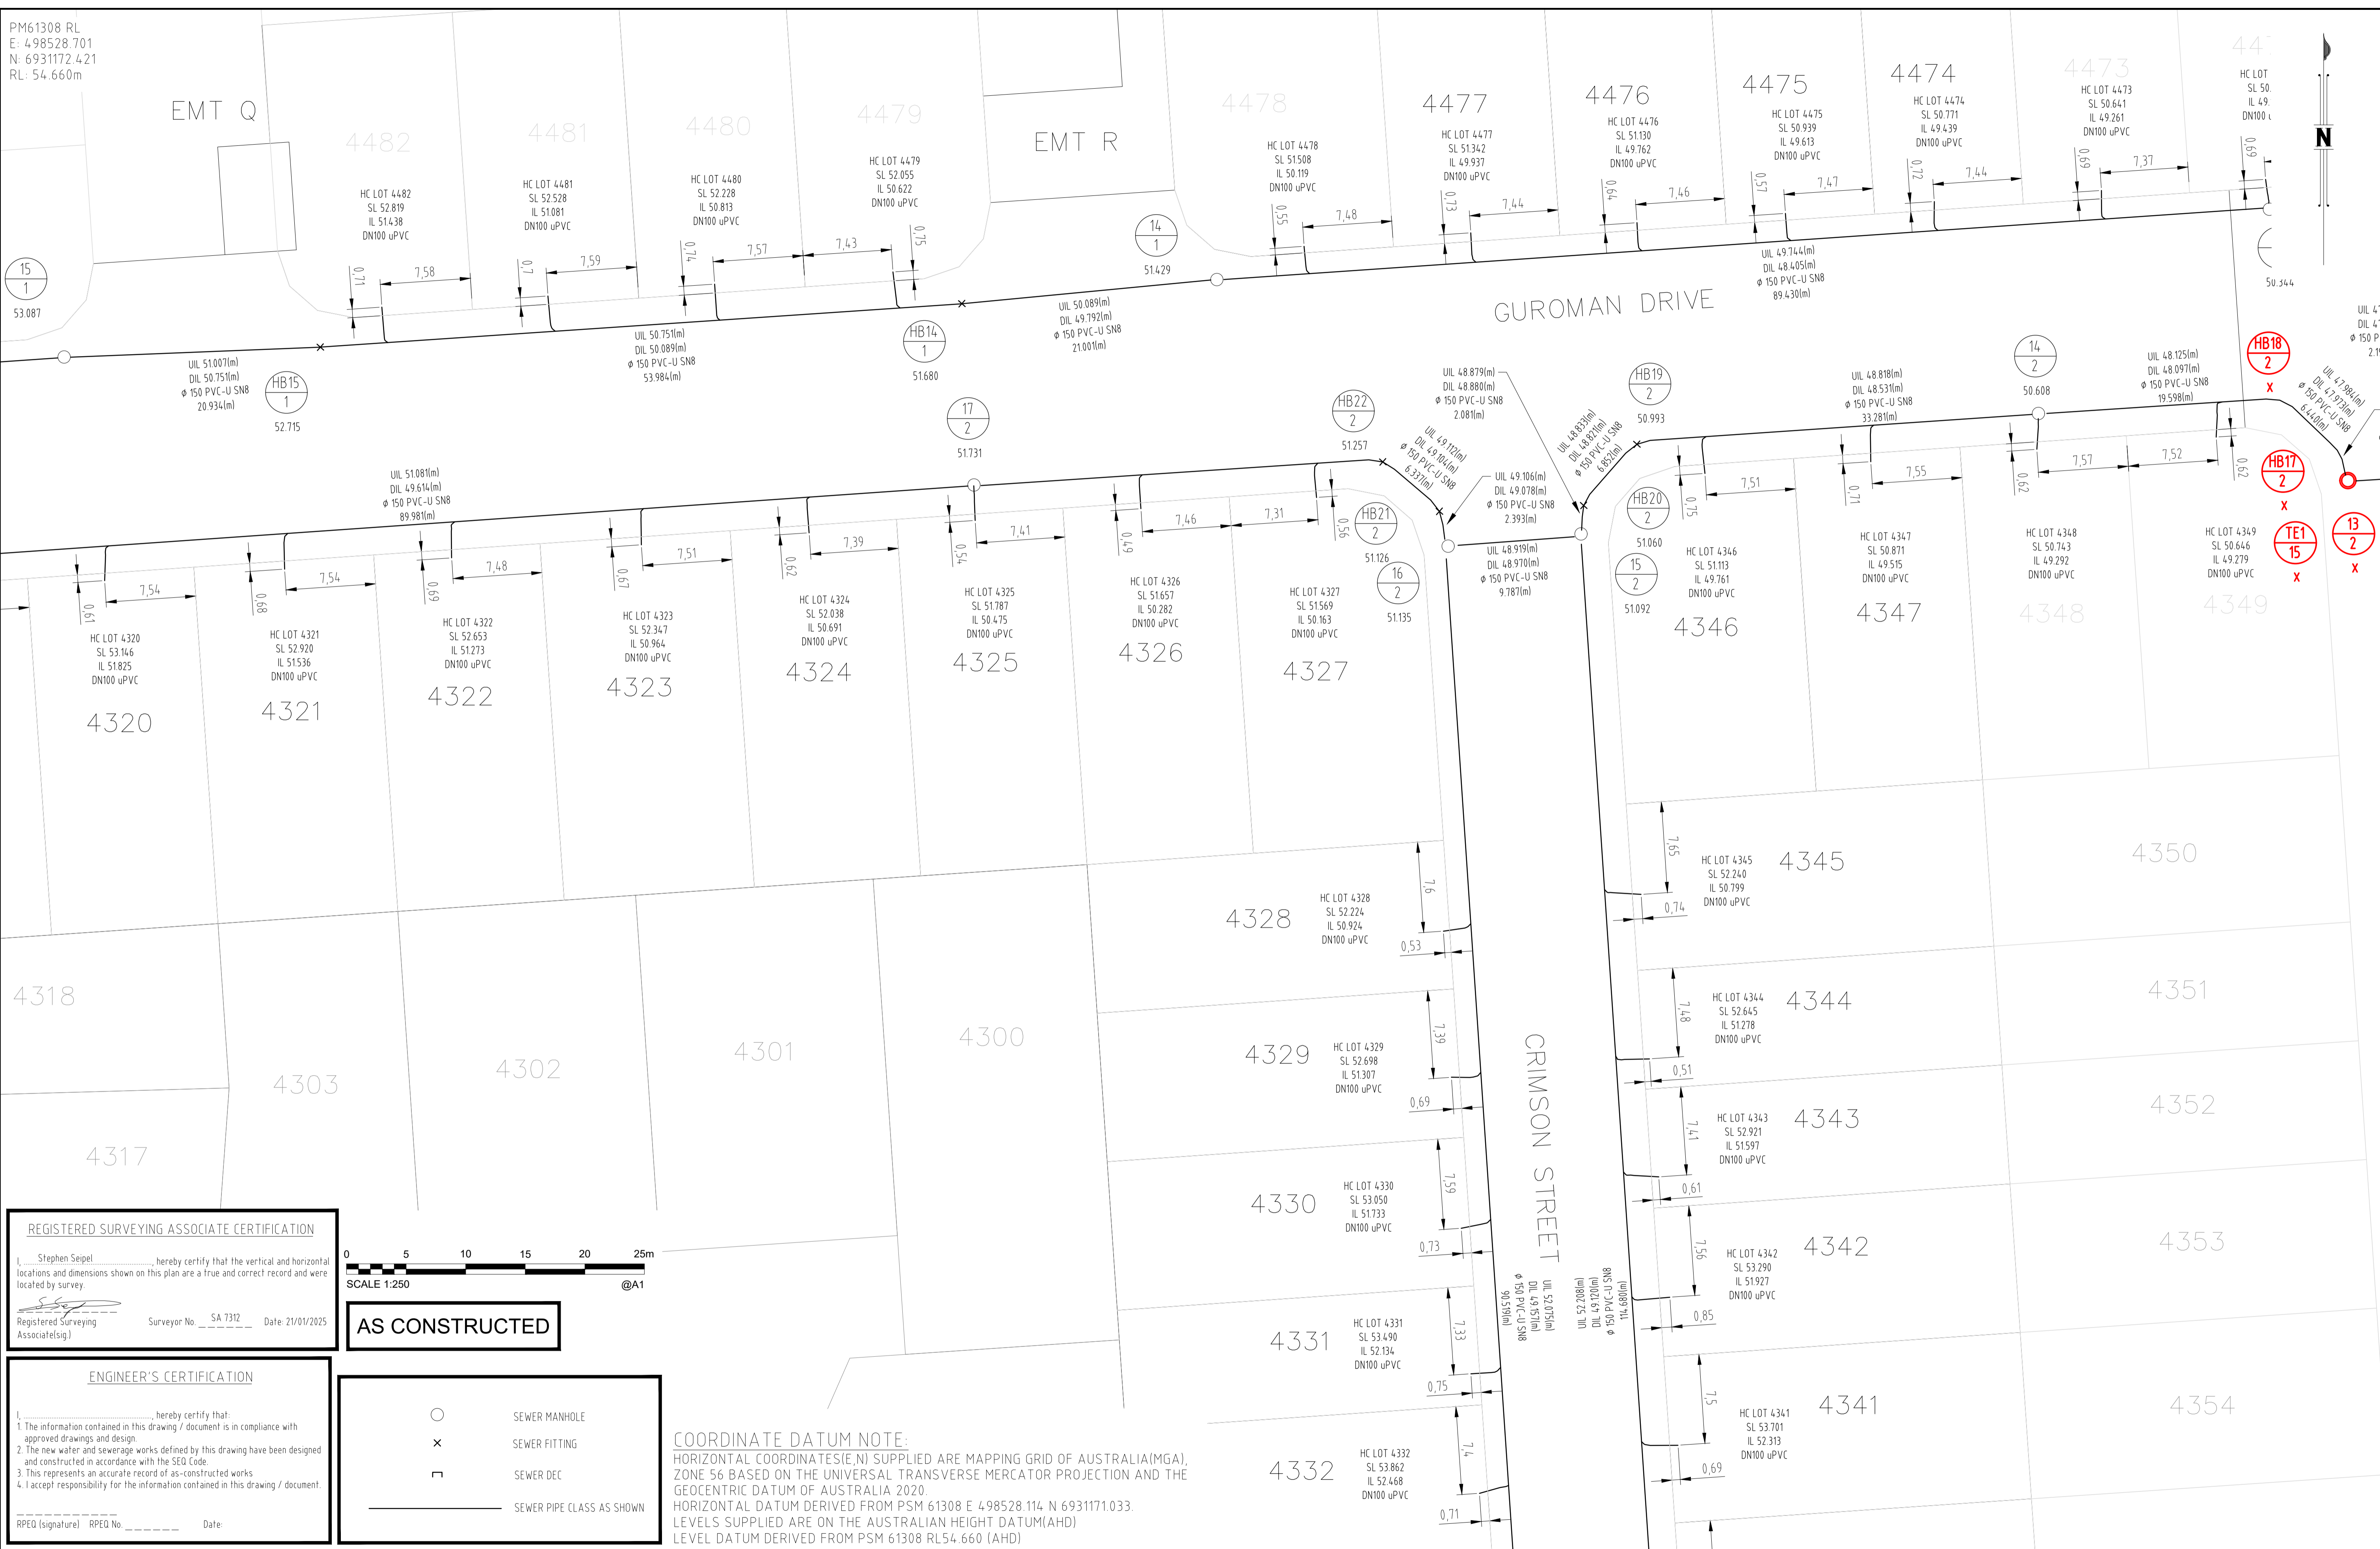


REGISTERED SURVEYING ASSOCIATE CERTIFICATION
I, Stephen Seipel, hereby certify that the vertical and horizontal locations and dimensions shown on this plan are a true and correct record and were located by survey.
Registered Surveying Associate (sig) Surveyor No. SA 7312 Date: 21/01/2025

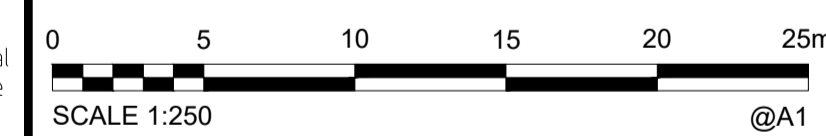

AS CONSTRUCTED

ENGINEER'S CERTIFICATION
I, _____, hereby certify that:
1. The information contained in this drawing / document is in compliance with approved drawings and design.
2. The new water and sewerage works defined by this drawing have been designed and constructed in accordance with the SEQ Code.
3. This represents an accurate record of as-constructed works.
4. I accept responsibility for the information contained in this drawing / document.
RPEQ (signature) RPEQ No. _____ Date: _____

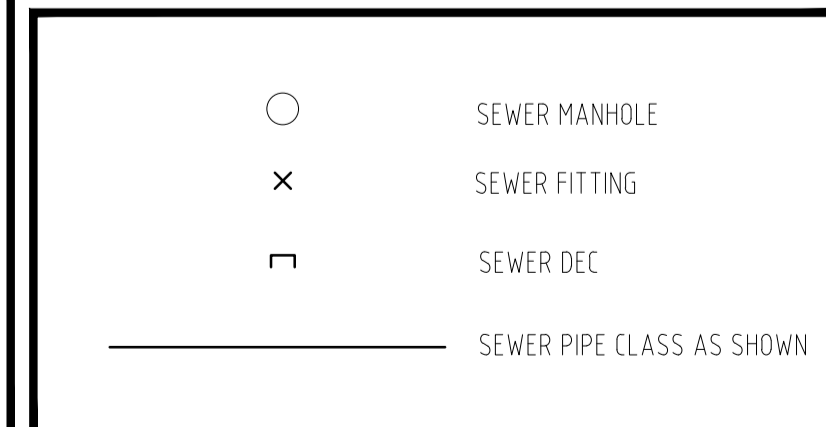

COORDINATE DATUM NOTE:
HORIZONTAL COORDINATES(E,N) SUPPLIED ARE MAPPING GRID OF AUSTRALIA(MGA), ZONE 56 BASED ON THE UNIVERSAL TRANSVERSE MERCATOR PROJECTION AND THE GEOCENTRIC DATUM OF AUSTRALIA 2020.
HORIZONTAL DATUM DERIVED FROM PSM 61308 E 498528.114 N 6931171.033.
LEVELS SUPPLIED ARE ON THE AUSTRALIAN HEIGHT DATUM(AHD).
LEVEL DATUM DERIVED FROM PSM 61308 RL54.660 (AHD)

A1	INDEX	DATE	AS CONSTRUCTED	DRAWN	CHECKED	PASSED	DRAWN	CHECKED	PASSED	INITIALS	DATE

shadforth
99 Sandalwood Lane, Forest Glen QLD 4056
P: 07 5438 3300 E: 07 5438 3308 F: e.c@shadforth.com.au

LOGAN CITY COUNCIL

LOGAN CITY COUNCIL
MIRVAC MIR-1004
AS CONSTRUCTED SURVEY - SEWER
EVERLEIGH PRECINCT 10.4C
GREENBANK QLD

SHEET 3 OF 8 SHEETS	SCALE 1:250 A1
REVISION DATE	REVISION -
DISCIPLINE CODE -	
DRAWING NO. ASC-SEWER-03-10.4C	

PM61308 RL
E: 498528.701
N: 6931172.421
RL: 54.660m

4303

4302

4330

IL 51307
DN100 uPVC

HC LOT 4330
SL 53.050
IL 51333
DN100 uPVC

4331

HC LOT 4331
SL 53.490
IL 52.134
DN100 uPVC

4332

HC LOT 4332
SL 53.862
IL 52.468
DN100 uPVC

4333

HC LOT 4333
SL 54.103
IL 52.774
DN100 uPVC

IMSON STREET
UL 52.035(m)
DIL 49.531(m)
φ 150 PVC-U SN8
(90.531m)

4343

HC LOT 4343
SL 52.921
IL 51597
DN100 uPVC

4342

HC LOT 4342
SL 53.290
IL 51927
DN100 uPVC

4341

HC LOT 4341
SL 53.701
IL 52.313
DN100 uPVC

4340

HC LOT 4340
SL 54.108
IL 52.716
DN100 uPVC

4339

HC LOT 4339
SL 54.281
IL 52.829
DN100 uPVC

4338

HC LOT 4338
SL 54.121
IL 52.719
DN100 uPVC

4337

HC LOT 4337
SL 53.786
IL 52.462
DN100 uPVC

4336

HC LOT 4336
SL 53.441
IL 52.052
DN100 uPVC

4335

HC LOT 4335
SL 52.761
IL 51.311
DN100 uPVC

4334

HC LOT 4334
SL 51.804
IL 50.445
DN100 uPVC

4352

4353

4354

4355

4356

4357

4358

4359

4360

4361

4304

4305

4306

4307

4311

4308

4299

4298

4295


4296

4297

4294

4293

PEACH AVENUE

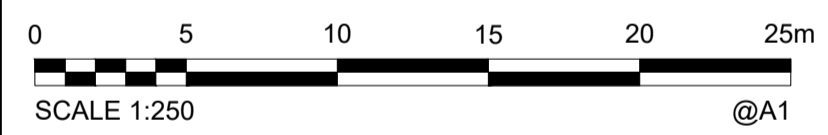

AS CONSTRUCTED

COORDINATE DATUM NOTE:
HORIZONTAL COORDINATES(E,N) SUPPLIED ARE MAPPING GRID OF AUSTRALIA(MGA), ZONE 56 BASED ON THE UNIVERSAL TRANSVERSE MERCATOR PROJECTION AND THE GEOCENTRIC DATUM OF AUSTRALIA 2020.
HORIZONTAL DATUM DERIVED FROM PSM 61308 E 498528.114 N 6931171.033.
LEVELS SUPPLIED ARE ON THE AUSTRALIAN HEIGHT DATUM(AHD)
LEVEL DATUM DERIVED FROM PSM 61308 RL54.660 (AHD)

ENGINEER'S CERTIFICATION
I, _____ hereby certify that:
1. The information contained in this drawing / document is in compliance with approved drawings and design.
2. The new water and sewerage works defined by this drawing have been designed and constructed in accordance with the SEQ Code.
3. This represents an accurate record of as-constructed works
4. I accept responsibility for the information contained in this drawing / document.
RPEQ (signature) RPEQ No. _____ Date: _____

- SEWER MANHOLE
- × SEWER FITTING
- ┌ SEWER DEC
- SEWER PIPE CLASS AS SHOWN

REGISTERED SURVEYING ASSOCIATE CERTIFICATION
I, Stephen Seigel, hereby certify that the vertical and horizontal locations and dimensions shown on this plan are a true and correct record and were located by survey.
Registered Surveying Associate(s)g) _____ Surveyor No. SA 7312 Date: 21/01/2025


A1	INDEX	DATE	AS CONSTRUCTED	REVISIONS	DRAWN	CHECKED	PASSED	DRAWN	CHECKED	PASSED	INITIALS	DATE



LOGAN CITY COUNCIL
MIRVAC MIR-1004
AS CONSTRUCTED SURVEY - SEWER
EVERLEIGH PRECINCT 10.4C
GREENBANK QLD

SHEET 4 OF 8 SHEETS	SCALE 1:250 A1
REVISION DATE	REVISION
DISCIPLINE CODE	-
DRAWING NO.	ASC-SEWER-04-10.4C


PM61308 RL
 E: 498528.701
 N: 6931172.421
 RL: 54.660m

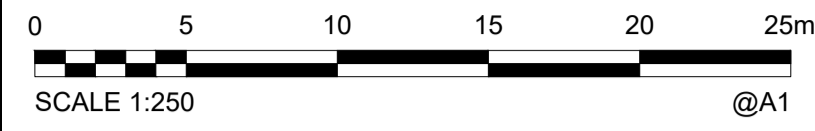

AS CONSTRUCTED

COORDINATE DATUM NOTE:


HORIZONTAL COORDINATES(E,N) SUPPLIED ARE MAPPING GRID OF AUSTRALIA(MGA), ZONE 56 BASED ON THE UNIVERSAL TRANSVERSE MERCATOR PROJECTION AND THE GEOCENTRIC DATUM OF AUSTRALIA 2020.
 HORIZONTAL DATUM DERIVED FROM PSM 61308 E 498528.114 N 6931171.033
 LEVELS SUPPLIED ARE ON THE AUSTRALIAN HEIGHT DATUM(AHD)
 LEVEL DATUM DERIVED FROM PSM 61308 RL54.660 (AHD)

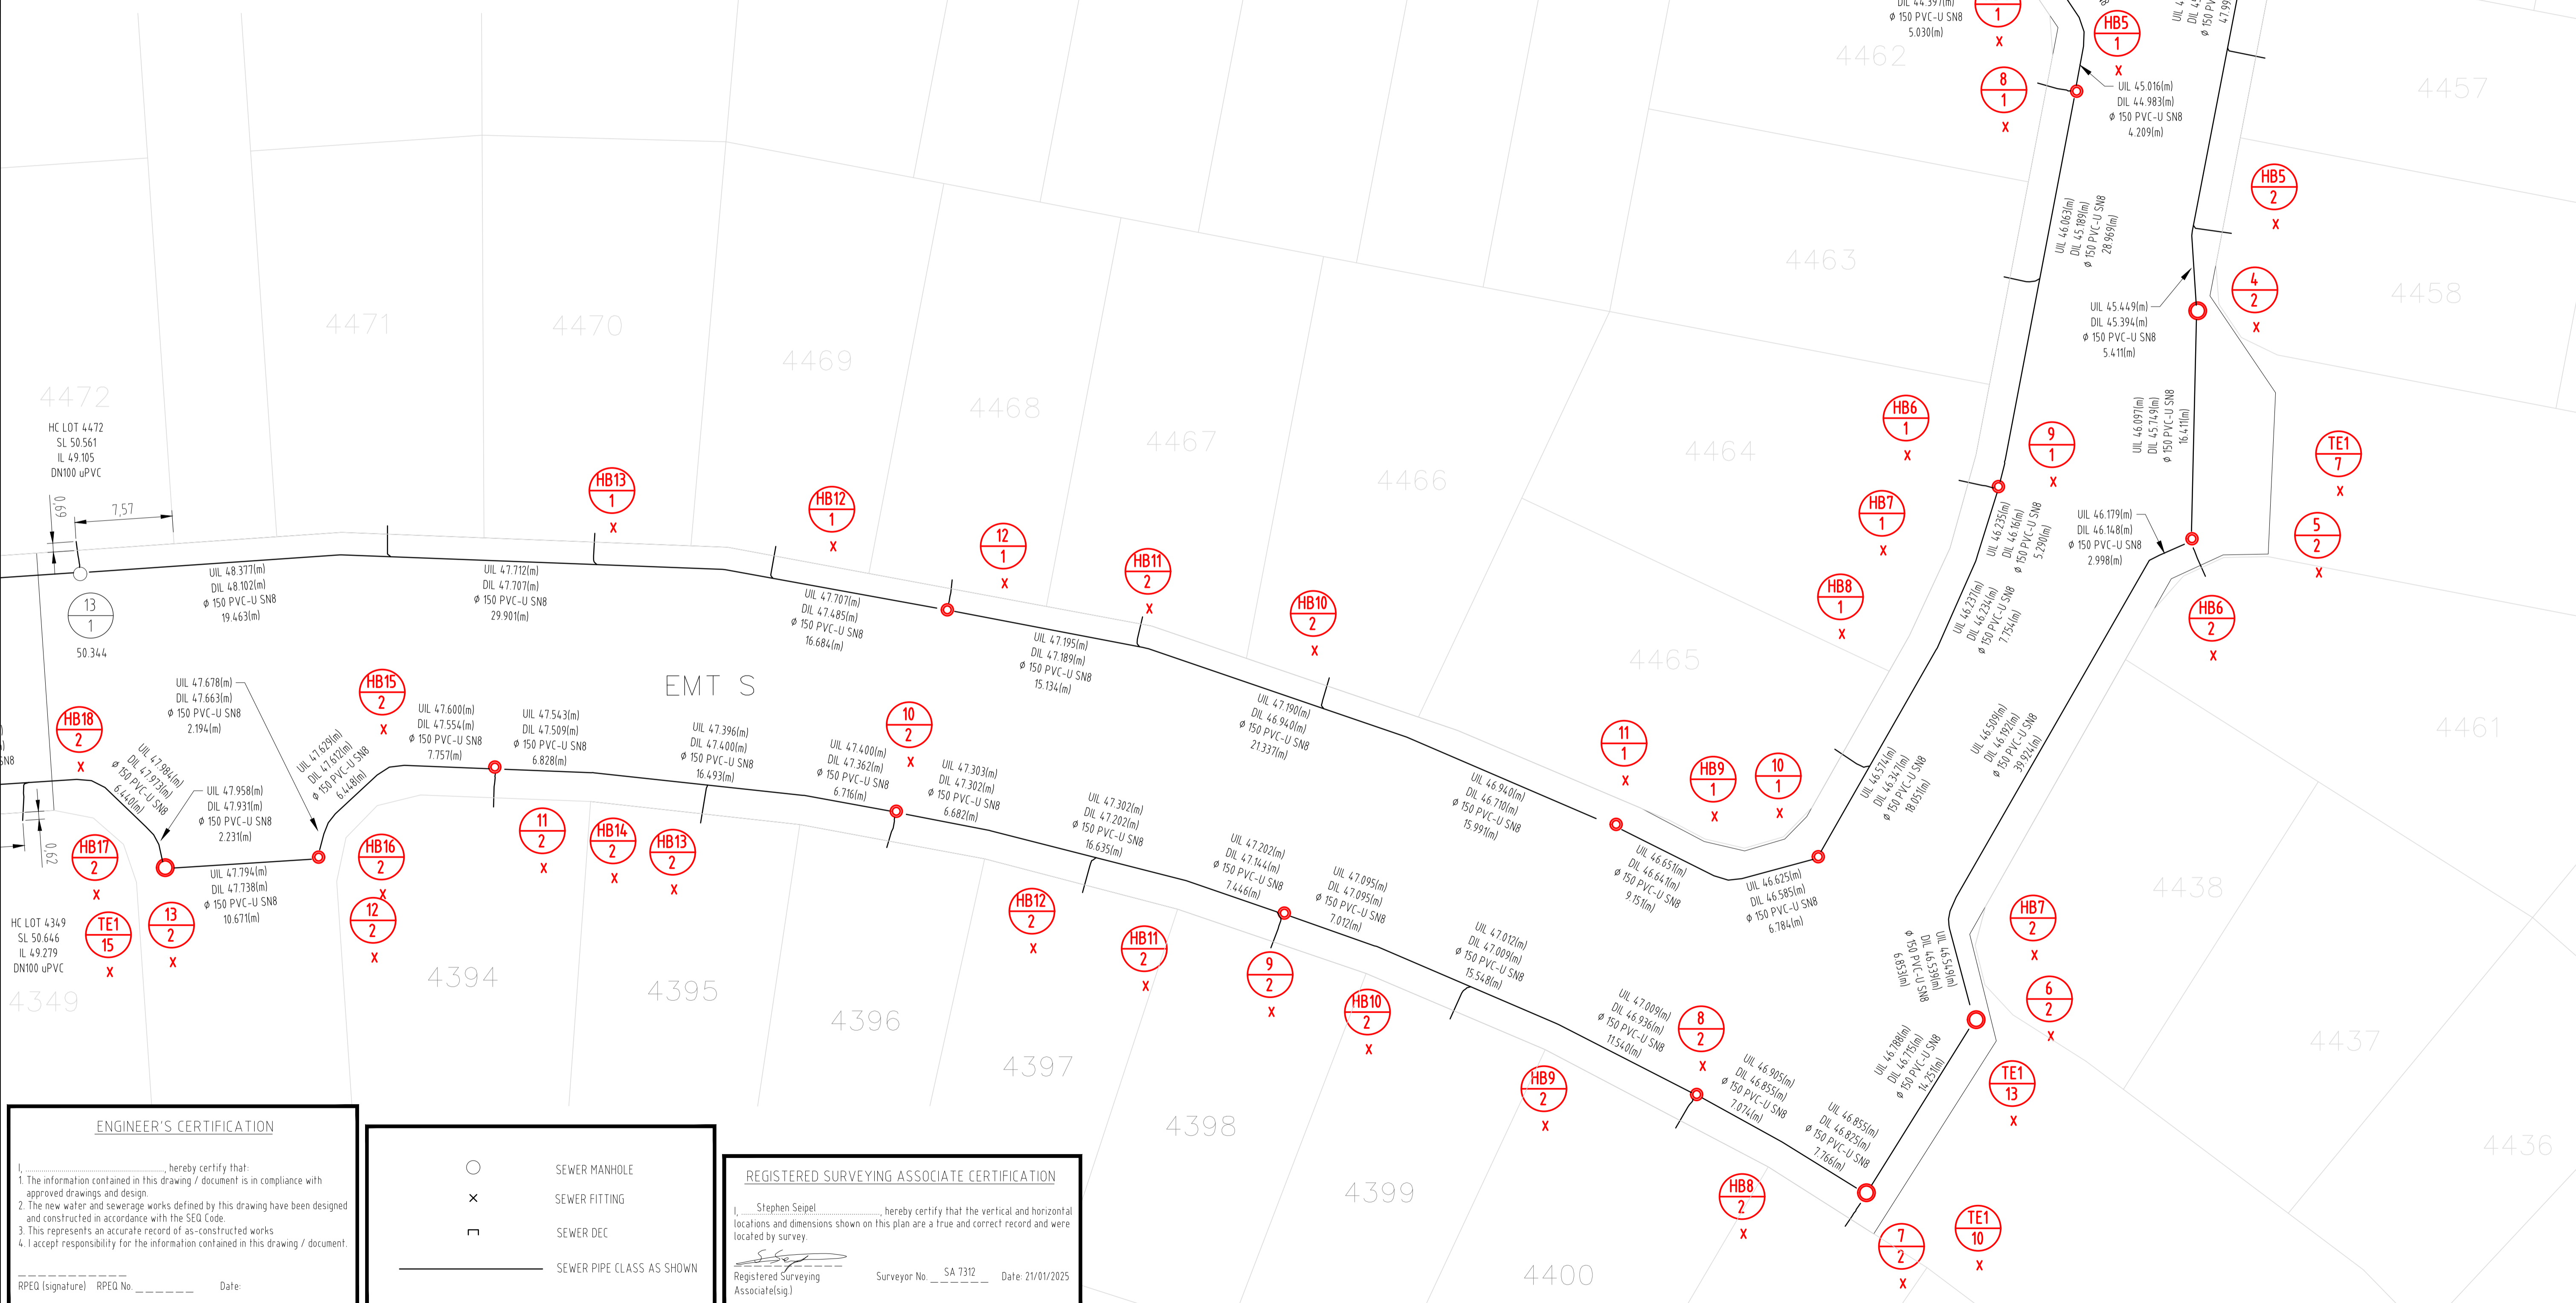

ENGINEER'S CERTIFICATION

I, _____ hereby certify that:
 1. The information contained in this drawing / document is in compliance with approved drawings and design.
 2. The new water and sewerage works defined by this drawing have been designed and constructed in accordance with the SEQ Code.
 3. This represents an accurate record of as-constructed works
 4. I accept responsibility for the information contained in this drawing / document.

RPEQ (signature) RPEQ No. _____ Date: _____

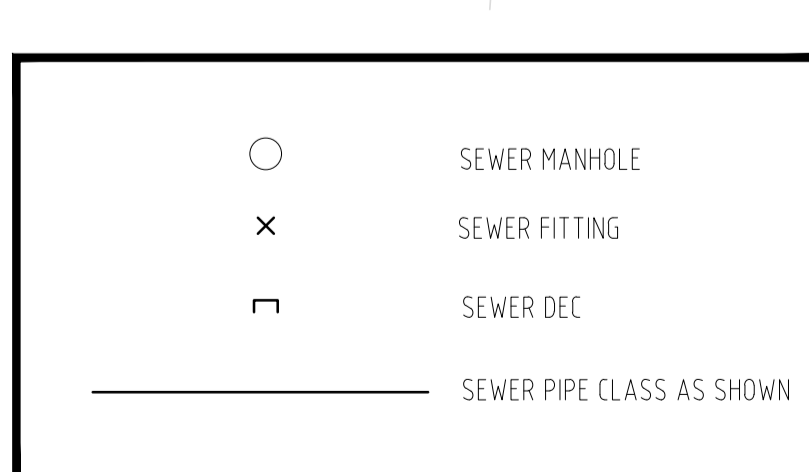

REGISTERED SURVEYING ASSOCIATE CERTIFICATION

I, Stephen Seigel, hereby certify that the vertical and horizontal locations and dimensions shown on this plan are a true and correct record and were located by survey.

Registered Surveying Associate(sig) _____ Surveyor No. SA 7312 Date: 21/01/2025

A1	INDEX	DATE	AS CONSTRUCTED	REVISIONS	DRAWN	CHECKED	PASSED	INITIALS	DATE




99 Sandwood Lane, Forest Glen QLD 4056
 P: 07 5438 3300 F: 07 5438 3308 E: info@shadforth.com.au

LOGAN CITY COUNCIL

MIRVAC MIR-1004
 AS CONSTRUCTED SURVEY - SEWER
 EVERLEIGH PRECINCT 10.4C
 GREENBANK QLD

SHEET 5 OF 8 SHEETS	SCALE 1:250 A1
REVISION DATE	REVISION
DISCIPLINE CODE	
DRAWING NO.	ASC-SEWER-05-10.4C

PM61308 RL
 E: 498528.701
 N: 6931172.421
 RL: 54.660m

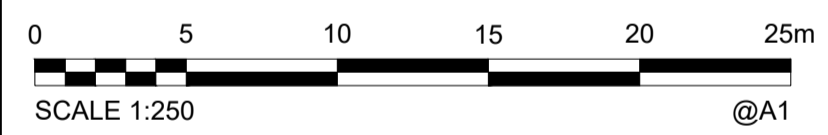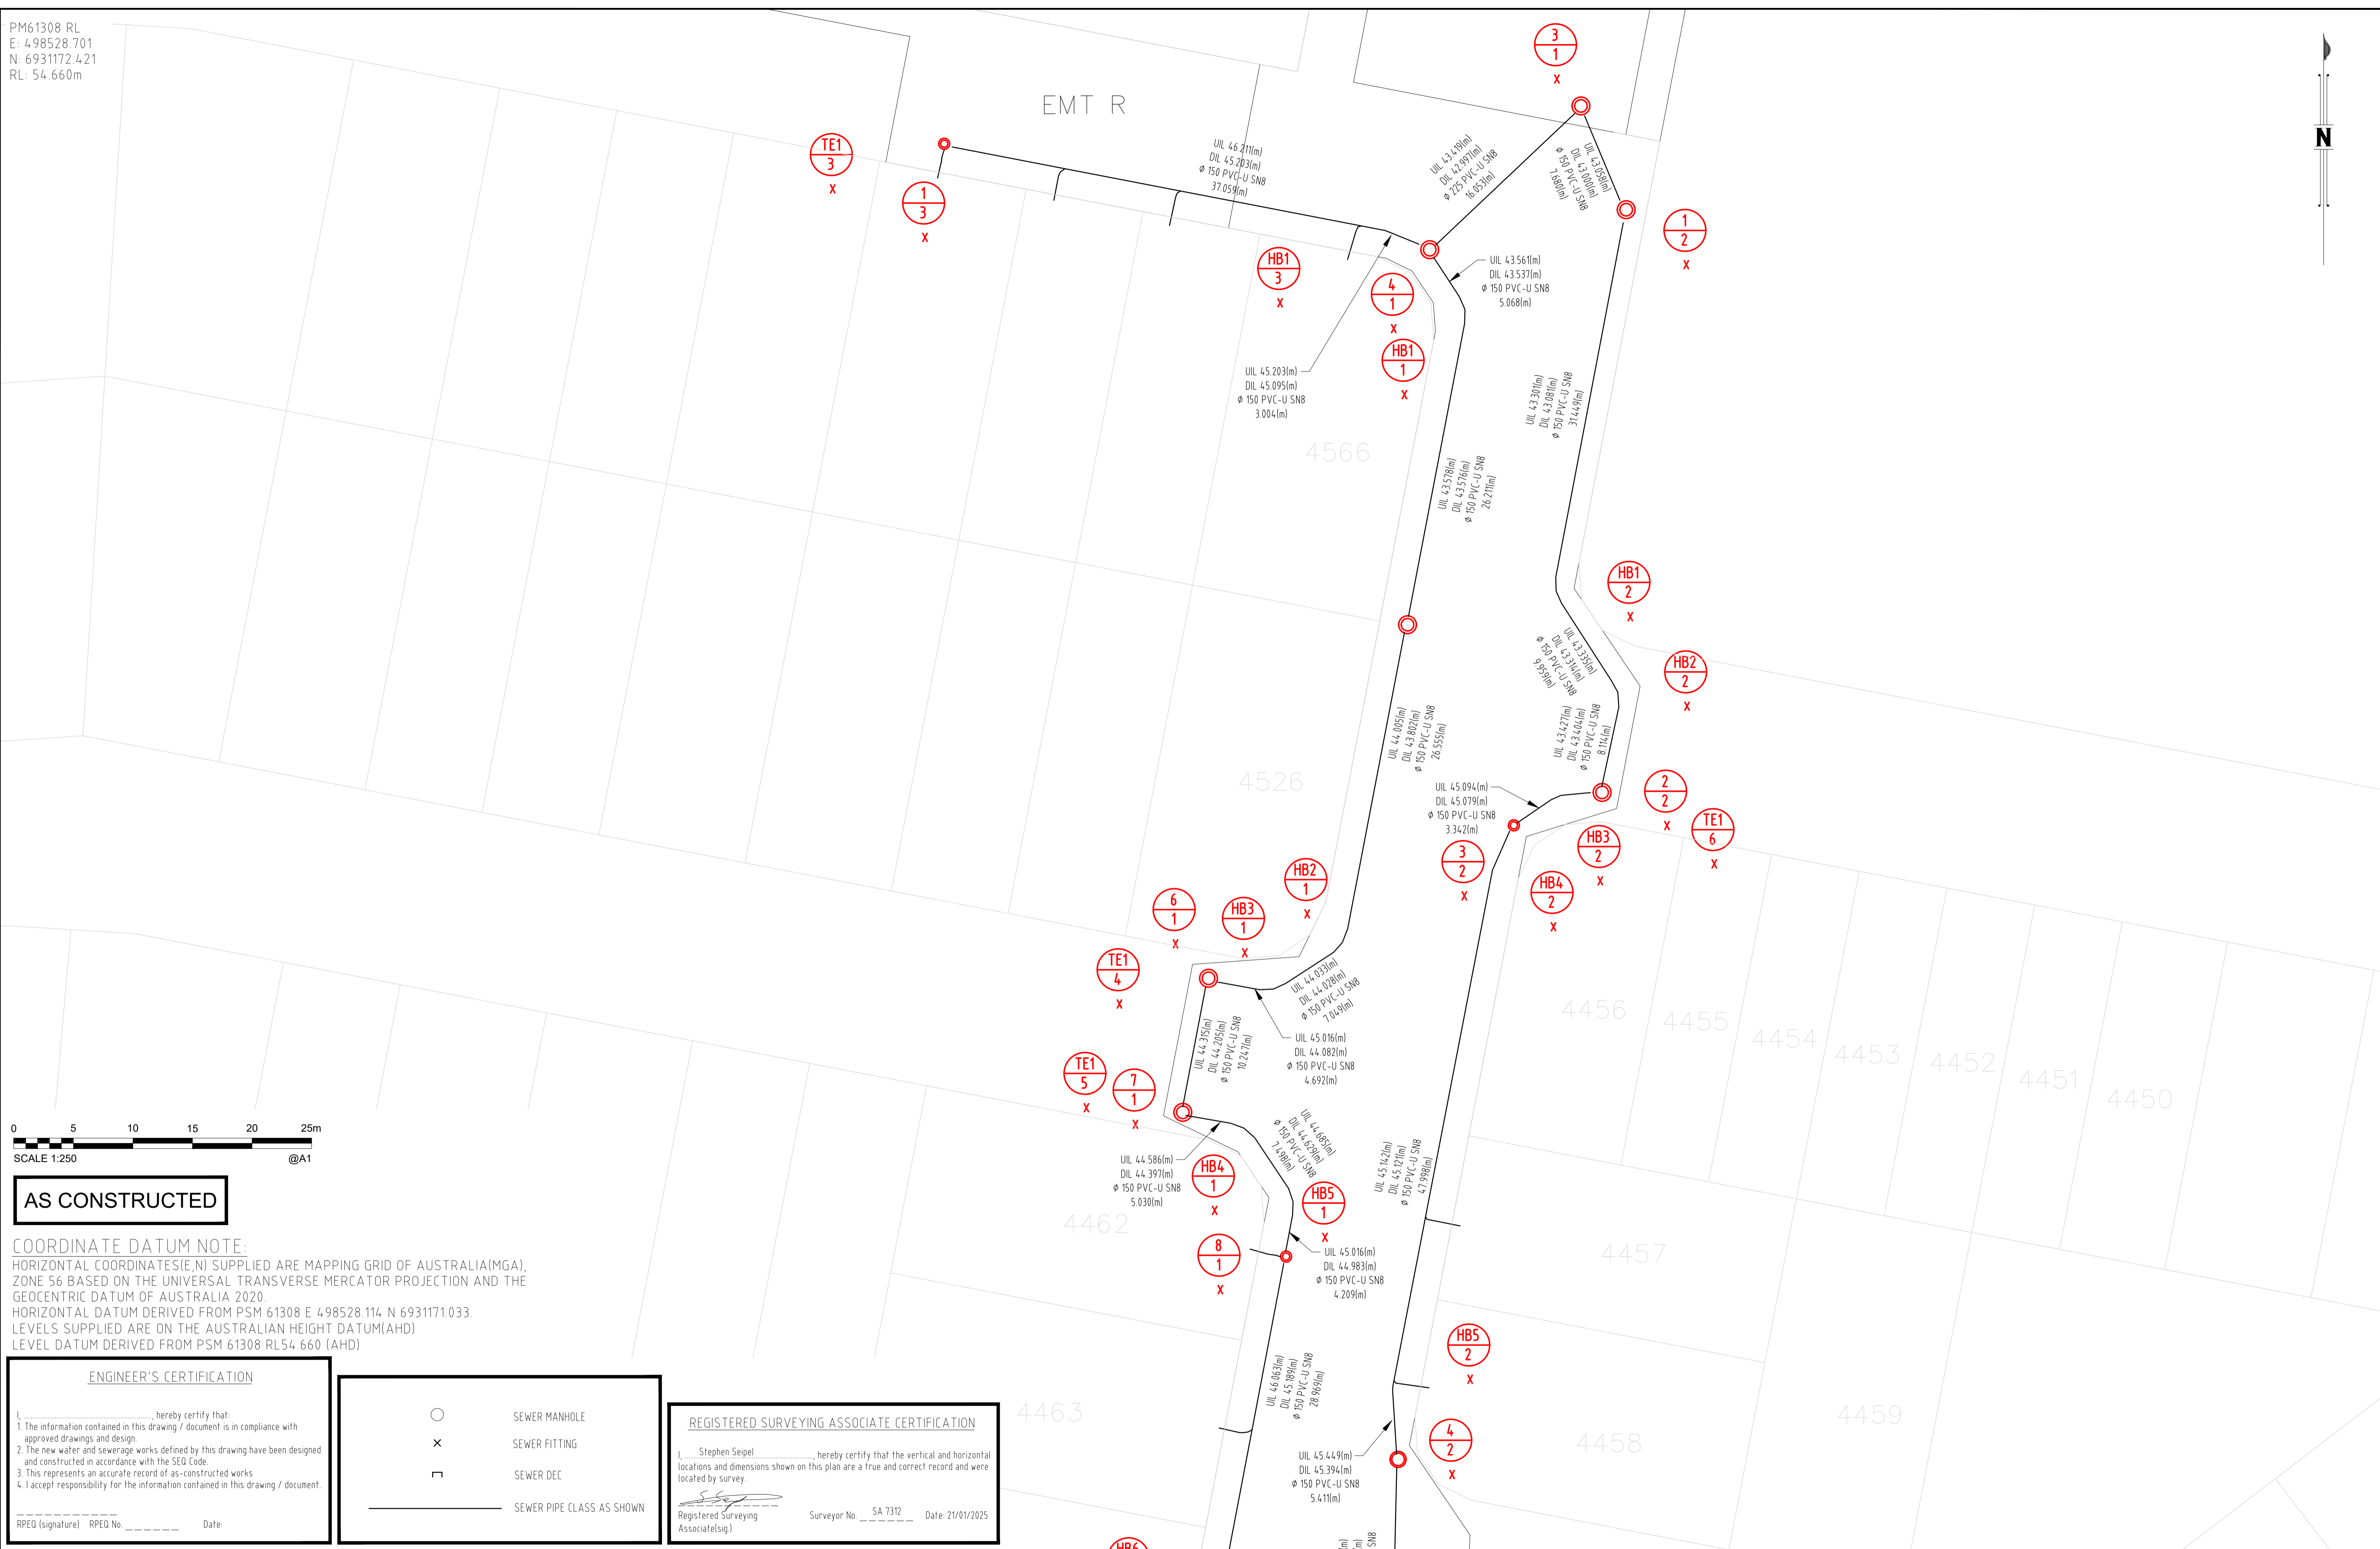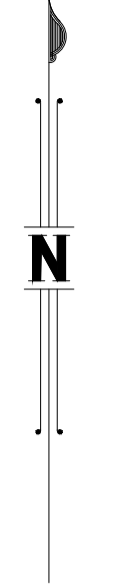

AS CONSTRUCTED

COORDINATE DATUM NOTE:
 HORIZONTAL COORDINATES(E,N) SUPPLIED ARE MAPPING GRID OF AUSTRALIA(MGA), ZONE 56 BASED ON THE UNIVERSAL TRANSVERSE MERCATOR PROJECTION AND THE GEOCENTRIC DATUM OF AUSTRALIA 2020.
 HORIZONTAL DATUM DERIVED FROM PSM 61308 E 498528.114 N 6931171.033.
 LEVELS SUPPLIED ARE ON THE AUSTRALIAN HEIGHT DATUM(AHD)
 LEVEL DATUM DERIVED FROM PSM 61308 RL54.660 (AHD)

ENGINEER'S CERTIFICATION
 I, _____ hereby certify that:
 1. The information contained in this drawing / document is in compliance with approved drawings and design.
 2. The new water and sewerage works defined by this drawing have been designed and constructed in accordance with the SEQ Code.
 3. This represents an accurate record of as-constructed works
 4. I accept responsibility for the information contained in this drawing / document.
 RPEQ (signature) RPEQ No. _____ Date: _____

○	SEWER MANHOLE
×	SEWER FITTING
┌	SEWER DEC
—	SEWER PIPE CLASS AS SHOWN

REGISTERED SURVEYING ASSOCIATE CERTIFICATION
 I, Stephen Seigel, hereby certify that the vertical and horizontal locations and dimensions shown on this plan are a true and correct record and were located by survey.
 Registered Surveying Associate (sig) Surveyor No. SA 7312 Date: 21/01/2025

A1	INDEX	DATE	AS CONSTRUCTED	REVISIONS	DRAWN	CHECKED	PASSED	DRAWN	CHECKED	PASSED

shadforth
 99 Sandalwood Lane, Forest Glen QLD 4056
 P: 07 5438 3300 F: 07 5438 3308 E: admin@shadforth.com.au

LOGAN CITY COUNCIL

LOGAN CITY COUNCIL
 MIRVAC MIR-1004
 AS CONSTRUCTED SURVEY - SEWER
 EVERLEIGH PRECINCT 10.4C
 GREENBANK QLD

SHEET 6 OF 8 SHEETS	SCALE 1:250 A1
REVISION DATE	REVISION
DISCIPLINE CODE	
DRAWING NO.	ASC-SEWER-06-10.4C