


PM61308 RL
 E: 498528.701
 N: 6931172.421
 RL: 54.660m



AS CONSTRUCTED

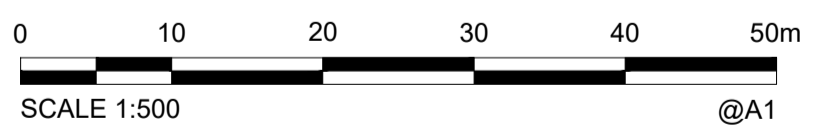

REGISTERED SURVEYING ASSOCIATE CERTIFICATION
 I, Stephen Seipel, hereby certify that the vertical and horizontal locations and dimensions shown on this plan are a true and correct record and were located by survey.
 Registered Surveying Associate (sig) Surveyor No. SA 7312 Date: 21/02/2025

COORDINATE DATUM NOTE:
 HORIZONTAL COORDINATES (E, N) SUPPLIED ARE MAPPING GRID OF AUSTRALIA (MGA), ZONE 56 BASED ON THE UNIVERSAL TRANSVERSE MERCATOR PROJECTION AND THE GEOCENTRIC DATUM OF AUSTRALIA 2020.
 HORIZONTAL DATUM DERIVED FROM PSM 61308 E 498528.114 N 6931171.033.
 LEVELS SUPPLIED ARE ON THE AUSTRALIAN HEIGHT DATUM (AHD)
 LEVEL DATUM DERIVED FROM PSM 61308 RL 54.660 (AHD)

- WATER METER BOX
- WATER REDUCER
- WATER BEND
- WATER TAPING BAND
- WATER BALL VALVE/STOP VALVE
- WATER FIRE HYDRANT
- WATERMAIN LINE (SIZE AND CLASS AS SHOWN)

ENGINEER'S CERTIFICATION
 I, _____, hereby certify that:
 1. The information contained in this drawing / document is in compliance with approved drawings and design.
 2. The new water and sewerage works defined by this drawing have been designed and constructed in accordance with the SEQ Code.
 3. This represents an accurate record of as-constructed works.
 4. I accept responsibility for the information contained in this drawing / document.
 RPEQ (signature) RPEQ No. _____ Date: _____



A1	INDEX	DATE	AS CONSTRUCTED	DRAWN	CHECKED	PASSED	DRAWN	CHECKED	PASSED

99 Sandalwood Lane, Forest Glen QLD 4056
 P: 07 5438 3300 > F: 07 5438 3308 > E: ash@shadforth.com.au

LOGAN CITY COUNCIL
 MIRVAC MIR-1004
 AS CONSTRUCTED SURVEY - WATERMAIN
 EVERLEIGH PRECINCT 10.4C
 GREENBANK QLD

SHEET 1 OF 6	SHEETS	SCALE 1:500 A1
REVISION DATE 21/02/2025	REVISION -	
DISCIPLINE CODE -		
DRAWING NO. ASC-WATERMAIN-01-10.4C		

PM61308 RL
 E: 498528.701
 N: 6931172.421
 RL: 54.660m

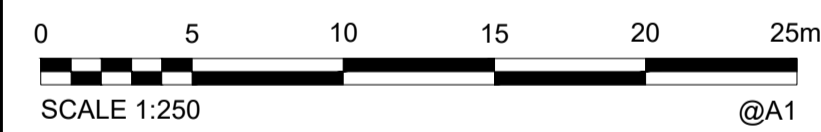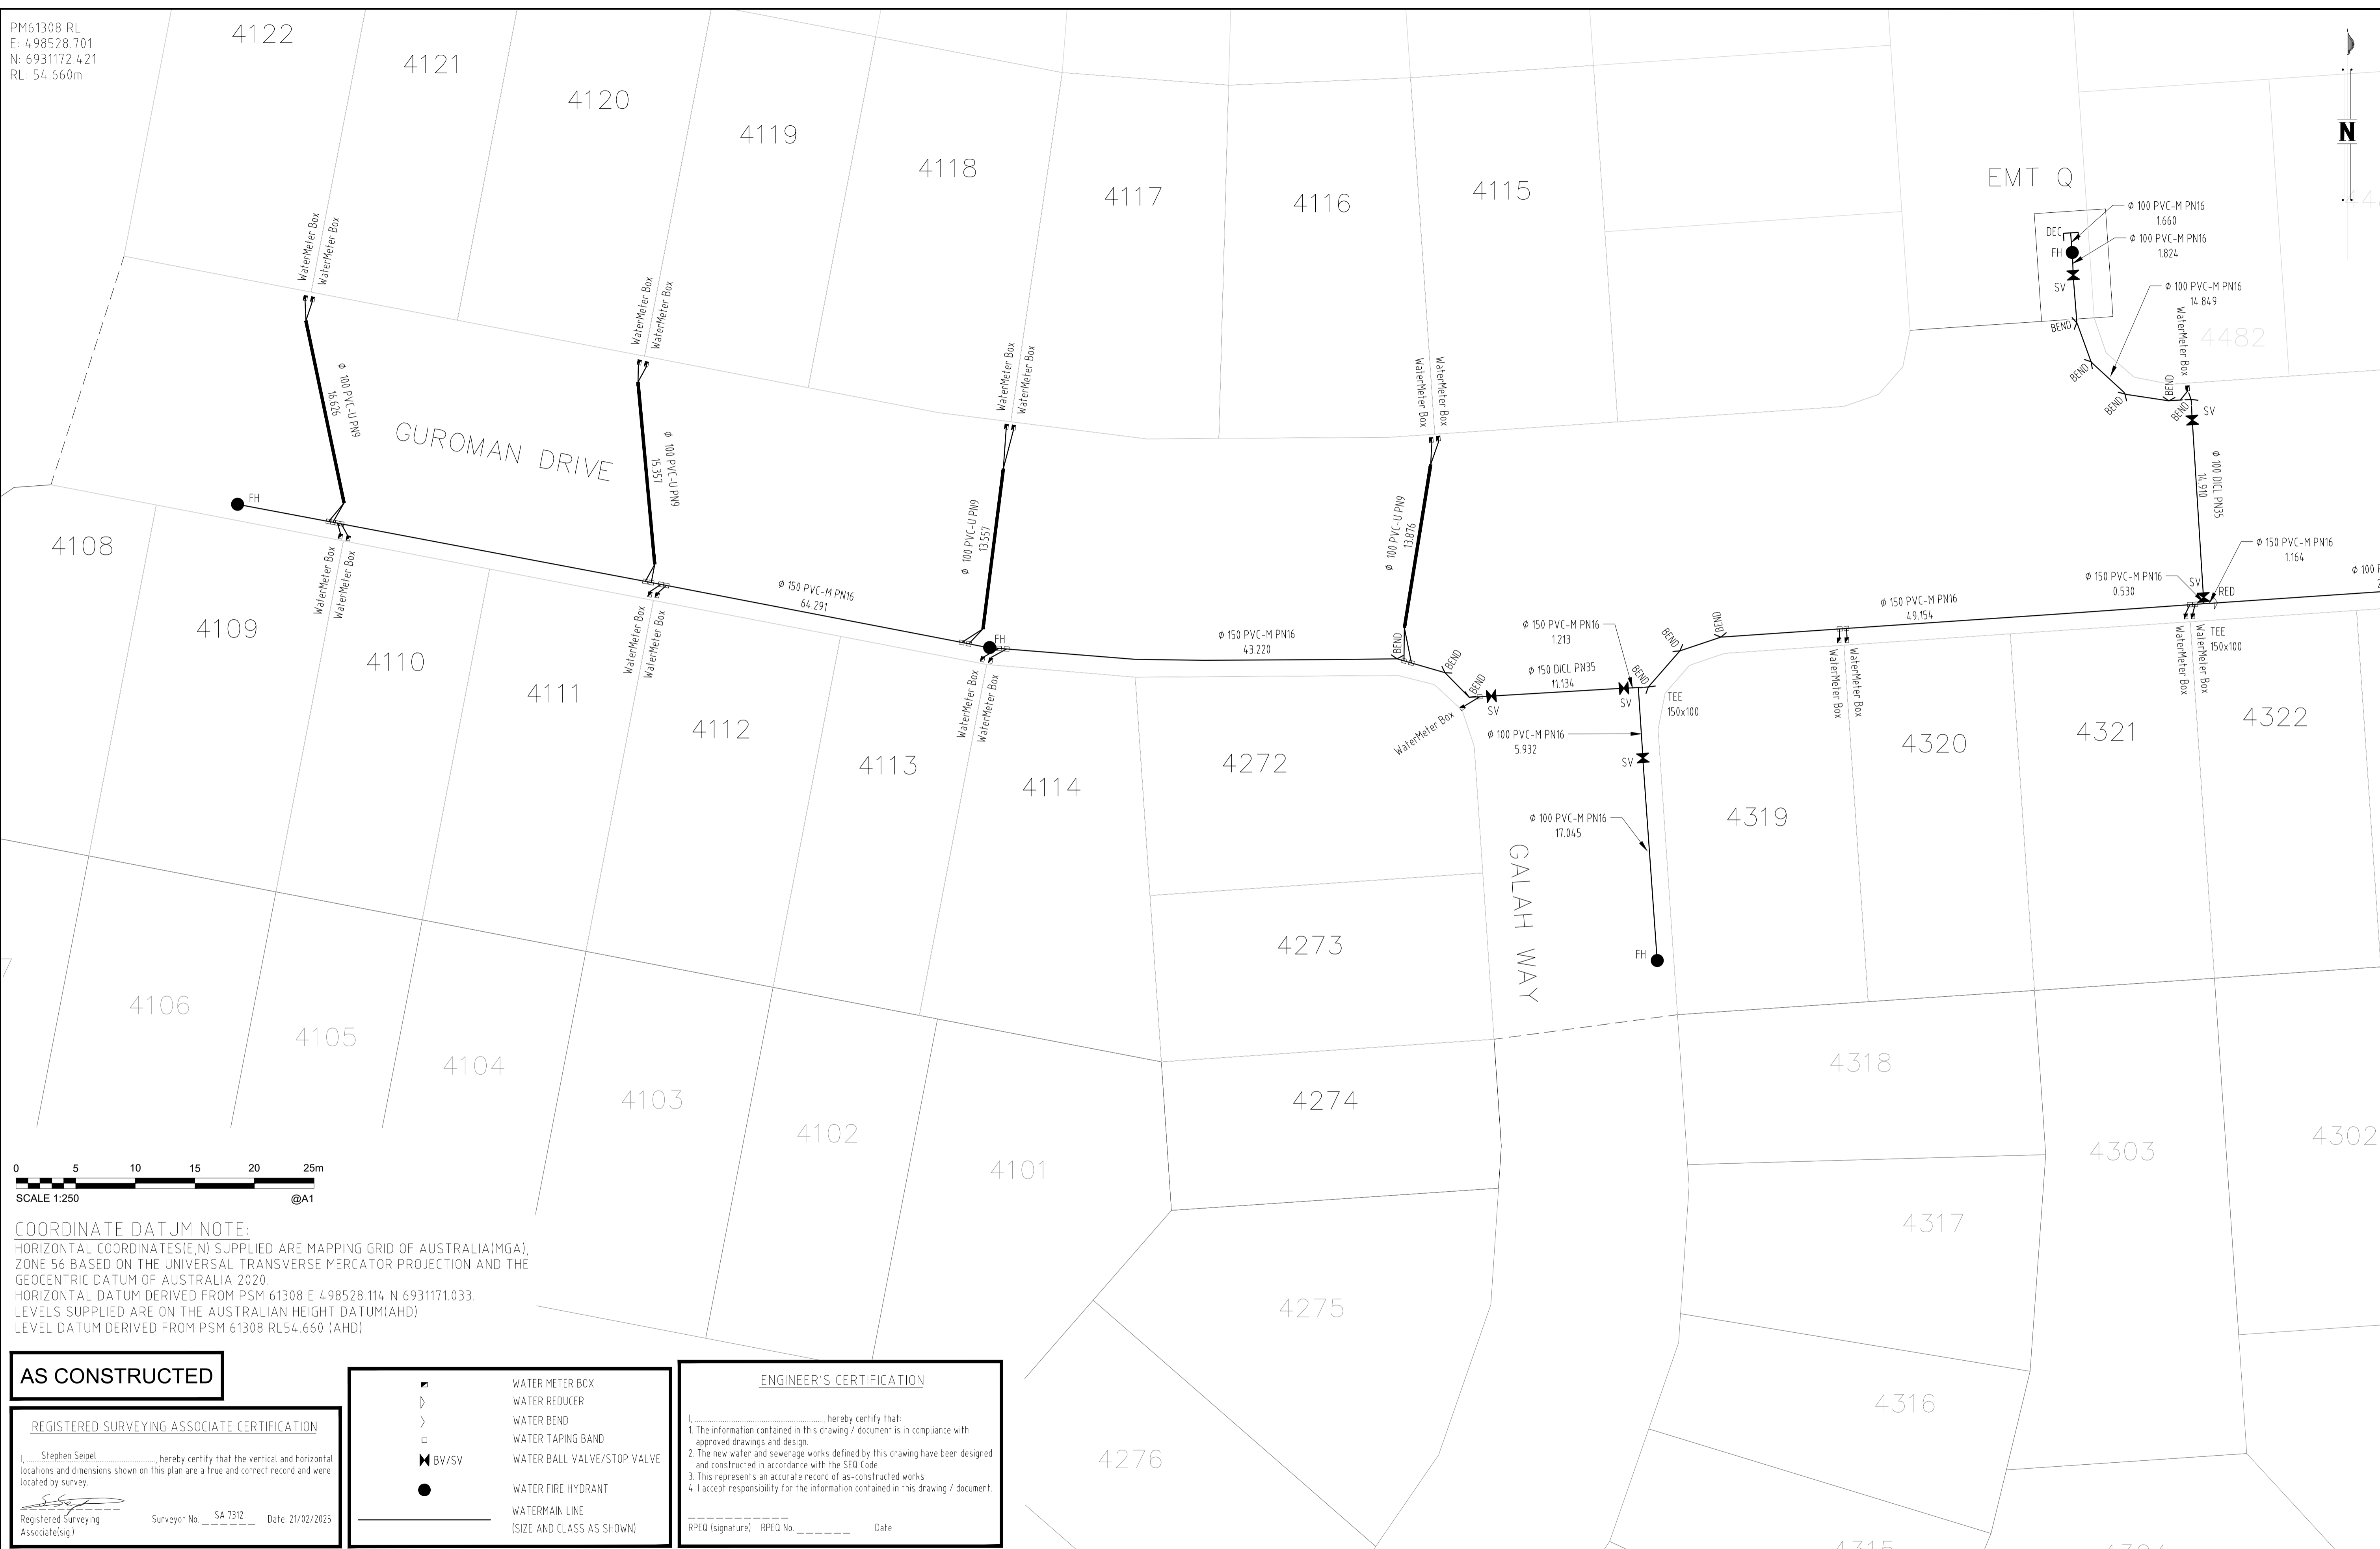

COORDINATE DATUM NOTE:
 HORIZONTAL COORDINATES(E,N) SUPPLIED ARE MAPPING GRID OF AUSTRALIA(MGA), ZONE 56 BASED ON THE UNIVERSAL TRANSVERSE MERCATOR PROJECTION AND THE GEOCENTRIC DATUM OF AUSTRALIA 2020.
 HORIZONTAL DATUM DERIVED FROM PSM 61308 E 498528.114 N 6931171.033.
 LEVELS SUPPLIED ARE ON THE AUSTRALIAN HEIGHT DATUM(AHD) LEVEL DATUM DERIVED FROM PSM 61308 RL54.660 (AHD)

AS CONSTRUCTED

REGISTERED SURVEYING ASSOCIATE CERTIFICATION

I, Stephen Seipel, hereby certify that the vertical and horizontal locations and dimensions shown on this plan are a true and correct record and were located by survey.

Registered Surveying Associate (sig) Surveyor No. SA 7312 Date: 21/02/2025

	WATER METER BOX
	WATER REDUCER
	WATER BEND
	WATER TAPING BAND
	WATER BALL VALVE/STOP VALVE
	WATER FIRE HYDRANT
	WATERMAIN LINE (SIZE AND CLASS AS SHOWN)

ENGINEER'S CERTIFICATION

I, _____, hereby certify that:
 1. The information contained in this drawing / document is in compliance with approved drawings and design.
 2. The new water and sewerage works defined by this drawing have been designed and constructed in accordance with the SEQ Code.
 3. This represents an accurate record of as-constructed works.
 4. I accept responsibility for the information contained in this drawing / document.

RPEQ (signature) RPEQ No. _____ Date: _____


A1	INDEX	DATE	AS CONSTRUCTED	DRAWN	CHECKED	PASSED	DRAWN	CHECKED	PASSED	INITIALS	DATE



LOGAN CITY COUNCIL


MIRVAC MIR-1004
 AS CONSTRUCTED SURVEY - WATERMAIN
 EVERLEIGH PRECINCT 10.4C
 GREENBANK QLD

SHEET 2 OF 6 SHEETS	SCALE 1:250 A1
REVISION DATE 21/02/2025	REVISION -
DISCIPLINE CODE -	
DRAWING NO. ASC-WATERMAIN-02-10.4C	

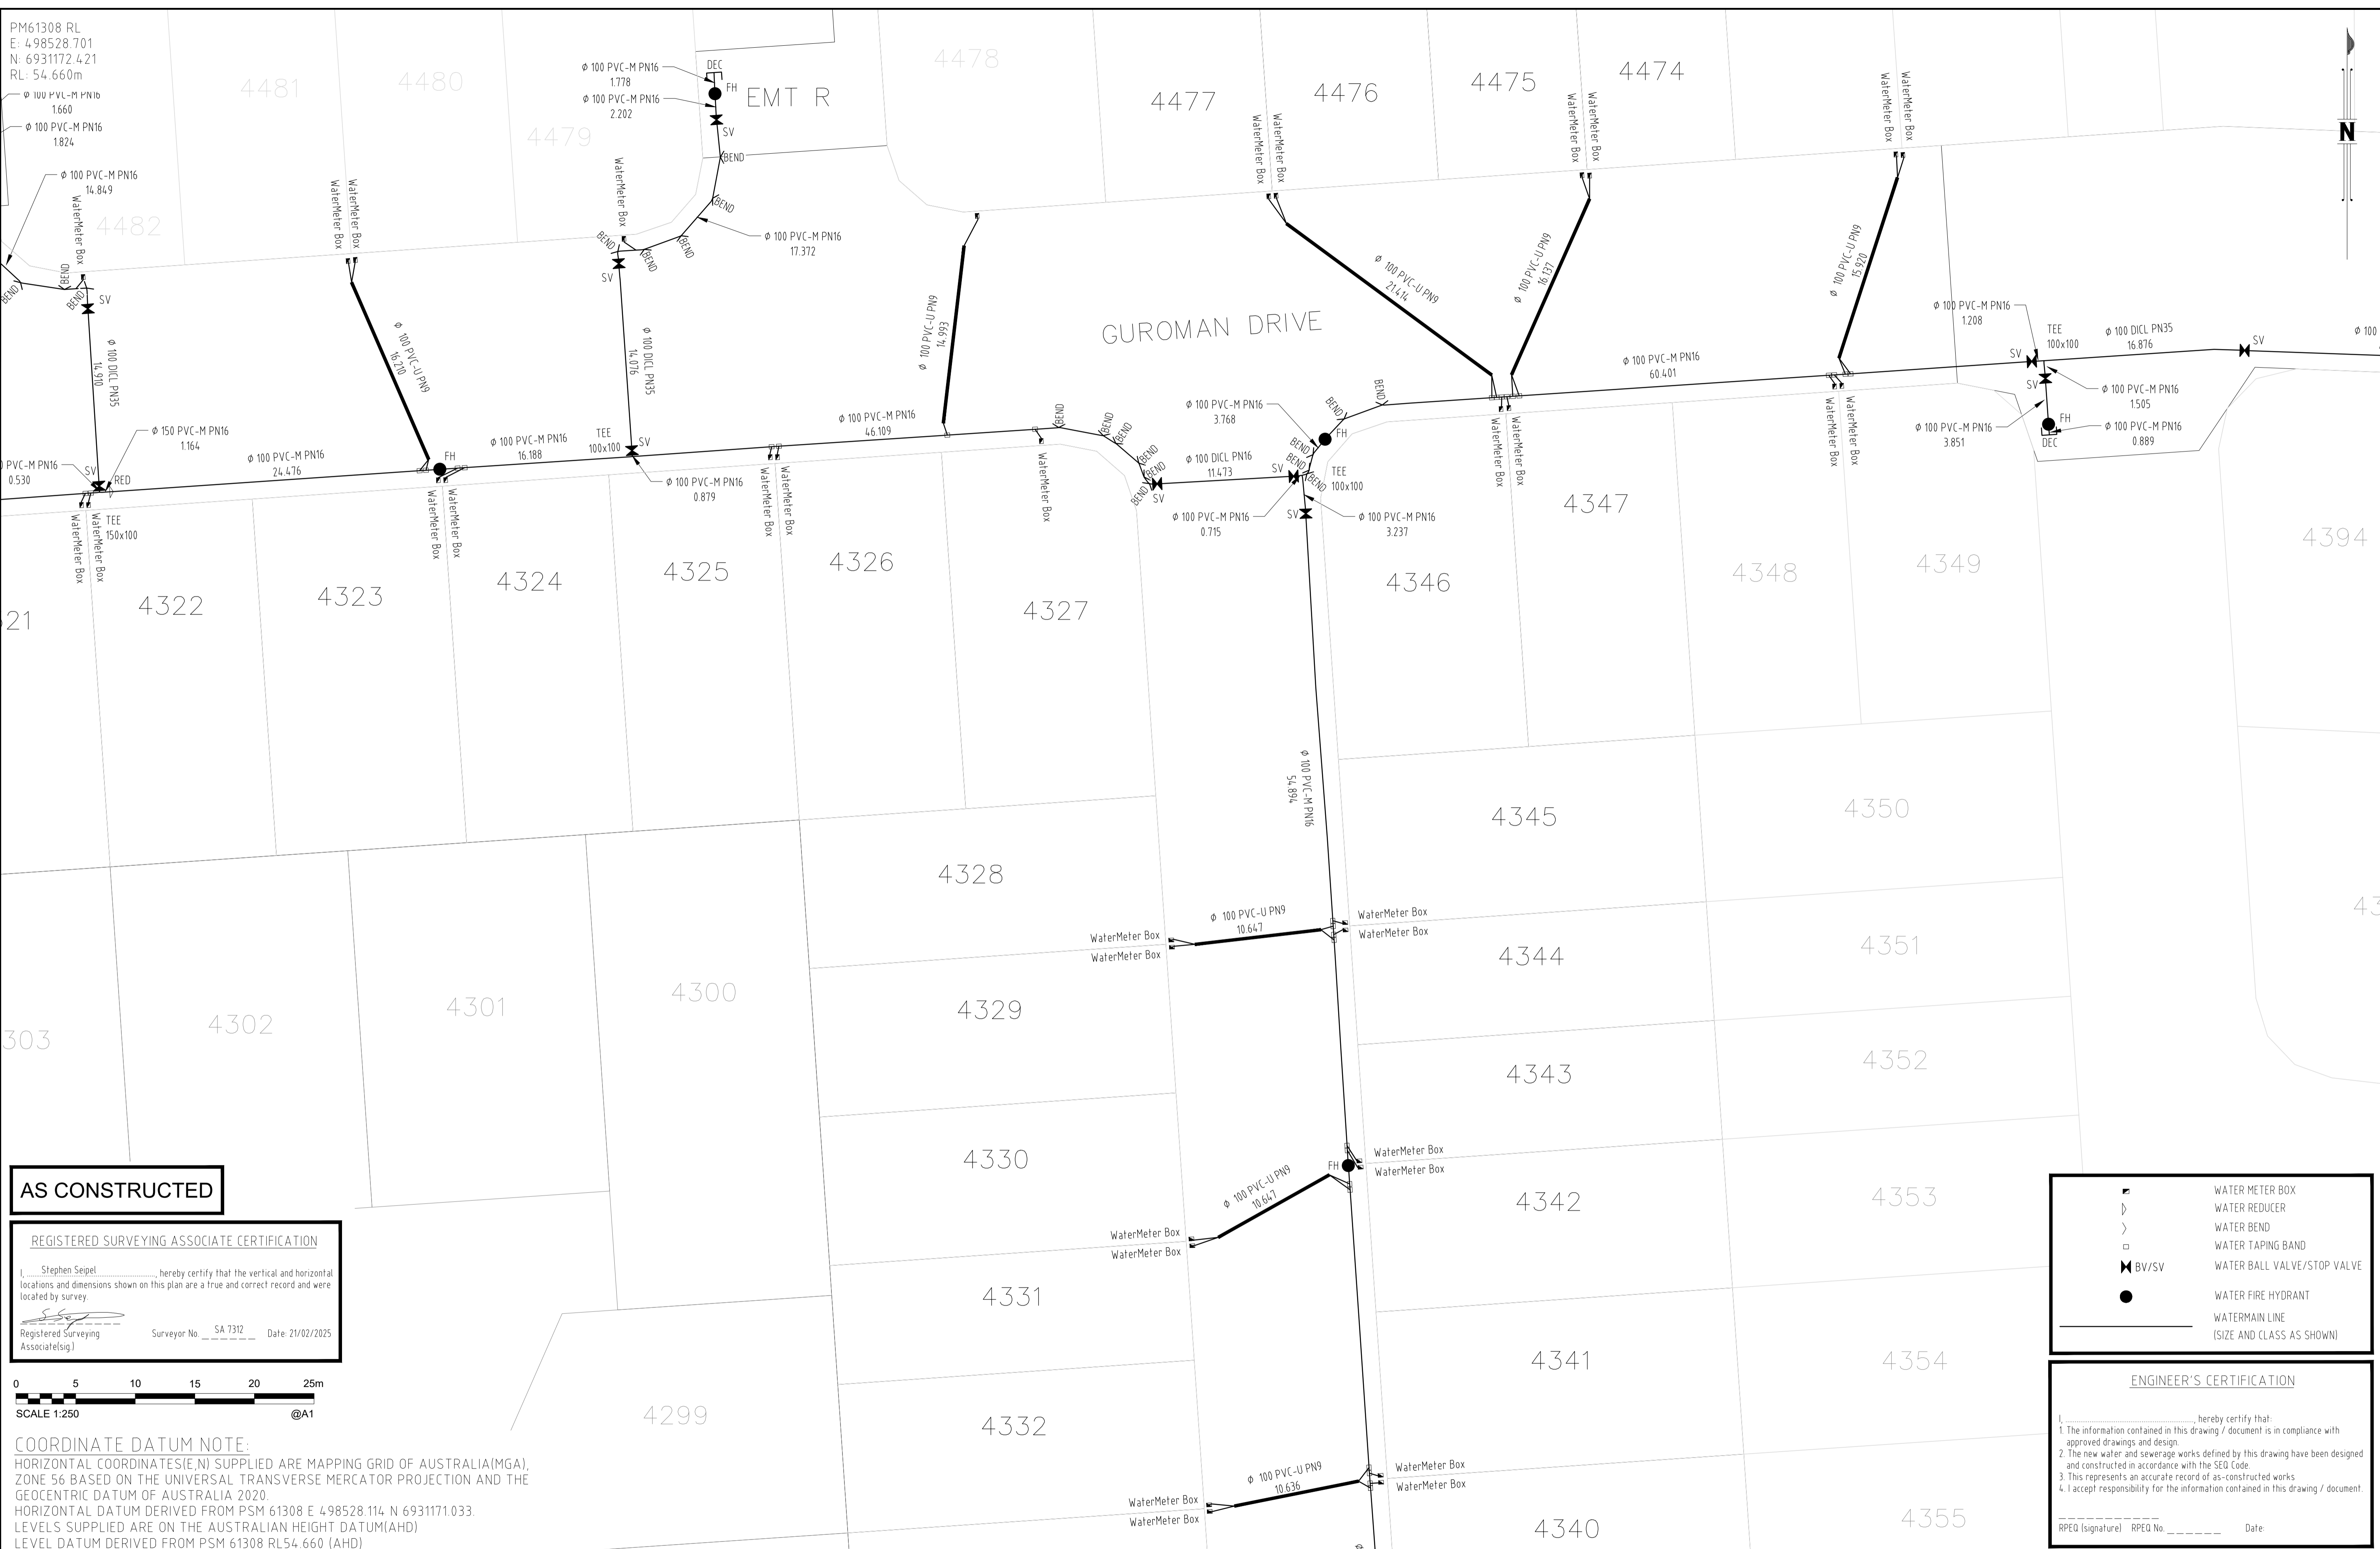

AS CONSTRUCTED

REGISTERED SURVEYING ASSOCIATE CERTIFICATION
 I, Stephen Seipel, hereby certify that the vertical and horizontal locations and dimensions shown on this plan are a true and correct record and were located by survey.
 Registered Surveying Associate [Signature]
 Surveyor No. SA 7312 Date: 21/02/2025

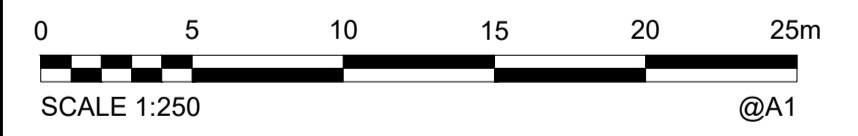

COORDINATE DATUM NOTE:
 HORIZONTAL COORDINATES(E,N) SUPPLIED ARE MAPPING GRID OF AUSTRALIA(MGA), ZONE 56 BASED ON THE UNIVERSAL TRANSVERSE MERCATOR PROJECTION AND THE GEOCENTRIC DATUM OF AUSTRALIA 2020.
 HORIZONTAL DATUM DERIVED FROM PSM 61308 E 4.98528.114 N 6931171.033.
 LEVELS SUPPLIED ARE ON THE AUSTRALIAN HEIGHT DATUM(AHD)
 LEVEL DATUM DERIVED FROM PSM 61308 RL54.660 (AHD)

	WATER METER BOX
	WATER REDUCER
	WATER BEND
	WATER TAPING BAND
	WATER BALL VALVE/STOP VALVE
	WATER FIRE HYDRANT
	WATERMAIN LINE (SIZE AND CLASS AS SHOWN)

ENGINEER'S CERTIFICATION
 I, _____, hereby certify that:
 1. The information contained in this drawing / document is in compliance with approved drawings and design.
 2. The new water and sewerage works defined by this drawing have been designed and constructed in accordance with the SED Code.
 3. This represents an accurate record of as-constructed works
 4. I accept responsibility for the information contained in this drawing / document.
 RPEQ [Signature] RPEQ No. _____ Date: _____




A1	INDEX	DATE	AS CONSTRUCTED	DRAWN	CHECKED	PASSED	DRAWN	CHECKED	PASSED
				DRAWN	RDE	21/02/2025			
				CHECKED	DAM	21/02/2025			
				PASSED					
							INITIALS	DATE	



LOGAN CITY COUNCIL
 MIRVAC MIR-1004
 AS CONSTRUCTED SURVEY - WATERMAIN
 EVERLEIGH PRECINCT 10.4C
 GREENBANK QLD

SHEET 3 OF 6	SHEETS	SCALE 1:250 A1
REVISION DATE 21/02/2025	REVISION -	
DISCIPLINE CODE -		
DRAWING NO. ASC-WATERMAIN-03-10.4C		

PM61308 RL
 E: 498528.701
 N: 6931172.421
 RL: 54.660m

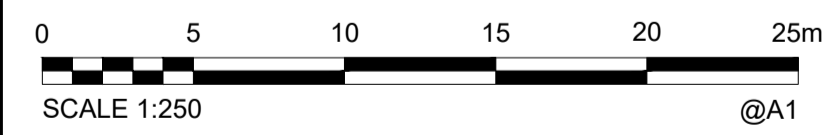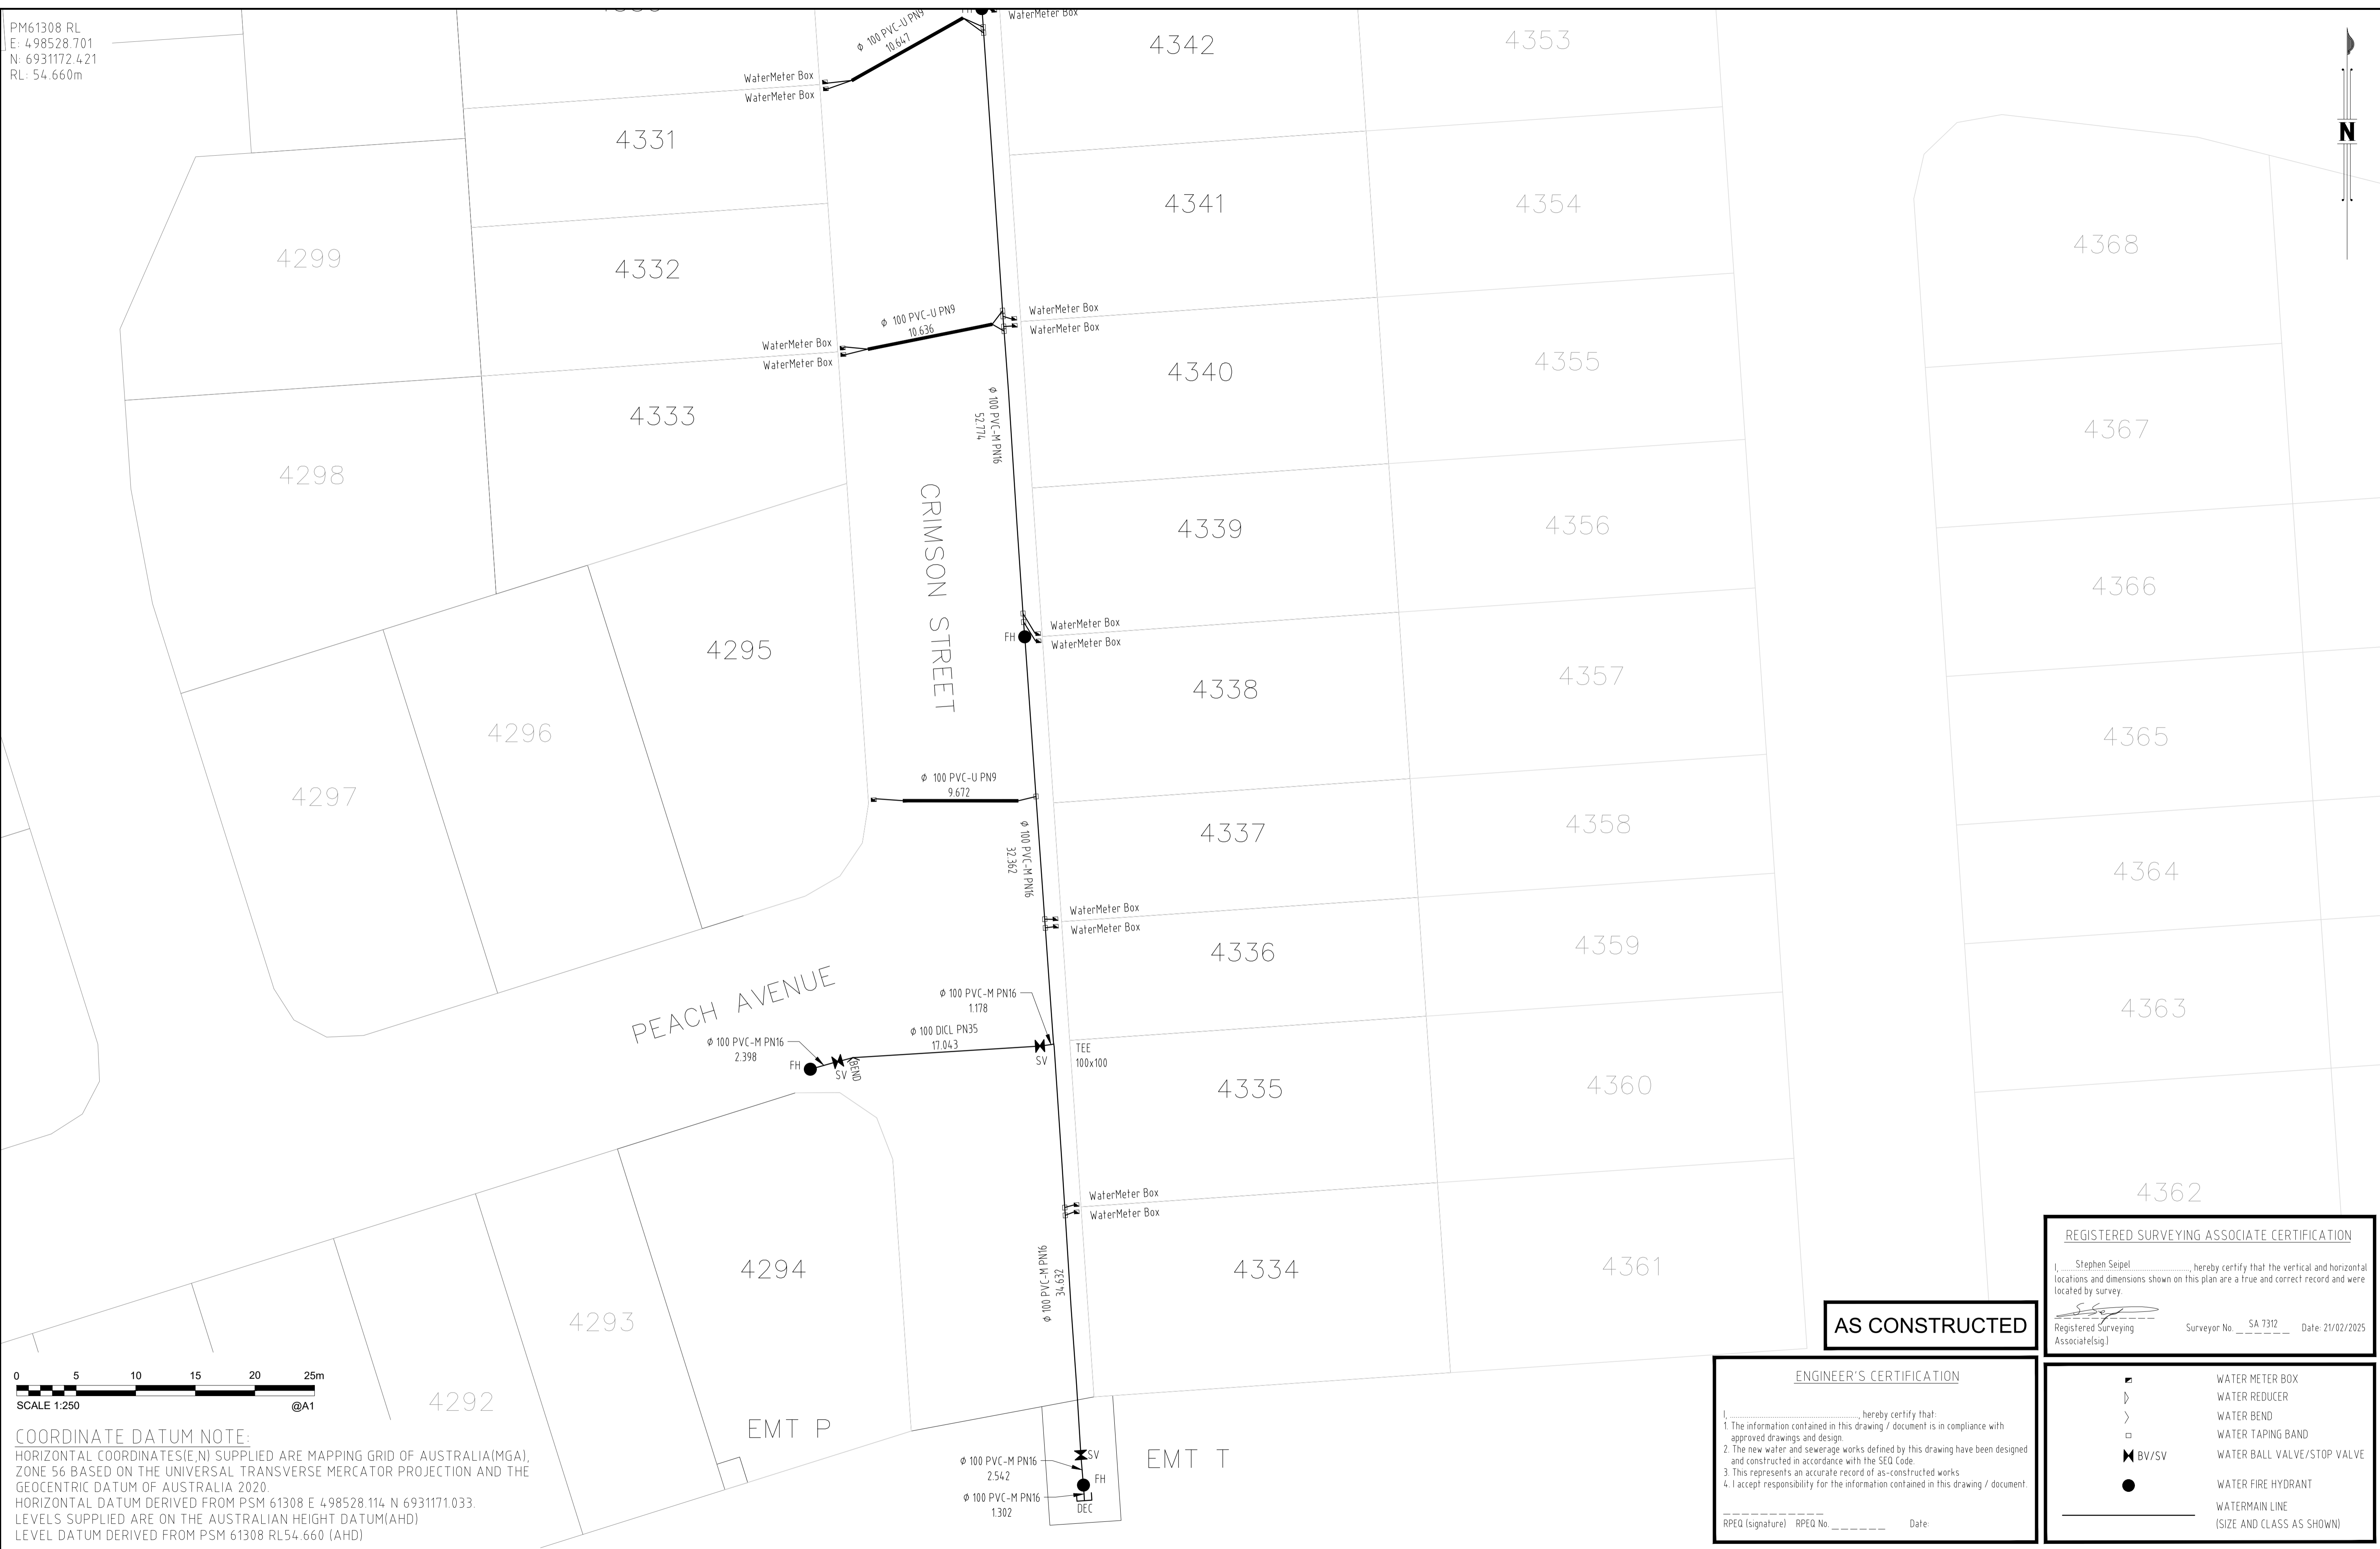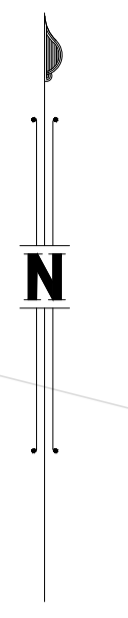

COORDINATE DATUM NOTE:
 HORIZONTAL COORDINATES(E,N) SUPPLIED ARE MAPPING GRID OF AUSTRALIA(MGA), ZONE 56 BASED ON THE UNIVERSAL TRANSVERSE MERCATOR PROJECTION AND THE GEOCENTRIC DATUM OF AUSTRALIA 2020.
 HORIZONTAL DATUM DERIVED FROM PSM 61308 E 498528.114 N 6931171.033.
 LEVELS SUPPLIED ARE ON THE AUSTRALIAN HEIGHT DATUM(AHD)
 LEVEL DATUM DERIVED FROM PSM 61308 RL54.660 (AHD)

REGISTERED SURVEYING ASSOCIATE CERTIFICATION
 I, Stephen Seipel, hereby certify that the vertical and horizontal locations and dimensions shown on this plan are a true and correct record and were located by survey.
 Registered Surveying Associate(s) [Signature] SA 7312 Date: 21/02/2025

AS CONSTRUCTED

ENGINEER'S CERTIFICATION
 I, _____, hereby certify that:
 1. The information contained in this drawing / document is in compliance with approved drawings and design.
 2. The new water and sewerage works defined by this drawing have been designed and constructed in accordance with the SEQ Code.
 3. This represents an accurate record of as-constructed works.
 4. I accept responsibility for the information contained in this drawing / document.
 RPEQ (signature) RPEQ No. _____ Date: _____

- ▣ WATER METER BOX
- ▤ WATER REDUCER
- > WATER BEND
- WATER TAPING BAND
- ⊕ BV/SV WATER BALL VALVE/STOP VALVE
- WATER FIRE HYDRANT
- WATERMAIN LINE (SIZE AND CLASS AS SHOWN)



A1	INDEX	DATE	AS CONSTRUCTED	REVISIONS	DRAWN	CHECKED	PASSED	DRAWN	CHECKED	PASSED	INITIALS	DATE



LOGAN CITY COUNCIL
 MIRVAC MIR-1004
 AS CONSTRUCTED SURVEY - WATERMAIN
 EVERLEIGH PRECINCT 10.4C
 GREENBANK QLD

SHEET 4 OF 6 SHEETS	SCALE 1:250 A1
REVISION DATE 21/02/2025	REVISION -
DISCIPLINE CODE -	
DRAWING NO. ASC-WATERMAIN-04-10.4C	

PM61308 RL
 E: 498528.701
 N: 6931172.421
 RL: 54.660m

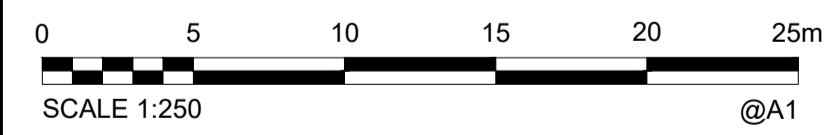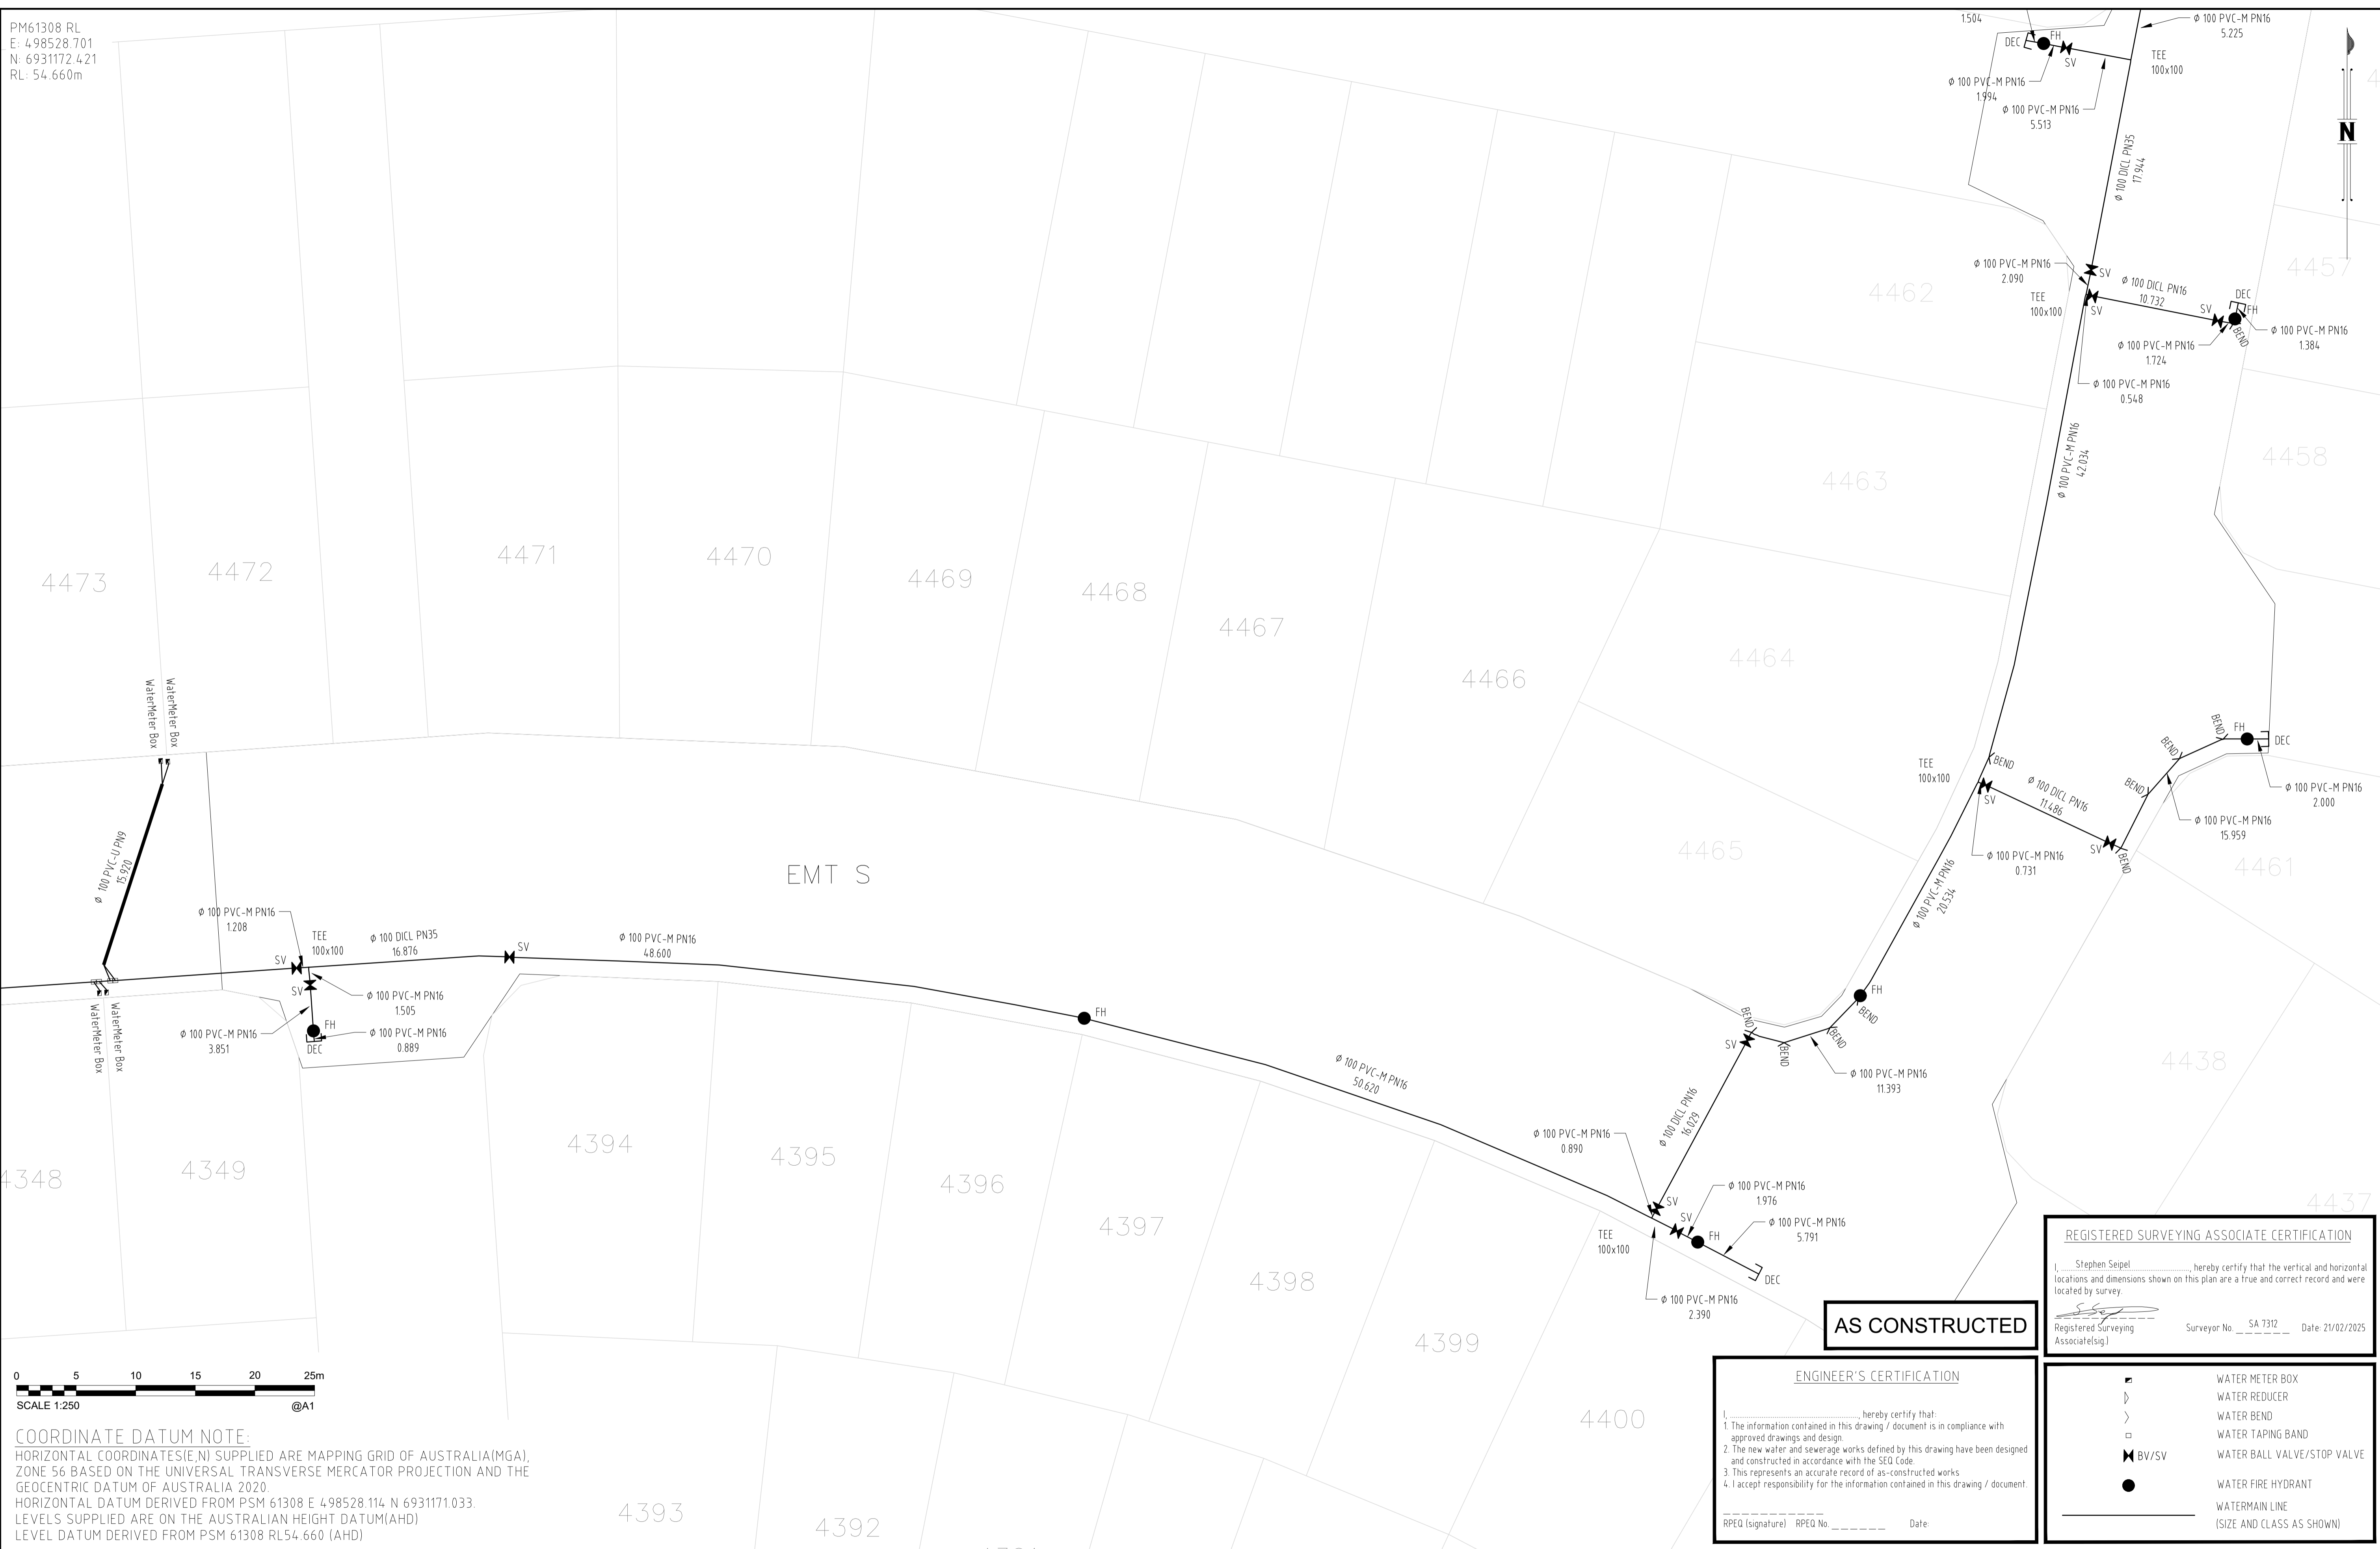

COORDINATE DATUM NOTE:
 HORIZONTAL COORDINATES(E,N) SUPPLIED ARE MAPPING GRID OF AUSTRALIA(MGA), ZONE 56 BASED ON THE UNIVERSAL TRANSVERSE MERCATOR PROJECTION AND THE GEOCENTRIC DATUM OF AUSTRALIA 2020.
 HORIZONTAL DATUM DERIVED FROM PSM 61308 E 498528.114 N 6931171.033.
 LEVELS SUPPLIED ARE ON THE AUSTRALIAN HEIGHT DATUM(AHD)
 LEVEL DATUM DERIVED FROM PSM 61308 RL54.660 (AHD)

REGISTERED SURVEYING ASSOCIATE CERTIFICATION
 I, Stephen Seipel, hereby certify that the vertical and horizontal locations and dimensions shown on this plan are a true and correct record and were located by survey.
 Registered Surveying Associate(s) [Signature] Surveyor No. SA 7312 Date: 21/02/2025

AS CONSTRUCTED

ENGINEER'S CERTIFICATION
 I, _____, hereby certify that:
 1. The information contained in this drawing / document is in compliance with approved drawings and design.
 2. The new water and sewerage works defined by this drawing have been designed and constructed in accordance with the SEQ Code.
 3. This represents an accurate record of as-constructed works.
 4. I accept responsibility for the information contained in this drawing / document.
 RPEQ (Signature) RPEQ No. _____ Date: _____

▣	WATER METER BOX
▤	WATER REDUCER
>	WATER BEND
□	WATER TAPING BAND
⊠	WATER BALL VALVE/STOP VALVE
●	WATER FIRE HYDRANT
—	WATERMAIN LINE (SIZE AND CLASS AS SHOWN)


A1	INDEX	DATE	AS CONSTRUCTED	DRAWN	CHECKED	PASSED	DRAWN	CHECKED	PASSED	INITIALS	DATE



LOGAN CITY COUNCIL
 MIRVAC MIR-1004
 AS CONSTRUCTED SURVEY - WATERMAIN
 EVERLEIGH PRECINCT 10.4C
 GREENBANK QLD

SHEET 5 OF 6 SHEETS	SCALE 1:250 A1
REVISION DATE 21/02/2025	REVISION -
DISCIPLINE CODE -	
DRAWING NO. ASC-WATERMAIN-05-10.4C	

PM61308 RL
 E: 498528.701
 N: 6931172.421
 RL: 54.660m

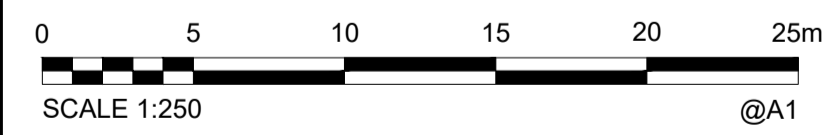

COORDINATE DATUM NOTE:
 HORIZONTAL COORDINATES (E,N) SUPPLIED ARE MAPPING GRID OF AUSTRALIA (MGA), ZONE 56 BASED ON THE UNIVERSAL TRANSVERSE MERCATOR PROJECTION AND THE GEOCENTRIC DATUM OF AUSTRALIA 2020.
 HORIZONTAL DATUM DERIVED FROM PSM 61308 E 498528.114 N 6931171.033.
 LEVELS SUPPLIED ARE ON THE AUSTRALIAN HEIGHT DATUM (AHD)
 LEVEL DATUM DERIVED FROM PSM 61308 RL54.660 (AHD)

REGISTERED SURVEYING ASSOCIATE CERTIFICATION
 I, Stephen Seipel, hereby certify that the vertical and horizontal locations and dimensions shown on this plan are a true and correct record and were located by survey.
 Registered Surveying Associate(sig) _____ Surveyor No. SA 7312 Date: 21/02/2025

AS CONSTRUCTED

ENGINEER'S CERTIFICATION
 I, _____, hereby certify that:
 1. The information contained in this drawing / document is in compliance with approved drawings and design.
 2. The new water and sewerage works defined by this drawing have been designed and constructed in accordance with the SEQ Code.
 3. This represents an accurate record of as-constructed works.
 4. I accept responsibility for the information contained in this drawing / document.
 RPEQ (signature) RPEQ No. _____ Date: _____

▣	WATER METER BOX
▤	WATER REDUCER
>	WATER BEND
□	WATER TAPING BAND
⊗ BV/SV	WATER BALL VALVE/STOP VALVE
●	WATER FIRE HYDRANT
—	WATERMAIN LINE (SIZE AND CLASS AS SHOWN)

A1	INDEX	DATE	AS CONSTRUCTED	REVISIONS	DRAWN	CHECKED	PASSED	DRAWN	CHECKED	PASSED	INITIALS	DATE



LOGAN CITY COUNCIL
 MIRVAC MIR-1004
 AS CONSTRUCTED SURVEY - WATERMAIN
 EVERLEIGH PRECINCT 10.4C
 GREENBANK QLD

SHEET 6 OF 6 SHEETS	SCALE 1:250 A1
REVISION DATE 21/02/2025	REVISION -
DISCIPLINE CODE -	
DRAWING NO. ASC-WATERMAIN-06-10.4C	