

PM61308 RL
E: 498528.701
N: 6931172.420
RL: 54.660m



AS CONSTRUCTED

COORDINATE DATUM NOTE:

HORIZONTAL COORDINATES(E,N) SUPPLIED ARE MAPPING GRID OF AUSTRALIA(MGA),
ZONE 56 BASED ON THE UNIVERSAL TRANSVERSE MERCATOR PROJECTION AND THE
GEOCENTRIC DATUM OF AUSTRALIA 2020.

HORIZONTAL DATUM DERIVED FROM PSM 61308 E 498528.701 N 6931172.420.

LEVELS SUPPLIED ARE ON THE AUSTRALIAN HEIGHT DATUM(AHD)

LEVEL DATUM DERIVED FROM PSM 61308 RL54.660 (AHD)

ENGINEER'S CERTIFICATION

I, _____, hereby certify that:

1. The information contained in this drawing / document is in compliance with approved drawings and design.
2. The new water and sewerage works defined by this drawing have been designed and constructed in accordance with the SED Code.
3. This represents an accurate record of as-constructed works
4. I accept responsibility for the information contained in this drawing / document.

RPEQ (signature) RPEQ No. Date:

○	SEWER MANHOLE
×	SEWER FITTING
┌	SEWER DEC
—————	SEWER PIPE CLASS AS SHOWN

REGISTERED SURVEYOR'S CERTIFICATION

I, Dale Delaforce, hereby certify that the vertical and horizontal locations and dimensions shown on this plan are a true and correct record and were located by survey.

Registered Surveyor (sig.) Reg. Surveyor No. 6176 Date: 12/05/2025

A1


							DRAWN	ALS	06/05/2025
							CHECKED	DAM	06/05/2025
							PASSED		
INDEX	DATE	AS CONSTRUCTED				DRAWN	CHECKED	PASSED	
		REVISIONS	INITIALS	DATE					




LOGAN CITY COUNCIL

MIRVAC MIR-1005
AS CONSTRUCTED SURVEY - SEWER
EVERLEIGH PRECINCT 10.5C
GREENBANK QLD


SHEET 1 OF 7	SHEETS	SCALE	1:1000 A1
REVISION DATE	06/05/2025	REVISION	—
DISCIPLINE CODE	—		
DRAWING NO.			
ASC-SEWER-01-10.5C			

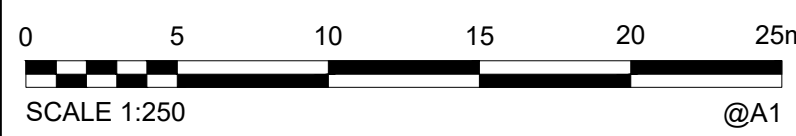

SHEET 3 OF 7		SHEETS		SCALE 1:250 A1	
REVISION DATE				REVISION -	
DISCIPLINE CODE		-			
DRAWING NO.					
ASC-SEWER-03-10.5C					

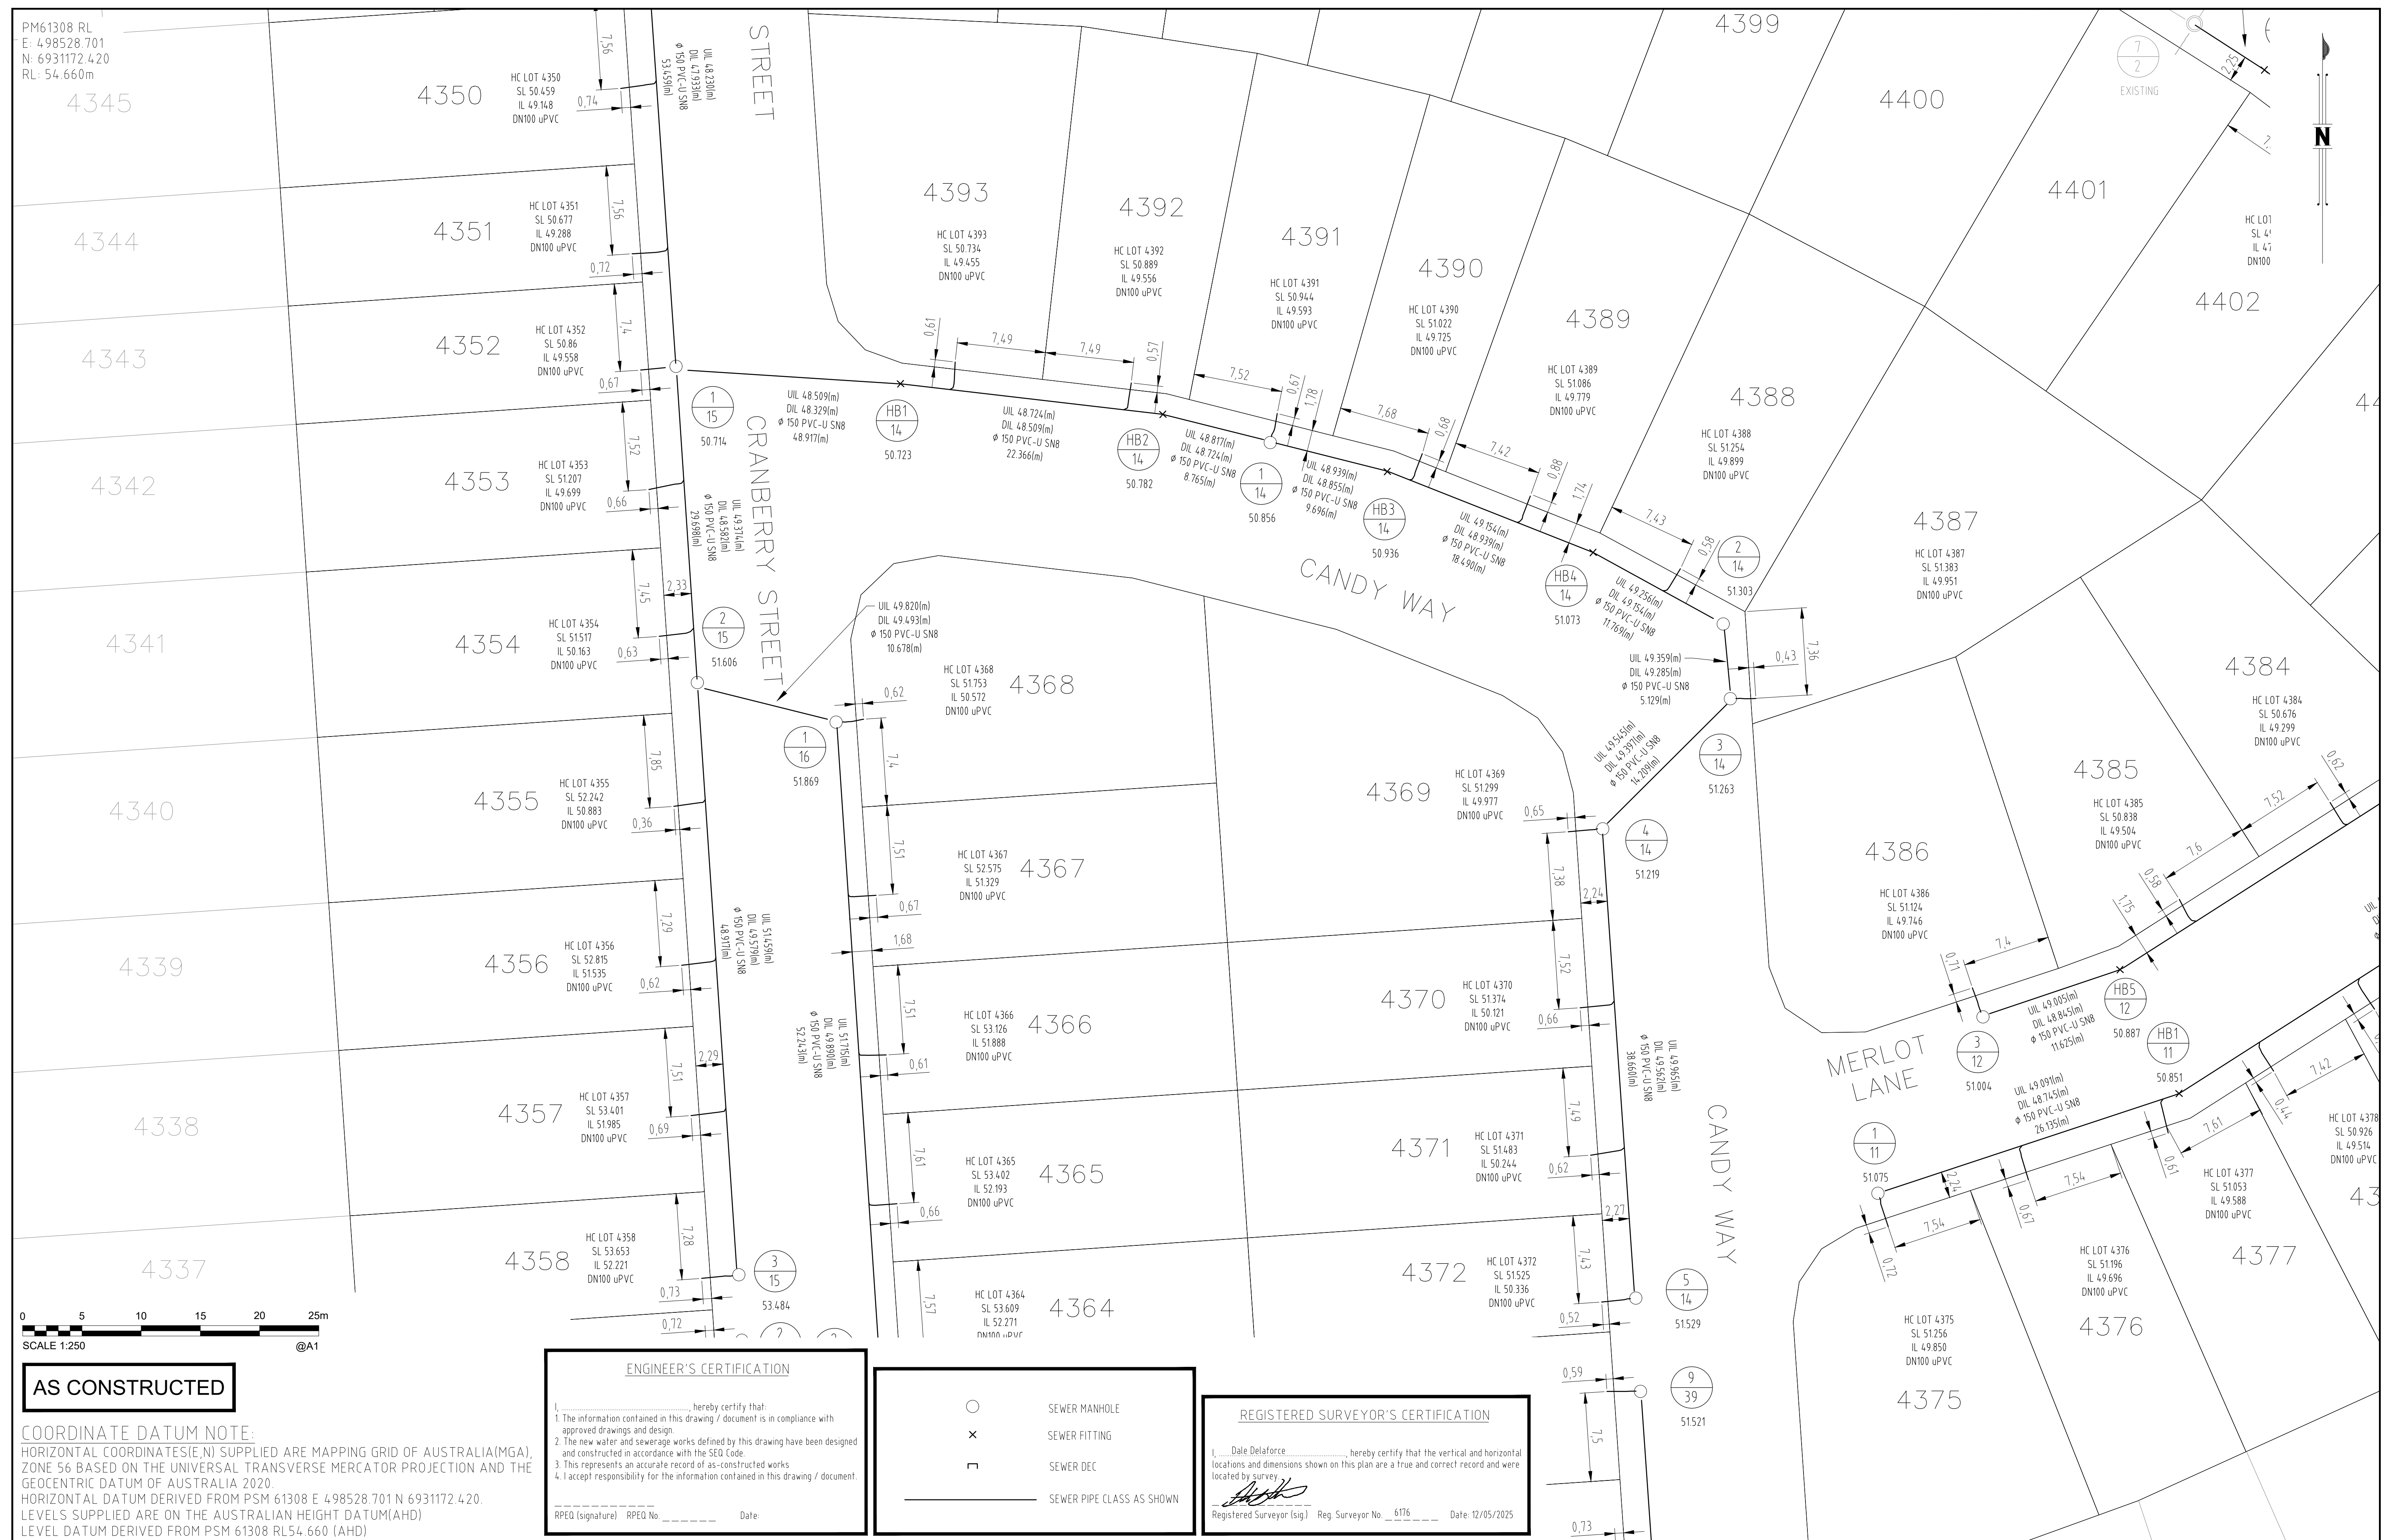[illegible]

PM61308 RL
E: 498528.701
N: 6931172.420
RL: 54.660m

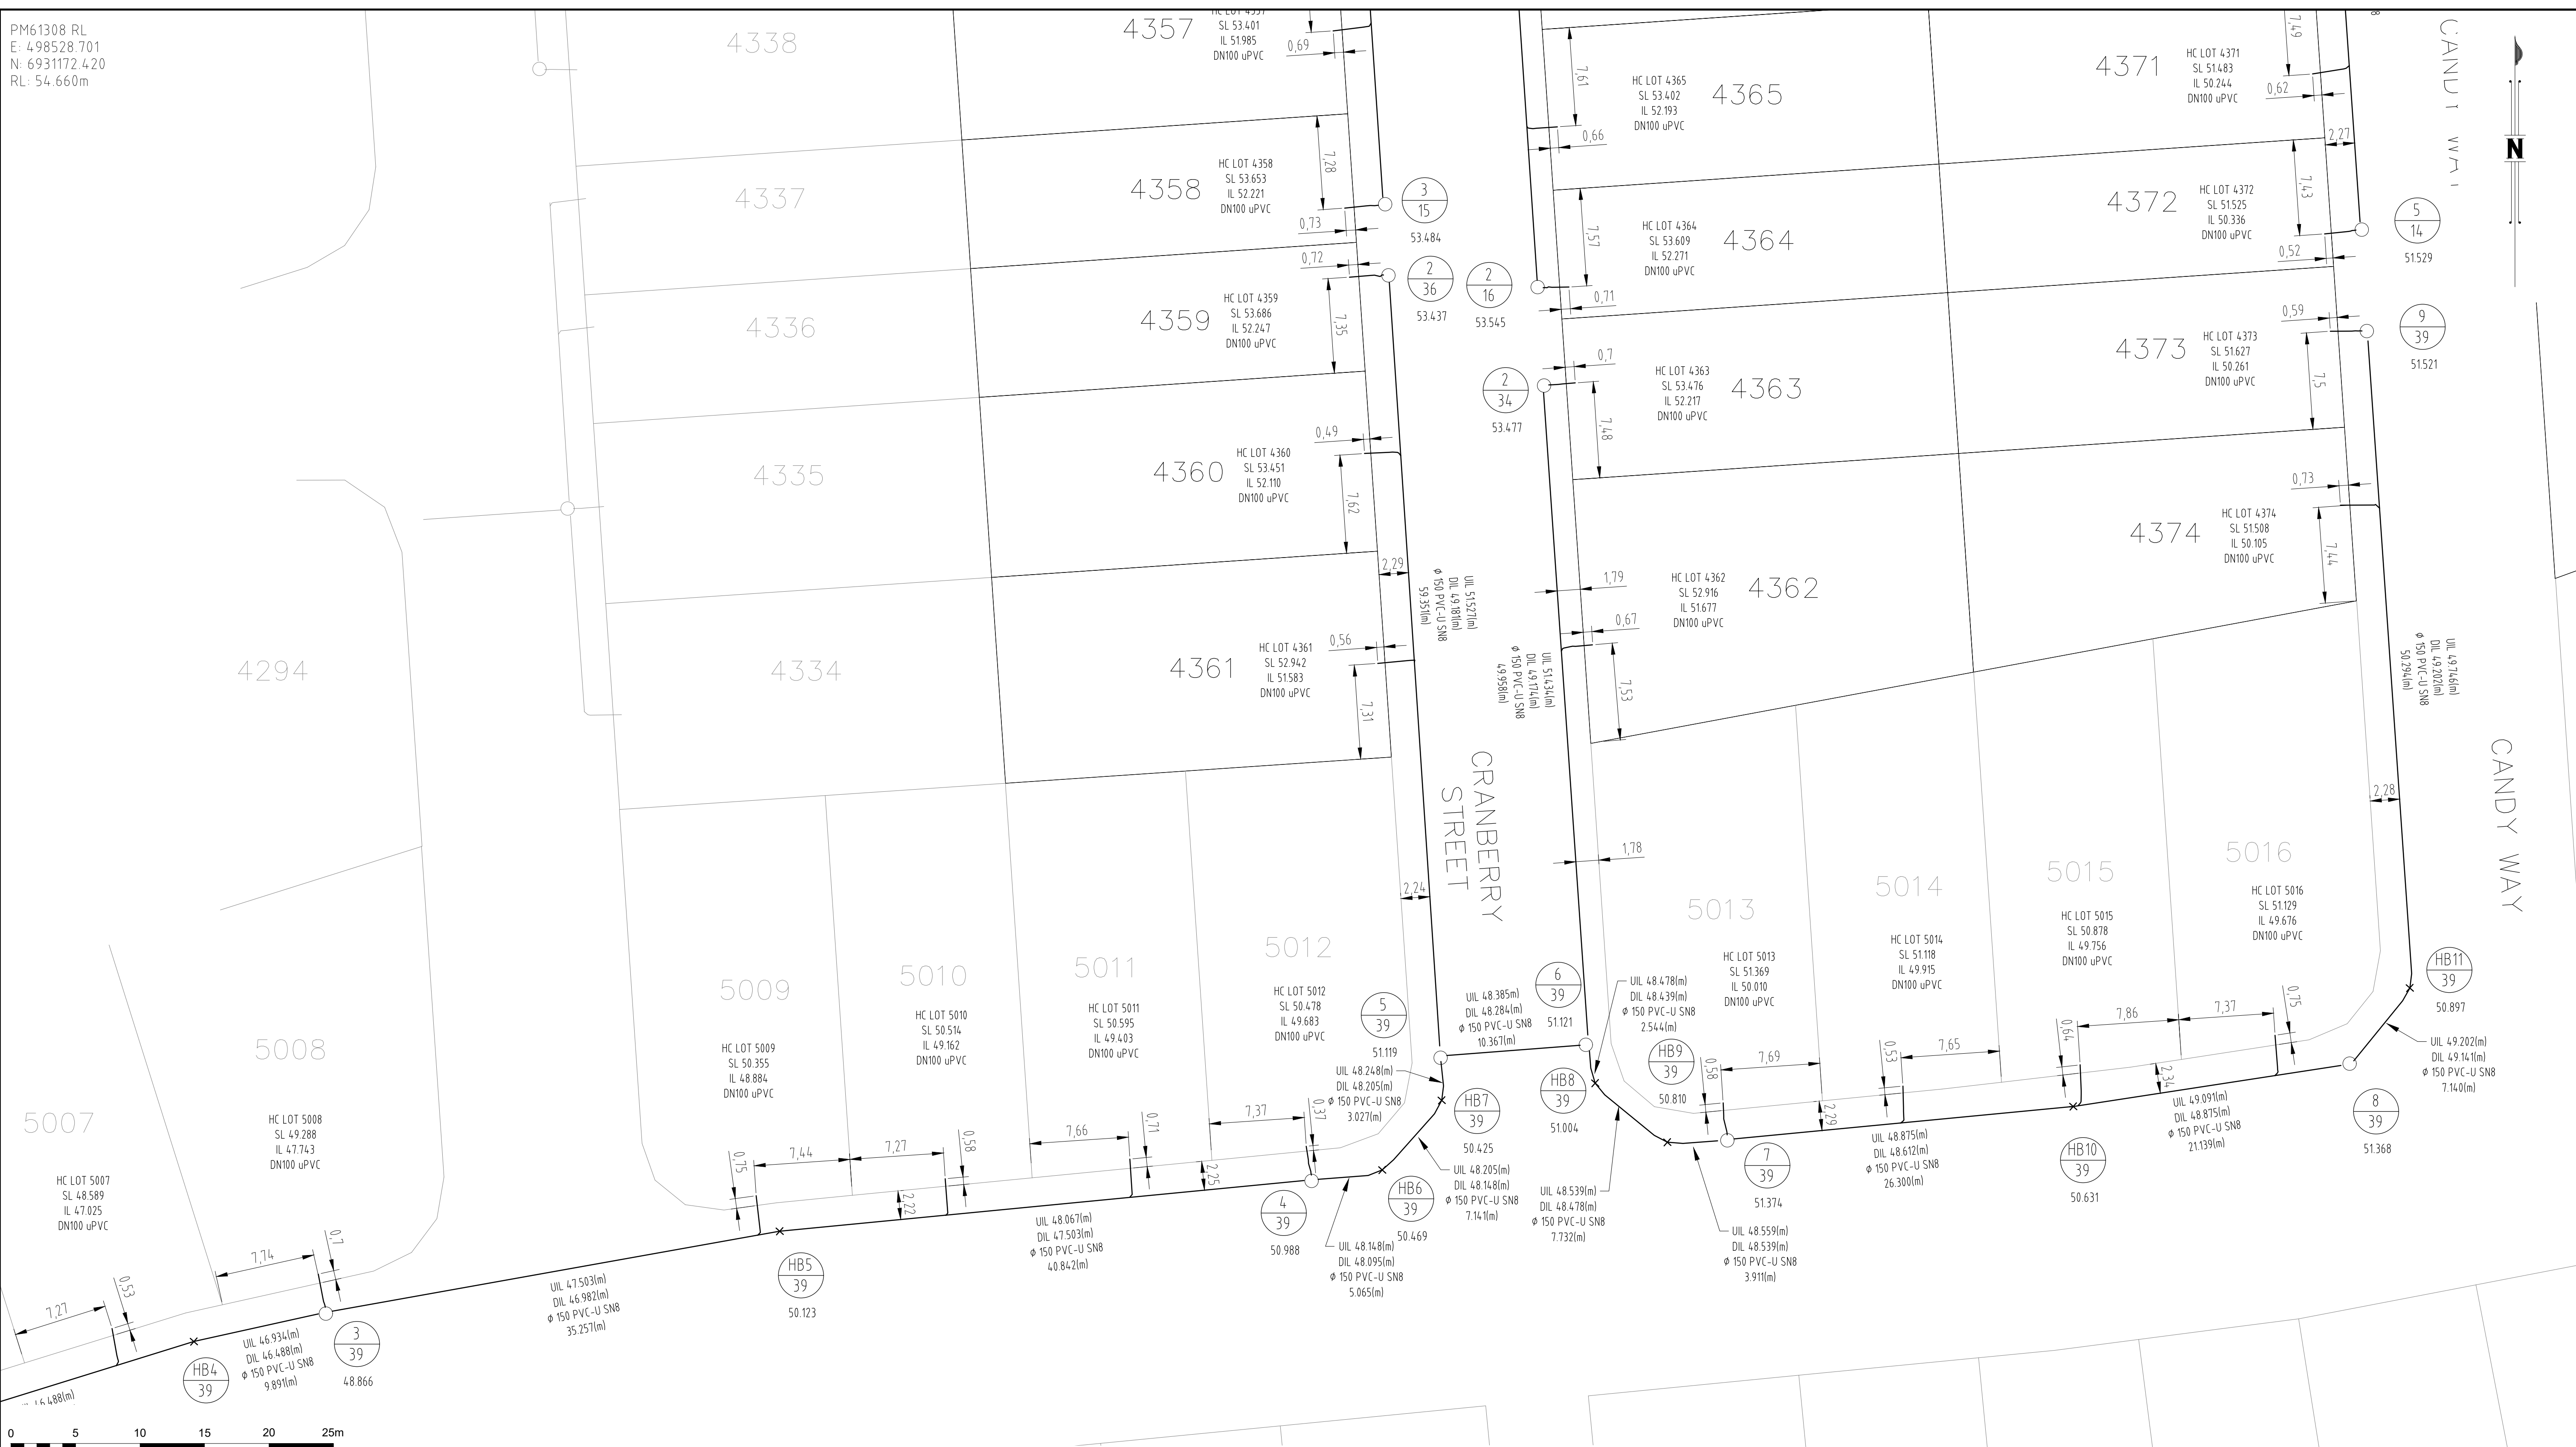

0 5 10 15 20 25m

SCALE 1:250 @A1

AS CONSTRUCTED


COORDINATE DATUM NOTE:
HORIZONTAL COORDINATES(E,N) SUPPLIED ARE MAPPING GRID OF AUSTRALIA(MGA),
ZONE 56 BASED ON THE UNIVERSAL TRANSVERSE MERCATOR PROJECTION AND THE
GEOCENTRIC DATUM OF AUSTRALIA 2020.
HORIZONTAL DATUM DERIVED FROM PSM 61308 E 4 98528 701 N 6931172 420.
LEVELS SUPPLIED ARE ON THE AUSTRALIAN HEIGHT DATUM(AHD)
LEVEL DATUM DERIVED FROM PSM 61308 RL54 660 (AHD)

ENGINEER'S CERTIFICATION

I, _____, hereby certify that:

1. The information contained in this drawing / document is in compliance with approved drawings and design.
2. The new water and sewerage works defined by this drawing have been designed and constructed in accordance with the SEQ Code.
3. This represents an accurate record of as-constructed works
4. I accept responsibility for the information contained in this drawing / document.

RPEQ (signature) RPEQ No. _____ Date: _____

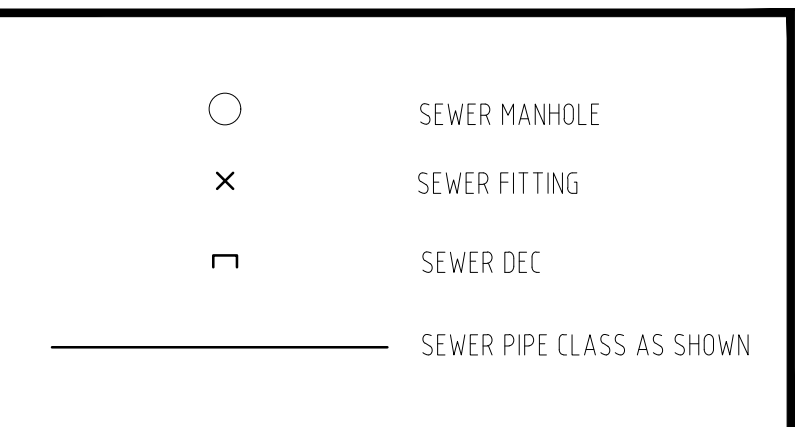

REGISTERED SURVEYOR'S CERTIFICATION

I, Dale Delaforce, hereby certify that the vertical and horizontal locations and dimensions shown on this plan are a true and correct record and were located by survey.



Registered Surveyor (sig.) Reg. Surveyor No. 6176 Date: 12/05/2025

A1																																																																																																																																																																																																																																																																																																																																																																																																																																																																																																																																																																																																																																																																																																																																																																																																																																																																																																																																																																																																																																																																																																																																																																																																																																																																																																																																																																																																																																					
----	--	--	



LOGAN CITY COUNCIL

MIRVAC MIR-1005
AS CONSTRUCTED SURVEY - SEWER
EVERLEIGH PRECINCT 10.5C
GREENBANK QLD

SHEET 6 OF 7 SHEETS		SCALE 1:250 A1	
REVISION DATE		REVISION	—
DISCIPLINE CODE	—		
DRAWING NO. ASC-SEWER-06-10.5C			

PM61308 RL
E: 498528.701
N: 6931172.420
RL: 54.660m

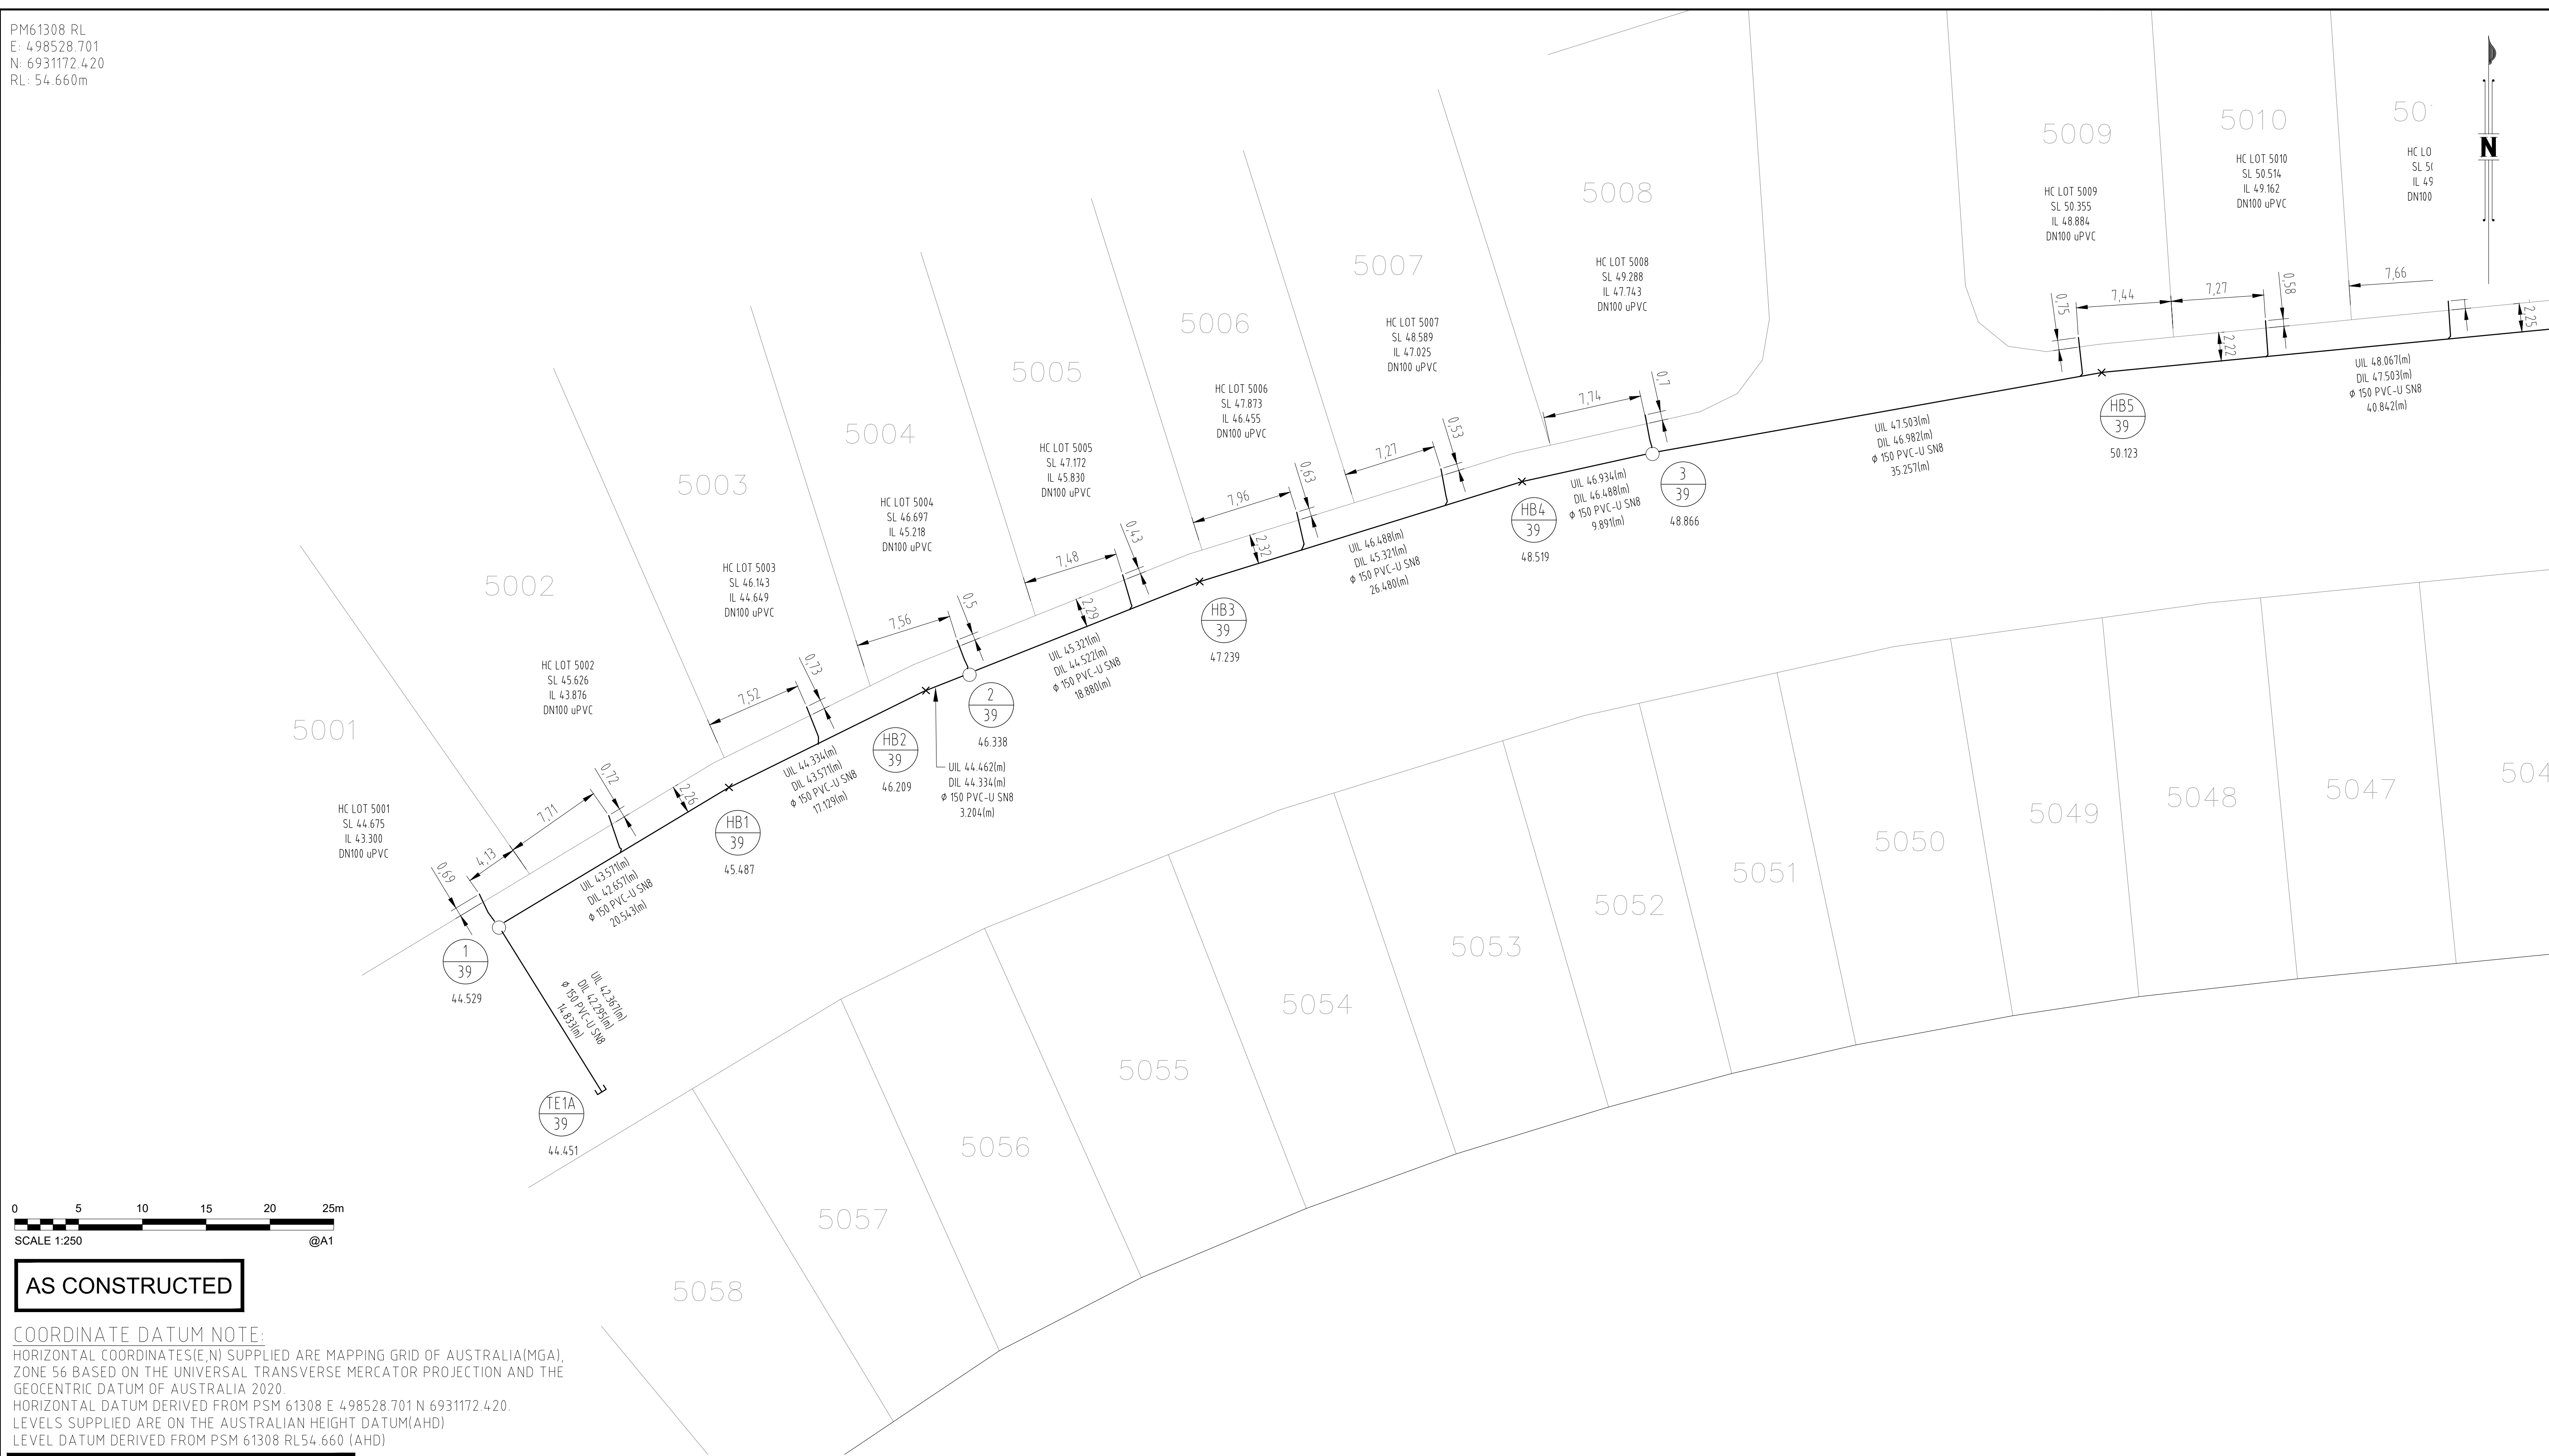

AS CONSTRUCTED

COORDINATE DATUM NOTE:

HORIZONTAL COORDINATES(E,N) SUPPLIED ARE MAPPING GRID OF AUSTRALIA(MGA),
ZONE 56 BASED ON THE UNIVERSAL TRANSVERSE MERCATOR PROJECTION AND THE
GEOCENTRIC DATUM OF AUSTRALIA 2020.
HORIZONTAL DATUM DERIVED FROM PSM 61308 E 498528.701 N 6931172.420.
LEVELS SUPPLIED ARE ON THE AUSTRALIAN HEIGHT DATUM(AHD)
LEVEL DATUM DERIVED FROM PSM 61308 RL54.660 (AHD)

ENGINEER'S CERTIFICATION

I, _____, hereby certify that:

1. The information contained in this drawing / document is in compliance with approved drawings and design.
2. The new water and sewerage works defined by this drawing have been designed and constructed in accordance with the SED Code.
3. This represents an accurate record of as-constructed works
4. I accept responsibility for the information contained in this drawing / document.

RPEQ (signature) RPEQ No. Date

○	SEWER MANHOLE
×	SEWER FITTING
┐	SEWER DEC
—————	SEWER PIPE CLASS AS SHOWN

REGISTERED SURVEYOR'S CERTIFICATION

I, Dale Delaforce, hereby certify that the vertical and horizontal locations and dimensions shown on this plan are a true and correct record and were located by survey.

Registered Surveyor (sig.) Reg. Surveyor No. 6176 Date: 12/05/2025

A1

							DRAWN	ALS	06/05/2025
							CHECKED	DAM	06/05/2025
							PASSED		
INDEX	DATE	AS CONSTRUCTED	REVISIONS		DRAWN	CHECKED	PASSED	INITIALS	DATE



LOGAN CITY COUNCIL

MIRVAC MIR-1005
AS CONSTRUCTED SURVEY - SEWER
EVERLEIGH PRECINCT 10.5C
GREENBANK QLD

SHEET 7 OF 7 SHEETS	SCALE 1:250 A1
---------------------	----------------

REVISION DATE		REVISION	—
---------------	--	----------	---

DISCIPLINE CODE

DRAWING NO.

ASC-SEWER-07-10.5C