



COORDINATE DATUM NOTE:
HORIZONTAL COORDINATES(E,N) SUPPLIED ARE MAPPING GRID OF AUSTRALIA(MGA),
ZONE 56 BASED ON THE UNIVERSAL TRANSVERSE MERCATOR PROJECTION AND THE
GEOCENTRIC DATUM OF AUSTRALIA 2020.
HORIZONTAL DATUM DERIVED FROM PSM 61308 E 4 98528.701 N 6931172.420.
LEVELS SUPPLIED ARE ON THE AUSTRALIAN HEIGHT DATUM(AHD)
LEVEL DATUM DERIVED FROM PSM 61308 RL54.660 (AHD)

- | | |
|---|---|
|  | WATER METER BOX |
|  | WATER REDUCER |
|  | WATER BEND |
|  | WATER TAPING BAND |
|  | WATER BALL VALVE/STOP VALVE |
|  | WATER FIRE HYDRANT |
|  | WATERMAIN LINE
(SIZE AND CLASS AS SHOWN) |

I, _____, hereby certify that:

1. The information contained in this drawing / document is in compliance with approved drawings and design.
2. The new water and sewerage works defined by this drawing have been designed and constructed in accordance with the SEQ Code.
3. This represents an accurate record of as-constructed works
4. I accept responsibility for the information contained in this drawing / document.

RPEQ (signature) RPEQ No. _____ Date: _____

[illegible]

MIRVAC MIR-1005
AS CONSTRUCTED SURVEY - WATERMAIN
EVERLEIGH PRECINCT 10.5C
GREENBANK QLD


REVISION DATE	15/05/2025	REVISION	—
---------------	------------	----------	---

DISCIPLINE CODE	—
-----------------	---

DRAWING NO.

ASC-WATERMAIN-01-10.5C

PM61308 RL
E: 498528.701
N: 6931172.420
RL: 54.660m

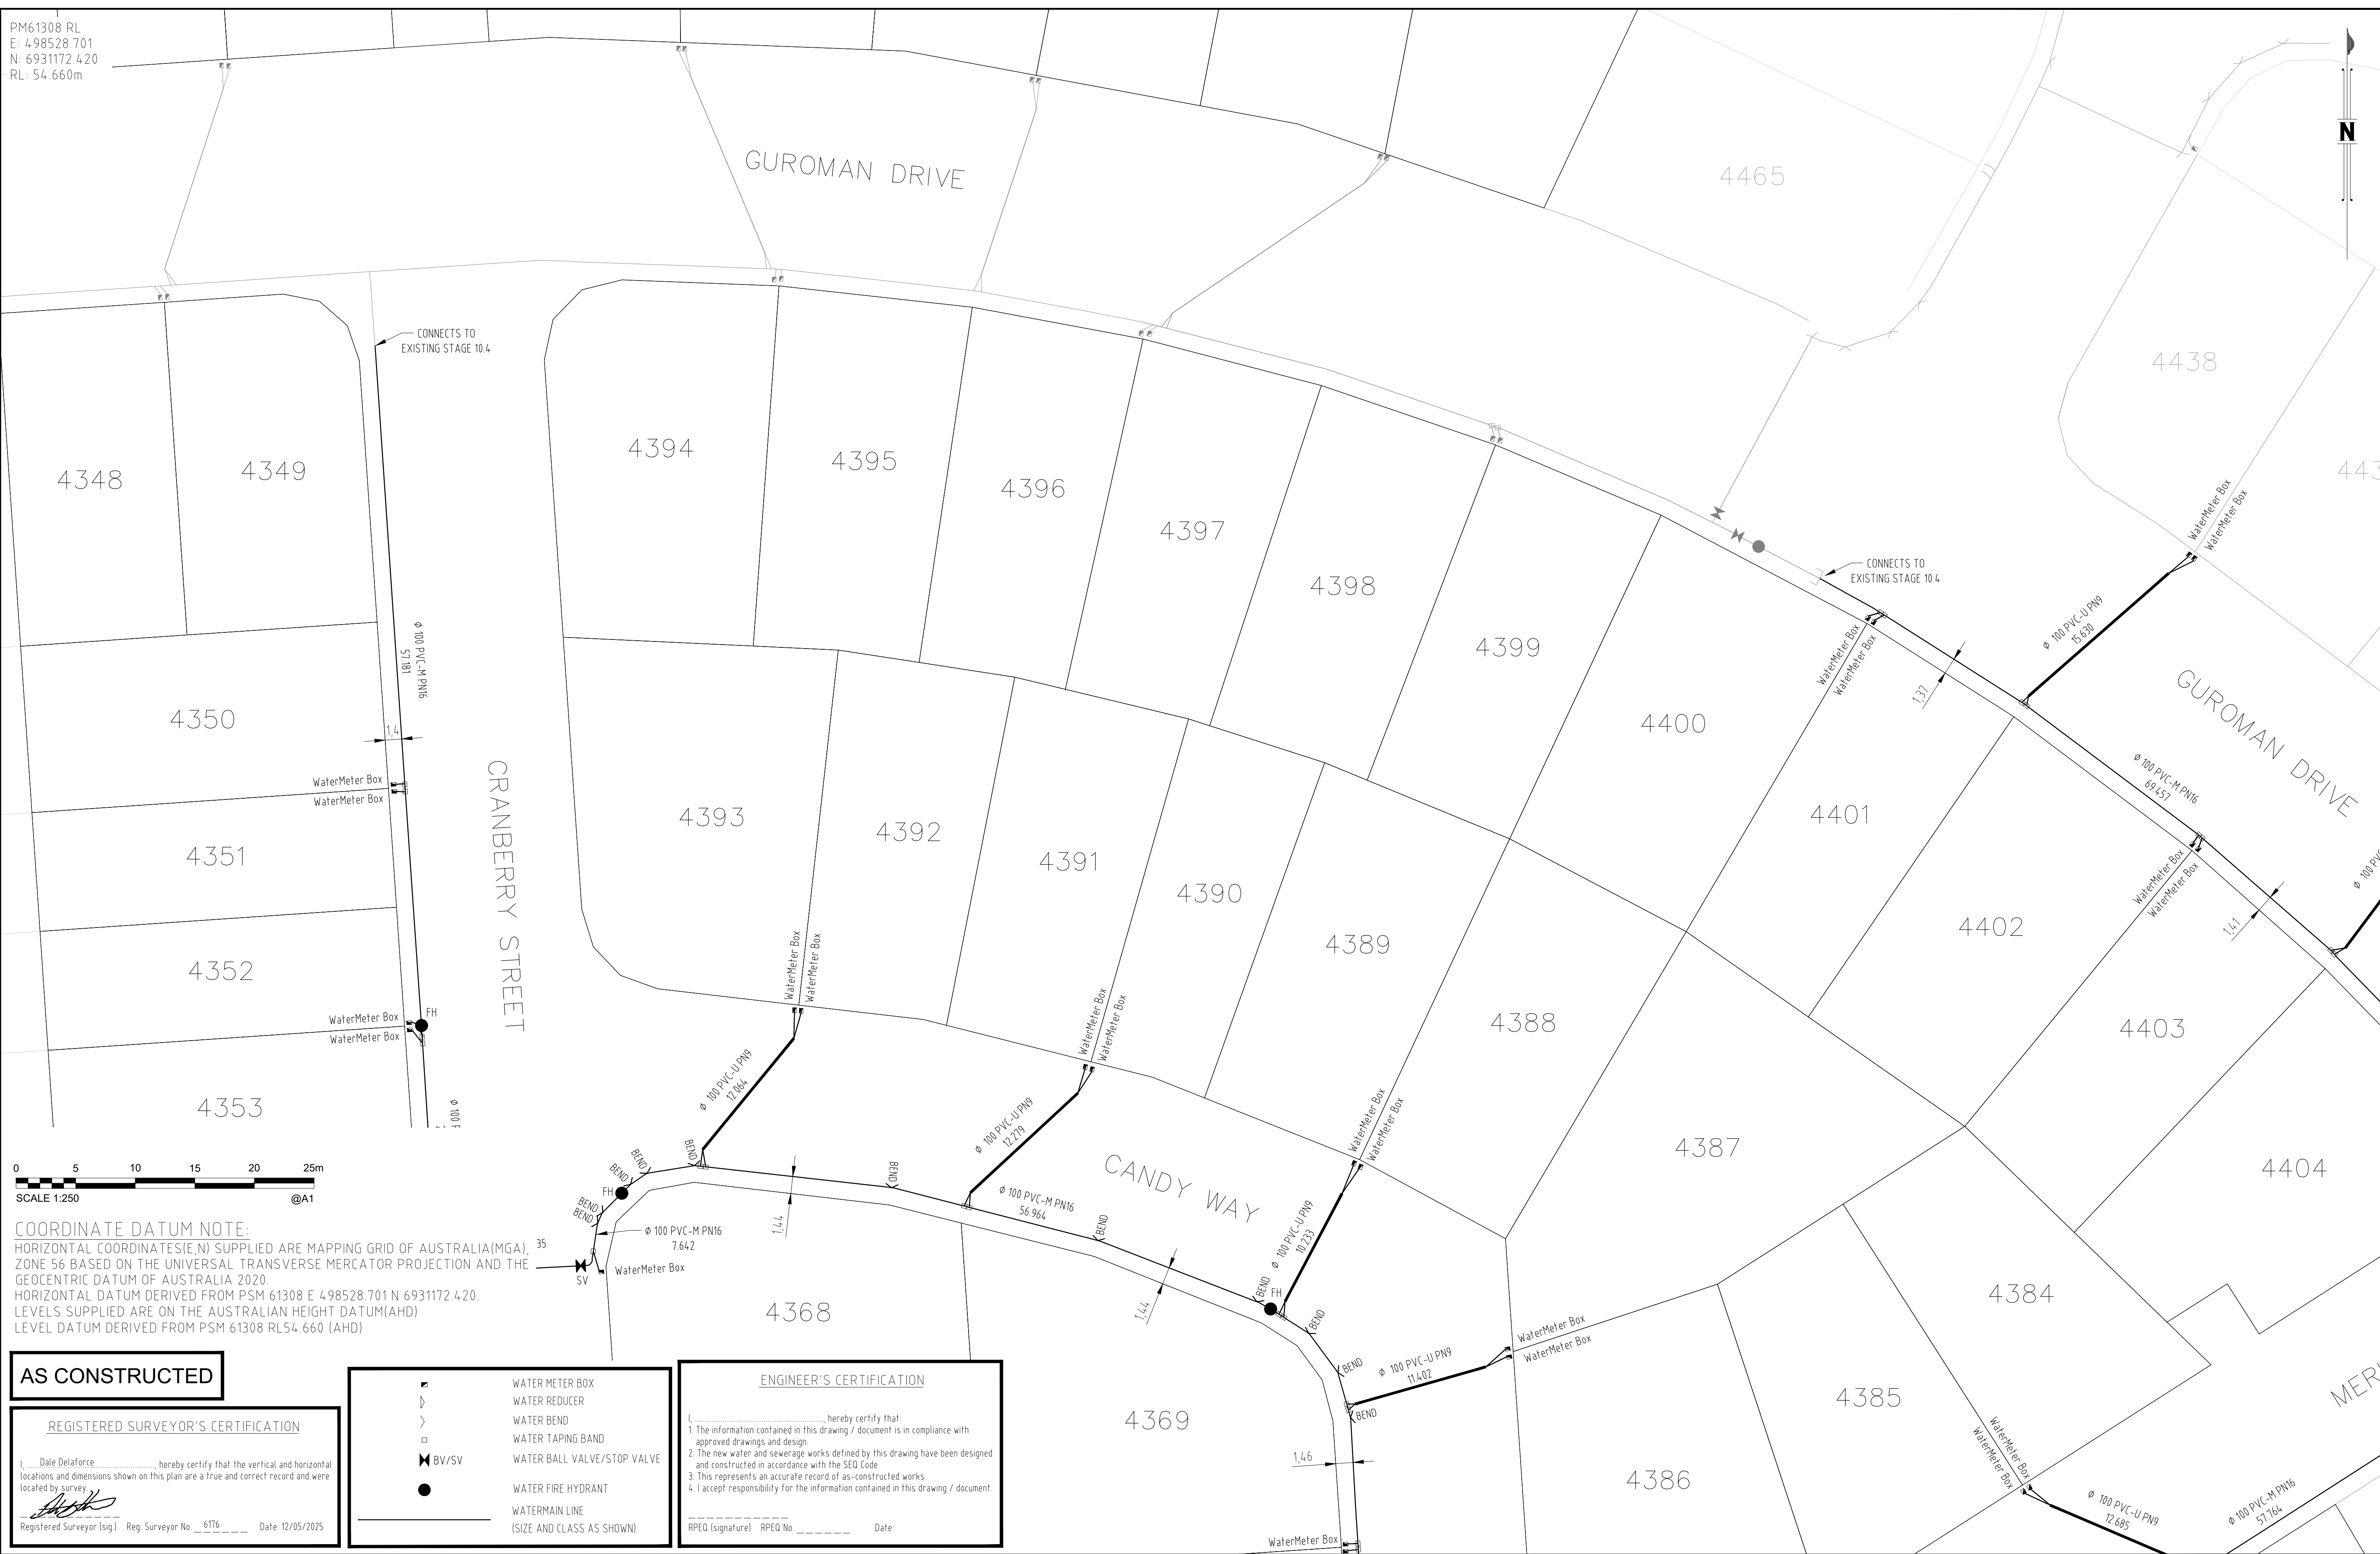

AS CONSTRUCTED

REGISTERED SURVEYOR'S CERTIFICATION

I, Dale Delaforce, hereby certify that the vertical and horizontal locations and dimensions shown on this plan are a true and correct record and were located by survey.

Registered Surveyor (sig.) _____ Reg. Surveyor No. 6176 Date: 12/05/2025

ENGINEER'S CERTIFICATION

- I, _____, hereby certify that:
1. The information contained in this drawing / document is in compliance with approved drawings and design.
 2. The new water and sewerage works defined by this drawing have been designed and constructed in accordance with the SEQ Code.
 3. This represents an accurate record of as-constructed works
 4. I accept responsibility for the information contained in this drawing / document.

RPEQ (signature) RPEQ No. _____ Date _____

A1

[illegible]

LOGAN CITY COUNCIL

MIRVAC MIR-1005
AS CONSTRUCTED SURVEY - WATERMAIN
EVERLEIGH PRECINCT 10.5C
GREENBANK QLD

SHEET 2 OF 6 SHEETS SCALE 1:250 A1

REVISION DATE	15/05/2025
---------------	------------

DISCIPLINE CODE

DRAWING NO.
ASC-WATERMAIN-02-10.50

SCALE 1:250 A1

REVISION

PM61308 RL
E: 498528.701
N: 6931172.420
RL: 54.660m




AS CONSTRUCTED

REGISTERED SURVEYOR'S CERTIFICATION

I, Dale DeLaforce, hereby certify that the vertical and horizontal locations and dimensions shown on this plan are a true and correct record and were located by survey.



Registered Surveyor (sig.) Reg. Surveyor No. 6176 Date: 12/05/2025

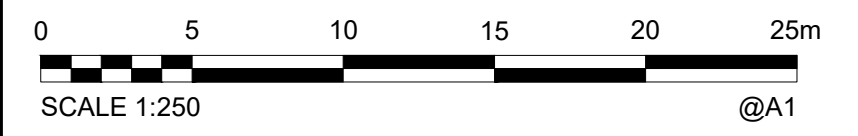

COORDINATE DATUM NOTE:
HORIZONTAL COORDINATES(E,N) SUPPLIED ARE MAPPING GRID OF AUSTRALIA(MGA),
ZONE 56 BASED ON THE UNIVERSAL TRANSVERSE MERCATOR PROJECTION AND THE
GEOCENTRIC DATUM OF AUSTRALIA 2020.
HORIZONTAL DATUM DERIVED FROM PSM 61308 E 4.98528 701 N 6931172 420.
LEVELS SUPPLIED ARE ON THE AUSTRALIAN HEIGHT DATUM(AHD)
LEVEL DATUM DERIVED FROM PSM 61308 RL54 660 (AHD)

A1							DRAWN	RDE	15/05/2025
							CHECKED	DAM	15/05/2025
			AS CONSTRUCTED				PASSED		
	INDEX	DATE	REVISIONS		DRAWN	CHECKED	PASSED	INITIALS	DATE

 **shadforth**

99 Sandalwood Lane, Forest Glen QLD 4556
P: 07 5438 3300 > F: 07 5438 3388 > E: admin@shadforth.com.au



LOGAN CITY COUNCIL

MIRVAC MIR-1005

AS CONSTRUCTED SURVEY - WATERMAIN

EVERLEIGH PRECINCT 10/5C

GREENBANK QLD

SHEET 3 OF 6	SHEETS	SCALE 1:250 A1
REVISION DATE	15/05/2025	REVISION —
DISCIPLINE CODE	—	
DRAWING NO.		
ASC-WATERMAIN-03-10.5C		



A1																																																																																																																																																																																																																																																																																																																																																																																																																																																																																																																																																																																																																																																																																																																																																																																																																																																																																																																																																																																																																																																																																																																																																																																																																																																																																																																																																																																																																																																																																																																																																																																																																																																																																																																																																																																																																																																																																																																									
----	--	--	
4550

4337

4336

4335

4334

6009

0 5 10 15 20 25m
SCALE 1:250 @A1

HORIZONTAL COORDINATES(E,N) SUPPLIED ARE MAPPING GRID OF AUSTRALIA(MGA),
ZONE 56 BASED ON THE UNIVERSAL TRANSVERSE MERCATOR PROJECTION AND THE
GEOCENTRIC DATUM OF AUSTRALIA 2020.

LEVELS SUPPLIED ARE ON THE AUSTRALIAN HEIGHT DATUM(AHD)

LEVELS SHOWN ARE ON THE ASSUMED MEAN HEIGHT DATUM
LEVEL DATUM DERIVED FROM PSM 61308 RL54.660 (AHD)

A1

INDEX

DATE _____

AS CONSTRUCTED

REVISIONS

	DRAW
--	------

CHECKED

PASSE

DRAW

	RDE
--	-----

15/05/2025

CHECK

DAM

15/05/2025

--	--

INITIAL

DATE



LOGAN CITY COUNCIL

MIRVAC MIR-1005
AS CONSTRUCTED SURVEY - WATERMAIN
EVERLEIGH PRECINCT 10.5C
GREENBANK QLD

SHEET 5 OF 6

REVISION DATE	15/05/2025
---------------	------------

DISCIPLINE CODE

DRAWING NO.

ASC-WATERMAIN-05-10.5C

SCALE 1:250 A1

REVISION	—
----------	---
