


# N

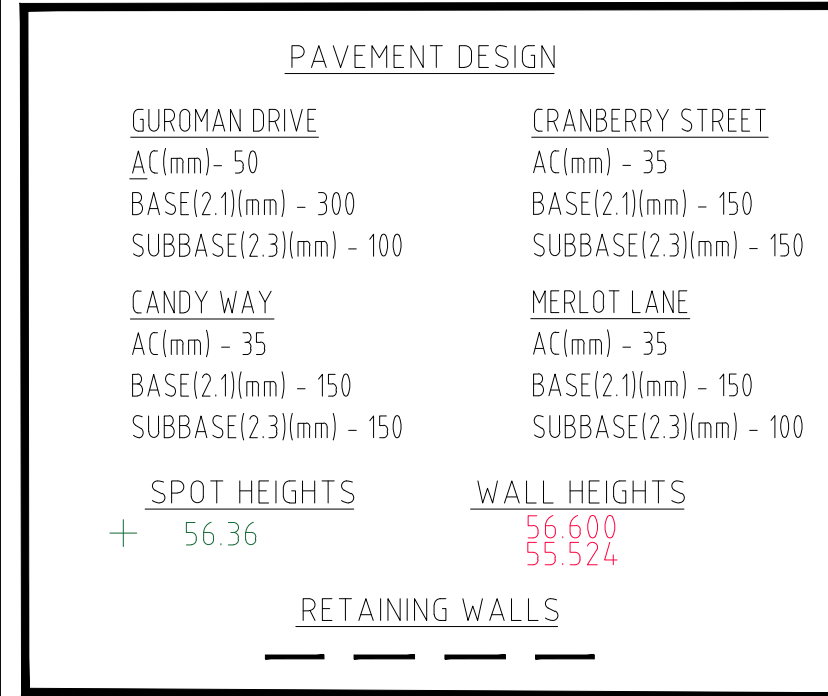

## ENGINEER'S CERTIFICATION

I, \_\_\_\_\_, hereby certify that:

1. The information contained in this drawing / document is in compliance with approved drawings and design.
2. This represents an accurate record of as-constructed works
3. I accept responsibility for the information contained in this drawing / document.


\_\_\_\_\_  
RPEQ (Signature)    RPEQ No. \_\_\_\_\_    Date: \_\_\_\_\_

## COORDINATE DATUM NOTE:

HORIZONTAL COORDINATES(E,N) SUPPLIED ARE MAPPING GRID OF AUSTRALIA(MGA), ZONE 56 BASED ON THE UNIVERSAL TRANSVERSE MERCATOR PROJECTION AND THE GEOCENTRIC DATUM OF AUSTRALIA 2020.

HORIZONTAL DATUM DERIVED FROM PSM 61308 EL54.660 N 6931172.420.

LEVELS SUPPLIED ARE ON THE AUSTRALIAN HEIGHT DATUM(AHD) LEVEL DATUM DERIVED FROM PSM 61308 RL54.660 (AHD)

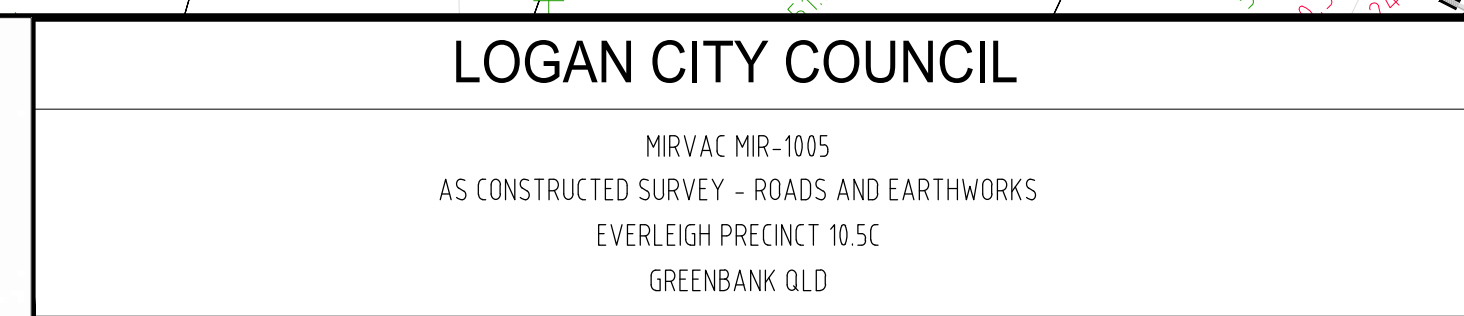

|                          |            |                |
|--------------------------|------------|----------------|
| SHEET 2 OF 6             | SHEETS     | SCALE 1:250 A1 |
| REVISION DATE 05/06/2025 | REVISION A |                |
| DISCIPLINE CODE -        |            |                |


DRAWING NO.

ASC-RDS AND EWKS-02-10.5C





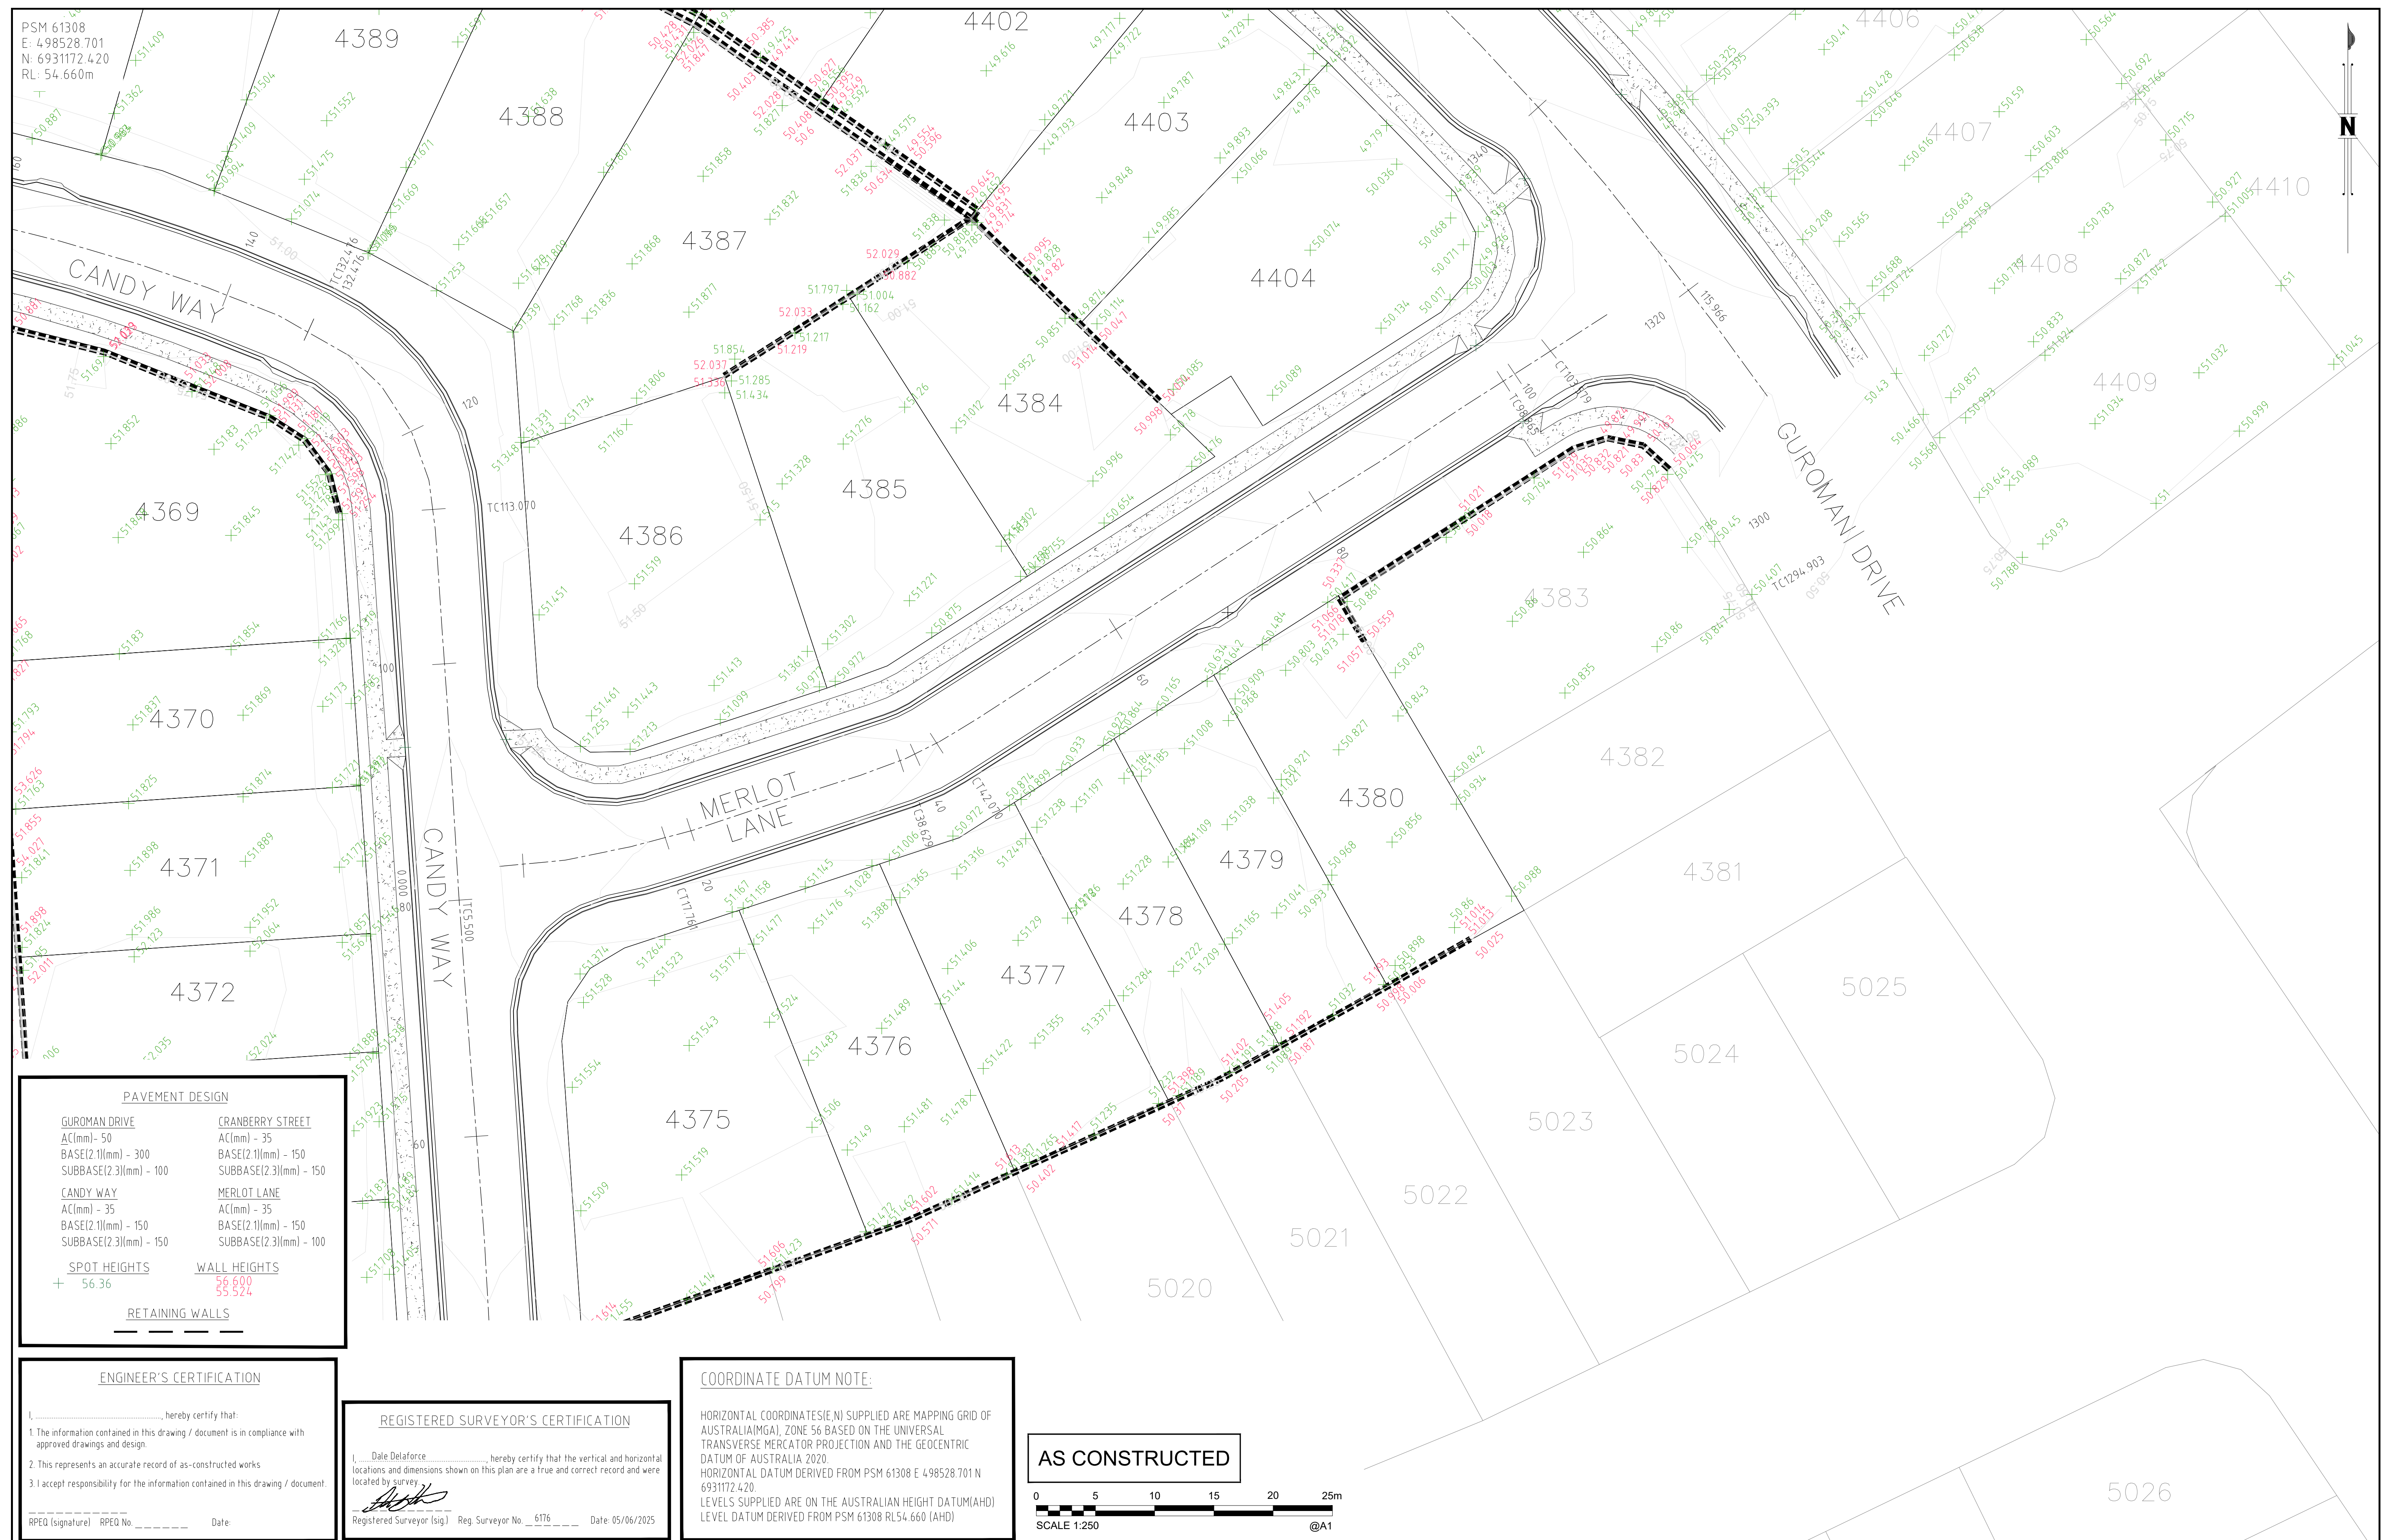

[illegible]