

PSM 61308
E: 498528.701
N: 6931172.420
RL: 54.660m



REFER TO PLAN ASC-STORMWATER-02-10.5C

REFER TO PLAN ASC-STORMWATER-03-10.5C



AS CONSTRUCTED

ENGINEER'S CERTIFICATION

- I, _____, hereby certify that:
1. The information contained in this drawing / document is in compliance with approved drawings and design.
 2. The new water and sewerage works defined by this drawing have been designed and constructed in accordance with the SEQ Code.
 3. This represents an accurate record of as-constructed works.
 4. I accept responsibility for the information contained in this drawing / document.

RPEQ (signature) RPEQ No. _____ Date: _____



STORMWATER MANHOLE



KERB INLET




KERB INLET (SAG)

STORMWATER PIPE CLASS AS SHOWN

REGISTERED SURVEYOR'S CERTIFICATION

I, _____, Date Delegation: _____, hereby certify that the vertical and horizontal locations and dimensions shown on this plan are a true and correct record and were located by survey.

Registered Surveyor (sig.) Reg. Surveyor No. 6176 Date: 03/06/2025

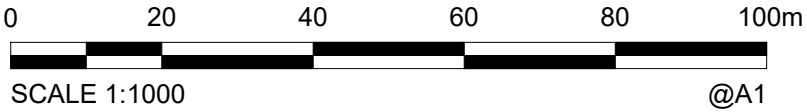

COORDINATE DATUM NOTE:

HORIZONTAL COORDINATES(E,N) SUPPLIED ARE MAPPING GRID OF AUSTRALIA(MGA), ZONE 56 BASED ON THE UNIVERSAL TRANSVERSE MERCATOR PROJECTION AND THE GEOCENTRIC DATUM OF AUSTRALIA 2020.

HORIZONTAL DATUM DERIVED FROM PSM 61308 E 498528.701 N 6931172.420.

LEVELS SUPPLIED ARE ON THE AUSTRALIAN HEIGHT DATUM(AHD)

LEVEL DATUM DERIVED FROM PSM 61308 RL54.660 (AHD)

A1

DRAWN RDE 03/06/2025
CHECKED DAM 03/06/2025
PASSED




LOGAN CITY COUNCIL

MIRVAC MIR-1005
AS CONSTRUCTED SURVEY - STORMWATER
EVERLEIGH PRECINCT 10.5C
GREENBANK QLD

SHEET 1 OF 3	SHEETS	SCALE 1:1000 A1
REVISION DATE	-	REVISION -
DISCIPLINE CODE	-	
DRAWING NO.	ASC-STORMWATER-01-10.5C	

PSM 61308
E: 498528.701
N: 6931172.420
RL: 54.660m

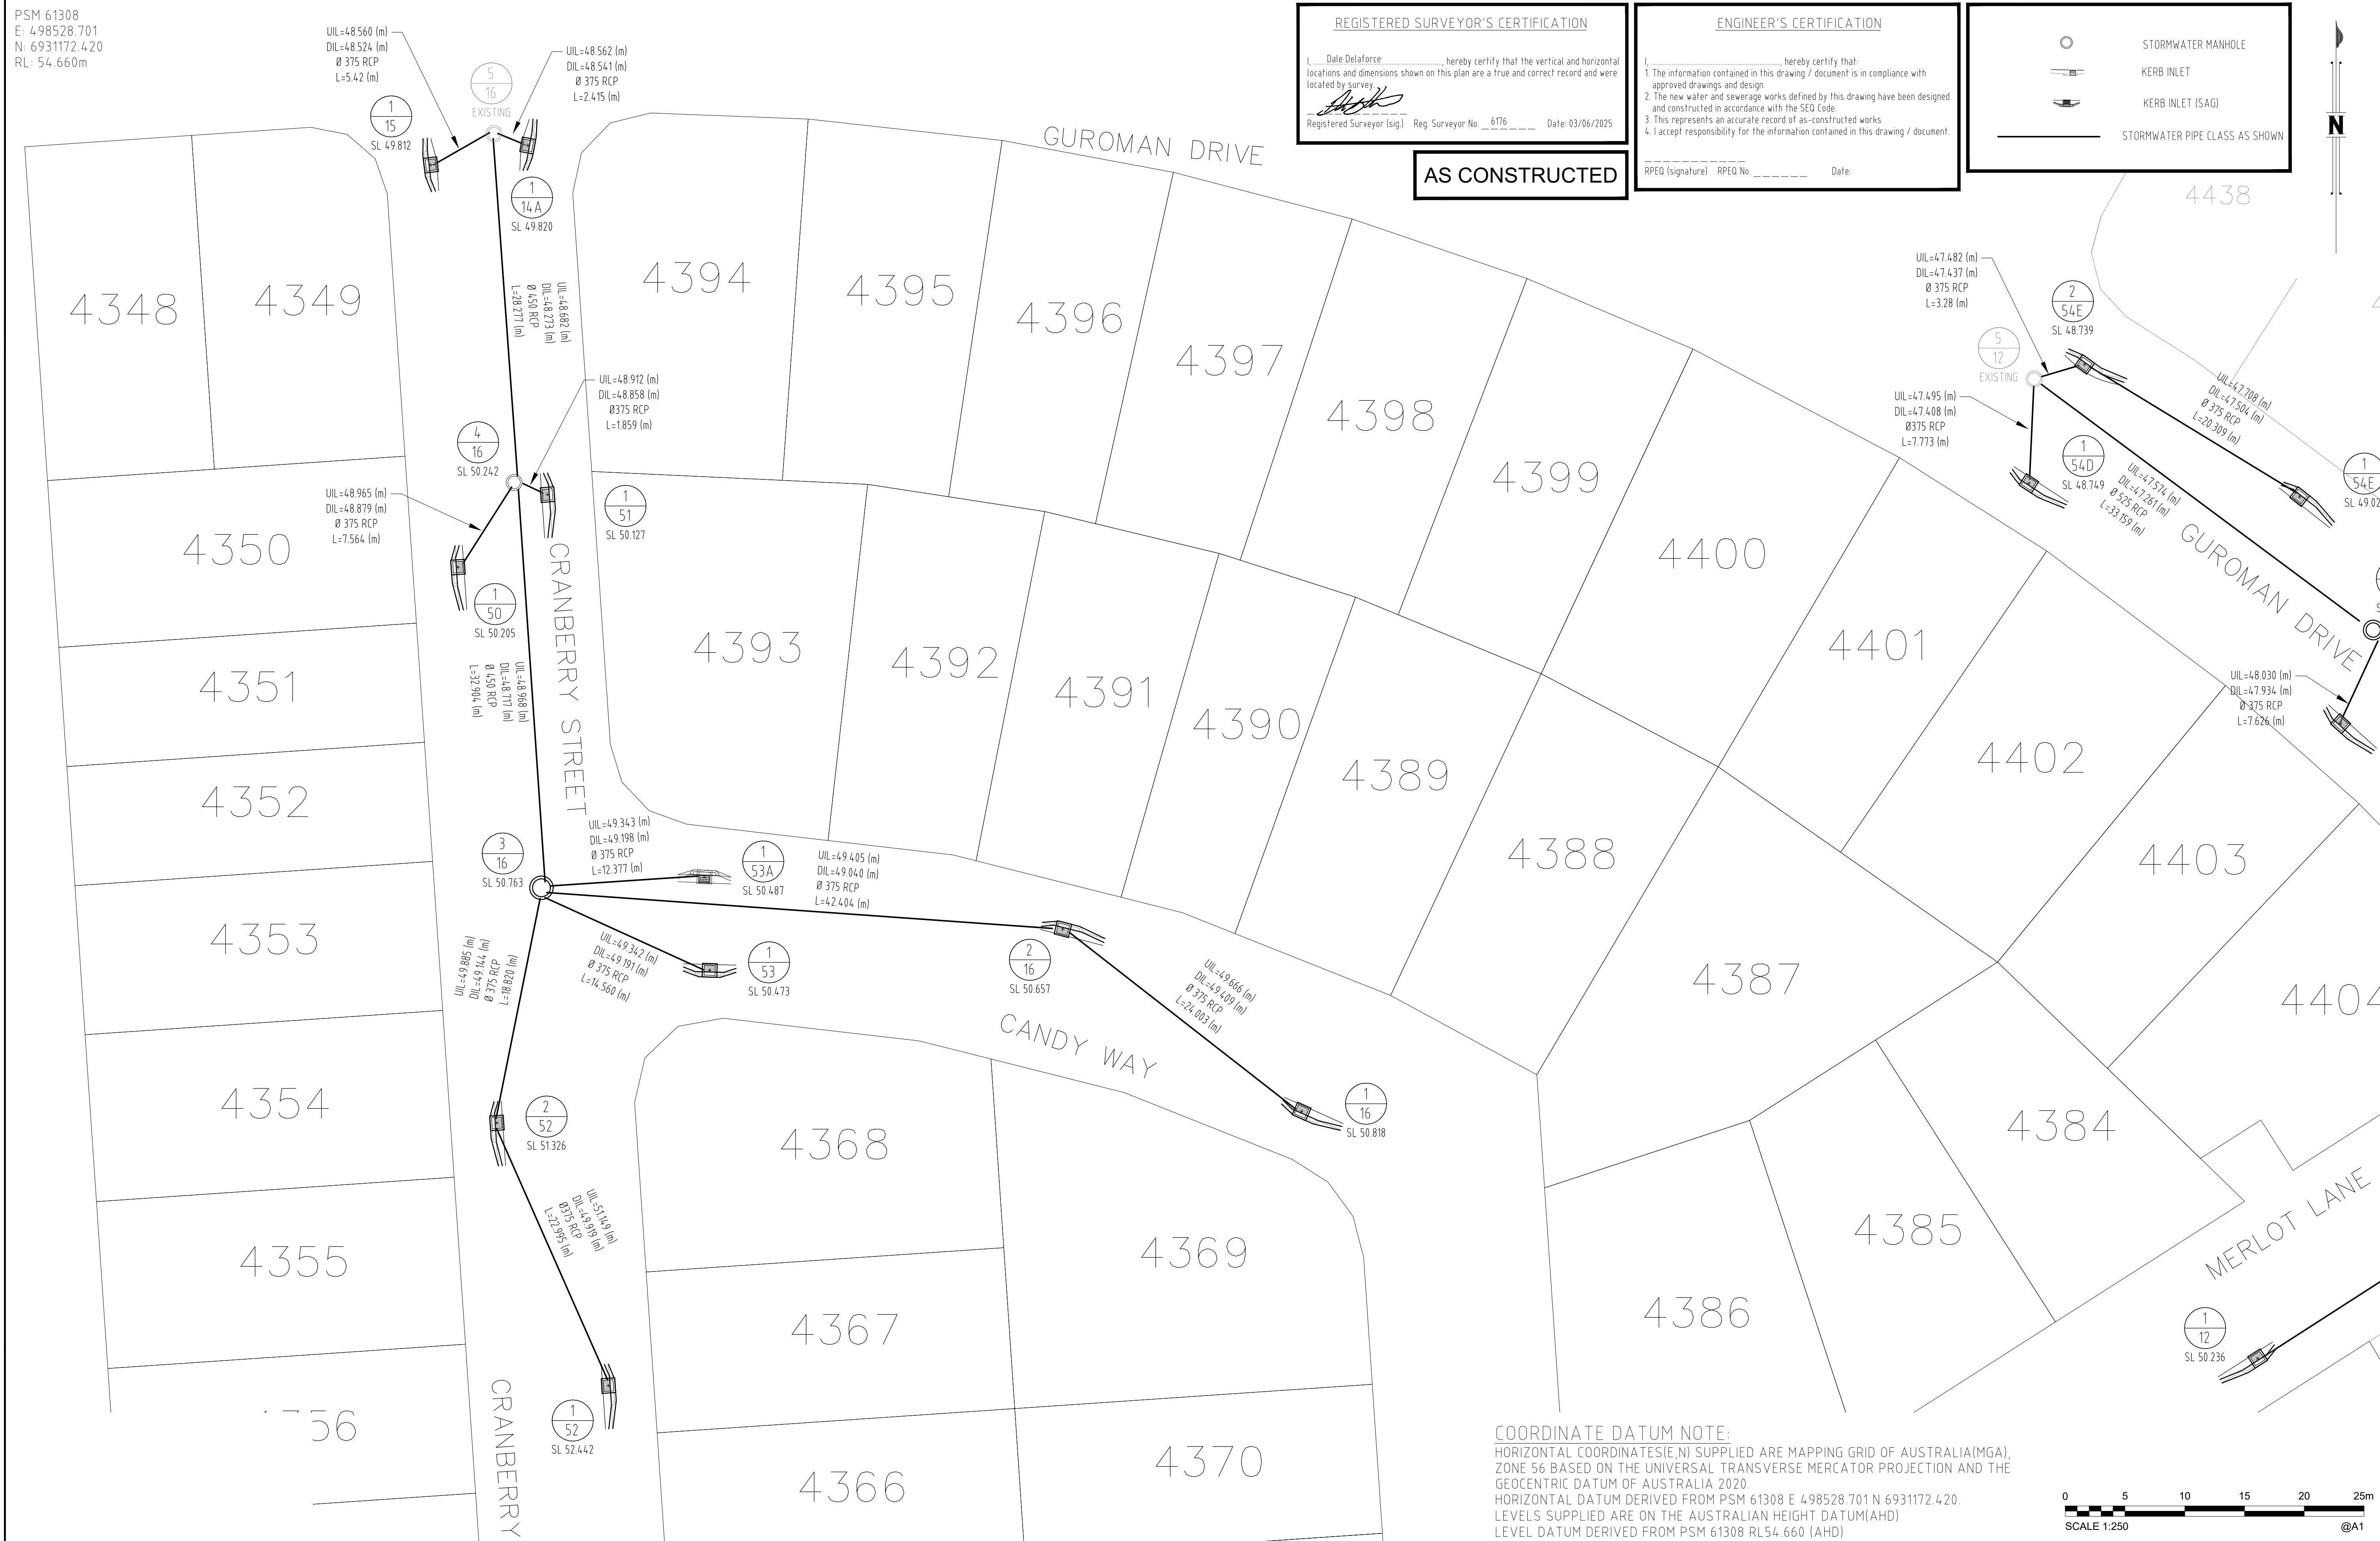

A1

[illegible]

LOGAN CITY COUNCIL

MIRVAC MIR-1005
AS CONSTRUCTED SURVEY - STORMWATER
EVERLEIGH PRECINCT 10.5C
GREENBANK QLD

SHEET 2 OF 3		SHEETS	SCALE 1:250 A1	
REVISION DATE	-	REVISION	—	
DISCIPLINE CODE	—			

DRAWING NO.

ASC-STORMWATER-02-10.5C

