

PM61308 RL
E: 498528.701
N: 6931172.420
RL: 54.660m

REFER TO PLAN ASC-SEWER-02-8.1C

REFER TO PLAN ASC-SEWER-03-8.1C

MAGENTA STREET


REFER TO PLAN ASC-SEWER-04-8.1C

REFER TO PLAN ASC-SEWER-05-8.1C

BURGUNDY BOULEVARD

SANGRIA AVENUE

GUROMAN DRIVE

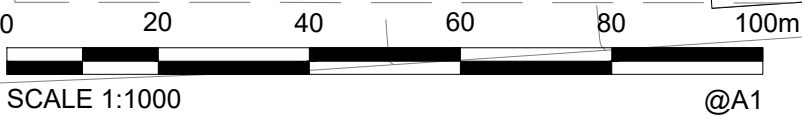

AS CONSTRUCTED

COORDINATE DATUM NOTE:

HORIZONTAL COORDINATES(E,N) SUPPLIED ARE MAPPING GRID OF AUSTRALIA(MGA), ZONE 56 BASED ON THE UNIVERSAL TRANSVERSE MERCATOR PROJECTION AND THE GEOCENTRIC DATUM OF AUSTRALIA 2020.
HORIZONTAL DATUM DERIVED FROM PSM 61308 E 498528.701 N 6931172.420.
LEVELS SUPPLIED ARE ON THE AUSTRALIAN HEIGHT DATUM(AHD)
LEVEL DATUM DERIVED FROM PSM 61308 RL54.660 (AHD)

ENGINEER'S CERTIFICATION

- I, _____, hereby certify that:
- The information contained in this drawing / document is in compliance with approved drawings and design.
 - The new water and sewerage works defined by this drawing have been designed and constructed in accordance with the SEQ Code.
 - This represents an accurate record of as-constructed works.
 - I accept responsibility for the information contained in this drawing / document.

RPEQ (signature) RPEQ No. _____ Date: _____



SEWER MANHOLE



SEWER FITTING



SEWER DEC

SEWER PIPE CLASS AS SHOWN

REGISTERED SURVEYOR'S CERTIFICATION

I, _____, Dale DeLaforce, hereby certify that the vertical and horizontal locations and dimensions shown on this plan are a true and correct record and were located by survey.

Registered Surveyor (sig) Reg. Surveyor No. 6176 Date: 04/08/2025

A1

DRAWN	ALS	04/08/2025
CHECKED	DAM	04/08/2025
PASSED		
INITIALS	DATE	



LOGAN CITY COUNCIL

MIRVAC MIR-0801
AS CONSTRUCTED SURVEY - SEWER
EVERLEIGH PRECINCT 8.1C
GREENBANK QLD

SHEET 1 OF 5 SHEETS
REVISION DATE 04/08/2025
SCALE 1:1000 A1

DISCIPLINE CODE -
DRAWING NO.
ASC-SEWER-01-8.1C

INDEX	DATE	AS CONSTRUCTED	REVISIONS	DRAWN	CHECKED	PASSED

PM61308 RL
E: 498528.701
N: 6931172.420
RL: 54.660m

AS CONSTRUCTED

ENGINEER'S CERTIFICATION

- I, _____, hereby certify that:
- The information contained in this drawing / document is in compliance with approved drawings and design.
 - The new water and sewerage works defined by this drawing have been designed and constructed in accordance with the SEQ Code.
 - This represents an accurate record of as-constructed works
 - I accept responsibility for the information contained in this drawing / document.


RPEQ (signature) RPEQ No. _____ Date: _____

- SEWER MANHOLE
× SEWER FITTING
└ SEWER DEC
_____ SEWER PIPE CLASS AS SHOWN


REGISTERED SURVEYOR'S CERTIFICATION

I, _____, hereby certify that the vertical and horizontal locations and dimensions shown on this plan are a true and correct record and were located by survey.

[Signature]
Registered Surveyor (sig) _____ Reg. Surveyor No. 6176 Date: 04/08/2025

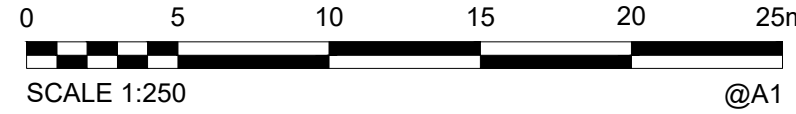

COORDINATE DATUM NOTE:
HORIZONTAL COORDINATES(E,N) SUPPLIED ARE MAPPING GRID OF AUSTRALIA(MGA), ZONE 56 BASED ON THE UNIVERSAL TRANSVERSE MERCATOR PROJECTION AND THE GEOCENTRIC DATUM OF AUSTRALIA 2020.
HORIZONTAL DATUM DERIVED FROM PSM 61308 E 498528.701 N 6931172.420.
LEVELS SUPPLIED ARE ON THE AUSTRALIAN HEIGHT DATUM(AHD)
LEVEL DATUM DERIVED FROM PSM 61308 RL54.660 (AHD)

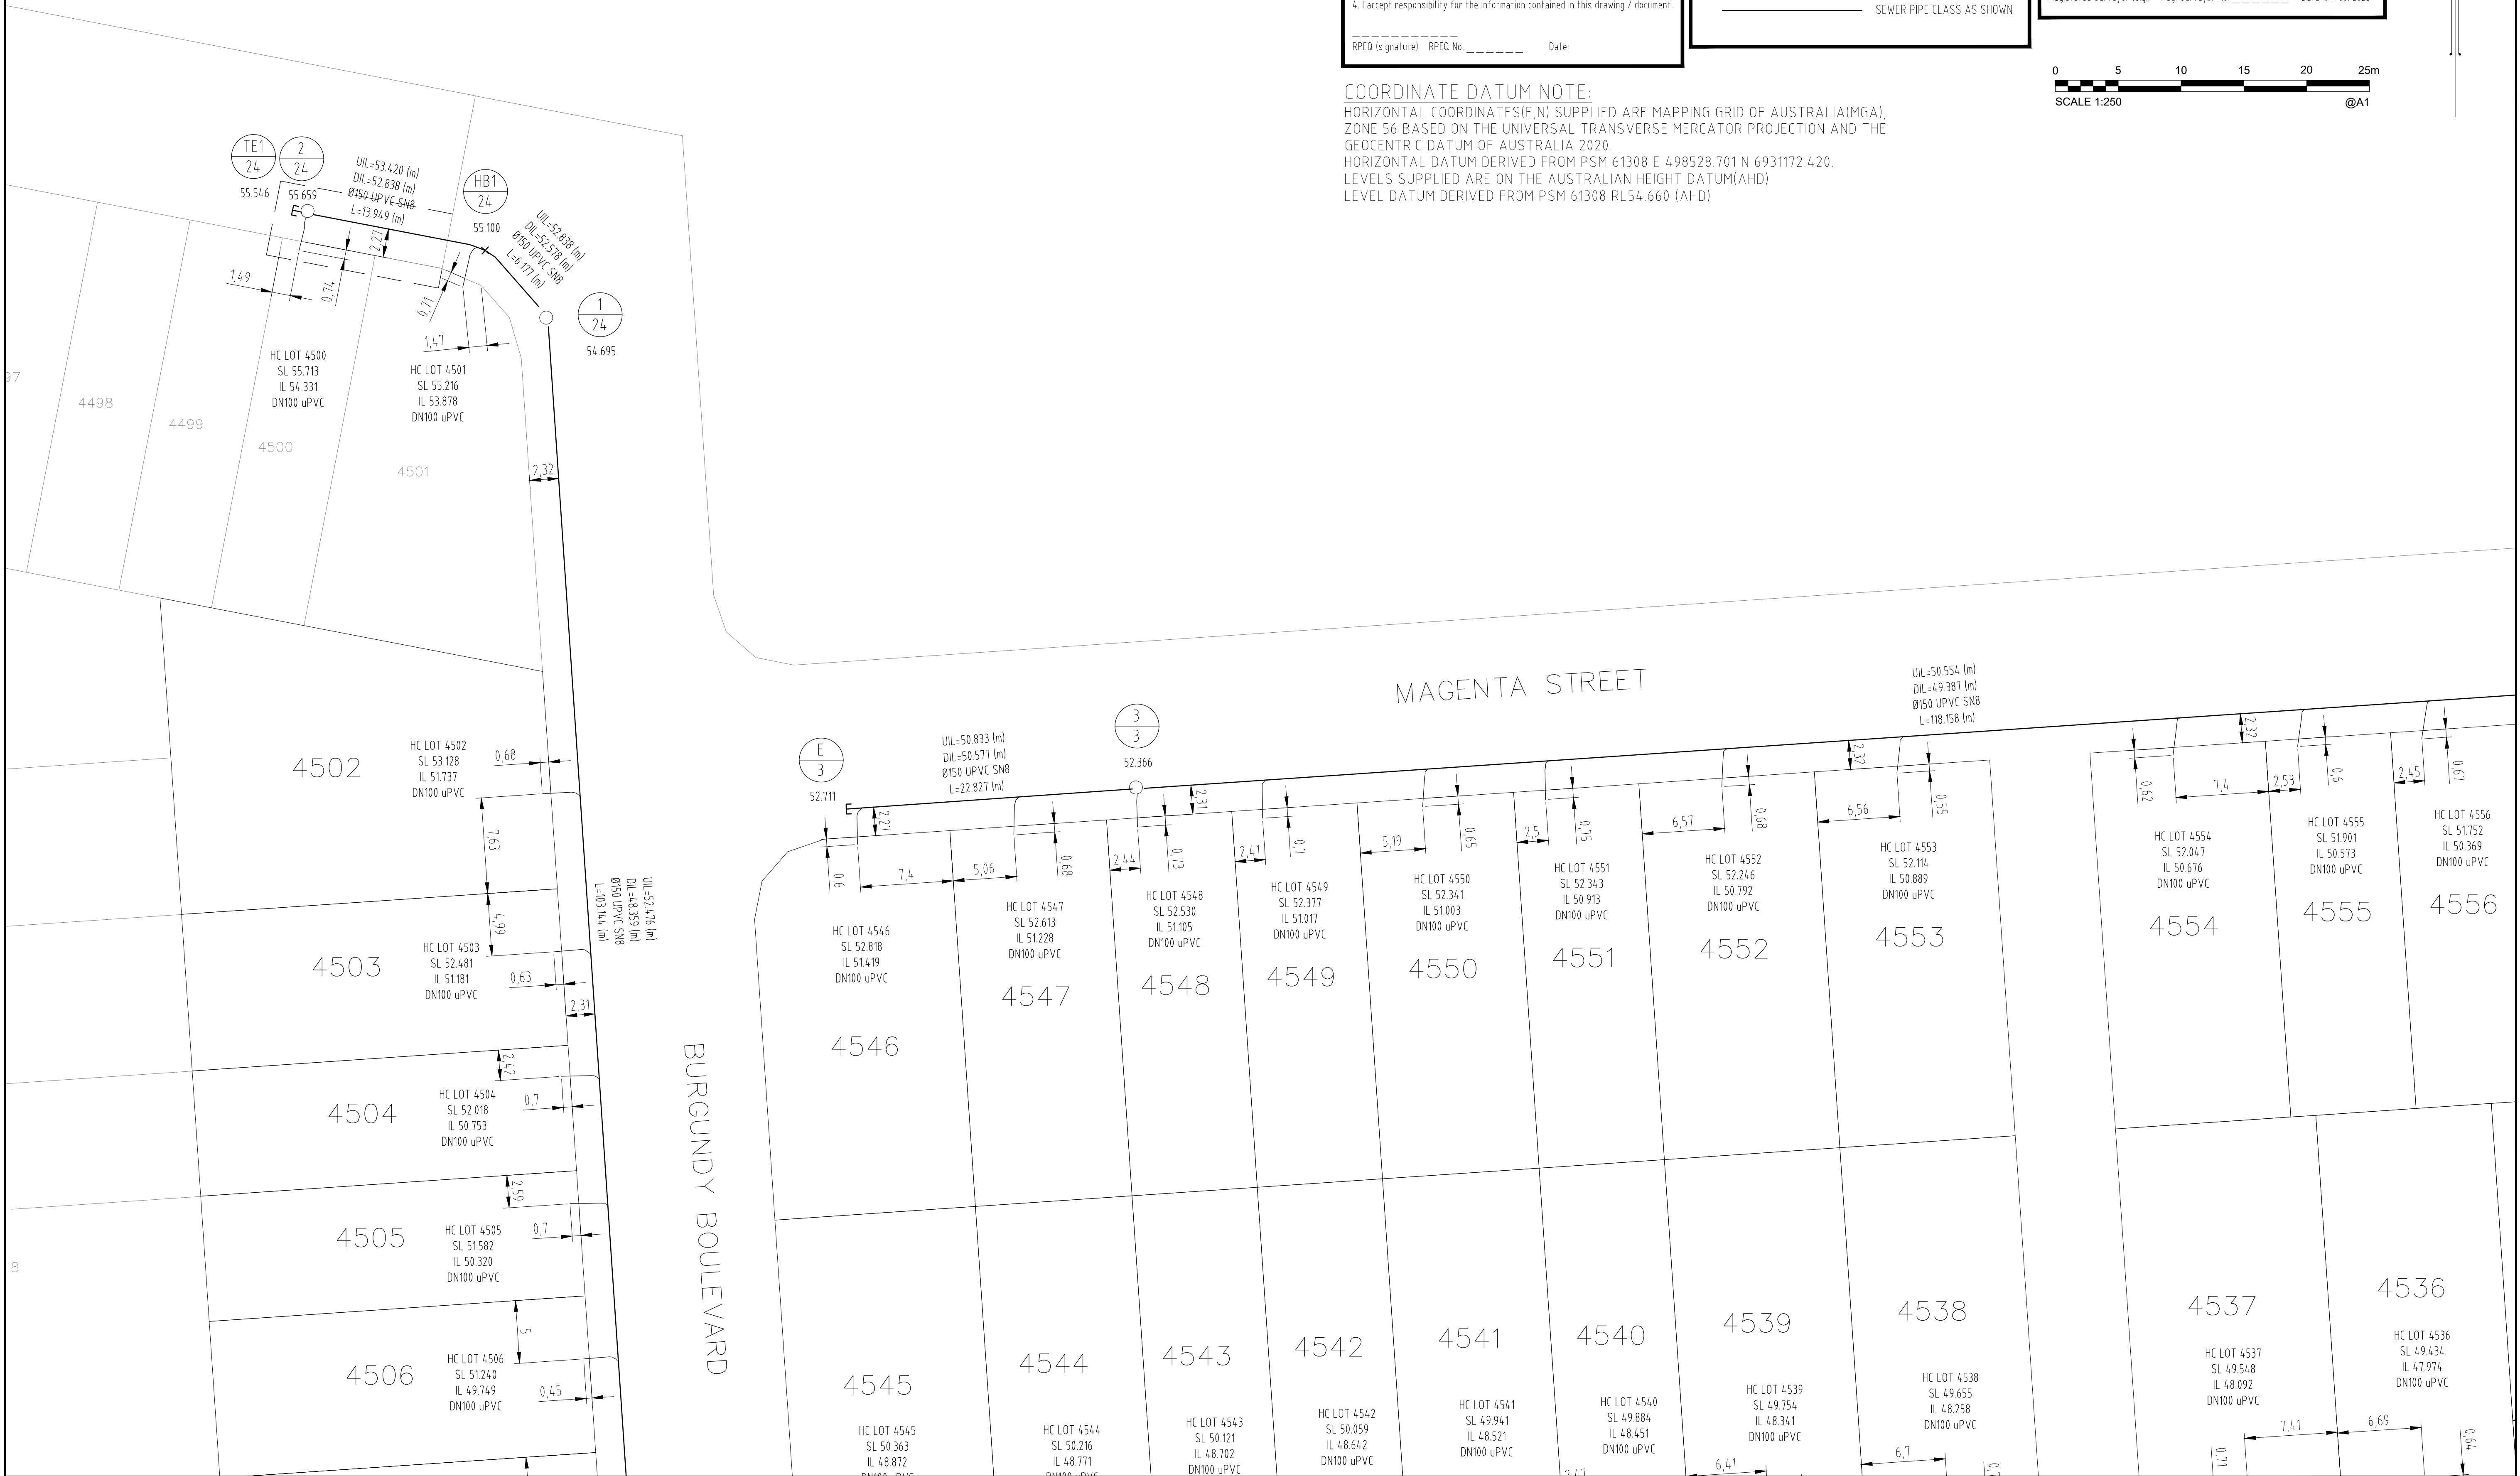

A1																																																																																																																																																																																																																																																																																																																																																																																																																																																																																																																																																																																																																																																																																																																																																																																																																																																																																																																																																																																																																																																																																																																																																																																																																																																																																																																																																																																																																				
----	--	--	
PM61308 RL
E: 498528.701
N: 6931172.420
RL: 54.660m

AS CONSTRUCTED

ENGINEER'S CERTIFICATION

- I, _____, hereby certify that:
- The information contained in this drawing / document is in compliance with approved drawings and design.
 - The new water and sewerage works defined by this drawing have been designed and constructed in accordance with the SEQ Code.
 - This represents an accurate record of as-constructed works.
 - I accept responsibility for the information contained in this drawing / document.


RPEQ (signature) RPEQ No. _____ Date: _____

- SEWER MANHOLE
× SEWER FITTING
└ SEWER DEC
_____ SEWER PIPE CLASS AS SHOWN


REGISTERED SURVEYOR'S CERTIFICATION

I, _____, hereby certify that the vertical and horizontal locations and dimensions shown on this plan are a true and correct record and were located by survey.

Registered Surveyor (sig) _____ Reg. Surveyor No. 6176 Date: 04/08/2025

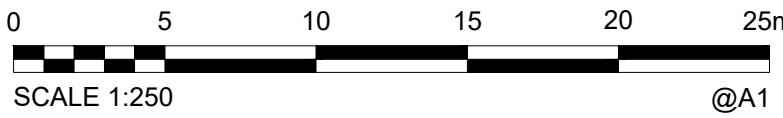


COORDINATE DATUM NOTE:
HORIZONTAL COORDINATES(E,N) SUPPLIED ARE MAPPING GRID OF AUSTRALIA(MGA), ZONE 56 BASED ON THE UNIVERSAL TRANSVERSE MERCATOR PROJECTION AND THE GEOCENTRIC DATUM OF AUSTRALIA 2020.
HORIZONTAL DATUM DERIVED FROM PSM 61308 E 498528.701 N 6931172.420.
LEVELS SUPPLIED ARE ON THE AUSTRALIAN HEIGHT DATUM(AHD)
LEVEL DATUM DERIVED FROM PSM 61308 RL54.660 (AHD)

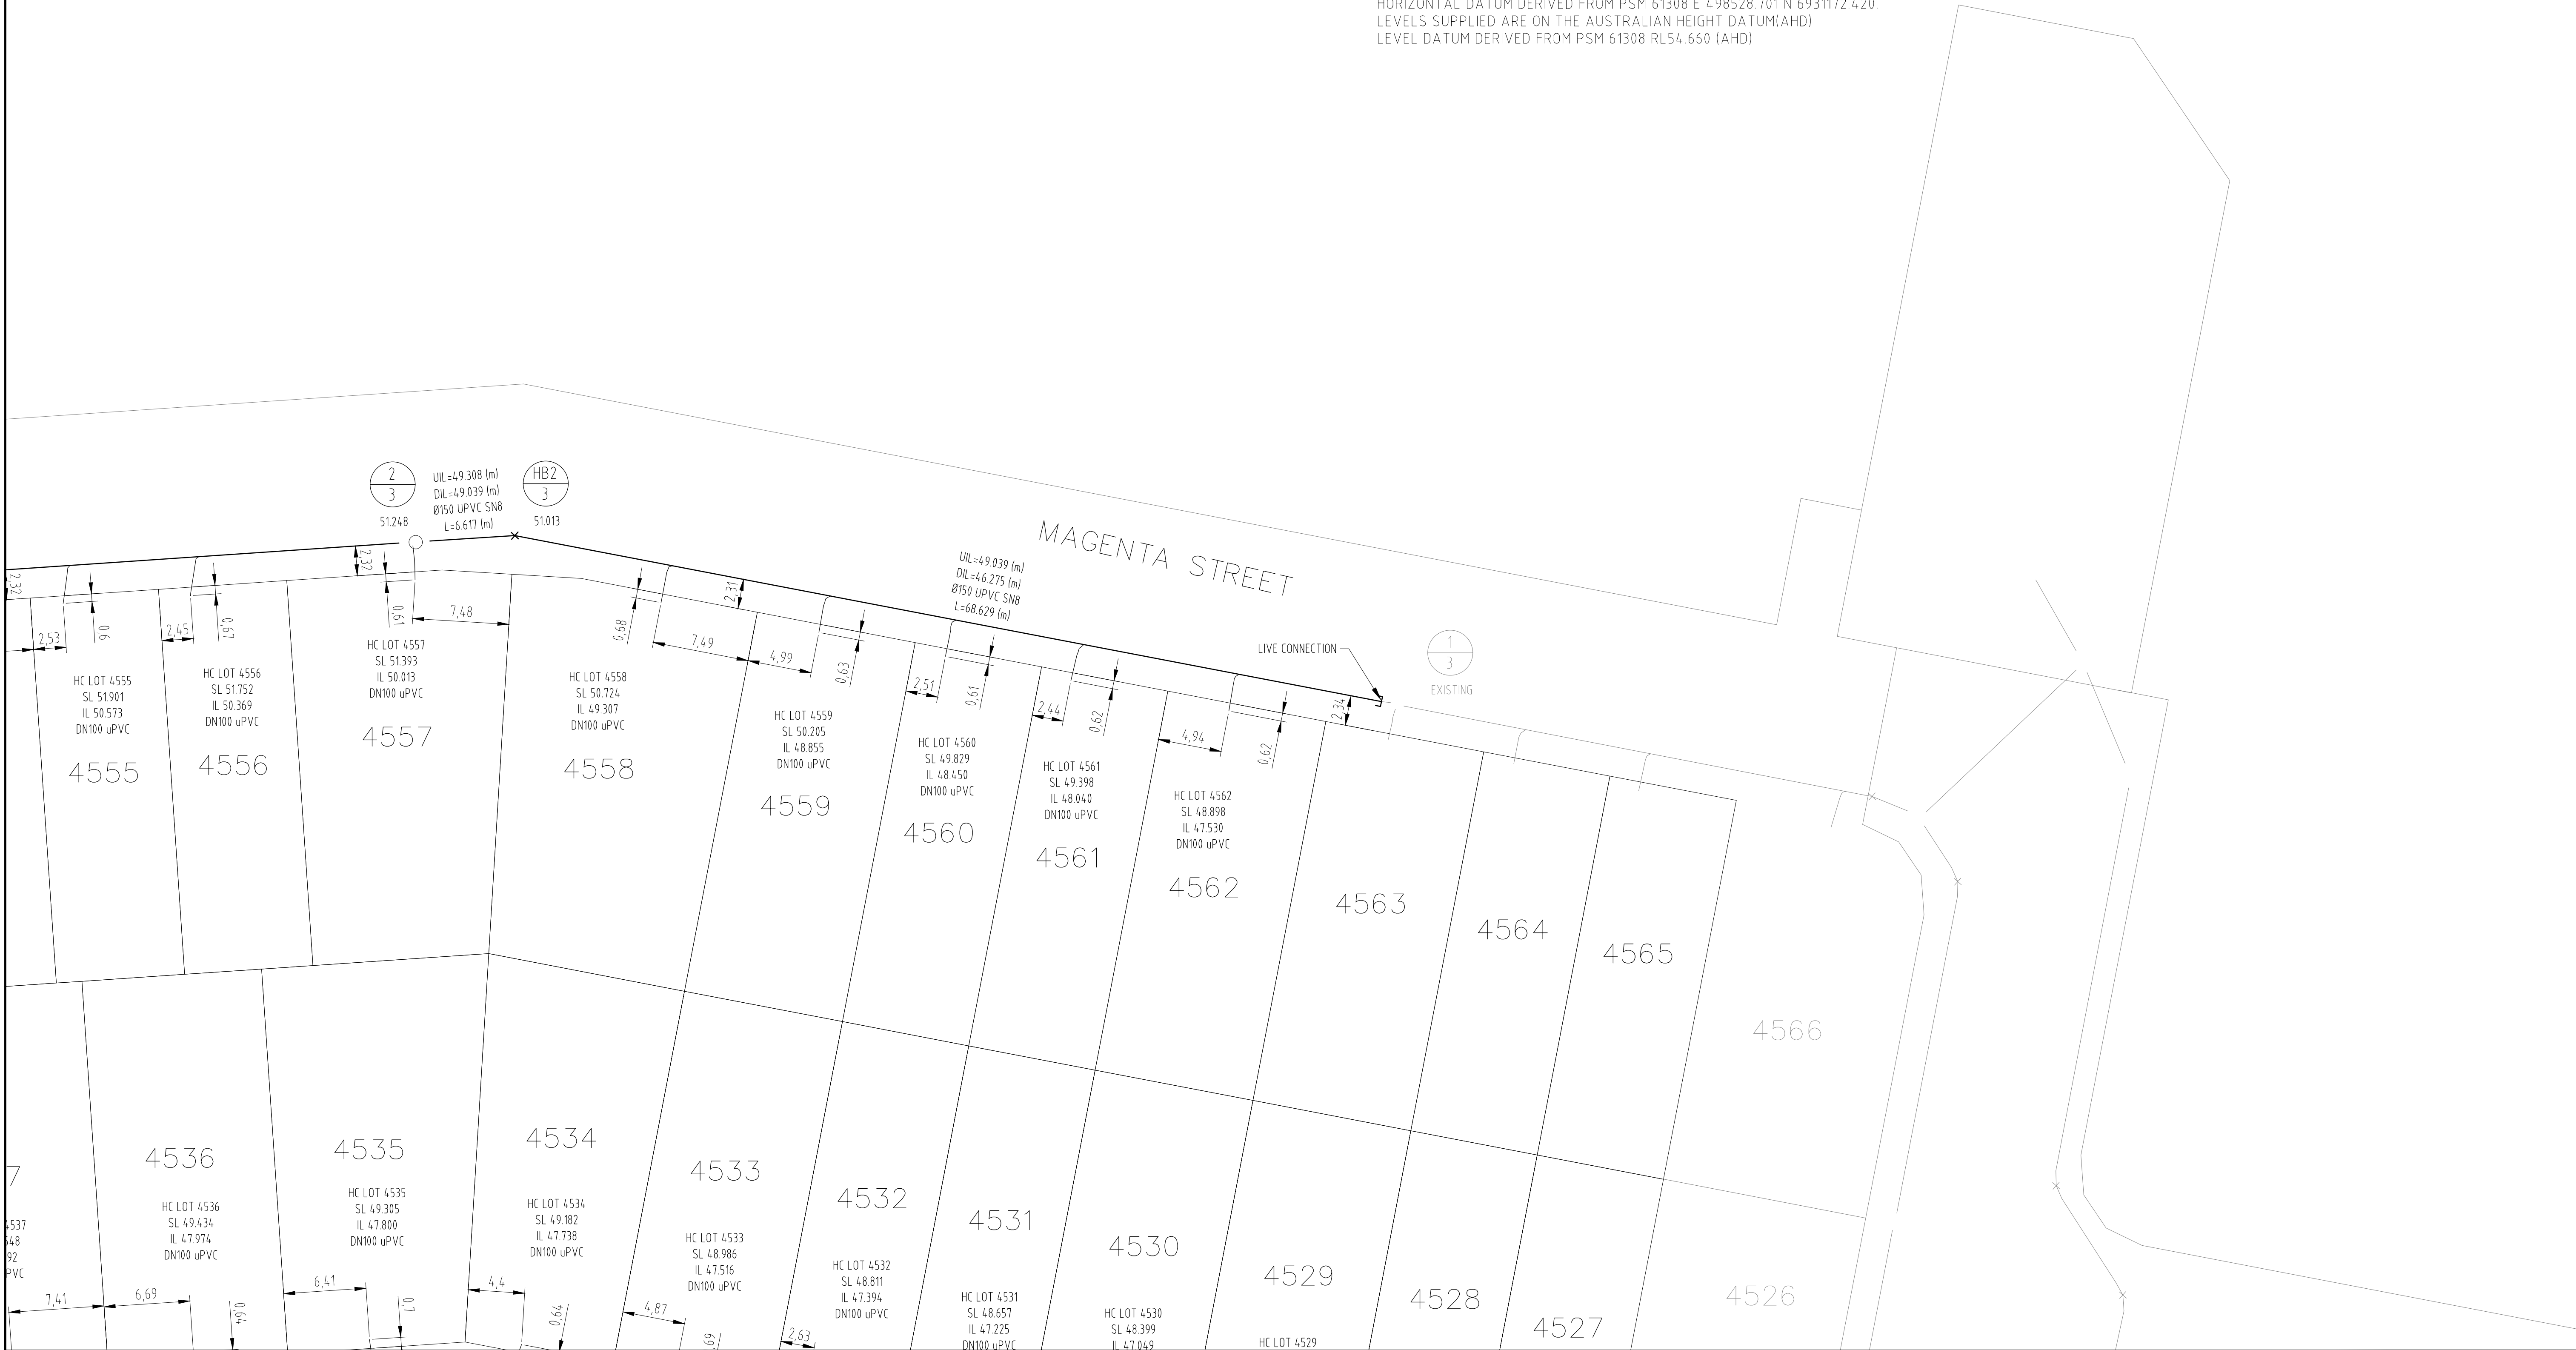

A1																																																																																																																																																																																																																																																																																																																																																																																																																																																																																																																																																																																																																																																																																																																																																																																																																																																																																																																																																																																																																																																																																																																																																																																																																																																																																																																																																																																																																				
----	--	--	
PM61308 RL
E: 498528.701
N: 6931172.420
RL: 54.660m

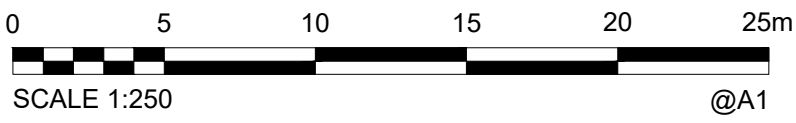

AS CONSTRUCTED

COORDINATE DATUM NOTE:
HORIZONTAL COORDINATES(E,N) SUPPLIED ARE MAPPING GRID OF AUSTRALIA(MGA), ZONE 56 BASED ON THE UNIVERSAL TRANSVERSE MERCATOR PROJECTION AND THE GEOCENTRIC DATUM OF AUSTRALIA 2020.
HORIZONTAL DATUM DERIVED FROM PSM 61308 E 498528.701 N 6931172.420.
LEVELS SUPPLIED ARE ON THE AUSTRALIAN HEIGHT DATUM(AHD)
LEVEL DATUM DERIVED FROM PSM 61308 RL54.660 (AHD)

ENGINEER'S CERTIFICATION

- I, _____, hereby certify that:
- The information contained in this drawing / document is in compliance with approved drawings and design.
 - The new water and sewerage works defined by this drawing have been designed and constructed in accordance with the SEQ Code.
 - This represents an accurate record of as-constructed works.
 - I accept responsibility for the information contained in this drawing / document.

RPEQ (signature) RPEQ No. _____ Date: _____

- SEWER MANHOLE
x SEWER FITTING
└ SEWER DEC
— SEWER PIPE CLASS AS SHOWN

REGISTERED SURVEYOR'S CERTIFICATION

I, _____, Dale Delaforce, hereby certify that the vertical and horizontal locations and dimensions shown on this plan are a true and correct record and were located by survey.

Registered Surveyor (sig) Reg. Surveyor No. 6176 Date: 04/08/2025

A1



LOGAN CITY COUNCIL

MIRVAC MIR-0801
AS CONSTRUCTED SURVEY - SEWER
EVERLEIGH PRECINCT 8.1C
GREENBANK QLD


SHEET 4 OF 5 SHEETS SCALE 1:250 A1

REVISION DATE REVISION

DISCIPLINE CODE

DRAWING NO.

ASC-SEWER-04-8.1C

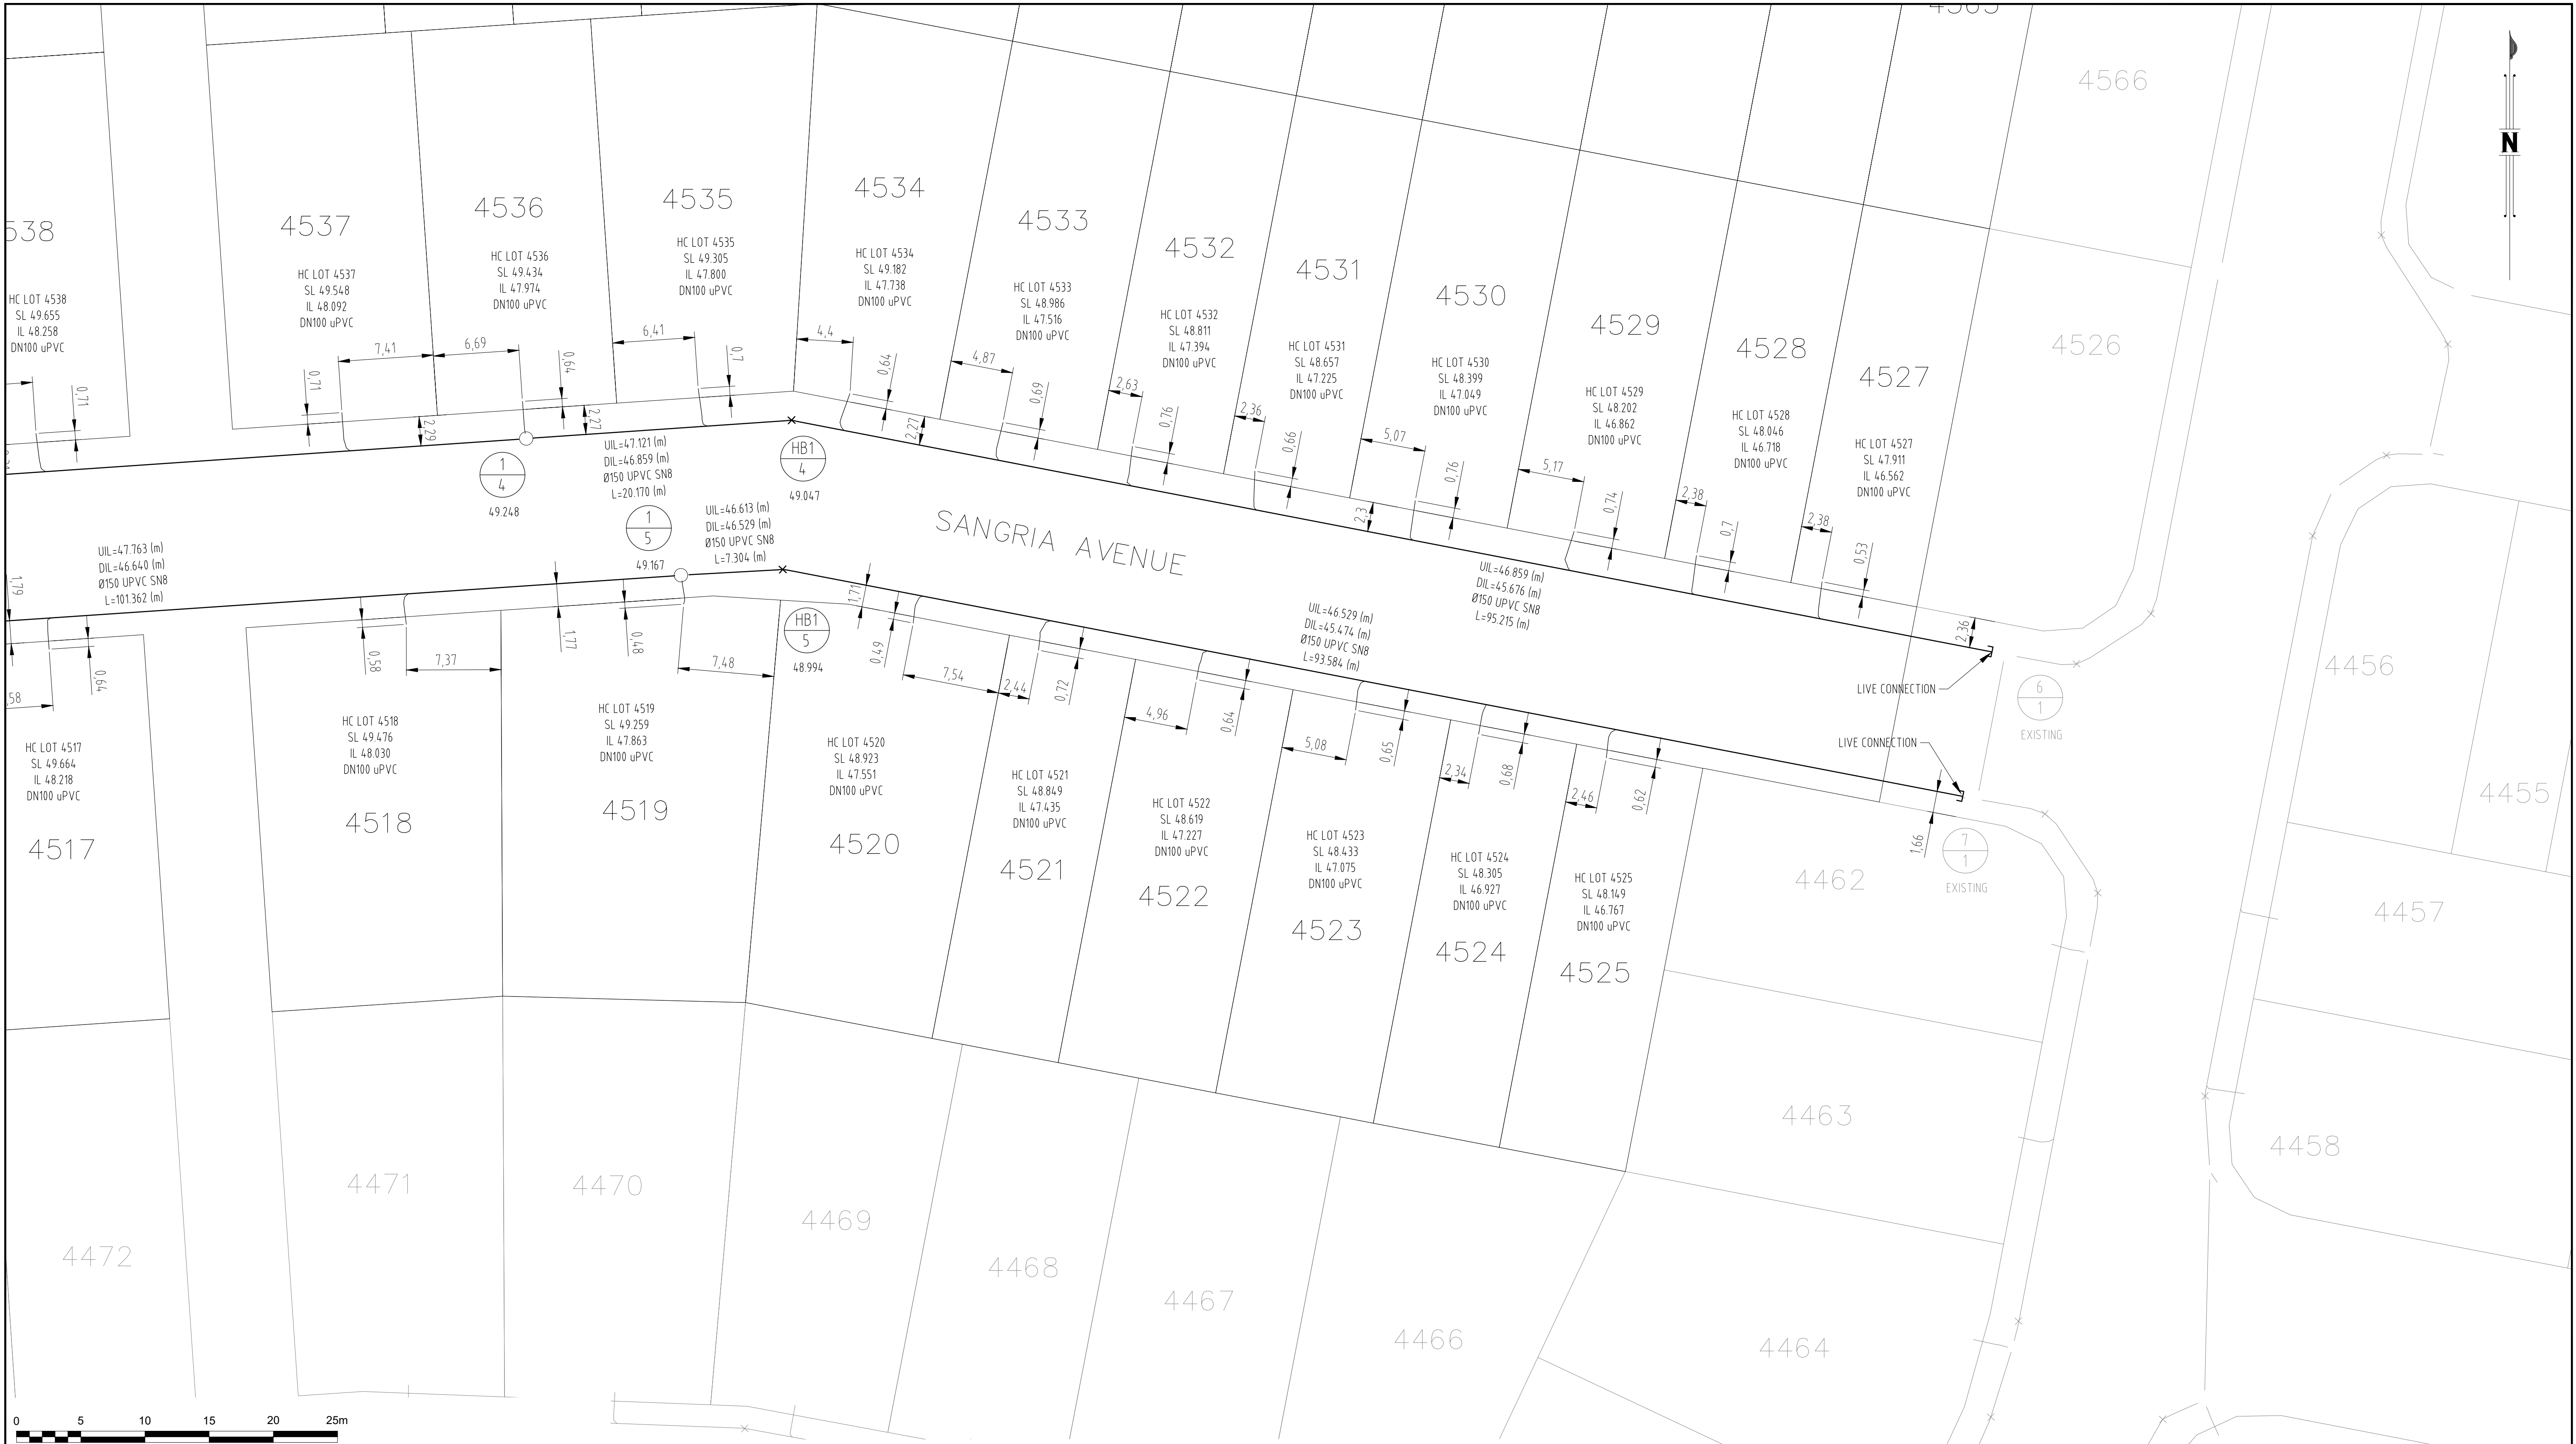

AS CONSTRUCTED

COORDINATE DATUM NOTE:
HORIZONTAL COORDINATES(E,N) SUPPLIED ARE MAPPING GRID OF AUSTRALIA(MGA), ZONE 56 BASED ON THE UNIVERSAL TRANSVERSE MERCATOR PROJECTION AND THE GEOCENTRIC DATUM OF AUSTRALIA 2020.
HORIZONTAL DATUM DERIVED FROM PSM 61308 E 498528.701 N 6931172.420.
LEVELS SUPPLIED ARE ON THE AUSTRALIAN HEIGHT DATUM(AHD)
LEVEL DATUM DERIVED FROM PSM 61308 RL54.660 (AHD)

ENGINEER'S CERTIFICATION

I, _____, hereby certify that:
1. The information contained in this drawing / document is in compliance with approved drawings and design.
2. The new water and sewerage works defined by this drawing have been designed and constructed in accordance with the SEQ Code.
3. This represents an accurate record of as-constructed works.
4. I accept responsibility for the information contained in this drawing / document.
RPEQ (signature) _____ RPEQ No. _____ Date: _____

○ SEWER MANHOLE
× SEWER FITTING
└ SEWER DEC
_____ SEWER PIPE CLASS AS SHOWN

REGISTERED SURVEYOR'S CERTIFICATION

I, _____, Date Delegation _____, hereby certify that the vertical and horizontal locations and dimensions shown on this plan are a true and correct record and were located by survey.

Registered Surveyor (sig.) Reg. Surveyor No. 6176 Date: 04/08/2025

PM61308 RL
E: 498528.701
N: 6931172.420
RL: 54.660m

A1									 99 Sandshewood Lane, Forest Glen QLD 4056 P: 07 5438 3300 > F: 07 5438 3308 > E: info@shadforth.com.au	 LOGAN CITY COUNCIL	LOGAN CITY COUNCIL		SHEET 5 OF 5 SHEETS		SCALE 1:250 A1			
											MIRVAC MIR-0801		REVISION DATE		REVISION			
											AS CONSTRUCTED SURVEY - SEWER		DISCIPLINE CODE		-			
											EVERLEIGH PRECINCT 8.1C		DRAWING NO.		ASC-SEWER-05-8.1C			
INDEX	DATE	AS CONSTRUCTED				DRAWN	CHECKED	PASSED			GREENBANK QLD							
		REVISIONS																
						DRAWN	CHECKED	PASSED										
						INITIALS	DATE											