

REFER TO PLAN ASC-WATER-03-8.1C

REFER TO PLAN ASC-WATER-04-8.1C

0 10 20 30 40 50m

SCALE 1:500 @A1

COORDINATE DATUM NOTE:
HORIZONTAL COORDINATES(E,N) SUPPLIED ARE MAPPING GRID OF AUSTRALIA(MGA),
ZONE 56 BASED ON THE UNIVERSAL TRANSVERSE MERCATOR PROJECTION AND THE
GEOCENTRIC DATUM OF AUSTRALIA 2020.
HORIZONTAL DATUM DERIVED FROM PSM 61308 E 4.98528 701 N 6931172.420.
LEVELS SUPPLIED ARE ON THE AUSTRALIAN HEIGHT DATUM(AHD).
LEVEL DATUM DERIVED FROM PSM 61308 RL54.660 (AHD).

	WATER METER BOX
	WATER REDUCER
	WATER BEND
	WATER TAPING BAND
 BV/SV	WATER BALL VALVE/STOP VALVE
	WATER FIRE HYDRANT
	WATERMAIN LINE (SIZE AND CLASS AS SHOWN)

I,, hereby certify that:

1. The information contained in this drawing / document is in compliance with approved drawings and design.
2. The new water and sewerage works defined by this drawing have been designed and constructed in accordance with the SEQ Code.
3. This represents an accurate record of as-constructed works
4. I accept responsibility for the information contained in this drawing / document.

RPEQ (signature) RPEQ No. Date:

DRAWN	RDE	19/08/2025
CHECKED	DAM	19/08/2025
PASSED		
	INITIALS	DATE



MIRVAC MIR-0801
AS CONSTRUCTED SURVEY - WATERMAIN
EVERLEIGH PRECINCT 8.1C
GREENBANK QLD

SHEET 1 OF 4 SHEETS		SCALE 1:1000 A1	
REVISION DATE	19/08/2025	REVISION	—
DISCIPLINE CODE	—		
DRAWING NO.			
ASC-WATERMAIN-01-8.1C			

PM61308 RL
E: 498528.701
N: 6931172.420
RL: 54.660m

COORDINATE DATUM NOTE:
HORIZONTAL COORDINATES(E,N) SUPPLIED ARE MAPPING GRID OF AUSTRALIA(MGA),
ZONE 56 BASED ON THE UNIVERSAL TRANSVERSE MERCATOR PROJECTION AND THE
GEOCENTRIC DATUM OF AUSTRALIA 2020.
HORIZONTAL DATUM DERIVED FROM PSM 61308 E 4.98528 701 N 6931172 420.
LEVELS SUPPLIED ARE ON THE AUSTRALIAN HEIGHT DATUM(AHD)
LEVEL DATUM DERIVED FROM PSM 61308 RL54 660 (AHD)

REGISTERED SURVEYOR'S CERTIFICATION

I, Dale Delaforce, hereby certify that the vertical and horizontal locations and dimensions shown on this plan are a true and correct record and were located by survey.

Registered Surveyor (sig.) Reg. Surveyor No. 6176 Date: 19/08/2025


AS CONSTRUCTED

ENGINEER'S CERTIFICATION

I, _____, hereby certify that:

1. The information contained in this drawing / document is in compliance with approved drawings and design.
2. The new water and sewerage works defined by this drawing have been designed and constructed in accordance with the SEQ Code.
3. This represents an accurate record of as-constructed works
4. I accept responsibility for the information contained in this drawing / document.

RPEQ (signature) RPEQ No. _____ Date: _____

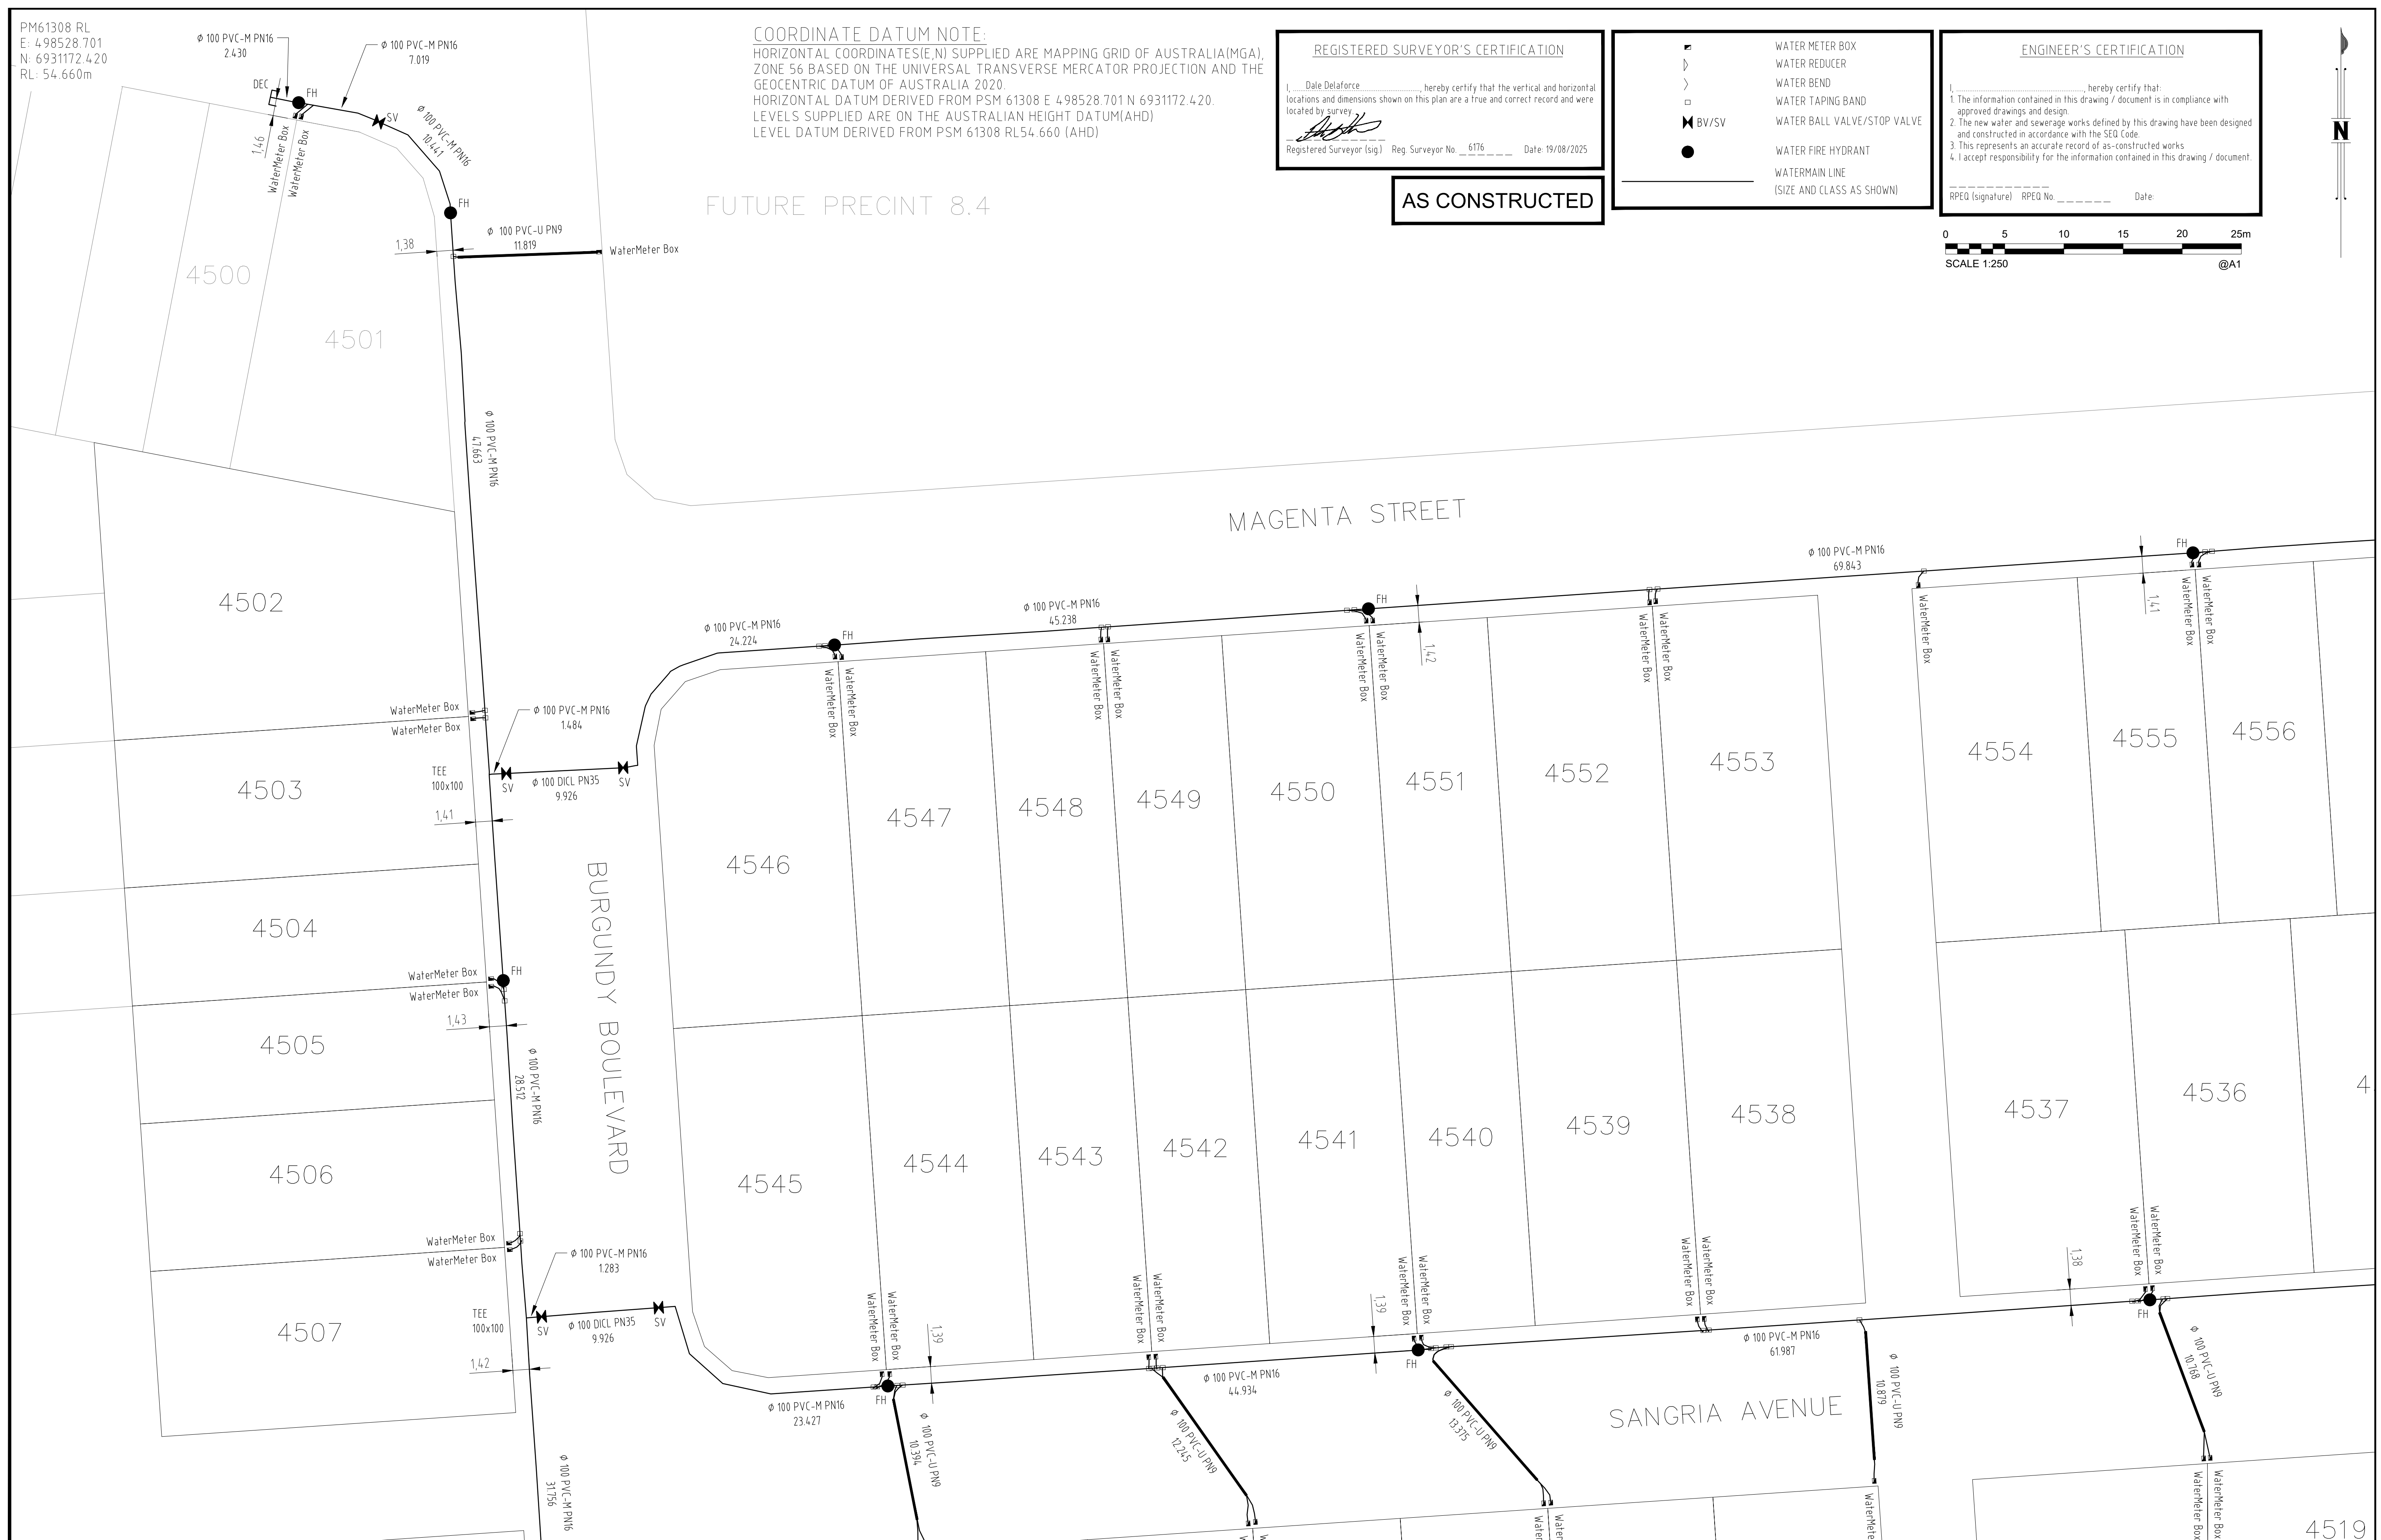

A1

							DRAWN	RDE	19/08/2025
							CHECKED	DAM	19/08/2025
							PASSED		
INDEX	DATE	AS CONSTRUCTED	REVISIONS		DRAWN	CHECKED	PASSED	INITIALS	DATE



LOGAN CITY COUNCIL

MIRVAC MIR-0801
AS CONSTRUCTED SURVEY - WATERMAIN
EVERLEIGH PRECINCT 8.1C
GREENBANK QLD

SHEET 2 OF 4		SHEETS		SCALE 1:250 A1	
REVISION DATE		19/08/2025		REVISION —	
DISCIPLINE CODE		—			
DRAWING NO.					
ASC-WATERMAIN-02-8.1C					

PM61308 RL
E: 498528.701
N: 6931172.420
RL: 54.660m



COORDINATE DATUM NOTE:

HORIZONTAL COORDINATES(E,N) SUPPLIED ARE MAPPING GRID OF AUSTRALIA(MGA), ZONE 56 BASED ON THE UNIVERSAL TRANSVERSE MERCATOR PROJECTION AND THE GEOCENTRIC DATUM OF AUSTRALIA 2020.

HORIZONTAL DATUM DERIVED FROM PSM 61308 E 498528.701 N 6931172.420.

LEVELS SUPPLIED ARE ON THE AUSTRALIAN HEIGHT DATUM(AHD)

LEVELS SHOWN ARE ON THE AUSTRALIAN HEIGHT DATA
LEVEL DATUM DERIVED FROM PSM 61308 RL54.660 (AHD)

AS CONSTRUCTED

REGISTERED SURVEYOR'S CERTIFICATION

I, Dale Delaforce, hereby certify that the vertical and horizontal locations and dimensions shown on this plan are a true and correct record and were located by survey.

Registered Surveyor (sig.) _____ Reg. Surveyor No. 6176 Date: 19/08/2025

ENGINEER'S CERTIFICATION

I, _____, hereby certify that:

1. The information contained in this drawing / document is in compliance with approved drawings and design.
2. The new water and sewerage works defined by this drawing have been designed and constructed in accordance with the SEQ Code.
3. This represents an accurate record of as-constructed works
4. I accept responsibility for the information contained in this drawing / document.

RPEQ (signature) RPEQ No. _____ Date: _____

A1

							DRAWN	RDE	19/08/2025
							CHECKED	DAM	19/08/2025
							PASSED		
INDEX	DATE	REVISIONS	DRAWN	CHECKED	PASSED		INITIALS	DATE	




LOGAN CITY COUNCIL

MIRVAC MIR-0801
AS CONSTRUCTED SURVEY - WATERMAIN
EVERLEIGH PRECINCT 8.1C
GREENBANK QLD

SHEET 3 OF 4 SHEETS		SCALE 1:250 A1	
REVISION DATE	19/08/2025	REVISION	—
DISCIPLINE CODE	—		
DRAWING NO. ASC-WATERMAIN-03-8.1C			

PM61308 RL
E: 498528.701
N: 6931172.420
RL: 54.660m

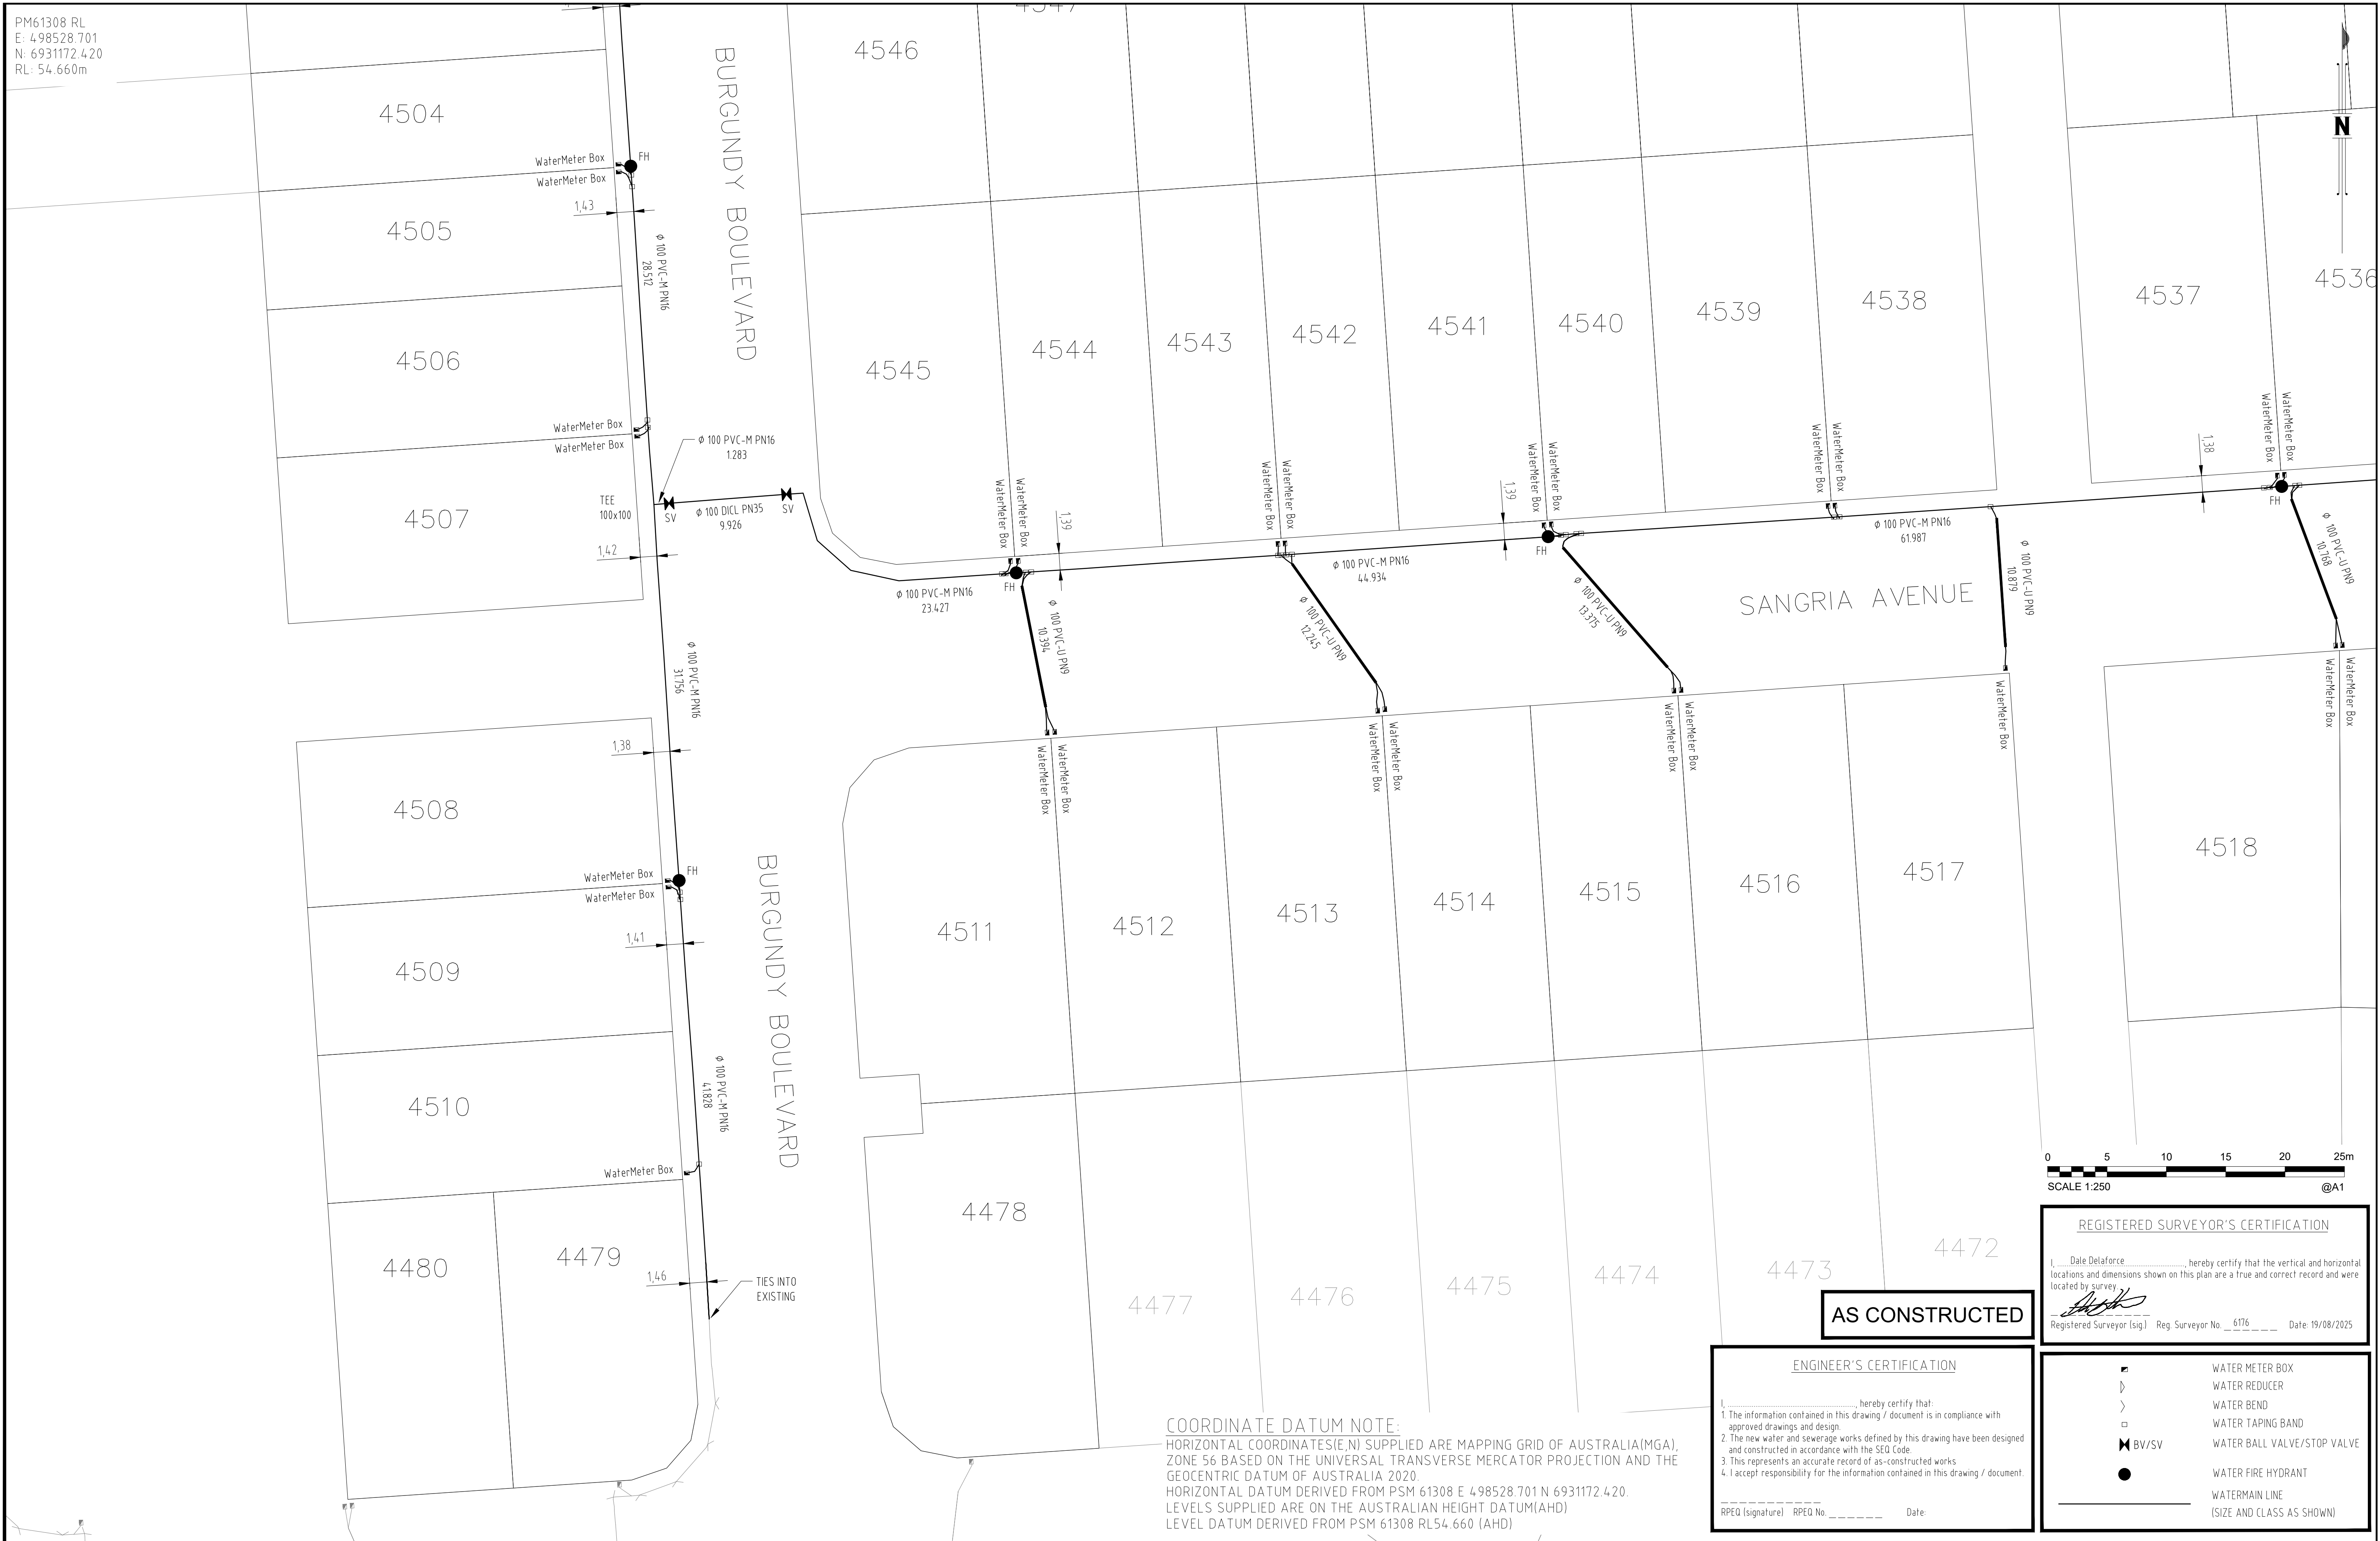

REGISTERED SURVEYOR'S CERTIFICATION

I, Date DeLaforce, hereby certify that the vertical and horizontal locations and dimensions shown on this plan are a true and correct record and were located by survey.

[Signature]
Registered Surveyor (sig.) Reg. Surveyor No. 6176 Date: 19/08/2025

AS CONSTRUCTED

ENGINEER'S CERTIFICATION

I, _____, hereby certify that:

1. The information contained in this drawing / document is in compliance with approved drawings and design.

2. The new water and sewerage works defined by this drawing have been designed and constructed in accordance with the SEQ Code.

3. This represents an accurate record of as-constructed works.

4. I accept responsibility for the information contained in this drawing / document.

RPEQ (signature) RPEQ No. _____ Date: _____

- WATER METER BOX
- ▷ WATER REDUCER
- > WATER BEND
- WATER TAPING BAND
- ✕ BV/SV WATER BALL VALVE/STOP VALVE
- WATER FIRE HYDRANT
- WATERMAIN LINE (SIZE AND CLASS AS SHOWN)

COORDINATE DATUM NOTE:
HORIZONTAL COORDINATES(E,N) SUPPLIED ARE MAPPING GRID OF AUSTRALIA(MGA), ZONE 56 BASED ON THE UNIVERSAL TRANSVERSE MERCATOR PROJECTION AND THE GEOCENTRIC DATUM OF AUSTRALIA 2020.
HORIZONTAL DATUM DERIVED FROM PSM 61308 E 498528.701 N 6931172.420.
LEVELS SUPPLIED ARE ON THE AUSTRALIAN HEIGHT DATUM(AHD)
LEVEL DATUM DERIVED FROM PSM 61308 RL54.660 (AHD)

A1

INDEX	DATE	AS CONSTRUCTED	REVISIONS	DRAWN	CHECKED	PASSED

DRAWN	RDE	19/08/2025
CHECKED	DAM	19/08/2025
PASSED		
INITIALS	DATE	

99 Sandalwood Lane, Forest Glen QLD 4056
Ph: 07 5438 3300 > F: 07 5438 3308 > E: info@shadforth.com.au

LOGAN CITY COUNCIL

MIRVAC MIR-0801
AS CONSTRUCTED SURVEY - WATERMAIN
EVERLEIGH PRECINCT 8.1C
GREENBANK QLD

SHEET 4 OF 4 SHEETS	SCALE 1:250 A1
REVISION DATE 19/08/2025	REVISION —
DISCIPLINE CODE —	
DRAWING NO. ASC-WATERMAIN-04-8.1C	