

PSM 61308
E: 498528.701
N: 6931172.420
RL: 54.660m

REFER TO PLAN RDS & EWKS-02-8.1C

REFER TO PLAN RDS & EWKS-03-8.1C

N

REFER TO PLAN RDS & EWKS-04-8.1C

REFER TO PLAN RDS & EWKS-05-8.10

ENGINEER'S CERTIFICATION

I, _____, hereby certify that:

1. The information contained in this drawing / document is in compliance with approved drawings and design.
2. This represents an accurate record of as-constructed works
3. I accept responsibility for the information contained in this drawing / document

RPEQ (signature) RPEQ No. _____ Date _____

HORIZONTAL COORDINATES(E,N) SUPPLIED ARE MAPPING GRID OF AUSTRALIA(MGA), ZONE 56 BASED ON THE UNIVERSAL TRANSVERSE MERCATOR PROJECTION AND THE GEOCENTRIC DATUM OF AUSTRALIA 2020.
HORIZONTAL DATUM DERIVED FROM PSM 61308 E 4.98528.701 N 6931172.420.
LEVELS SUPPLIED ARE ON THE AUSTRALIAN HEIGHT DATUM(AHD).
LEVEL DATUM DERIVED FROM PSM 61308 RL54.660 (AHD).

PAVEMENT DESIGN

<u>MAGENTA STREET</u>	<u>SANGRIA AVENUE</u>
AC(mm) - 35	AC(mm) - 35
BASE(2.1)(mm) - 150	BASE(2.1)(mm) - 150
SUBBASE(2.3)(mm) - 150	SUBBASE(2.3)(mm) - 150

BURGUNDY BOULEVARD
AC(mm) - 35
BASE(2.1)(mm) - 150
SUBBASE(2.3)(mm) - 150

SPOT HEIGHTS	WALL HEIGHTS
+ 56.36	56.600
	55.524

RETAINING WALLS

AS CONSTRUCTED



REGISTERED SURVEYOR'S CERTIFICATION

I, Date Delaforce, hereby certify that the vertical and horizontal locations and dimensions shown on this plan are a true and correct record and were located by survey.


Registered Surveyor (sig.) Reg. Surveyor No. 6176 Date: 04/09/2025

A1

DRAWN	ALS	04/09/2025
CHECKED	DAM	04/09/2025
PASSED	JH	04/09/2025
	INITIALS	DATE



LOGAN CITY COUNCIL

MIRVAC MIR-0801
AS CONSTRUCTED SURVEY - ROADS AND EARTHWORKS
EVERLEIGH PRECINCT 8.1C
GREENBANK QLD

SHEET 1 OF 5 SHEETS	SCALE 1:500 A1
---------------------	----------------

REVISION DATE	04/09/202
---------------	-----------

DISCIPLINE CODE	
-----------------	--

DRAWING NO.

ASC-RDS AND EWKS-01-8.1C

SCALE 1:500 A1

REVISION	A
----------	---

PSM 61308
E: 498528.701
N: 6931172.420
RL: 54.660m



AS CONSTRUCTED



ENGINEER'S CERTIFICATION

- I, _____, hereby certify that:
- The information contained in this drawing / document is in compliance with approved drawings and design.
 - This represents an accurate record of as-constructed works
 - I accept responsibility for the information contained in this drawing / document.

RPEQ (signature) RPEQ No. _____ Date: _____

PAVEMENT DESIGN

MAGENTA STREET	SANGRIA AVENUE
AC(mm) - 35	AC(mm) - 35
BASE(2.1l(mm) - 150	BASE(2.1l(mm) - 150
SUBBASE(2.3l(mm) - 150	SUBBASE(2.3l(mm) - 150
BURGUNDY BOULEVARD	
AC(mm) - 35	
BASE(2.1l(mm) - 150	
SUBBASE(2.3l(mm) - 150	

SPOT HEIGHTS	WALL HEIGHTS
+ 56.36	56.600
	55.524

RETAINING WALLS

REGISTERED SURVEYOR'S CERTIFICATION

I, Dale Delaforce, hereby certify that the vertical and horizontal locations and dimensions shown on this plan are a true and correct record and were located by survey.

Registered Surveyor (sig) Reg. Surveyor No. 6176 Date: 04/09/2025

COORDINATE DATUM NOTE:

HORIZONTAL COORDINATES (E, N) SUPPLIED ARE MAPPING GRID OF AUSTRALIA (MGA), ZONE 56 BASED ON THE UNIVERSAL TRANSVERSE MERCATOR PROJECTION AND THE GEOCENTRIC DATUM OF AUSTRALIA 2020.
HORIZONTAL DATUM DERIVED FROM PSM 61308 E 498528.701 N 6931172.420
LEVELS SUPPLIED ARE ON THE AUSTRALIAN HEIGHT DATUM (AHD) LEVEL DATUM DERIVED FROM PSM 61308 RL 54.660 (AHD)

A1

INDEX	DATE	AS CONSTRUCTED	REVISIONS	DRAWN	CHECKED	PASSED
A	04/09/2025	AS CONSTRUCTED		ALS	DAM	JH

DRAWN	ALS	04/09/2025
CHECKED	DAM	04/09/2025
PASSED	JH	04/09/2025
INITIALS		DATE




LOGAN CITY COUNCIL


MIRVAC MIR-0801
AS CONSTRUCTED SURVEY - ROADS AND EARTHWORKS
EVERLEIGH PRECINCT 8.1C
GREENBANK QLD

SHEET 2 OF 5 SHEETS	SCALE 1:250 A1
REVISION DATE 04/09/2025	REVISION A
DISCIPLINE CODE -	
DRAWING NO.	
ASC-RDS AND EWKS-02-8.1C	

PSM 61308
E: 498528.701
N: 6931172.420
RL: 54.660m

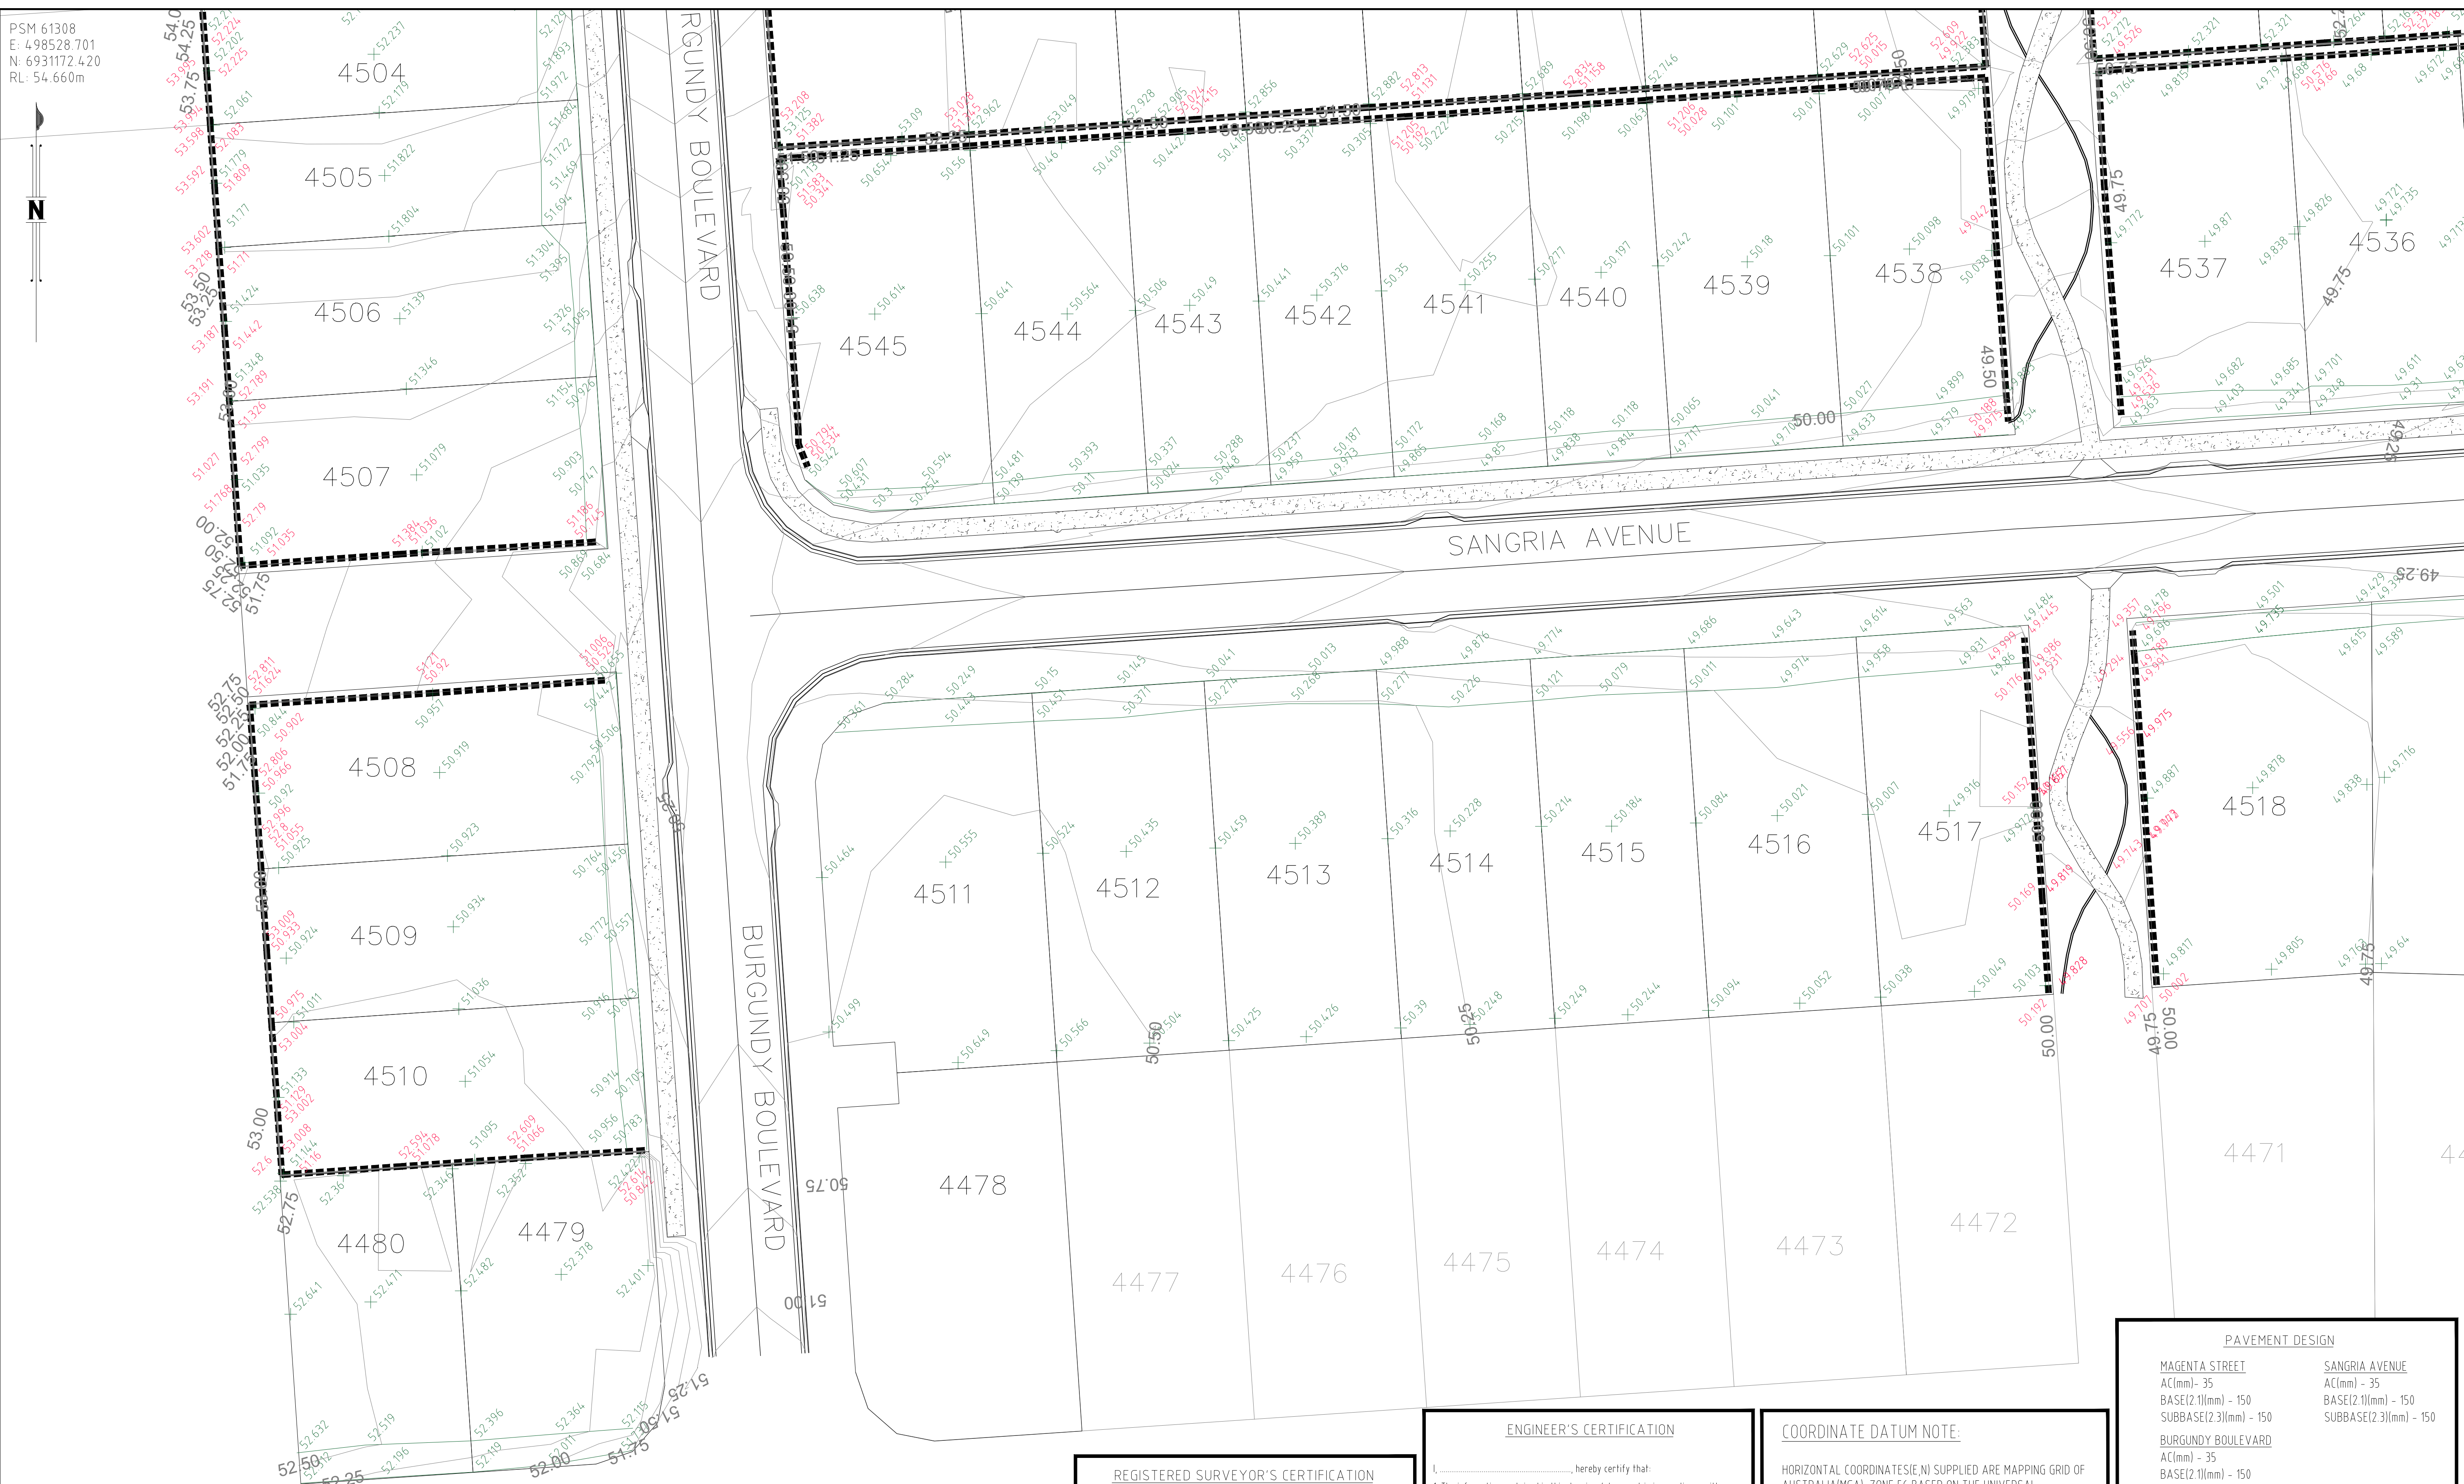

AS CONSTRUCTED

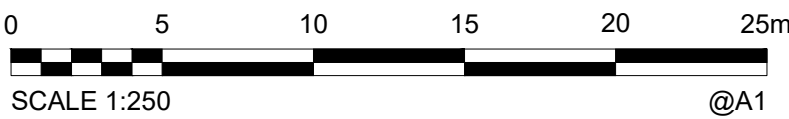

REGISTERED SURVEYOR'S CERTIFICATION

I, Dale Delaforte, hereby certify that the vertical and horizontal locations and dimensions shown on this plan are a true and correct record and were located by survey.

Registered Surveyor (sig) Reg. Surveyor No. 6176 Date: 04/09/2025

ENGINEER'S CERTIFICATION

- I, _____, hereby certify that:
- The information contained in this drawing / document is in compliance with approved drawings and design.
 - This represents an accurate record of as-constructed works
 - I accept responsibility for the information contained in this drawing / document.

RPEQ (Signature) RPEQ No. _____ Date: _____

COORDINATE DATUM NOTE:

HORIZONTAL COORDINATES (E, N) SUPPLIED ARE MAPPING GRID OF AUSTRALIA (MGA), ZONE 56 BASED ON THE UNIVERSAL TRANSVERSE MERCATOR PROJECTION AND THE GEOCENTRIC DATUM OF AUSTRALIA 2020.
HORIZONTAL DATUM DERIVED FROM PSM 61308 E 498528.701 N 6931172.420.
LEVELS SUPPLIED ARE ON THE AUSTRALIAN HEIGHT DATUM (AHD).
LEVEL DATUM DERIVED FROM PSM 61308 RL54.660 (AHD)

PAVEMENT DESIGN

MAGENTA STREET	SANGRIA AVENUE
AC(mm) - 35	AC(mm) - 35
BASE(2.1)(mm) - 150	BASE(2.1)(mm) - 150
SUBBASE(2.3)(mm) - 150	SUBBASE(2.3)(mm) - 150

BURGUNDY BOULEVARD
AC(mm) - 35
BASE(2.1)(mm) - 150
SUBBASE(2.3)(mm) - 150

SPOT HEIGHTS	WALL HEIGHTS
+ 56.36	56.600 55.524

RETAINING WALLS

A1


INDEX	DATE	AS CONSTRUCTED	REVISIONS	DRAWN	CHECKED	PASSED	INITIALS	DATE
A	04/09/2025	AS CONSTRUCTED		ALS	DAM	JH		



LOGAN CITY COUNCIL

MIRVAC MIR-0801
AS CONSTRUCTED SURVEY - ROADS AND EARTHWORKS
EVERLEIGH PRECINCT 8.1C
GREENBANK QLD

SHEET 4 OF 5	SHEETS	SCALE 1:250 A1
REVISION DATE	04/09/2025	REVISION A
DISCIPLINE CODE	—	
DRAWING NO.	ASC-RDS AND EWKS-04-8.1C	

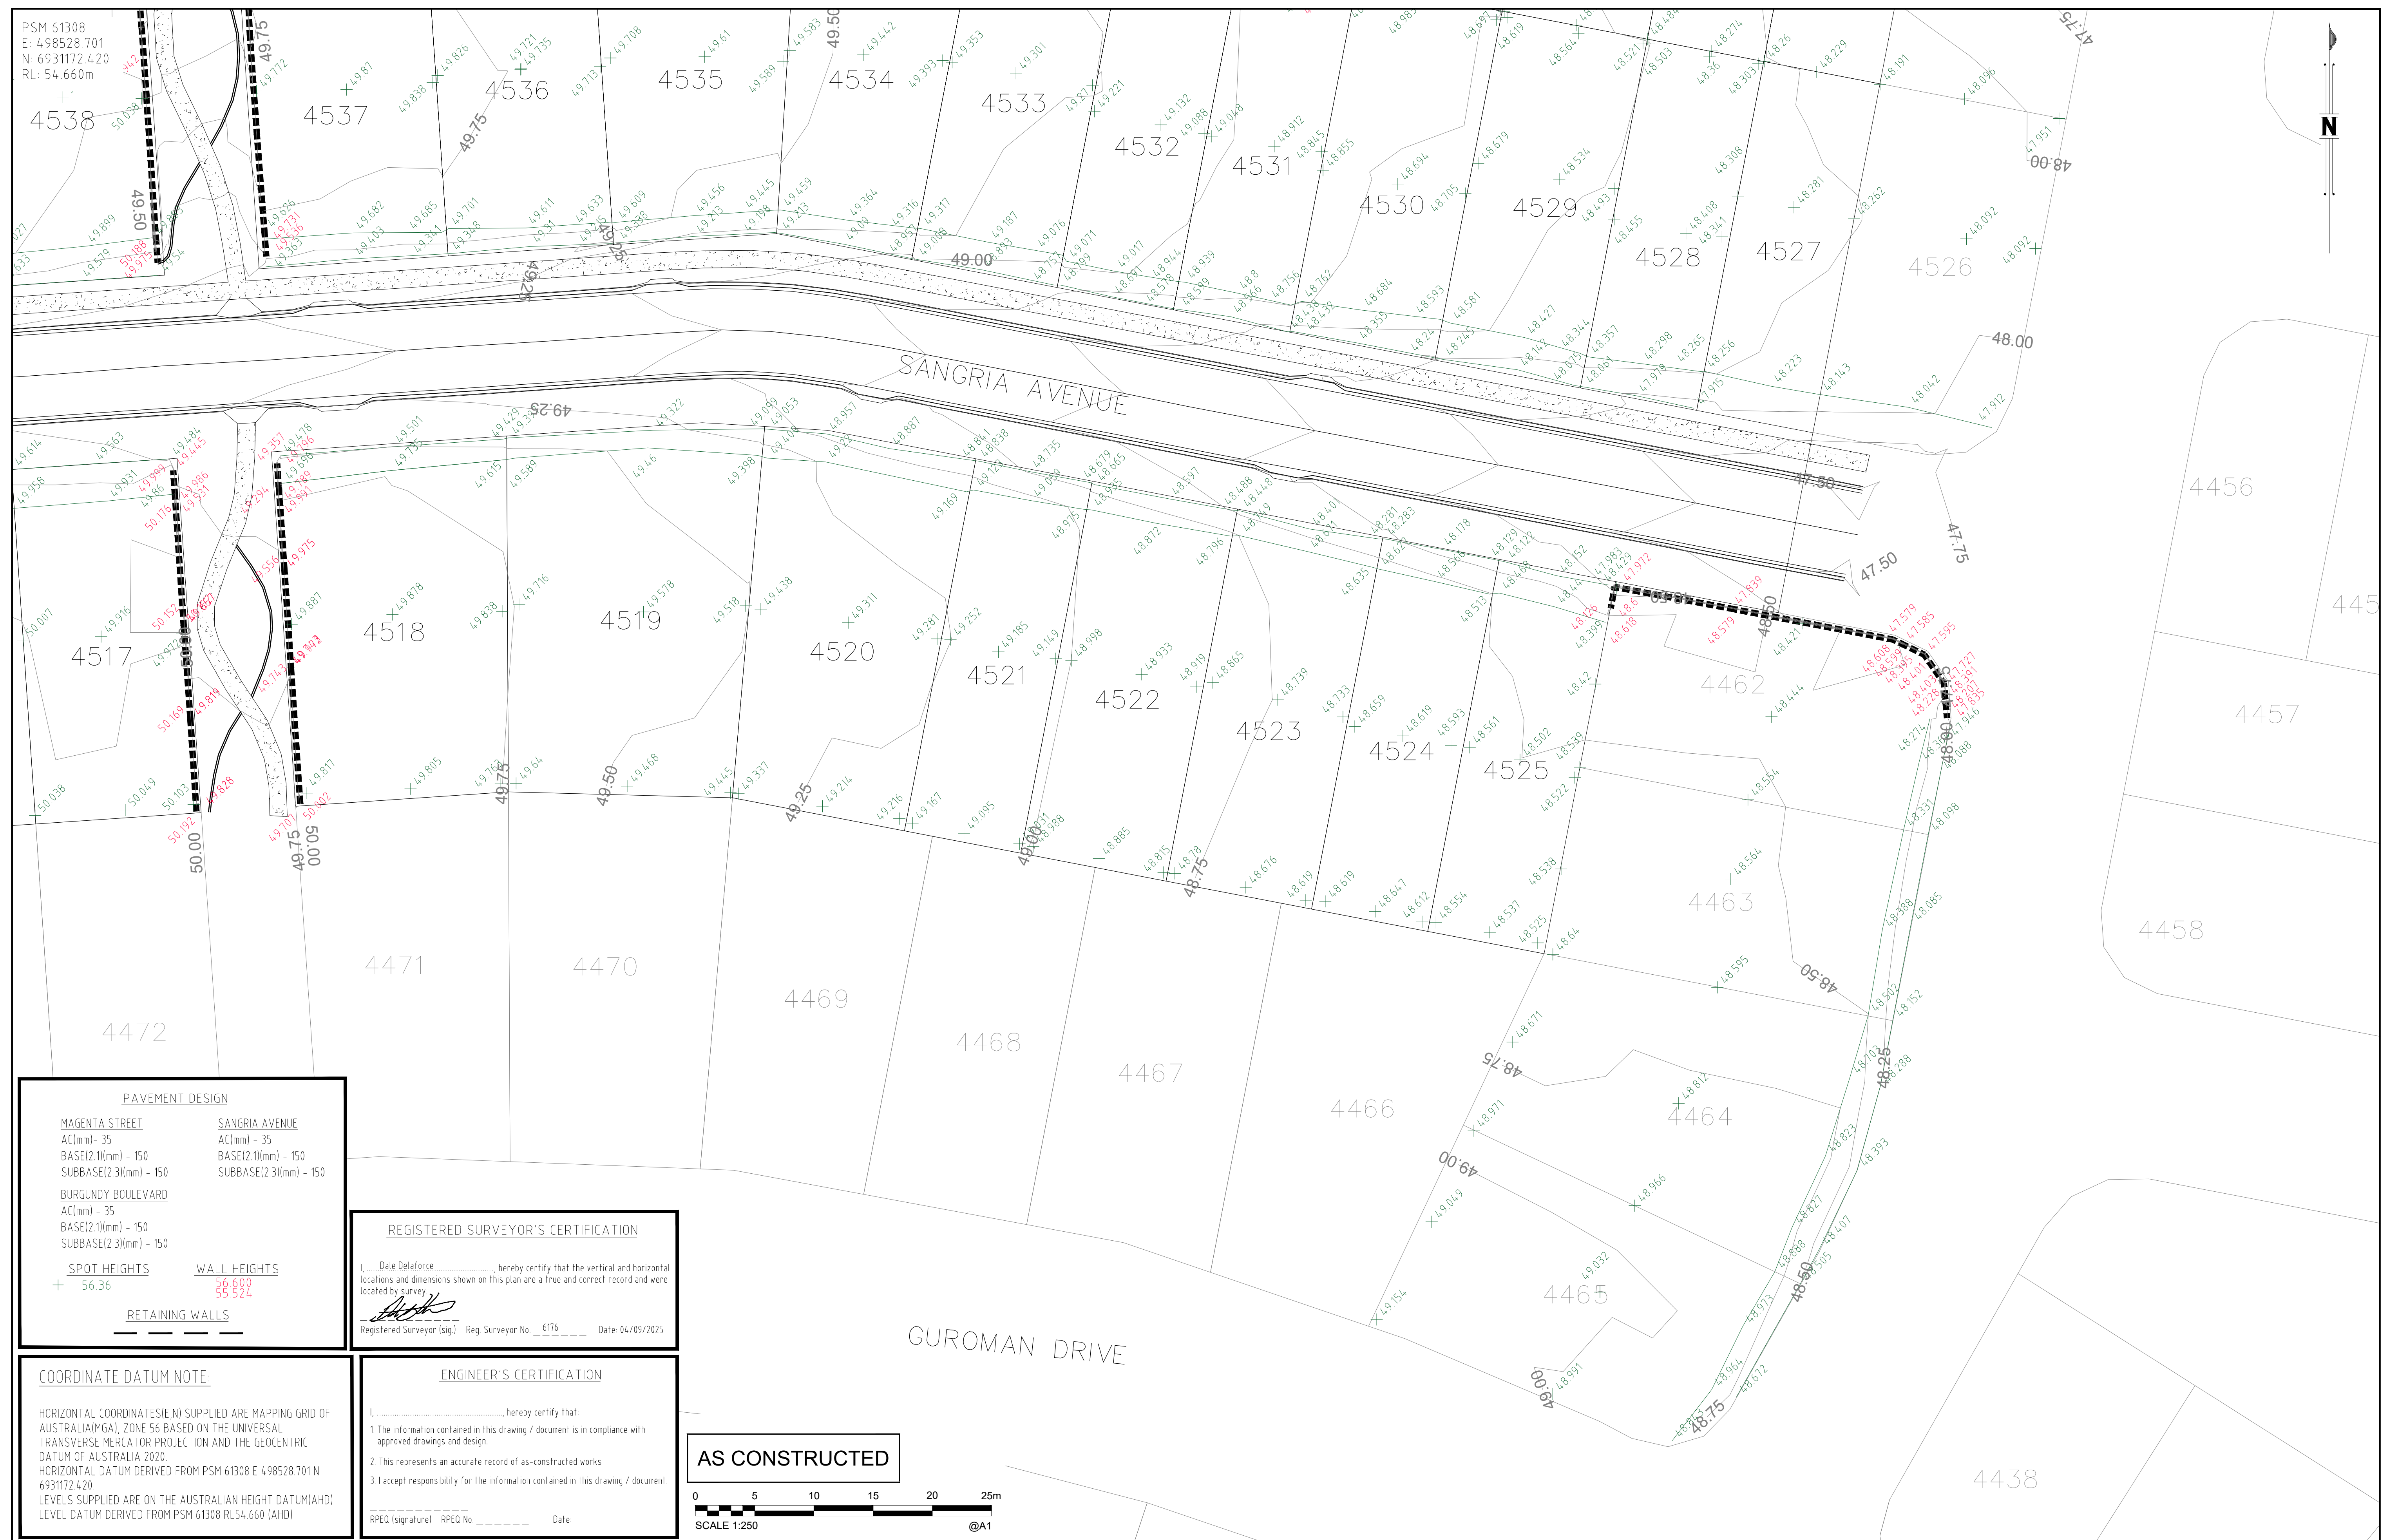[illegible]