

PSM 61308
E: 498528.701
N: 6931172.420
RL: 54.660m

REFER TO PLAN ASC-STORMWATER-02-8.1C

REFER TO PLAN ASC-STORMWATER-04-8.1C

REFER TO PLAN ASC-STORMWATER-03-8.1C

AS CONSTRUCTED

COORDINATE DATUM NOTE:

HORIZONTAL COORDINATES(E,N) SUPPLIED ARE MAPPING GRID OF AUSTRALIA(MGA),
ZONE 56 BASED ON THE UNIVERSAL TRANSVERSE MERCATOR PROJECTION AND THE
GEOCENTRIC DATUM OF AUSTRALIA 2020.

HORIZONTAL DATUM DERIVED FROM PSM 61308 E 498528.701 N 6931172.420.

LEVELS SUPPLIED ARE ON THE AUSTRALIAN HEIGHT DATUM(AHD)

LEVEL DATUM DERIVED FROM PSM 61308 RL54.660 (AHD)

REGISTERED SURVEYOR'S CERTIFICATION

I, Dale Delaforce, hereby certify that the vertical and horizontal locations and dimensions shown on this plan are a true and correct record and were located by survey.

Registered Surveyor (sig.) Reg. Surveyor No. 6176 Date: 17/09/2025

ENGINEER'S CERTIFICATION

I, _____, hereby certify that:

1. The information contained in this drawing / document is in compliance with approved drawings and design.
2. The new water and sewerage works defined by this drawing have been designed and constructed in accordance with the SEQ Code.
3. This represents an accurate record of as-constructed works
4. I accept responsibility for the information contained in this drawing / document.

RPEQ (signature) RPEQ No. _____ Date: _____

0 10 20 30 40 50m

SCALE 1:500 @A1

A1

DRAWN	RDE	17/09/2025
CHECKED	DAM	17/09/2025
PASSED		
	INITIALS	DATE



LOGAN CITY COUNCIL

MIRVAC MIR-801
AS CONSTRUCTED SURVEY - STORMWATER
EVERLEIGH PRECINCT 8.1C
GREENBANK QLD

SHEET 1 OF 4 SHEETS		SCALE 1:500 A1	
REVISION DATE	-	REVISION	-
DISCIPLINE CODE	-		
DRAWING NO.			
ASC-STORMWATER-01-8.1C			

PSM 61308
E: 498528.701
N: 6931172.420
RL: 54.660m



REGISTERED SURVEYOR'S CERTIFICATION

I, Dale Delaforce, hereby certify that the vertical and horizontal locations and dimensions shown on this plan are a true and correct record and were located by survey.

Registered Surveyor (sig.) Reg. Surveyor No. 6176 Date: 17/09/2025

AS CONSTRUCTED

ENGINEER'S CERTIFICATION


I, _____, hereby certify that:

1. The information contained in this drawing / document is in compliance with approved drawings and design.
2. The new water and sewerage works defined by this drawing have been designed and constructed in accordance with the SEQ Code.
3. This represents an accurate record of as-constructed works
4. I accept responsibility for the information contained in this drawing / document.

RPEQ (signature) RPEQ No. Date:

	STORMWATER MANHOLE
	KERB INLET
	KERB INLET (SAG)
	STORMWATER PIPE CLASS AS SHOWN

N

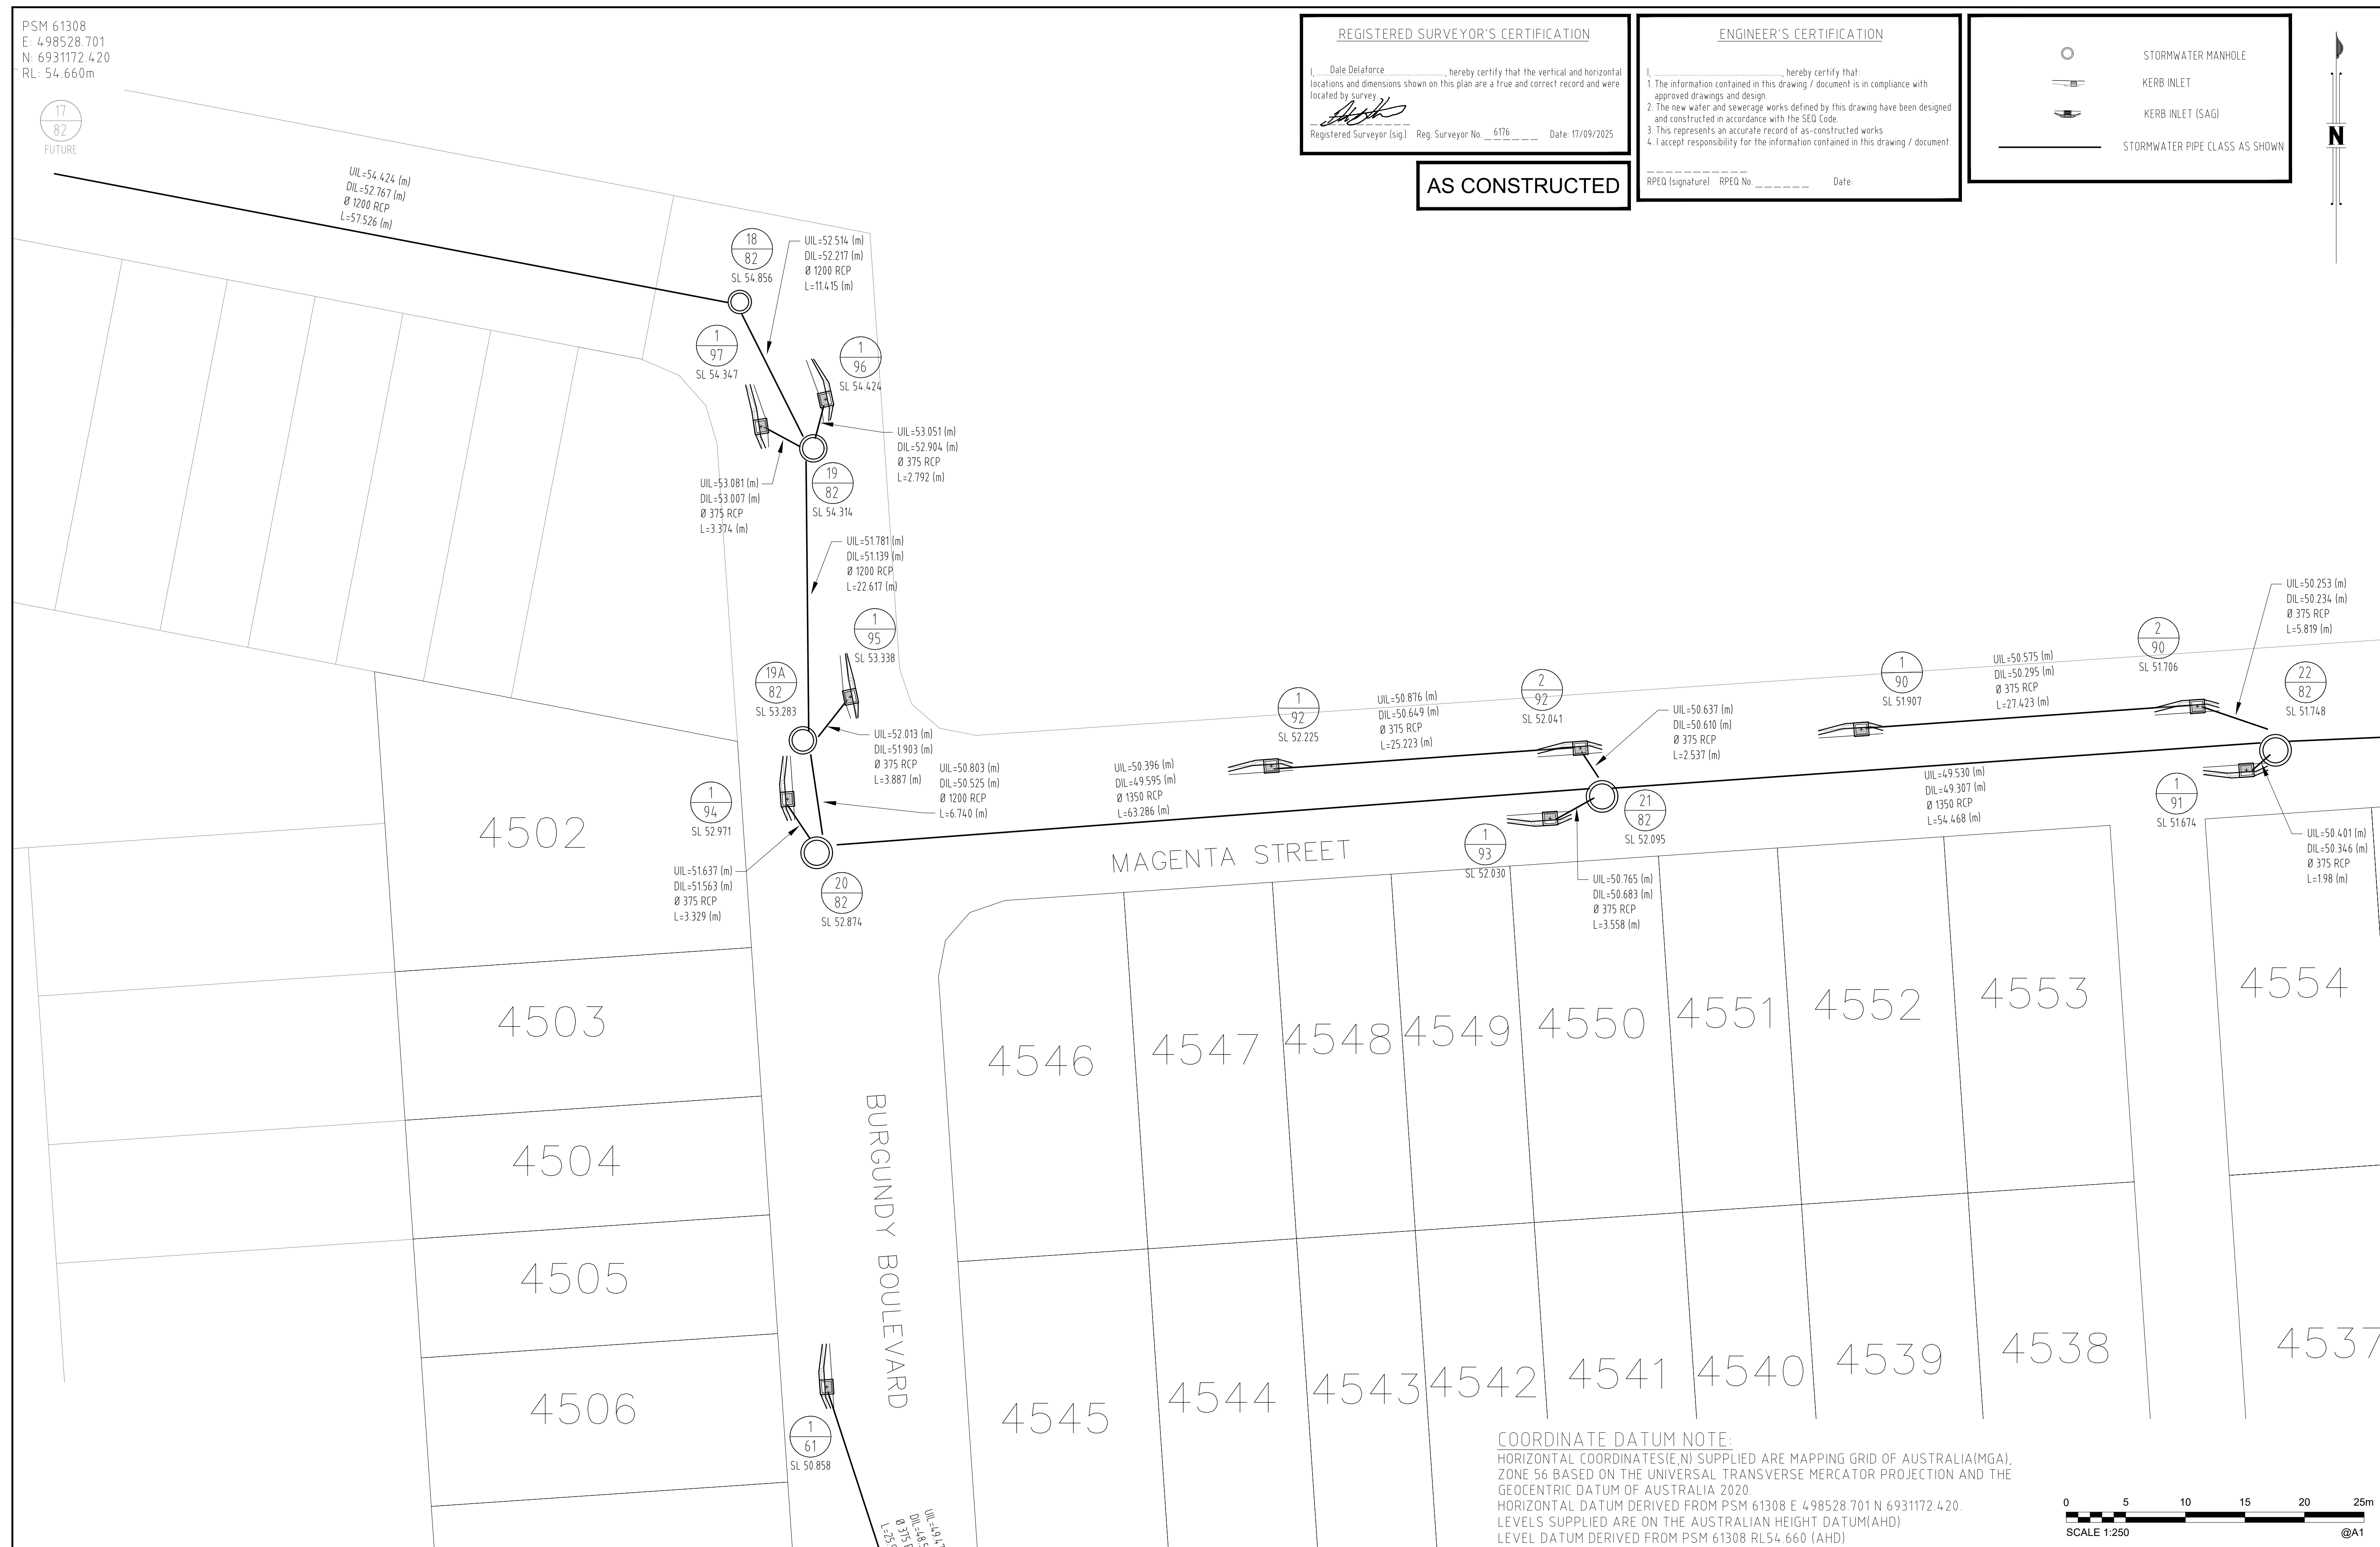

COORDINATE DATUM NOTE:
HORIZONTAL COORDINATES(E,N) SUPPLIED ARE MAPPING GRID OF AUSTRALIA(MGA),
ZONE 56 BASED ON THE UNIVERSAL TRANSVERSE MERCATOR PROJECTION AND THE
GEOCENTRIC DATUM OF AUSTRALIA 2020.
HORIZONTAL DATUM DERIVED FROM PSM 61308 E 4 98528 701 N 6931172 420.
LEVELS SUPPLIED ARE ON THE AUSTRALIAN HEIGHT DATUM(AHD)
LEVEL DATUM DERIVED FROM PSM 61308 RL564.660 (AHD)

ASC-STORMWATER-02-8.1C

A1

DRAWN	RDE	17/09/2025
CHECKED	DAM	17/09/2025
PASSED		
	INITIALS	DATE



LOGAN CITY COUNCIL


MIRVAC MIR-801
AS CONSTRUCTED SURVEY - STORMWATER
EVERLEIGH PRECINCT 8.1C
GREENBANK QLD

SHEET 2 OF 4	SHEETS	SCALE	1:250 A1
REVISION DATE	-	REVISION	-
DISCIPLINE CODE	-		

DRAWING NO.

ASC-STORMWATER-02-8.1C

PSM 61308
E: 498528.701
N: 6931172.420
RL: 54.660m

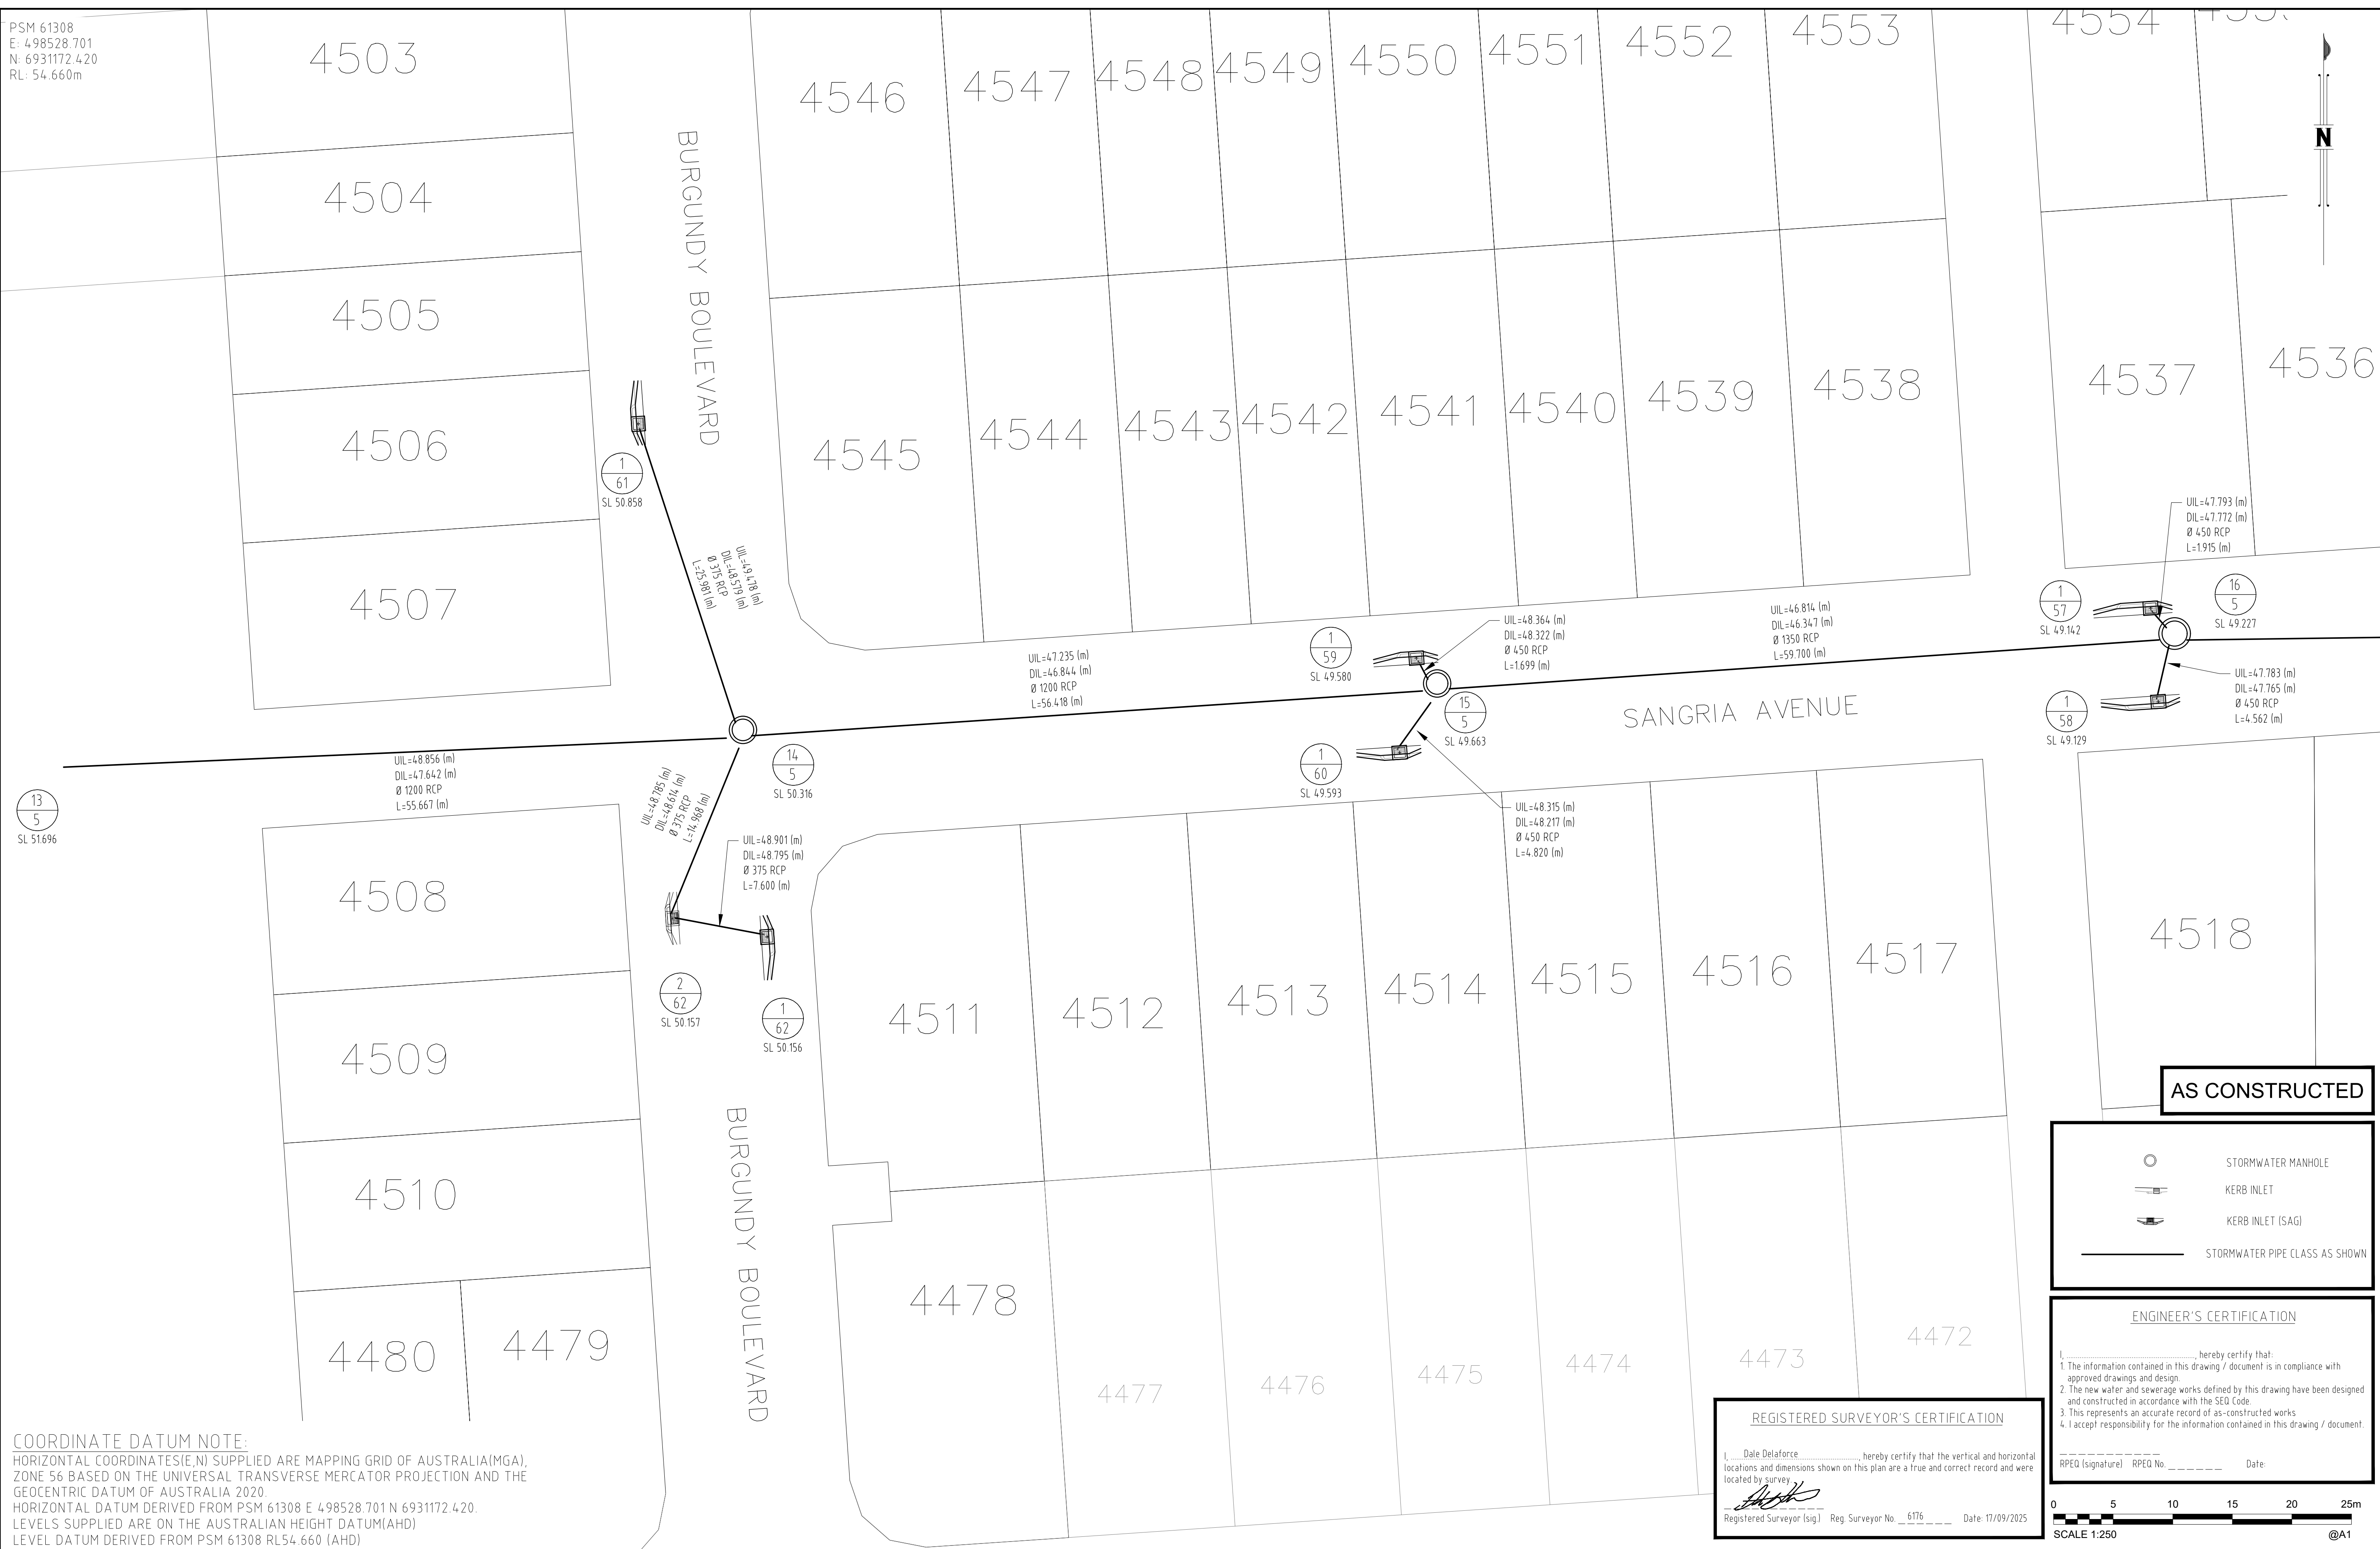

COORDINATE DATUM NOTE:
HORIZONTAL COORDINATES(E,N) SUPPLIED ARE MAPPING GRID OF AUSTRALIA(MGA),
ZONE 56 BASED ON THE UNIVERSAL TRANSVERSE MERCATOR PROJECTION AND THE
GEOCENTRIC DATUM OF AUSTRALIA 2020.
HORIZONTAL DATUM DERIVED FROM PSM 61308 E 4 98528 701 N 6931172 420.
LEVELS SUPPLIED ARE ON THE AUSTRALIAN HEIGHT DATUM(AHD)
LEVEL DATUM DERIVED FROM PSM 61308 RL54.660 (AHD)

REGISTERED SURVEYOR'S CERTIFICATION

I, Dale Delaforce, hereby certify that the vertical and horizontal locations and dimensions shown on this plan are a true and correct record and were located by survey.



Registered Surveyor (sig) Reg. Surveyor No. 6176 Date: 11/09/2025

AS CONSTRUCTED	
	STORMWATER MANHOLE
	KERB INLET
	KERB INLET (SAG)
	STORMWATER PIPE CLASS AS SHOWN

ENGINEER'S CERTIFICATION	
I, _____, hereby certify that: - The information contained in this drawing / document is in compliance with approved drawings and design. - The new water and sewerage works defined by this drawing have been designed and constructed in accordance with the SEQ Code. - This represents an accurate record of as-constructed works. - I accept responsibility for the information contained in this drawing / document.	
_____ RPEQ (signature) RPEQ No. _____	_____ Date:



SCALE 1:250
@A1

A1																																																																																																																																																																																																																																																																																																																																																																																																																																																																																																																																																																																																																																																																																																																																																																																																																																																																																																																																																																																																																																																																																																																																																																																																																																																																																																																																																																																																																																																											
----	--	--	


LOGAN CITY COUNCIL MIRVAC MIR-801 AS CONSTRUCTED SURVEY - STORMWATER EVERLEIGH PRECINCT 81C GREENBANK QLD	
--	--

SHEET 3 OF 4		SHEETS		SCALE 1:250 A1	
REVISION DATE	-	REVISION	-		
DISCIPLINE CODE	-				
DRAWING NO.					
ASC-STORMWATER-03-8.1C					

