


PM61308 RL
E: 498528.701
N: 6931172.420
RL: 54.660m

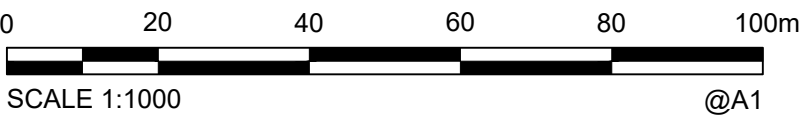

AS CONSTRUCTED

COORDINATE DATUM NOTE:
HORIZONTAL COORDINATES(E,N) SUPPLIED ARE MAPPING GRID OF AUSTRALIA(MGA),
ZONE 56 BASED ON THE UNIVERSAL TRANSVERSE MERCATOR PROJECTION AND THE
GEOCENTRIC DATUM OF AUSTRALIA 2020.
HORIZONTAL DATUM DERIVED FROM PSM 61308 E 498528.701 N 6931172.420.
LEVELS SUPPLIED ARE ON THE AUSTRALIAN HEIGHT DATUM(AHD)
LEVEL DATUM DERIVED FROM PSM 61308 RL54.660 (AHD)

ENGINEER'S CERTIFICATION

I, _____, hereby certify that:
1. The information contained in this drawing / document is in compliance with approved drawings and design.
2. The new water and sewerage works defined by this drawing have been designed and constructed in accordance with the SEQ Code.
3. This represents an accurate record of as-constructed works
4. I accept responsibility for the information contained in this drawing / document.

RPEQ (signature) RPEQ No. _____ Date: _____

- SEWER MANHOLE
- × SEWER FITTING
- └ SEWER DEC
- SEWER PIPE CLASS AS SHOWN

REGISTERED SURVEYOR'S CERTIFICATION

I, _____ Dale DeLaforce, hereby certify that the vertical and horizontal locations and dimensions shown on this plan are a true and correct record and were located by survey.

Registered Surveyor (sig.) Reg. Surveyor No. 6176 Date: 08/06/2026

A1

INDEX	DATE	REVISIONS	DRAWN	CHECKED	PASSED	INITIALS	DATE
	08/06/2026	AS CONSTRUCTED				JH	08/06/2026



LOGAN CITY COUNCIL

MIRVAC MIR-0804
AS CONSTRUCTED SURVEY - SEWER
EVERLEIGH PRECINCT 8.4C
GREENBANK QLD


SHEET 1 OF 5 SHEETS	SCALE 1:1000 A1
REVISION DATE 08/06/2026	REVISION —
DISCIPLINE CODE —	
DRAWING NO.	
ASC-SEWER-01-8.4C	

SHEET 2 OF 5	SHEETS	SCALE 1:250 A1
REVISION DATE		REVISION -
DISCIPLINE CODE	-	

DRAWING NO.

ASC-SEWER-02-8.4C

PM61308 RL
E: 498528.701
N: 6931172.420
RL: 54.660m

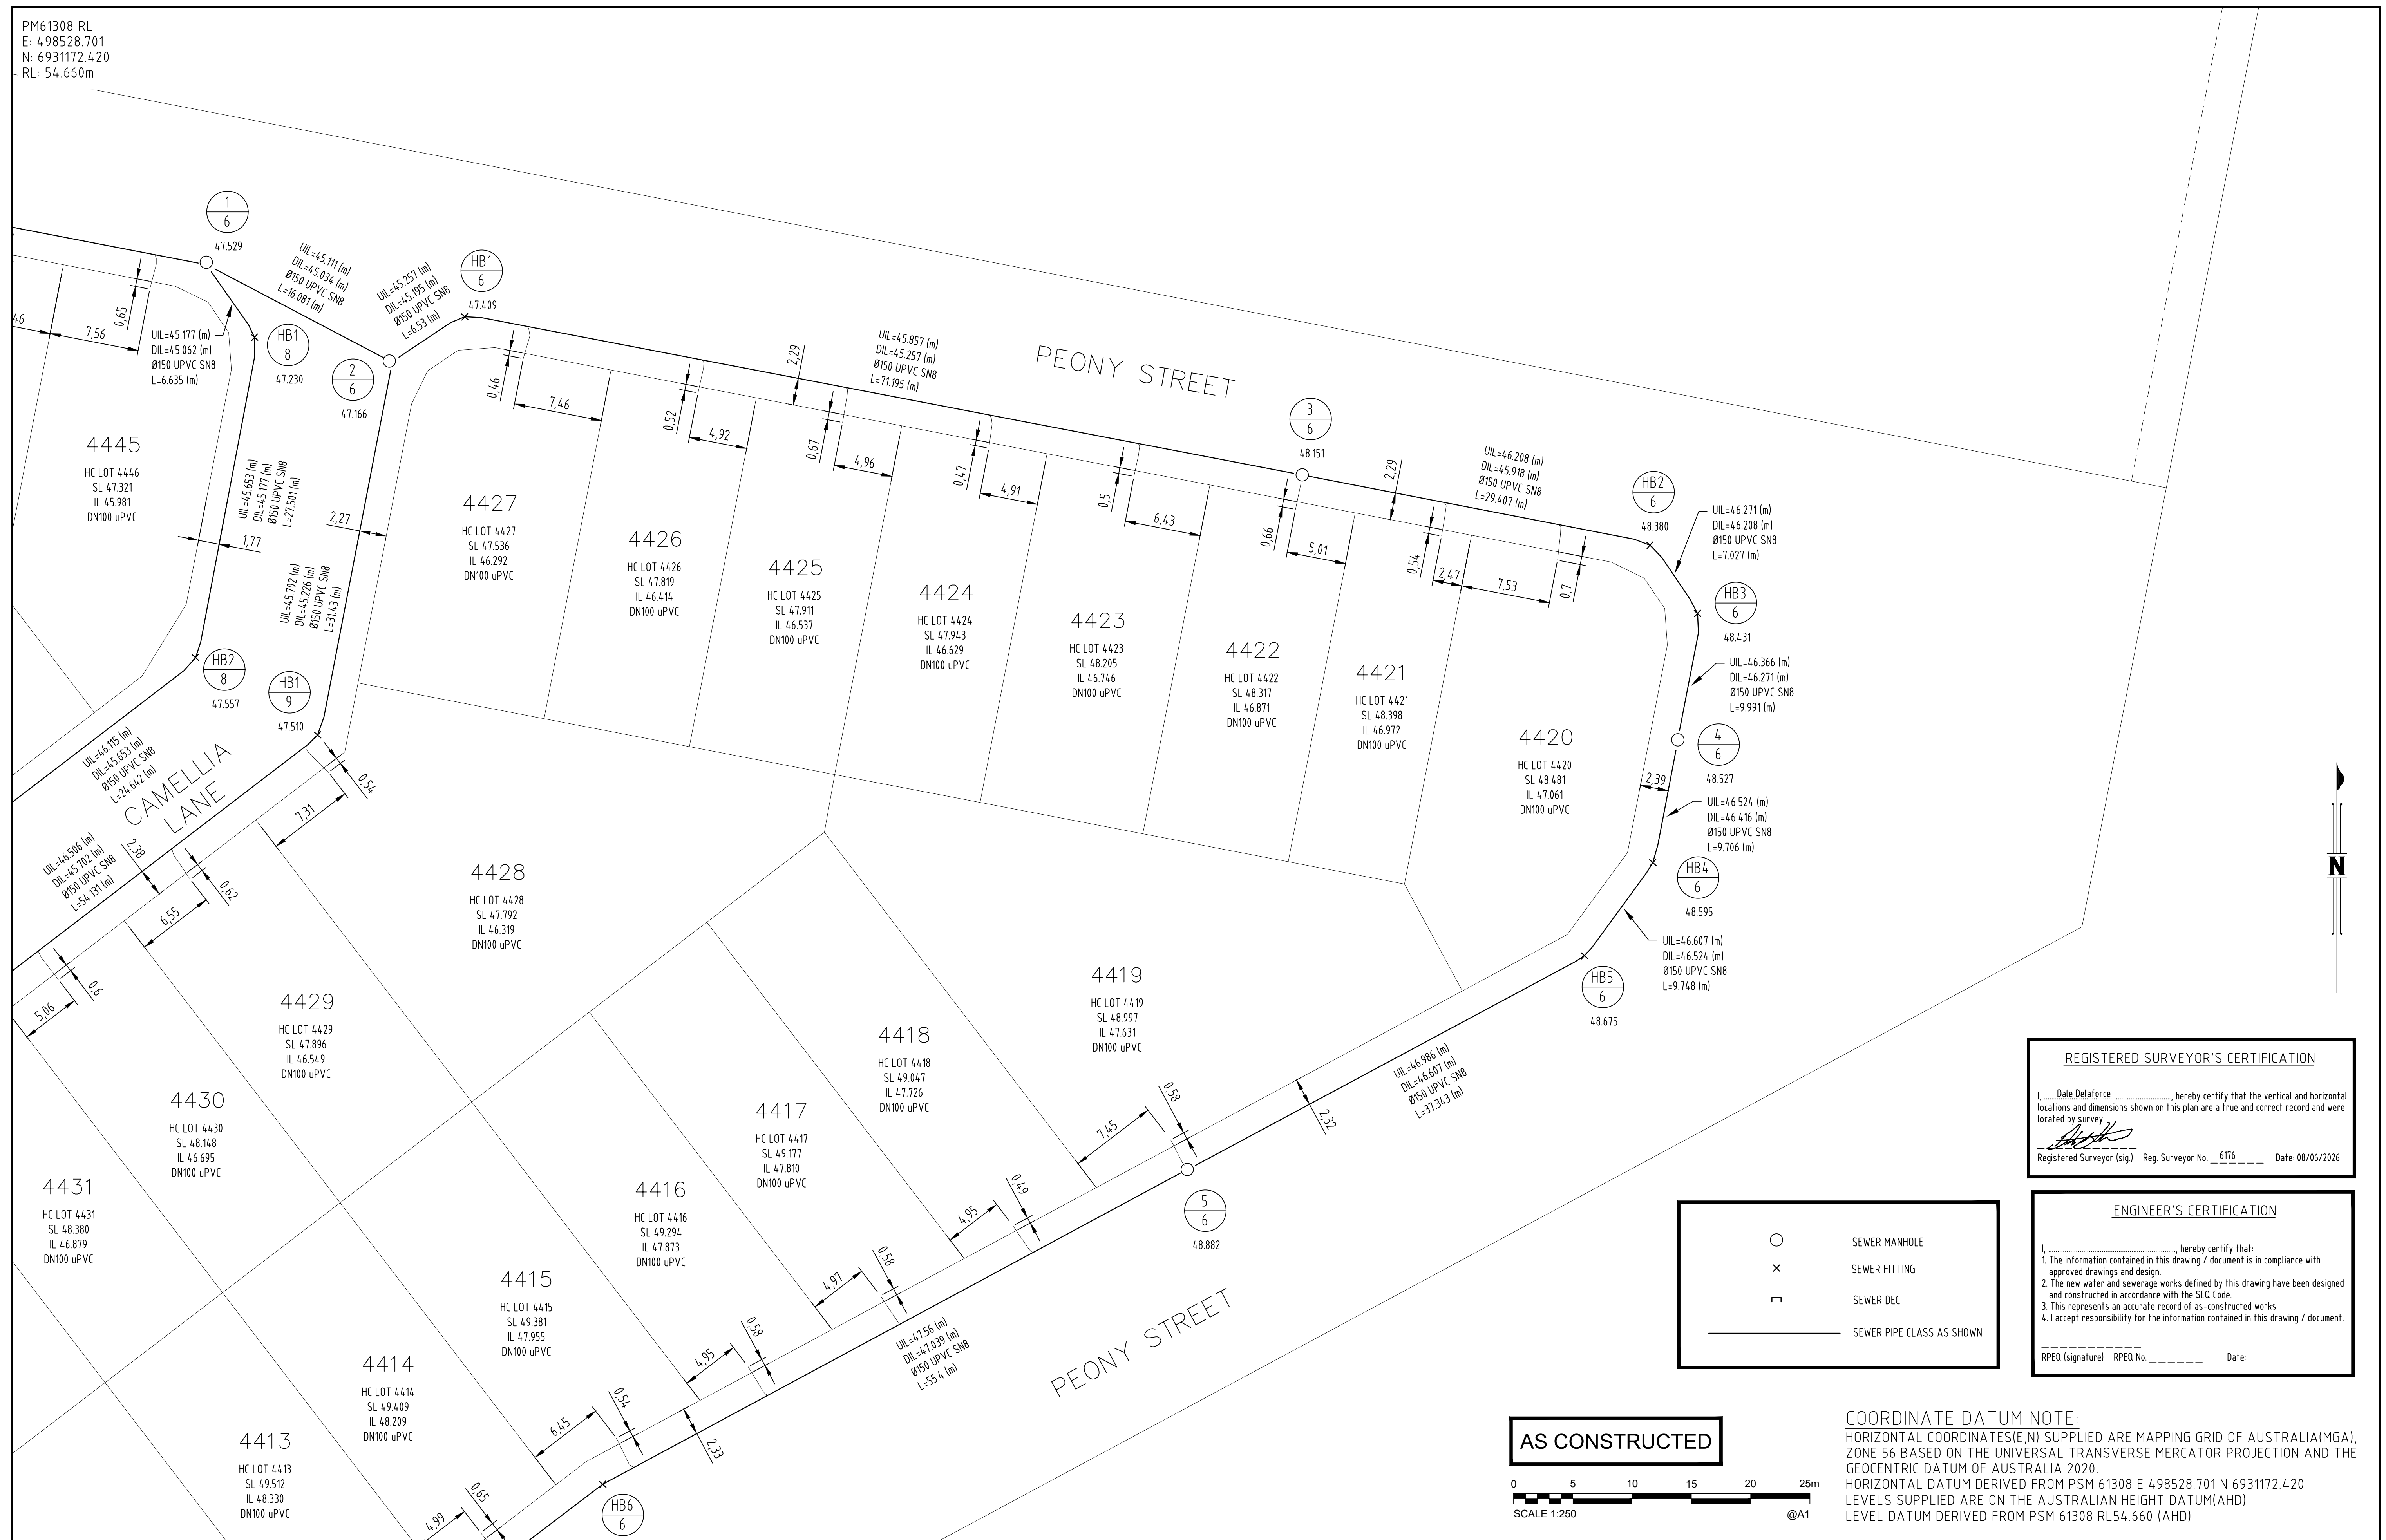

A1											
									DRAWN	ALS	08/06/2026
									CHECKED	DAM	08/06/2026
		08/06/2026	AS CONSTRUCTED					JH	PASSED	JH	08/06/2026
	INDEX	DATE				REVISIONS	DRAWN	CHECKED	PASSED		
										INITIALS	DATE



LOGAN CITY COUNCIL

MIRVAC MIR-0804
AS CONSTRUCTED SURVEY - SEWER
EVERLEIGH PRECINCT 8.4C
GREENBANK QLD

SHEET 3 OF 5		SHEETS		SCALE 1:250 A1	
REVISION DATE				REVISION -	
DISCIPLINE CODE		-			
DRAWING NO.					
ASC-SEWER-03-8.4C					

