

COORDINATE DATUM NOTE:
HORIZONTAL COORDINATES(E,N) SUPPLIED ARE MAPPING GRID OF AUSTRALIA(MGA),
ZONE 56 BASED ON THE UNIVERSAL TRANSVERSE MERCATOR PROJECTION AND THE
GEOCENTRIC DATUM OF AUSTRALIA 2020.
HORIZONTAL DATUM DERIVED FROM PSM 61308 E 4.98528.701 N 6931172.420.
LEVELS SUPPLIED ARE ON THE AUSTRALIAN HEIGHT DATUM(AHD)
LEVEL DATUM DERIVED FROM PSM 61308 RL54.660 (AHD)

	WATER METER BOX
	WATER REDUCER
	WATER BEND
	WATER TAPING BAND
	WATER BALL VALVE/STOP VALVE
	WATER FIRE HYDRANT
	WATERMAIN LINE (SIZE AND CLASS AS SHOWN)

I, _____, hereby certify that:

1. The information contained in this drawing / document is in compliance with approved drawings and design.
2. The new water and sewerage works defined by this drawing have been designed and constructed in accordance with the SEQ Code.
3. This represents an accurate record of as-constructed works
4. I accept responsibility for the information contained in this drawing / document.

RPEQ (signature) RPEQ No. _____ Date: _____

										DRAWN	ALS	08/06/2026
										CHECKED	DAM	08/06/2026
	08/06/2026	AS CONSTRUCTED				JH	PASSED			PASSED	JH	08/06/2026
INDEX	DATE	REVISIONS			DRAWN	CHECKED	PASSED				INITIALS	DATE



MIRVAC MIR-0804
AS CONSTRUCTED SURVEY - WATERMAIN
EVERLEIGH PRECINCT 8.4C
GREENBANK QLD

SHEET 1 OF 5 SHEETS	SCALE 1:1000 A1
---------------------	-----------------

REVISION DATE	08/06/2026
---------------	------------

DISCIPLINE CODE

DRAWING NO.

ASC-WATERMAIN-01-8.4C

SCALE 1:1000 A1

REVISION	—
----------	---

PM61308 RL
E: 498528.701
N: 6931172.420
RL: 54.660m

REGISTERED SURVEYOR'S CERTIFICATION

I, Dale Delaforce, hereby certify that the vertical and horizontal locations and dimensions shown on this plan are a true and correct record and were located by survey.

Registered Surveyor (sig) Reg. Surveyor No. 6176 Date: 08/06/2026

AS CONSTRUCTED

ENGINEER'S CERTIFICATION


I, hereby certify that:
1. The information contained in this drawing / document is in compliance with approved drawings and design.
2. The new water and sewerage works defined by this drawing have been designed and constructed in accordance with the SEQ Code.
3. This represents an accurate record of as-constructed works
4. I accept responsibility for the information contained in this drawing / document.

RPEQ (signature) RPEQ No. Date:

0 5 10 15 20 25m
SCALE 1:250 @A1

COORDINATE DATUM NOTE:

HORIZONTAL COORDINATES(E,N) SUPPLIED ARE MAPPING GRID OF AUSTRALIA(MGA), ZONE 56 BASED ON THE UNIVERSAL TRANSVERSE MERCATOR PROJECTION AND THE GEOCENTRIC DATUM OF AUSTRALIA 2020.
HORIZONTAL DATUM DERIVED FROM PSM 61308 E 498528.701 N 6931172.420.
LEVELS SUPPLIED ARE ON THE AUSTRALIAN HEIGHT DATUM(AHD)
LEVEL DATUM DERIVED FROM PSM 61308 RL54.660 (AHD)

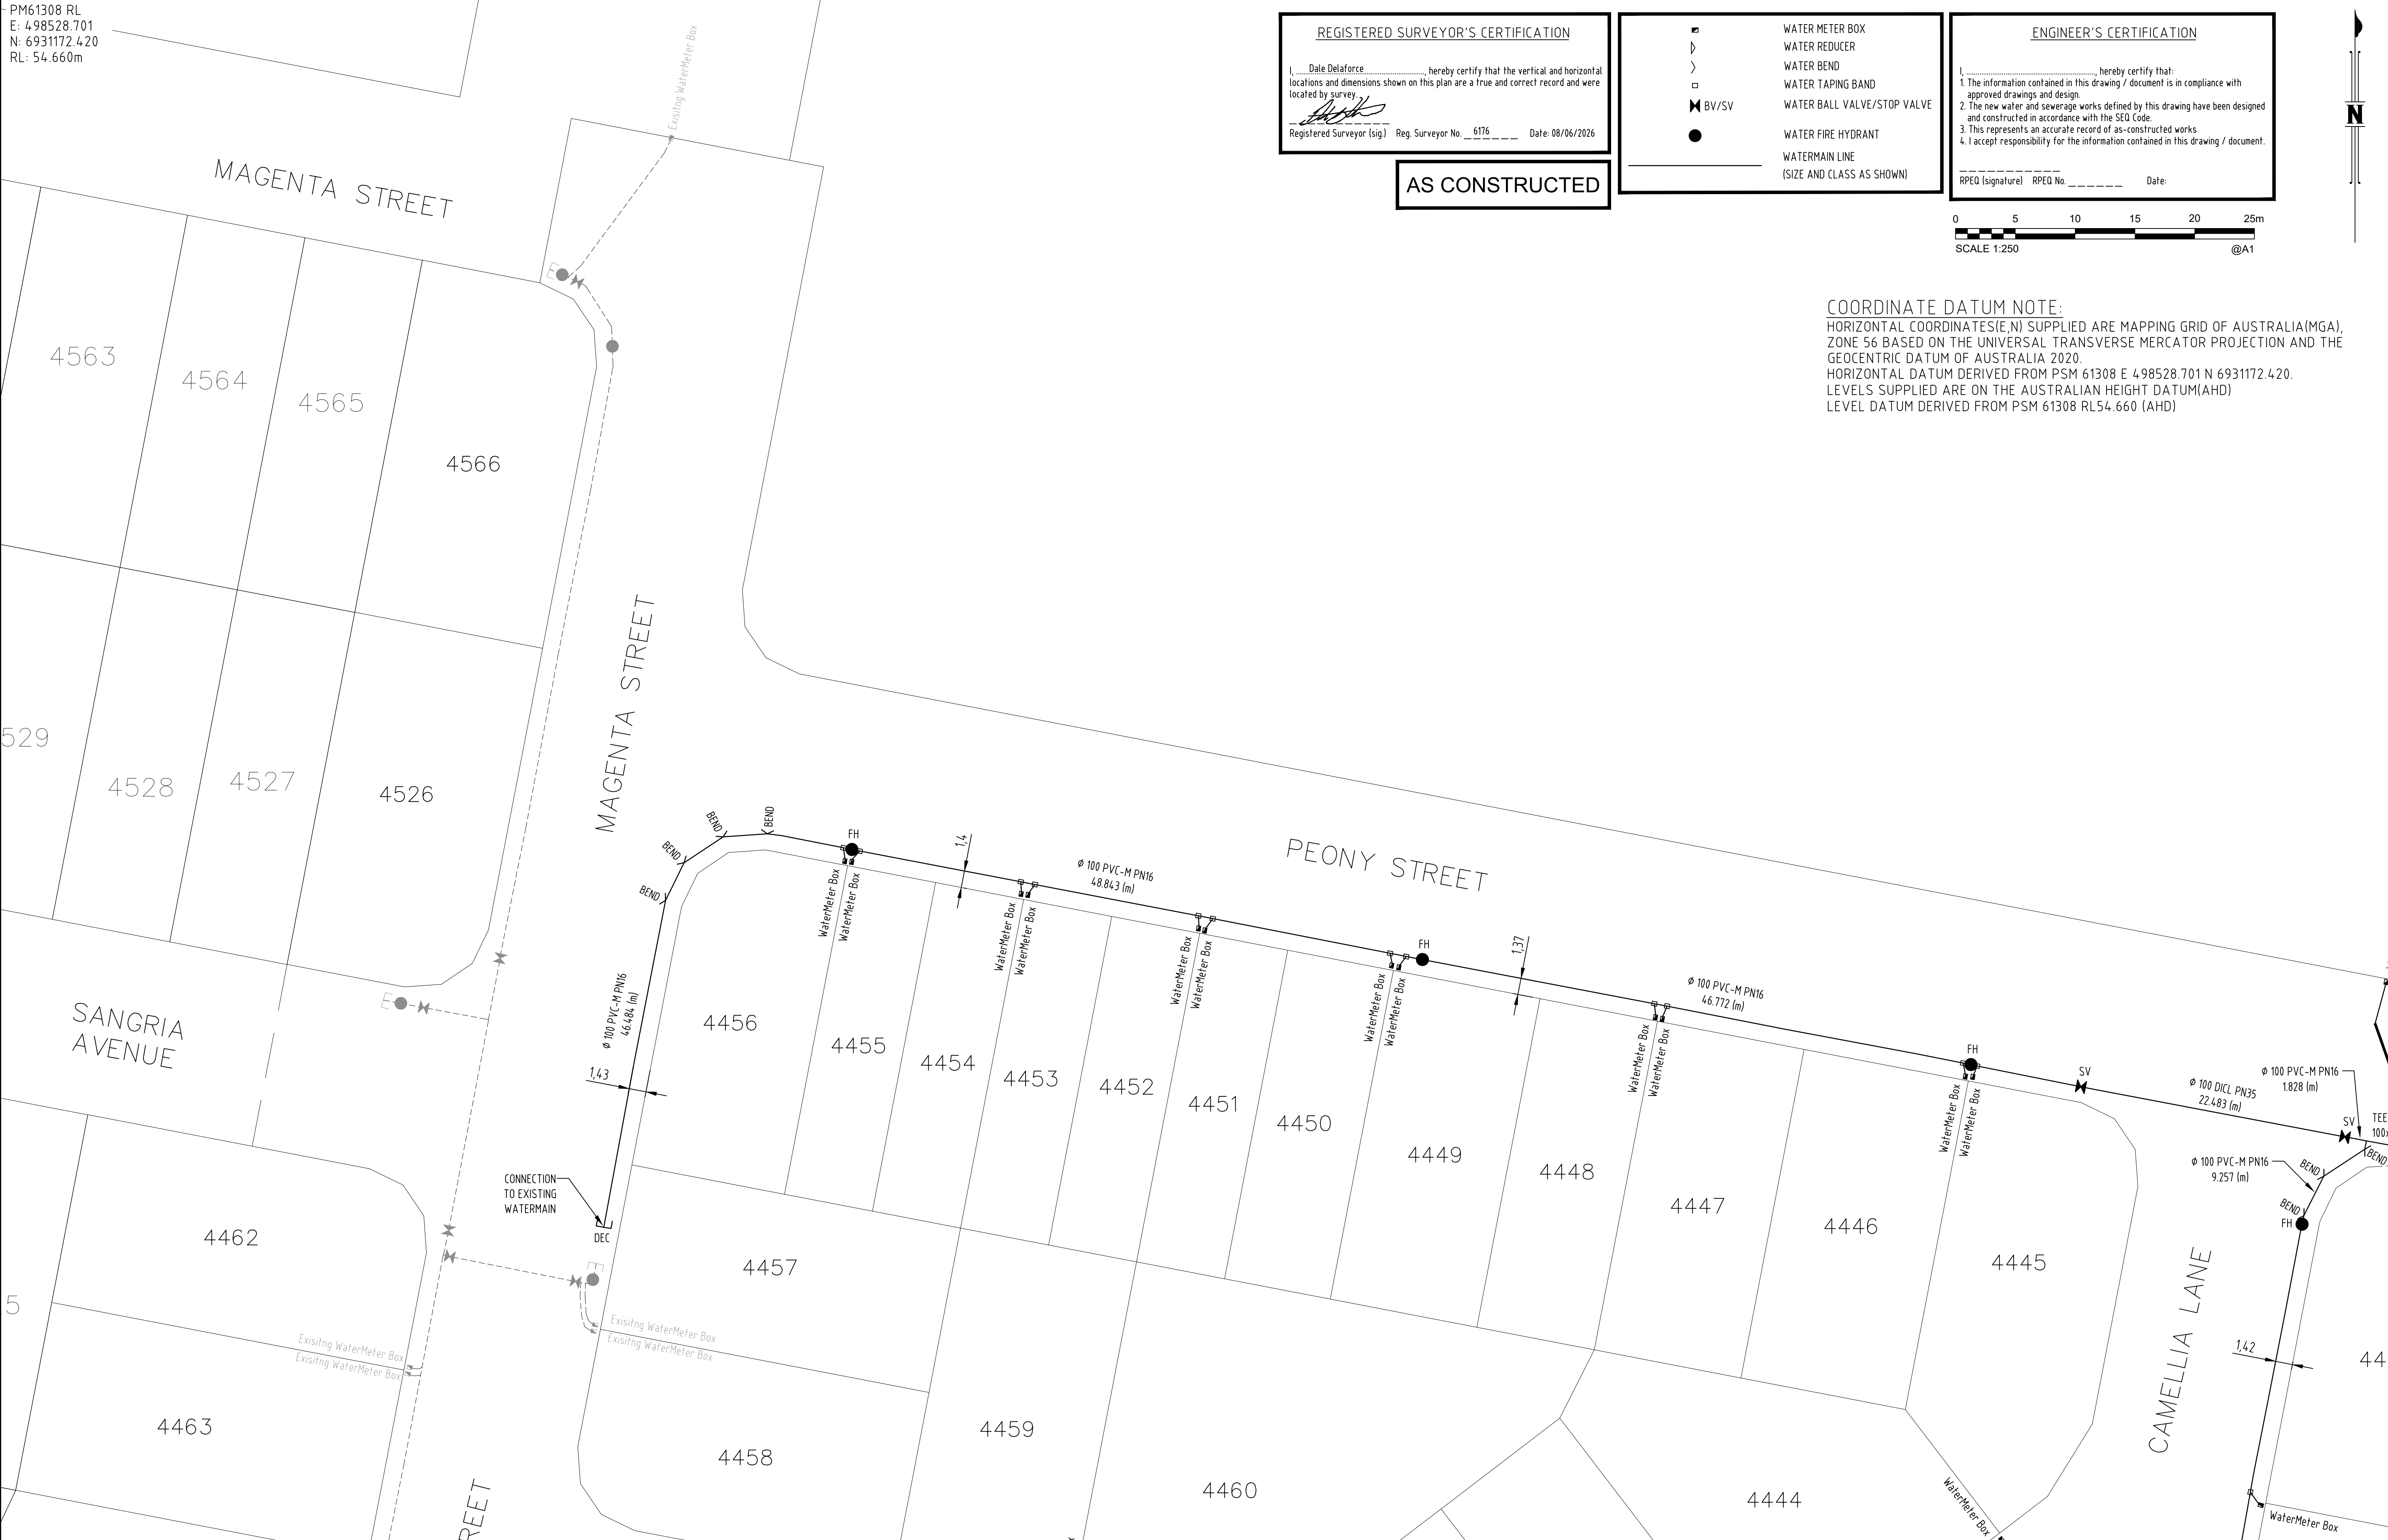

A1

INDEX	DATE	REVISIONS	DRAWN	CHECKED	PASSED	INITIALS	DATE
	08/06/2026	AS CONSTRUCTED				JH	08/06/2026




LOGAN CITY COUNCIL

MIRVAC MIR-0804
AS CONSTRUCTED SURVEY - WATERMAIN
EVERLEIGH PRECINCT 8.4C
GREENBANK QLD

SHEET 2 OF 5 SHEETS	SCALE 1:250 A1
REVISION DATE 08/06/2026	REVISION -
DISCIPLINE CODE -	
DRAWING NO. ASC-WATERMAIN-02-8.4C	

PM61308 RL
E: 498528.701
N: 6931172.420
RL: 54.660m

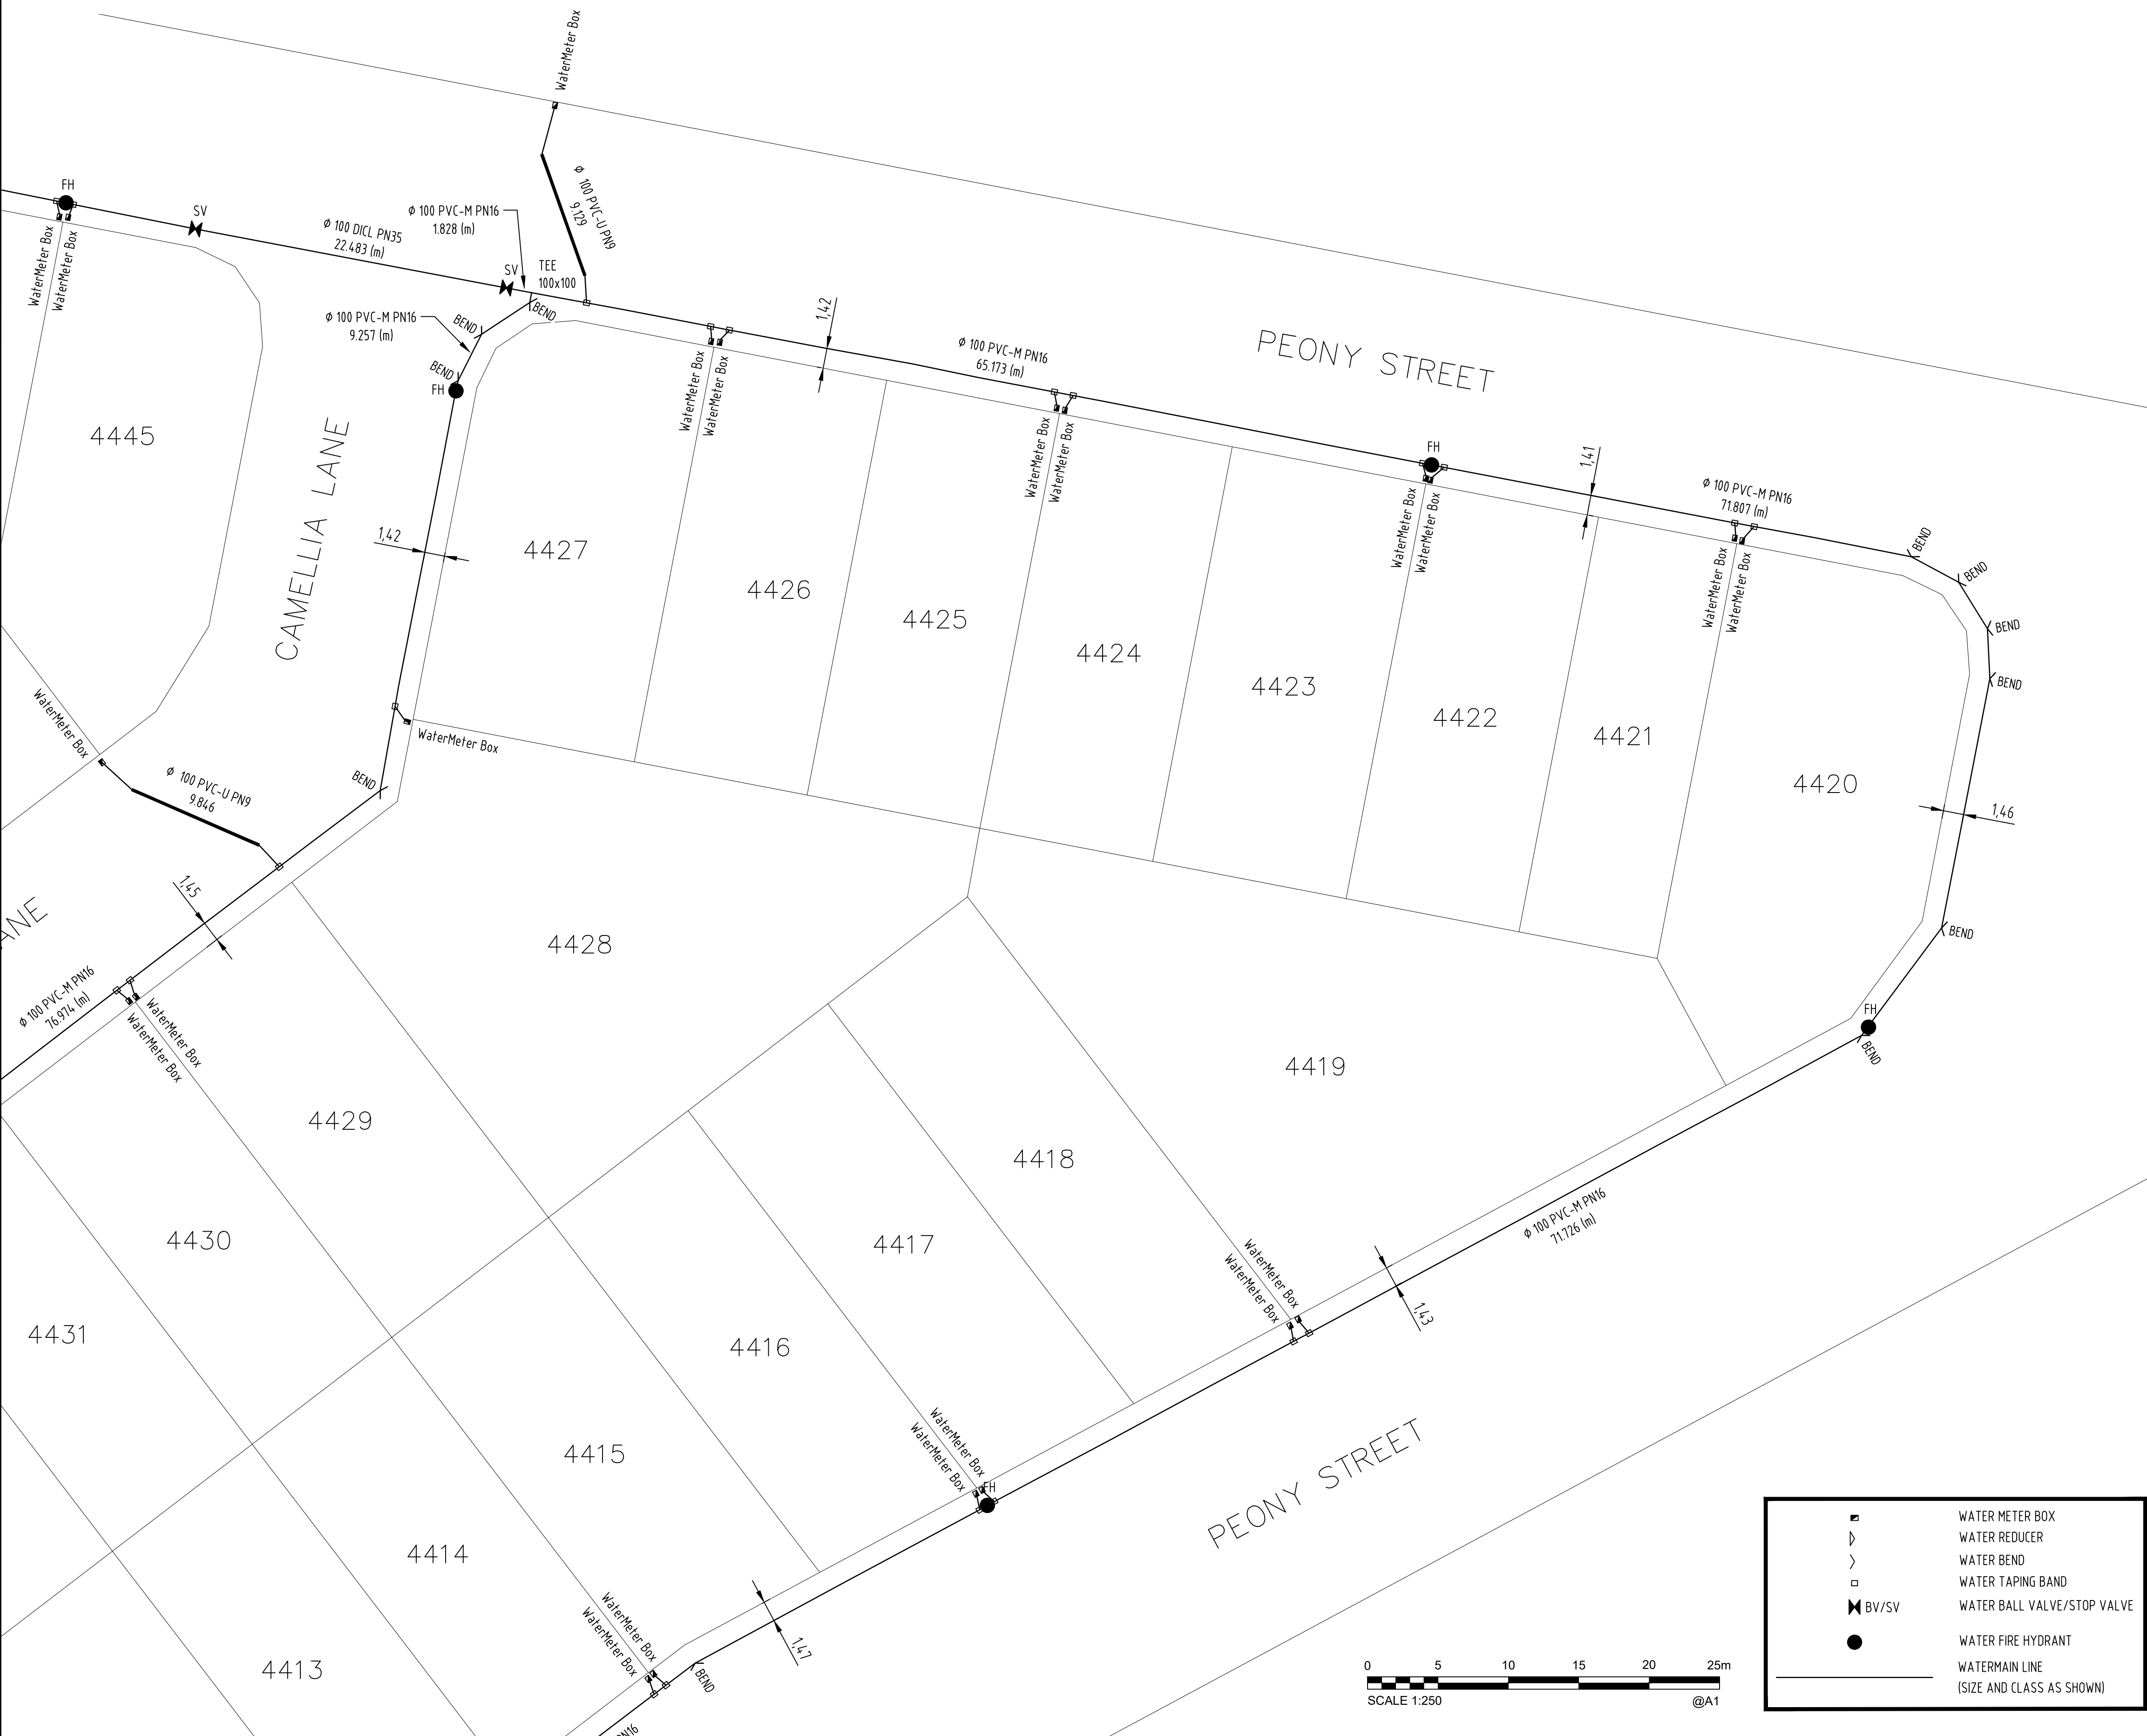

AS CONSTRUCTED

REGISTERED SURVEYOR'S CERTIFICATION

I, Dale Delaforce, hereby certify that the vertical and horizontal locations and dimensions shown on this plan are a true and correct record and were located by survey. ,

Registered Surveyor (sig.) _____ Reg. Surveyor No. 6176 Date: 08/06/2026

ENGINEER'S CERTIFICATION

I, _____, hereby certify that:

1. The information contained in this drawing / document is in compliance with approved drawings and design.
2. The new water and sewerage works defined by this drawing have been designed and constructed in accordance with the SEQ Code.
3. This represents an accurate record of as-constructed works
4. I accept responsibility for the information contained in this drawing / document.

RPEQ (signature) RPEQ No. Date:

COORDINATE DATUM NOTE:
HORIZONTAL COORDINATES(E,N) SUPPLIED ARE MAPPING GRID OF AUSTRALIA(MGA),
ZONE 56 BASED ON THE UNIVERSAL TRANSVERSE MERCATOR PROJECTION AND THE
GEOCENTRIC DATUM OF AUSTRALIA 2020.
HORIZONTAL DATUM DERIVED FROM PSM 61308 E 498528.701 N 6931172.420.
LEVELS SUPPLIED ARE ON THE AUSTRALIAN HEIGHT DATUM(AHD).
LEVEL DATUM DERIVED FROM PSM 61308 RL54.660 (AHD).

A1																																																																																																																																																																																																																																																																																																																																																																																																																																																																																																																																																																																																																																																																																																																																																																																																																																																																																																																																																																																																																																																																																																																																																																																																																																																																																																																																																																																																																				</
----	--	--	----



LOGAN CITY COUNCIL

MIRVAC MIR-0804
AS CONSTRUCTED SURVEY - WATERMAIN
EVERLEIGH PRECINCT 8.4C
GREENBANK QLD

SHEET 3 OF 5	SHEETS	SCALE	1:250 A1
REVISION DATE	08/06/2026	REVISION	-
DISCIPLINE CODE	-		
DRAWING NO. ASC-WATERMAIN-03-8.4C			

PM61308 RL
E: 498528.701
N: 6931172.420
RL: 54.660m

23

4524

4525

4462

4463

4464

4466

4465

MAGENTA STREET

4457

4458

4459

4460

MULBERRY STREET

4461

4438

4437

4436

4439

4440

4435

4441

4405

4406

4407

4449

4448

4447

4446

4445

4444

4443

4442

CAMELLIA LANE

4430

4431

4432

4412

4411

AS CONSTRUCTED

REGISTERED SURVEYOR'S CERTIFICATION

I, Date DeLaforce, hereby certify that the vertical and horizontal locations and dimensions shown on this plan are a true and correct record and were located by survey.

Registered Surveyor (Sig.) Date: 08/06/2026
Reg. Surveyor No. 6176

ENGINEER'S CERTIFICATION

I, Date, hereby certify that:
1. The information contained in this drawing / document is in compliance with approved drawings and design.
2. The new water and sewerage works defined by this drawing have been designed and constructed in accordance with the SEQ Code.
3. This represents an accurate record of as-constructed works.
4. I accept responsibility for the information contained in this drawing / document.

RPEQ (signature) Date:
RPEQ No.

COORDINATE DATUM NOTE:

HORIZONTAL COORDINATES(E,N) SUPPLIED ARE MAPPING GRID OF AUSTRALIA(MGA), ZONE 56 BASED ON THE UNIVERSAL TRANSVERSE MERCATOR PROJECTION AND THE GEOCENTRIC DATUM OF AUSTRALIA 2020.

HORIZONTAL DATUM DERIVED FROM PSM 61308 E 498528.701 N 6931172.420.

LEVELS SUPPLIED ARE ON THE AUSTRALIAN HEIGHT DATUM(AHD)

LEVEL DATUM DERIVED FROM PSM 61308 RL54.660 (AHD)

	WATER METER BOX
	WATER REDUCER
	WATER BEND
	WATER TAPING BAND
	WATER BALL VALVE/STOP VALVE
	WATER FIRE HYDRANT
	WATERMAIN LINE (SIZE AND CLASS AS SHOWN)

0 5 10 15 20 25m
SCALE 1:250 @A1

A1

DRAWN	ALS	08/06/2026
CHECKED	DAM	08/06/2026
PASSED	JH	08/06/2026
INITIALS	DATE	



LOGAN CITY COUNCIL

MIRVAC MIR-0804
AS CONSTRUCTED SURVEY - WATERMAIN
EVERLEIGH PRECINCT 8.4C
GREENBANK QLD

SHEET 4 OF 5 SHEETS SCALE 1:250 A1


REVISION DATE 08/06/2026 REVISION -

DISCIPLINE CODE -

DRAWING NO.

ASC-WATERMAIN-04-8.4C

PM61308 RL
E: 498528.701
N: 6931172.420
RL: 54.660m

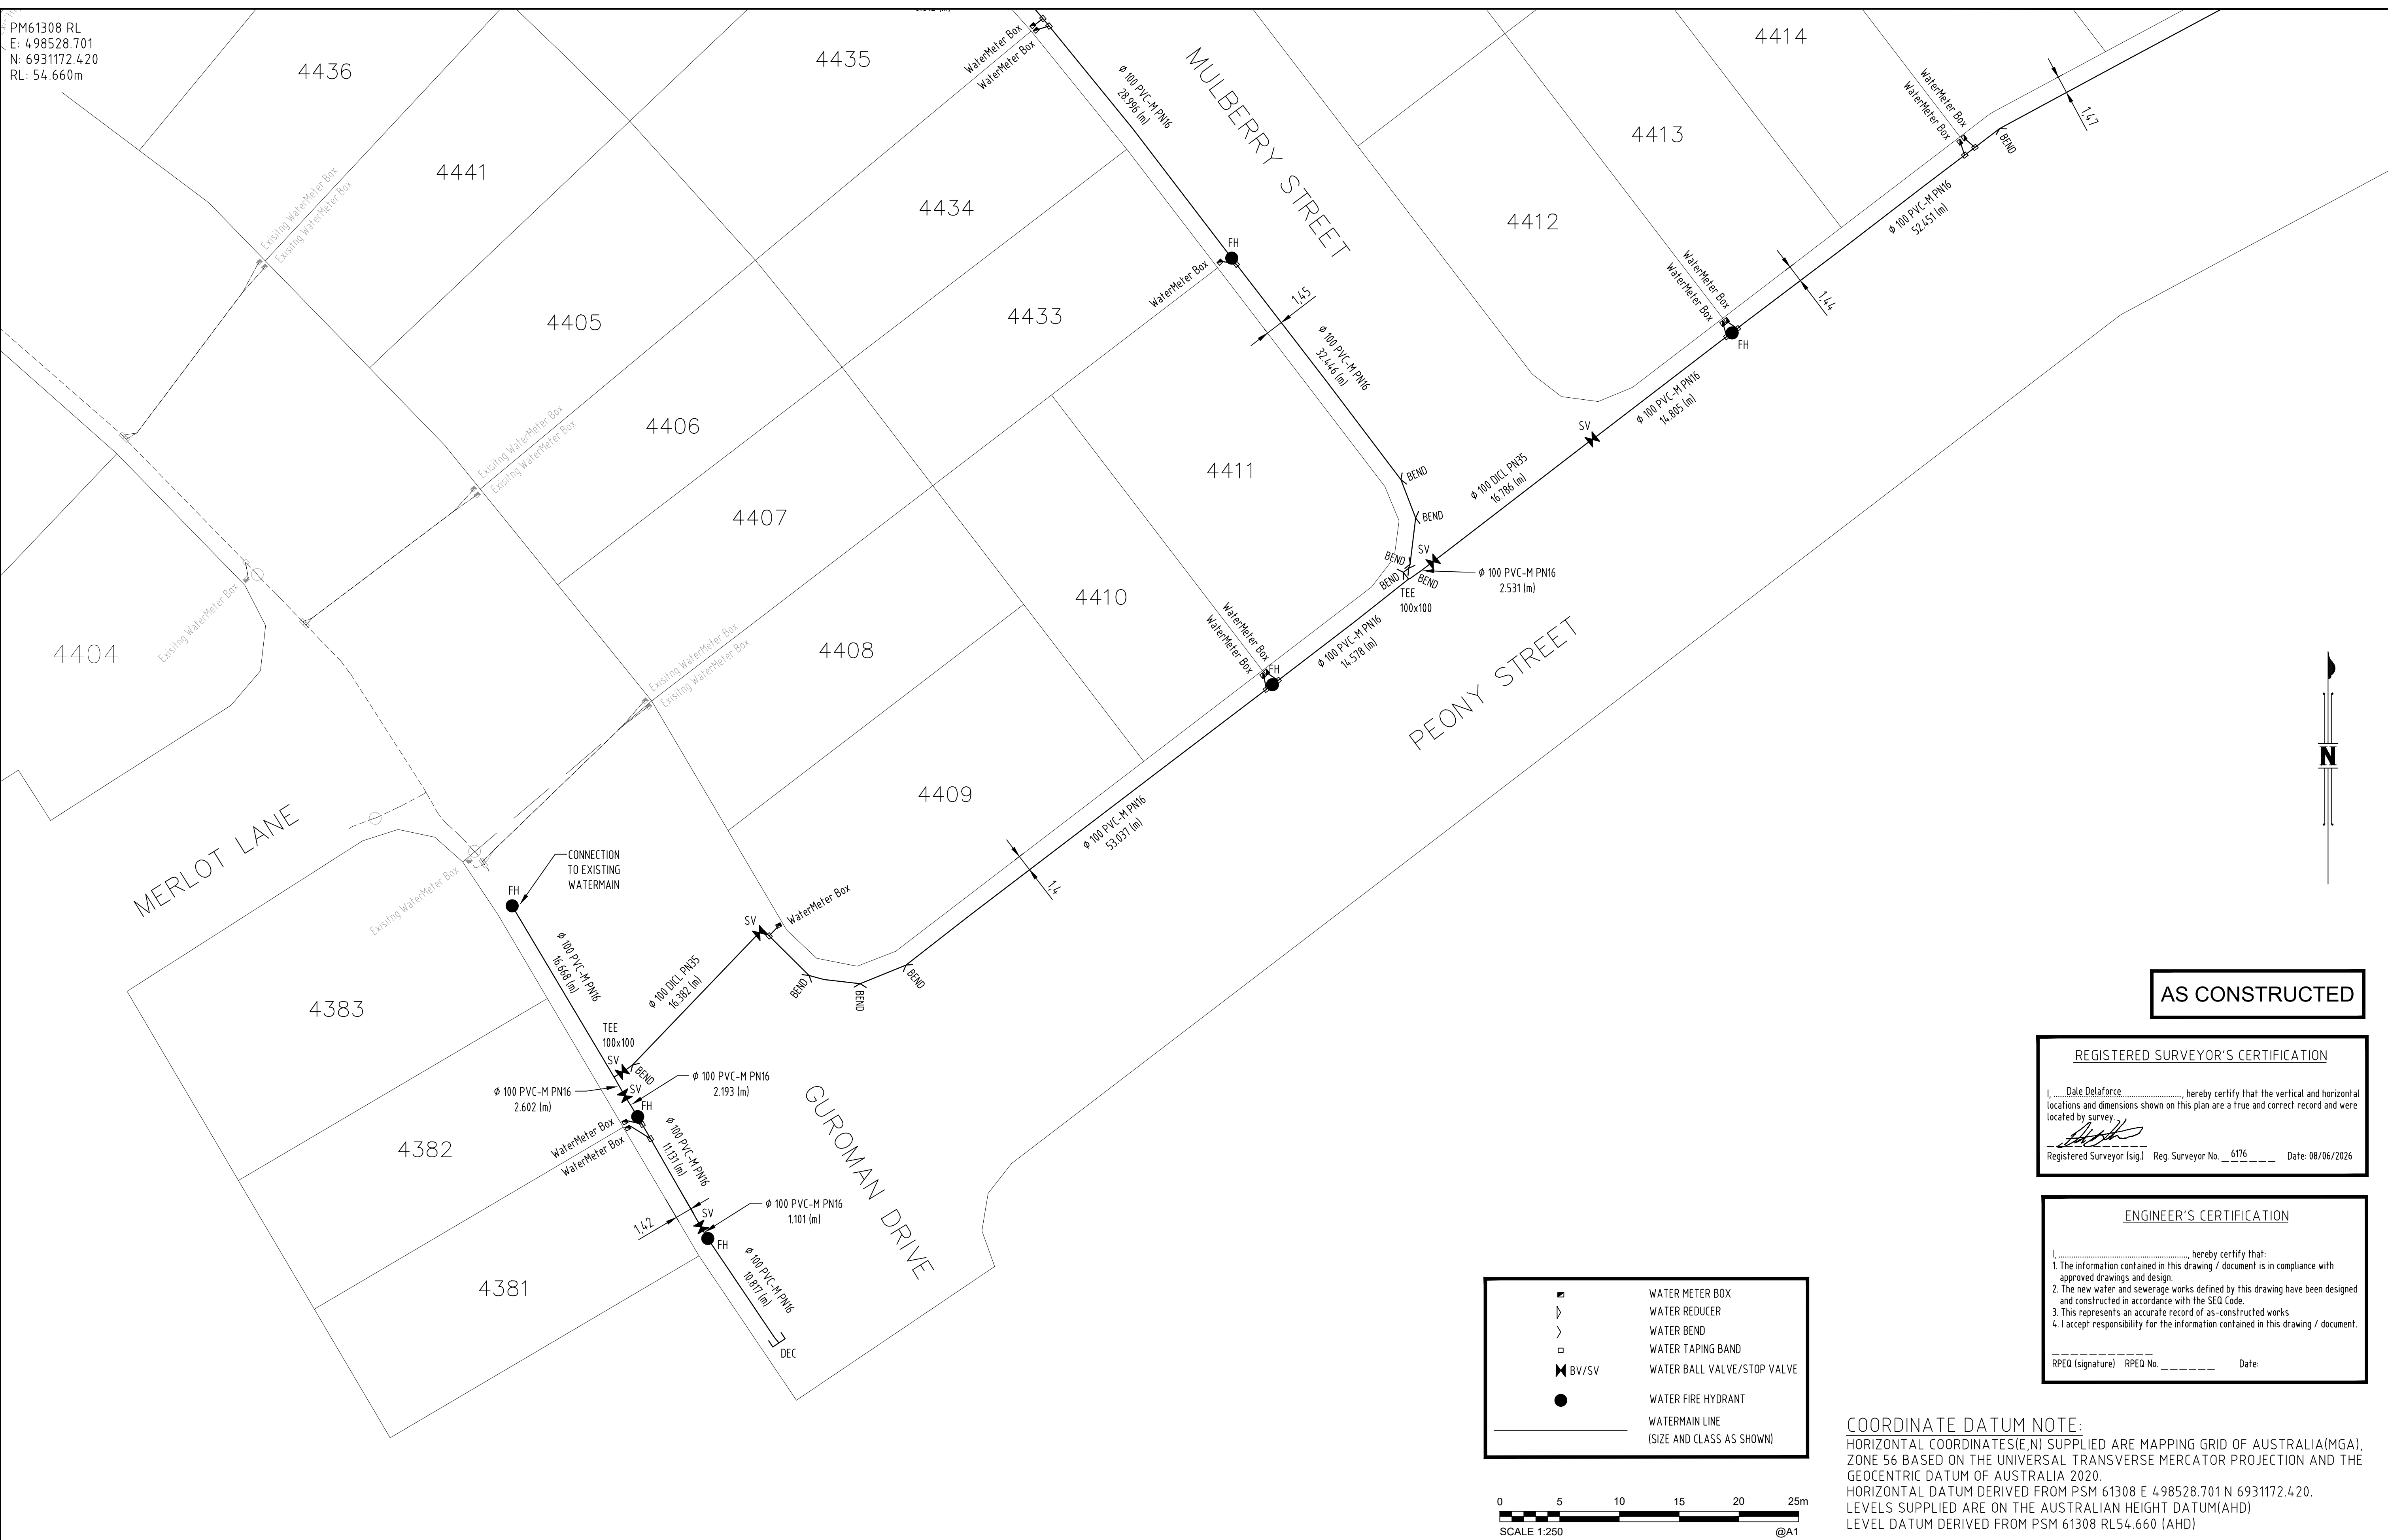

AS CONSTRUCTED

REGISTERED SURVEYOR'S CERTIFICATION

I, Dale Delaforce, hereby certify that the vertical and horizontal locations and dimensions shown on this plan are a true and correct record and were located by survey.

Registered Surveyor (s/a) _____ Rea. Surveyor No. 6176 Date: 08/06/2026

ENGINEER'S CERTIFICATION

I, _____, hereby certify that:

1. The information contained in this drawing / document is in compliance with approved drawings and design.
2. The new water and sewerage works defined by this drawing have been designed and constructed in accordance with the SEQ Code.
3. This represents an accurate record of as-constructed works
4. I accept responsibility for the information contained in this drawing / document.

RPEQ (signature) RPEQ No. _____ Date _____

COORDINATE DATUM NOTE:
 HORIZONTAL COORDINATES(E,N) SUPPLIED ARE MAPPING GRID OF AUSTRALIA(MGA)
 ZONE 56 BASED ON THE UNIVERSAL TRANSVERSE MERCATOR PROJECTION AND THE
 GEOCENTRIC DATUM OF AUSTRALIA 2020.
 HORIZONTAL DATUM DERIVED FROM PSM 61308 E 4 98528.701 N 6931172.420.
 LEVELS SUPPLIED ARE ON THE AUSTRALIAN HEIGHT DATUM(AHD)
 LEVEL DATUM DERIVED FROM PSM 61308 RL54.660 (AHD)

A1

[illegible]

LOGAN CITY COUNCIL

MIRVAC MIR-0804
AS CONSTRUCTED SURVEY - WATERMAIN
EVERLEIGH PRECINCT 8.4C
GREENBANK QLD

SHEET 5 OF 5	SHEETS	SCALE	1:250 A1
REVISION DATE	08/06/2026	REVISION	—
DISCIPLINE CODE	—		
DRAWING NO. ASC-WATERMAIN-05-8.4C			